

Part I-80-5

GUARD RAIL AND SIGNING  
I-80-5(83)153--01-50

JASPER-POWESHIK COUNTY

LETTING DATE 10-11-77

CONVENTIONAL SIGNS


State Line  
Co. Line  
Twp. Line  
Sec. Line  
Corp. Line  
Urban Bdy.  
R.O.W. Lines  
Survey Line

Sec. Corner  
Profile Grade  
Railroad  
Field Tile  
Underground Lines

Culverts  
Utility Poles

Fence  
Trees Or Fr. sh.  
Stream  
Dike

County Road No.  
Primary Road No.  
U.S. Road No.  
Interstate Road No.

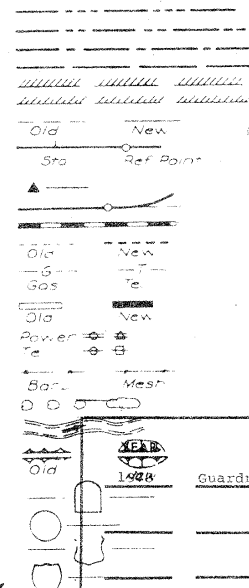

THIS AS BUILT PLAN INCLUDES  
WORK CONTRACTOR

PROJ. INSPECTOR

Guardrail & Signing Dieseth Specialty

Roy E. Johnson

IOWA  
DEPARTMENT OF TRANSPORTATION  
Highway Division  
PLANS OF PROPOSED IMPROVEMENT ON THE  
INTERSTATE ROAD SYSTEM  
JASPER - POWESHIK COUNTY  
GUARD RAIL AND SIGNING  
CURB REMOVAL AND ISLAND MODIFICATION  
ON I-80 FROM POLK CO. LINE TO IOWA CO. LINE

SCALES AS NOTED

THE STANDARD SPECIFICATIONS, SERIES OF 1977,  
OF THE IOWA STATE HIGHWAY COMMISSION,  
SHALL APPLY TO CONSTRUCTION WORK ON THIS PROJECT

CONSTRUCTION PLANS SHOWING PROJECT AS BUILT

Plan Preparation Supervised By: *E. J. ...*

Resident Construction Engineer

Date: 8/20/77 Iowa Reg. No. 7554

REVIEWED AND FORWARDED TO AMES

Roy Kuhn  
District Construction Engineer

Date: 5/4/78

One Set of Plans to Be Made and Returned To

Bob Humphrey  
District Engineer


AFTER MICROFILMING RETURN ORIGINAL  
TO DISTRICT NO. 1

FOR DESIGN DATA, INDEX OF SHEETS, MILEAGE  
SUMMARY AND TABULATION OF ROAD STAND-  
ARDS SEE SHEET NO. 2A.

REVISED:

SEE FOLLOWING SHEET 1A

STA. 3458+41.00  
END DIV. 1  
BEGIN DIV. 2

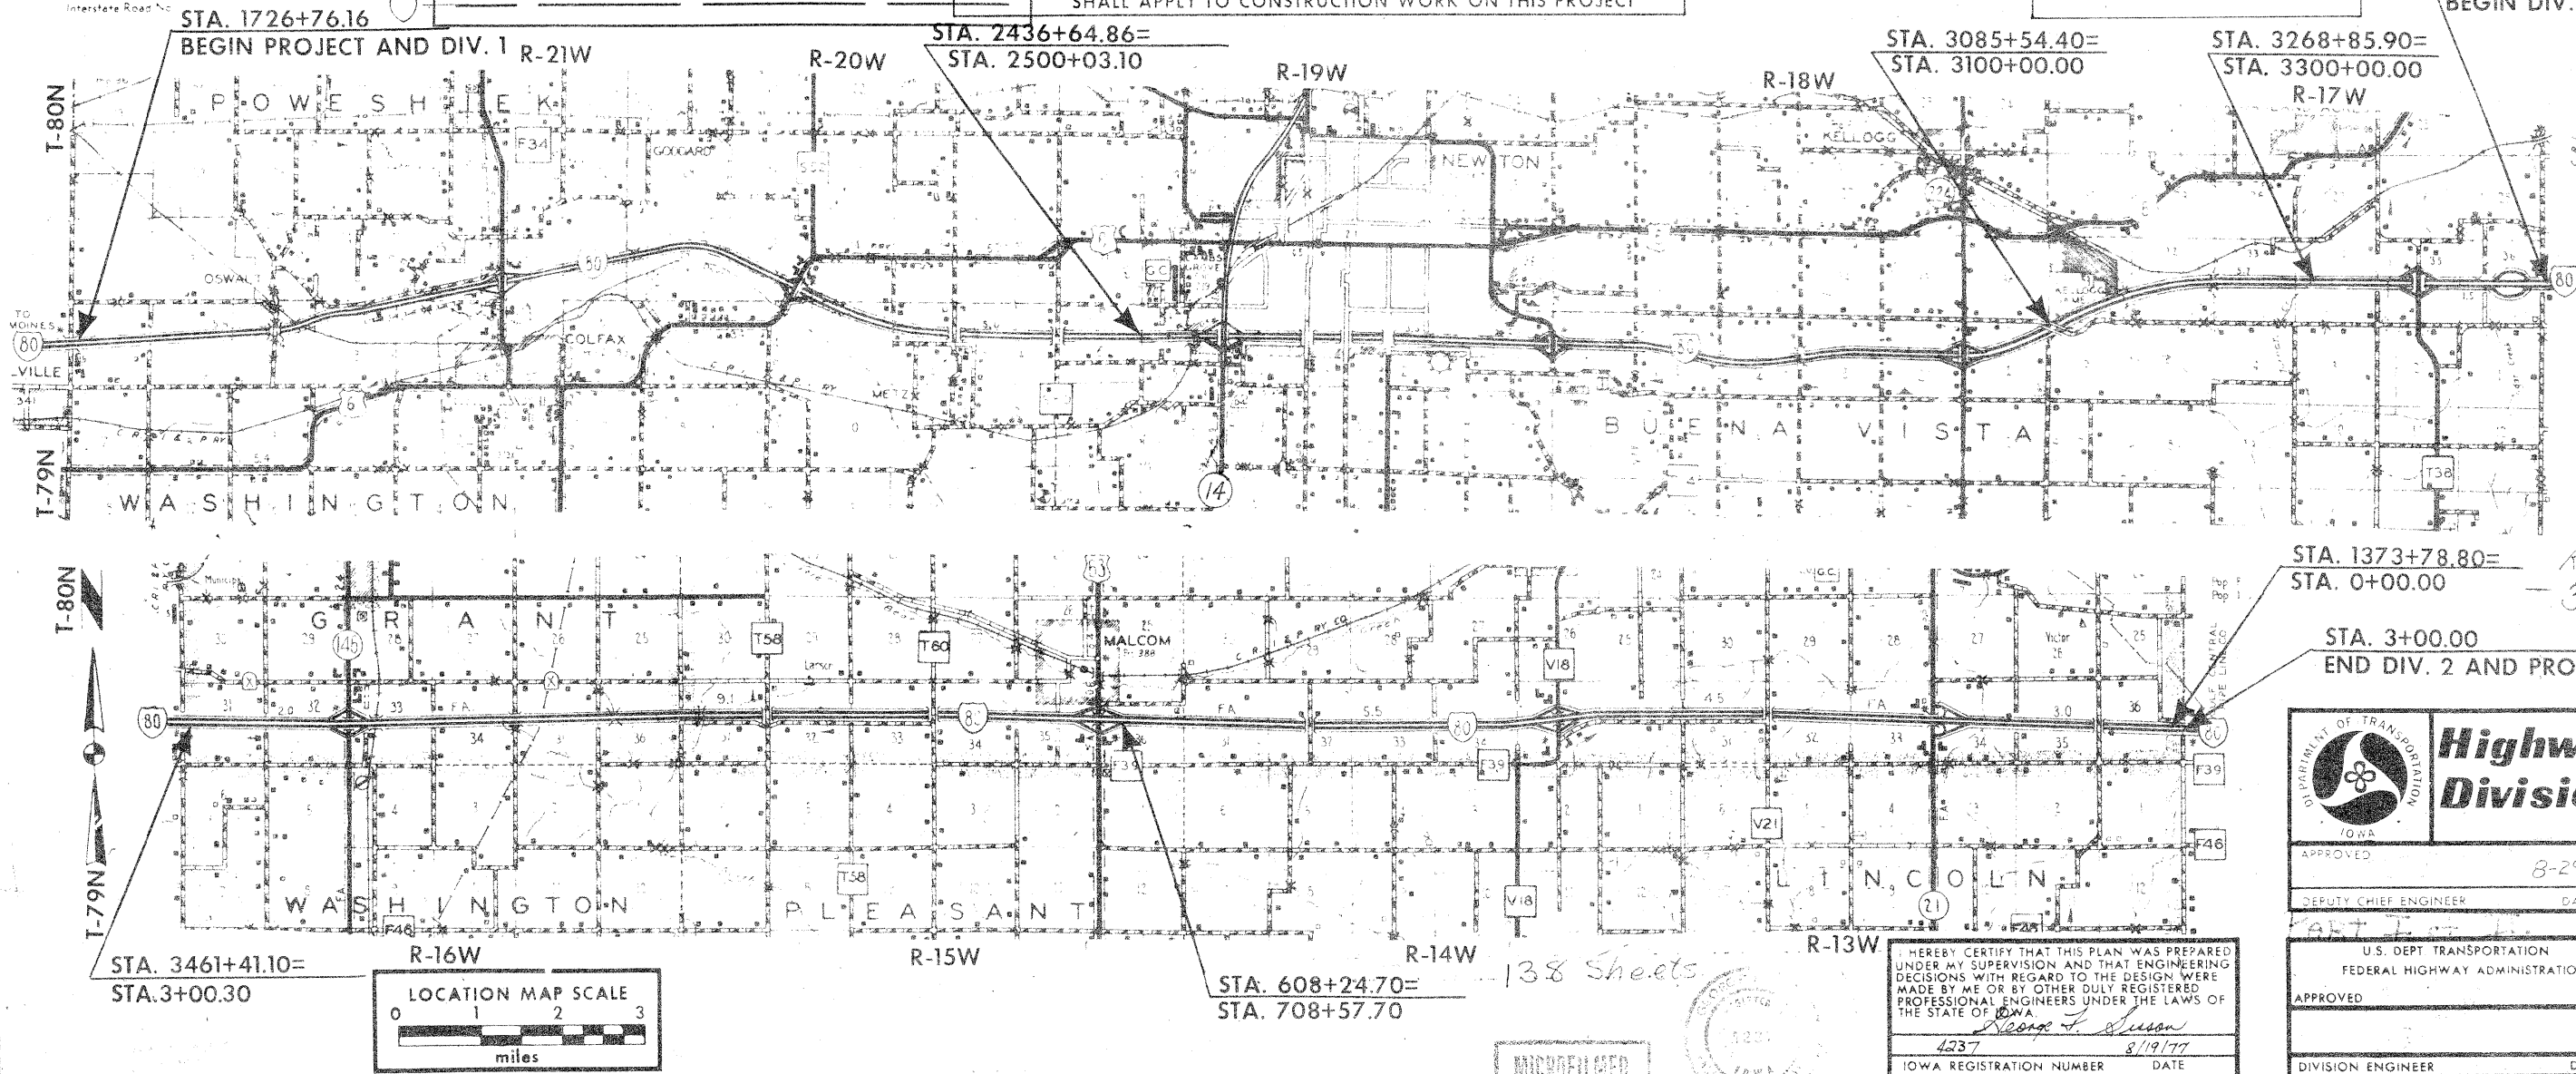

STA. 1373+78.80=  
STA. 0+00.00

STA. 3+00.00  
END DIV. 2 AND PROJECT

APPROVED	8-29-77
DEPUTY CHIEF ENGINEER	DATE
U.S. DEPT. TRANSPORTATION FEDERAL HIGHWAY ADMINISTRATION	
APPROVED	
DIVISION ENGINEER	DATE

HEREBY CERTIFY THAT THIS PLAN WAS PREPARED  
UNDER MY SUPERVISION AND THAT ENGINEERING  
DECISIONS WITH REGARD TO THE DESIGN WERE  
MADE BY ME OR BY OTHER DULY REGISTERED  
PROFESSIONAL ENGINEERS UNDER THE LAWS OF  
THE STATE OF IOWA  
*George F. ...*  
4237 8/19/77  
IOWA REGISTRATION NUMBER DATE

MICROFILMED

