


BRIDGES  
FFD-561-1(2)--2N-82

SCOTT COUNTY

## CONVENTIONAL SIGNS

State Line  
Co. Line  
Twp. Line  
Sec. Line  
Corp. Line  
Urban Bdry.  
R.O.W. Lines  
Survey Line

Sec. Corner  
Profile Grade  
Railroad  
Field Tile  
Underground Lines  
Culverts  
Utility Poles  
Fences  
Trees Or Brush  
Stream  
Dike  
County Road No.  
Primary Road No.  
U. S. Road No.  
Interstate Road No.

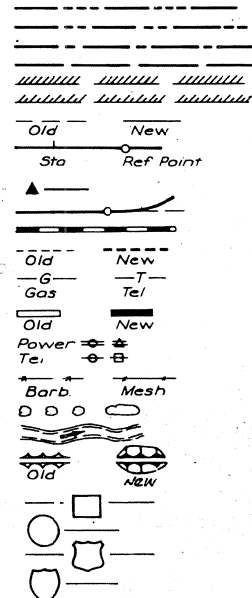

IOWA  
DEPARTMENT OF TRANSPORTATION  
**Highway Division**  
PLANS OF PROPOSED IMPROVEMENT ON THE  
**PRIMARY ROAD SYSTEM**  
**SCOTT COUNTY**  
**BRIDGES**

U.S. 561 FROM I-80 N. 4.5 MILES


SCALES: AS NOTED

THE STANDARD SPECIFICATIONS, SERIES OF 1977  
OF THE IOWA DEPARTMENT OF TRANSPORTATION, <sup>DID</sup>  
SHALL APPLY TO CONSTRUCTION WORK ON THIS PROJECT

(PLUS CURRENT SUPPLEMENTAL SPECIFICATIONS AND SPECIAL PROVISIONS)

## DESIGN STRESSES:

Design stresses for the following materials are in accordance with the  
AASHTO Standard Specifications for Highway Bridges, Series of 1977.  
Reinforcing Steel in accordance with Section I.5, Grade 40 and Grade 60.  
Concrete in accordance with Section I.5, f'c = 3,500 psi.  
Structural Steel in accordance with Section I.7. ASTM A-36. Fatigue  
stress cycles based on Case II.

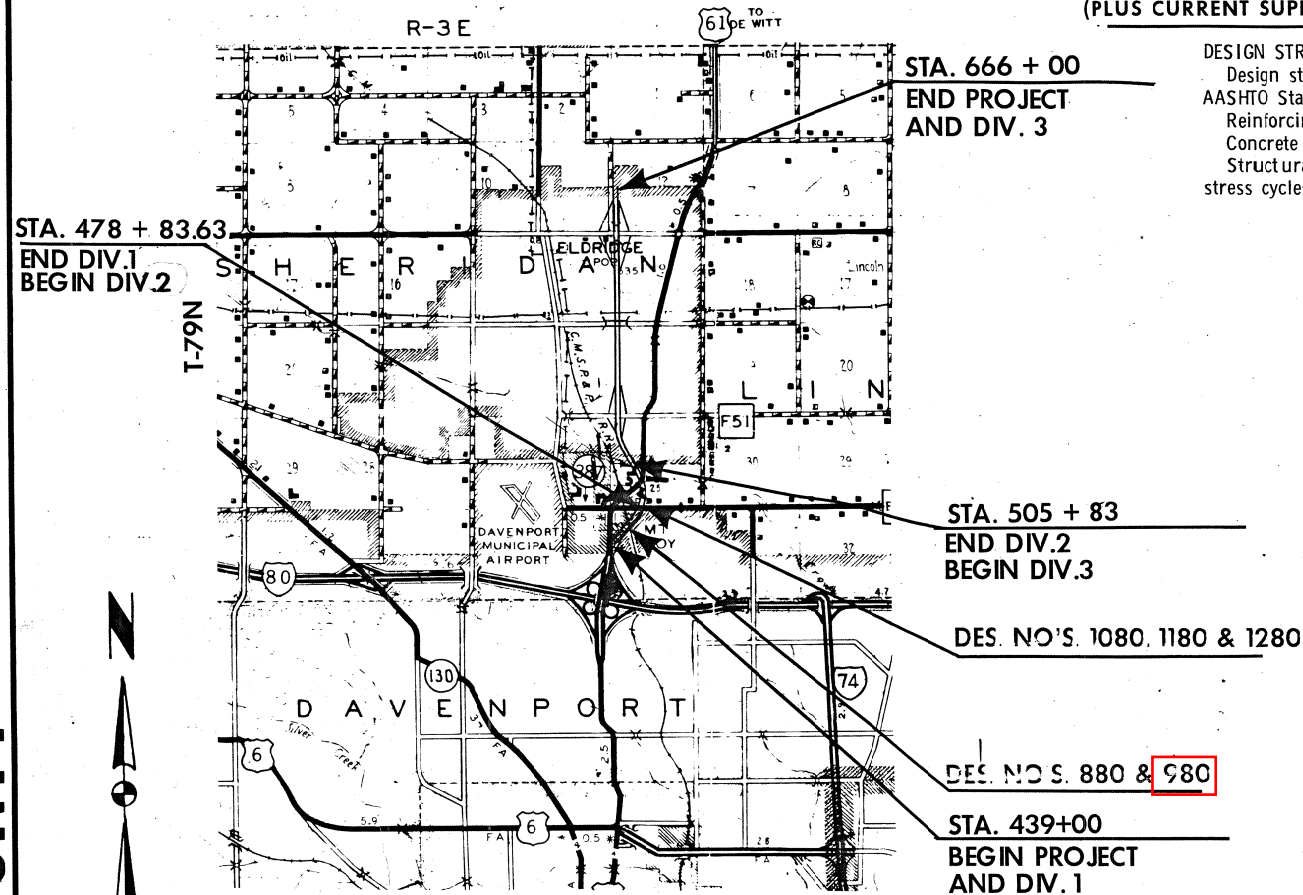

STA. 666 + 00  
END PROJECT  
AND DIV. 3

STA. 478 + 83.63  
END DIV. 1  
BEGIN DIV. 2

STA. 505 + 83  
END DIV. 2  
BEGIN DIV. 3

DES. NO'S. 1080, 1180 &amp; 1280

DES. NO'S. 880 &amp; 980

STA. 439+00  
BEGIN PROJECT  
AND DIV. 1

## LOCATION MAP



## DESIGN DATA

RURAL				URBAN			
1979 AADT	14,250	V.P.D.		1979 AADT	14,250	V.P.D.	
1999 AADT	29,910	V.P.D.		1999 AADT	29,910	V.P.D.	
1999 DHV	3,424	V.P.H.		1999 DHV	3,424	V.P.H.	
DIRECTIONAL		%		DIRECTIONAL		%	
TRUCKS	11	%		TRUCKS	11	%	
DESIGN V		M.P.H.		DESIGN V		M.P.H.	
CLASS 1	ACCESS CONTROL			CLASS 1	ACCESS CONTROL		

## MILEAGE SUMMARY

105.1

DIV.	LOCATION	LIN. FT.	MILES
1	URBAN: (City of Davenport) Sta. 439+00.00 to Sta. 478+83.63 Bridges at Sta. 462+20.68 Bridges at Sta. 478+83.54 (South Half) Total Length of Roadway - Div. 1 Total Length of Bridges - Div. 1 Total Length of Div. 1	3,983.63 345.20 132.30 3,506.13 477.50 3,983.63	0.664 0.090 0.754
2	RURAL: (Scott Co.) Sta. 478+83.63 to Sta. 505+83.00 Bridges at Sta. 478+83.54 (North Half) Bridges at Sta. 505+96.00 (South Half) Total Length of Roadway - Div. 2 Total Length of Bridges - Div. 2 Total Length of Div. 2	2,699.37 132.30 61.60 2,505.47 193.90 2,699.37	0.474 0.097 0.511
3	URBAN: (City of Eldridge) Sta. 505+83.00 to Sta. 666+00.00 Bridges at Sta. 505+96.00 (North Half) Bridge at Sta. 545+86.00 (R.C.B.) Equation: Sta. 547+32.19 = Sta. 547+20.63 (Lengthens Line) Bridges at Sta. 640+66.91 Total Length of Roadway - Div. 3 Total Length of Bridges - Div. 3 Total Length of Div. 3	16,017.00 61.60 26.51 11.56 171.00 15,769.45 259.11 16,028.56	2.987 0.049 3.036
Total Length of Roadway in Project		21,781.05	4.125
Total Length of Bridges in Project		930.51	0.176
Total Length of Project		22,711.56	4.301

REV  
\* 45 \*

REVISED

SEE FOLLOWING SHEET 1A

I HEREBY CERTIFY THAT THIS PLAN WAS PREPARED  
UNDER MY SUPERVISION AND THAT ENGINEERING  
DECISIONS WITH REGARD TO THE DESIGN WERE  
MADE BY ME OR BY OTHER DULY REGISTERED  
PROFESSIONAL ENGINEERS UNDER THE LAWS OF  
THE STATE OF IOWA.  
See Design Sheet 1 of each  
Design  
IOWA REGISTRATION NUMBER DATE

STATE	FED. ROAD DIST. NO.	FISCAL YEAR	SHEET NO.	TOTAL SHEETS
IOWA	1		1	125
PROJECT NUMBER				
FFD-561-1(2)--2N-82				
R.O.W. PROJECT NUMBER				
F-561-1(3)--20-82				
PRELIMINARY ENGINEER NUMBER				
F-561-1(900)--20-82				

## INDEX OF SHEETS

NO.	DESCRIPTION
1	TITLE SHEET
1A	REVISION SHEET
2-3	ESTIMATE SHEET
4-32	BRIDGE DESIGN NO. 880
33-61	BRIDGE DESIGN NO. 980
62-84	BRIDGE DESIGN NO. 1080
85-108	BRIDGE DESIGN NO. 1180
109-125	BRIDGE DESIGN NO. 1280

## CONSTRUCTION PLANS SHOWING PROJECT AS BUILT


Plan Preparation Supervised By: Bruce Kuehl  
Resident Construction Engineer  
Date: 1-16-86 Iowa Reg. No. 8371  
REVIEWED AND FORWARDED TO AMES  
District Construction Engineer  
One 50% Reduced and Four Full-Size Prints To Be Made and Returned To  
R. C. Henely  
District Engineer

AFTER MICROFILMING RETURN ORIGINAL  
TO DISTRICT NO. 6

DEPARTMENT OF TRANSPORTATION, HIGHWAY DIVISION  
STANDARDS REQUIRED (Available at Bridge Design Services)

STANDARD ISSUED REVISED

YEAR	WORK	CONTRACTOR	PROJ. INSPECTOR
1981	Bridge 880	Lunda	F. Springer
1981	Bridge 980	Lunda	F. Springer
1981	Bridge 1080	Lunda	M. Jackson
1981	Bridge 1180	Lunda	M. Jackson
1981	Bridge 1280	Lunda	M. Jackson

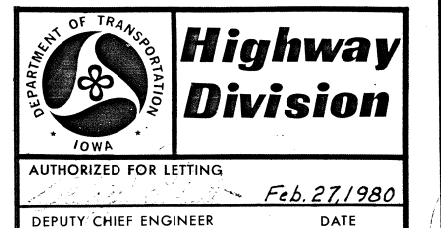

U.S. DEPT. TRANSPORTATION  
FEDERAL HIGHWAY ADMINISTRATION  
APPROVED  
DIVISION ENGINEER DATE

LETTING DATE APRIL 22, 1980

STATE CONTROL SECTION NUMBER 82-2500

FILE NO. 25588

SCOTT COUNTY

PROJECT NO. FFD-561-1(2)--2N-82

SHEET NO. 1 OF 125

LISTING OF PROJECT REVISIONS

DATE	SHEET NUMBER	DESCRIPTION OF REVISIONS	DATE	SHEET NUMBER	DESCRIPTION OF REVISIONS															
3-6-81		Designs 880, 980, 1080 & 1180																		
	1A of <del>125</del> 130	This sheet added to project (Revision Sheet).																		
		Design 880																		
	5 of <del>125</del> 130	Reinforcing Steel and Epoxy Coated Reinforcing Steel quantities changed and/or corrected.																		
	9 of <del>125</del> 130	Pier Column Reinforcing changed.																		
	10 of <del>125</del> 130	Re-bar number and weight changed for Pier No. 1 and Pier No. 2																		
	13 of <del>125</del> 130	"Tabulation of Epoxy Coated Re-bars" corrected.																		
	16 of <del>125</del> 130	"Reinforcing Steel" list and "Total Estimated Quantities" list correcte.																		
	24 of <del>125</del> 130	Epoxy Coated re-bar list and Estimated Qtynty list corrected.																		
		Design 980																		
	<del>34</del> 35 of <del>125</del> 130	Reinforcing Steel and Epoxy Coated Reinforcing Steel quantittes changed and/or corrected.																		
	<del>38</del> 39 of <del>125</del> 130	Pier Column reinforcing changed.																		
	<del>39</del> 40 of <del>125</del> 130	Reinforcing Bar list--Pier No. 2 changed. Total Estimated Quantities changed.																		
	<del>42</del> 43 of <del>125</del> 130	Weight corrected in tabulation of Epoxy Coated Re-bars.																		
	<del>43</del> 45 of <del>125</del> 130	Reinforcing Steel list and Total Estimated Quantities list corrected.																		
		Design 1080																		
	<del>63</del> 64 of <del>125</del> 130	Superstructure quantity for Epoxy Coated Reinforcing Steel corrected.																		
	<del>75</del> 77 of <del>125</del> 130	Number and Weight of 5d1 reinforcing bars corrected.																		
		Design 1180																		
	<del>86</del> 88 of <del>125</del> 130	Pier quantity for Reinforcing Steel corrected.																		
	<del>93</del> 95 of <del>125</del> 130	Number and weight of 5c2 & 5c3 cap hoops corrected.																		
	<del>97</del> 99 of <del>125</del> 130	Number and weight of 4e1 column hoops corrected.																		
	2 of <del>125</del> 130	Designs 880 & 980---Reinforcing Steel weights changed and/or corrected.																		
	3 of <del>125</del> 130	Design 1080--Epoxy Coated Reinforcing Steel weight corrected.																		
		Design 1180--Reinforcing Steel weight corrected.																		
	1 of <del>125</del> 130	Sheet 1A added to "Index of Sheets."																		
		REASON: On Designs 880 & 980 there was a design omission concerning the effects of cap shrinkage in designing the Piers. The redesign shows a need for additional reinforcing in the exterior columns of Piers No. 2 in both designs. All other corrections were due to plan errors.																		
		<table><tr><td></td><td>Reinforcing Steel</td><td>Epoxy Coated Reinforcing Steel</td></tr><tr><td>Design 880</td><td>+217</td><td>-57</td></tr><tr><td>Design 980</td><td>+1060</td><td>+4</td></tr><tr><td>Design 1080</td><td></td><td>+57</td></tr><tr><td>Design 1180</td><td>-64</td><td></td></tr></table>		Reinforcing Steel	Epoxy Coated Reinforcing Steel	Design 880	+217	-57	Design 980	+1060	+4	Design 1080		+57	Design 1180	-64				
	Reinforcing Steel	Epoxy Coated Reinforcing Steel																		
Design 880	+217	-57																		
Design 980	+1060	+4																		
Design 1080		+57																		
Design 1180	-64																			

REVISION SHEET






**CORRECTED  
PLANS**

THIS AS BUILT PLAN INCLUDES			
YEAR	WORK	CONTRACTOR	PROJ. INSPECTOR
1981	Bridge	Lunda	F. Springer

Sta. 464+54.14 25.5' Lt. E. Med. THCM Top N.E. Wingwall Elev. 778.40

BENCH MARK NO. 53 STA. 458+15-304' RT.  
R.R. SPK. W. SIDE PO. POLE AT R.R. TRACK--EL. 743.13

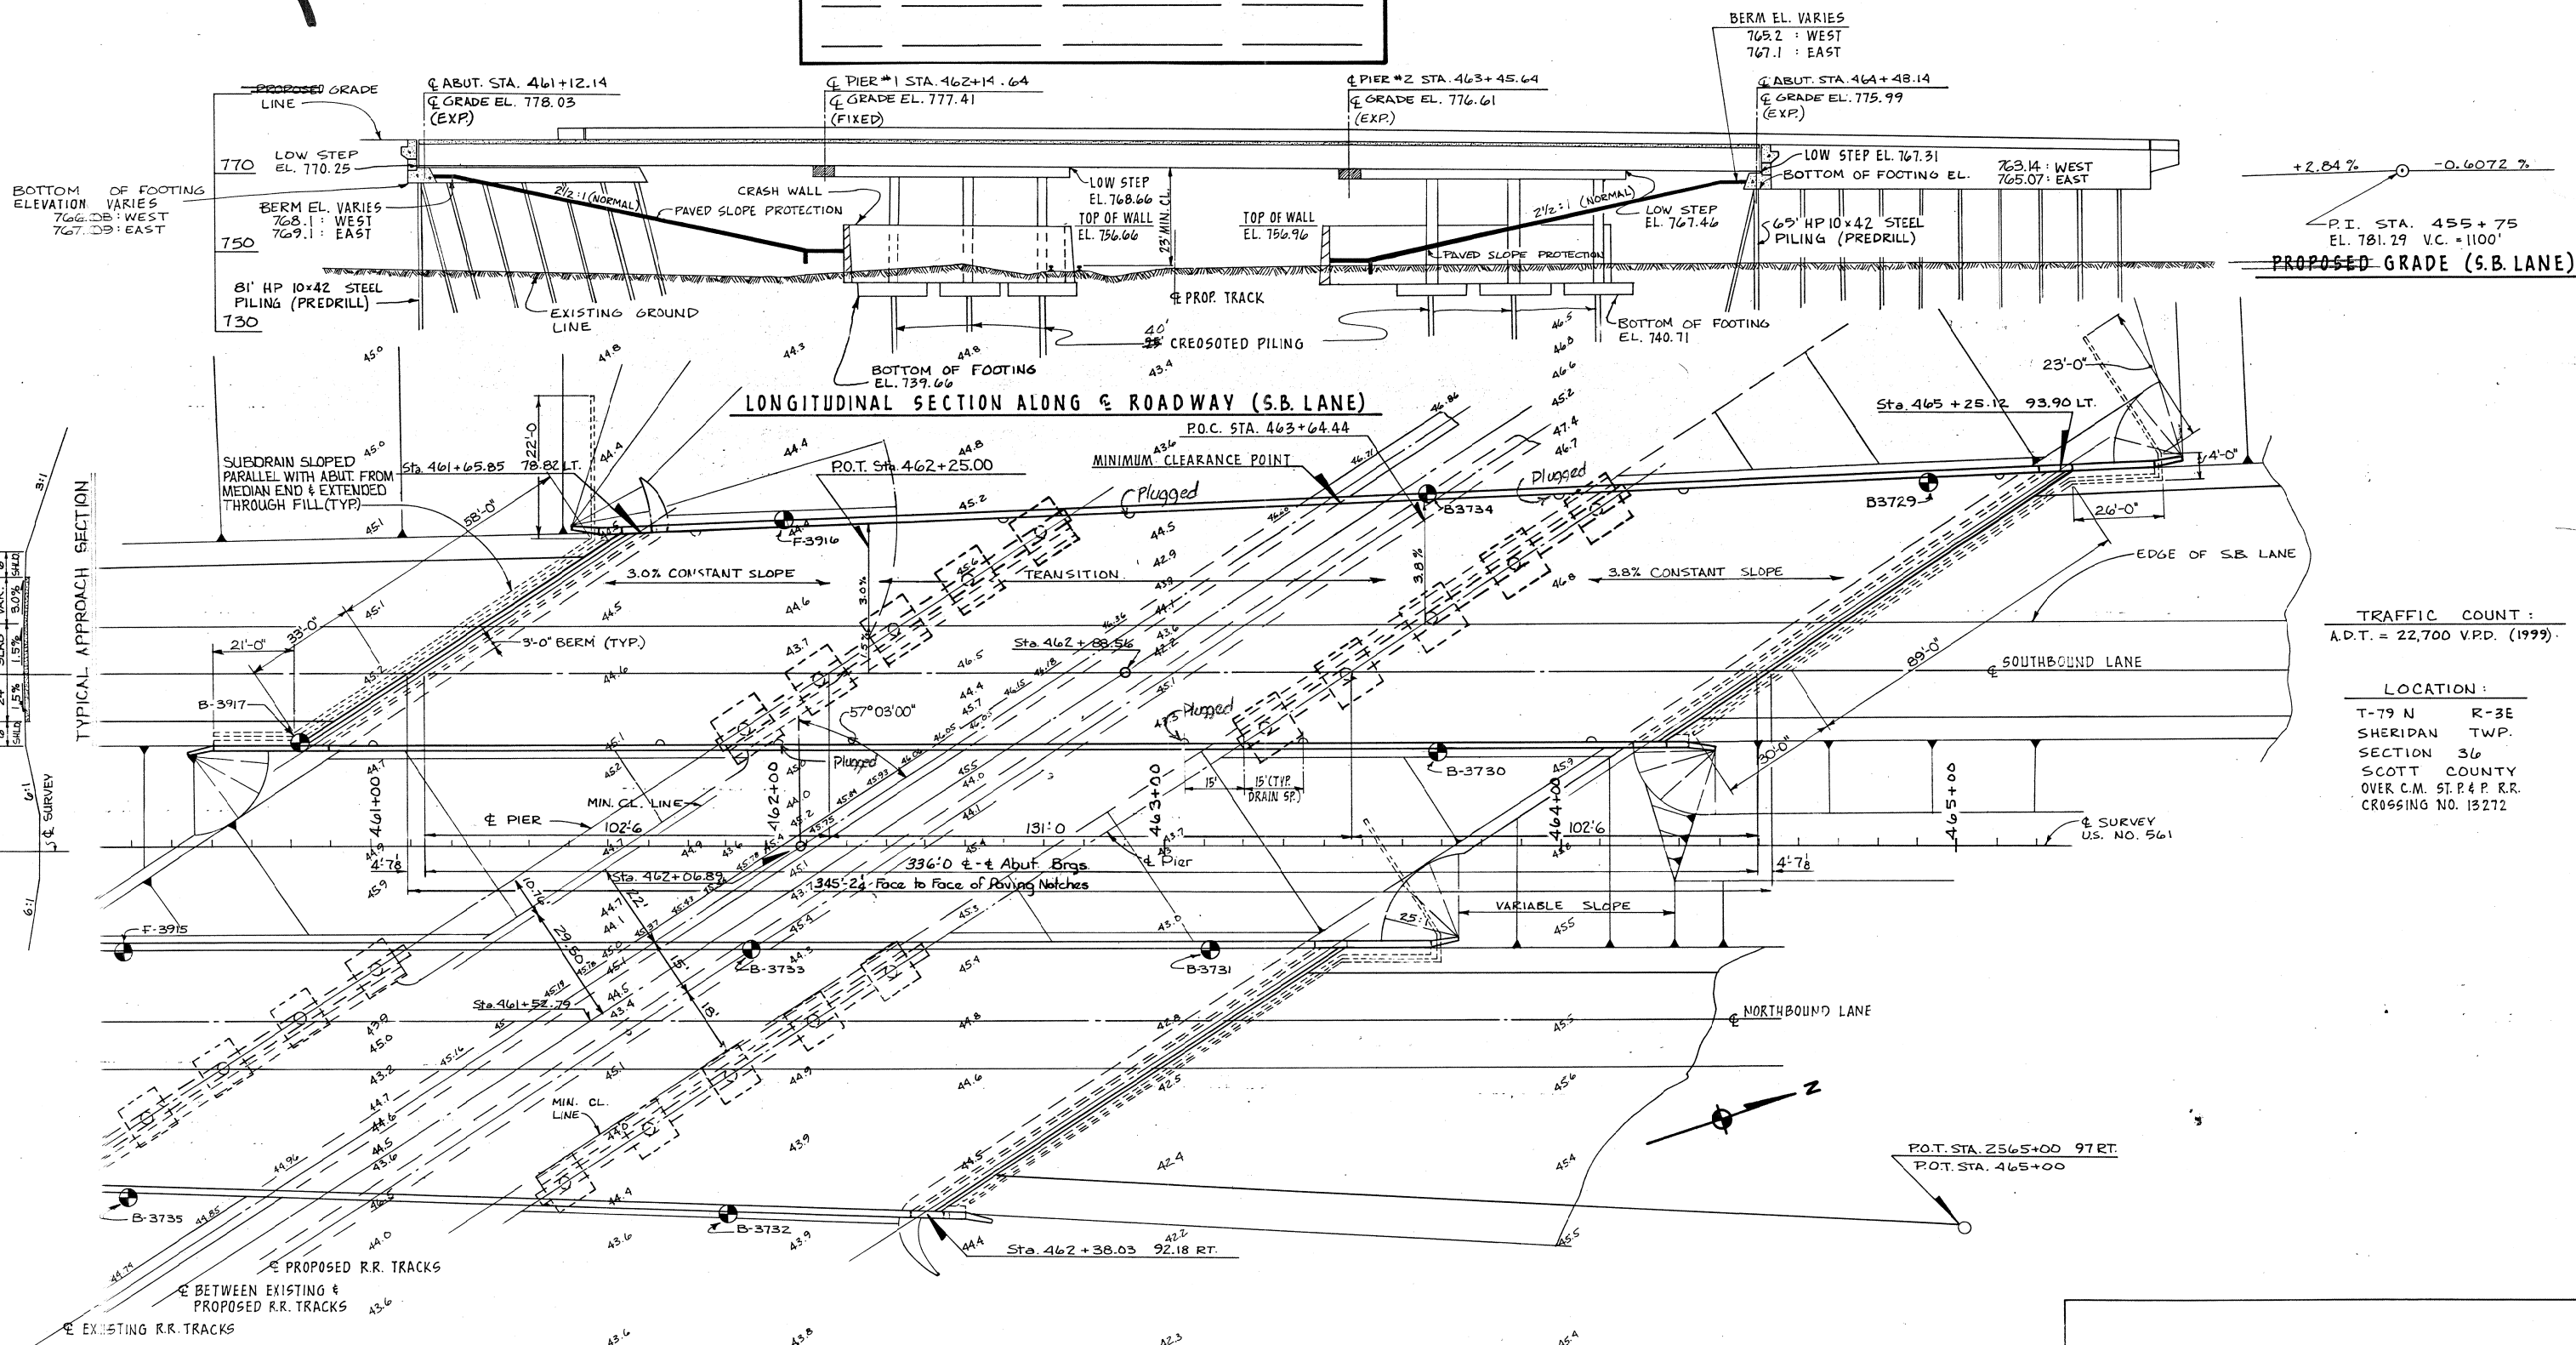


TRAFFIC COUNT:  
A.D.T. = 22,700 V.P.D. (1999)

LOCATION:  
T-79 N R-3E  
SHERIDAN TWP.  
SECTION 36  
SCOTT COUNTY  
OVER C.M. ST. P. & P. R.R.  
CROSSING NO. 13272

### SITUATION PLAN

I HEREBY CERTIFY THAT THESE PLANS AND SPECIFICATIONS  
WERE PREPARED BY ME OR UNDER MY DIRECT SUPERVISION  
AND THAT I AM A DULY REGISTERED PROFESSIONAL ENGINEER  
UNDER THE LAWS OF THE STATE OF IOWA

*Richard E. Witter*  
DATE FEB. 26, 1979 REGIST. NO. 3810


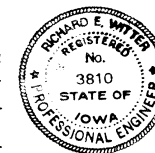


DESIGN FOR 57°03'00" SKEW  
336'-0" X VARI. CONTINUOUS  
WELDED PLATE GIRDER BRIDGE  
102'-6" END SPANS 131'-0" INTERIOR SPAN  
SITUATION PLAN  
STATION: 462+88.56 (± S.B. LANE, U.S. NO. 561) NOV. 1978  
SCOTT COUNTY  
IOWA DEPARTMENT OF TRANSPORTATION-HIGHWAY DIVISION  
DESIGN SHEET NO. 1 OF 29 FILE NO. 25588 DESIGN NO. 980

STATE	FED. ROAD DIST. NO.	FISCAL YEAR	SHEET NO.	TOTAL SHEETS
IOWA	5		33	125

W. Eyer



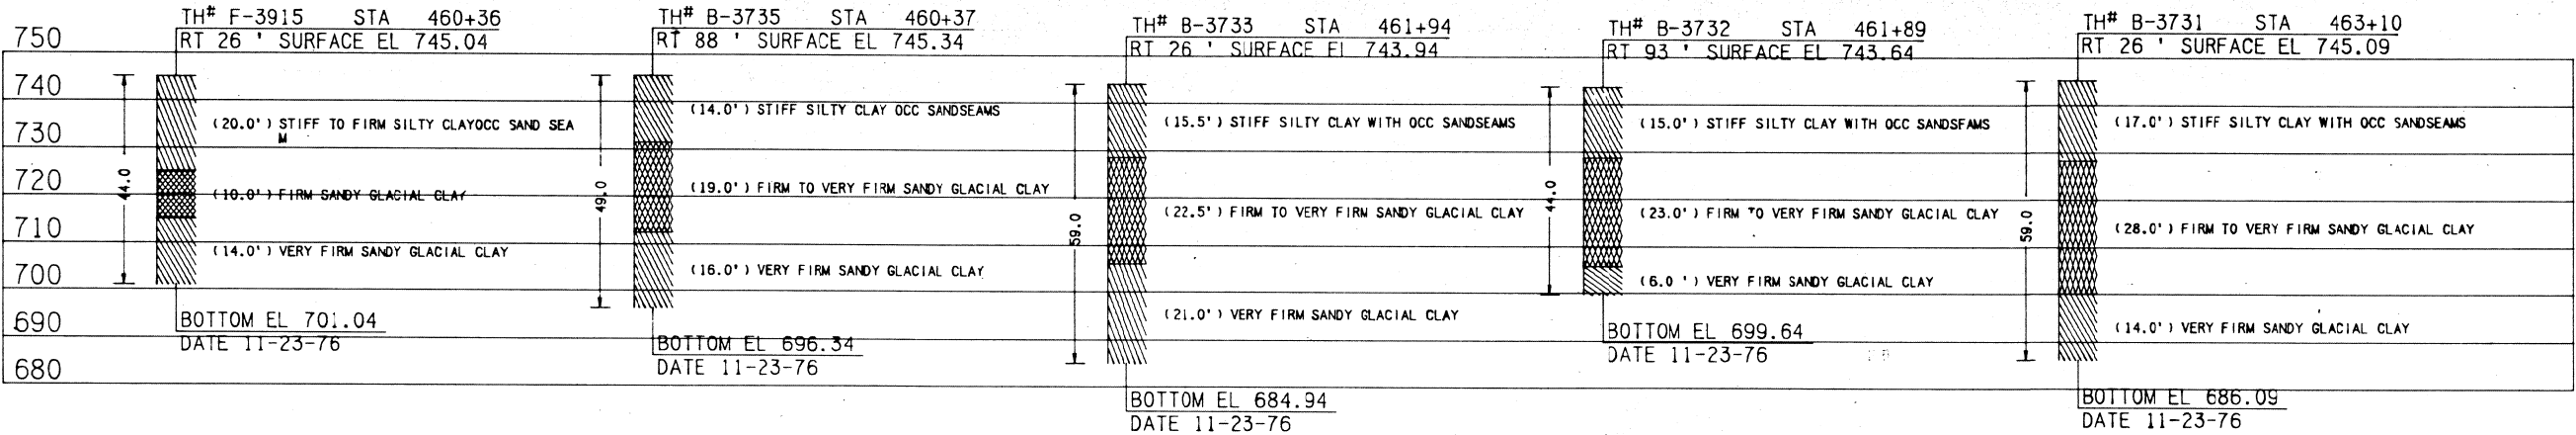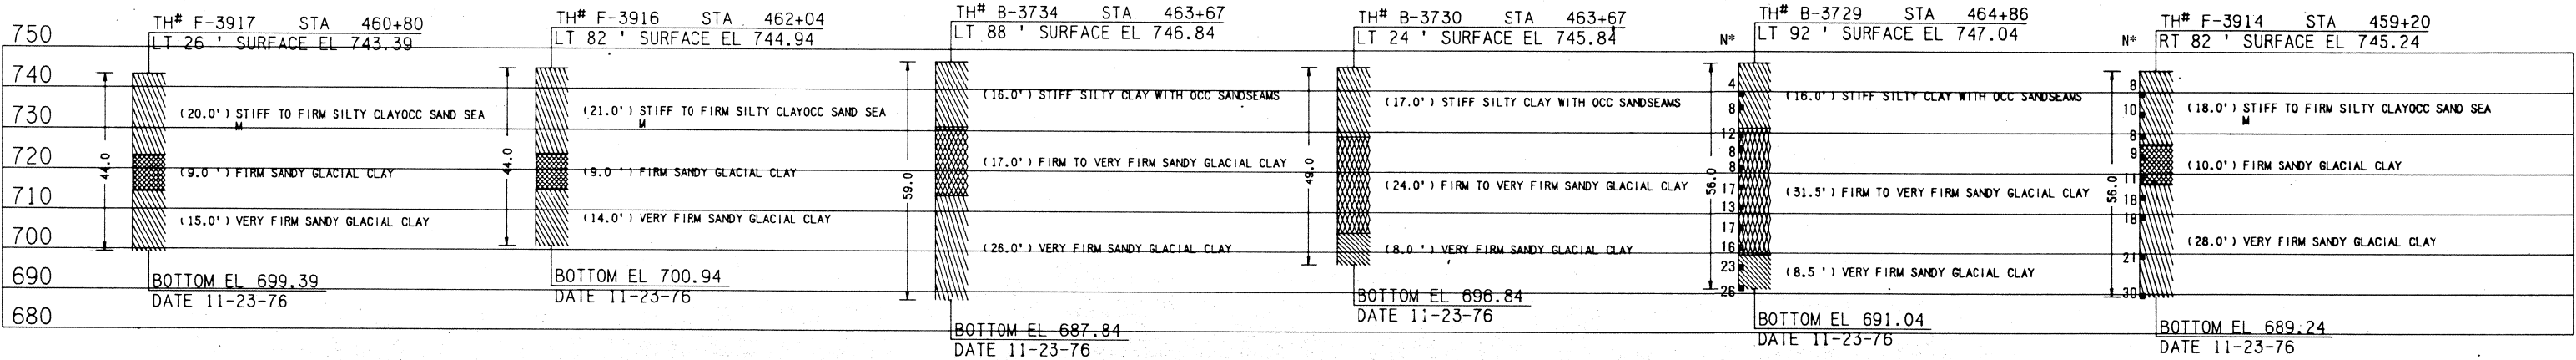

SOUNDING DATA  
N# = NUMBER OF BLOWS PER FOOT OF PENETRATION

GENERAL NOTES:

THIS BRIDGE IS DESIGNED FOR HS20-44 LOADING, PLUS 20 LBS. PER SQUARE FOOT OF ROADWAY FOR FUTURE WEARING SURFACE. THE BRIDGE CONTRACTOR IS TO INSTALL SUBDRAINS BEHIND EACH ABUTMENT AS DETAILED. THE SUBDRAIN MAY BE EITHER DRAIN TILE OR PERFORATED PLASTIC PIPE WITH A MINIMUM NOMINAL DIAMETER OF 4" AND A MAXIMUM NOMINAL DIAMETER OF 6". THE PRICE BID FOR "SUBDRAIN" IS TO INCLUDE THE EXCAVATION NECESSARY FOR THE INSTALLATION. THE APPROACH FILLS AS SHOWN ARE NOT A PART OF THIS CONTRACT, BUT ARE TO BE IN PLACE BEFORE ABUTMENT PILES ARE DRIVEN. THE BRIDGE CONTRACTOR IS TO LEVEL OFF AND SHAPE THE BERMS TO THE ELEVATIONS AND DIMENSIONS SHOWN. DRESSING OF SLOPES OUTSIDE THE BRIDGE AREA NOT DISTURBED BY THE BRIDGE CONTRACTOR SHALL BE PAID FOR AS EXTRA WORK. ABUTMENT PILES ARE TO BE DRIVEN IN OVERSIZE HOLES DRILLED THROUGH THE FILL TO EL. 741.08 AT THE SOUTH ABUTMENT AND TO EL. 738.14 AT THE NORTH ABUTMENT. THE MINIMUM DIAMETER OF THE DRILLED HOLES IS TO BE 18 INCHES. THESE DRILLED HOLES ARE TO BE MAINTAINED OPEN DURING DRIVING OF THE PILES TO THE EXTENT THAT CASING OR DRILLING MUD MAY BE REQUIRED FOR COLLAPSING SOILS. IMMEDIATELY AFTER DRIVING A PILE, THE VOID AROUND THE PILE IS TO BE FILLED WITH LOOSE DRY SAND. ANY DRILLING MUD USED SHALL BE REMOVED FROM THE HOLE PRIOR TO PLACING THE SAND. PIER EXCAVATION IS BASED ON THE ASSUMPTION THAT THE APPROACH FILLS WILL HAVE BEEN COMPLETED PRIOR TO STARTING CONSTRUCTION OF THE PIERS. BRIDGE SEAT SEALER IS TO BE APPLIED TO ALL EXPOSED BRIDGE SEAT SURFACES AT THE ABUTMENTS. THE BRIDGE SEAT SURFACE IS TO INCLUDE ALL SURFACES OF THE BRIDGE SEAT STEPS, THE WASH BETWEEN STEPS AND THE EDGE FILLETS. THE SEALER IS TO EXTEND SIX INCHES UP THE FRONT FACE OF THE BACKWALL. THE SEALER IS ALSO TO BE APPLIED TO THE TOP OF THE BACKWALL. THE BRIDGE SEAT PROTECTIVE COATING SHALL BE AN APPROVED SEALER PER MATERIALS I.M. 491.12 AND APPLIED IN ACCORDANCE WITH THE MANUFACTURER'S RECOMMENDATIONS.

GUARD RAIL WILL BE PLACED BY OTHERS.

SPECIFICATIONS:

DESIGN: A.A.S.H.T.O. SERIES OF 1977.  
CONSTRUCTION: IOWA DEPARTMENT OF TRANSPORTATION STANDARD SPECIFICATIONS, SERIES OF 1977, WITH CURRENT SPECIAL PROVISIONS AND SUPPLEMENTAL SPECIFICATIONS.

DESIGN STRESSES:

DESIGN STRESSES FOR THE FOLLOWING MATERIALS ARE IN ACCORDANCE WITH A.A.S.H.T.O. STANDARD SPECIFICATIONS FOR HIGHWAY BRIDGES, SERIES OF 1977.  
CONCRETE IN ACCORDANCE WITH SECTION 1.5, f'c= 3,500 P.S.I.  
REINFORCING STEEL IN ACCORDANCE WITH SECTION 1.5, Grade 40 and Grade 60.  
STRUCTURAL STEEL IN ACCORDANCE WITH SECTION 1.7, ASTM A-36, Fatigue stress cycles based on Case II.

TOTAL ESTIMATED BRIDGE QUANTITIES						
ITEM NO.	ITEM	UNITS	2 ABUTS.	2 PIERS	1 SUPERSTR.	TOTAL
1	STRUCTURAL CONCRETE	CU. YDS.	293.5	630.5	556.8	1481.1
2	STRUCTURAL STEEL	LBS.	-	-	719,075	719,075
3	REINFORCING STEEL	LBS.	18,548	(18,535)	87,876	(218,793)
4	REINFORCING STEEL-EPOXY COATED	LBS.	12,404	(12,406)	108,459	(120,869)
5	CREOSOTED PILING	LIN. FT.	-	8,743	-	8,743
6	HP 10X42 STEEL	FURNISH	5,566	-	-	5,566
7	BEARING PILING	DRIVE	5,487.8	-	-	5,487.8
8	PREBORED HOLES	LIN. FT.	1800	-	-	1800
9	SUBDRAIN	LIN. FT.	306	-	-	306
10	BRIDGE SEAT SEALER	SQ. FT.	1,023	-	-	1,023
11	GRANULAR BACKFILL	CU. YDS.	520	-	-	520
12	CLASS 20 EXCAVATION	CU. YDS.	346	490	-	836
13	CONCRETE BARRIER RAIL	LIN. FT.	-	-	794.5	794.5
14	CONCRETE SLOPE PROTECTION	SQ. YDS.	-	-	-	-

ESTIMATE REFERENCE INFORMATION:

ITEM NO. 1: INCLUDES 924.3 CU. YDS. OF STRUCTURAL CONCRETE CLASS "C" FOR SUBSTRUCTURE AND 556.8 CU. YDS. OF STRUCTURAL CONCRETE, CLASS "D" FOR SUPERSTRUCTURE.  
ITEM NO. 2: INCLUDES 614 LBS. FOR LEAD PLATES & 1092 LBS. FOR DRAINS.

DESIGN FOR 57°03'00" SKEW  
336'-0" X VARI. CONTINUOUS  
WELDED PLATE GIRDER BRIDGE  
102'-6" END SPANS 131'-0" INTERIOR SPAN  
SOUNDING DATA & QUANTITIES  
STATION: 462 + 88.56 (S.B. LANE, U.S. NO. 561) NOV. 1978  
SCOTT COUNTY  
IOWA DEPARTMENT OF TRANSPORTATION-HIGHWAY DIVISION  
DESIGN SHEET NO. 2 OF 29 FILE NO. 25588 DESIGN NO. 980

Revised 3-6-81: Reinforcing Steel and Epoxy Coated Reinforcing Steel quantities changed and/or corrected.

SCOTT COUNTY

PROJECT NUMBER


STATE

FED. ROAD DIST. NO.

FISCAL YEAR


SHEET NO.

TOTAL SHEETS

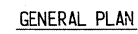


SCOTT COUNTY

PROJECT NUMBER	STATE	FED. ROAD DIST. NO.	FISCAL YEAR	SHEET NO.	TOTAL SHEETS
	IOWA	5		35	125

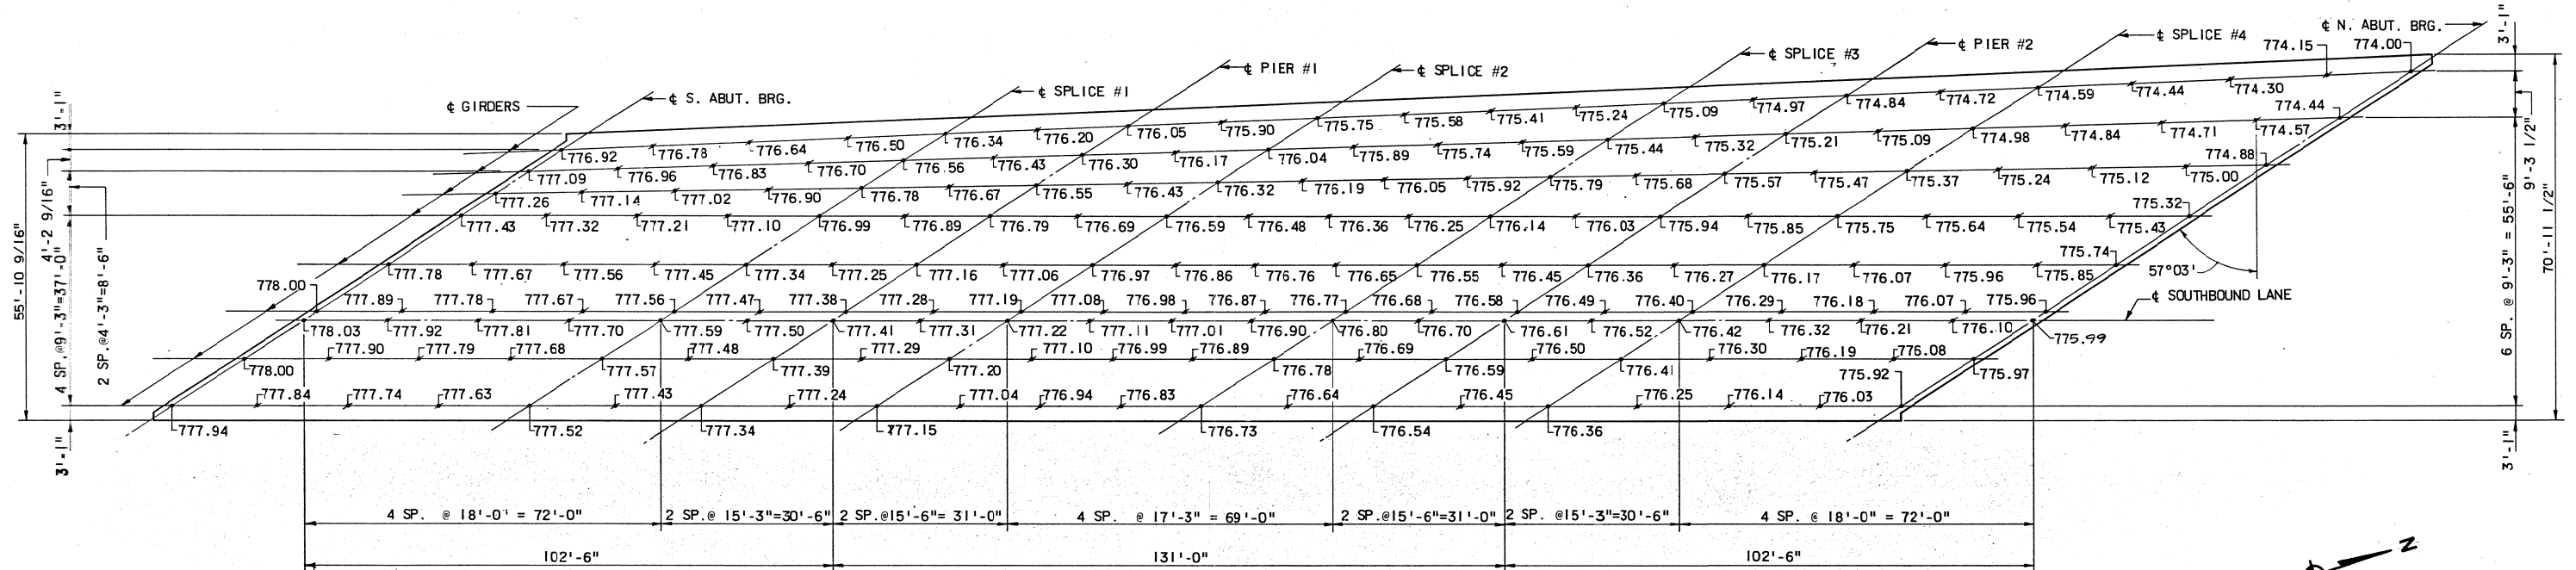

TOP OF SLAB ELEVATIONS

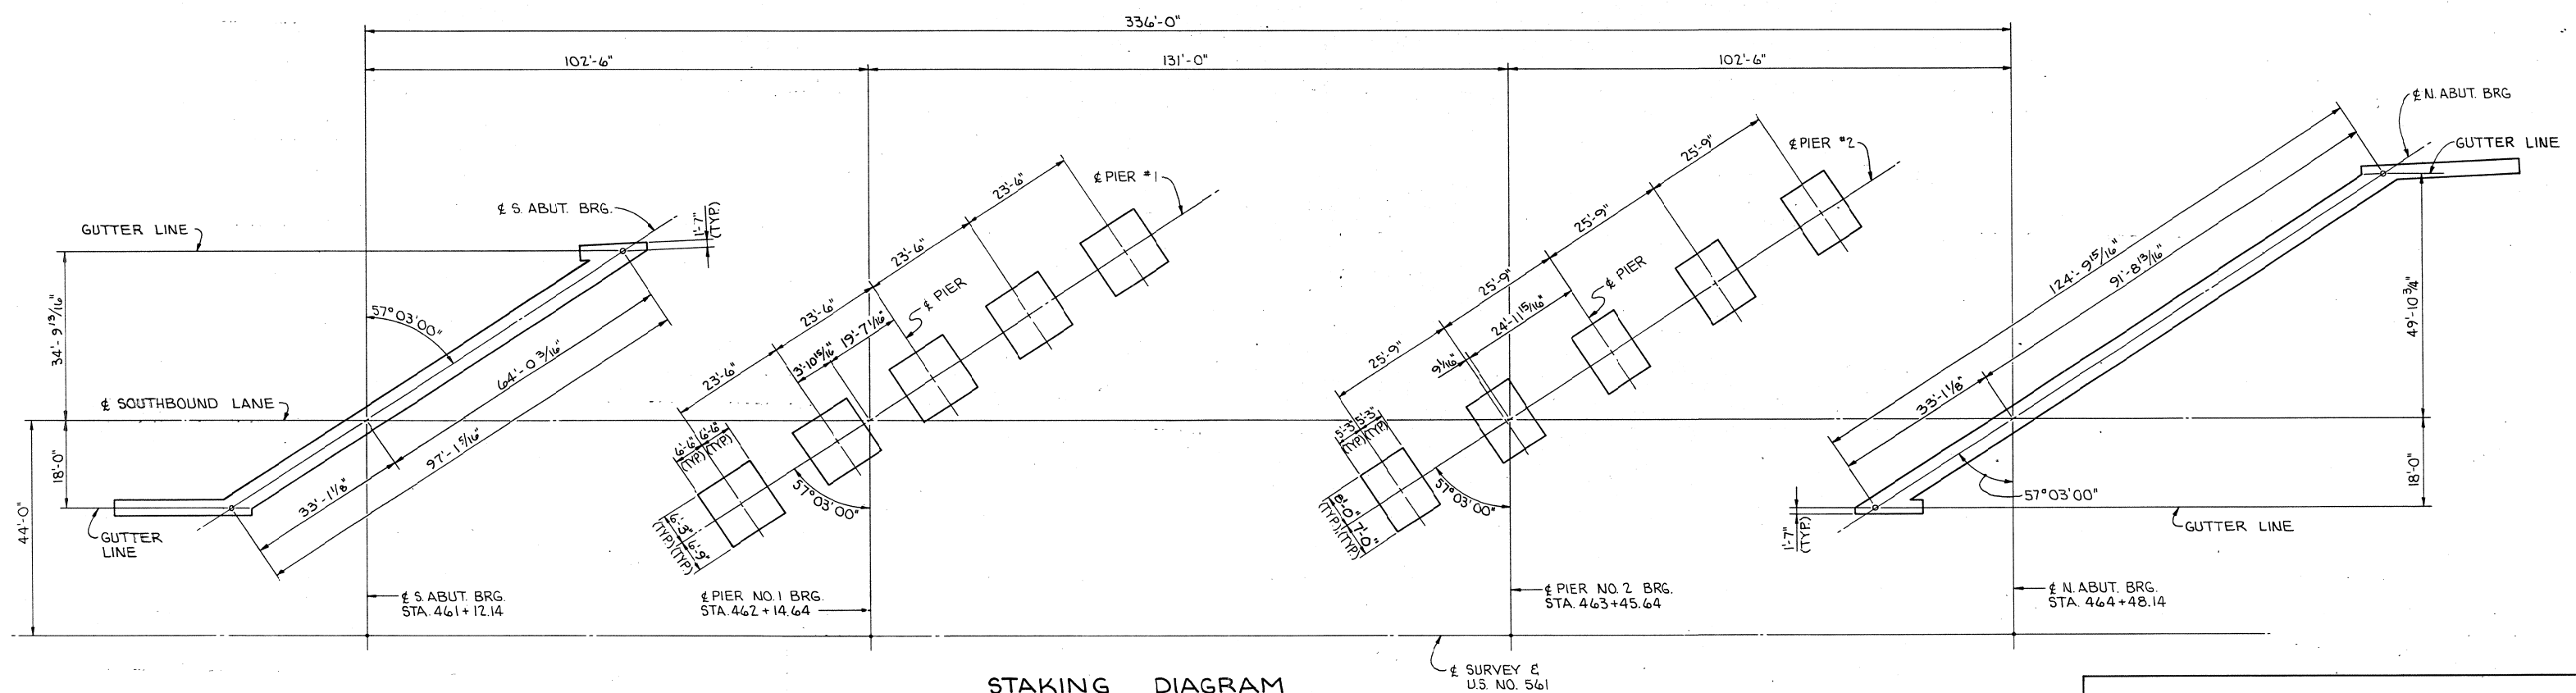

STAKING DIAGRAM

DESIGN FOR 57°03'00" SKEW  
336'-0" X VARI. CONTINUOUS  
WELDED PLATE GIRDER BRIDGE  
102'-6" END SPANS 131'-0" INTERIOR SPAN  
STAKING DIAGRAM & SLAB ELEVATIONS  
STATION: 462+88.56 (± S.B. LANE, U.S. NO. 561) NOV.1978  
SCOTT COUNTY  
IOWA DEPARTMENT OF TRANSPORTATION-HIGHWAY DIVISION  
DESIGN SHEET NO. 4 OF 29 FILE NO. 25588 DESIGN NO. 980


SCOTT COUNTY

PROJECT NUMBER


STATE	FED. ROAD DIST. NO.	FISCAL YEAR	SHEET NO.	TOTAL SHEETS
IOWA	5		36	125



BENCH MARK NO. 53 STA. 458+15-304 RT.  
R.R. SPK. W. SIDE PO. POLE AT R.R. TRACK  
EL. 743.13

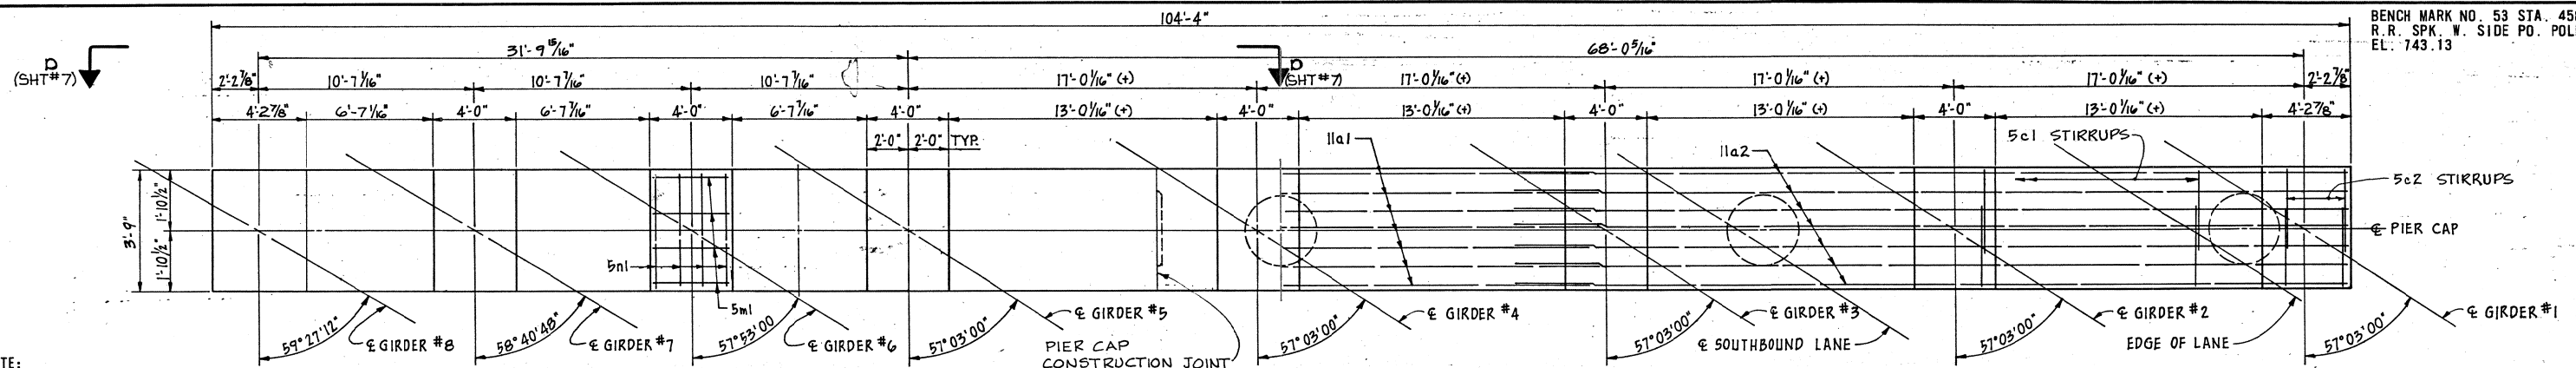


NOTE:  
PLACE 5m1 & 5n1 BARS  
UNDER EACH GIRDER.  
BEARING ASSEMBLIES FOR  
GIRDERS #6-#8 ARE TO BE  
SET TO THE SAME ANGLE  
AS GIRDERS #1-#5.

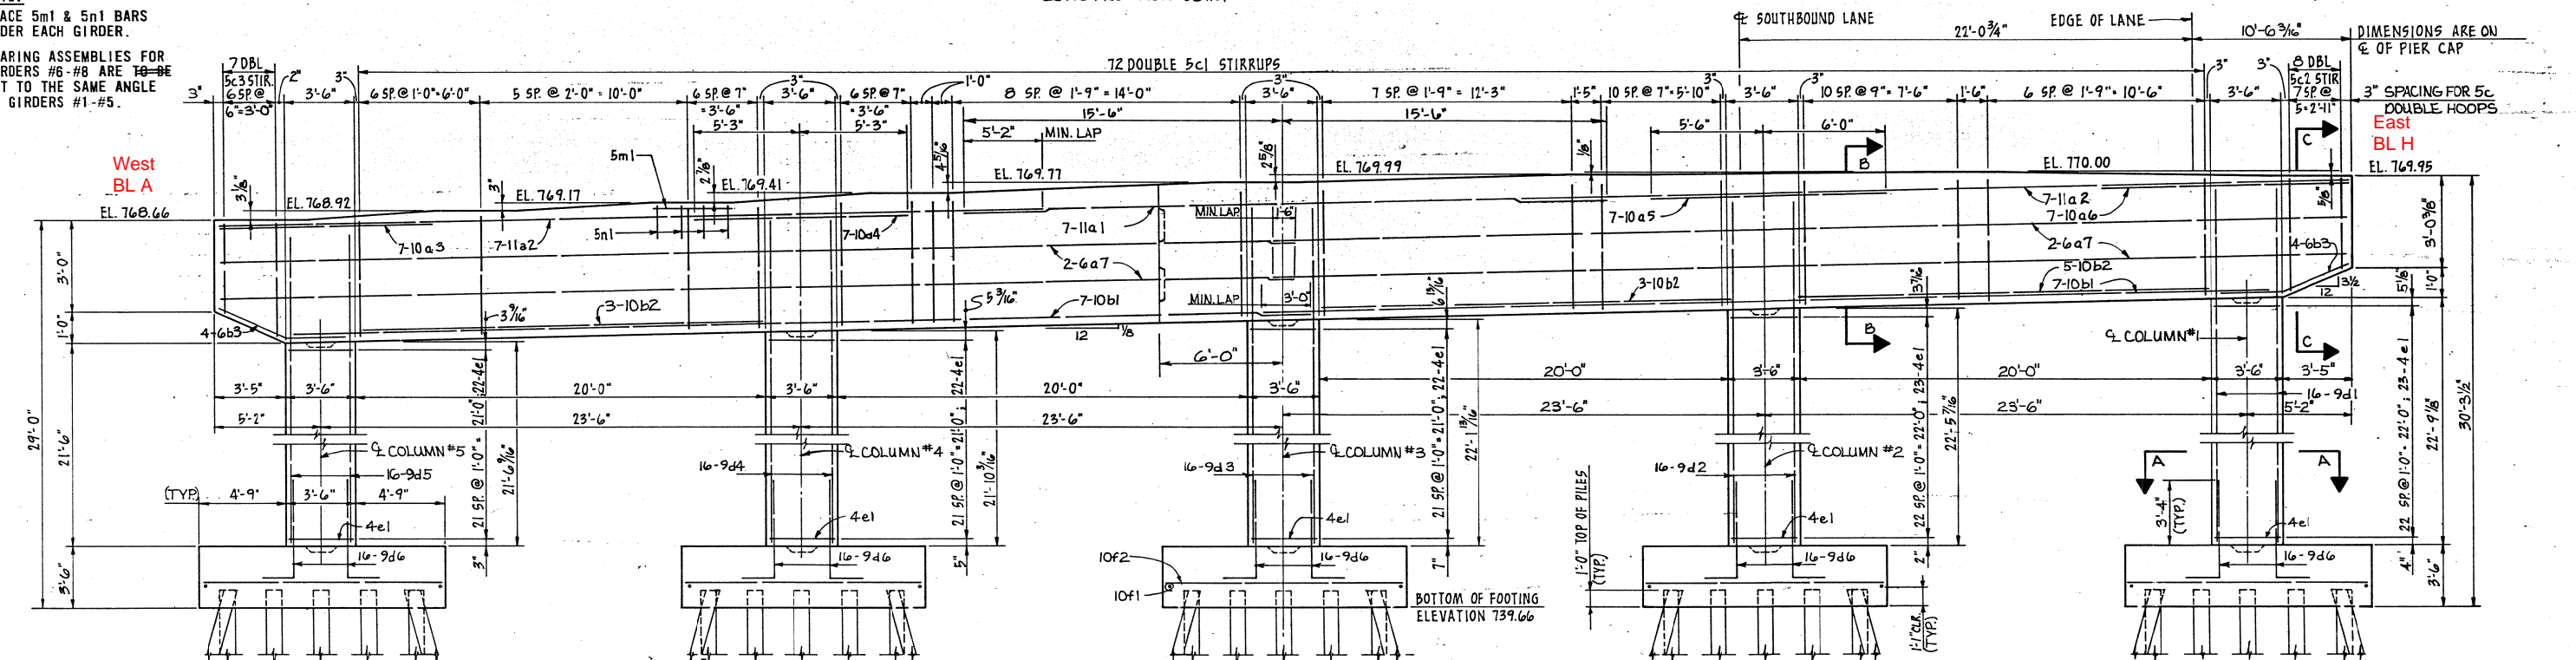


PIER ELEVATION  
(LOOKING NORTH)

NOTE:  
SEE SHEET #7 FOR CRASH WALL  
REINFORCING AND DETAILS.  
SEE SHEET #7 FOR PIER CAP  
CONSTRUCTION JOINT  
DETAILS.

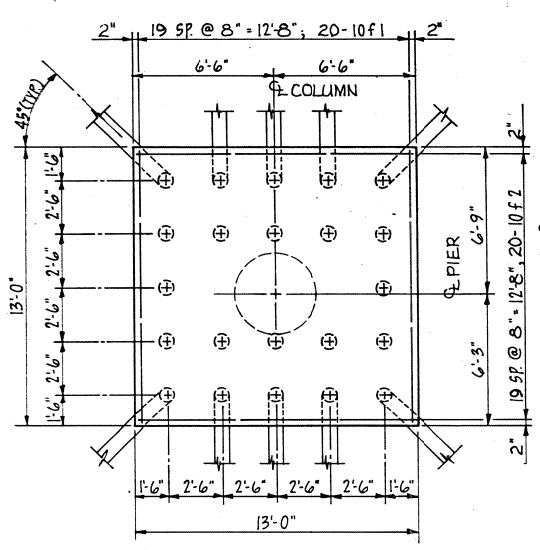


FOOTING PLAN


NOTE: ALL DIMENSIONS ARE AT BOTTOM OF FOOTING. BATTER  
PILES 1:4 IN DIRECTION INDICATED. 22 CREOSOTED  
PILING REQUIRED FOR EACH FOOTING.

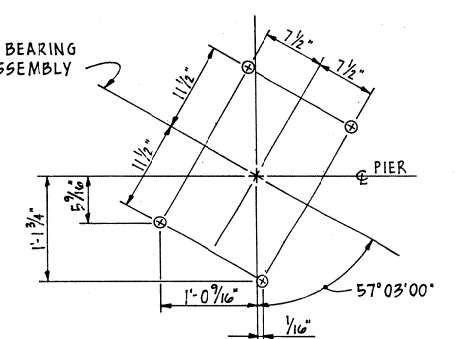


ANCHOR BOLT LOCATION  
(FIXED)  
1 1/2" Ø x 2'-0" SWEDGE ANCHOR BOLTS  
PROJECTION = 5"

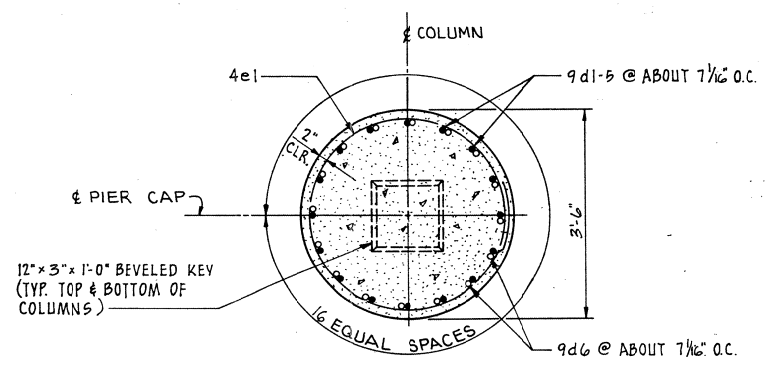

SECTION A-A

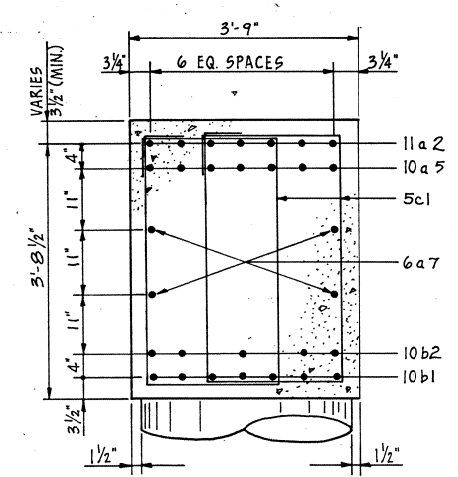

SECTION B-B

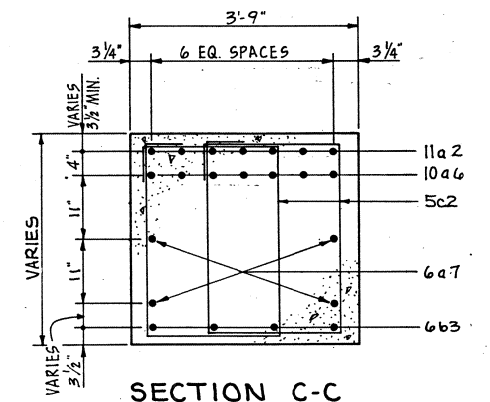


SECTION C-C


DESIGN FOR 57°03'00" SKEW  
336'-0" X VARI. CONTINUOUS  
WELDED PLATE GIRDER BRIDGE  
102'-6" END SPANS 131'-0" INTERIOR SPAN  
PIER NO. 1  
STATION: 462+88.56 (± S.B. LANE, U.S. NO. 561) NOV. 1978  
SCOTT COUNTY  
IOWA DEPARTMENT OF TRANSPORTATION-HIGHWAY DIVISION  
DESIGN SHEET NO. 5 OF 27 FILE NO. 25588 DESIGN NO. 980




7087-5

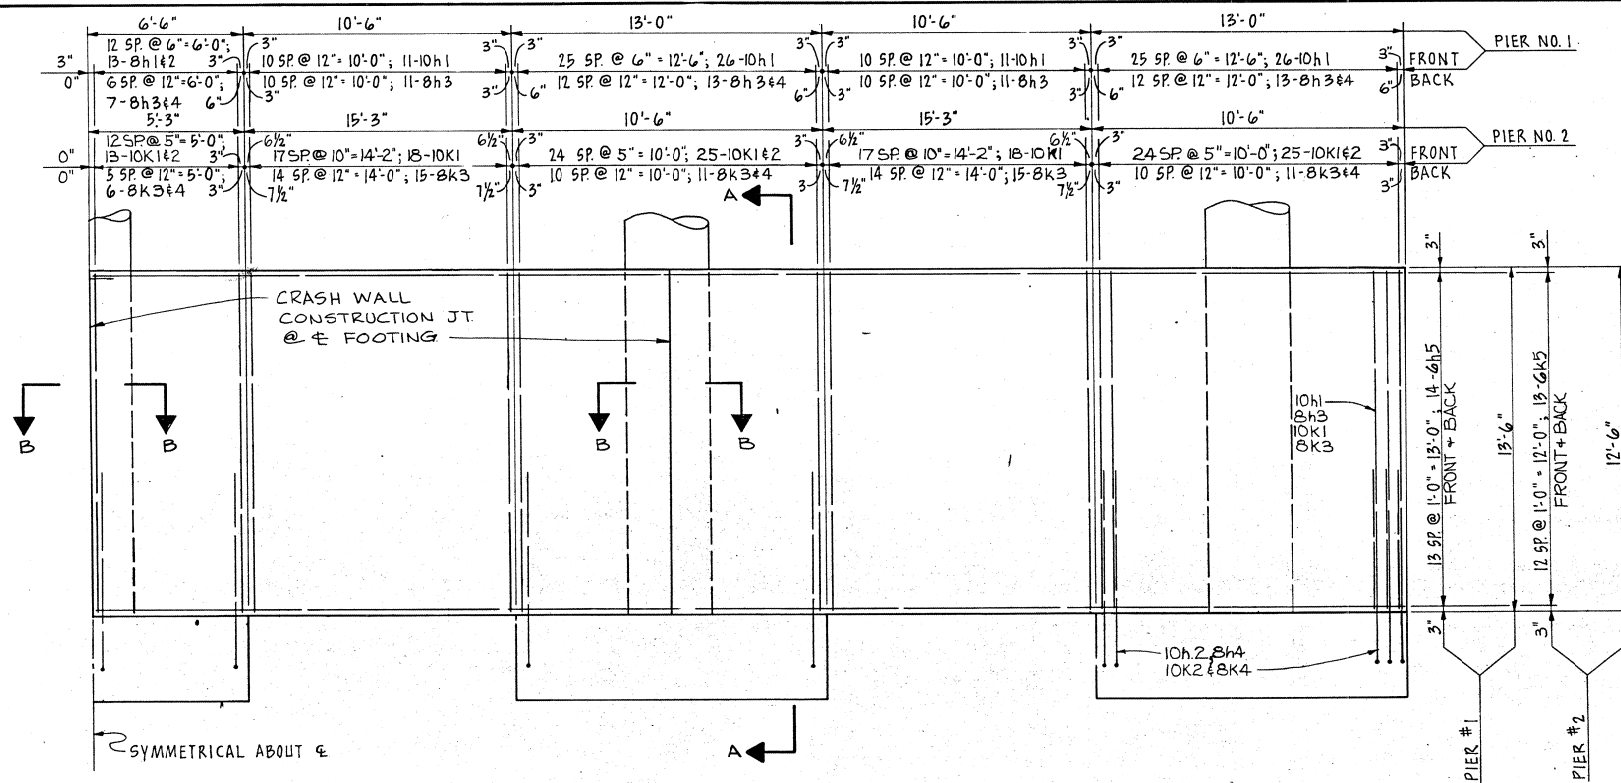

CRASH WALL ELEVATION  
(FRONT VIEW)  
SECTION D-D

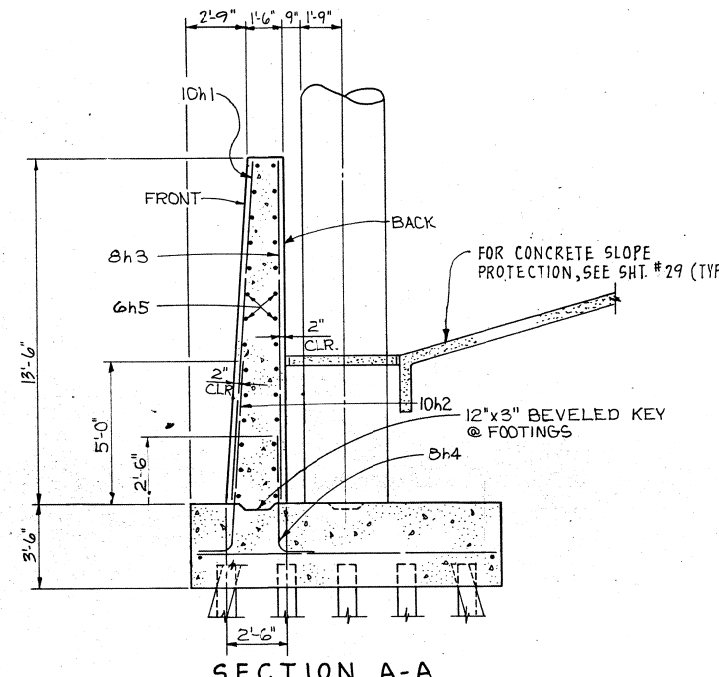

SECTION A-A  
PIER NO. 1

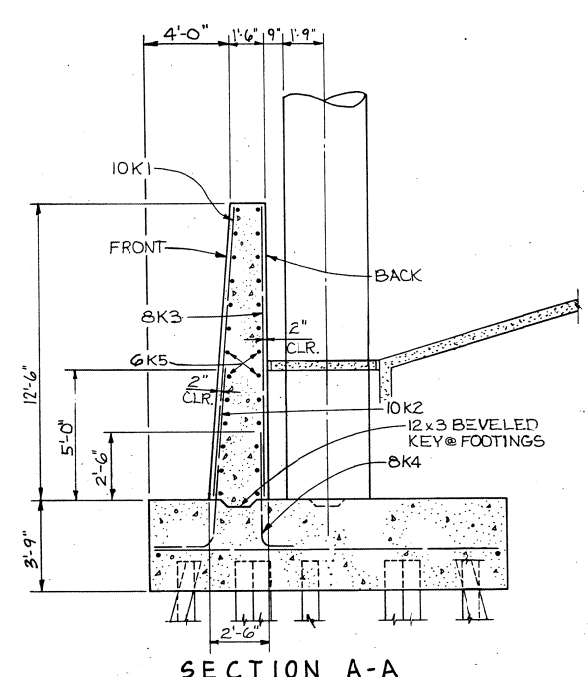

SECTION A-A  
PIER NO. 2

REINFORCING BAR LIST - PIER NO. 1					
BAR	LOCATION	SHAPE	NO.	LENGTH	WEIGHT
11a1	PIER CAP. TOP, LONGIT.	—	7	31'-0"	1153
11a2	PIER CAP. TOP, LONGIT.	—	14	41'-8"	3099
10a3	PIER CAP. TOP, LONGIT.	—	7	10'-6"	316
10a4	PIER CAP. TOP, LONGIT.	—	7	10'-6"	316
10a5	PIER CAP. TOP, LONGIT.	—	7	11'-8"	346
10a6	PIER CAP. TOP, LONGIT.	—	7	12'-0"	361
6a7	PIER CAP. SIDES, LONGIT.	—	8	52'-9"	634
10b1	PIER CAP. BOT. LONGIT.	—	14	50'-0"	3027
10b2	PIER CAP. BOT. LONGIT.	—	11	20'-1"	947
6b3	PIER CAP. CANTILEVER	—	8	5'-7"	67
5c1	PIER CAP. HOOPS	□	144	12'-6"	1377
5c2	PIER CAP. HOOPS, CANT.	□	16	11'-5"	191
5c3	PIER CAP. HOOPS, CANT.	□	14	11'-6"	168
9d1	COLUMN #1 VERTICAL	—	16	25'-9"	1401
9d2	COLUMN #2 VERTICAL	—	16	25'-6"	1387
9d3	COLUMN #3 VERTICAL	—	16	25'-2"	1369
9d4	COLUMN #4 VERTICAL	—	16	24'-11"	1355
9d5	COLUMN #5 VERTICAL	—	16	24'-7"	1337
9d6	COLUMNS TO FTGS., DOWELS	⌋	80	6'-5"	1768
4e1	COLUMN HOOPS	○	112	10'-10"	811
10f1	FOOTINGS, TRANSVERSE	—	100	12'-8"	5450
10f2	FOOTINGS, LONGITUDINAL	—	100	12'-8"	5450
10h1	CRASH WALL, VERTICAL	—	174	13'-2"	9858
10h2	WALL TO FTG., DOWELS	⌋	130	8'-2"	4568
8h3	CRASH WALL, VERTICAL	—	109	13'-2"	3832
8h4	WALL TO FTGS., DOWELS	⌋	65	5'-3"	911
6h5	CRASH WALL, HORIZONTAL	—	56	54'-0"	4542
5m1	BEAM STEPS, LONGITUDINAL	—	32	3'-8"	122
5n1	BEAM STEPS, TRANSVERSE	⌋	32	5'-5"	192
TOTAL (LBS.)				56,855	

REINFORCING BAR LIST - PIER NO. 2					
BAR	LOCATION	SHAPE	NO.	LENGTH	WEIGHT
11a1	PIER CAP. TOP, LONGIT.	—	7	32'-0"	1190
11a2	PIER CAP. TOP, LONGIT.	—	14	46'-8"	3471
11a3	PIER CAP. TOP, LONGIT.	—	14	13'-6"	1004
11a4	PIER CAP. TOP, LONGIT.	—	7	13'-0"	483
11a5	PIER CAP. TOP, LONGIT.	—	14	12'-3"	911
6a6	PIER CAP. SIDES, LONGIT.	—	12	39'-4"	709
11b1	PIER CAP. BOT. LONGIT.	—	12	54'-9"	3491
11b2	PIER CAP. BOT. LONGIT.	—	18	22'-3"	2128
6b4	PIER CAP. CANTILEVER	—	8	6'-7"	79
5c1	PIER CAP. HOOPS	□	156	12'-6"	2034
5c4	PIER CAP. HOOPS, CANT.	□	22	11'-6"	264
5c5	PIER CAP. HOOPS, CANT.	□	18	11'-7"	217
9d1	COLUMN #1 VERTICAL	—	19	23'-8"	1107
9d2	COLUMN #2 VERTICAL	—	14	23'-3"	1107
9d3	COLUMN #3 VERTICAL	—	14	22'-6"	1071
9d4	COLUMN #4 VERTICAL	—	14	22'-1"	1071
9d7	COLUMNS TO FTGS., DOWELS	⌋	80	6'-9"	1836
4e1	COLUMN HOOPS	○	100	10'-10"	724
10f1	FOOTINGS, TRANSVERSE	—	80	14'-8"	5049
9f2	FOOTINGS, LONGITUDINAL	—	75	10'-2"	2593
10k1	CRASH WALL, VERTICAL	—	197	12'-2"	10,314
10k2	WALL TO FTG., DOWELS	⌋	125	8'-5"	4527
8k3	CRASH WALL, VERTICAL	—	115	12'-2"	3736
8k4	WALL TO FTG., DOWELS	⌋	55	5'-6"	808
6k5	CRASH WALL, HORIZONTAL	—	52	57'-3"	4471
5m1	BEAM STEPS, LONGITUDINAL	—	32	3'-8"	122
5n1	BEAM STEPS, TRANSVERSE	⌋	32	5'-9"	192
TOTAL (LBS.)				56,574	

NOTE: CONTRACTOR HAS THE OPTION TO SPLICE BARS OVER 40'-0" LONG ANY SPLICE LOCATIONS WERE TO BE APPROVED BY THE ENGINEER. PAYMENT FOR REINFORCING BARS SHALL BE BASED ON NO SPLICES AND NO ALLOWANCE SHALL BE MADE FOR THE ADDITIONAL LENGTH OF BAR REQUIRED FOR THE USE OF SPLICES.




CONCRETE PLACEMENT QUANTITIES

LOCATION	PIER NO. 1	PIER NO. 2
PIER CAP	61.8	69.3
COLUMN NO. 1	8.1	7.4
COLUMN NO. 2	8.0	7.2
COLUMN NO. 3	7.9	7.1
COLUMN NO. 4	7.8	6.9
COLUMN NO. 5	7.7	6.8
PIER FOOTINGS	106.3	106.4
CRASH WALL	107	105.1
TOTAL (C.Y.)	314.6	316.2

FINAL TOTAL ESTIMATED QUANTITIES

ITEM	UNIT	PIER NO. 1	PIER NO. 2	TOTAL
STRUCTURAL CONCRETE CLASS "C"	C.Y.	314.6	316.2	630.8
REINFORCING STEEL	LBS.	56,855	56,574	113,429
CRESOTED PILING	L.F.	140	100	240
CLASS 20 EXCAVATION	C.Y.	264	226	490

BENT BAR DETAILS

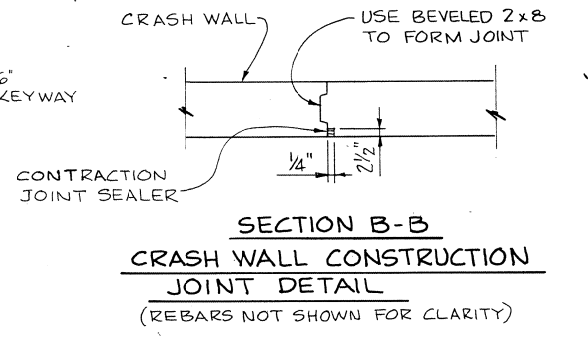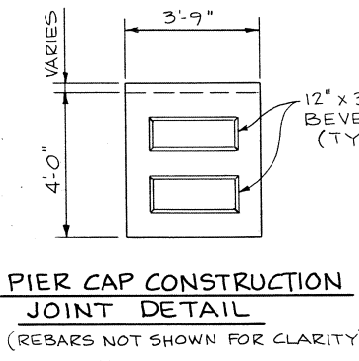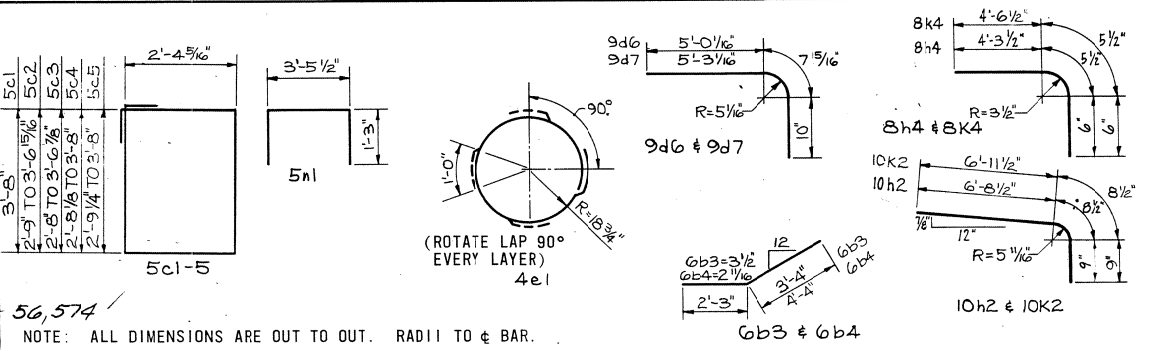


PIER NOTES:  
MINIMUM CLEAR DISTANCE FROM FACE OF CONCRETE TO NEAR REINFORCING BAR IS 2" UNLESS OTHERWISE NOTED OR SHOWN.  
ALL EXPOSED CORNERS 90° OR SHARPER ARE TO BE FILLETED WITH A 3/4" DRESSED AND BEVELED STRIP.  
REINFORCING STEEL IS TO BE SECURELY WIRED IN PLACE BEFORE CONCRETE WAS POURED.  
PILES ARE TO BE DRIVEN TO FULL PENETRATION IF PRACTICABLE, BUT NOT LESS THAN 20 TONS NOR MORE THAN 40 TONS BEARING VALUE PER PILE.  
ANCHOR BOLTS ARE TO BE PRESET IN PIERS IN ACCORDANCE WITH THE STANDARD SPECIFICATIONS. THE WEIGHT OF ANCHOR BOLTS IS INCLUDED IN THE STRUCTURAL STEEL QUANTITIES.



Revised 05-16-81. Reinforcing Bar List- Pier No. 2 changed. Total Estimated Quantities changed.

DESIGN FOR 57°03'00" SKEW  
336'-0" X VARI. CONTINUOUS  
WELDED PLATE GIRDER BRIDGE  
102'-6" END SPANS 131'-0" INTERIOR SPAN  
PIER DETAILS  
STATION: 462+88.56 (± S.B. LANE, U.S. NO. 561) NOV. 1978  
SCOTT COUNTY  
IOWA DEPARTMENT OF TRANSPORTATION-HIGHWAY DIVISION  
DESIGN SHEET NO. 7 OF 28 FILE NO. 25588 DESIGN NO. 980



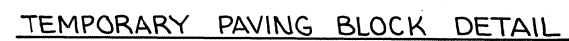

FOR CONSTRUCTION JOINT  
DETAIL SEE SHEET 12 ~

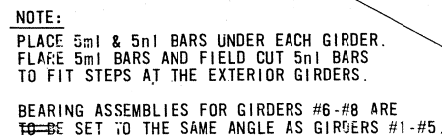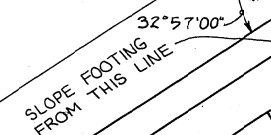


PLAN VIEW

EPOXY COATING NOTE

-The following portions of each abutment <sup>did</sup> ~~shall~~ have epoxy coated reinforcing steel:


- \*1. Top surface under bridge seat and batter face of main footing.
- \*2. Front face of backwall.
- \*3. Steps under masonry plates.
- \*4. Maskwalls.

Parentetical numbers associated with reinforcing bar designations are reference keys to notes above. See Design Sheet 10 for tabulation of bars to be epoxy coated.

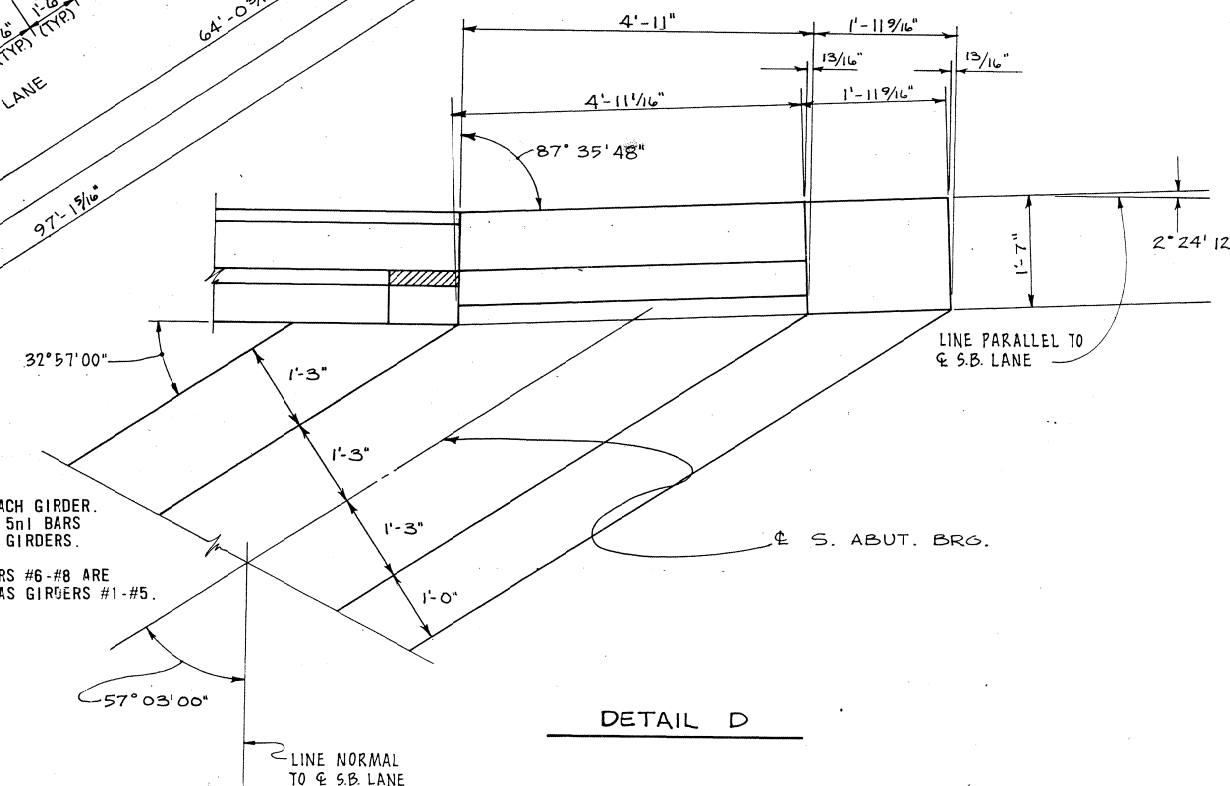


DETAIL D

DESIGN FOR 57'03.00" SKEW  
336'-0" X VARI. CONTINUOUS  
WELDED PLATE GIRDER BRIDGE  
102'-6" END SPANS 131'-0" INTERIOR SPAN  
SOUTH ABUTMENT  
STATION: 462+88.56 (E S.B. LANE, U.S. NO. 561) NOV. 1978  
SCOTT COUNTY  
IOWA DEPARTMENT OF TRANSPORTATION-HIGHWAY DIVISION  
DESIGN SHEET NO. B OF 29 FILE NO. 25588 DESIGN NO. 980

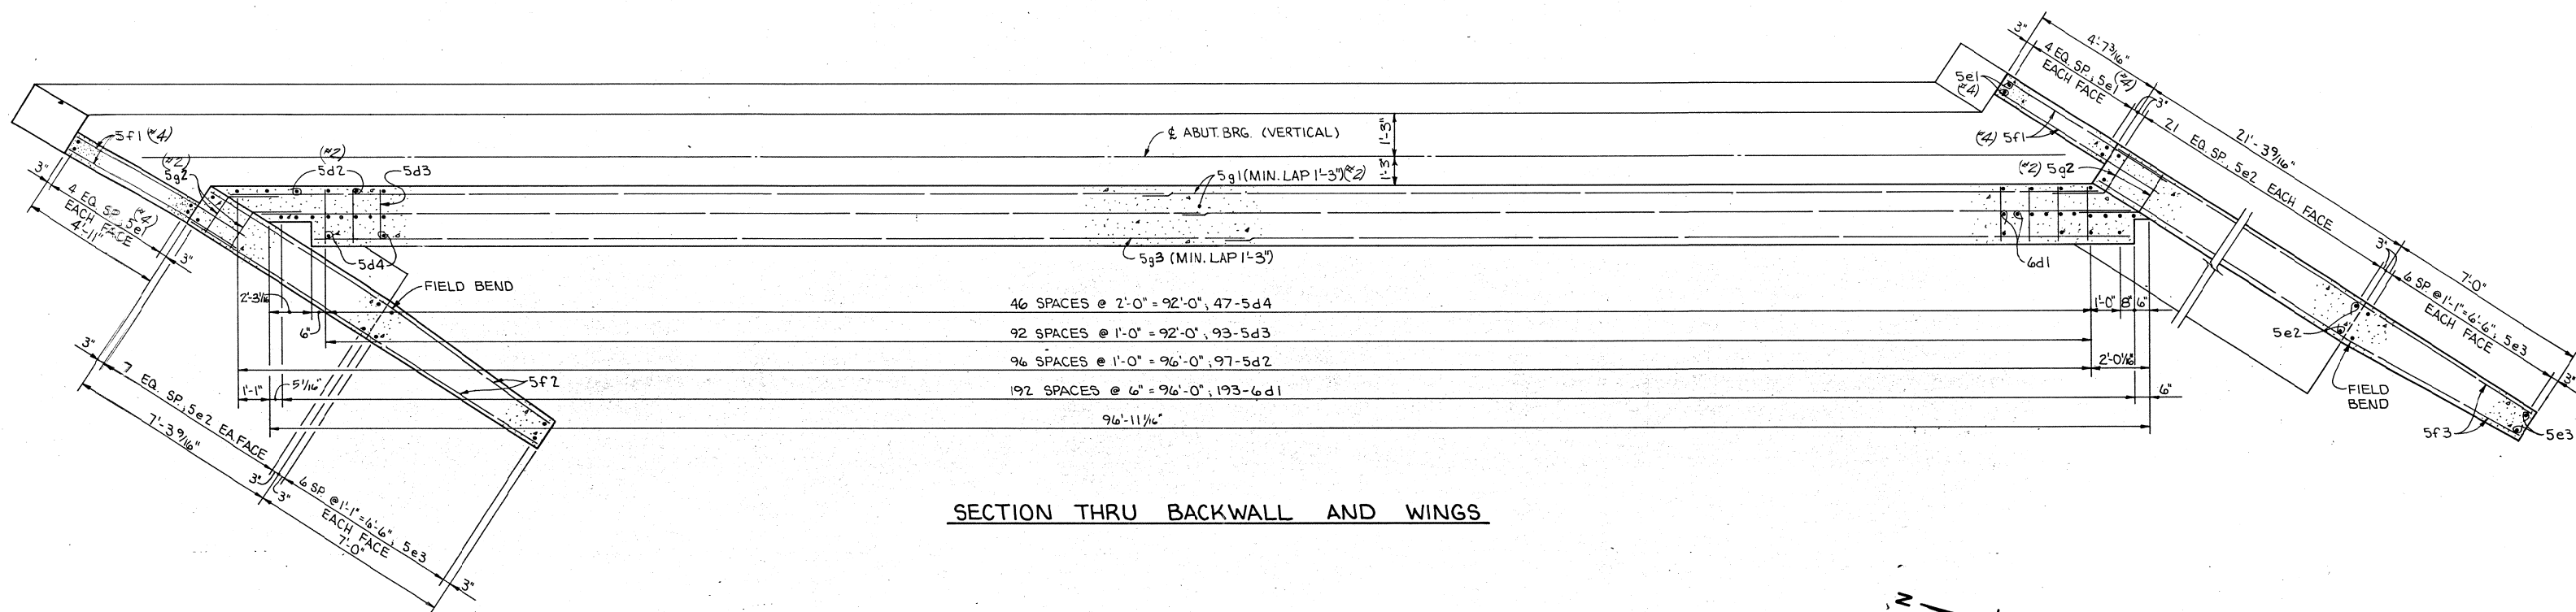


SECTION THRU BACKWALL AND WINGS

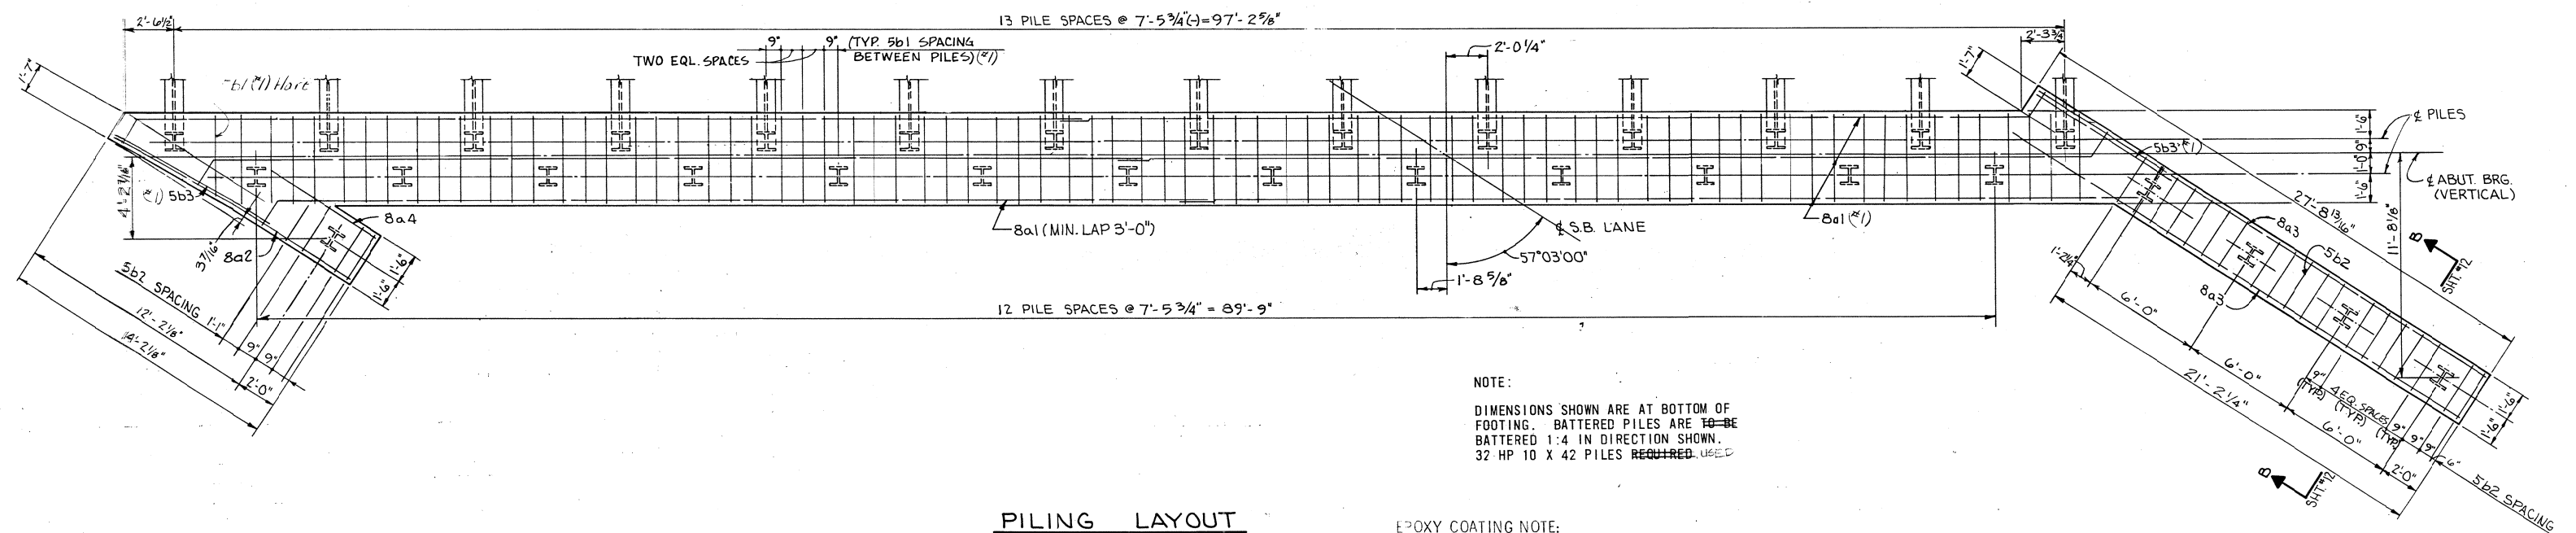


NOTE:  
DIMENSIONS SHOWN ARE AT BOTTOM OF  
FOOTING. BATTERED PILES ARE TO BE  
BATTERED 1:4 IN DIRECTION SHOWN.  
32 HP 10 X 42 PILES REQUIRED.

EPOXY COATING NOTE:  
Certain reinforcing bars are to be epoxy coated. Parenthet-  
ical numbers associated with re-bar designations are reference  
to notes on Design Sheet 8.


DESIGN FOR 57°03'00" SKEW  
336'-0" X VARI. CONTINUOUS  
WELDED PLATE GIRDER BRIDGE  
102'-6" END SPANS 131'-0" INTERIOR SPAN  
SOUTH ABUTMENT  
STATION: 462+88.56 (± S.B. LANE, U.S. NO. 561) NOV. 1978  
SCOTT COUNTY  
IOWA DEPARTMENT OF TRANSPORTATION-HIGHWAY DIVISION  
DESIGN SHEET NO. 9 OF 29 FILE NO. 25588 DESIGN NO. 980

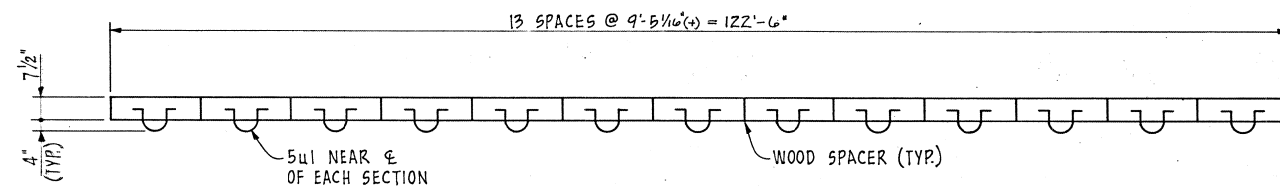

TEMPORARY PAVING BLOCK DETAIL

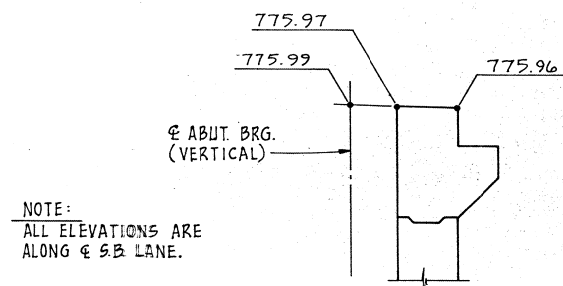

DETAIL C  
(SEE DESIGN SHEET # 12)

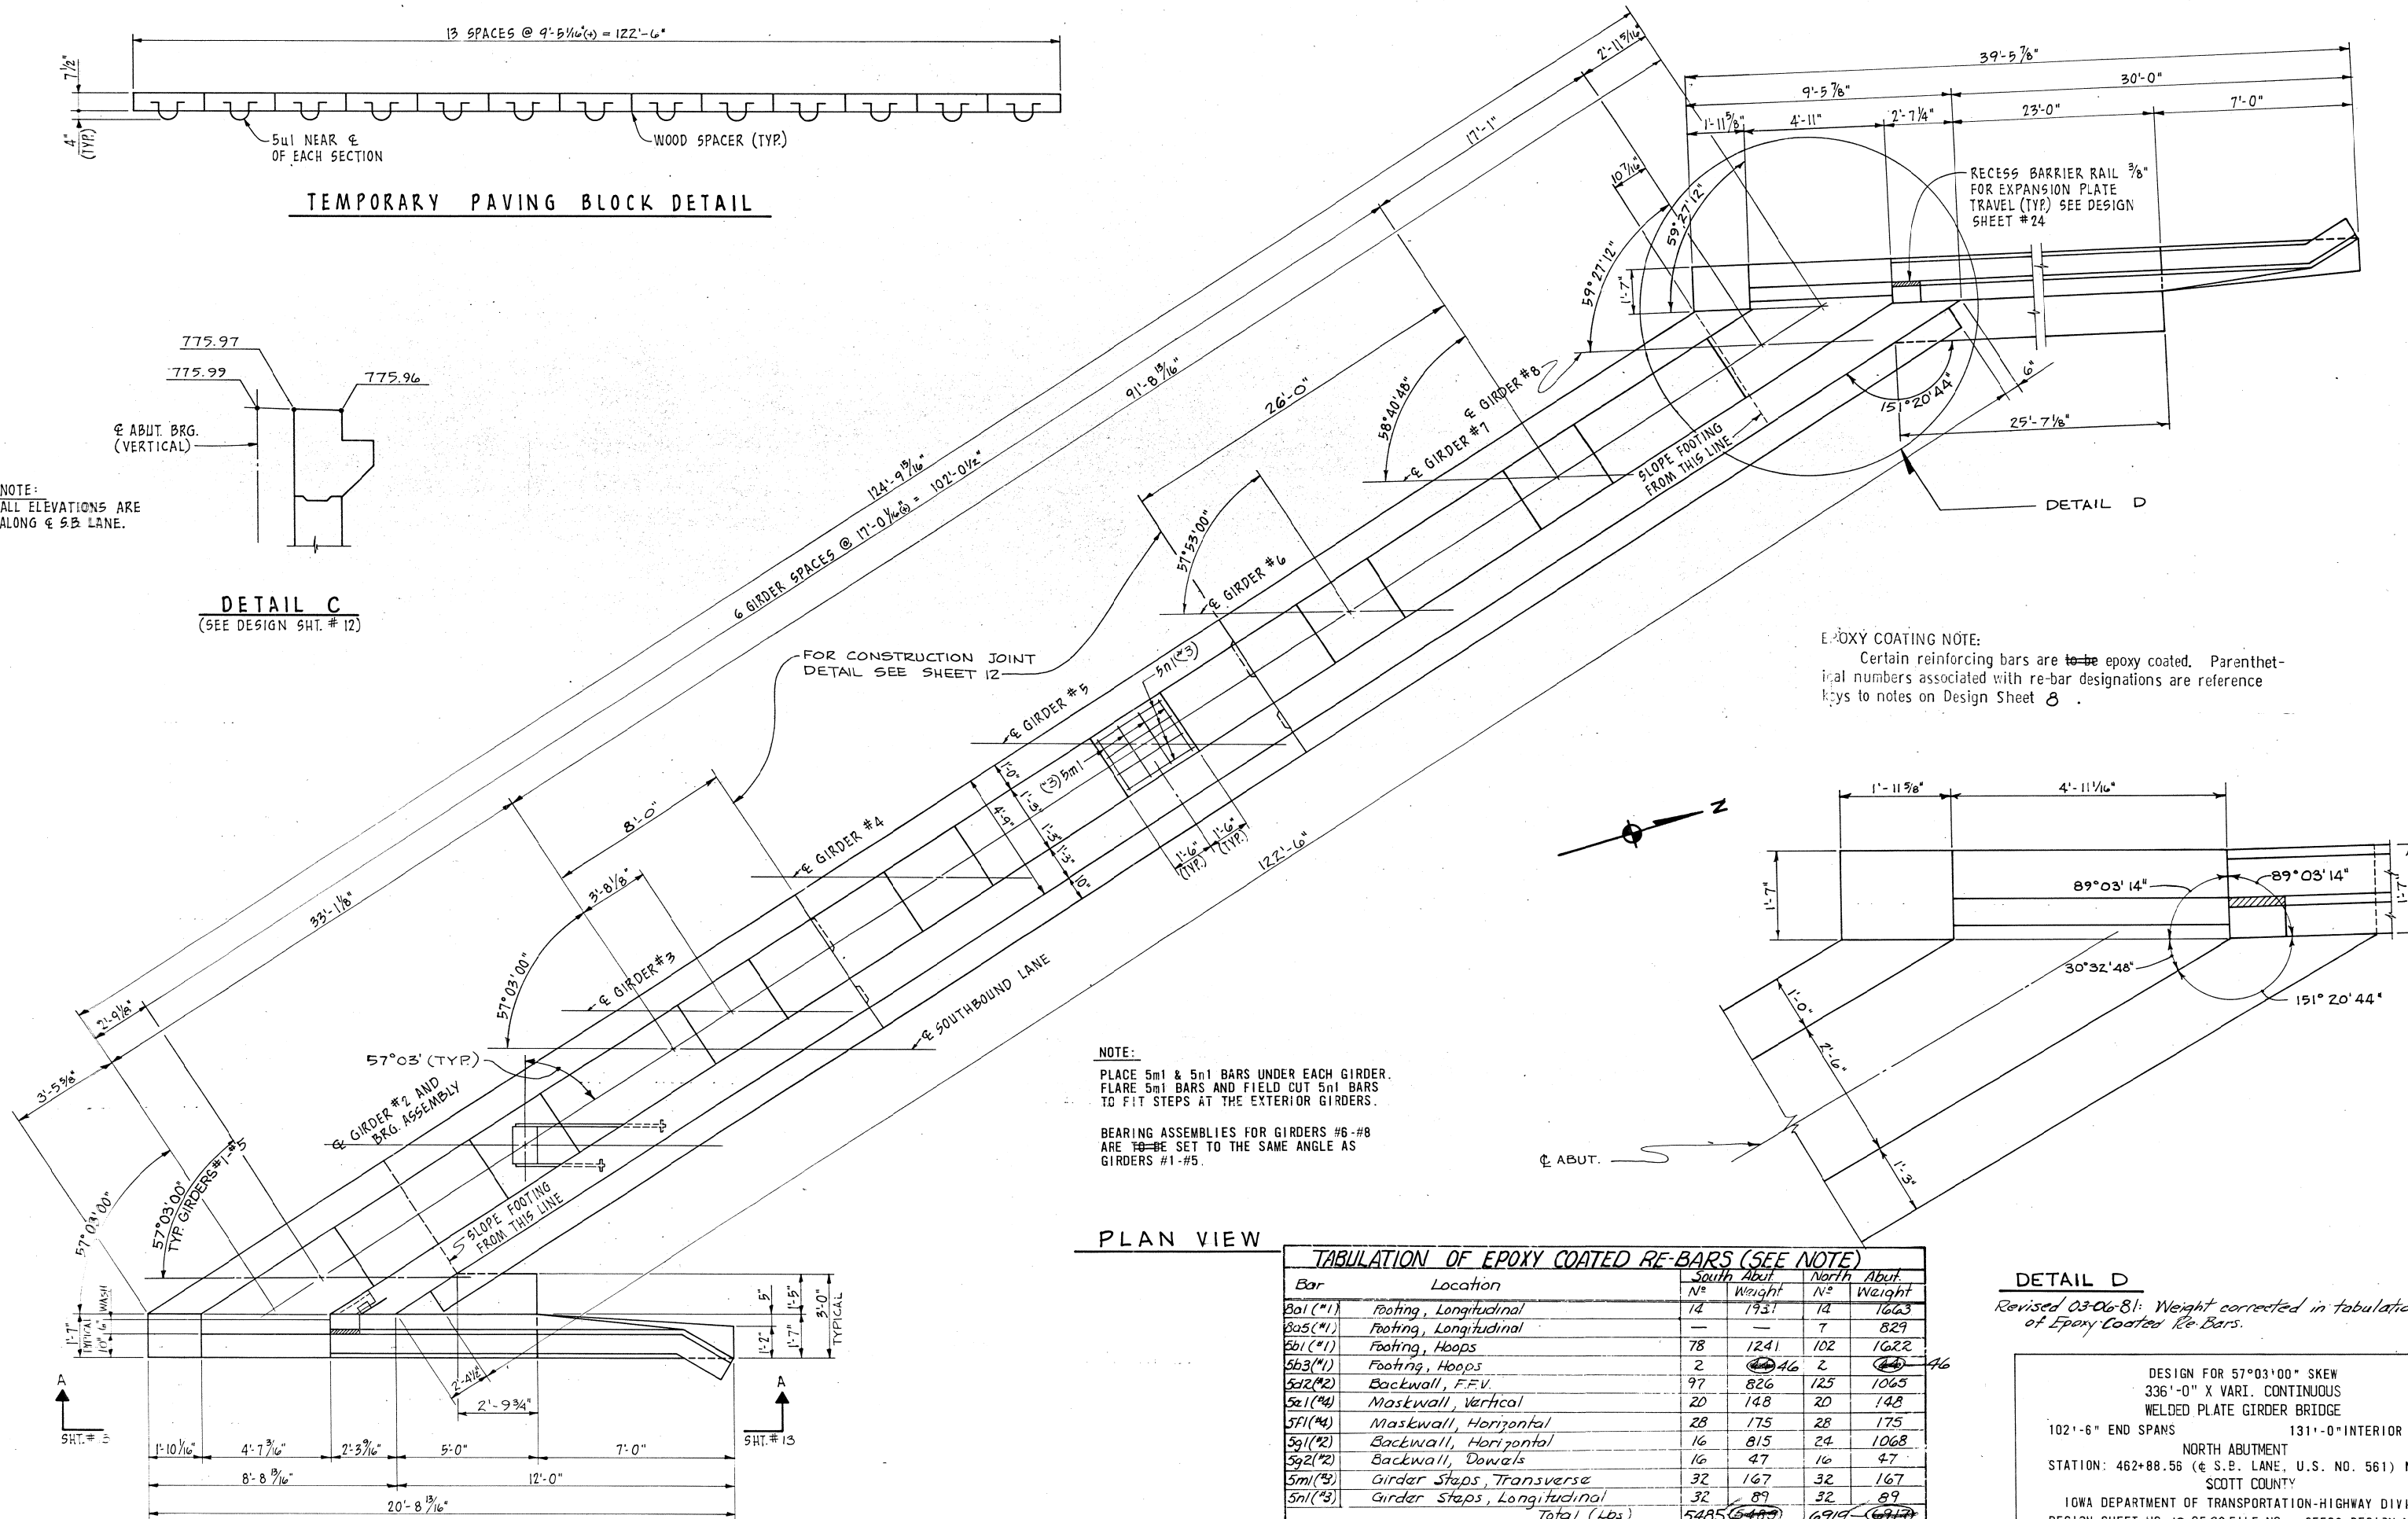

NOTE:

PLACE 5m1 & 5n1 BARS UNDER EACH GIRDER. FLARE 5m1 BARS AND FIELD CUT 5n1 BARS TO FIT STEPS AT THE EXTERIOR GIRDERS.

BEARING ASSEMBLIES FOR GIRDERS #6-#8 ARE TO BE SET TO THE SAME ANGLE AS GIRDERS #1-#5.

PLAN VIEW

TABULATION OF EPOXY COATED RE-BARS (SEE NOTE)

Bar	Location	South Abut		North Abut	
		N <sup>o</sup>	Weight	N <sup>o</sup>	Weight
8a1 (#1)	Footing, Longitudinal	14	193.1	14	166.3
8a5 (#1)	Footing, Longitudinal	—	—	7	82.9
8b1 (#1)	Footing, Hoops	78	124.1	102	162.2
5b3 (#1)	Footing, Hoops	2	46	2	46
5d2 (#2)	Backwall, F.F.V.	97	826	125	1065
5e1 (#4)	Maskwall, Vertical	20	148	20	148
5f1 (#4)	Maskwall, Horizontal	28	175	28	175
5g1 (#2)	Backwall, Horizontal	16	815	24	1068
5g2 (#2)	Backwall, Dowels	16	47	16	47
5m1 (#3)	Girder Steps, Transverse	32	167	32	167
5n1 (#3)	Girder Steps, Longitudinal	32	89	32	89
Total (Lbs)		5485	6489	6919	6419

DETAIL D

Revised 03-06-81: Weight corrected in tabulation of Epoxy Coated Re-Bars.



DESIGN FOR 57°03'00" SKEW  
336'-0" X VARI. CONTINUOUS  
WELDED PLATE GIRDER BRIDGE  
102'-6" END SPANS 131'-0" INTERIOR SPAN  
NORTH ABUTMENT  
STATION: 462+88.56 (S.B. LANE, U.S. NO. 561) NOV. 1978  
SCOTT COUNTY  
IOWA DEPARTMENT OF TRANSPORTATION-HIGHWAY DIVISION  
DESIGN SHEET NO. 10 OF 29 FILE NO. 25588 DESIGN NO. 980

SCOTT COUNTY

PROJECT NUMBER

STATE	FED. ROAD DIST. NO.	FISCAL YEAR	SHEET NO.	TOTAL SHEETS
IOWA	5		42	125



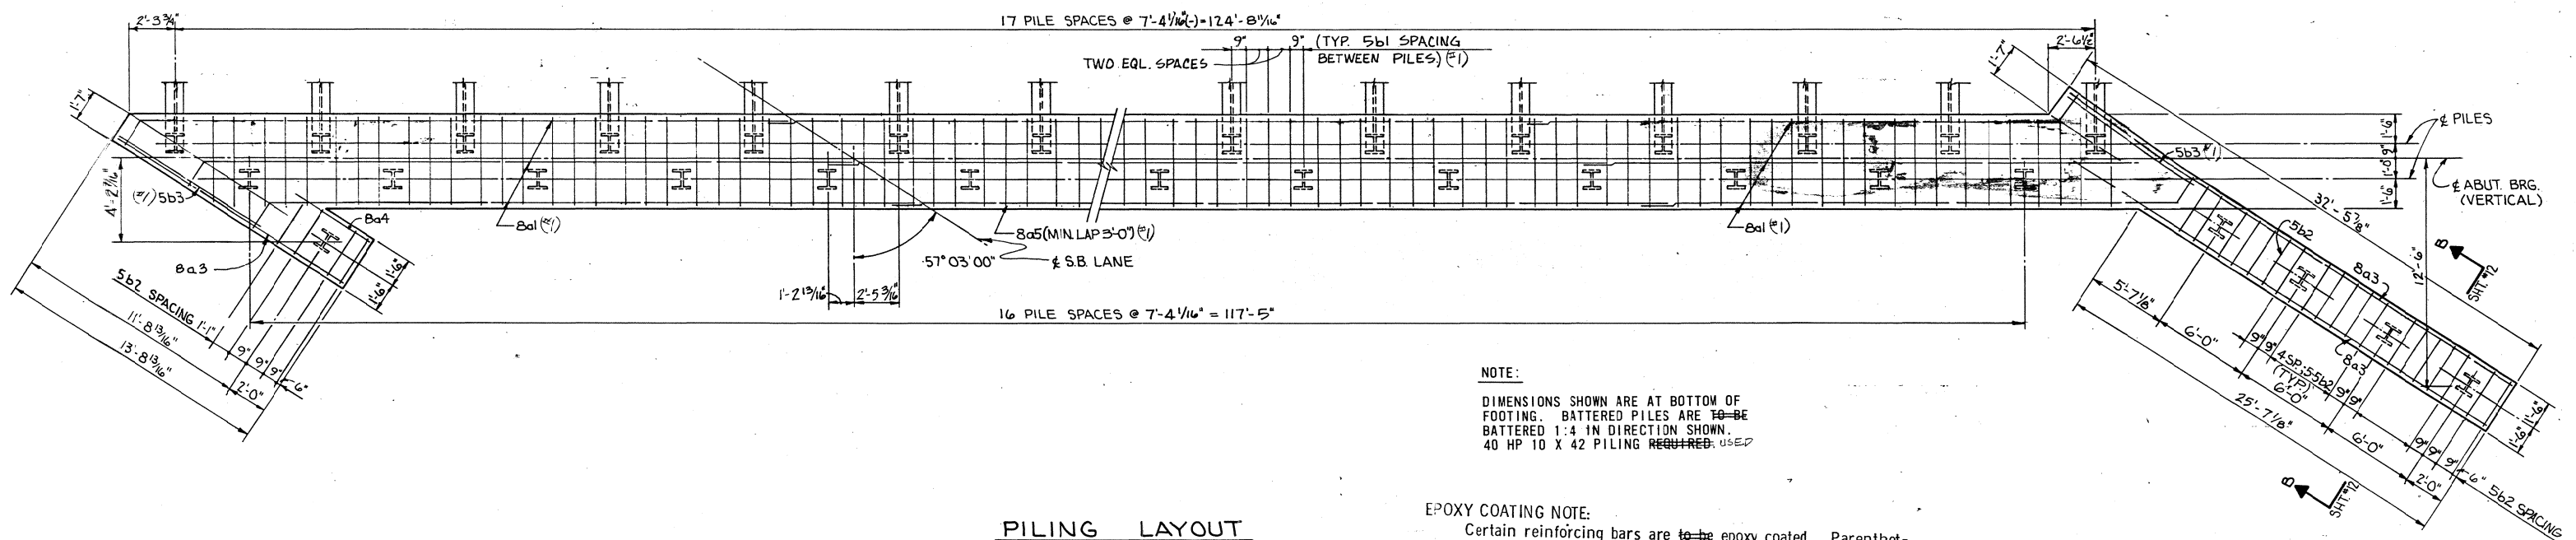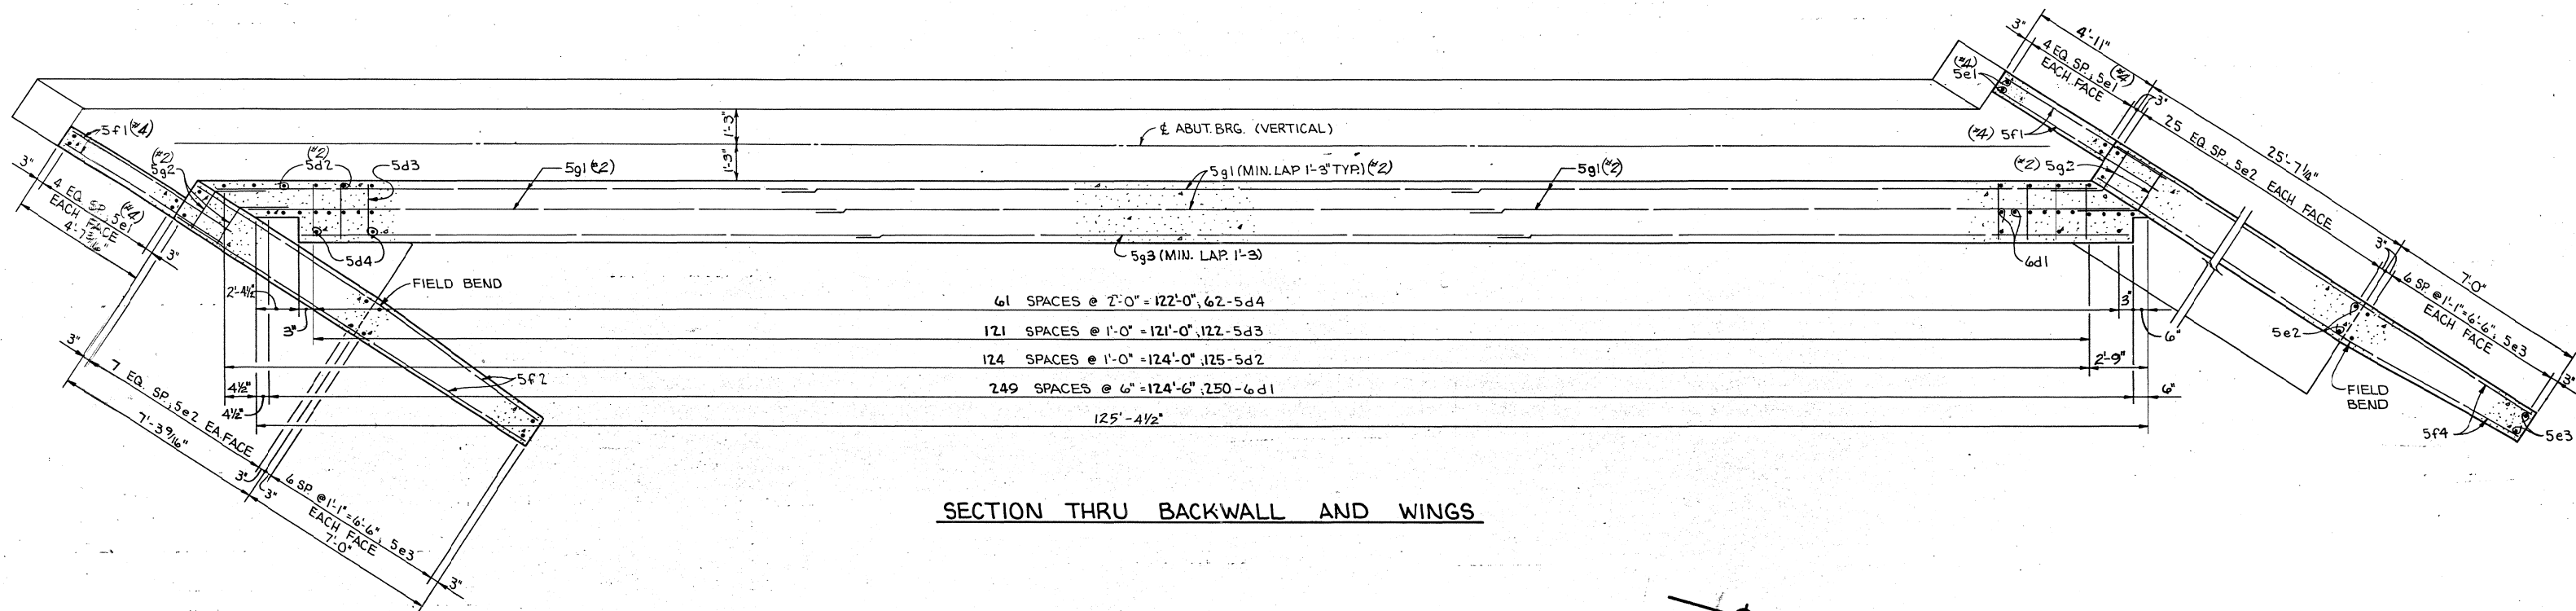







**NOTE:**

DIMENSIONS SHOWN ARE AT BOTTOM OF  
FOOTING. BATTERED PILES ARE ~~TO BE~~  
BATTERED 1:4 IN DIRECTION SHOWN.  
40 HP 10 X 42 PILING REQUIRED. ~~USED~~

EPOXY COATING NOTE:

Certain reinforcing bars are to be epoxy coated. Parenthetical numbers associated with re-bar designations are reference keys to notes on Design Sheet 8.


DESIGN FOR 57'03'00" SKEW  
336'-0" X VARI. CONTINUOUS  
WELDED PLATE GIRDER BRIDGE  
102'-6" END SPANS                      131'-0" INTERIOR SPAN  
NORTH ABUTMENT  
STATION: 462+88.56 (€ S.B. LANE, U.S. NO. 561) NOV. 1978  
SCOTT COUNTY  
IOWA DEPARTMENT OF TRANSPORTATION-HIGHWAY DIVISION  
DESIGN SHEET NO. 11 OF 29 FILE NO. 25588 DESIGN NO. 980

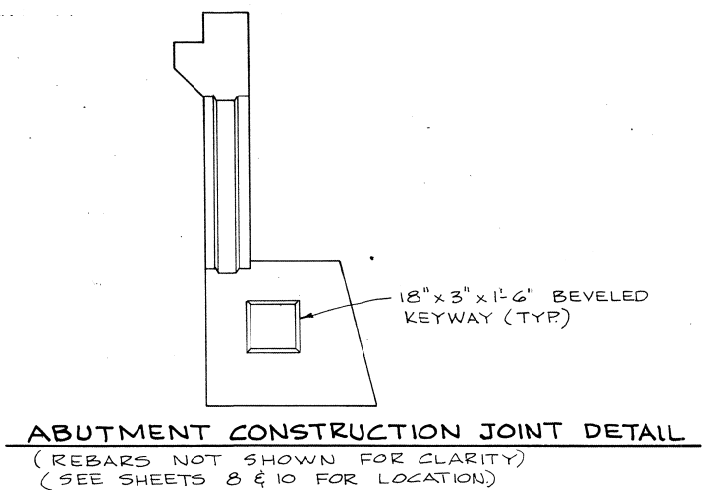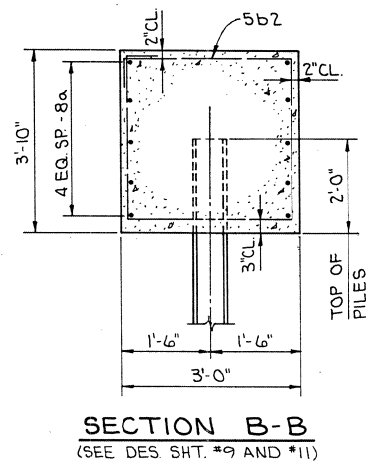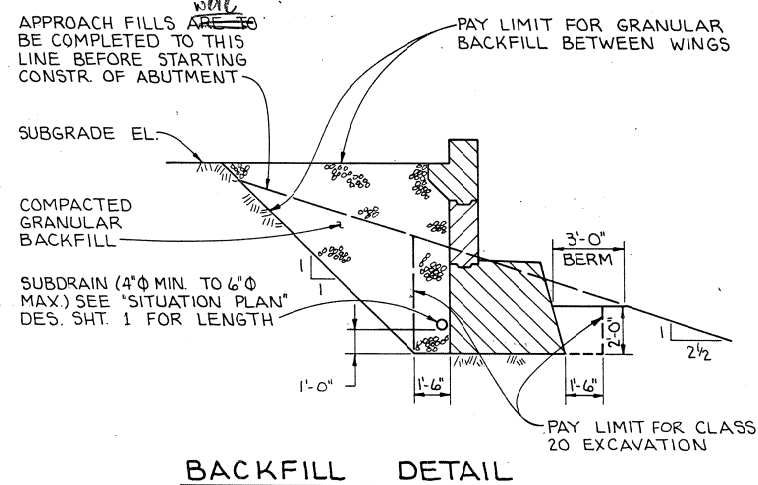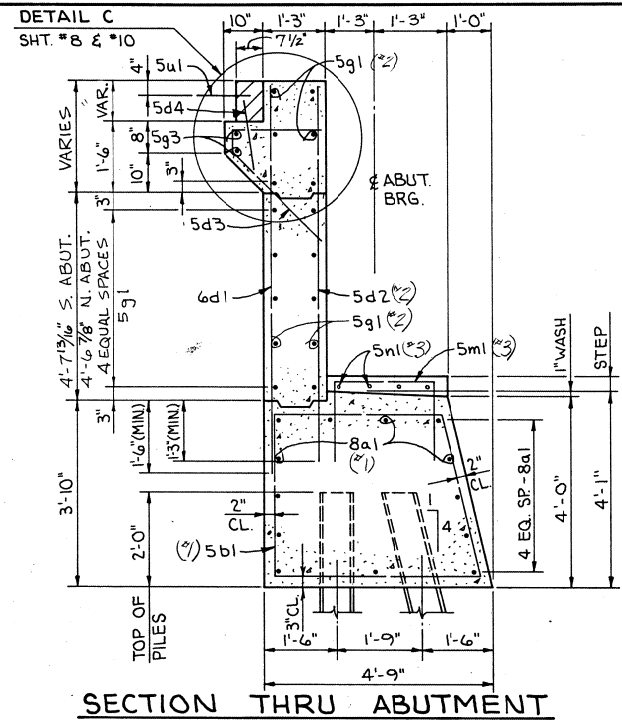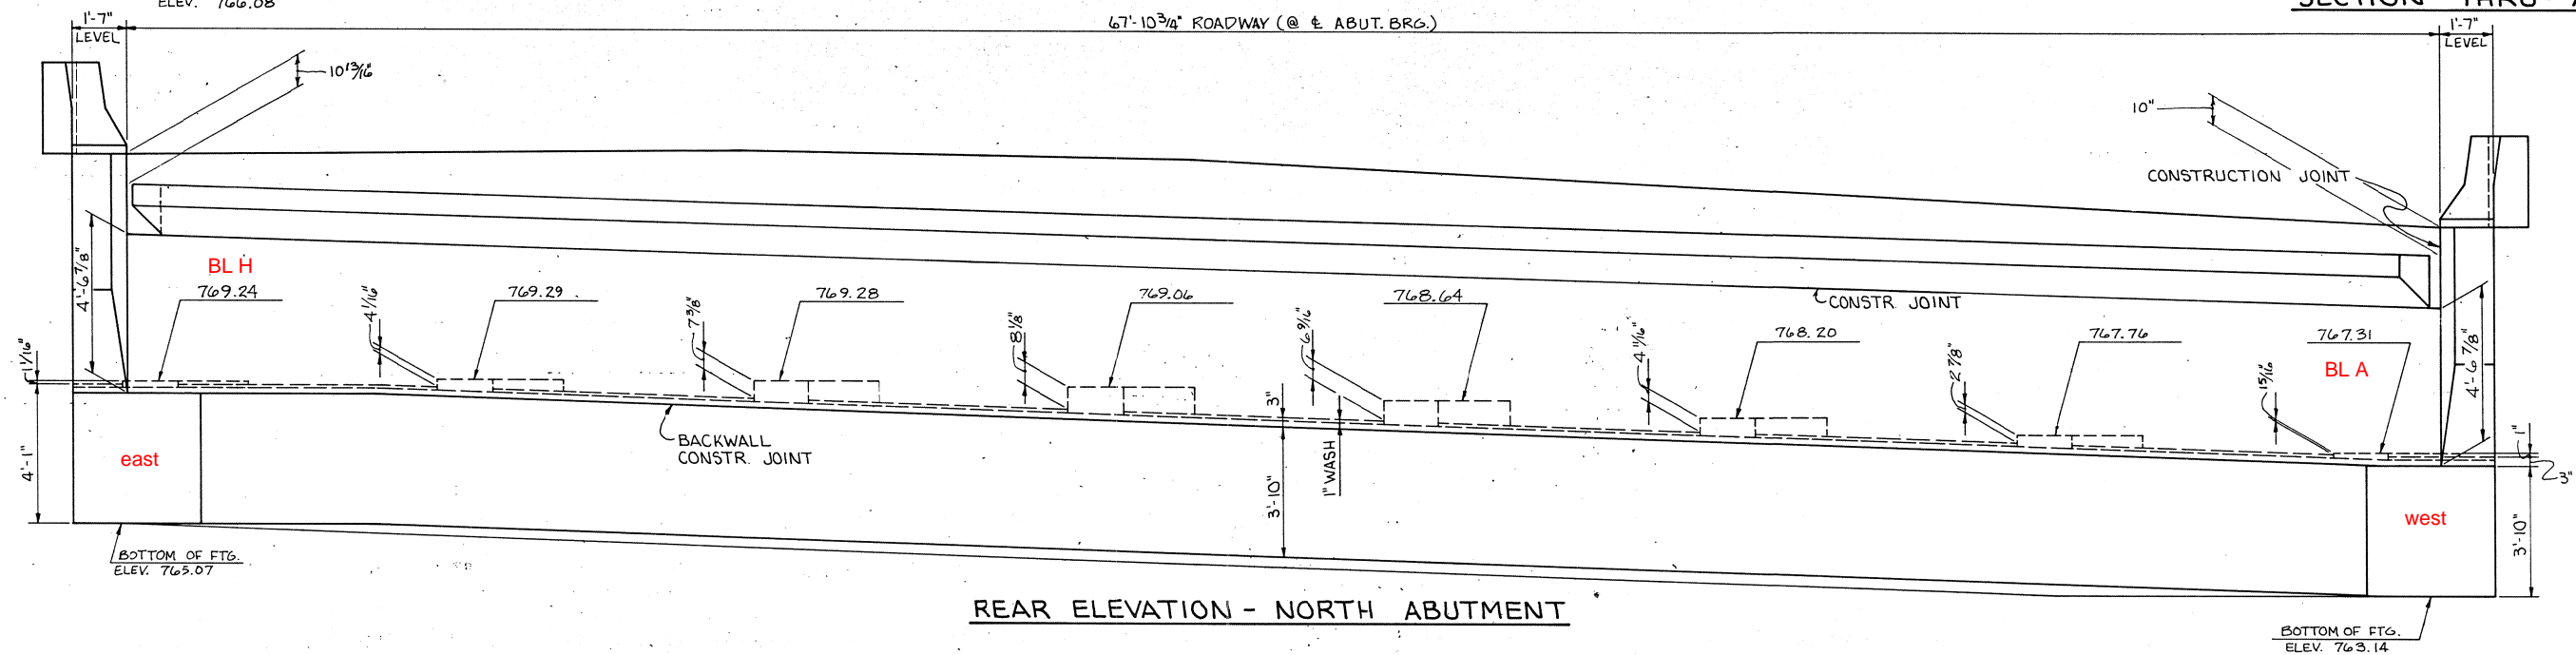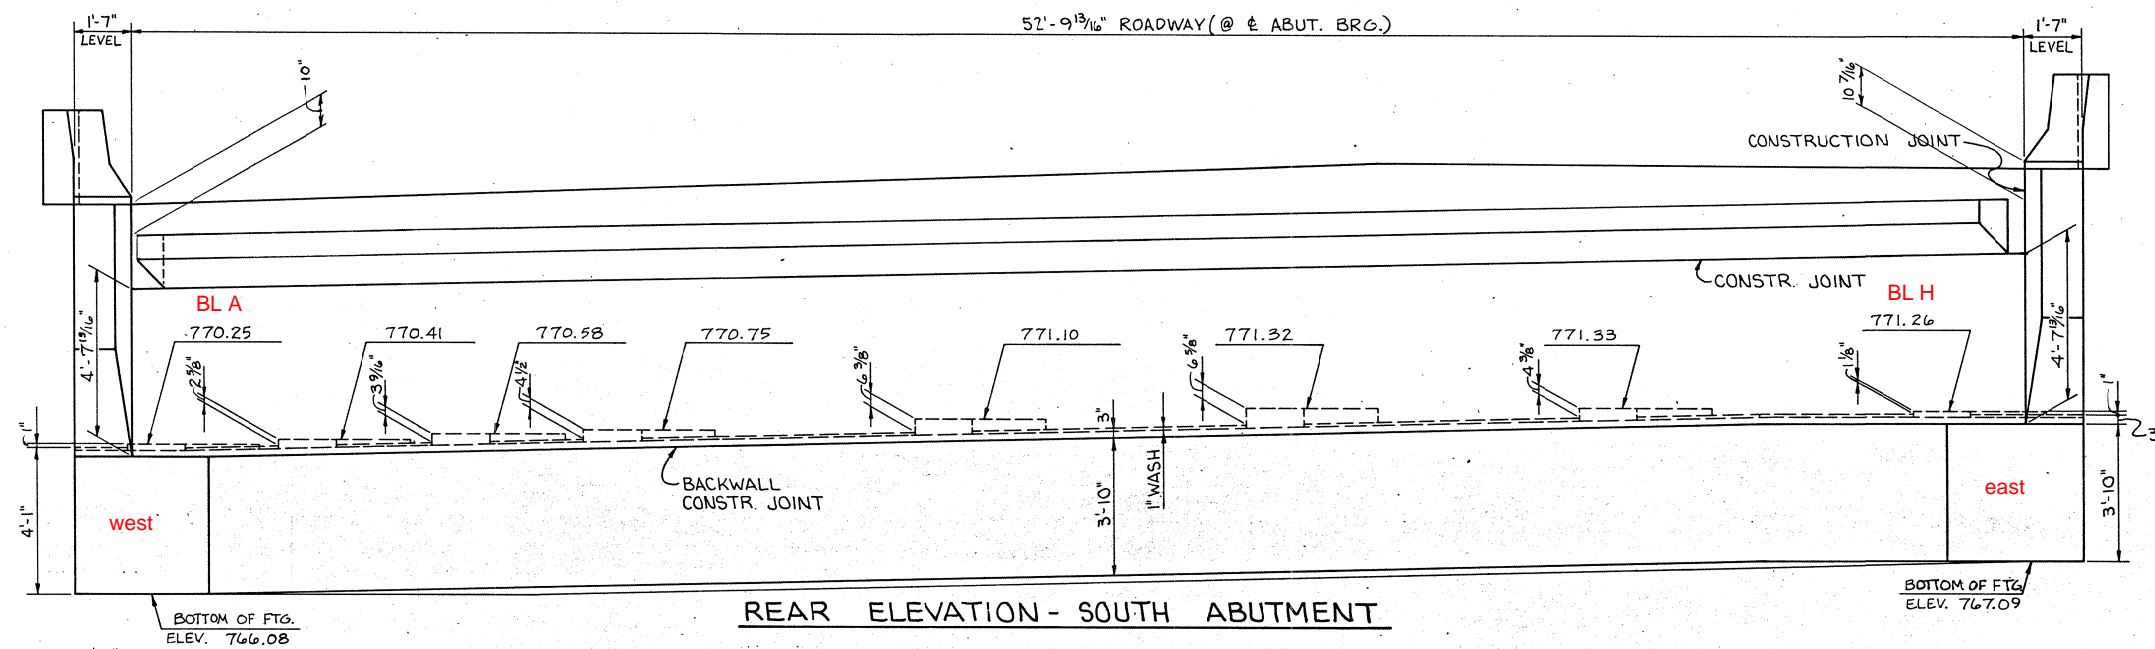

EPOXY COATING NOTE:  
Certain reinforcing bars are to be epoxy coated. Parenthetical numbers associated with re-bar designations are reference keys to notes on Design Sheet 8.


DESIGN FOR 57'03"00" SKEW  
336'-0" X VARI. CONTINUOUS  
WELDED PLATE GIRDER BRIDGE  
102'-6" END SPANS                      131'-0" INTERIOR SPAN  
ABUTMENT DETAILS  
STATION: 462+88.56 (¢ S.B. LANE, U.S. NO. 561) NOV. 1978  
SCOTT COUNTY  
IOWA DEPARTMENT OF TRANSPORTATION-HIGHWAY DIVISION  
DESIGN SHEET NO. 12 OF 29 FILE NO. 25588 DESIGN NO. 980

SCOTT COUNTY	PROJECT NUMBER	STATE	FED. ROAD DIST. NO.	FISCAL YEAR	SHEET NO.	TOTAL SHEETS
		IOWA	5		44	175

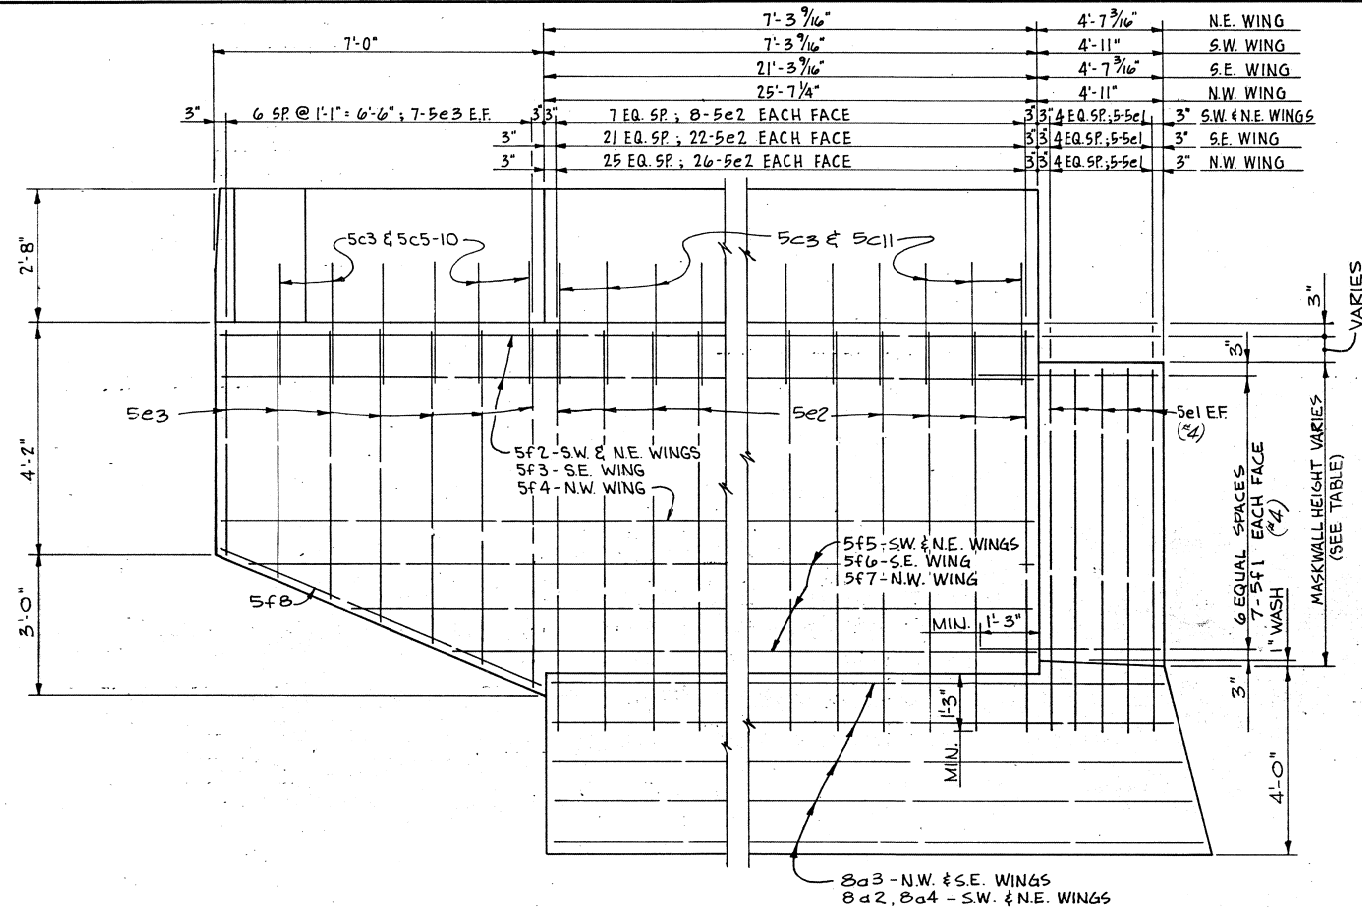

VIEW A-A  
SHOWING REINFORCING

NOTE:  
SEE SHEETS 8 AND 10 FOR LOCATION  
OF VIEW A-A, SEE SHEETS 27 AND 28  
FOR 5C3 AND 5C5-11.

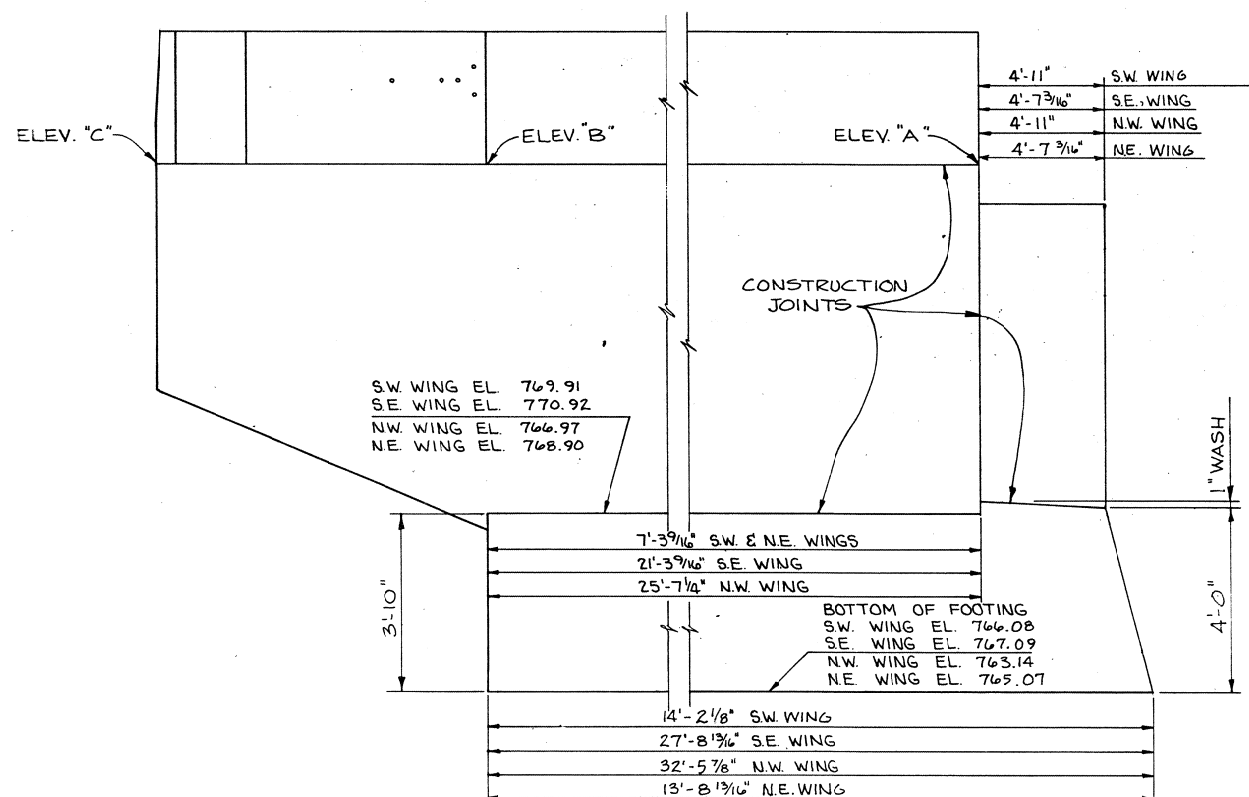

VIEW A-A  
SHOWING ELEVATIONS

FINAL TOTAL ESTIMATED QUANTITIES				
ITEM	UNITS	S. ABUT.	N. ABUT.	TOTAL
STRUCTURAL CONCRETE, CLASS "C"	CU. YDS.	130.7	162.8	293.5
REINFORCING STEEL	LBS.	8,284	10,264	18,548
HP 10X42 STEEL	FURNISH	32 @ 81'	40 @ 65'	5192
BEARING PILING	DRIVE	32 @ 81'	40 @ 65'	5192
PREBORED HOLES	LIN. FT.	32 @ 25'	40 @ 25'	1800
BRIDGE SEAT SEALER	SQ. FT.	434	556	990
SUBDRAIN	LIN. FT.	134	172	306
CLASS 20 EXCAVATION	CU. YDS.	154	192	346
GRANULAR BACKFILL	CU. YDS.	228	292	520
REINFORCING STEEL, EPOXY COATED	LBS.	5,485	6,919	12,404

CONCRETE PLACEMENT QUANTITIES		
LOCATION	S. ABUT.	N. ABUT.
FOOTING & STEPS	75.3	94.7
BACKWALL BELOW CONSTRUCTION JOINT	20.9	26.5
BACKWALL ABOVE CONSTRUCTION JOINT	14.7	19.5
EAST WING & WINGWALL	10.8	5.0
WEST WING & WINGWALL	5.0	12.2
* PAVING BLOCK	2.3	3.3
MASKWALL	1.7	1.6
TOTAL (CU. YDS.)	130.7	162.8

\* MAY BE CLASS "C" OR CLASS "D"

WING ELEVATIONS AND MASKWALL HEIGHT				
	SOUTH ABUTMENT		NORTH ABUTMENT	
	W. WING	E. WING	W. WING	E. WING
ELEV. A	776.88	777.94	773.91	775.90
ELEV. B	776.92	778.03	773.68	775.85
ELEV. C	776.97	778.06	773.61	775.81
MASKWALL HEIGHT	5'-11 1/8"	5'-11 5/8"	5'-11 13/16"	5'-11 1/4"

#### ABUTMENT NOTES:

ALL EXPOSED CORNERS OF 90° OR SHARPER ARE TO BE FILLETED WITH A 3/4" DRESSED AND BEVELED STRIP.  
REINFORCING STEEL IS TO BE SECURELY WIRED IN PLACE BEFORE CONCRETE IS POURED.  
MINIMUM CLEAR DISTANCE FROM FACE OF CONCRETE TO NEAR REINFORCING BARS IS TO BE 2" UNLESS OTHERWISE NOTED OR SHOWN.  
ALL BACKFILL BEHIND ABUTMENTS BETWEEN WINGS IS TO BE GRANULAR BACKFILL. THE REMAINDER OF ABUTMENT EXCAVATION IS TO BE BACKFILLED WITH SOIL.  
THE MASKWALL IS TO BE POURED BEFORE SUPERSTRUCTURE SLAB WAS POURED.  
CONSTRUCTION JOINT KEYWAYS ARE TO BE FORMED WITH BEVELED 2 X 6'S.  
BEAMS AND MASONRY PLATES ARE TO BE SET BEFORE BACKWALL IS POURED.  
THE PORTION OF BACKWALL CONTAINING ABUTMENT ANCHORAGE OF THE EXPANSION DEVICE IS TO BE POURED AFTER BRIDGE FLOOR IS PLACED.  
BEFORE PAVING BLOCK IS POURED, BEND DOWN DOWELS 5d4 (STRUCTURAL GRADE) AND LINE PAVING NOTCH WITH TARPAPER TO PREVENT BOND. PAVING BLOCK IS TO BE REMOVED AND BARS STRAIGHTENED BEFORE PAVEMENT IS PLACED (BY OTHERS).  
THE NUMBER OF PILES IS BASED ON 37 TONS BEARING PER PILE. PILES ARE TO BE DRIVEN TO FULL PENETRATION IF PRACTICABLE, BUT NOT LESS THAN 37 TONS BEARING VALUE PER PILE.  
CONTRACTOR HAS THE OPTION TO SPLICE BARS OVER 40'-0". LONG SPLICE LOCATIONS TO BE APPROVED BY THE ENGINEER. PAYMENT FOR REINFORCING BARS SHALL BE BASED ON NO SPLICES, AND NO ALLOWANCE SHALL BE MADE FOR THE ADDITIONAL LENGTH OF BAR REQUIRED FOR THE USE OF SPLICES.

#### EPOXY COATING NOTE:

Certain reinforcing bars are to be epoxy coated. Parenthetical numbers associated with re-bar designations are reference keys to notes on Design Sheet 8.


Revised 03-06-81: Reinforcing Steel list and Total Estimated Quantities list corrected.

#### REINFORCING STEEL

BAR	LOCATION	SHAPE	SOUTH ABUTMENT			NORTH ABUTMENT		
			NO.	LENGTH	WEIGHT	NO.	LENGTH	WEIGHT
8a1	FOOTING - LONGITUDINAL		26	51'-8"	3587	26	44'-6"	3089
8a2	WING FOOTING - LONGITUDINAL		5	VARIES	171	5	VARIES	167
8a3	WING FOOTING - LONGITUDINAL		10	VARIES	705	10	VARIES	834
8a4	WING FOOTING - LONGITUDINAL		5	4'-10"	65	5	4'-10"	65
8a5	FOOTING - LONGITUDINAL		-	-	-	13	44'-4"	1539
5b1	FOOTING, HOOPS		78	15'-3"	1241	102	15'-3"	1622
5b2	WING FOOTING HOOPS		22	12'-5"	285	32	12'-5"	425
5b3	FOOTING, HOOPS		2	22'-2"	46	2	22'-2"	46
6d1	BACKWALL, BFV		193	8'-5"	2440	250	8'-5"	3160
5d2	BACKWALL, FFV		97	8'-2"	826	125	8'-2"	1065
5d3	PAVING NOTCH - TRANSVERSE		93	4'-6"	436	122	4'-6"	573
5d4	PAVING DOWELS		47	2'-0"	98	62	2'-0"	129
5e1	MASKWALL - VERTICAL		20	7'-1"	148	20	7'-1"	148
5e2	WINGWALL - VERTICAL		60	8'-3"	516	68	8'-3"	585
5e3	WING - VERTICAL		28	VARIES	141	28	VARIES	141
5f1	MASKWALL - HORIZONTAL		28	6'-0"	175	28	6'-0"	175
5f2	WING & WINGWALL - HORIZONTAL		10	13'-11"	145	10	13'-11"	145
5f3	WING & WINGWALL - HORIZONTAL		10	27'-11"	291	-	-	-
5f4	WING & WINGWALL - HORIZONTAL		-	-	-	10	32'-3"	336
5f5	WING & WINGWALL - HORIZONTAL		6	VARIES	66	6	VARIES	72
5f6	WING & WINGWALL - HORIZONTAL		6	VARIES	153	-	-	-
5f7	WING & WINGWALL - HORIZONTAL		-	-	-	6	VARIES	185
5f8	WING SLOPE		4	7'-4"	31	4	7'-4"	31
5g1	BACKWALL - HORIZONTAL		32	48'-10"	1630	48	42'-8"	2136
5g2	BACKWALL - DOWELS		32	2'-10"	95	32	2'-10"	95
5g3	PAVING NOTCH - LONGITUDINAL		4	47'-7"	199	6	41'-7"	260
5m1	GIRDER STEPS - TRANSVERSE		32	5'-0"	167	32	5'-0"	167
5n1	GIRDER STEPS - LONGITUDINAL		32	2'-8"	89	32	2'-8"	89
5u1	PAVING BLOCK - LOOPS		10	2'-3"	23	13	2'-3"	31

\*\*\* TOTAL (LBS.) 13,769 17,183

#### BENT BAR DETAILS

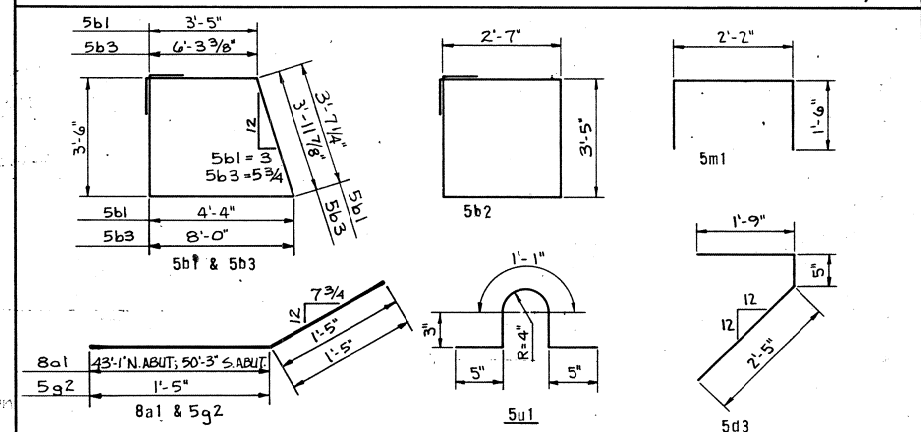

NOTE: ALL DIMENSIONS ARE OUT TO OUT. RADIUS IS TO 4 BAR.

\*\* SEE ABUTMENT NOTES THIS SHEET.

\*\*\* Includes both regular re-bars and epoxy coated re-bars. See tabulation of epoxy coated re-bars on Design Sheet 10.

DESIGN FOR 57°03'00" SKEW  
336'-0" X VARI. CONTINUOUS  
WELDED PLATE GIRDER BRIDGE  
102'-6" END SPANS 131'-0" INTERIOR SPAN  
ABUTMENT DETAILS  
STATION: 462+88.56 (E S.B. LANE, U.S. NO. 561) NOV. 1978  
SCOTT COUNTY  
IOWA DEPARTMENT OF TRANSPORTATION-HIGHWAY DIVISION  
DESIGN SHEET NO. 13 OF 29 FILE NO. 25588 DESIGN NO. 980


SCOTT COUNTY

PROJECT NUMBER

STATE FED. ROAD DIST. NO. FISCAL YEAR SHEET NO. TOTAL SHEETS

IOWA 5 1978 45 130



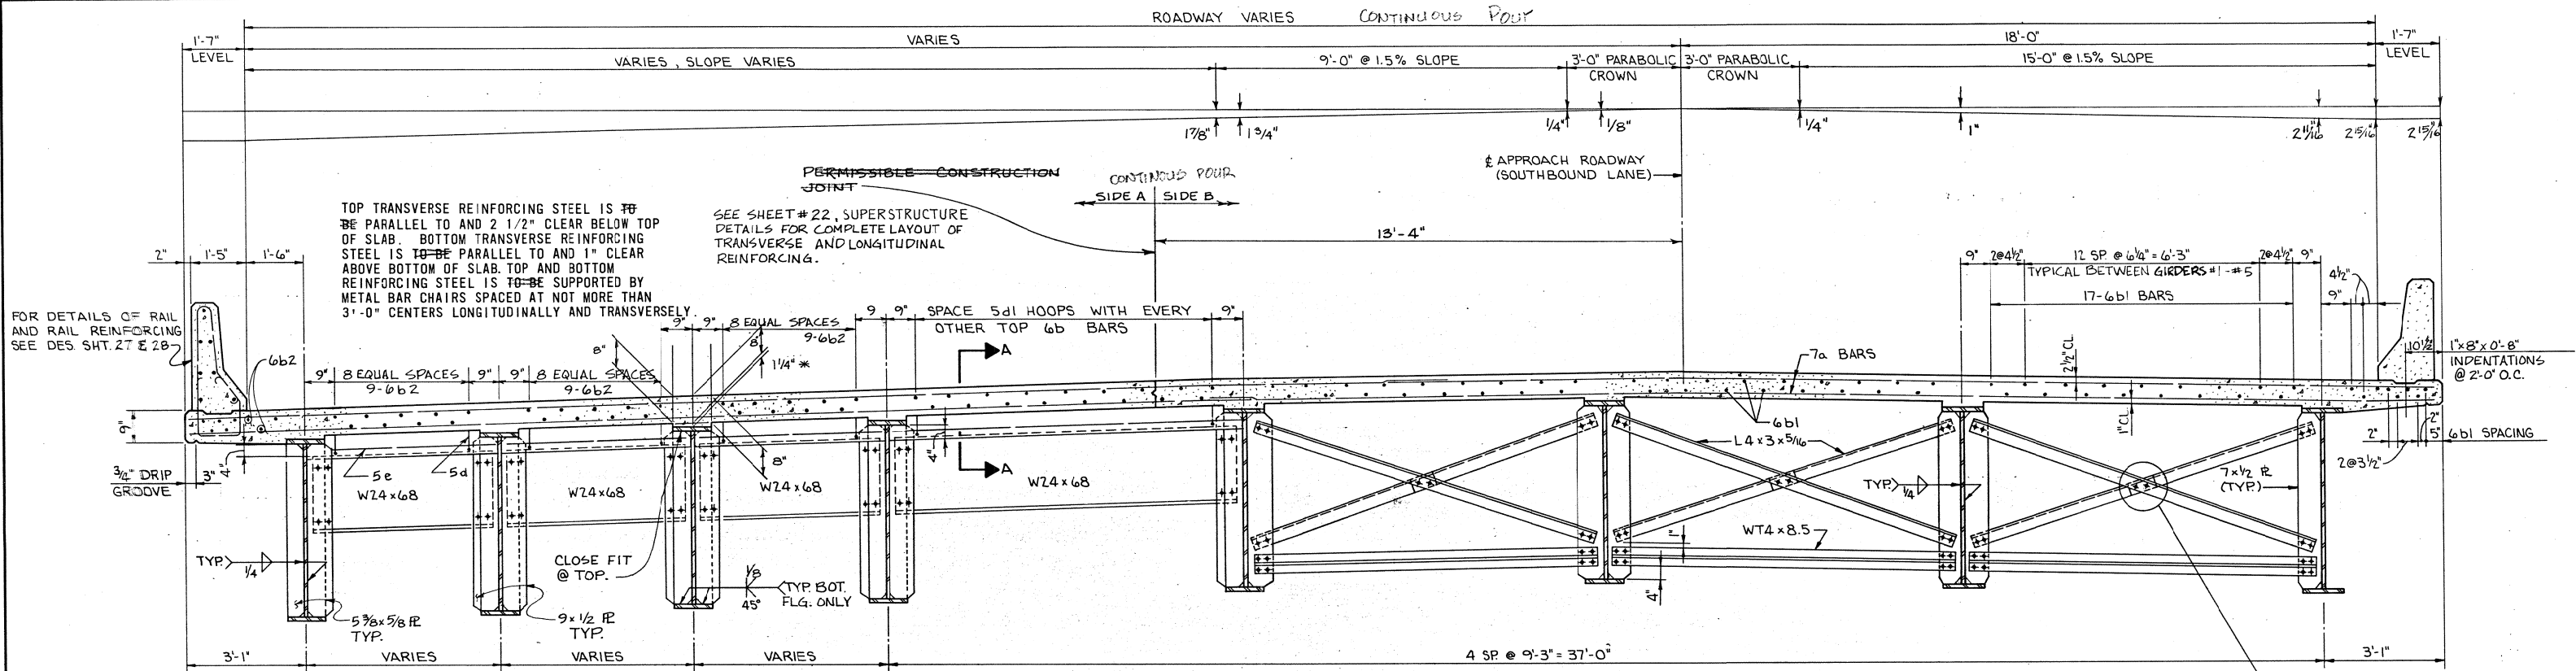

**PART SECTION NEAR SOUTH ABUTMENT**

**PART INTERMEDIATE SECTION**  
SEE DESIGN SHEET 15 FOR INTERMEDIATE DIAPHRAGM STIFFENER DETAILS

**SUPERSTRUCTURE NOTES:**

THIS BRIDGE IS DESIGNED FOR HS20-44 LOADING, PLUS 20 LB. PER SQUARE FOOT OF ROADWAY FOR FUTURE WEARING SURFACE.

MINIMUM CLEAR DISTANCE FROM EDGE OF BAR TO FACE OF CONCRETE IS TO BE 2" UNLESS OTHERWISE NOTED OR SHOWN.

THE FLOOR SLAB AS SHOWN INCLUDES 1/2" OF WEARING SURFACE.

ALL FIELD CONNECTIONS ARE TO BE BOLTED USING "HIGH TENSILE STRENGTH BOLTS" UNLESS OTHERWISE NOTED. ALL OPEN HOLES ARE TO BE 15/16" Ø AND ALL BOLTS ARE TO BE 7/8" Ø.

BOTTOM FLANGES ARE TO BE PERPENDICULAR TO WEBS AT THE REACTION JOINTS.

ALL PAINT IS TO BE OMITTED ON TOPS OF TOP FLANGES AND ON OTHER STEEL SURFACES IN CONTACT WITH CONCRETE. PARTS INACCESSIBLE AFTER ERECTION ARE TO BE GIVEN THE FULL PAINT SYSTEM IN THE SHOP.

FORMS FOR THE SLAB AND BARRIER RAIL ARE TO BE SUPPORTED BY THE GIRDERS.

FILL THICKNESS SHOWN ON PLANS ARE BASED ON NOMINAL BEAM OR GIRDER DIMENSIONS. THESE THICKNESSES ARE TO BE VERIFIED OR ADJUSTED DURING FABRICATION TO SECURE A CLOSE FIT. EACH FILL PLATE SHALL FIT TO THE NEAREST 1/16" IN THICKNESS AND SINGLE PLATES ARE REQUIRED AT ANY FILL LOCATION. BEAMS OR GIRDERS ARE TO BE TRULY SQUARE AT SPLICE POINTS WITH FLANGES PERPENDICULAR TO WEBS.

THE DESIGN DRAWINGS INDICATE AWS PREQUALIFIED WELDED JOINTS, AND UNLESS OTHERWISE NOTED THE DESIGN JOINT DETAILS ARE FOR MANUAL SHIELDED METAL ARC WELDING. ALTERNATE JOINT DETAILS MAY BE SUBMITTED FOR APPROVAL.


MAGNETIC PARTICLE INSPECTION OF WELDS, IN ACCORDANCE WITH THE STANDARD SPECIFICATIONS, WILL BE REQUIRED FOR THE WEB TO FLANGE WELDS AND THE BEARING STIFFENER WELDS OF THE GIRDERS.

STUD SHEAR CONNECTORS ARE TO BE WELDED IN THE SHOP OR IN THE FIELD AT THE LOCATIONS SHOWN ON THE DESIGN PLANS OR THE APPROVED SHOP DRAWINGS.


FAYING SURFACES AT DIAPHRAGM CONNECTIONS ARE TO BE GIVEN THE SHOP COAT OF PAINT.

THE SLAB TRANSVERSE AND LONGITUDINAL REINFORCING, 7a AND 6b BARS, ARE TO BE GRADE 60 REINFORCING. ALL OTHER REINFORCING MAY BE GRADE 40.


THE TOP LAYER OF SLAB TRANSVERSE AND LONGITUDINAL REINFORCING, 7a AND 6b BARS ARE TO BE EPOXY COATED. THE EPOXY COATING SHALL BE IN ACCORDANCE WITH STANDARD SPECIFICATIONS OF THE IOWA D.O.T., SERIES OF 1977.

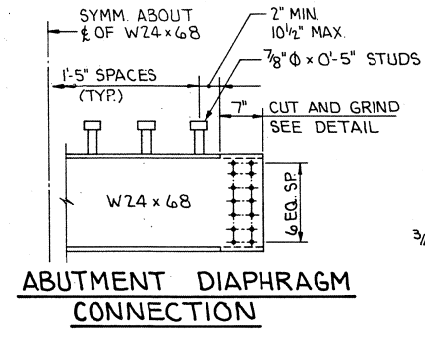


**ABUTMENT DIAPHRAGM CONNECTION**

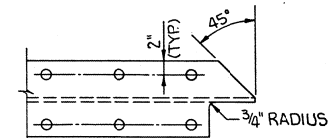


**TYPICAL CUT AND GRIND DETAIL**

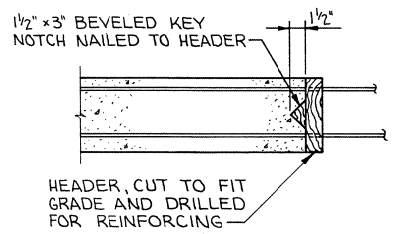

**LONGITUDINAL AND TRANSVERSE CONSTRUCTION JOINT DETAIL**

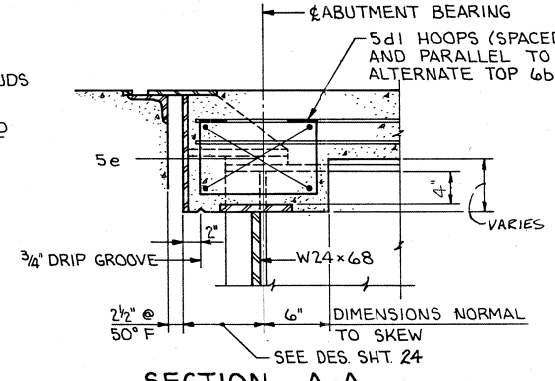


**SECTION A-A**  
TRANSVERSE REINFORCING NOT SHOWN


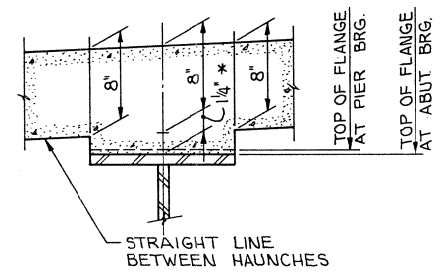


**TYPICAL SLAB AND HAUNCH DETAIL**


\* THE HAUNCH DIMENSION SHOWN IS THE NOMINAL HAUNCH DIMENSION NEAR THE ABUTMENT BEARINGS. FOR THE SLAB THICKNESS OVER THE BEAM AT ANY LOCATION THE NOMINAL HAUNCH DIMENSION IS TO BE DECREASED BY THE ADDITIONAL FLANGE THICKNESS AT THAT POINT AND INCREASED BY THE AMOUNT INDICATED ON THE "HAUNCH THICKENING DIAGRAM" SHOWN ON SHEET 18, AND MAY BE INCREASED OR DECREASED TO COMPENSATE FOR CONSTRUCTION INACCURACIES. THE MAXIMUM HAUNCH ALLOWED IS 2 INCHES AND THE MINIMUM HAUNCH ALLOWED IS 0 INCHES.

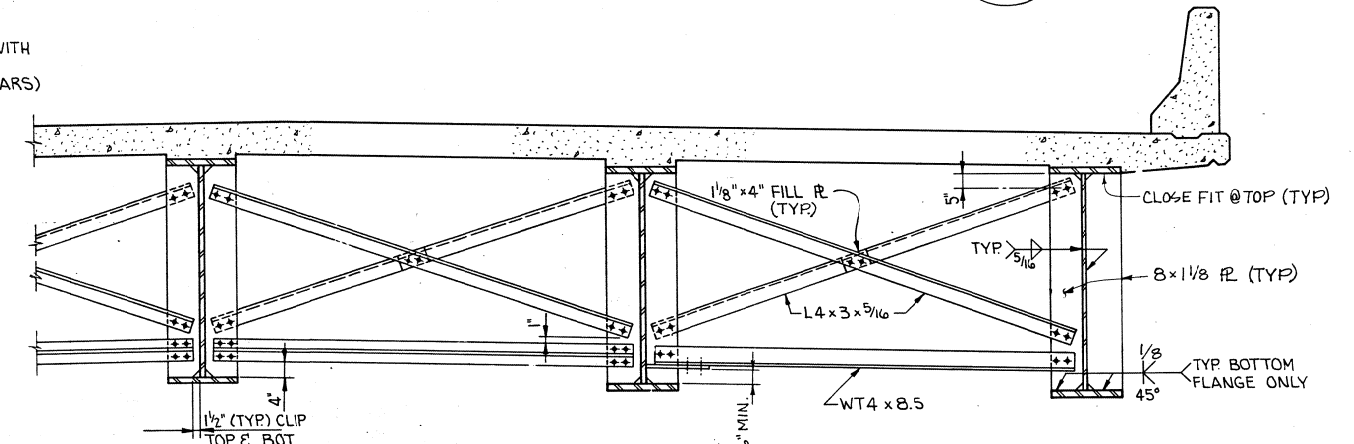


**PART SECTION NEAR PIER**

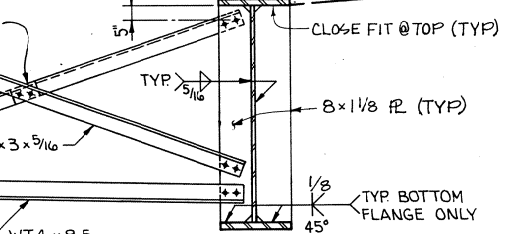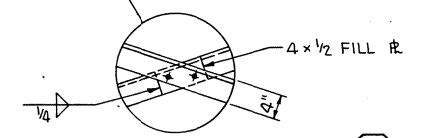

DESIGN FOR 57°03'00" SKEW  
336'-0" X VARI. CONTINUOUS  
WELDED PLATE GIRDER BRIDGE  
102'-6" END SPANS 131'-0" INTERIOR SPAN  
SUPERSTRUCTURE DETAILS  
STATION: 462+88.56 (± S.B. LANE, U.S. NO. 561) NOV. 1978  
SCOTT COUNTY  
IOWA DEPARTMENT OF TRANSPORTATION-HIGHWAY DIVISION  
DESIGN SHEET NO. 14 OF 29 FILE NO. 25588 DESIGN NO. 980

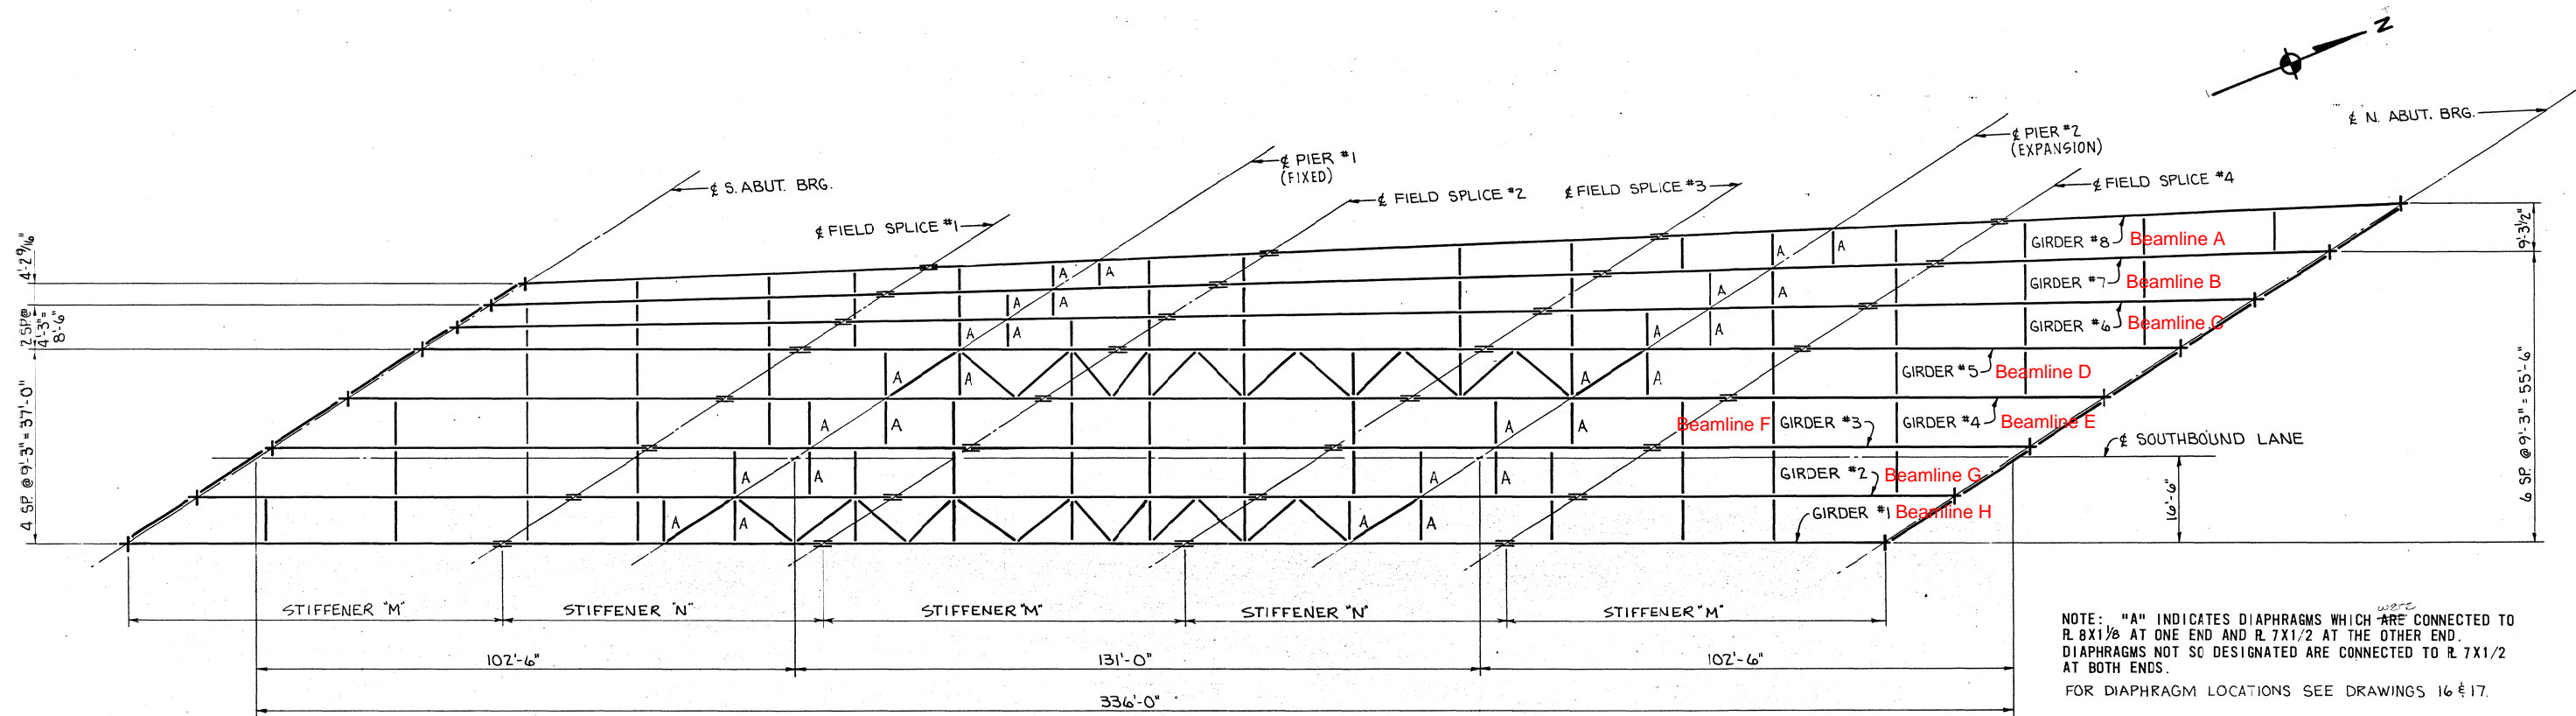


### STRUCTURAL STEEL LAYOUT

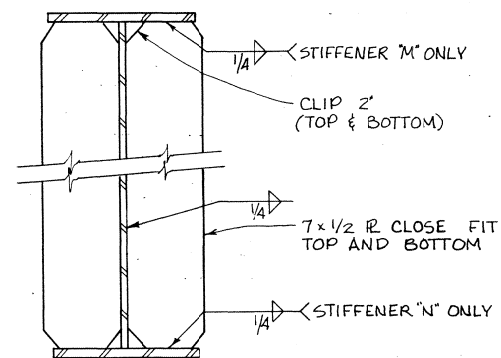

### INTERMEDIATE DIAPHRAGM STIFFENER DETAILS

SEE DESIGN SHEET 20 FOR INTERMEDIATE GUSSET STIFFENERS. SEE DESIGN SHEET 14 FOR INTERMEDIATE DIAPHRAGMS.

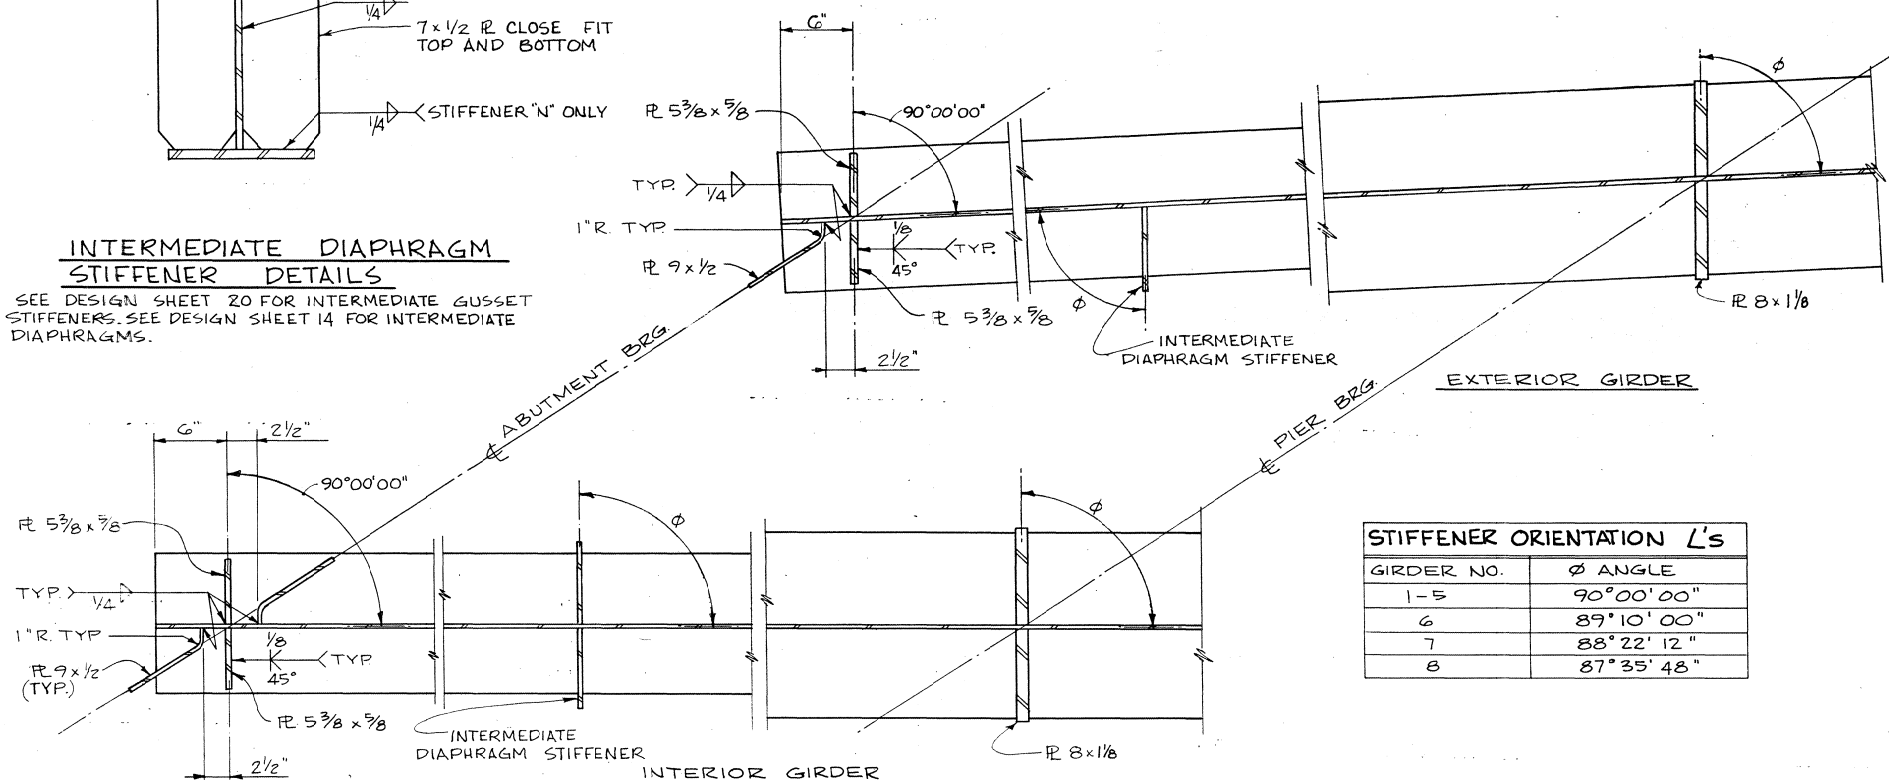

### GIRDER DETAILS

STIFFENER ORIENTATION L's	
GIRDER NO.	Ø ANGLE
1-5	90°00'00"
6	89°10'00"
7	88°22'12"
8	87°35'48"

MOM. IN FOOT-KIPS REACTION IN KIPS LOAD IN KIPS/FOOT	LOAD		POS. MOM. END SPANS		NEG. MOM. @ PIERS		POS. MOM. INT. SPAN		ABUT. REACTION		PIER REACTION	
	EXT.	INT.	EXT.	INT.	EXT.	INT.	EXT.	INT.	EXT.	INT.	EXT.	INT.
DEAD LOAD NO. 1	1.017	1.168	713.2	741.2	1672.7	1799.4	570.8	668.9	35.5	41.1	135.3	155.2
DEAD LOAD NO. 2 *	.523	0.186	438.6	139.7	807.7	251.0	453.8	163.0	20.3	7.2	68.0	24.0
L.L. (TRUCK) + IMPACT	-	-	1200.1	1357.7	-	-	1236.4	1430.4	66.3	70.6	-	-
L.L. (LANE) + IMPACT	-	-	-	-	1097.6	1252.4	-	-	-	-	107.4	118.8
TOTAL	-	-	-	-	3578.0	3302.8	-	-	122.1	118.9	310.7	298.0

\* INCLUDES FUTURE WEARING SURFACE AND BARRIER CURB (BARRIER CURB ASSUMED CARRIED BY EXTERIOR GIRDERS ONLY.)






NOTE: EXTERIOR GIRDER MOMENTS & REACTIONS ARE SHOWN FOR GIRDER #1 OR GIRDER #8, WHICHEVER GOVERNS.

DESIGN FOR 57°03'00" SKEW  
336'-0" X VARI. CONTINUOUS  
WELDED PLATE GIRDER BRIDGE  
102'-6" END SPANS 131'-0" INTERIOR SPAN  
SUPERSTRUCTURE DETAILS  
STATION: 462+88.56 (S.B. LANE, U.S. NO. 561) NOV. 1978  
SCOTT COUNTY  
IOWA DEPARTMENT OF TRANSPORTATION-HIGHWAY DIVISION  
DESIGN SHEET NO. 15 OF 29 FILE NO. 25588 DESIGN NO. 980


SCOTT COUNTY

PROJECT NUMBER

STATE IOWA  
FED. ROAD DIST. NO. 5  
FISCAL YEAR  
SHEET NO. 47  
TOTAL SHEETS 125

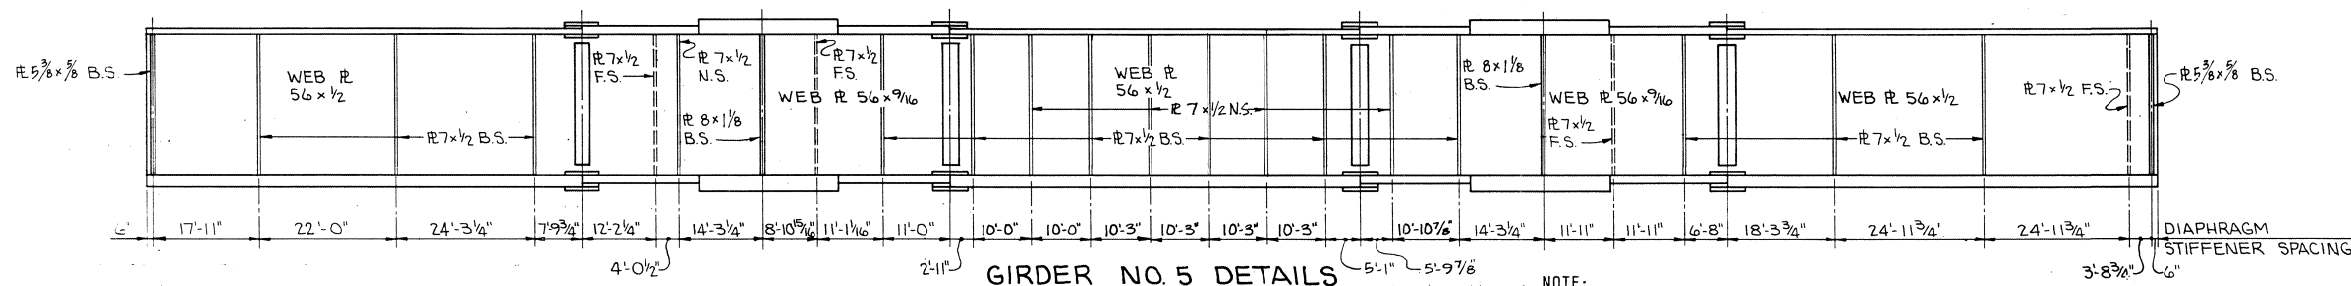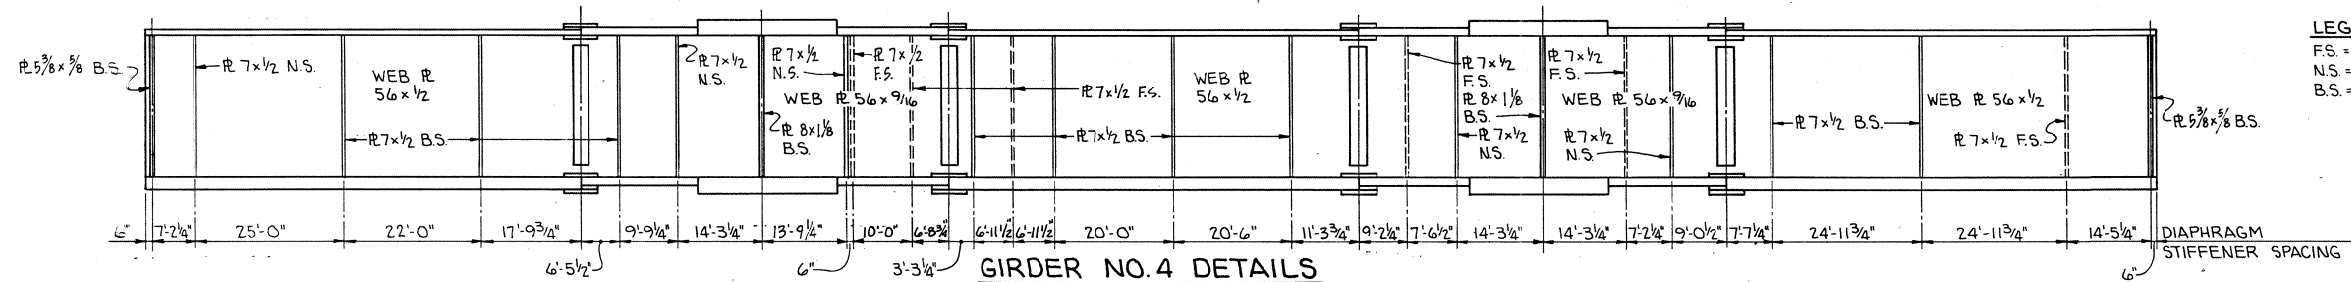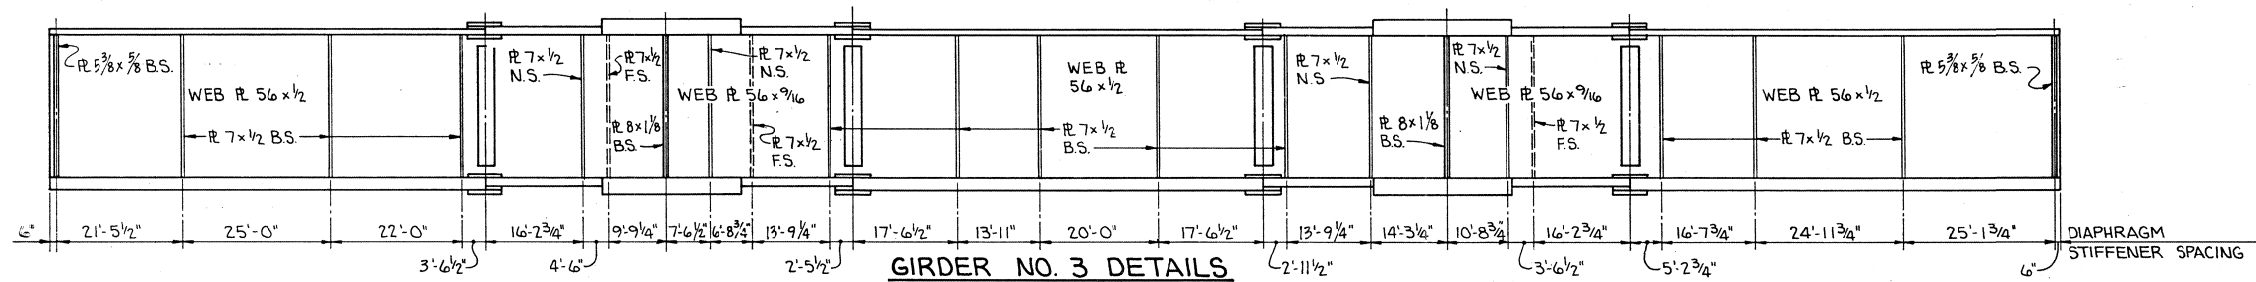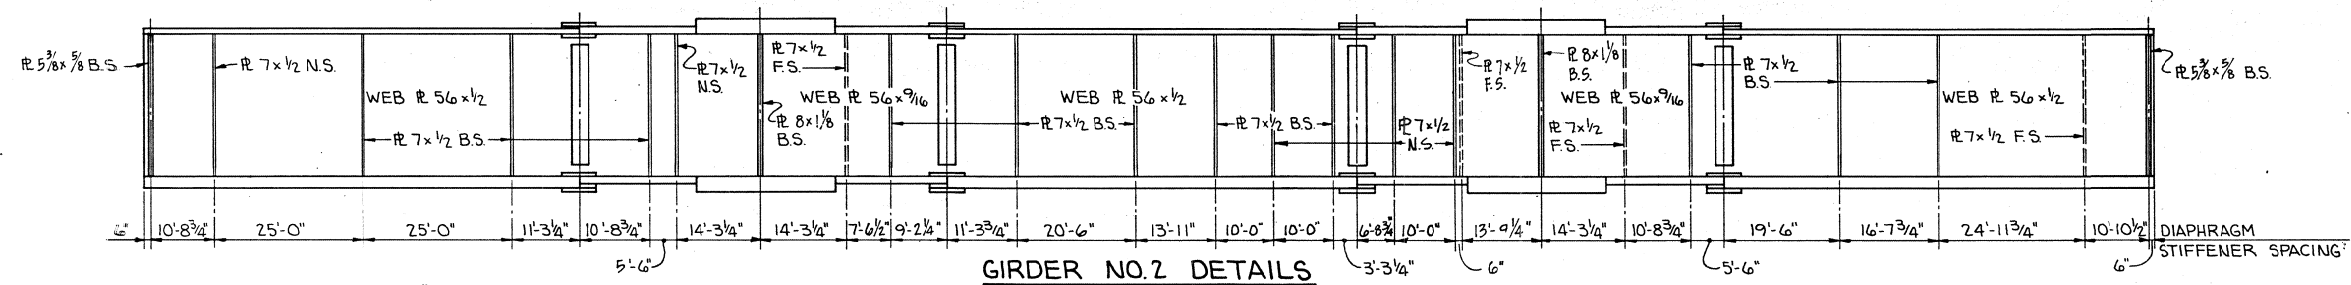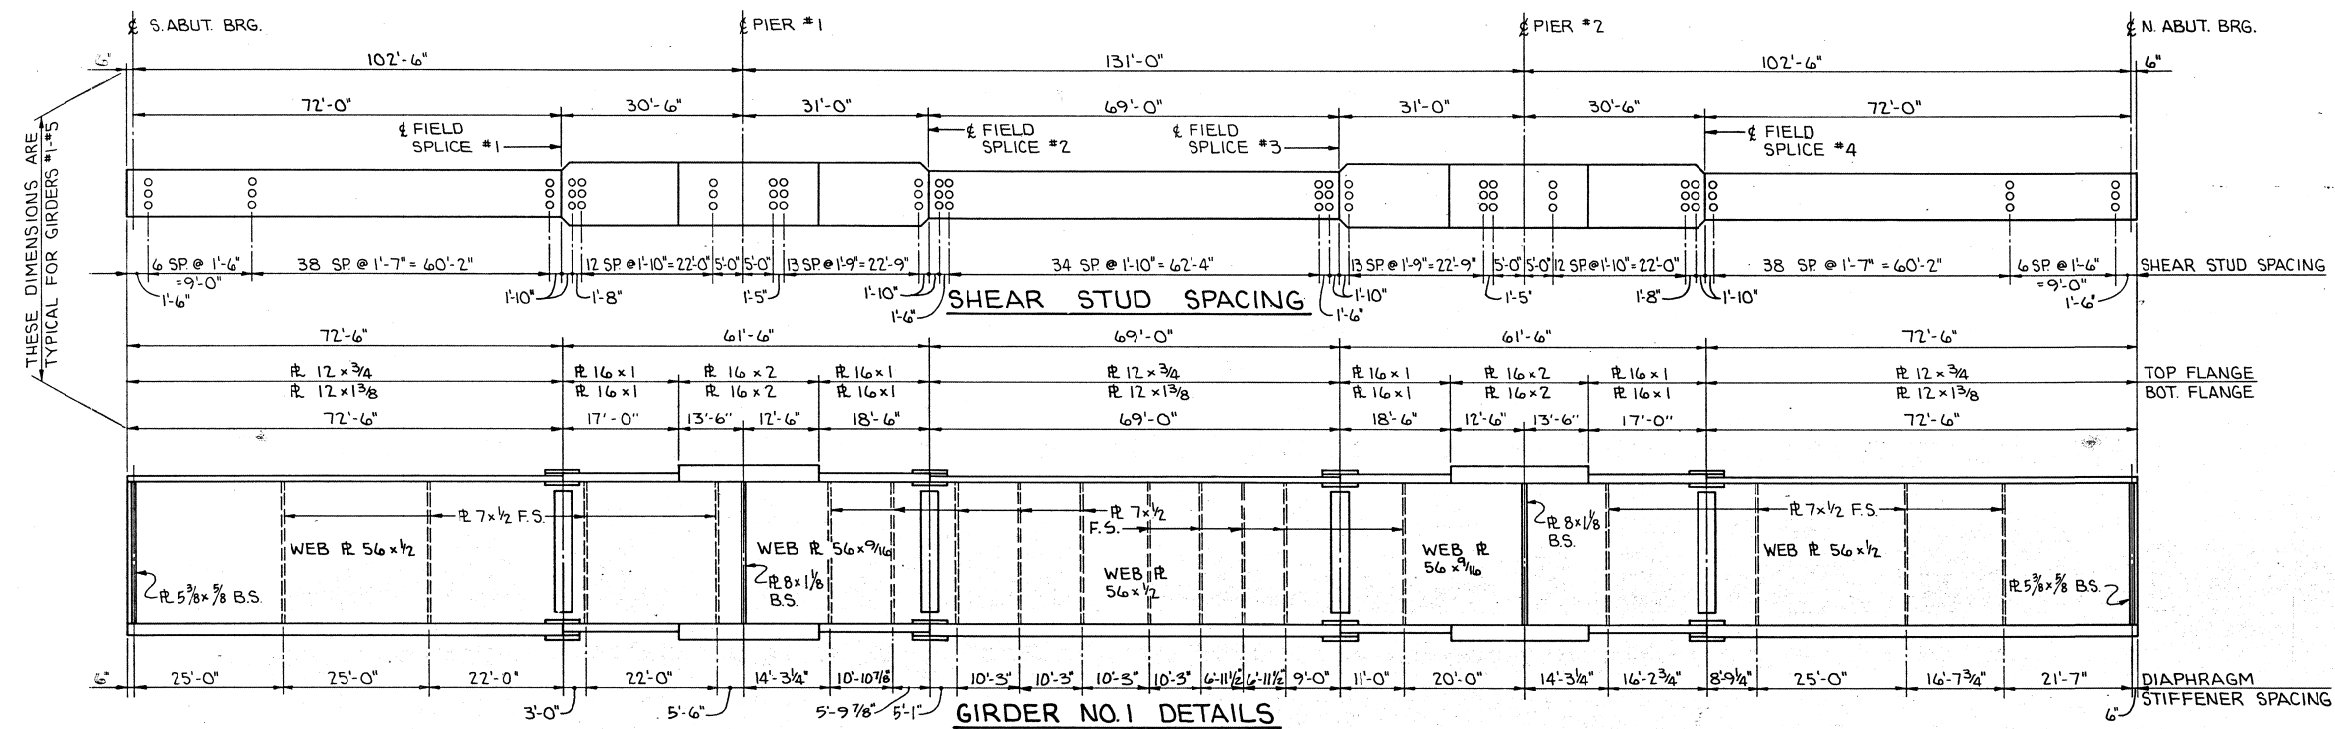

NOTE:  
DIMENSIONS SHOWN IN "GIRDER DETAILS" ARE ALONG & OF GIRDERS  
AND ARE TRUE LENGTHS ALONG GIRDERS.

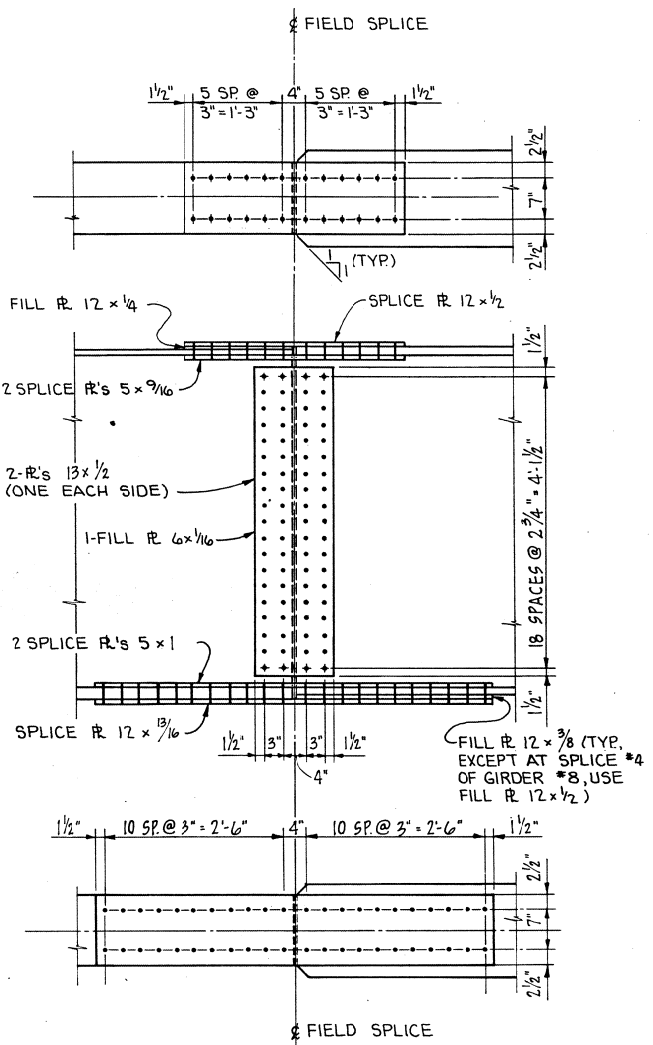


LEGEND:  
FS = FAR SIDE  
NS = NEAR SIDE  
BS = BOTH SIDES

DESIGN FOR 57°03'00" SKEW  
336'-0" X VARI. CONTINUOUS  
WELDED PLATE GIRDER BRIDGE  
102'-6" END SPANS 131'-0" INTERIOR SPAN  
SUPERSTRUCTURE DETAILS  
STATION: 462+88.56 (S.B. LANE, U.S. NO. 561) NOV. 1978  
SCOTT COUNTY  
IOWA DEPARTMENT OF TRANSPORTATION-HIGHWAY DIVISION  
DESIGN SHEET NO. 16 OF 29 FILE NO. 25588 DESIGN NO. 980


SCOTT COUNTY

STATE	FED. ROAD DIST. NO.	FISCAL YEAR	SHEET NO.	TOTAL SHEETS
IOWA	5		48	125




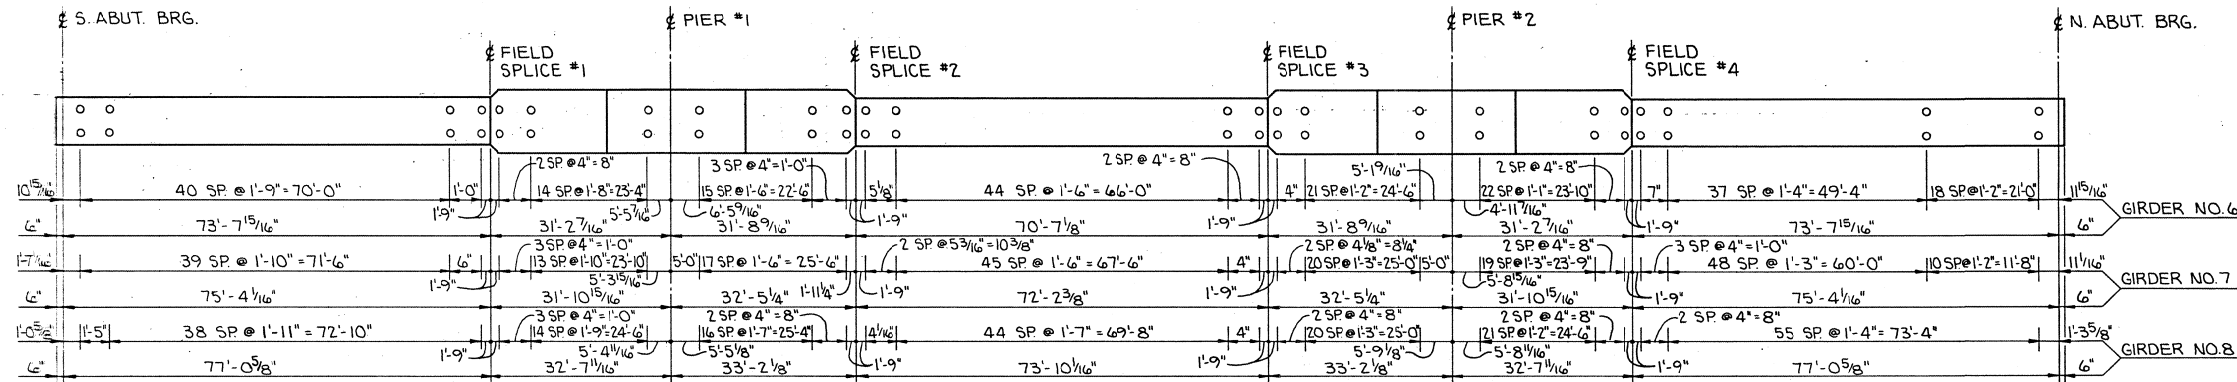


FLANGE TO WEB WELD SIZE	
WELD SIZE	FLANGE THICKNESS
1/4	3/4"
5/16	1", 1 1/8" & 1 1/2"
3/8	2"

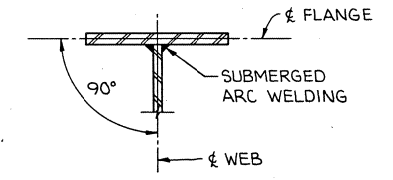

FLANGE TO WEB DETAILS

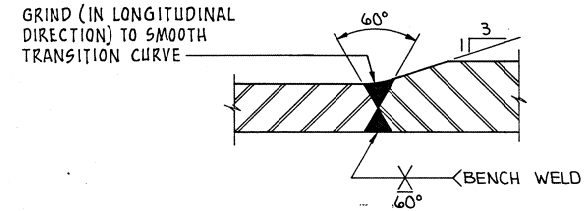

FLANGE WELDED SPLICE PLATE  
NOTE: ALL FLANGE BUTT-WELDED JOINTS ARE WERE TO BE RADIOGRAPHED FULL WIDTH.

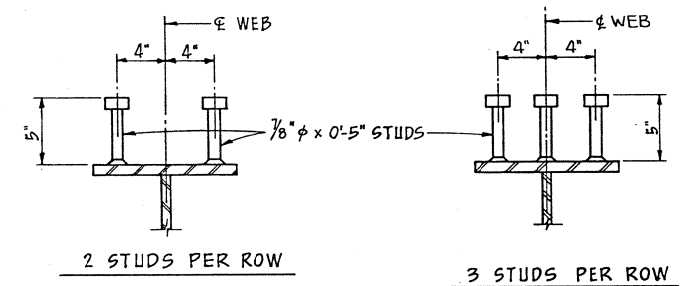

SHEAR STUD DETAILS

LEGEND:  
N.S. = NEAR SIDE  
F.S. = FAR SIDE  
B.S. = BOTH SIDES


LOCATION	$\phi$
GIRDER 5#1-#5	90°00'00"
GIRDER #6	89°10'00"
GIRDER #7	88°22'12"
GIRDER #8	87°35'48"

BEARING ASSEMBLY ORIENTATION ANGLES


NOTE:  
DIMENSIONS SHOWN IN "GIRDER DETAILS" ARE ALONG  $\phi$  OF GIRDERS AND ARE TRUE LENGTHS ALONG GIRDERS.

DESIGN FOR 57°03'00" SKEW  
336'-0" X VARI. CONTINUOUS  
WELDED PLATE GIRDER BRIDGE  
102'-6" END SPANS 131'-0" INTERIOR SPAN  
SUPERSTRUCTURE DETAILS  
STATION: 462+88.56 (S.B. LANE, U.S. NO. 561) NOV.1978  
SCOTT COUNTY  
IOWA DEPARTMENT OF TRANSPORTATION-HIGHWAY DIVISION  
DESIGN SHEET NO.170F29 FILE NO. 25588 DESIGN NO. 980


SHEAR STUD SPACING

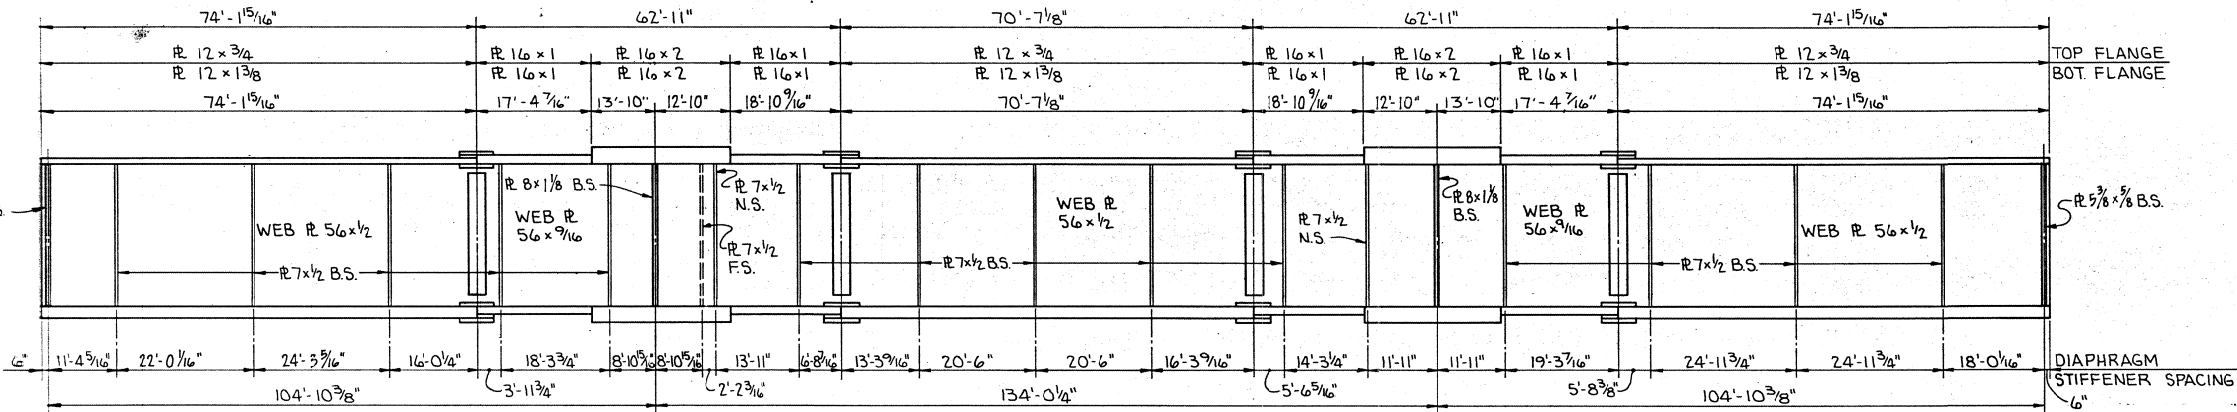


GIRDER NO. 6 DETAILS

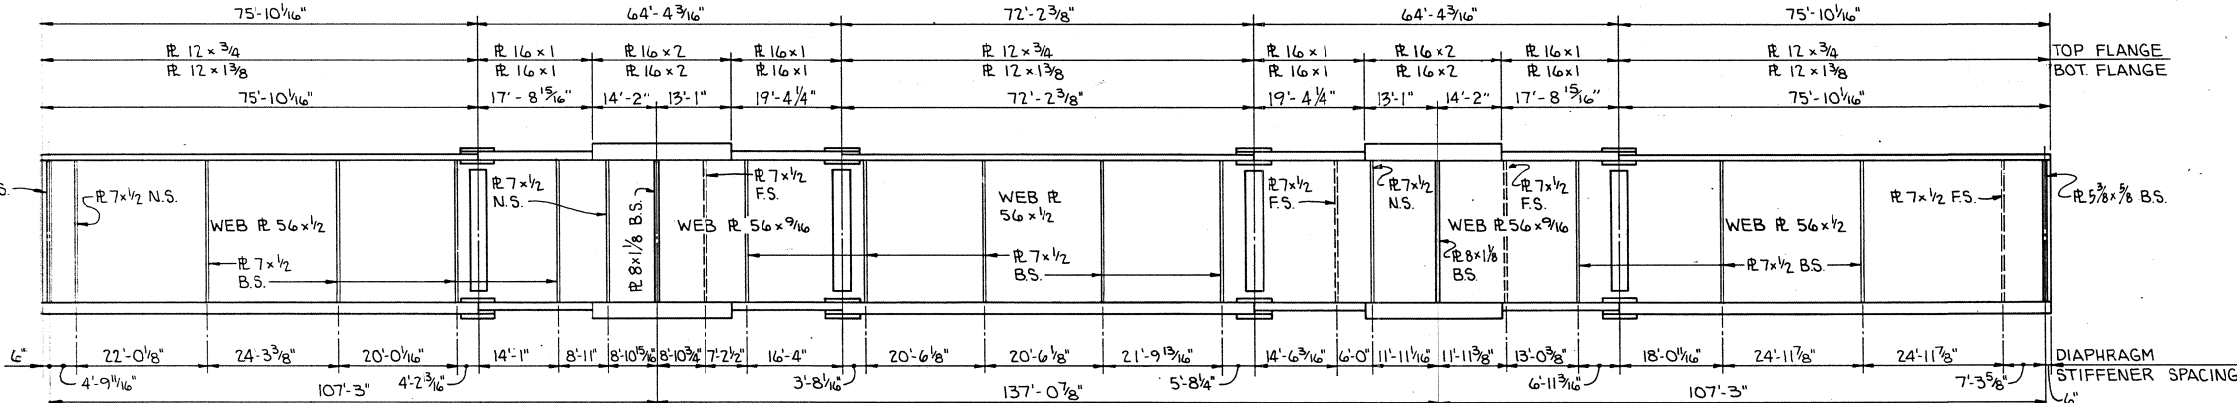

GIRDER NO. 7 DETAILS


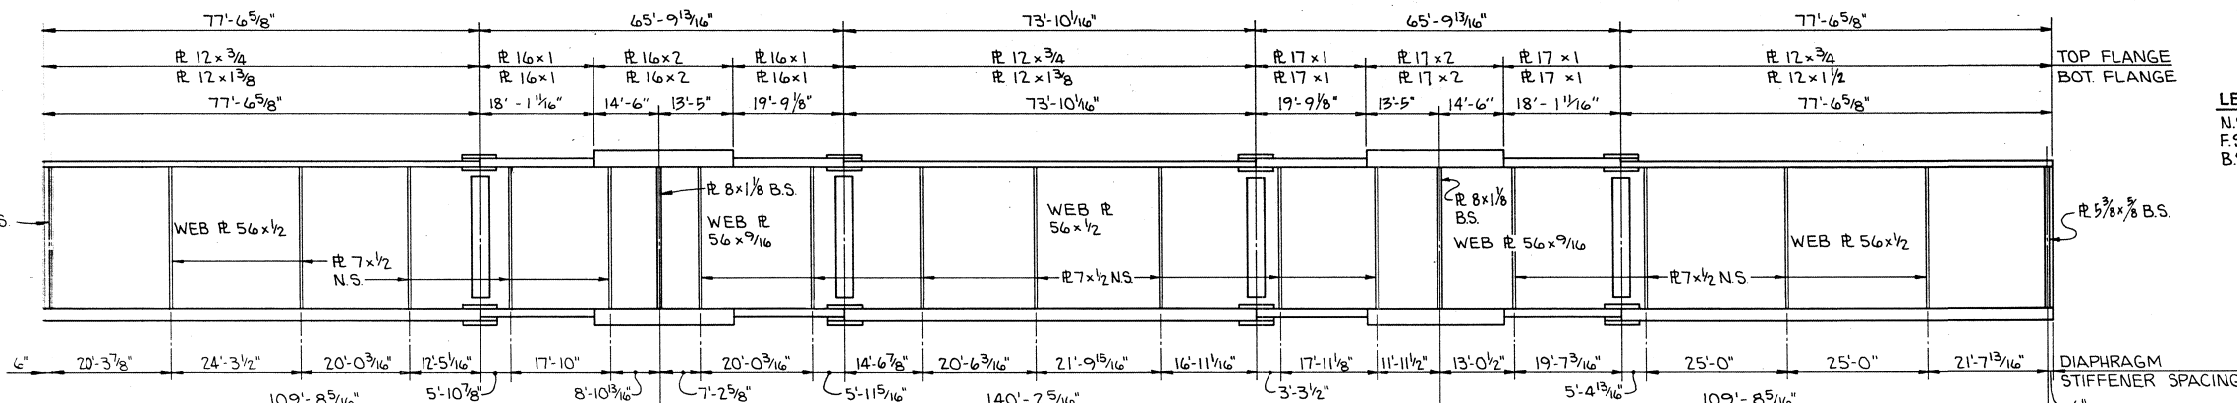


GIRDER NO. 8 DETAILS

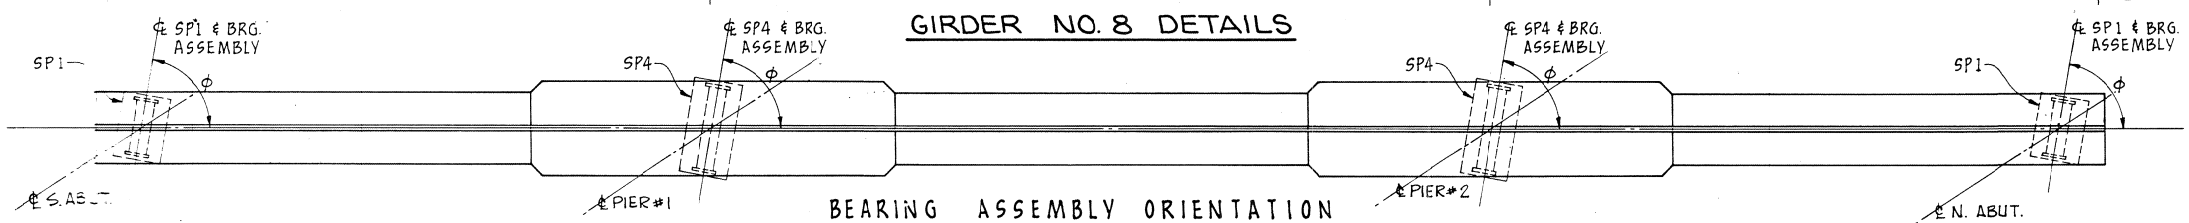

BEARING ASSEMBLY ORIENTATION  
(LOCKING DOWN) (STIFFENERS NOT SHOWN FOR CLARITY)




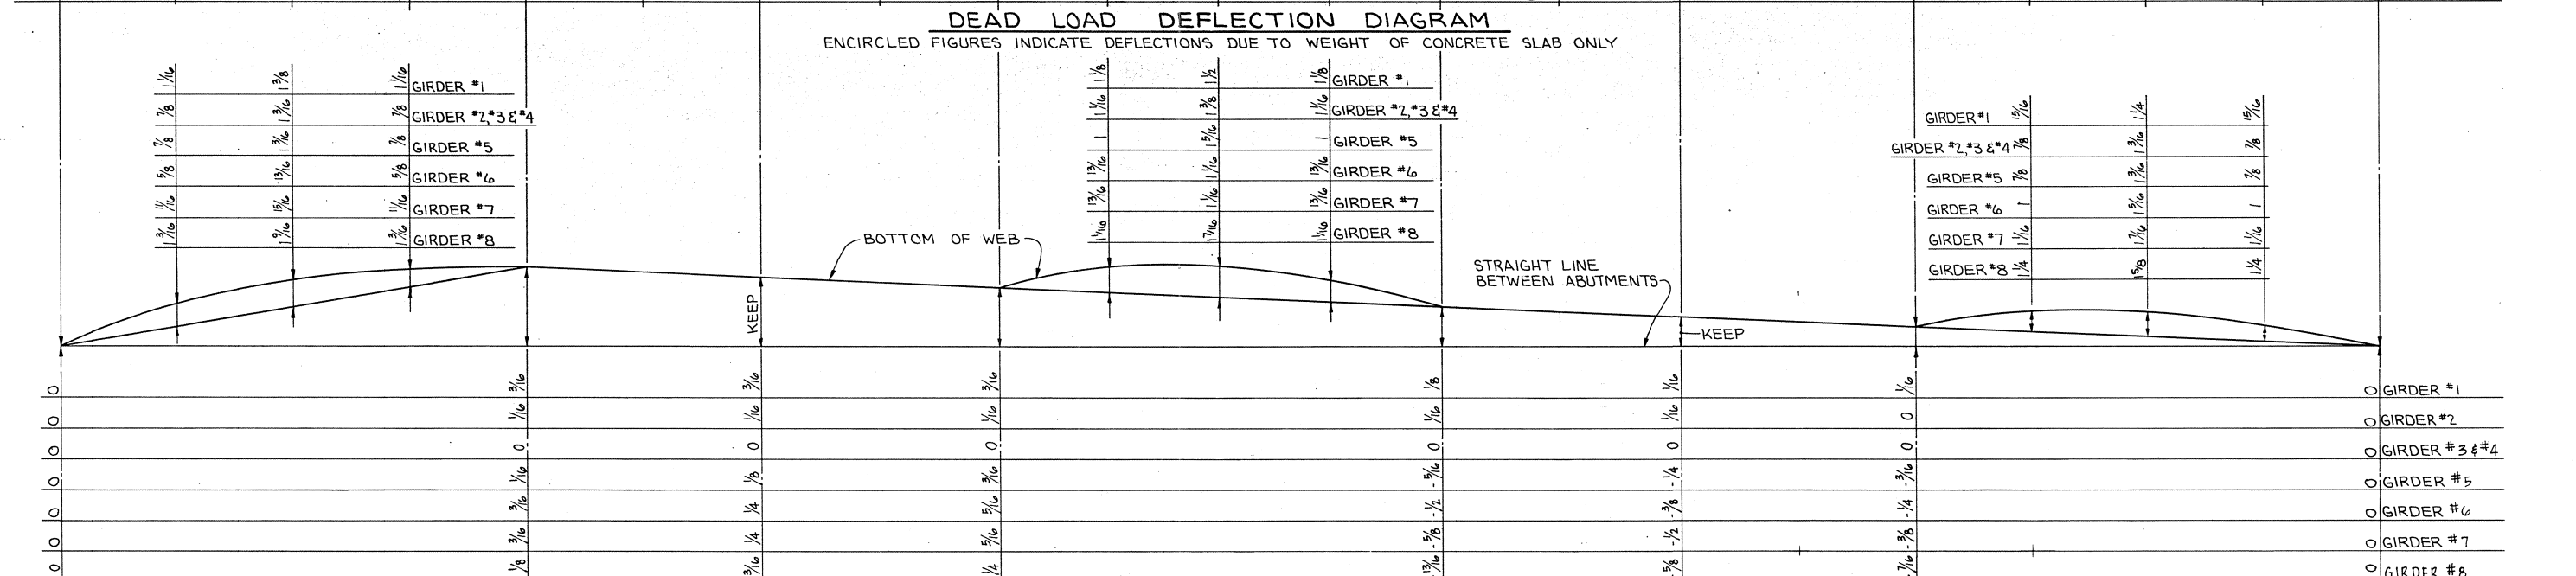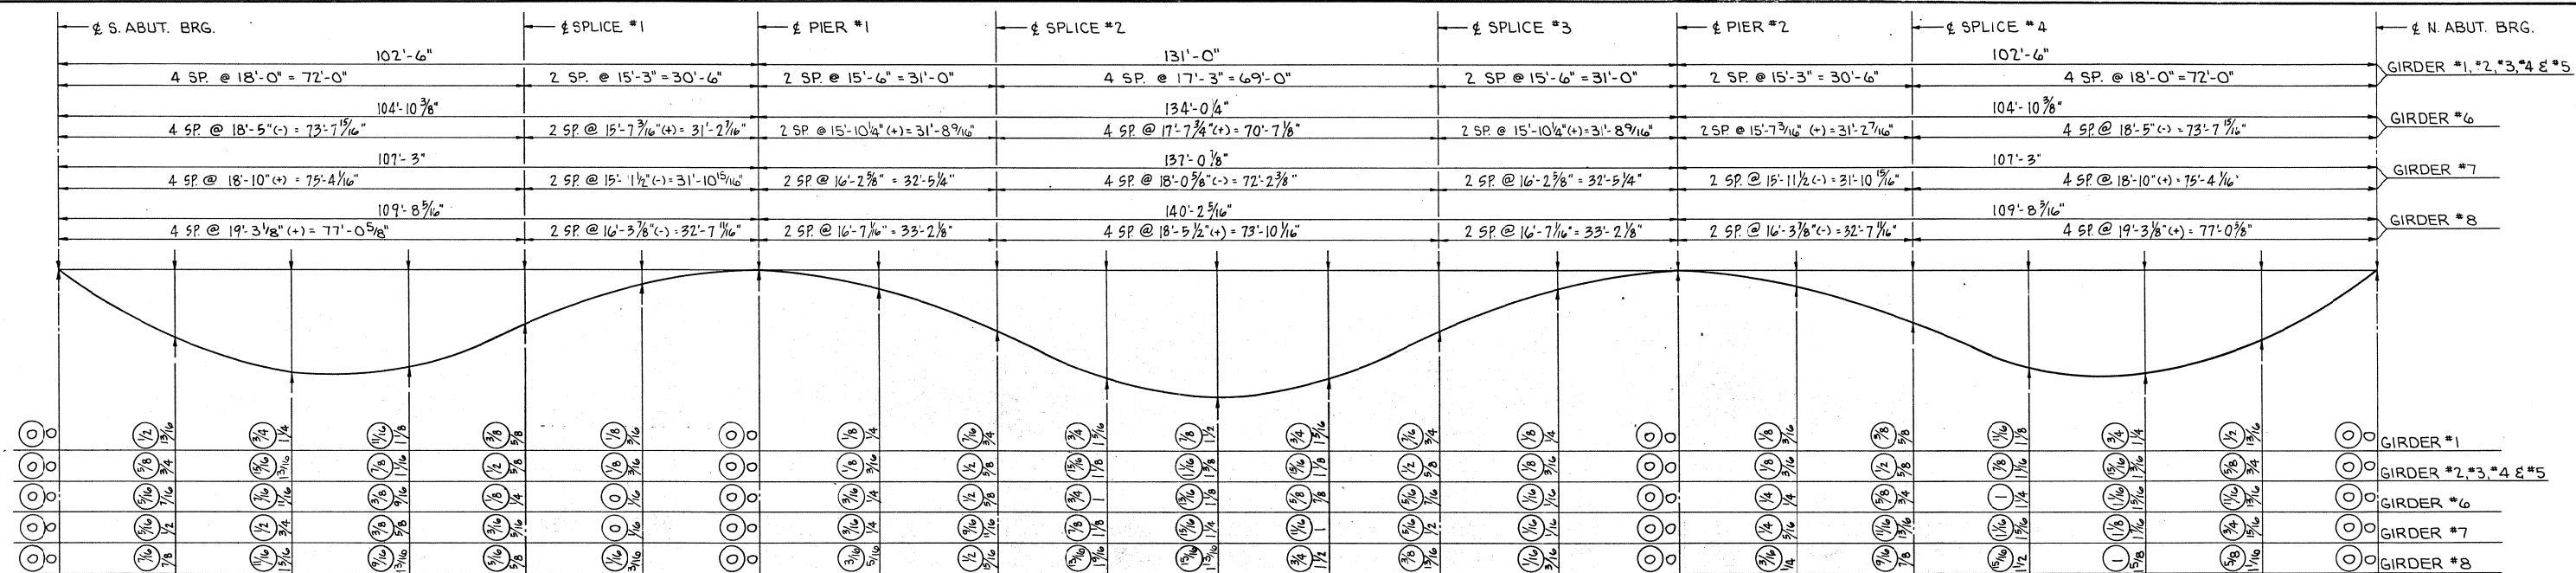


### HAUNCH THICKENING DIAGRAM

FOR ESTIMATING PURPOSES ONLY. MINUS VALUE INDICATES HAUNCH THINNING


DESIGN FOR 57°03'00" SKEW  
336'-0" X VARI. CONTINUOUS  
WELDED PLATE GIRDER BRIDGE  
102'-6" END SPANS 131'-0" INTERIOR SPAN  
SUPERSTRUCTURE DETAILS  
STATION: 462+88.56 (± S.B. LANE. U.S. NO. 561) NOV. 1978  
SCOTT COUNTY  
IOWA DEPARTMENT OF TRANSPORTATION-HIGHWAY DIVISION  
DESIGN SHEET NO. 18 OF 29 FILE NO. 25588 DESIGN NO. 980

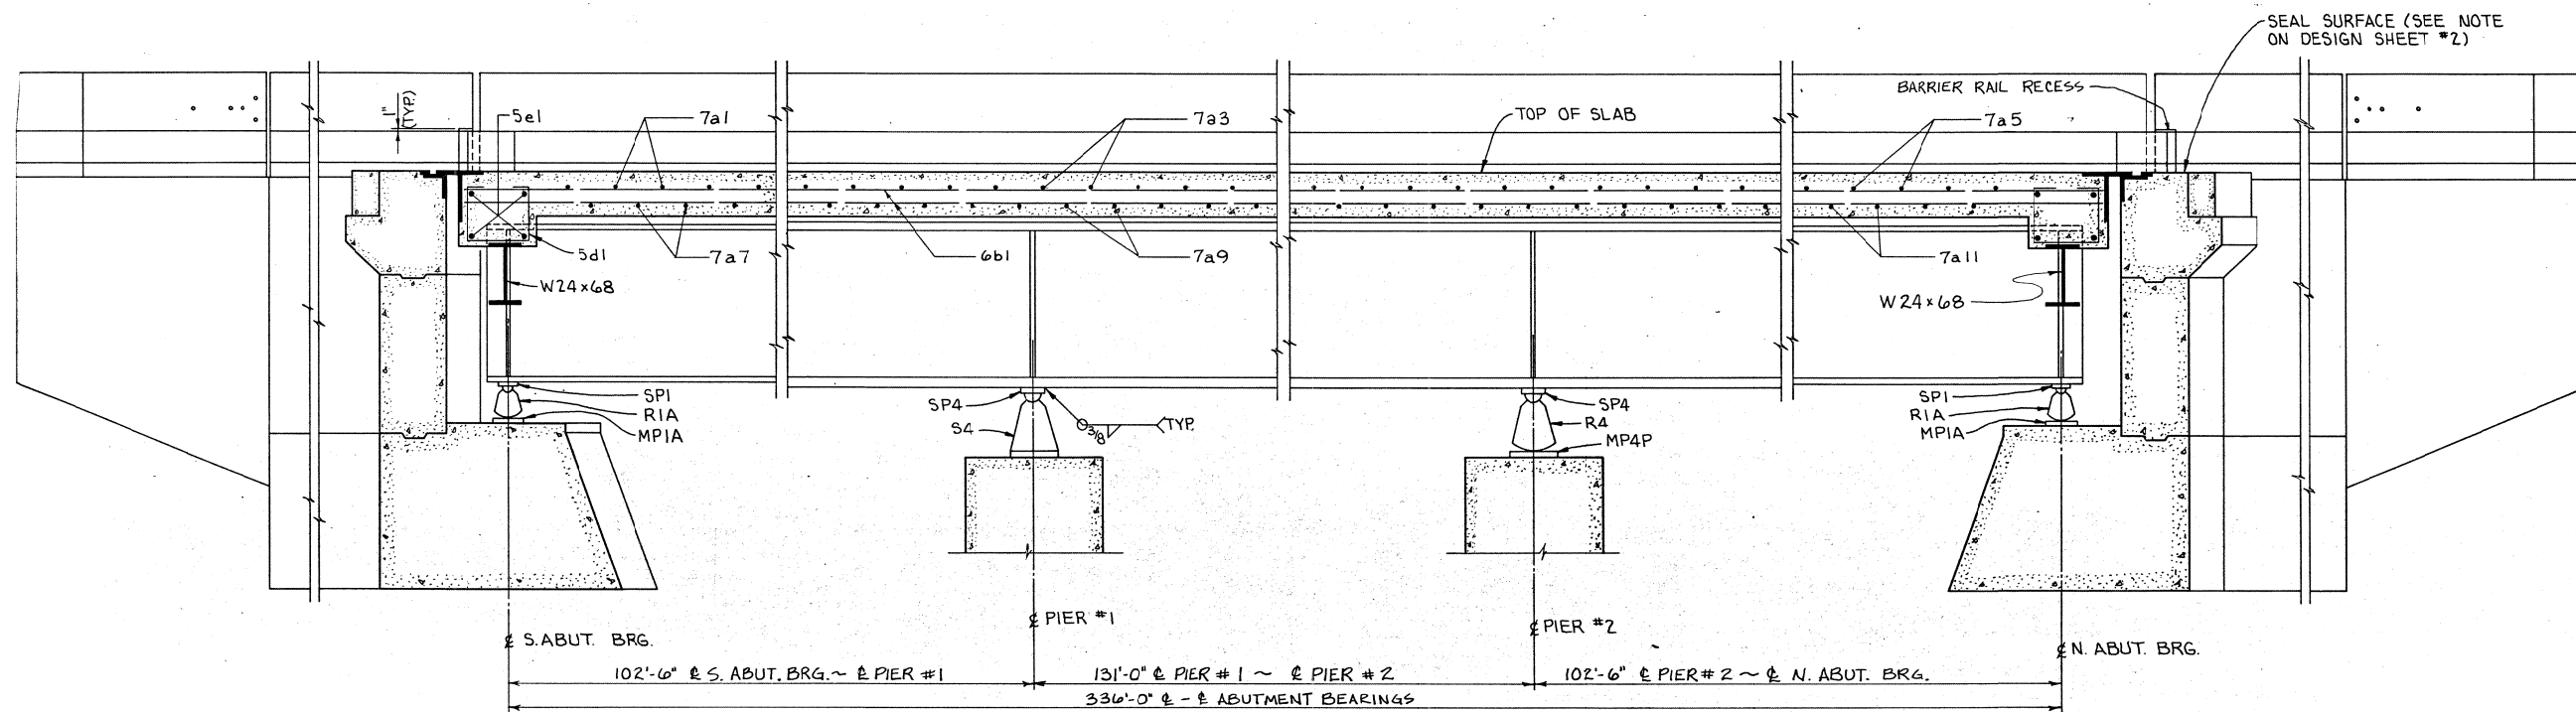

PART LONGITUDINAL SECTION NEAR EXTERIOR GIRDER

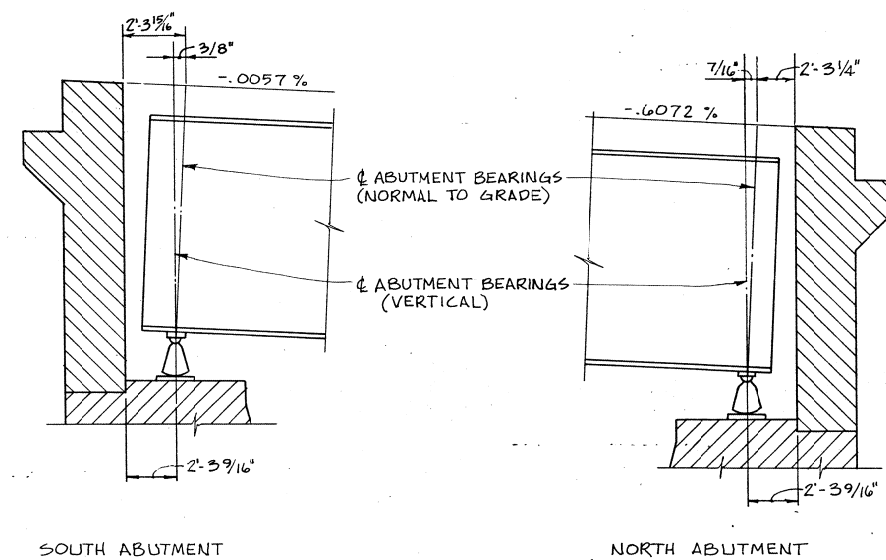


PART LONGITUDINAL SECTION  
(SHOWING GRADE VARIATIONS ALONG SOUTHBOUND ROADWAY AT ABUTMENTS)

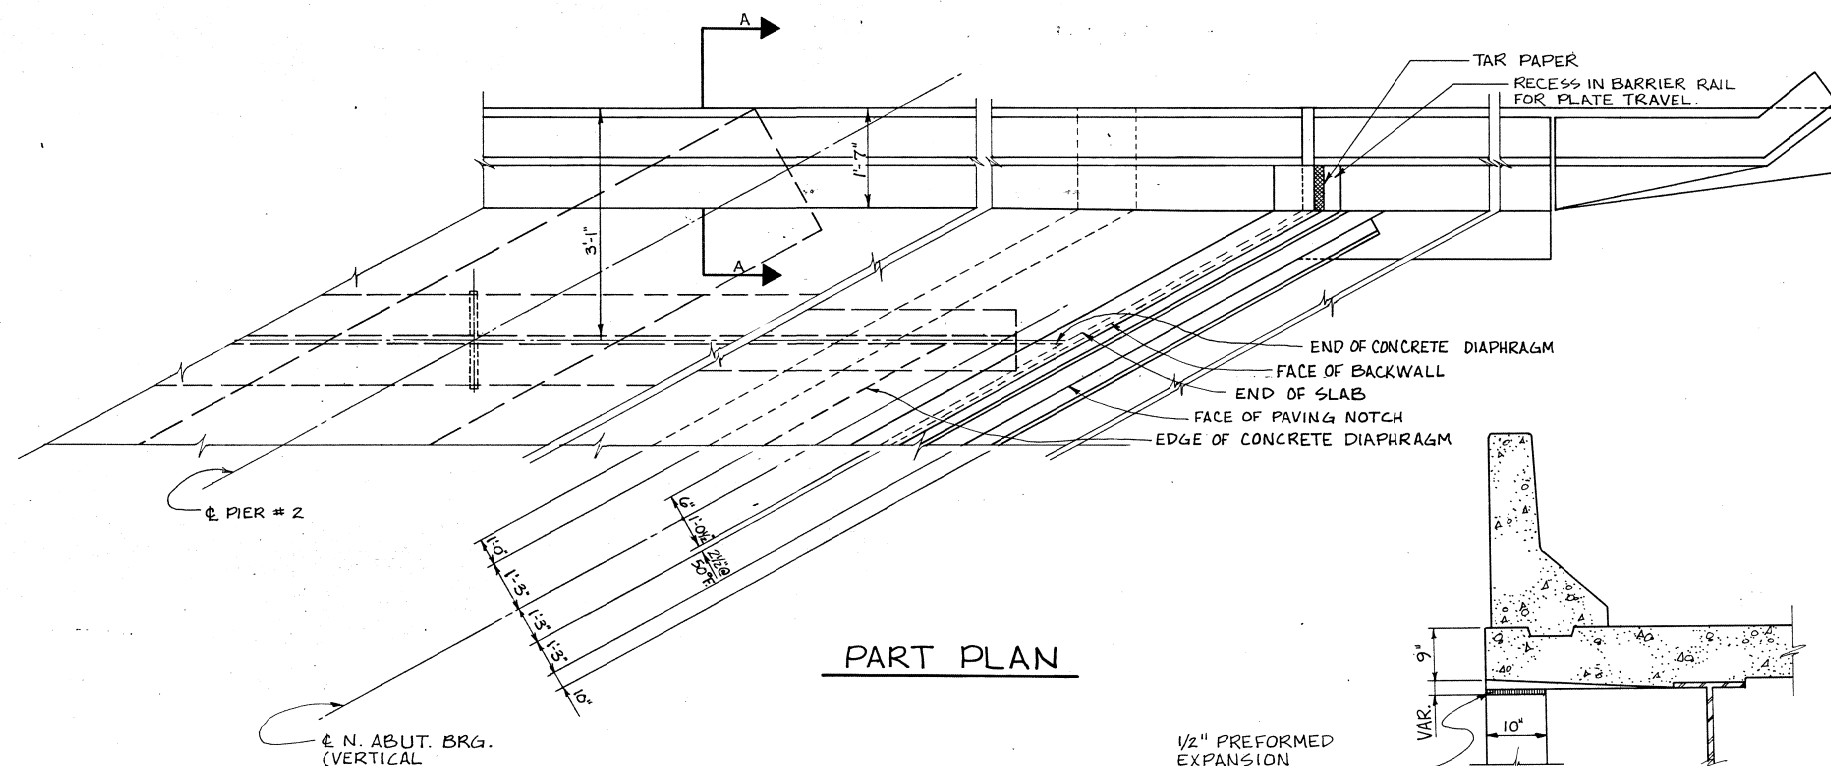

PART PLAN

1/2" PREFORMED  
EXPANSION  
JOINT FILLER

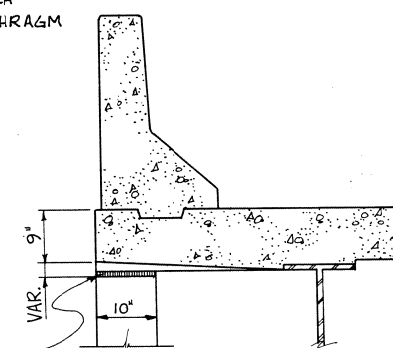

SECTION A-A

ROCKER AND EXPANSION PLATE SETTINGS					
TEMP. @ TIME OF SETTING (F)	SOUTH ABUTMENT	PIER #1	PIER #2	NORTH ABUTMENT	
10°	2 13/16"	-5/16"	-7/16"	-3/4"	3 1/4"
50°	2 1/2"	0	0	0	2 1/2"
90°	2 3/16"	+5/16"	+7/16"	+3/4"	1 3/4"


NOTE: TILT ROCKERS IN DIRECTION SHOWN FOR TEMP. ABOVE 50°F. AND IN THE OPPOSITE DIRECTION FOR TEMP. BELOW 50°. SETTINGS FOR OTHER TEMP. ARE PROPORTIONAL.

DESIGN FOR 57°03'00" SKEW  
336'-0" X VARI. CONTINUOUS  
WELDED PLATE GIRDER BRIDGE  
102'-6" END SPANS 131'-0" INTERIOR SPAN  
SUPERSTRUCTURE DETAILS  
STATION: 462+88.56 (S.B. LANE, U.S. NO. 561) NOV. 1978  
SCOTT COUNTY  
IOWA DEPARTMENT OF TRANSPORTATION-HIGHWAY DIVISION  
DESIGN SHEET NO. 19 OF 29 FILE NO. 25588 DESIGN NO. 980

SCOTT COUNTY


PROJECT NUMBER

STATE IOWA  
FED. ROAD DIST. NO. 5  
FISCAL YEAR  
SHEET NO. 51  
TOTAL SHEETS 125

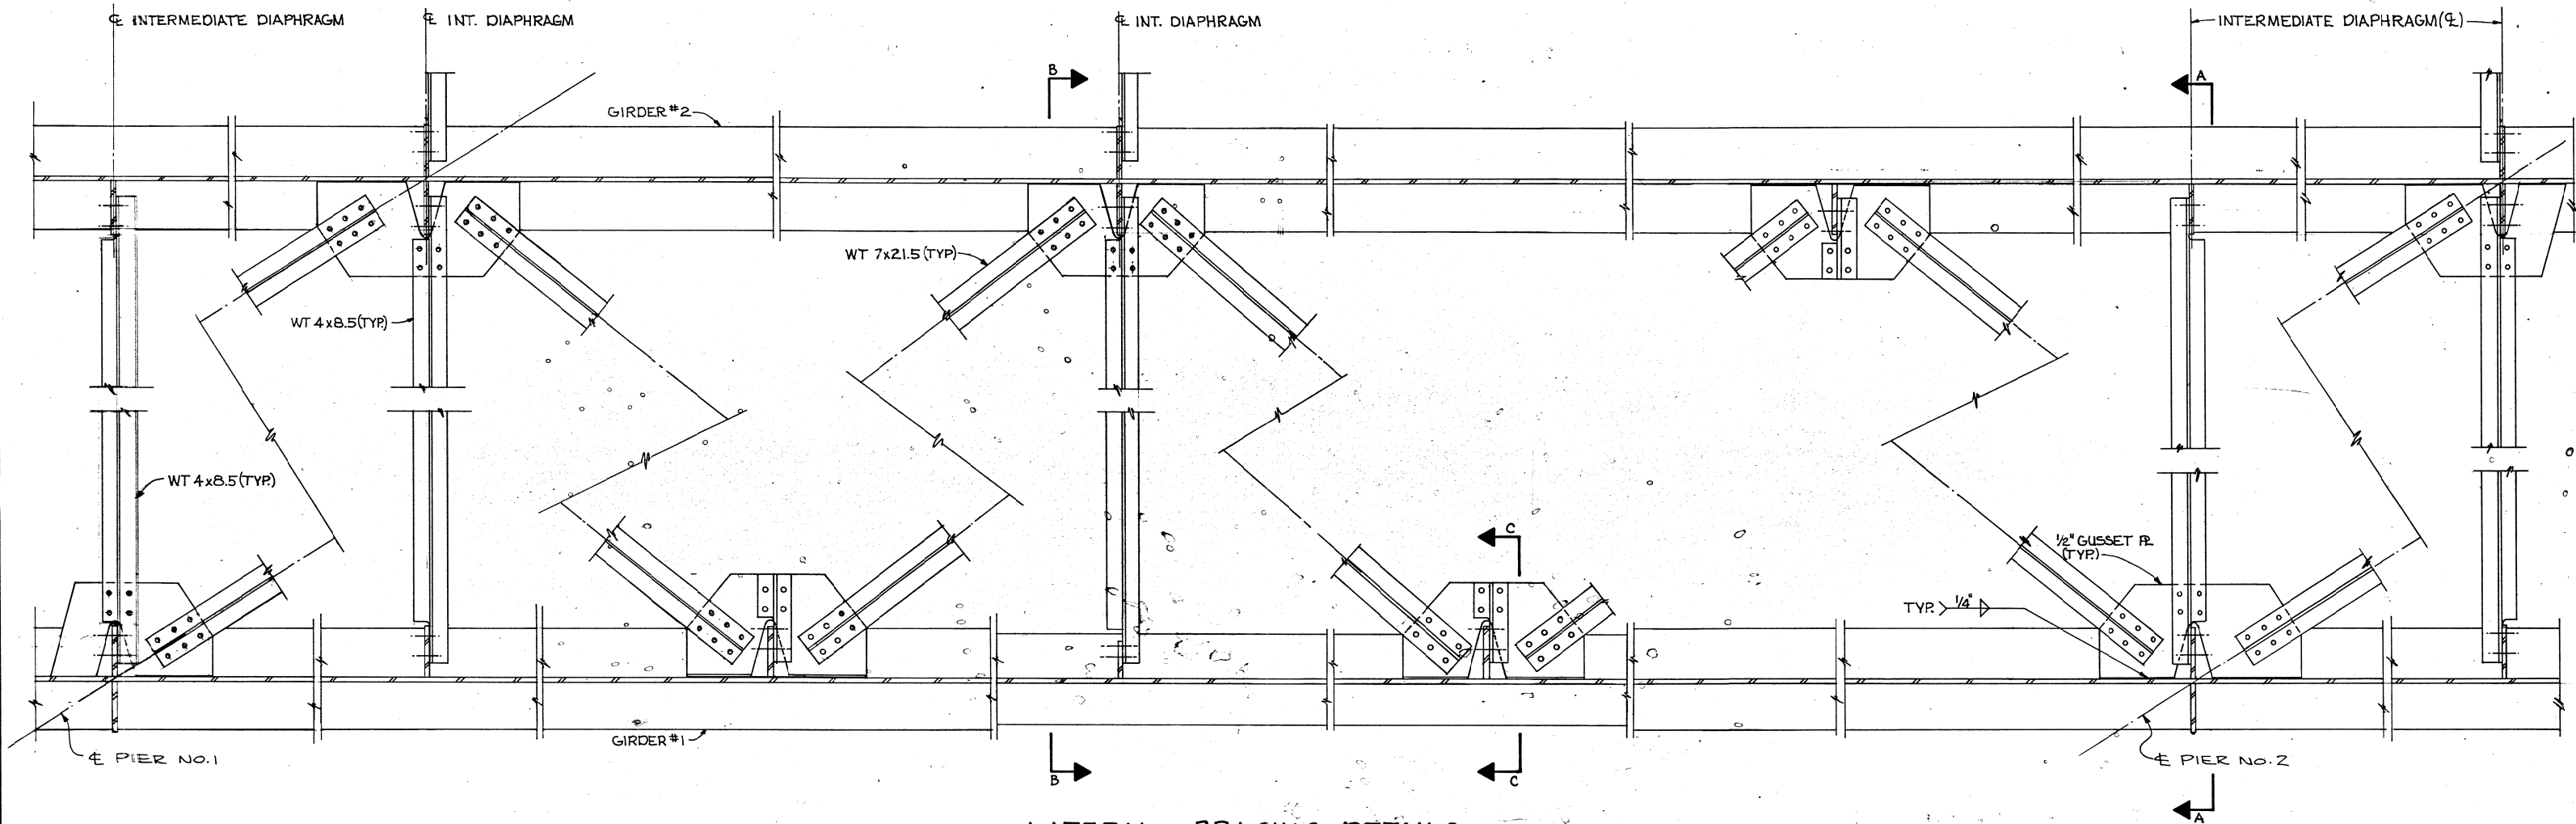


### LATERAL BRACING DETAILS


(SEE SHT. NO. 15 FOR STRUCTURAL STEEL LAYOUT  
TYPICAL FOR LATERAL BRACING BETWEEN GIRDERS 4 & 5).

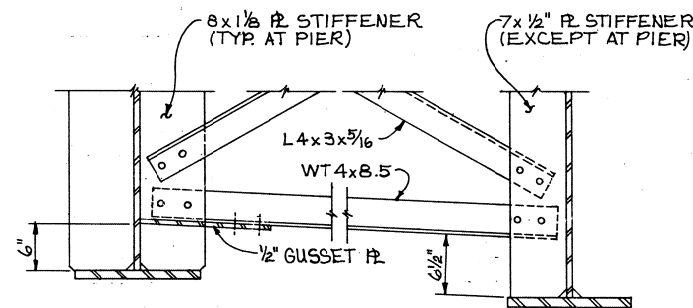


SECTION A-A

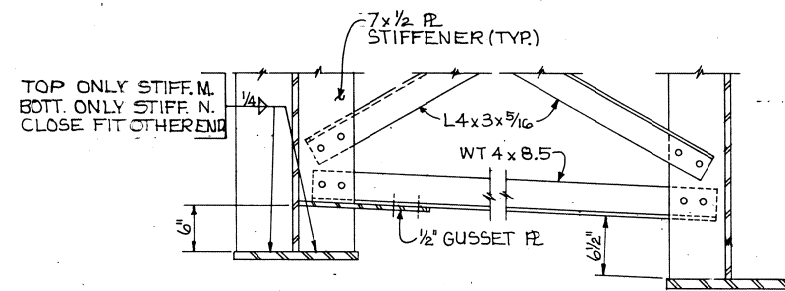


SECTION B-B

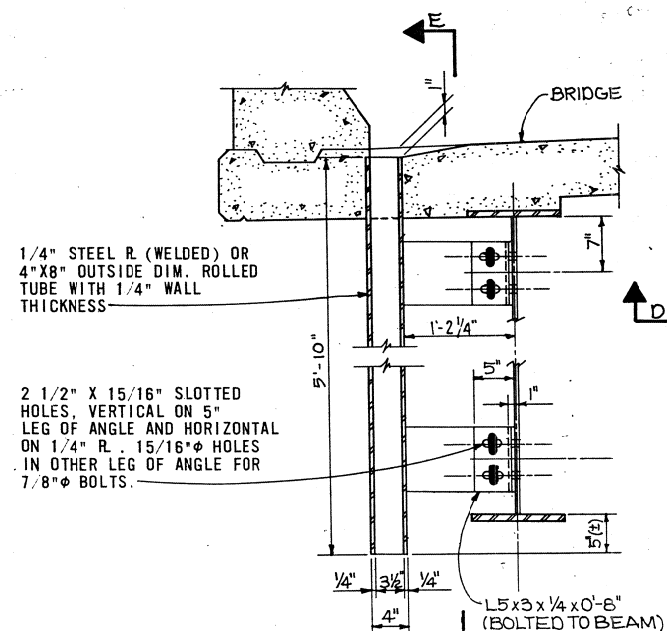


SECTION D-D

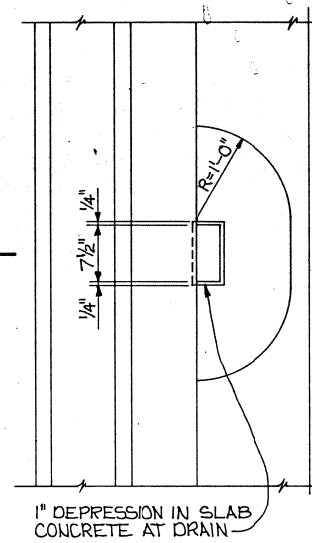

PART PLAN  
DRAIN DETAILS

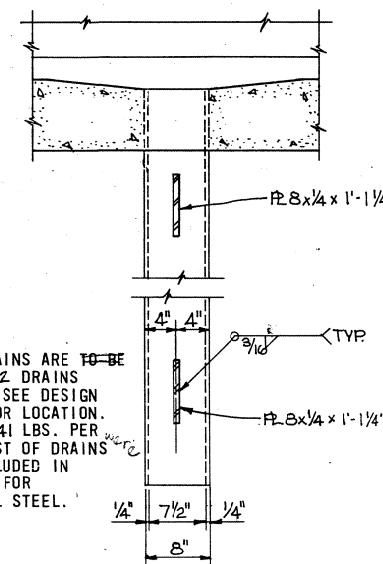

SECTION E-E

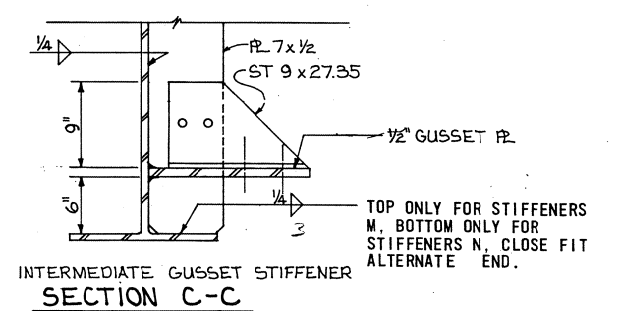

INTERMEDIATE GUSSET STIFFENER  
SECTION C-C

DESIGN FOR 57°03'00" SKEW  
336'-0" X VARI. CONTINUOUS  
WELDED PLATE GIRDER BRIDGE  
102'-6" END SPANS 131'-0" INTERIOR SPAN  
SUPERSTRUCTURE DETAILS  
STATION: 462+88.56 (± S.B. LANE, U.S. NO. 561) NOV. 1978  
SCOTT COUNTY  
IOWA DEPARTMENT OF TRANSPORTATION-HIGHWAY DIVISION  
DESIGN SHEET NO. 20 OF 29 FILE NO. 25588 DESIGN NO. 980

SCOTT COUNTY

PROJECT NUMBER	STATE	FED. ROAD DIST. NO.	FISCAL YEAR	SHEET NO.	TOTAL SHEETS
	IOWA	5		52	125

53 130



## EPOXY-COATING NOTES:

ALL TOP OF SLAB REINFORCING STEEL, BOTH LONGITUDINAL AND TRANSVERSE BARS, SHALL BE EPOXY-COATED IN ACCORDANCE WITH CURRENT SPECIAL PROVISIONS AND SUPPLEMENTAL SPECIFICATIONS OF THE IOWA D.O.T. HIGHWAY DIVISION.

FROM THE REINFORCING BAR LIST SHOWN ON THIS SHEET, THE FOLLOWING BARS SHALL BE EPOXY-COATED:

ALL OF THE 7a1 BARS = 5807  
ALL OF THE 7a2 BARS = 23,877  
ALL OF THE 7a3 BARS = 17,936  
ALL OF THE 7a4 BARS = 4131  
369 OF THE 6b1 BARS = 21,661  
156 OF THE 6b2 BARS = 9372  
104 OF THE 6b3 BARS = 5558  
ALL OF THE 5d1 BARS = 289  
ALL OF THE 7a5 BARS = 1377  
ALL OF THE 7a6 BARS = 3663

6 OF THE 5e1 BARS = 221  
6 OF THE 5e2 BARS = 278  
EAST BARRIER RAIL = 6887  
WEST BARRIER RAIL = 7402

TOTAL = 108,459 LBS. TO BE EPOXY-COATED

## ESTIMATED QUANTITIES - SUPERSTRUCTURE

ITEM	UNIT	QUANTITY
STRUCTURAL CONCRETE, CLASS "D"	CU. YD.	556.8
REINFORCING STEEL	LBS.	87,876
REINFORCING STEEL - EPOXY COATED	LBS.	108,459
* STRUCTURAL STEEL - A36	LBS.	719,075

Δ INCLUDES QUANTITIES FOR THE BARRIER RAIL INCLUDING THE END SECTIONS (SEE DESIGN SHEET NO. 27 & 28)

\* INCLUDES 1692 LBS. OF DRAINS AND 614 LBS. OF LEAD PLATES.


## CONCRETE PLACEMENT QUANTITIES

LOCATION	SIDE A	SIDE B
SECTION 1	48.1	64.0
SECTION 2	69.9	61.8
SECTION 3	54.4	58.3
SECTION 4	44.0	51.7
SECTION 5	52.9	51.7
TOTAL(CU. YD.)	269.3	287.5


## REINFORCING STEEL - SUPERSTRUCTURE

BAR	LOCATION	SHAPE	NO.	LENGTH	WEIGHT
7a1	SLAB, TRANSVERSE, TOP	—	103	VARIES	5807
7a2	SLAB, TRANSVERSE, TOP	—	326	VARIES	23,877
7a3	SLAB, TRANSVERSE, TOP	—	326	26'-11"	17,936
7a4	SLAB, TRANSVERSE, TOP	—	49	41'-3"	4131
7a5	SLAB, TRANSVERSE, TOP	—	49	VARIES	1377
7a6	SLAB, TRANSVERSE, TOP	—	84	VARIES	3663
7a7	SLAB, TRANSVERSE, BOTTOM	—	102	VARIES	5751
7a8	SLAB, TRANSVERSE, BOTTOM	—	327	VARIES	20,887
7a9	SLAB, TRANSVERSE, BOTTOM	—	327	31'-8"	21,054
7a10	SLAB, TRANSVERSE, BOTTOM	—	58	36'-8"	4347
7a11	SLAB, TRANSVERSE, BOTTOM	—	58	VARIES	1887
7a12	SLAB, TRANSVERSE, BOTTOM	—	74	VARIES	2899
6b1	SLAB, LONGITUDINAL	—	684	39'-1"	40,153
6b2	SLAB, LONGITUDINAL	—	282	40'-0"	16,943
6b3	SLAB, LONGITUDINAL	—	188	35'-7"	10,048
5d1	SLAB HOOPS @ ABUTMENT DIAPHRAGM	□	64	4'-4"	289
5e1	SLAB TRANSVERSE @ ABUT. DIAPHRAGM	—	12	35'-3"	441
5e2	SLAB TRANSVERSE @ ABUT. DIAPHRAGM	—	12	44'-5"	556
	EAST BARRIER RAIL(SEE DES.SHT.27)				6887
	WEST BARRIER RAIL(SEE DES.SHT.28)				7402
SEE EPOXY COATING NOTES ON THIS SHEET					TOTAL(LBS.) 196,335

## BENT BAR DETAILS

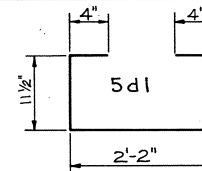

NOTE:  
ALL DIMENSIONS ARE  
OUT TO OUT.

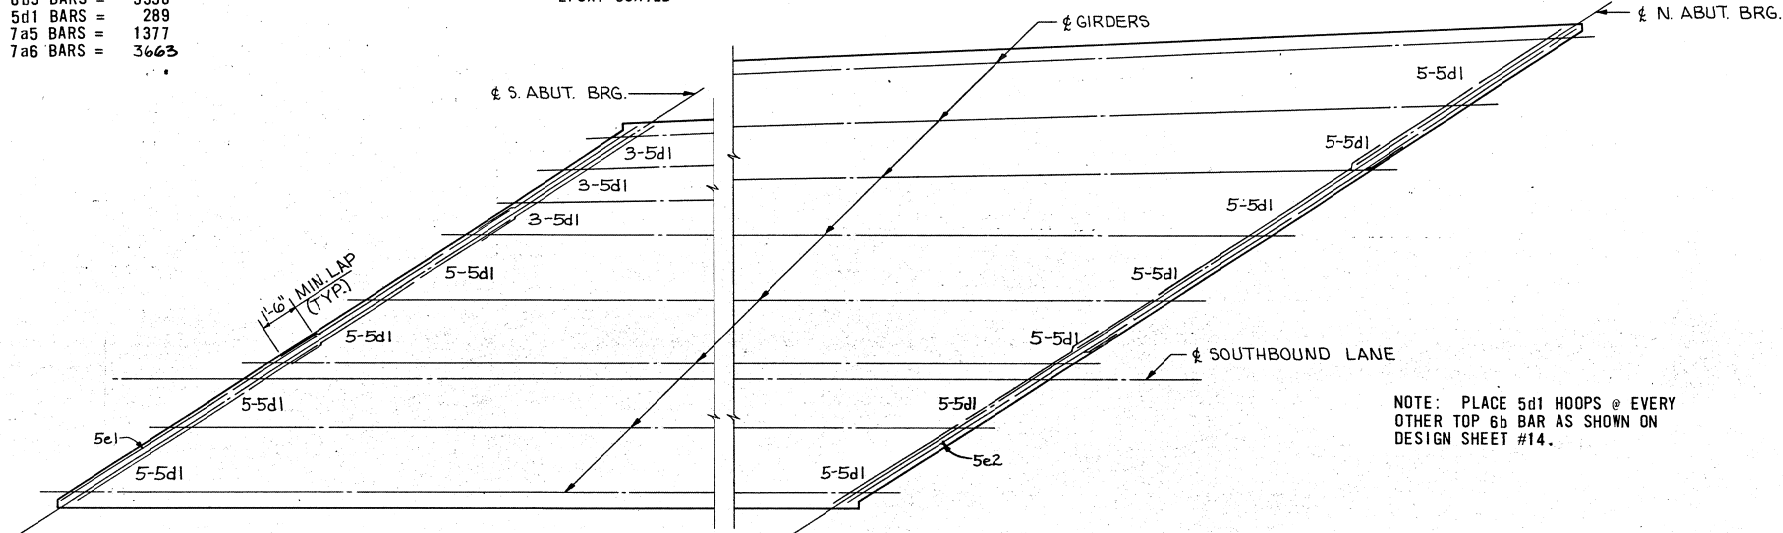ABUTMENT DIAPHRAGM HOOP  
PLACEMENT DIAGRAM

## CONCRETE PLACEMENT DIAGRAM

## NOTE:

ROADWAY SLAB SHALL BE PLACED IN SECTIONS AND IN SEQUENCE INDICATED BY ENCLOSED NUMBERS ON PLACEMENT DIAGRAM AND PREFERABLY AT INTERVALS NOT EXCEEDING 24 HOURS. ALL SLAB REINFORCING STEEL IS TO BE IN PLACE BEFORE ANY SECTION IS POURED. ALTERNATE PROCEDURES FOR PLACING CONCRETE MAY BE SUBMITTED FOR APPROVAL, TOGETHER WITH A STATEMENT OF THE PROPOSED METHOD AND EVIDENCE THAT THE CONTRACTOR POSSESSES THE NECESSARY EQUIPMENT AND FACILITIES TO ACCOMPLISH THE REQUIRED RESULT.

DESIGN FOR 57°03'00" SKEW  
336'-0" X VARI. CONTINUOUS  
WELDED PLATE GIRDER BRIDGE  
102'-6" END SPANS 131'-0" INTERIOR SPAN  
SUPERSTRUCTURE DETAILS  
STATION: 462+88.56 (S.B. LANE, U.S. NO. 561) NOV.1978  
SCOTT COUNTY  
IOWA DEPARTMENT OF TRANSPORTATION-HIGHWAY DIVISION  
DESIGN SHEET NO. 21 OF 29 FILE NO. 25588 DESIGN NO. 980

SCOTT

COUNTY

PROJECT NUMBER

STATE

FED. ROAD

DIST. NO.

FISCAL

YEAR

SHEET

NO.


TOTAL

IOWA


5

53

125

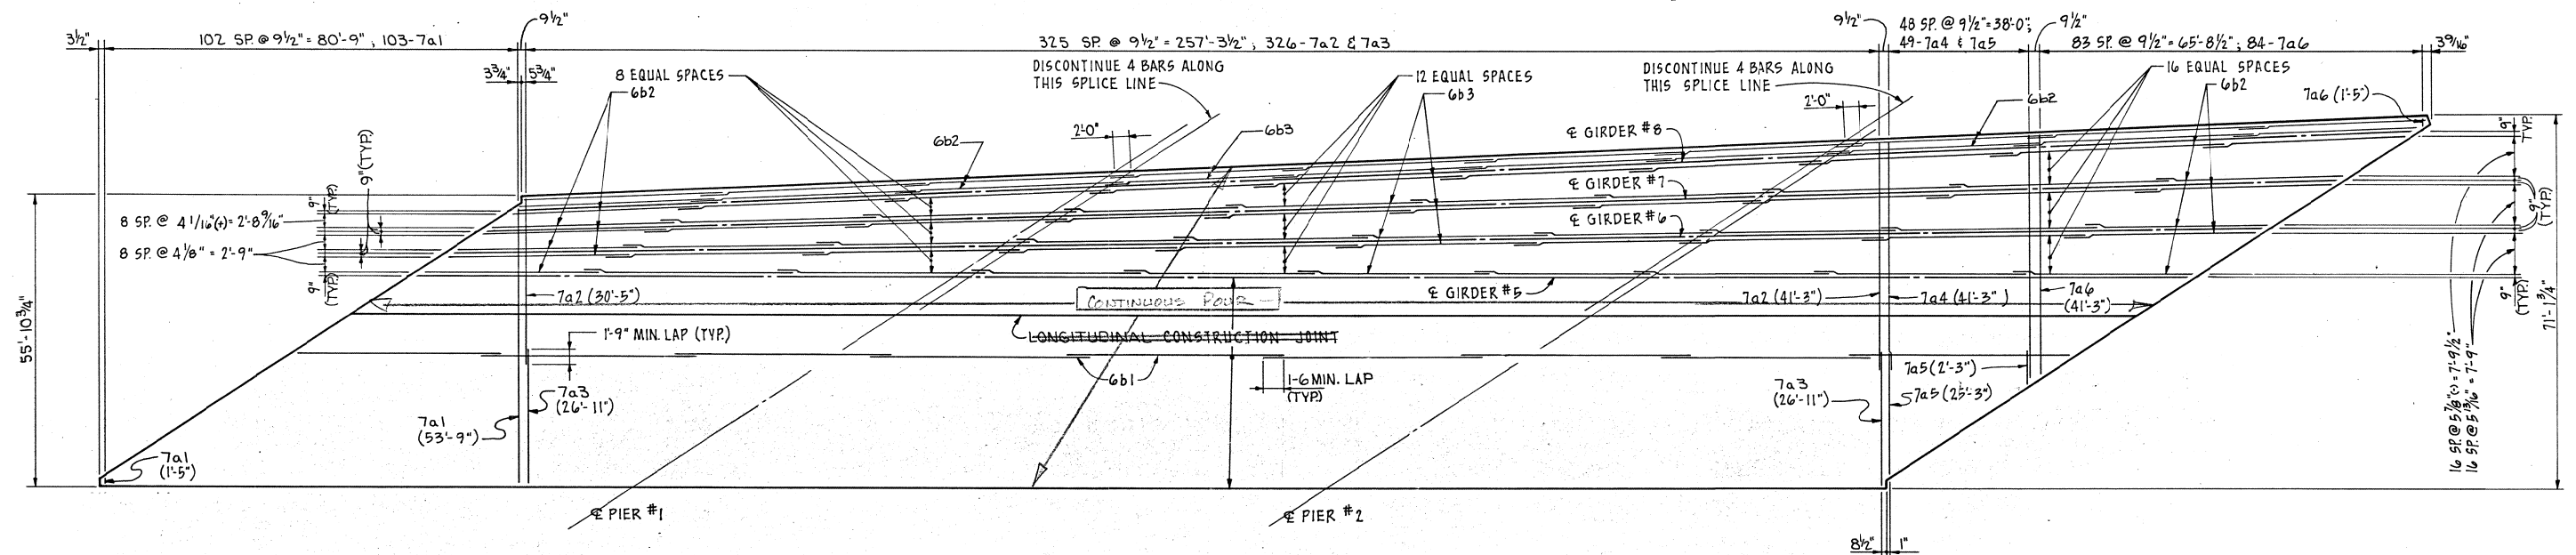

LONGITUDINAL AND TOP OF SLAB TRANSVERSE REINFORCING LAYOUT

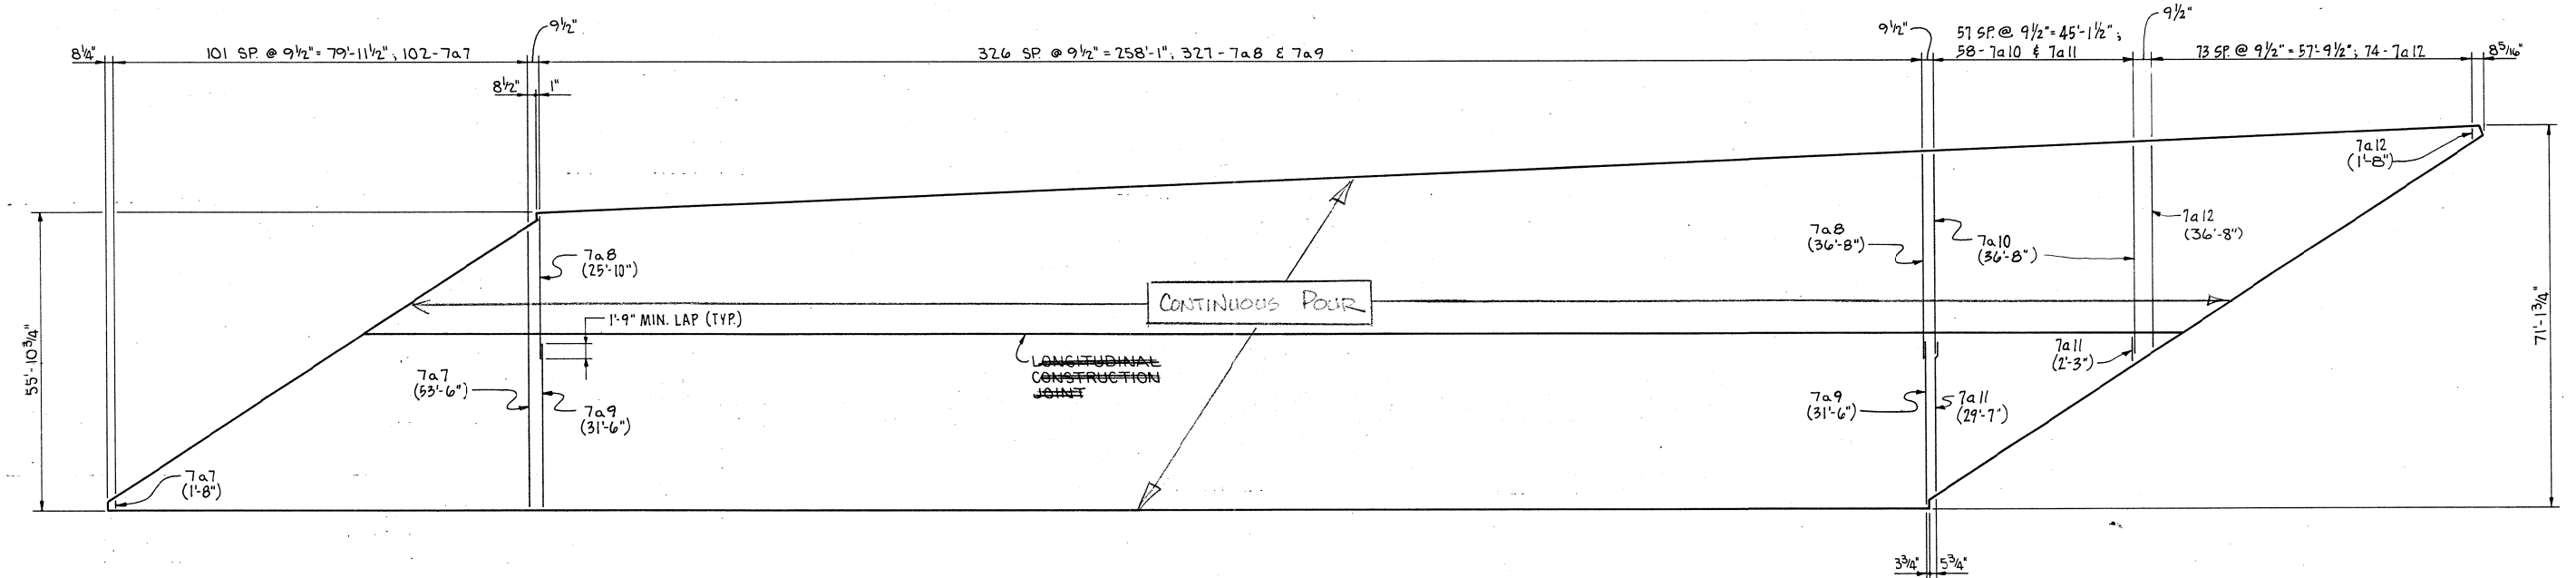

BOTTOM OF SLAB TRANSVERSE REINFORCING LAYOUT

NOTE:



CONTRACTOR HAS THE OPTION TO SPLICE BARS OVER 40'-0" LONG. SPLICE LOCATIONS WERE APPROVED BY THE ENGINEER. PAYMENT FOR REINFORCING BARS SHALL BE BASED ON NO SPLICES, AND NO ALLOWANCE SHALL BE MADE FOR THE ADDITIONAL LENGTH OF BAR REQUIRED FOR THE USE OF SPLICES.

DESIGN FOR 57°03'00" SKEW  
336'-0" X VARI. CONTINUOUS  
WELDED PLATE GIRDER BRIDGE  
102'-6" END SPANS 131'-0" INTERIOR SPAN  
SUPERSTRUCTURE DETAILS  
STATION: 462+88.56 (± S.B. LANE, U.S. NO. 561) NOV. 1978  
SCOTT COUNTY  
IOWA DEPARTMENT OF TRANSPORTATION-HIGHWAY DIVISION  
DESIGN SHEET NO. 22 OF 29 FILE NO. 25588 DESIGN NO. 980


SCOTT COUNTY

PROJECT NUMBER



STATE	FED. ROAD DIST. NO.	FISCAL YEAR	SHEET NO.	TOTAL SHEETS
IOWA	5		54	125

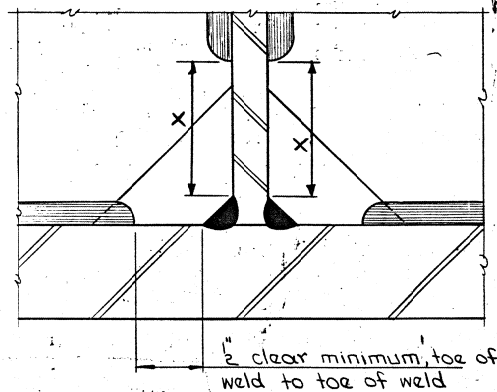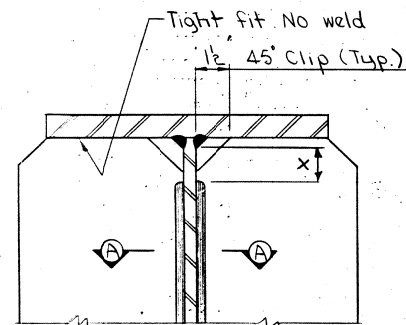

DETAIL A

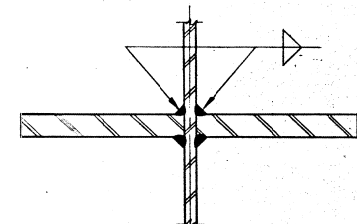


SECTION A-A

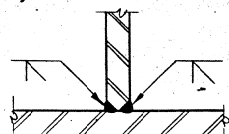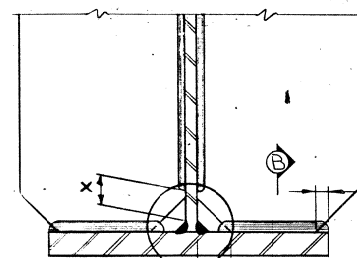


SECTION B-B

See Detail A


BEARING STIFFENER

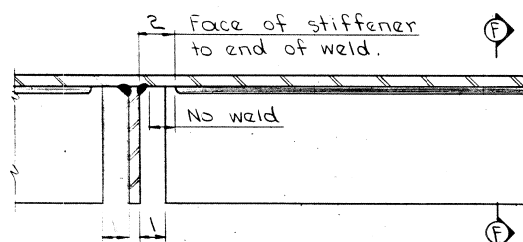

LONGITUDINAL STIFFENER

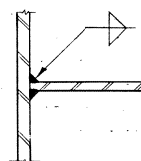

SECTION F-F

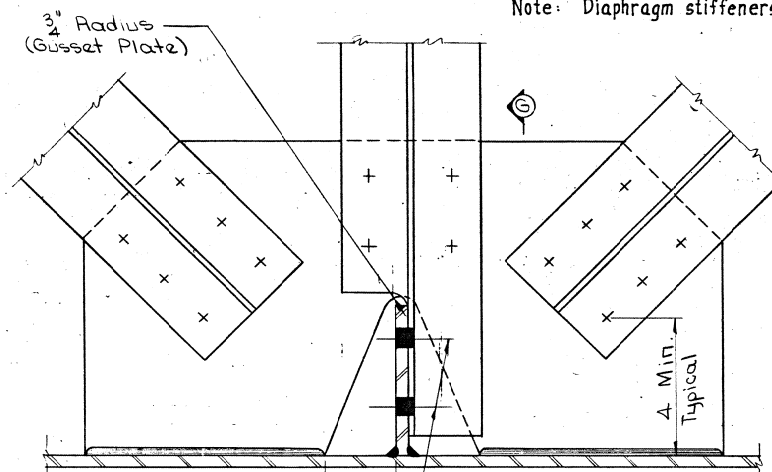


GUSSET PLATE TO WEB DETAIL

### DIAPHRAGM STIFFENER



Note: Used where no intermediate stiffeners are required. If intermediate stiffeners are required the diaphragm stiffener is to be welded the same as the intermediate stiffeners.

Note: Diaphragm stiffeners are full depth for this design.


Web Thickness	X = 5t
3/8	1 7/8
7/16	2 3/16
1/2	2 1/2
9/16	2 13/16
5/8	3 1/8
11/16	3 7/16
3/4	3 3/4

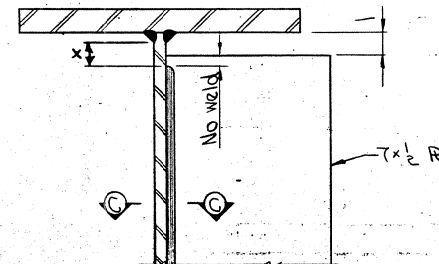

SECTION C-C

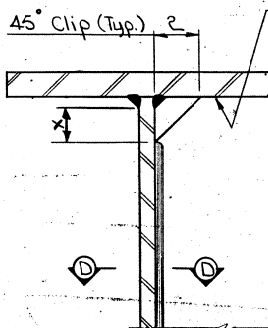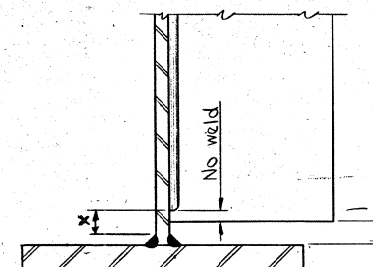

SECTION D-D

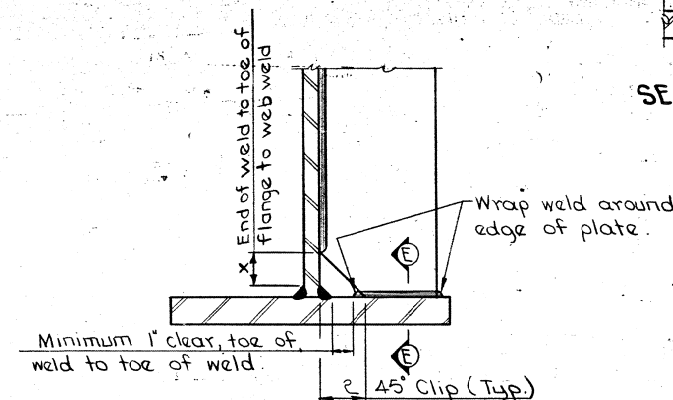


INTERMEDIATE STIFFENER

### NOTE

This sheet is primarily for the use of fabricator's workmen and Iowa Department of Transportation inspectors in interpreting plan details. It covers the locations of weld termini that are not specified by typical weld symbols.

The acceptability and use of the weld treatment shown on this sheet for any specific project is the responsibility of the designing engineer.

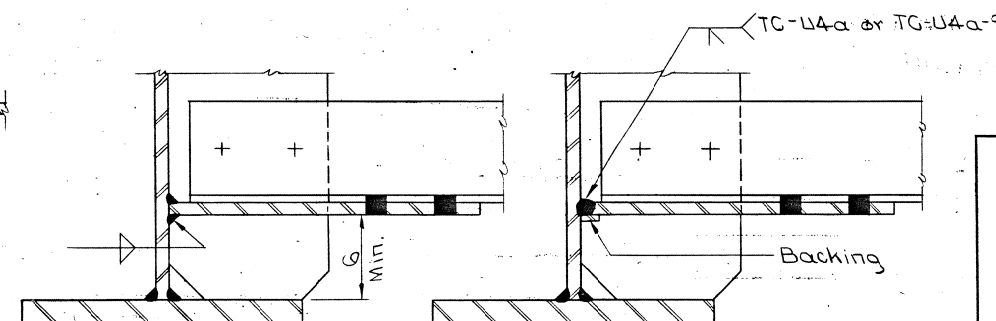

ALTERNATE SECTIONS G-G


DESIGN FOR 57°03'00" SKEW  
336'-0" X VARI. CONTINUOUS  
WELDED PLATE GIRDER BRIDGE  
102'-6" END SPANS 131'-0" INTERIOR SPAN  
WELDING DETAILS  
STATION: 462+88.56 (± S.B. LANE U.S. NO. 561) NOV. 1978  
SCOTT COUNTY  
IOWA DEPARTMENT OF TRANSPORTATION - HIGHWAY DIVISION  
Design Sheet No.: 23 Of 29 File No.: 25588 Design No.: 980

Revised 8-1-77: Stiffener weld gap changed.  
Revised 5-2-77: Gusset plate to web details changed.  
JST: 1-12-77






Revision (7-6-64) Finish on shoes and masonry plates in contact with concrete added.  
Revision (6-1-65) Specifications for Rocker and Shoe material clarified.  
Revision (7-8-71) Note concerning galvanizing of abutment masonry plates added.  
Revision (3-28-72) ASA changed to ANSI.  
Revision (11-22-72) Note concerning finishing changed.  
Revision (8-29-77) Agency updated. Notes concerning finishing changed.

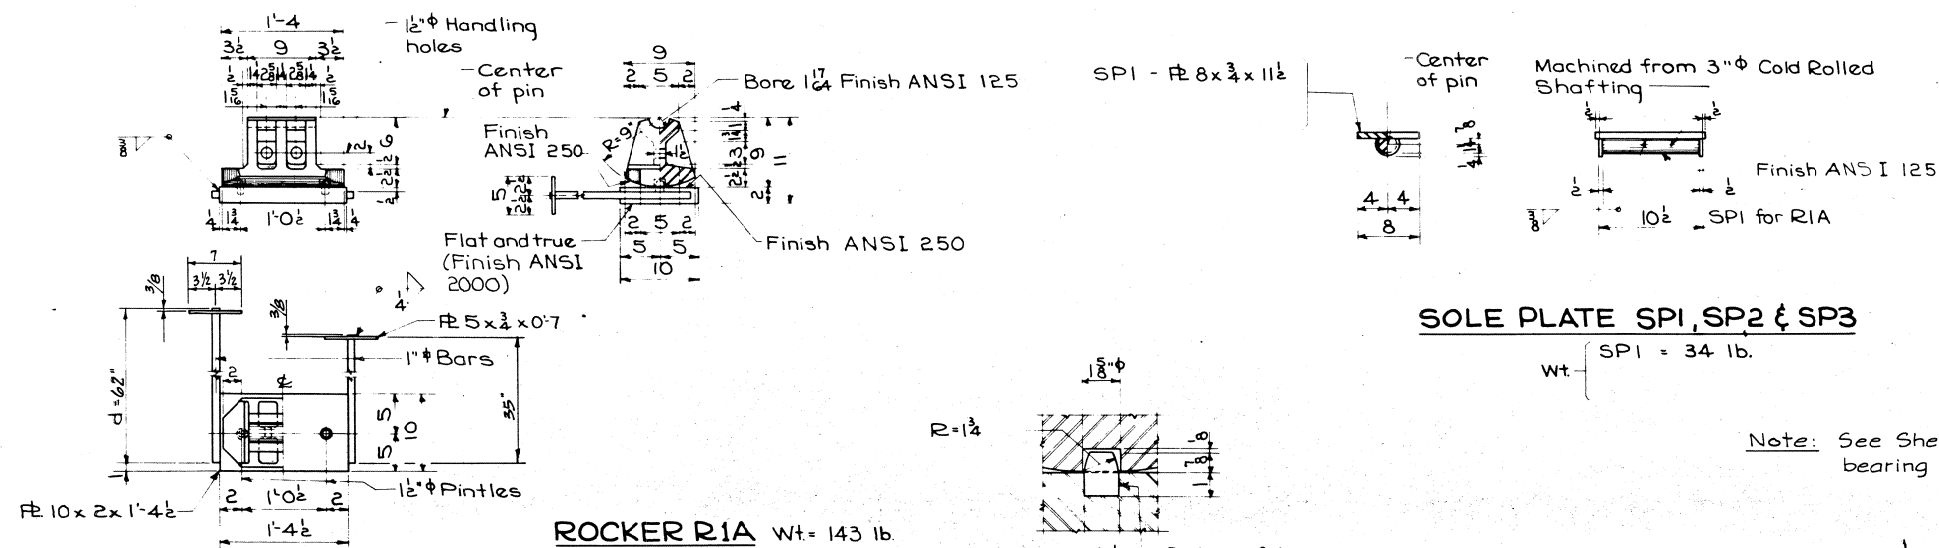

**TYPICAL PINTLE DETAIL**

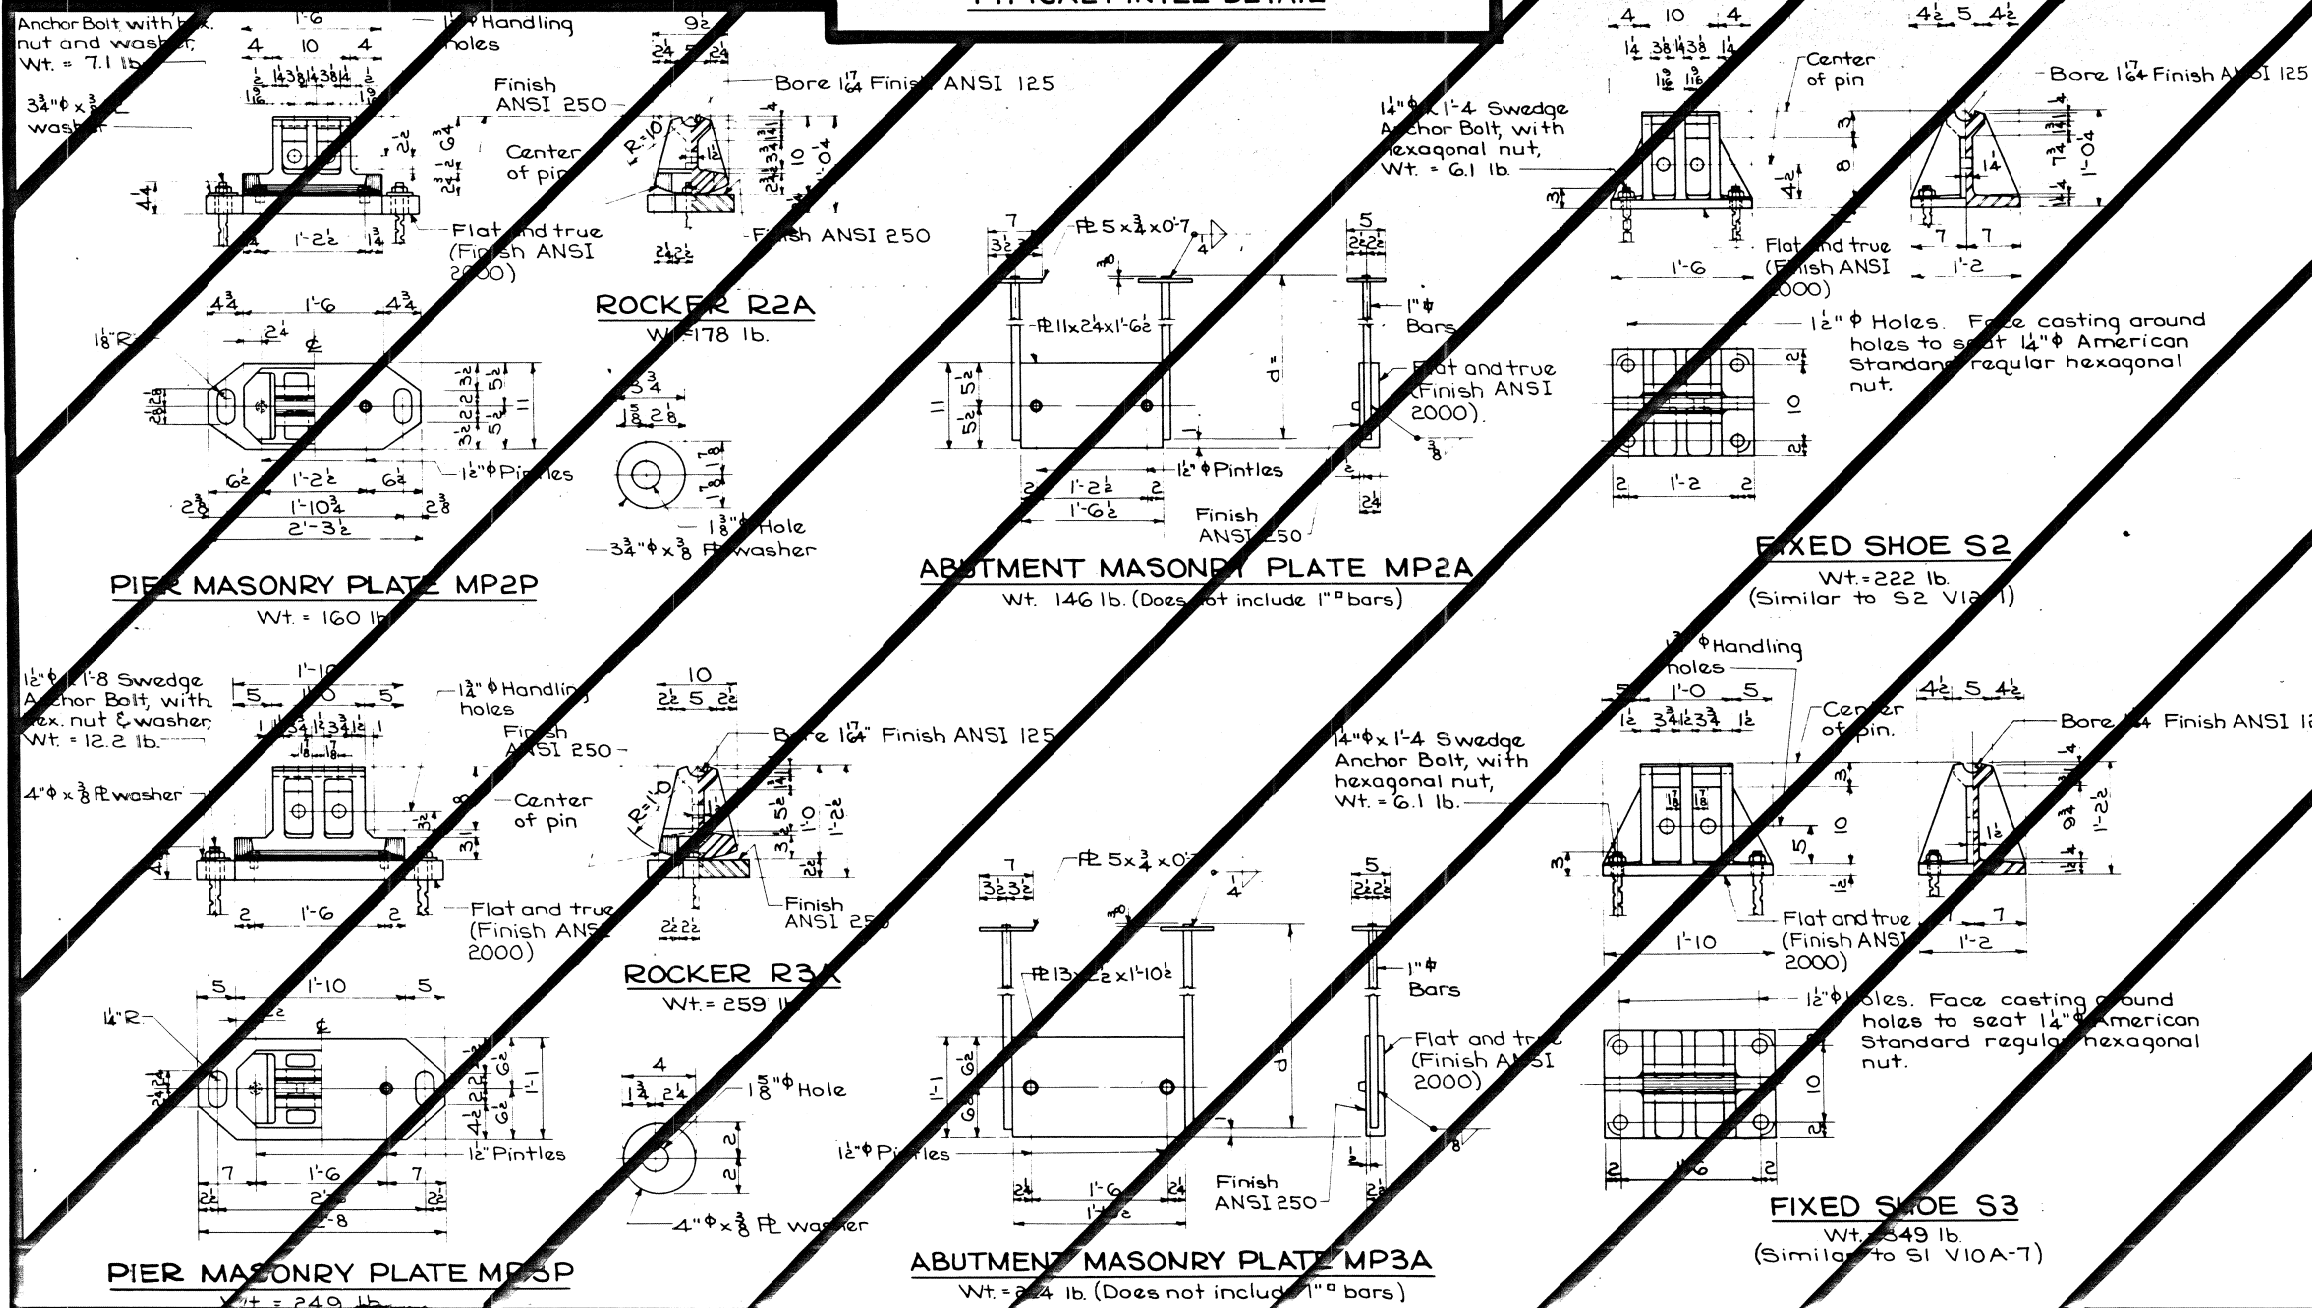

### BEARING NOTES:

The casting of R1A, shall comply with Article 4153.04 of the IDOT Standard Specifications. Castings may be Gray Iron or Nodular Iron.  
The masonry plate marked MP1A, shall comply with the requirements of ASTM A-36 steel.  
The pins shall comply with Article 4153.02 of the IDOT Standard Specifications and with the requirements of ASTM A-108 steel.

Anchor bolts shall be set in accordance with Article 2408.47 of the IDOT Standard Specifications.

All bearings are to be set on a  $\frac{1}{8}$ " lead sheet in accordance with 2408.38 of the Specifications.

The weight of bearings shown does not include the weight of paint.

As soon as the surfacing process is done, the surfaces finished with an ANSI 125 finish shall be shop coated with an application of waterproof National Lubricating Grease Institute No. 3 multipurpose grease. Just before the erection of the structural steel in the field, the shop coated surfaces are to be wiped clean and a field coat of N.L.G.I. No. 3 grease is to be applied.

Masonry plate MP1A was shall be galvanized after the 1" bars have been welded to the masonry plates.

After masonry plates, rockers and shoes are in correct location, fill slotted holes around anchor bolts with a sulphur-based compound or epoxy resin adhesive in accordance with Article 2408.47 of the Standard Specifications.

### DISTANCE FROM TOP OF SOLE PLATE TO BRIDGE SEAT

	Diagram
Rockers & Fixed Shoes	
R1A	1'-0 3/4
R2A	1'-2
R3A	1'-2 1/4

\* Including  $\frac{1}{8}$ " lead sheet.

### MAXIMUM REACTION (In Kips)

	R1A	R2A	R3A
132	11	11	26


DESIGN FOR 57°03'00" SKEW  
336'-0" X VARI. CONTINUOUS  
WELDED PLATE GIRDER BRIDGE  
102'-6" END SPANS 131'-0" INTERIOR SPAN  
BEARING DETAILS  
STATION: 462+88.56 (S.B. LANE, U.S. NO. 561) NOV. 1978  
SCOTT COUNTY  
IOWA DEPARTMENT OF TRANSPORTATION-HIGHWAY DIVISION  
Design Sheet No 25 Of 29 File No 25588 Design No 980

- Revision (12-12-62) Pintle size changed
- Revision (1-6-64) Final drawing and listing of the contract with concrete attached.
- Revision (5-27-65) Weights for MP41, MP5Pa and MP5Pb changed
- Revision (6-20-66) Nodular Iron Casting ASTM number and grade changed.
- Revision (3-28-76) ASA changed to ANSI.
- Revision (11-22-72) Note concerning finishing changed.
- Revision (7-11-73) Material for Rockers, Shoes and Masonry Plates changed.
- Revision (8-29-77) Notes concerning material to fill slots and seating of bearings changed.















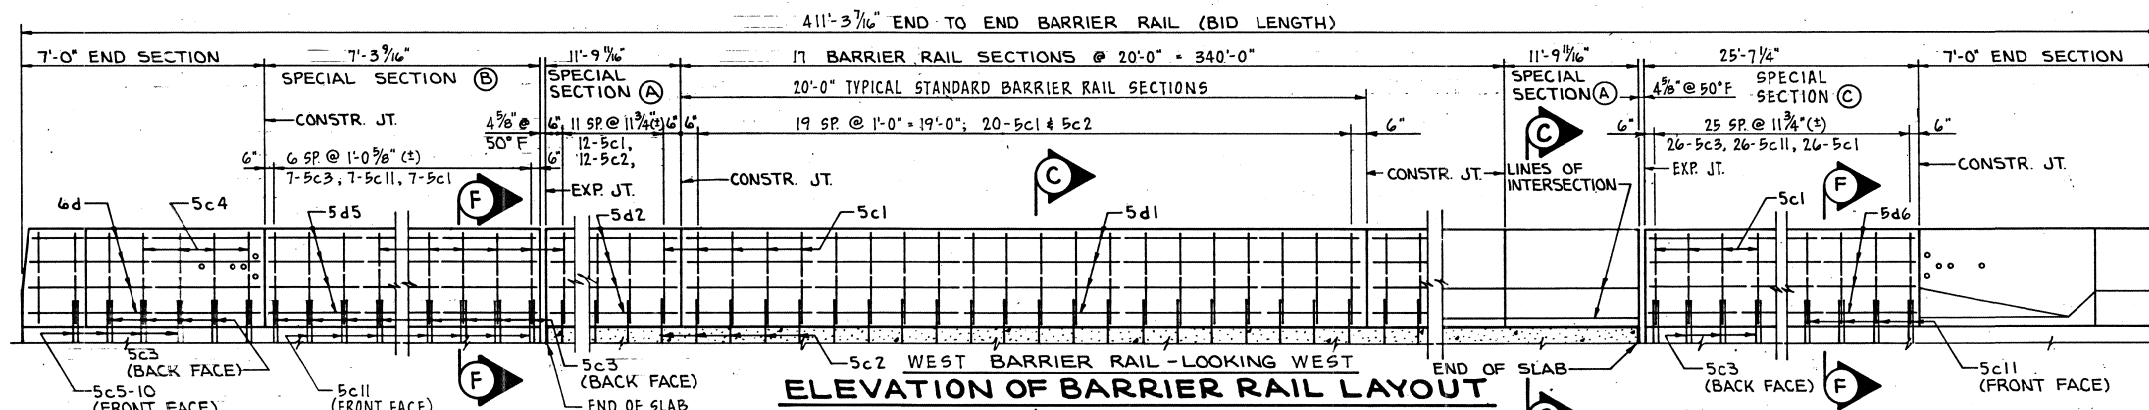

Provide five threaded steel inserts with solid bottom to fit 8 x 2 galvanized cap screws with galvanized round washers. Cost of inserts ~~to be~~ included in price bid for "Structural Concrete". Screws and washers are not a part of this contract.

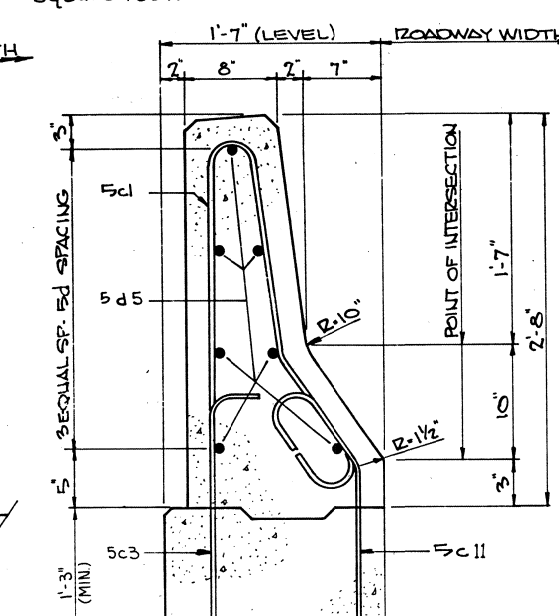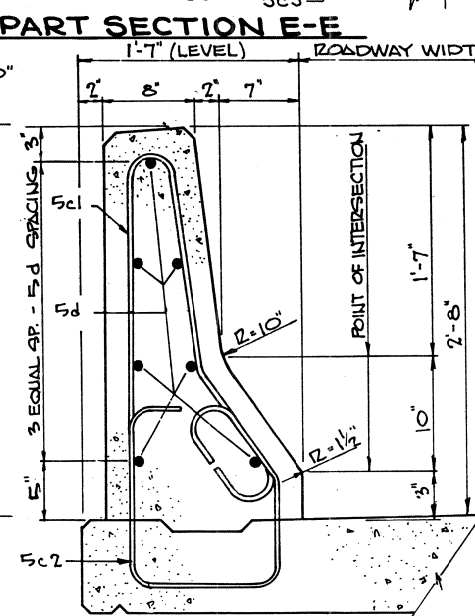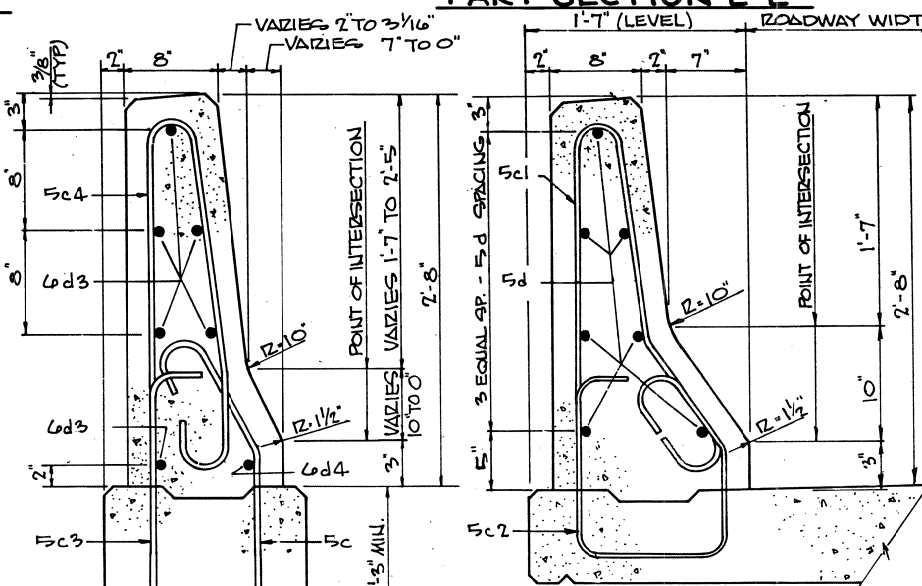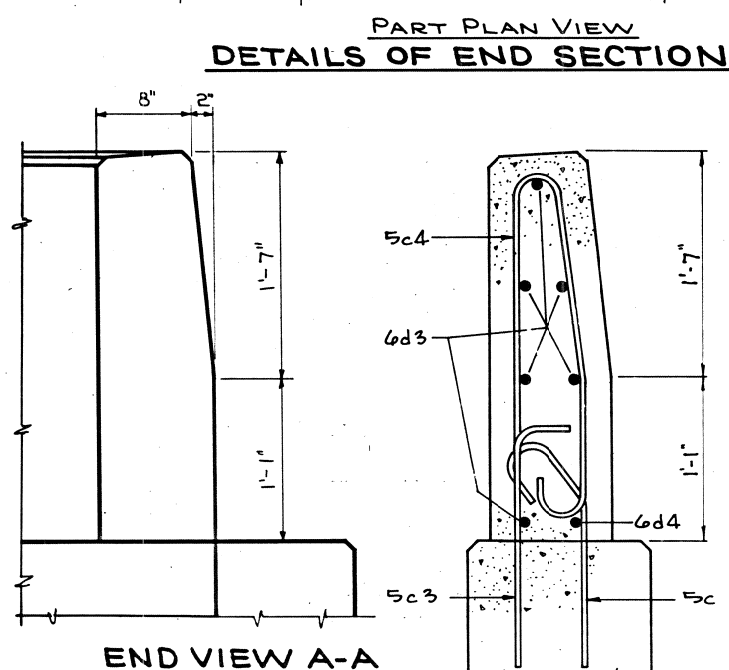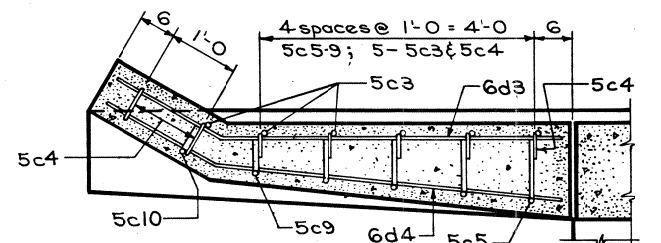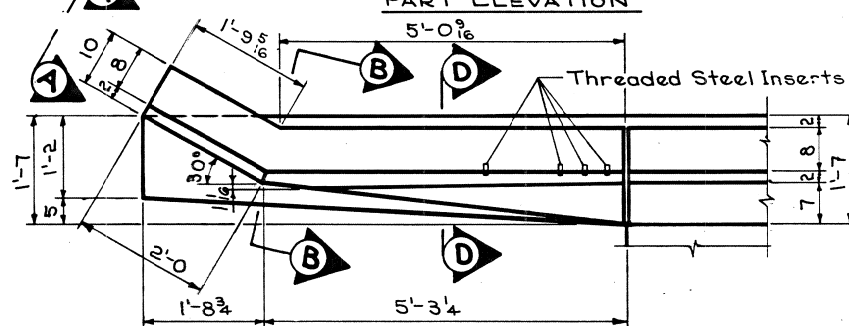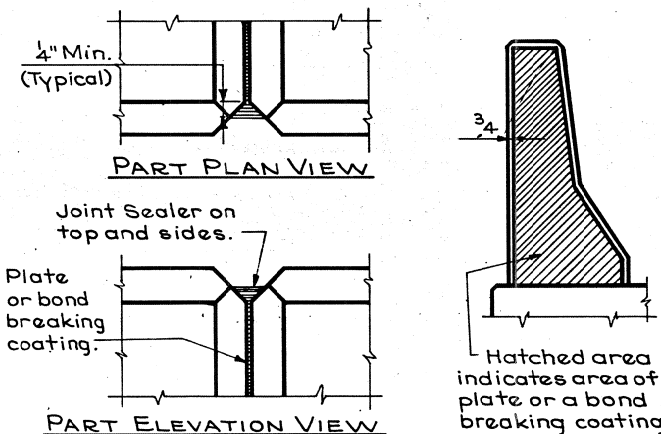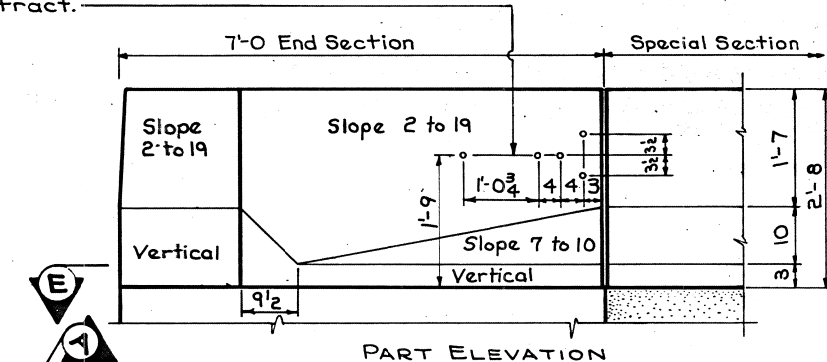

**BARRIER RAIL NOTES:**

Minimum clear distance from face of concrete  
to near reinforcing bar is to be 2" unless otherwise  
noted or shown.

All exposed corners 90° or sharper <sup>were</sup> to be filled with a  $\frac{3}{4}$ " dressed and beveled strip.

Top of the barrier rail is ~~to be~~ parallel to the theoretical  $\frac{1}{2}$  grade.

The barrier rail <sup>was</sup> may be placed in sections or continuously. When it is placed continuously a 1/4 inch sheet of either aluminum, galvanized steel, high density styrene, or plexiglass shall be placed at the joints to separate the sections. When the barrier rail is placed in sections the end of the section to be poured against is to be coated with paraffin or other bond breaker approved by the Engineer and the plate separators may be omitted. The joint sealer shall conform to Fed. Spec. TT-500230 or TT-500227 for Type II, Class A or B.

The concrete barrier rail is to be bid on a lineal foot basis measured from end to end of rail. The number of lineal feet of barrier rail installed will be paid for at the contract price per lineal foot based on plan quantities. Price bid for Concrete Barrier Rail shall be full compensation for furnishing all material, excluding reinforcing steel, and all of the equipment and labor required to erect the rail in accordance with these plans and current specifications. All barrier rail reinforcing steel is to be included with the superstructure reinforcing steel.

*All barrier rail reinforcing steel is to be epoxy-coated.*

NOTE:  
Cross Sectional Area of the Special Section  
and Standard Section of the Barrier Rail = 2.47  
square feet.

REINFORCING STEEL - ONE SECTION						
Section	Bar	Location	Shape	Nº	Length	Weight
STANDARD SECTION	5c1	VERTICAL	B	20	5'-5"	113
	5c2	VERTICAL	B	20	4'-10"	101
	5d1	LONGITUDINAL	—	7	19'-8"	144
	TOTAL FOR ONE SECTION			TOTAL (LB.)		358
7'-0" END SECTION	5c3	VERTICAL	D	6	2'-6"	16
	5c4	VERTICAL	D	7	5'-5"	40
	5c5-10	VERTICAL	9	6	VARIES	18
	6d3	LONGITUDINAL	—	6	6'-7"	59
	6d4	LONGITUDINAL	—	1	6'-10"	10
FOR ONE SECTION			TOTAL (LB.)		143	
SPECIAL SECTIONS (ALL REINFORCING REQUIRED)	5c1	VERTICAL	B	57	5'-5"	322
	5c2	VERTICAL	B	24	4'-10"	121
	5c3	VERTICAL	—	33	2'-6"	86
	5c11	VERTICAL	—	33	2'-11"	100
	5d2	LONGIT-SPECIAL SECTIONS (A)	—	14	11'-5"	167
	5d5	LONGIT-SPECIAL SECTIONS (B)	—	7	6'-11"	50
	5d6	LONGIT-SPECIAL SECTIONS (C)	—	7	25'-3"	184
TOTAL LBS. FOR ALL SPECIAL SECTIONS			TOTAL (LB.)		1030	

### BENT BAR DETAILS

5c1

5c4

5c2

5c3

5c5-11

BAR	"X"
5c5	14
5c6	12
5c7	9
5c8	7
5c9	5
5c10	5
5c11	8



All dimensions are out to out. Radii to  $\frac{1}{2}$  bar.

EPOXY REINFORCING SUMMARY			
Section	Number of Sections	Reinforcing Per Section	Total
Standard	17	358	6086
End	2	143	286
Special	4	-	1030

(Include with Superstructure Reinforcing)	Total (lb.)	7402	
CONCRETE PLACEMENT SUMMARY			
Section	Number of Sections	Concrete Per Section	Total
Standard	17	1.83	31.1
End	2	.58	1.2
Special (A)	2	1.08	2.2
Special (B)	1	.67	.7
Special (C)	1	2.34	2.3
TOTAL (C.Y.)			37.5


CONCRETE BARRIER RAIL QUANTITIES		
Item	Unit	Quantity
West Concrete Barrier Rail	L.F.	411.3

DESIGN FOR 57'03"00" SKEW  
336'-0" X-VARI. CONTINUOUS  
WELDED PLATE GIRDER BRIDGE  
102'-6" END SPANS 131'-0" INTERIOR SPAN  
WEST CURB - BARRIER RAIL  
STATION: 462+88.56 (± S.B. LANE, U.S. NO. 561) NOV. 1978  
SCOTT COUNTY  
IOWA DEPARTMENT OF TRANSPORTATION-HIGHWAY DIVISION  
DESIGN SHEET NO. 28 OF 29 FILE NO. 25588 DESIGN NO 980

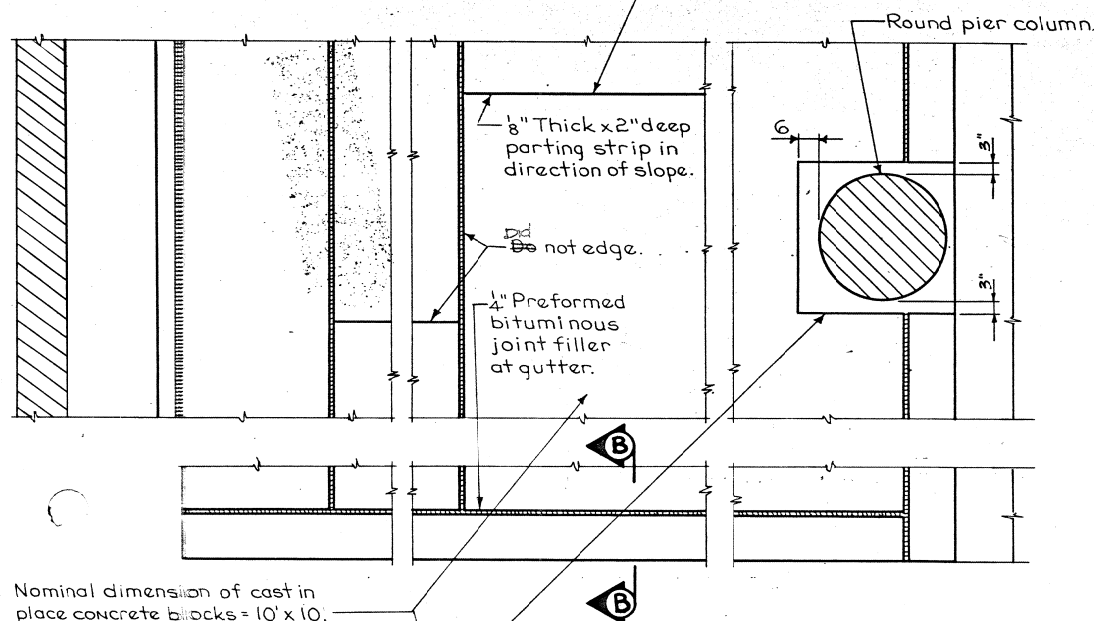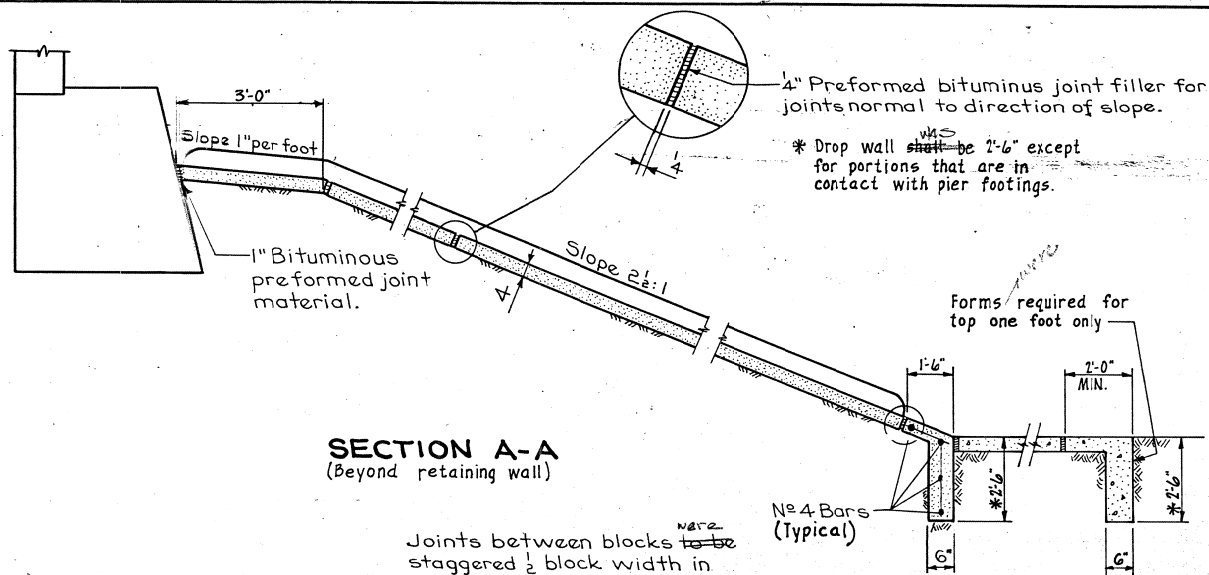


Nominal dimension of cast in place concrete blocks = 10' x 10'.

Slope protection is to be formed out around column to this line and the remaining void was filled with commercial bituminous patching material as approved by the Engineer. No separate payment was made for the bituminous material. Omit drop wall along pier column as shown.

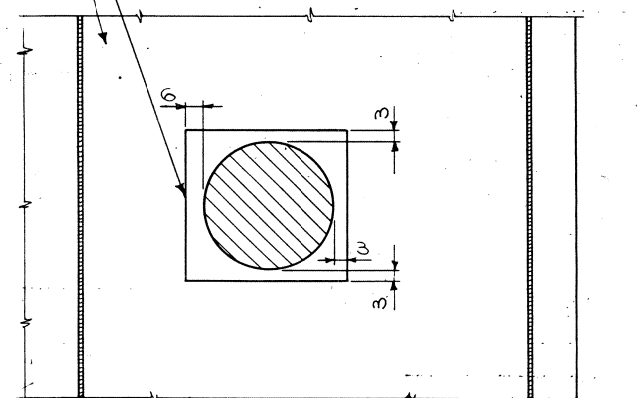


Note: Drop wall is not required behind retaining wall.

Slope protection shall slope so that water will drain from behind the retaining wall.

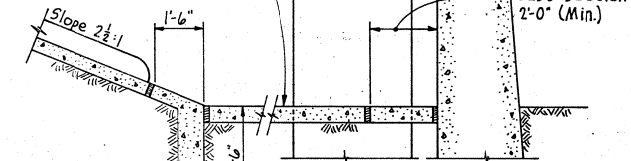

#### SECTION B-B

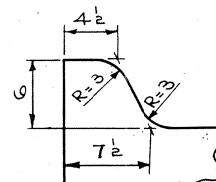

#### GENERAL NOTES:

This sheet shows details for placing portland cement concrete slope protection under overhead structures. The standard specifications of the Iowa Department of Transportation shall apply with modifications or additions listed below:

Concrete - Class C Structural.






Finish - Class 1, Floated Surface Finish.

Cure - Cure as per current Specifications.

Subgrade Preparation - The subgrade shall be shaped and compacted so that finished slope protection will be similar to examples shown on this sheet. The subgrade shall be firm when concrete is placed. Sprinkling required shall be done early enough so that concrete is not placed on a muddy subgrade. No subgrade paper will be required.

The cast in place concrete is to be poured in approximately 10' wide courses, but all courses on one slope shall have approximately equal widths. Adjacent courses shall not be poured within 15 hours of one another. The joints in the direction of the slope are to be staggered about 1/2 block width.

Basis of payment: Payment will be made on a square yard basis for slope protection constructed. The unit price bid per square yard is to include costs of all materials and labor required to construct this protection as shown or intended by these plans. The subgrade preparation including any necessary

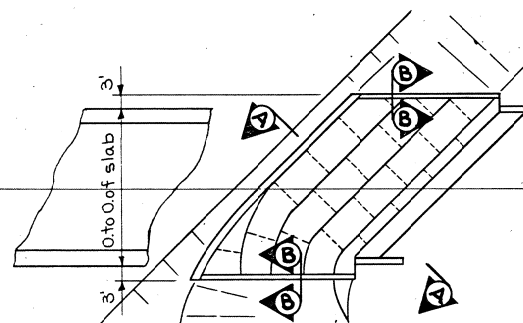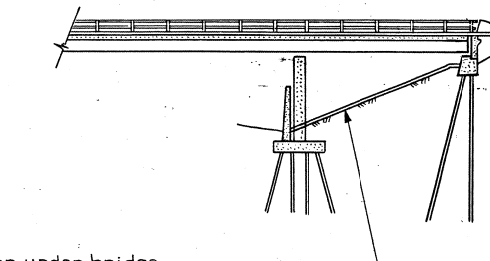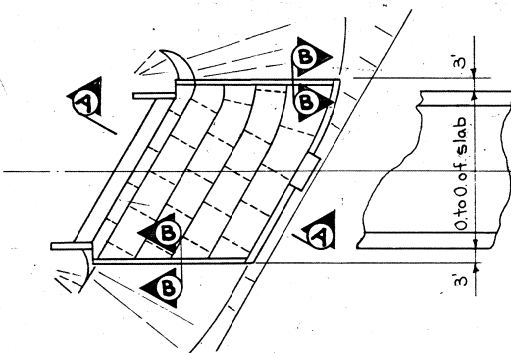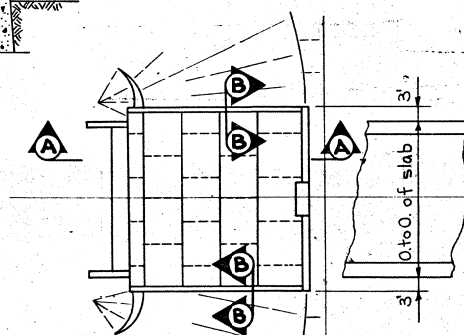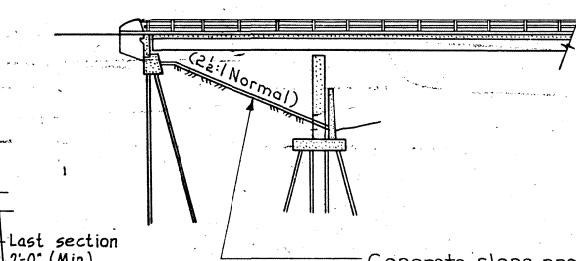

excavation or filling required to shape the slope to the lines shown on the plans and disposal of excess earth excavated as directed by the Engineer, are considered incidental to placing the concrete slope protection. Pay quantities are to be based on field measured out to out dimensions.

Where erosion control work is completed the Contractor shall be responsible for any plant materials destroyed adjacent to slope protection area. The Contractor shall replant, reseed and mulch any such areas in accordance with Section 2601 of the Standard Specifications, Series of 1977, at his expense.

CONCRETE SLOPE PROTECTION			
BRIDGE	S. ABUT.	N. ABUT.	TOTAL
SOUTH BOUND	731	980	1711
	685.7	926.1	1611.8
Total (SQ. YDS.)			1721 1611.8

DESIGN FOR 57'03"00" SKEW  
336'-0" X VARI. CONTINUOUS  
WELDED PLATE GIRDER BRIDGE  
102'-6" END SPANS 131'-0" INTERIOR SPAN

CONCRETE SLOPE PROTECTION  
STATION: 462+88.56 (S. B. LANE, U.S. NO. 561) NOV. 1978  
SCOTT COUNTY  
IOWA DEPARTMENT OF TRANSPORTATION-HIGHWAY DIVISION  
DESIGN SHEET NO. 29 OF 29 FILE NO. 25588 DESIGN NO. 980

DESIGNED BY: \_\_\_\_\_  
CHECKED BY: \_\_\_\_\_

CONCRETE SLOPE PROTECTION

STANDARD SHEET 1006

SCOTT COUNTY


PROJECT NUMBER

STATE: IOWA  
FED. ROAD DIST. NO.: 5  
YEAR: 61  
SHEET NO.: 125

62-7087-101-130




FOUNDATION NUMBER	PIILING LOG	KIND OF PILING
South Abutment		HP10x42 Steel Bearing

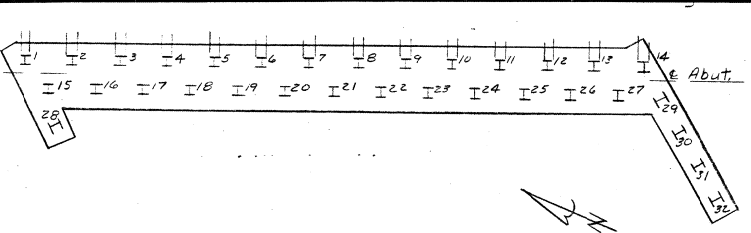


PILE NO.	LENGTH IN STRUCTURE	BEARING (in Tons)	PILE NO.	LENGTH IN STRUCTURE	BEARING (in Tons)	PILE NO.	LENGTH IN STRUCTURE	BEARING (in Tons)
1	80.9	34.5	17	79.4	44.8			
2	87.1	73.8	18	80.4	53.6			
3	86.1	73.8	19	80.6	48.2			
4	79.4	34.5	20	79.2	38.9			
5	84.9	73.8	21	79.9	56.7			
6	78.4	35.7	22	80.4	64.3			
7	80.9	49.7	23	80.5	53.6			
8	80.7	38.6	24	81.0	47.1			
9	79.4	37.3	25	80.3	40.7			
10	80.2	37.3	26	80.1	37.1			
11	81.0	32.1	27	80.7	37.1			
12	79.8	37.3	28	80.4	40.7			
13	84.1	68.9	29	79.8	38.9			
14	79.6	34.4	30	80.5	41.9			
15	80.7	43.5	31	80.0	45.9			
16	79.5	40.7	32	80.3	43.8			

FOUNDATION NUMBER	PIILING LOG	KIND OF PILING
North Abutment		HP10x42 Steel Bearing

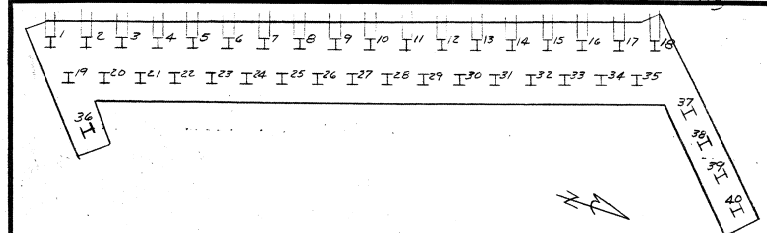


PILE NO.	LENGTH IN STRUCTURE	BEARING (in Tons)	PILE NO.	LENGTH IN STRUCTURE	BEARING (in Tons)	PILE NO.	LENGTH IN STRUCTURE	BEARING (in Tons)
1	73.2	Ref.	21	73.2	Ref.			
2	72.1	Ref.	22	73.2	Ref.			
3	72.9	62.0	23	74.1	Ref.			
4	73.1	Ref.	24	73.9	65.8			
5	74.2	Ref.	25	74.3	Ref.			
6	73.9	Ref.	26	74.0				
7	74.5	63.8	27	73.4				
8	74.0	Ref.	28	73.4				
9	73.5		29	73.3				
10	74.1		30	73.7				
11	73.8		31	72.9				
12	73.7		32	73.6				
13	74.3		33	73.4				
14	74.5		34	73.2				
15	73.4		35	72.2				
16	74.1		36	72.8	Ref.			
17	74.1		37	64.4	24.8			
18	73.7		38	63.2	25.5			
19	72.1		39	63.9	23.5			
20	72.5	Ref.	40	63.8	21.8			

FOUNDATION NUMBER	PIILING LOG	KIND OF PILING
Pier #1		Creosoted

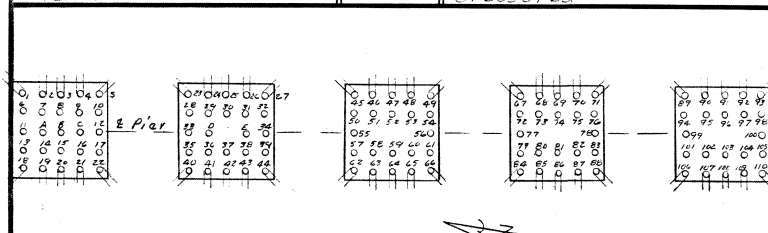

PILE NO.	LENGTH IN STRUCTURE	BEARING (in Tons)	PILE NO.	LENGTH IN STRUCTURE	BEARING (in Tons)	PILE NO.	LENGTH IN STRUCTURE	BEARING (in Tons)
1	38.9	21.1	37	39.3	39.2	73	39.3	Ref.
2	39.2	Ref.	38	39.1	34.7	74	39.6	Ref.
3	39.0	Ref.	39	39.0	24.9	75	39.2	Ref.
4	39.0	Ref.	40	39.4	24.9	76	38.9	26.8
5	39.5	28.9	41	39.1	23.5	77	39.6	Ref.
6	24.5	00.0	42	39.2	23.3	78	38.8	
7	39.5	37.5	43	39.0	27.4	79	39.4	
8	39.6	36.2	44	39.4	26.0	80	39.5	
9	38.5	38.9	45	39.2	35.4	81	39.7	
10	24.1	00.0	46	38.2	36.5	82	39.5	
11	39.5	32.3	47	38.6	Ref.	83	39.4	
12	23.9	00.0	48	38.8		84	38.6	
13	38.7	32.3	49	38.8		85	39.6	
14	39.2	32.3	50	38.7		86	39.5	
15	38.8	Ref.	51	38.5		87	39.2	
16	38.9	Ref.	52	39.0		88	39.3	Ref.
17	38.9	34.7	53	39.2		89	38.8	24.9
18	39.1	28.8	54	39.9		90	39.1	26.1
19	39.4	32.3	55	38.9		91	39.1	29.5
20	39.3	32.3	56	38.4		92	39.5	25.5
21	39.1	Ref.	57	39.1	Ref.	93	39.1	25.7
22	39.1	25.3	58	39.3	39.4	94	38.9	24.4
A	39.1	27.4	59	39.2		95	38.4	20.3
B	39.3	34.7	60	39.2		96	39.1	20.0
C	39.2	26.7	61	39.2		97	39.2	22.7
23	39.2	28.1	62	39.4		98	39.2	22.7
24	39.1	32.2	63	39.4		99	39.3	Ref.
25	39.2	36.5	64	39.4		100	39.0	23.8
26	39.2	25.3	65	39.3		101	39.5	16.3
27	39.1	23.0	66	39.3		102	39.6	Ref.
28	39.0	32.2	67	39.4		103	39.2	20.4
29	39.4	36.0	68	39.4		104	39.3	16.9
30	42.7	25.6	69	38.4		105	39.4	18.2
31	39.0	34.8	70	38.6		106	39.3	23.8
32	39.3	26.6	71	37.4		107	39.8	23.8
33	29.3	35.1	72	39.1		108	40.0	15.7
34	38.9	25.3	73	38.4		109	39.7	17.1
35	39.7	Ref.	74	39.3	Ref.	110	39.0	17.7
36	39.7	30.5						

FOUNDATION NUMBER	PIILING LOG	KIND OF PILING
Pier #2		Creosoted

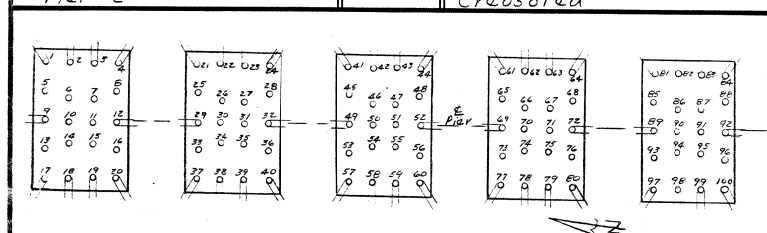

PILE NO.	LENGTH IN STRUCTURE	BEARING (in Tons)	PILE NO.	LENGTH IN STRUCTURE	BEARING (in Tons)	PILE NO.	LENGTH IN STRUCTURE	BEARING (in Tons)
1	39.9	Ref.	35	38.1	Ref.	68	38.7	Ref.
2	39.0		36	33.2		69	39.0	32.6
3	39.3		37	38.0		70	39.2	Ref.
4	39.5		38	39.0		71	39.2	
5	39.6		39	39.7		72	36.0	
6	39.4		40	39.0	Ref.	73	39.4	
7	39.1		41	38.2	36.4	74	39.3	
8	39.3		42	39.4	Ref.	75	38.6	Ref.
9	39.3		43	38.4	35.0	76	39.0	37.7
10	37.5		44	38.4	Ref.	77	39.0	39.8
11	39.3	Ref.	45	39.2	38.4	78	39.1	Ref.
12	39.4	37.7	46	39.0	35.7	79	37.4	35.0
13	39.6	Ref.	47	38.8	Ref.	80	39.0	Ref.
14	38.0		48	38.9	Ref.	81	38.7	34.0
15	38.8		49	39.6	38.4	82	38.5	Ref.
16	39.2		50	39.2	Ref.	83	38.2	Ref.
17	39.9		51	39.1		84	36.5	36.7
18	39.2		52	39.2		85	38.8	36.7
19	38.7		53	34.2		86	38.8	Ref.
20	39.4		54	33.6		87	38.5	Ref.
21	39.0		55	34.2		88	38.5	Ref.
22	38.0		56	34.9		89	38.5	Ref.
23	38.7		57	39.5		90	38.7	36.7
24	38.6		58	39.2		91	38.9	36.7
25	39.3	Ref.	59	39.3	Ref.	92	38.8	39.8
26	39.2	36.4	60	39.4	39.1	93	38.9	Ref.
27	37.3	Ref.	61	38.6	Ref.	94	38.5	Ref.
28	39.2	Ref.	62	38.4	Ref.	95	38.8	Ref.
29	39.2	39.8	63	38.5	Ref.	96	38.4	36.7
30	39.2	Ref.	64	38.3	39.8	97	27.0	Ref.
31	39.6		65	33.7	Ref.	98	38.5	Ref.
32	39.2		66	38.5	Ref.	99	38.6	Ref.
33	39.6		67	38.7	Ref.	100	39.0	Ref.
34	39.1	Ref.						