

Table with 3 columns: ITEM, UNIT, TOTAL. Includes items like Concrete, Reinforcing Steel, Class 10 Channel Excavation, etc.

STATE OF IOWA
STATE HIGHWAY COMMISSION
DESIGN FOR
BRIDGES AND CULVERTS
PRIMARY ROAD SYSTEM
PROJECT NO. FU-1065(10)
STORY COUNTY
JANUARY, 1963

CONSTRUCTION PLANS SHOWING
PROJECT AS BUILT

DATE 3-4-64 COPIES PREPARED 3
PREPARED BY James C. George
RESIDENT ENGINEER

ONE COPY APPROVED & FORWARDED TO AMES
DIST. ENGR. DATE.
TWO COPIES TO BE MADE & RETURNED TO
STEINER SILENCE DIST. ENGR.
ROBERT SHELQUIST RES. MAINT ENGR.

Table with 3 columns: ITEM, UNIT, TOTAL. Includes items like Concrete, Reinforcing Steel, Pretensioned, etc.

Table with 10 columns: DESIGN, LOCATION (SECTION, TOWNSHIP, STATION), DESCRIPTION, SIZE AND TYPE, CONCRETE CUBIC YARDS, REINFORCING STEEL LBS., EXCAVATION -- CUBIC YARDS (CLASS 20, CLASS 24, CLASS 10 CHANNEL), REMOVALS.

SPECIFICATIONS

CONSTRUCTION: Standard Specifications of the Iowa State Highway Commission, Series of 1960, plus current Supplemental Specifications and Special Provisions.

DESIGN STRESSES for the following materials are in accordance with A. A. S. H. C. Standard Specifications, Series of 1961.

- Reinforcing Steel in accordance with Section 1.4.12 "Reinforcement" for Intermediate, Hard, or "Ail Steel Grade.
- Concrete in accordance with Section 1.4.11 f'c = 3500 p. s. i.
- Prestressed Concrete in accordance with Section 1.13.7 f'c = 5000 psi.
- Prestressing Steel in accordance with Section 1.13.7 f's = 250,000 psi.

Design stresses for Structural Steel (A-36) to be in accordance with the Bureau of Public Roads Circular Memorandum entitled, "Unit Stresses for A. S. T. M. A -36 Carbon Steel and for Rivets and Bolts", dated August 17, 1962.

These bridges will require bridge Sign Assemblies furnished and placed by others as specified in Traffic and Highway Planning Instruction No. 11, Revised October 1, 1961.

45-Sheets


Table with 3 columns: DIV., LOCATION, LIN. FT., MILES. Includes rows for Bridge at Sta. 1258+98.85 and Bridge at Sta. 1301+20.00.

DEPUTY R. M. [Signature]

DIVISION

Revised 7-22-63: Sheet 7a of 23 Design 3261 added for corrected footing layout, quantities changed on sheets 1 and 7 of 23.
Revised 6-10-63 Design 3261: Number and weight of bars 5g1 corrected on Sh.# 2 & 3 of 23.
Number and weight of bars 5c1 & 5c2-7 corrected on Sh.# 6 of 23.

Revised 5-6-63 Design 3061: Structural Steel quantity corrected on sheets 1 & 10
Revised 2-27-63 Design 3061: Structural Carbon Steel designation changed for minor members; Notes on Sheets 1 & 11 changed.

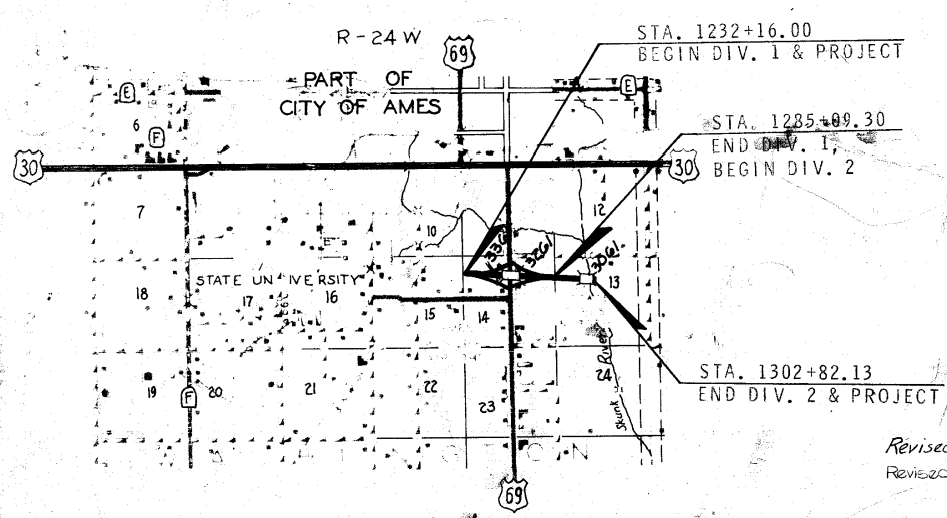


LAYOUT
SCALE 1" = 1 MILE

Story U.S. 30 #7

COUNTY STORY

PROJECT NO. FU-1065 (10)

FILE NO. 21508

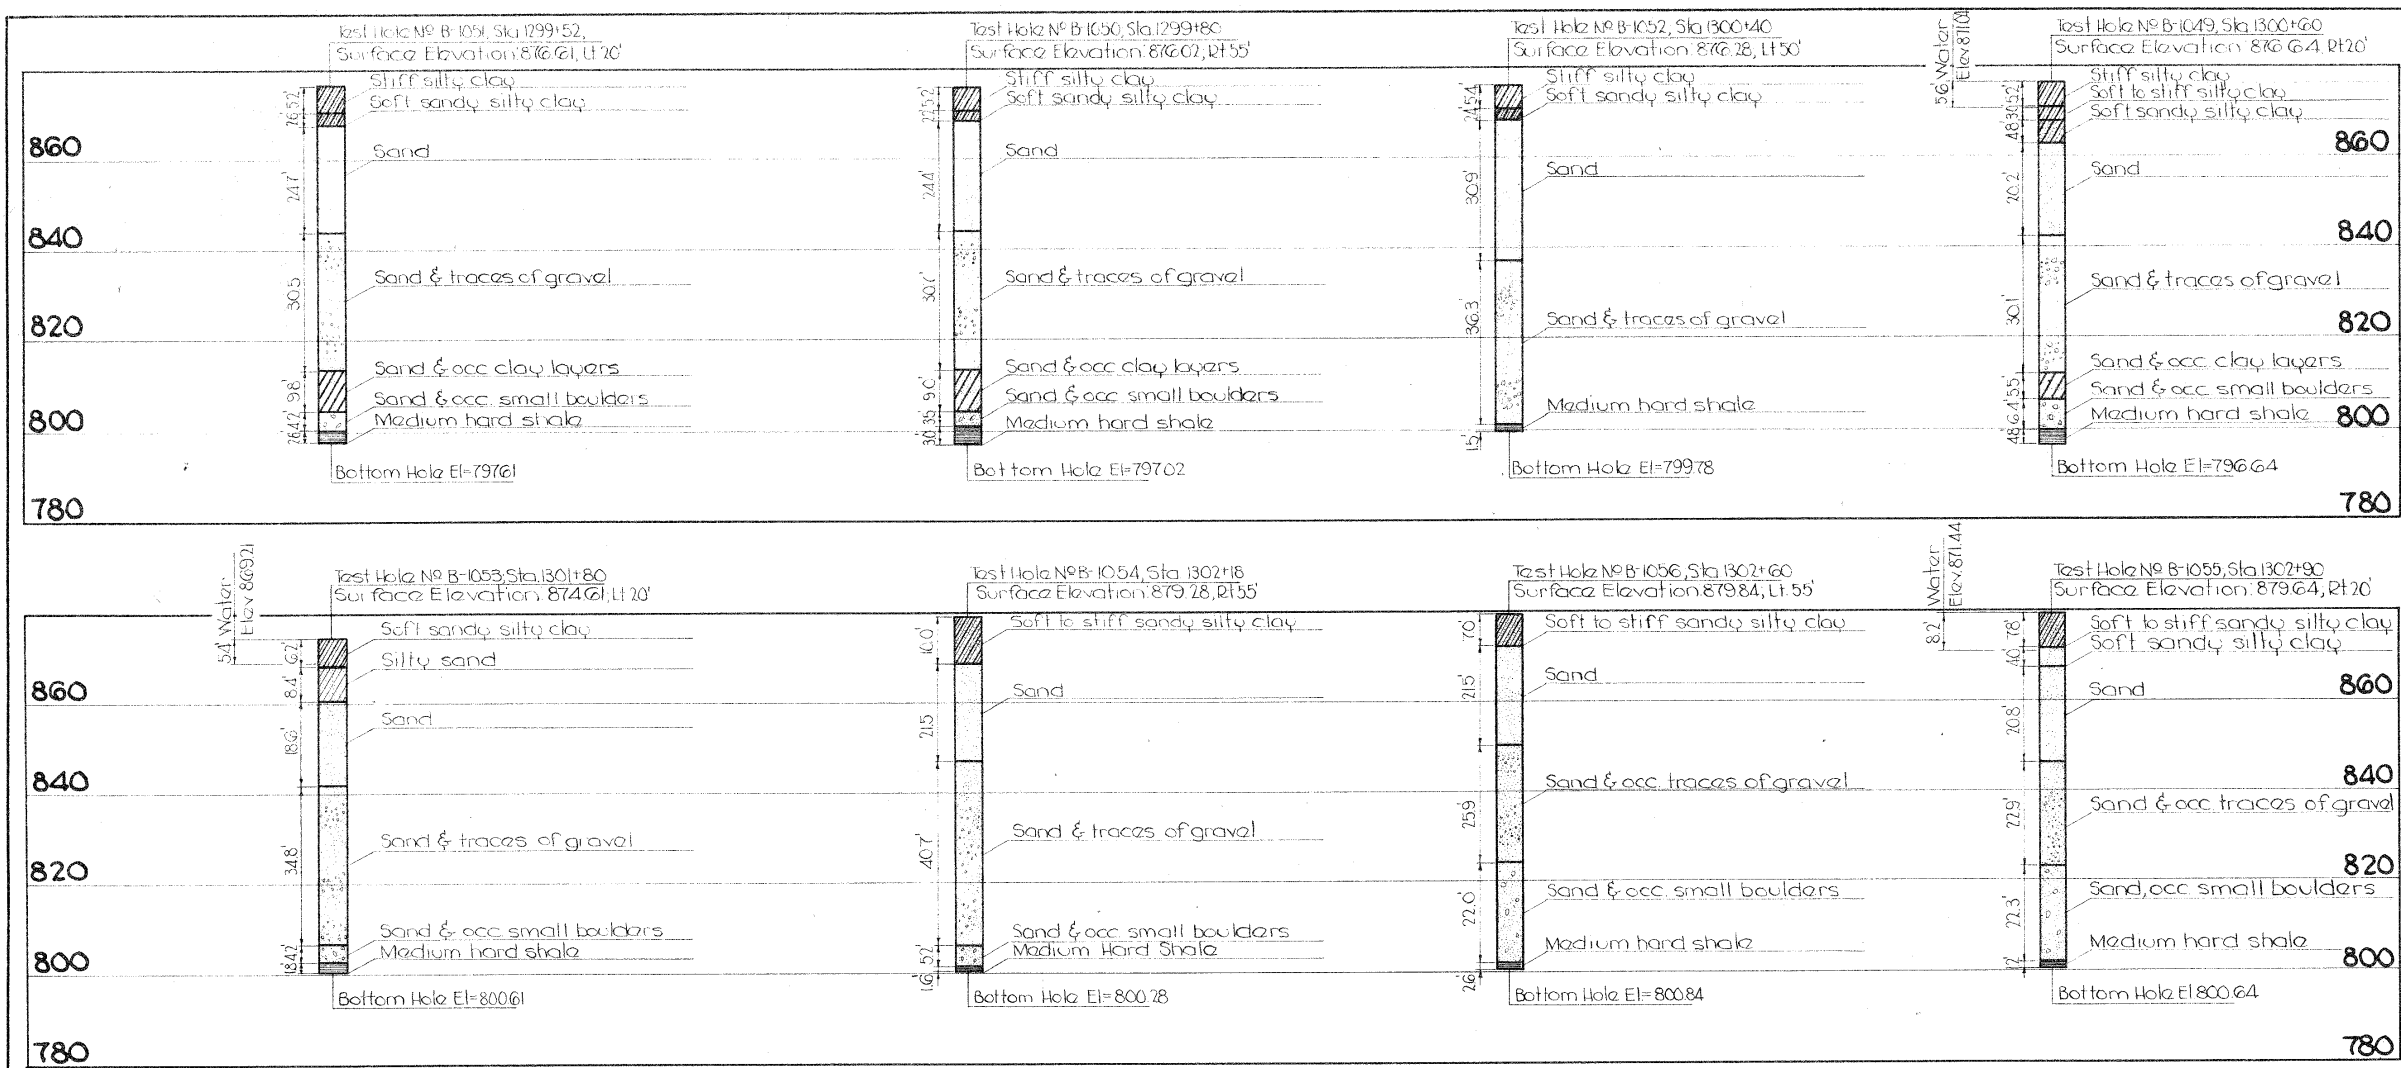

Bench Mark No. 23, Sta. 1300+91 RR spike in E. side of 15' Willow 122' R11 Elev. 891.75
Bench Marks: N 2 25 B Sta 127+80 I.H.C. on SW wing E.B. Bridge Elev. 891.74
N 2 25 B Sta 1302+60 I.H.C. on N.E. wing V.P. Bridge

S O U N D I N G D A T A

Dated: 2-14-62

GENERAL NOTES:

These bridges were designed for 420-516 loading plus an allowance of 191b per square foot of roadway for future wearing surface. Approach fills are not a part of this contract but are to be in place before abutment piles are driven. The Bridge Contractor is to level and shape the batters to the elevations and dimensions shown in the plans. The Bridge Contractor is to clear the channel to 65 feet on each side of the survey as indicated by the cross hatched areas on the Situation Plan and Longitudinal Sections, sheet 4. The excavation quantities for the piers are based on the assumption that the channel clearance will be completed before the construction of the piers is begun. The dirt from the channel clearance and footing excavation shall be deposited in the waste area shown on the General Plan, sheet 2, as directed by the Engineer. The construction of the wing dikes and the remainder of the channel clearance is to be done by others and is not a part of this contract. The formed beam guardrail and crossot posts at the ends of the bridges are to be furnished and placed by others and are not a part of this contract. A test load pile was driven at Pier 1 of the Eastbound Lane. For the location and the driving and testing procedure see details on sheet 2. The Bridge Contractor is to cooperate with the Engineer in the performance of this test and to assist in setting and removing the test beam. The cost of this work is considered incidental to the driving of the footing piles and no separate payment will be made for this work or for delays caused by testing. Untreated piling for pier footings shall be either oak or gumwood. The bid item "Welded Wire Fabric Retard" shall include the cost of all labor, excavation, furnishing and driving piling materials, and other incidental items necessary for the construction of the retard and wingdams. The 1" and 3/4" cable shall be furnished by the I.H.C.; see sheet 3.

SPECIFICATIONS:

Design: A.A.S.H.O. Series of 1961 plus U.S.B.P.R. Circular memo dated August 17, 1962, Unit Stresses for ASTM A-36 Carbon Steel.
Design stresses for:
Reinforcing Steel in accordance with Sec. 1.4.12 "Reinforcement for intermediate, hard or rail steel grade," AASHTO.
Concrete in accordance with Sec. 1.4.11 f'c = 3500 psi. AASHTO.
Structural Steel: All structural steel in accordance with U.S.B.P.R. Circular Memo 8-17-62, Unit Stresses for ASTM A-36 Carbon Steel.
Construction: I.S.H.C. Standard Specifications Series of 1960, plus current special provisions and supplemental specifications.
Revised 5-6-63: Structural Steel quantity corrected to include different carbon steels.
Revised 2-27-63: Specifications Note changed to include different carbon steels.

TOTAL ESTIMATED QUANTITIES				
Items	4 Abuts.	4 Piers	2 Superst.	Totals
Concrete	3176	3240	630.4	1272.0cy
Reinforcing Steel	30,148	39,768	197,328	267,244lb
Structural Steel			519,408	519,408lb
Class 10 Channel Excavation			572.310	1600cy
Class 20 Excavation	748	140		888cy
Class 21 Excavation		520		520cy
Crossot Piling	96@35			3,360LF
Untreated Piling (oak or gumwood)		192@35		6,720LF
Aluminum Handrail (E & End Posts)				12480LF
or Steel Handrail (E & End Posts)				12540LF
Granular Backfill	897			897tons
Welded Wire Fabric Retard (E & End Piles - Includes wingdams)				840LF
Porous Backfill	46			46cy

Note: Superstructure reinforcing steel quantity is based on the use of Aluminum Handrail. (See sheet 10)

LOCATION:


Story County
T83N R24W
Washington Twp
Section 13
U.S. No 30 over
Skunk River

DESIGN FOR 20° SKEW DUAL 320'-0" x 30' CONTINUOUS WELDED GIRDER BRIDGES AND WELDED WIRE RETARD


97'-6" End Spans 125'0" INTERIOR SPAN
CONCRETE FLOOR & SUBSTRUCTURE Tubular HAND RAIL
STATION: 1301+20.00 Project No. FU-1065(10)
IOWA STATE HIGHWAY COMMISSION
December 1962 SHEET 1 of 15
DESIGN No. 3061 STORY COUNTY FILE No. 21508

Benchmark No. 23, Sta. 1300+01, 22 spike in E. side 15" Willow, 122' Bl. Elev. = 878.13
Bench Marks N^o 23B Sta. 1299+80 I.H.C. B.M. on S.W. wing E.R. Bridge Elev. 871.75
N^o 23C Sta. 1302+60 I.H.C. B.M. on N.E. wing W.B. Bridge Elev. 871.74

PILE NOTES FOR TEST LOAD: (REFER TO SKETCH)
Test load one pile only for Pier 1 East Bound Lane. For pile notes and details not shown see Pier Details, sheet 7.
Drive all footing pile as shown, except test-load pile. Drive test-load pile to 20± ton. Top of anchor piles shall be 3 ft above bottom of footing. Pile to be test load shall be driven without jacking.
The Resident Construction Engineer will notify the Materials Engineer in Ames when test-load pile is ready for loading.
Statically load test-load pile to yield point as described in Article 2501.14 of the Standard Specifications.
After testing, the test-load pile and the anchor piles shall be cut off to proper elevation and shall be left in acceptable condition for footing support.

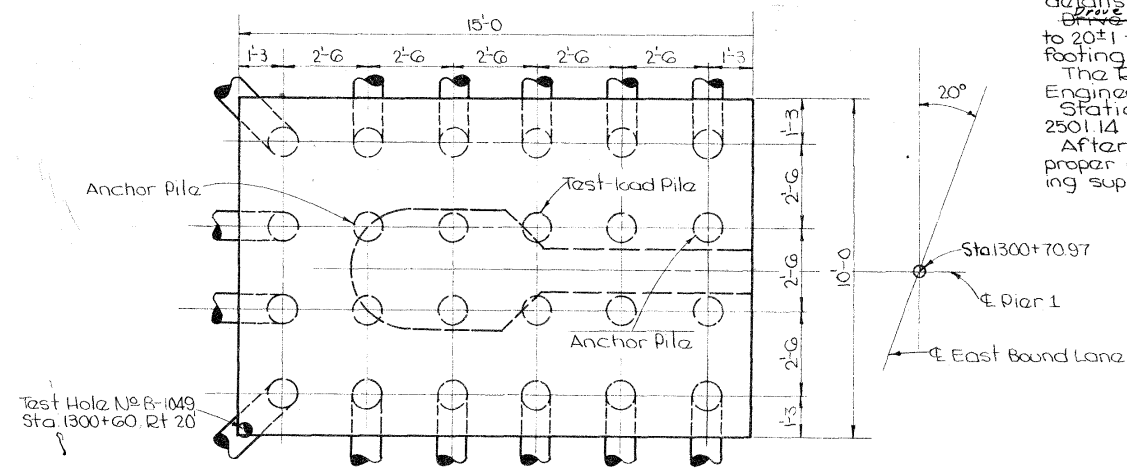

PILE LAYOUT
Pier 1 East Bound Lane
Bottom Footing El. = 860.00
Showing pile designated for test loading

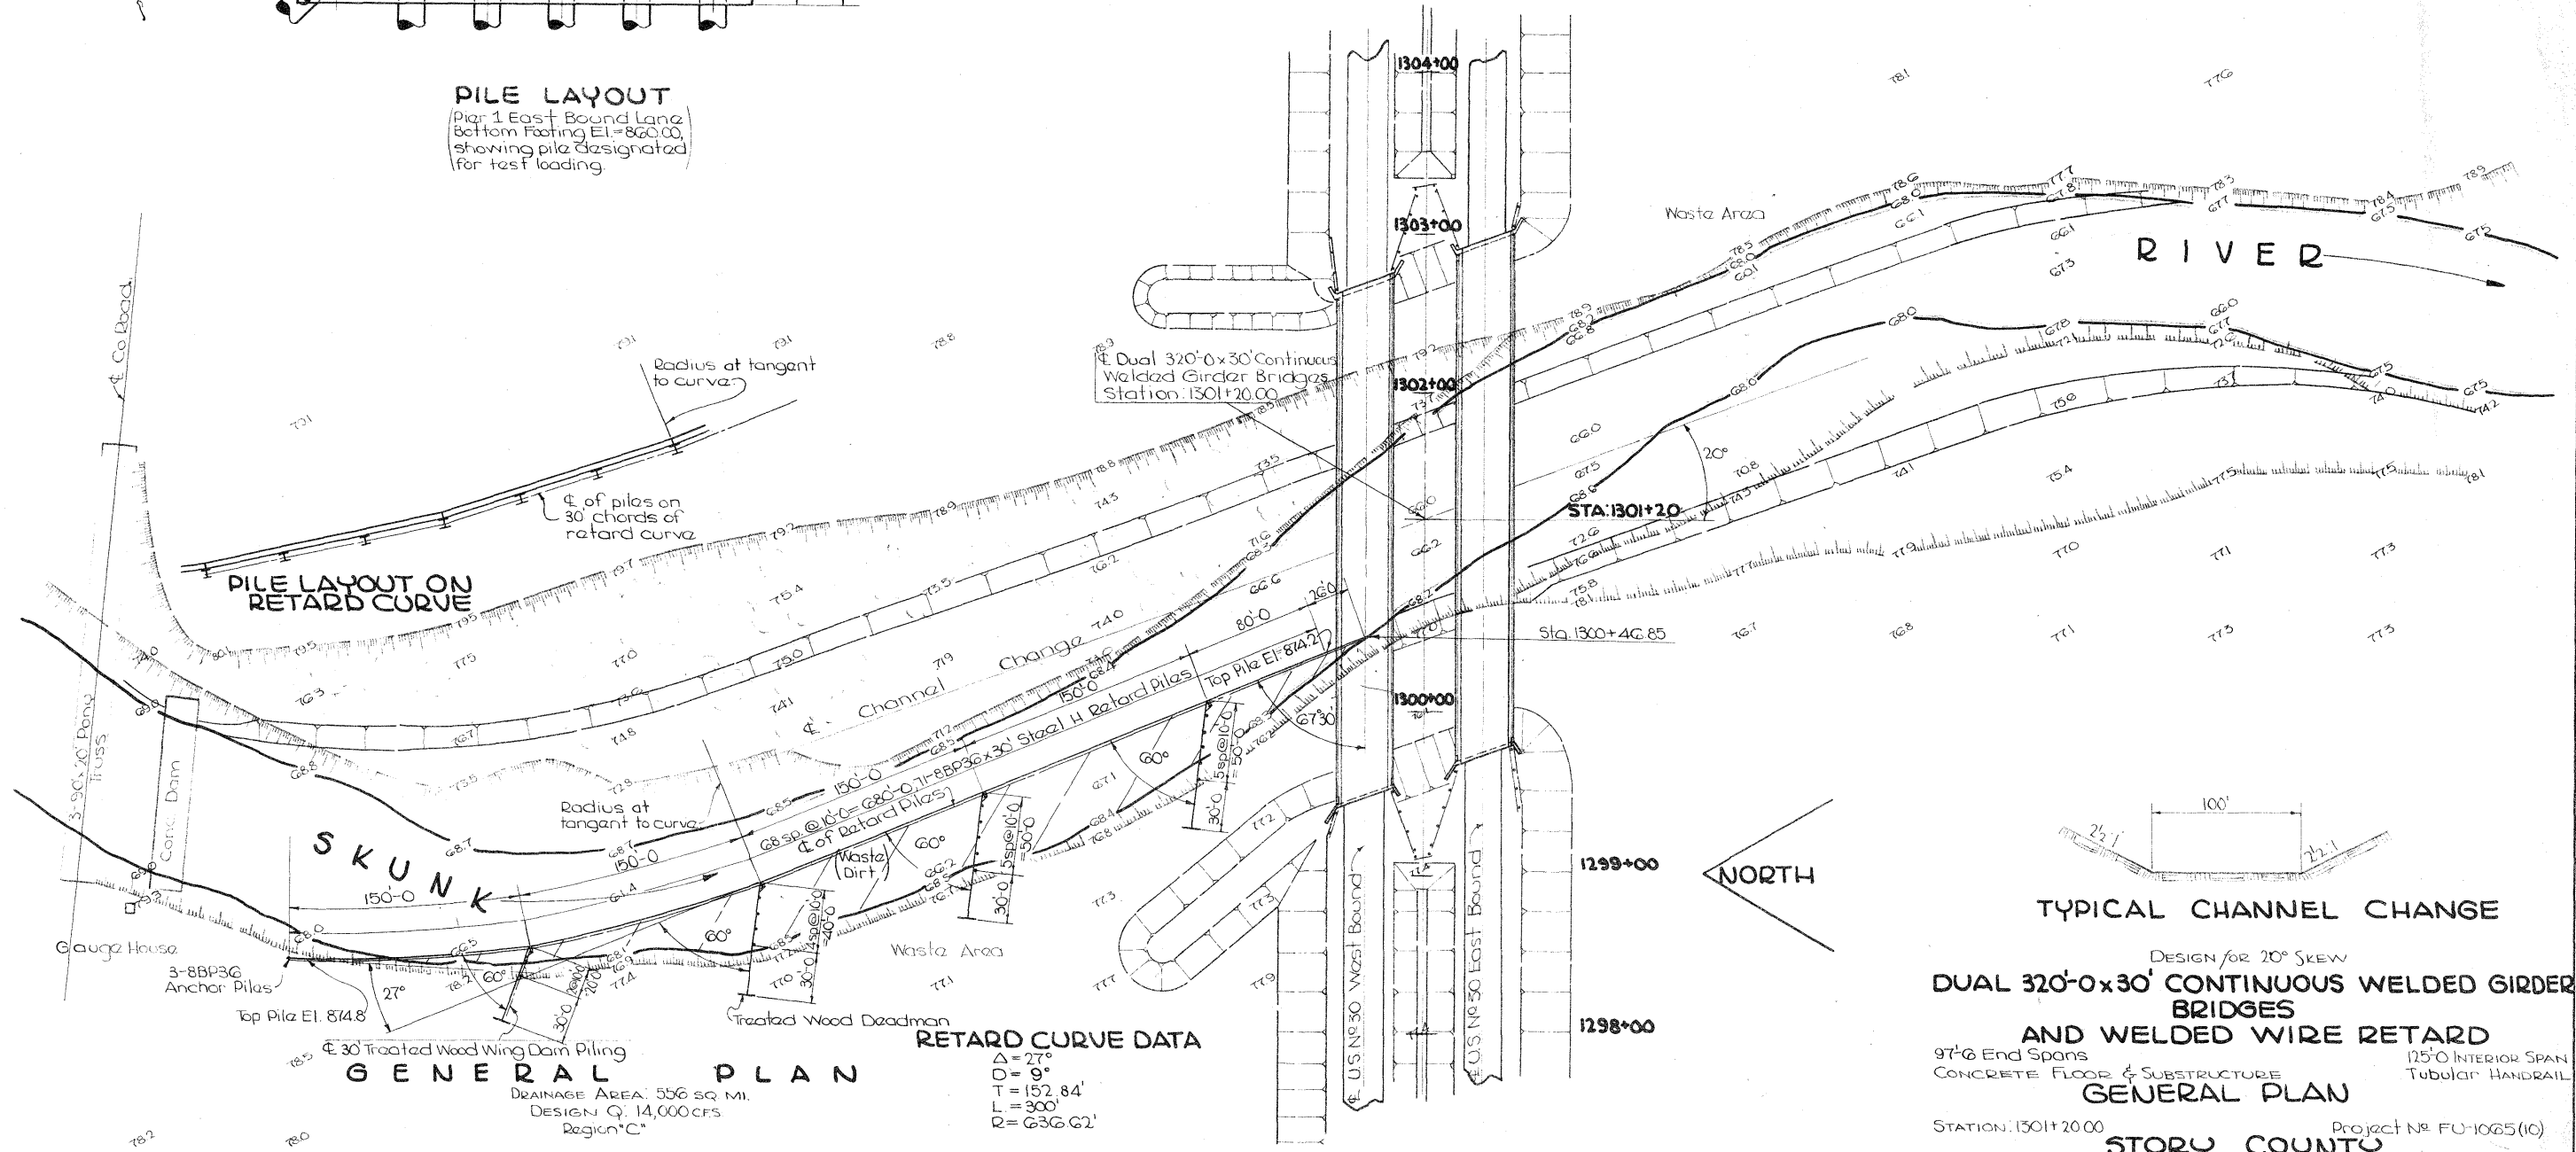

PILE LAYOUT ON RETARD CURVE




RETARD CURVE DATA
 $\Delta = 27^\circ$
 $D = 9'$
 $T = 152.84'$
 $L = 300'$
 $R = 636.62'$

TYPICAL CHANNEL CHANGE


DESIGN FOR 20° SKEW
DUAL 320'-0" x 30' CONTINUOUS WELDED GIRDER BRIDGES
AND WELDED WIRE RETARD
97'-6" End Spans
CONCRETE FLOOR & SUBSTRUCTURE
GENERAL PLAN
125'-0" INTERIOR SPAN
TUBULAR HANDRAIL

STATION: 1301+20.00
Iowa STATE HIGHWAY
December 1962
DESIGN N^o 3061
Project No. FU-1065 (10)
STORY COUNTY
COMMISSION
SHEET 2 OF 15
File No. 21508



Branch Mark No. 73 Sta. 1300+91, R.R. spike in E. side 15' Willow, 122' El. Elevation = 878.13
238 Sta. 1299+80 E.H.C. B.M. on S.W. wing E.B. Bridge Elev. 891.75
248 Sta. 1302+60 E.H.C. B.M. on N.E. wing W.B. Bridge Elev. 891.74

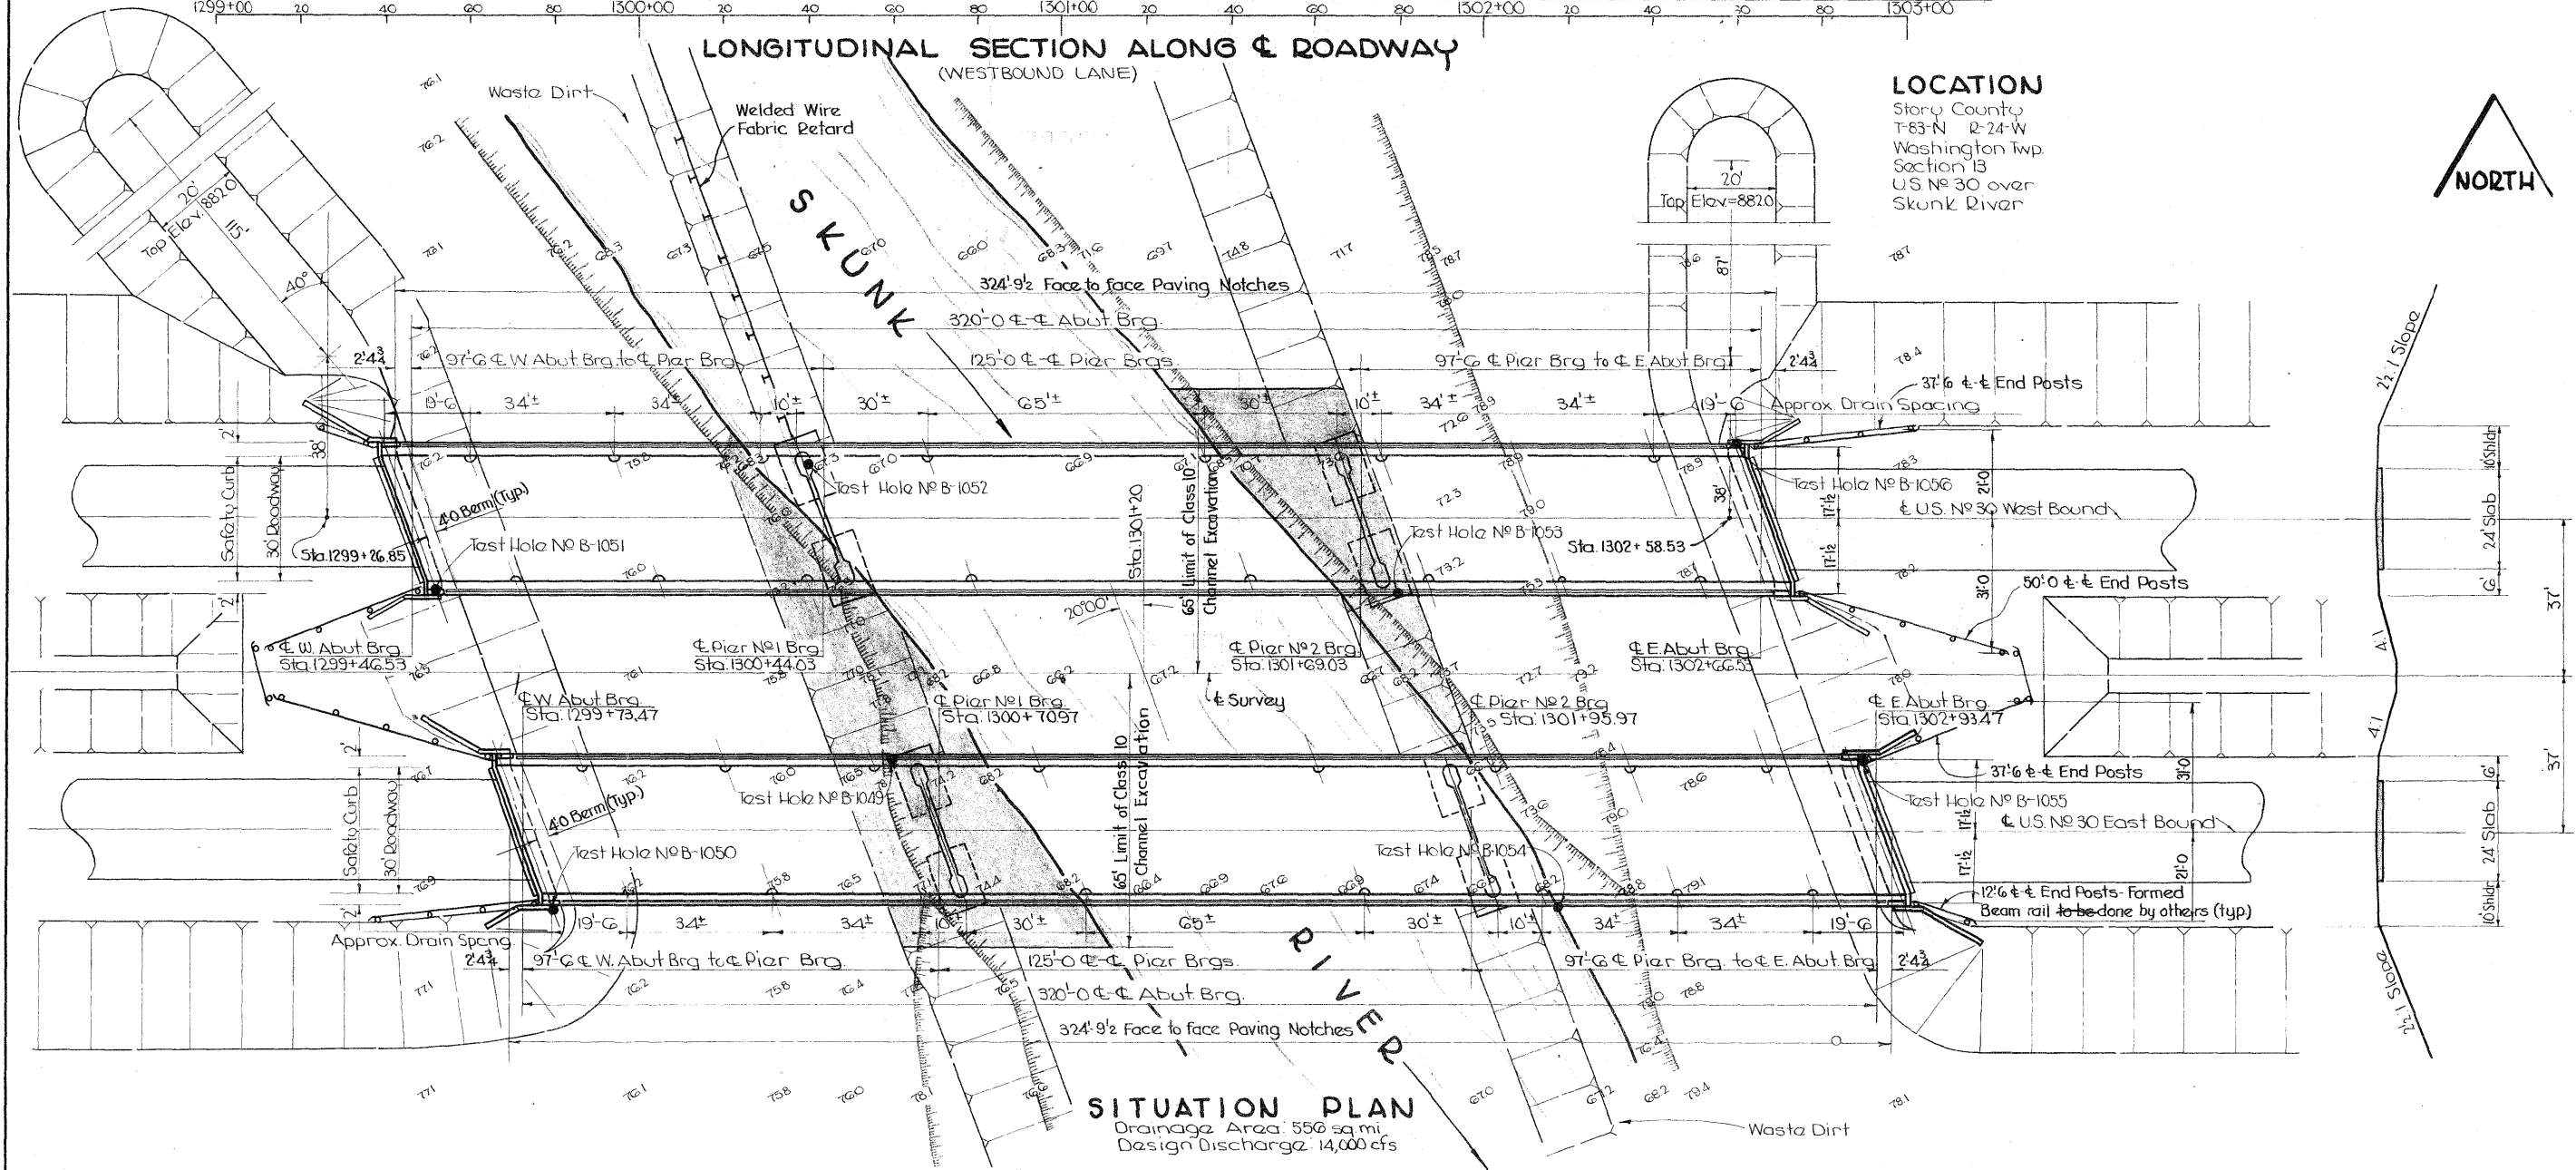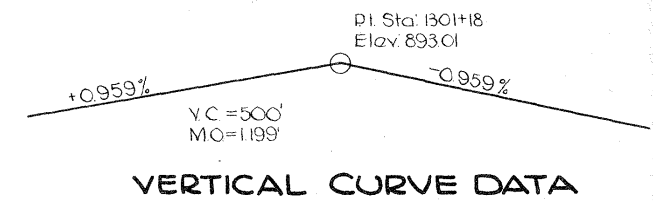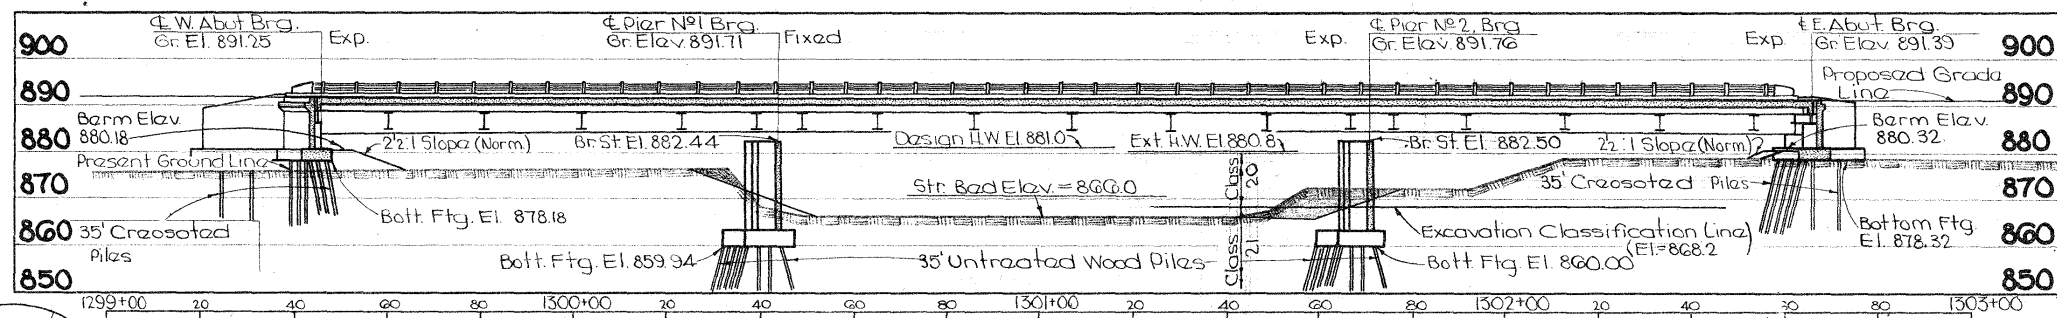



TYPICAL APPROACH SECTION

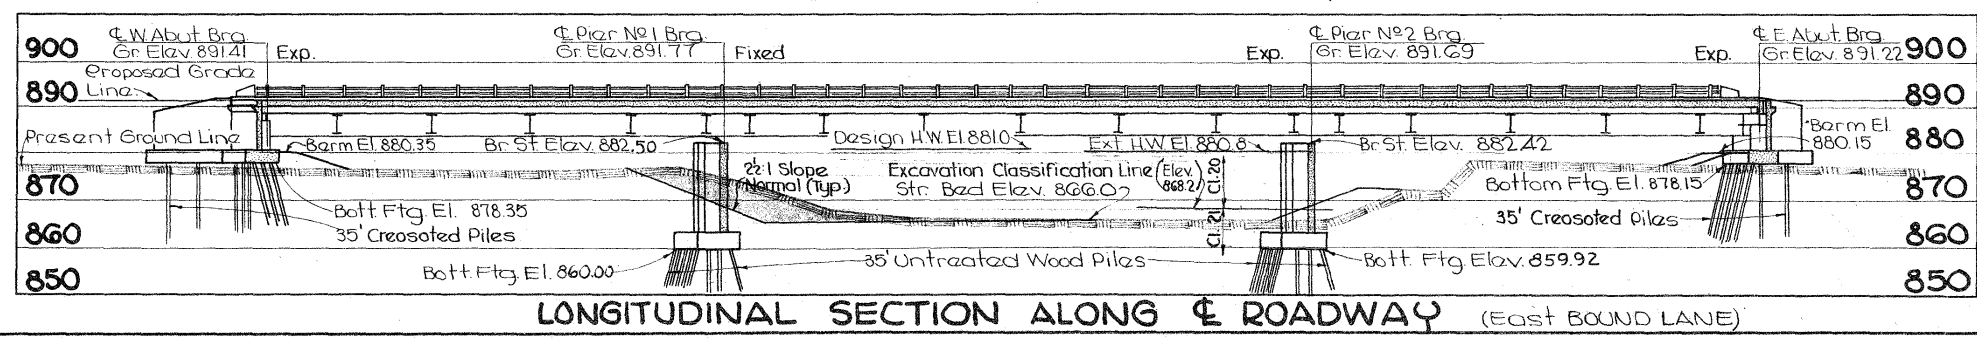

DESIGN FOR 20° SKEW
DUAL 320'-0" x 30' CONTINUOUS WELDED GIRDER BRIDGES
AND WELDED WIRE RETARD
2x 97'-6" END SPANS 125'-0" INTERIOR SPAN
CONCRETE FLOOR & SUBSTRUCTURE TUBULAR HAND RAIL
SITUATION PLAN
STATION: 1301+20.00 Project No. FU-1005(10)
STORY COUNTY
IOWA STATE HIGHWAY COMMISSION
DECEMBER 1962 SHEET 4 OF 15
DESIGN No. 3061 STORY COUNTY FILE No. 21508
TRACED BY: JEFFREY CHECKED BY: JPH

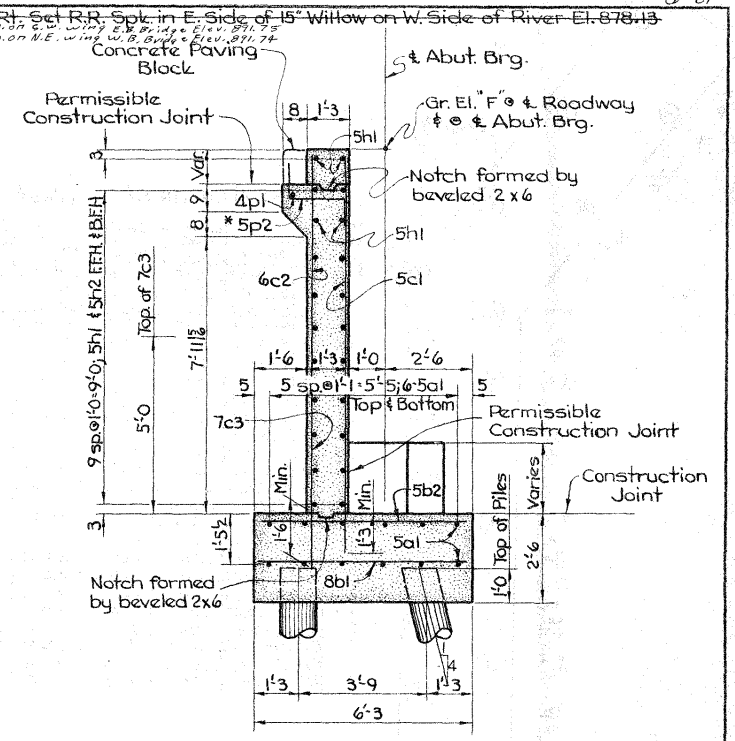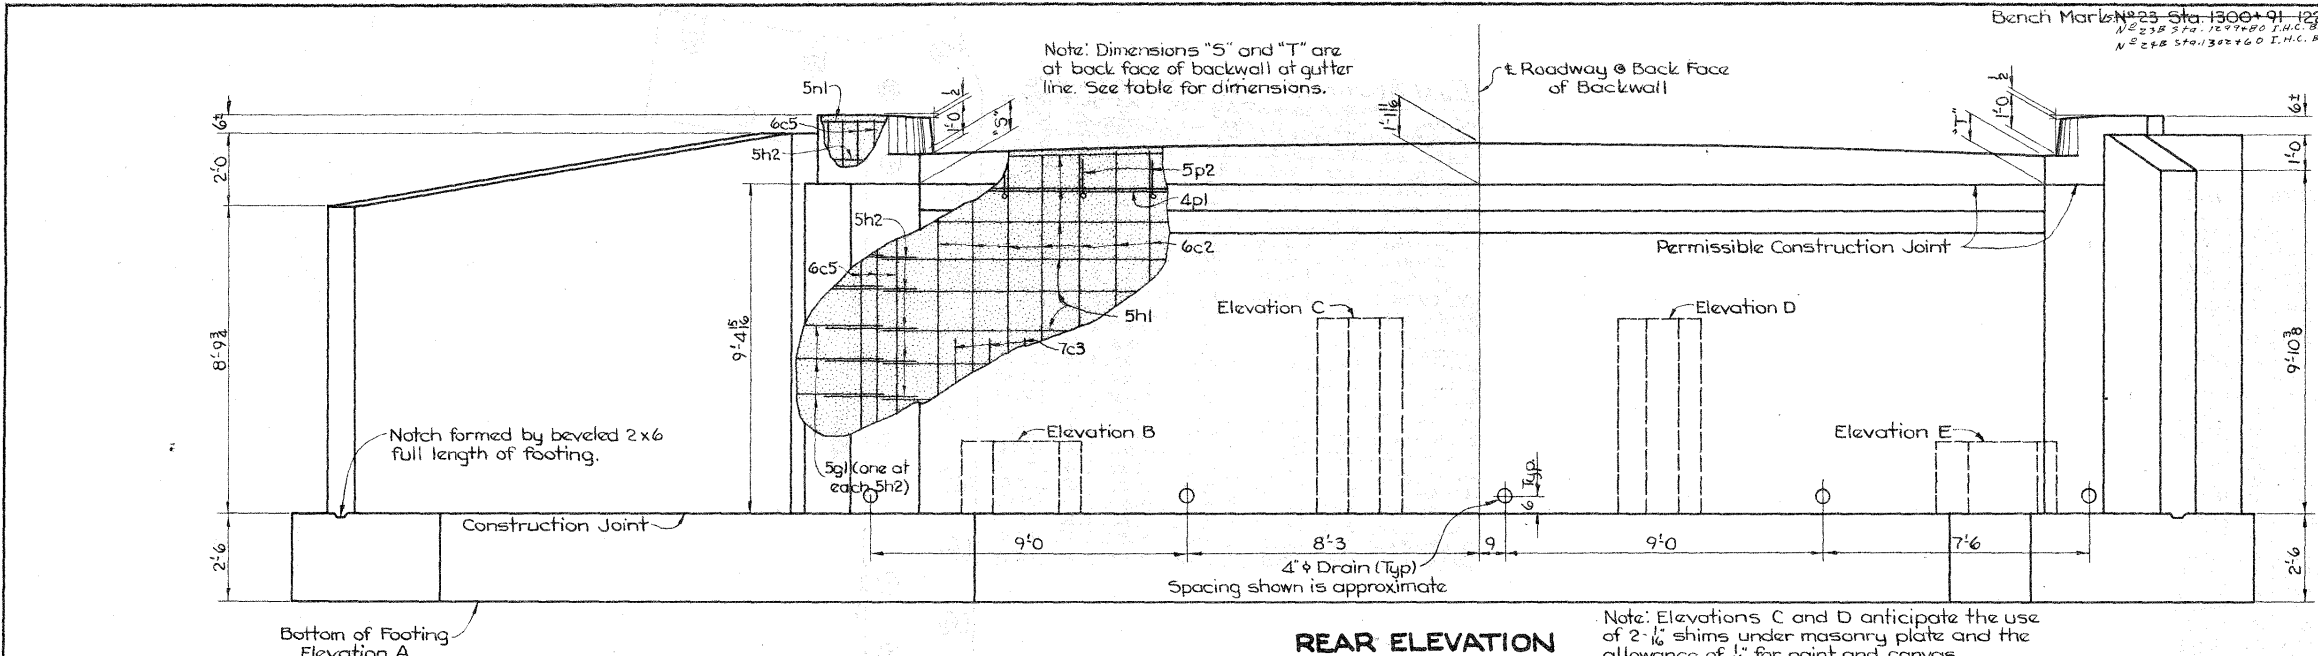

DIMENSION TABLE		
Abutment Location	*S	*T
Westbound Lane ~ West Abut.	10	10 1/2
Eastbound Lane ~ West Abut.	10 1/2	10 1/2
Westbound Lane ~ East Abut.	10 1/2	10 1/2
Eastbound Lane ~ East Abut.	10	10 1/2

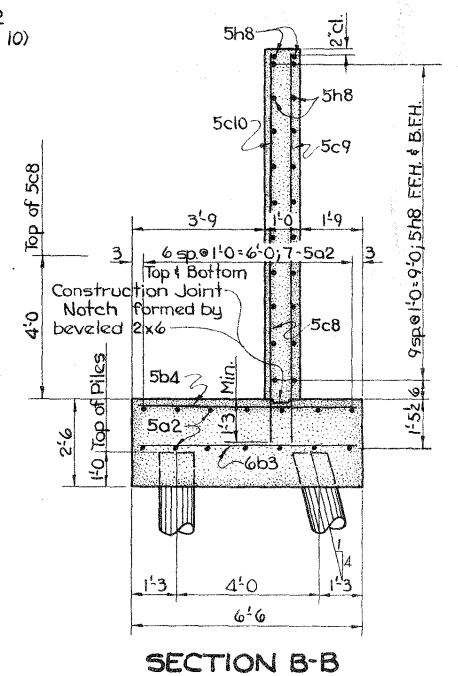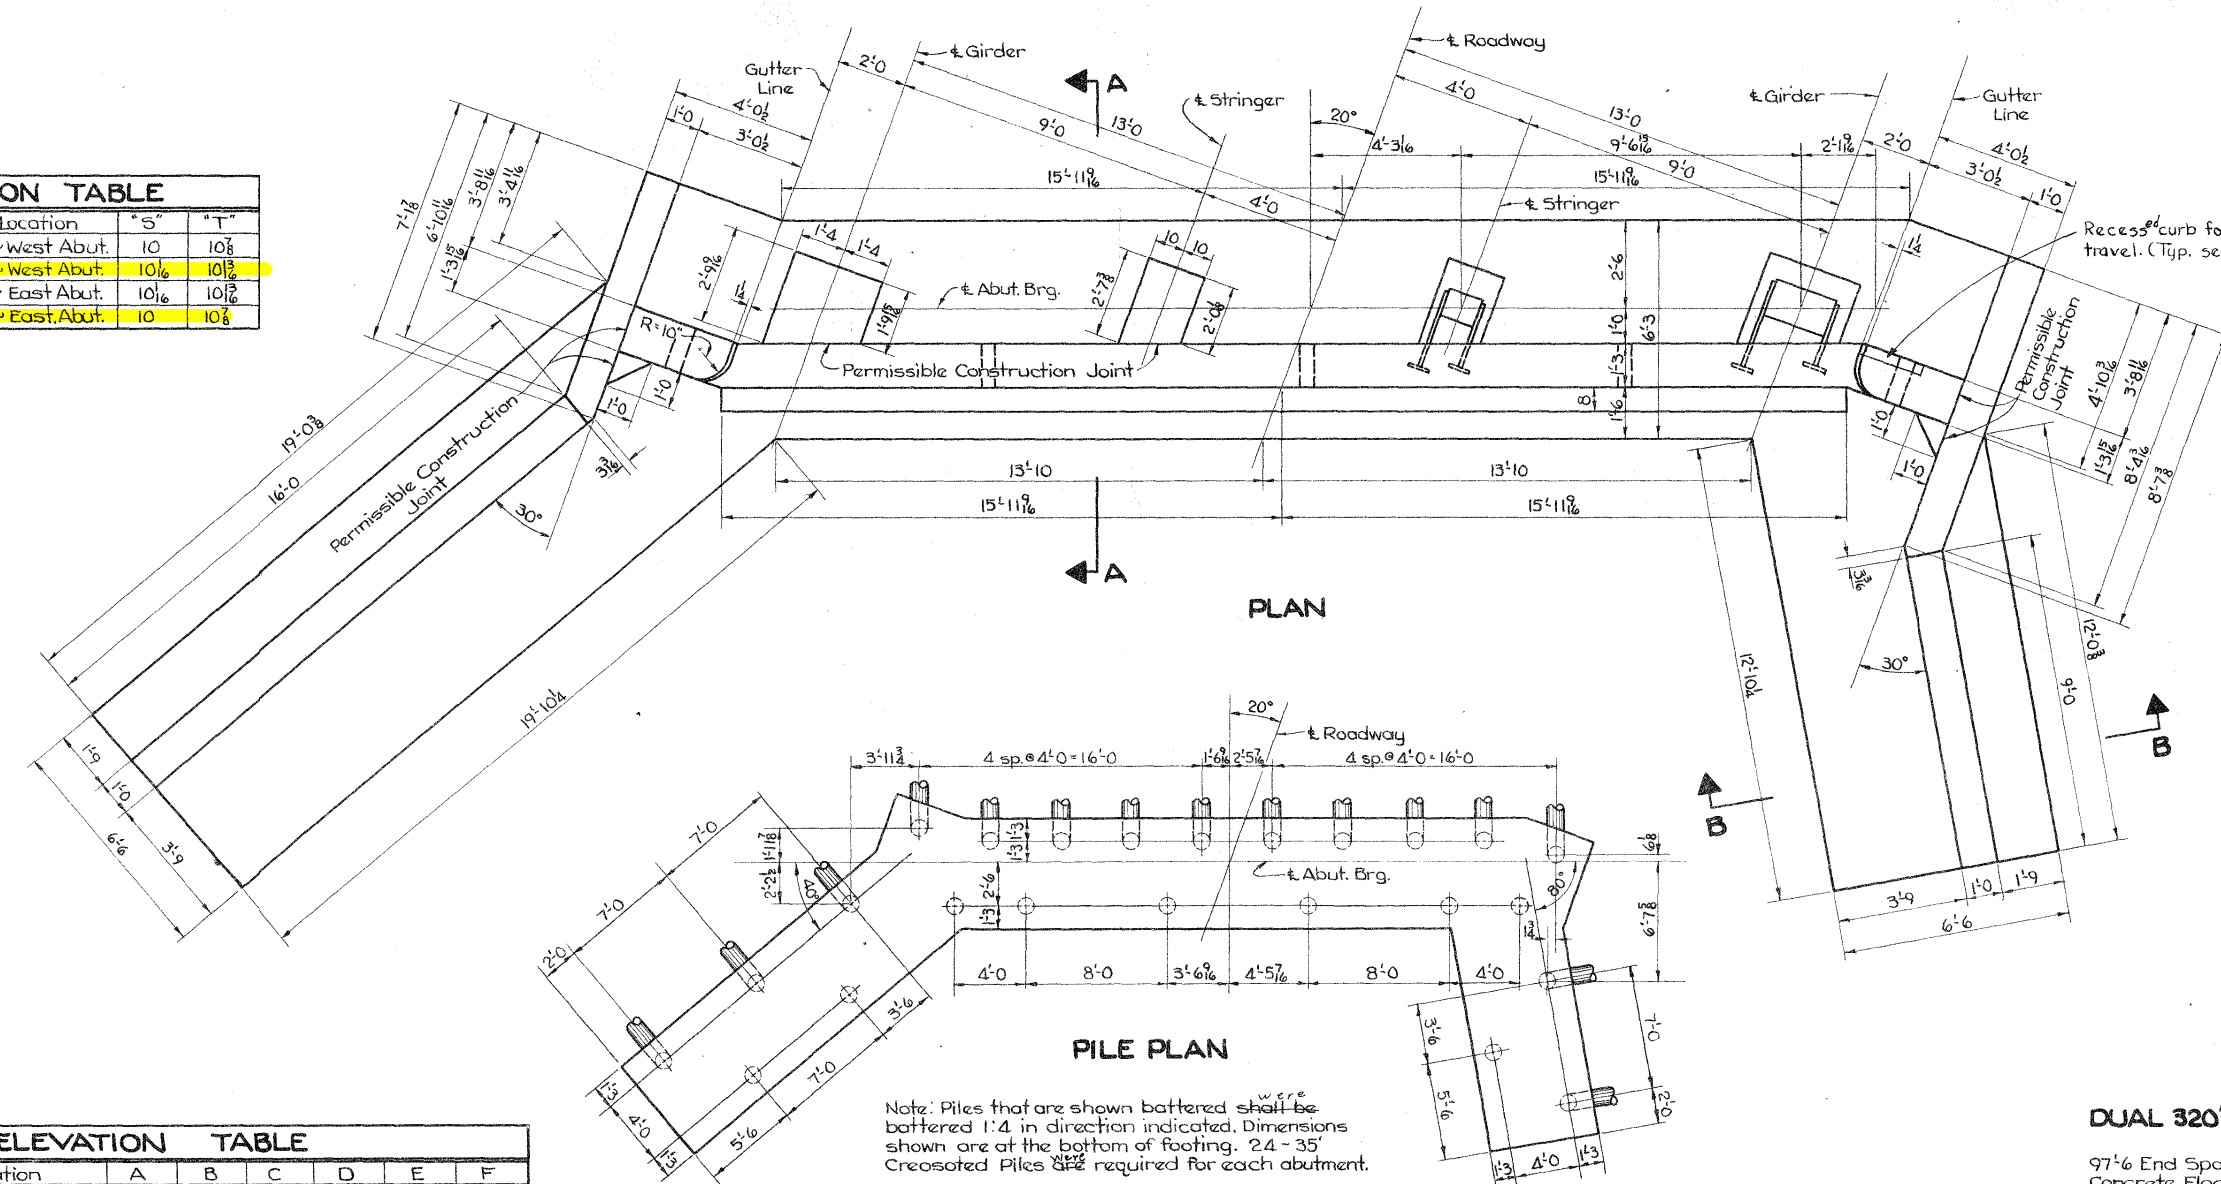


ELEVATION TABLE						
Abutment Location	A	B	C	D	E	F
Westbound Lane ~ West Abut.	878.18	882.68	886.16	886.18	882.74	891.25
Eastbound Lane ~ West Abut.	878.35	882.85	886.32	886.34	882.90	891.41
Westbound Lane ~ East Abut.	878.32	882.82	886.30	886.32	882.88	891.39
Eastbound Lane ~ East Abut.	878.15	882.65	886.13	886.15	882.72	891.22


Design for 20° Skew
DUAL 320'-0" x 30' CONTINUOUS WELDED GIRDER BRIDGES AND WELDED WIRE RETARD
97'-6" End Spans
Concrete Floor & Substructure
Station: 1301 + 20.00
December 1962
Design No 3061

125'-0" Interior Span
Tubular Handrail
ABUTMENT DETAILS
Project No FU-1065(10)
STORY COUNTY
Iowa State Highway Commission
Story County


Sheet 5 of 15
File No 21508
Checked by: CED

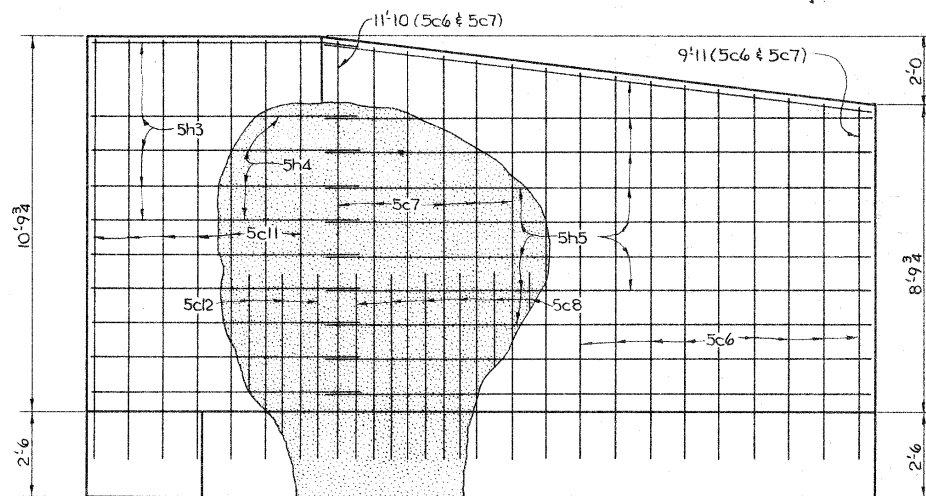


VIEW D-D

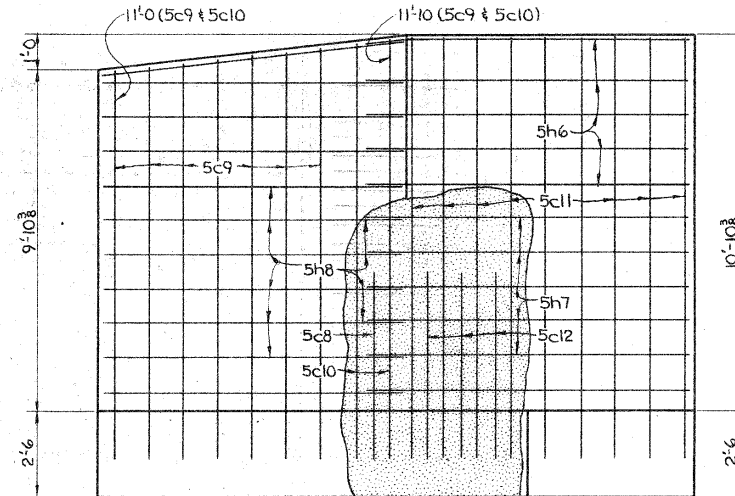


VIEW E-E

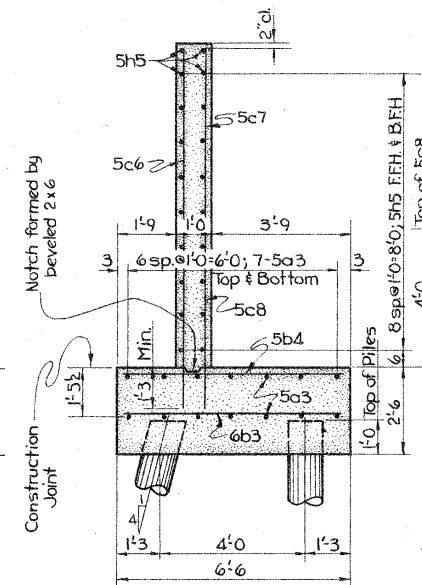


SECTION C-C

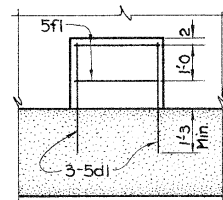

PART VIEW F-F

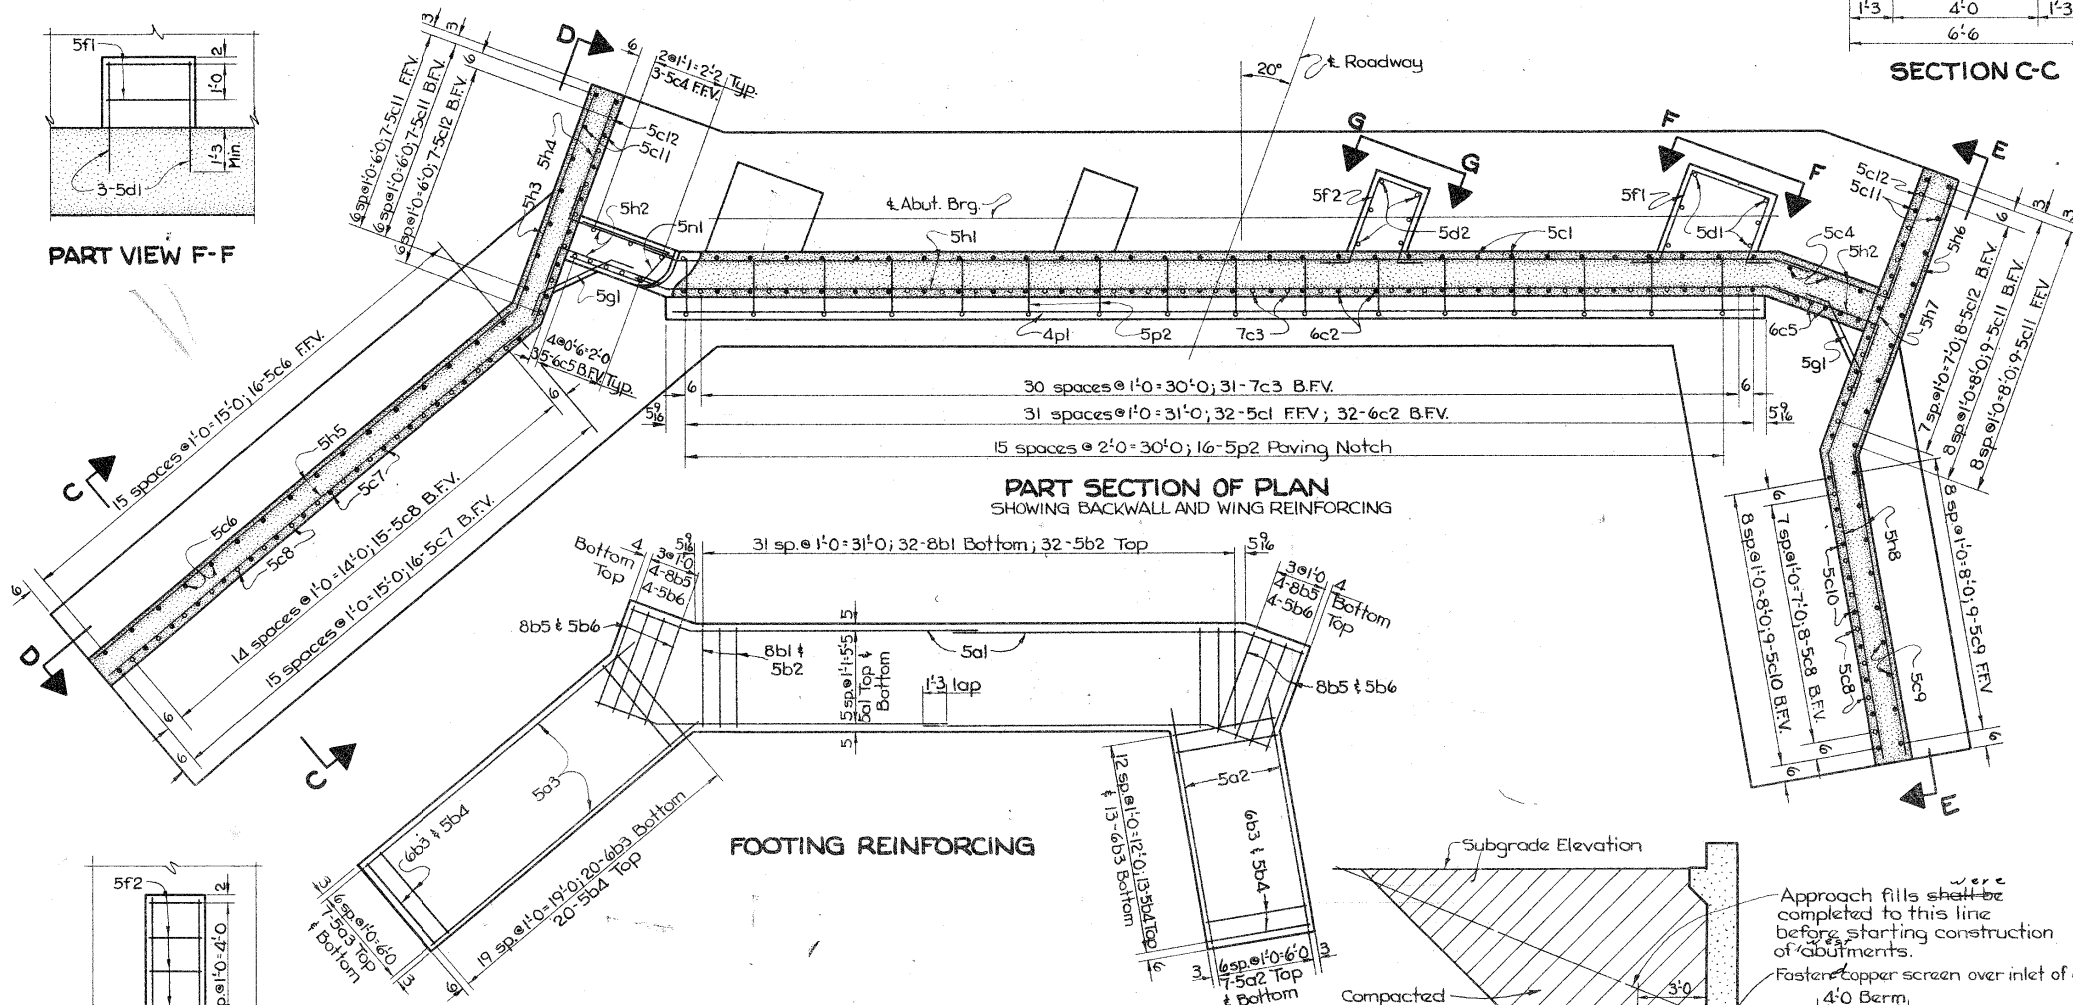


PART SECTION OF PLAN
SHOWING BACKWALL AND WING REINFORCING

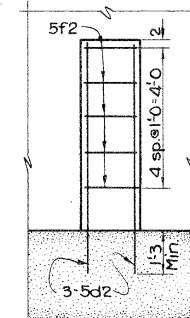


PART VIEW G-G

ABUTMENT NOTES:
All exposed corners of 90° or sharper are to be filleted with a 3" dressed and beveled strip.
Minimum clear distance from face of concrete to near reinforcing bar is to be 2" unless otherwise noted or shown.
The Bridge Contractor is to backfill abutments between wings to subgrade elevation with granular backfill complying with Section 4133 of the Standard Specifications.
Piling shall be driven to full penetration, if practicable, but to not less than 20 ton nor more than 40 ton bearing value.
The porous backfill material to be used along the backwall and wings shall comply with Section 4131 of the Standard Specifications.

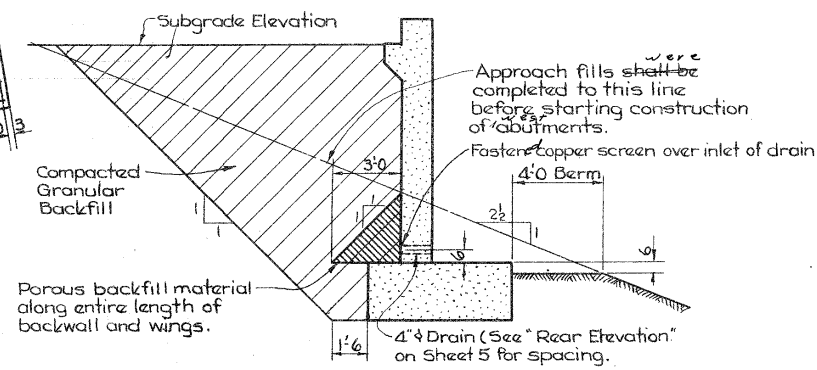

SECTION SHOWING SPECIAL BACKFILL
Note: Excavation outside of the limits shown shall also be backfilled with granular backfill but at the Contractor's expense.

REINFORCING STEEL ~ ONE ABUTMENT					
Bar	Location	Shape	Nº	Length	Weight
5a1	Footing, Top & Bottom, Longitudinal	24	20	5	511
5a2	Wing Footing, Top & Bottom, Longitudinal	14	13	8	199
5a3	Wing Footing, Top & Bottom, Longitudinal	14	20	8	302
8b1	Footing, Bottom, Transverse	32	5	11	505
5b2	Footing, Top, Transverse	32	5	11	197
6b3	Wing Footing, Bottom, Transverse	33	6	2	306
5b4	Wing Footing, Top, Transverse	33	6	2	212
8b5	Footing, Bottom, Transverse	8	6	3	133
5b6	Footing, Top, Transverse	8	6	3	52
5c1	Backwall, F.F.V.	32	11	8	389
6c2	Backwall, B.F.V.	32	11	11	573
7c3	Backwall, B.F.V.	31	6	6	412
5c4	Backwall, F.F.V.	6	12	4	77
6c5	Backwall, B.F.V.	10	12	7	189
5c6	Long Wing, F.F.V.	16	Varies		181
5c7	Long Wing, B.F.V.	16	Varies		181
5c8	Both Wings, B.F.V.	23	5	3	126
5c9	Short Wing, F.F.V.	9	Varies		107
5c10	Short Wing, B.F.V.	9	Varies		107
5c11	Both Wings, F.F.V. & B.F.V.	32	11	11	398
5c12	Both Wings, B.F.V.	15	5	3	82
5d1	Step, Girder Bearing, Vertical	12	3	2	40
5d2	Step, Floor Beam Bearing, Vertical	12	6	7	82
5f1	Step, Girder Bearing, Horizontal	4	8	6	35
5f2	Step, Floor Beam Bearing, Horizontal	10	7	7	79
5g1	Backwall & Wing Fillet	20	3	5	71
5h1	Backwall, F.F.H. & B.F.H.	22	34	5	790
5h2	Backwall, F.F.H. & B.F.H.	44	4	2	191
5h3	Long Wing, F.F.H.	10	8	0	83
5h4	Long Wing, B.F.H.	10	8	4	87
5h5	Long Wing, B.F.H. & F.F.H.	20	15	9	329
5h6	Short Wing, F.F.H.	11	9	6	109
5h7	Short Wing, B.F.H.	11	9	10	113
5h8	Short Wing, B.F.H. & F.F.H.	22	8	9	201
5n1	Backwall, Curb, Horizontal	2	6	1	13
4p1	Backwall, Paving Notch, Horizontal	1	3	1	21
5p2	Backwall, Paving Notch, Vertical	16	3	3	54
Total					7537 lbs.

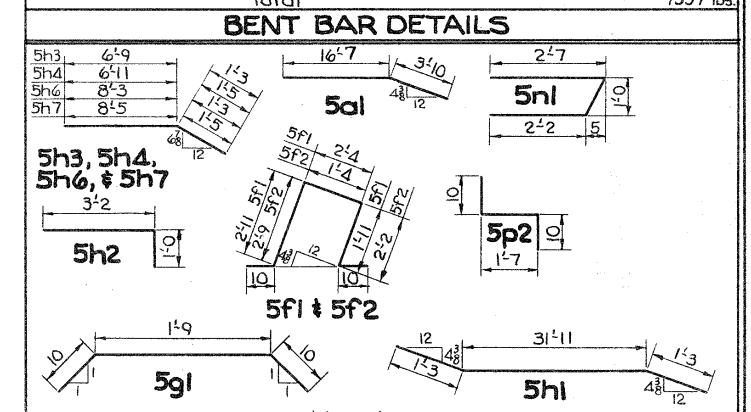


Note: All dimensions are out to out.

CONCRETE PLACEMENT QUANTITIES ~ ONE ABUT.	
Footing	40.5
Wings	15.6
Bearing Seats & Backwall below Construction Joint	20.4
Backwall above Construction Joint	2.1
Paving Block	0.8
Total	79.4 c.y.

ESTIMATED QUANTITIES ~ 4 ABUTMENTS	
Item	Quantity
Concrete	317.6 c.y.
Reinforcing Steel	30,128 lbs.
Crescoted Piling 96 @ 35'	3360 L.F.
Class 20 Excavation	748 c.y.
Granular Backfill	897 tons
Porous Backfill	46 c.y.


Design for 20° Skew
DUAL 320'-0" x 30' CONTINUOUS WELDED GIRDER BRIDGES AND WELDED WIRE RETARD
97'-6" End Spans
Concrete Floor & Substructure
Station: 1301 + 20.00
December 1962
Design Nº 3061
125'-0" Interior Span
Tubular Handrail
ABUTMENT DETAILS
Project Nº FU-1065(10)
STORY COUNTY
Iowa State Highway Commission
Story County
Sheet 6 of 15
File Nº 21508

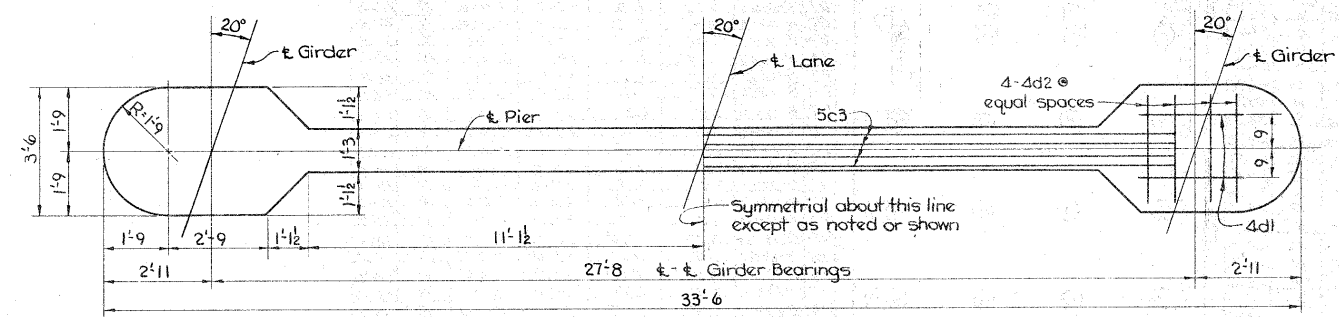


TOP VIEW

*Grade to Pier Top (Includes 1/8" for paint & canvas)
E. Bound Lane - Pier 1: 9'-3 3/4"; Pier 2: 9'-3 3/4"
W. Bound Lane - Pier 1: 9'-3 3/4"; Pier 2: 9'-3 3/4"

*Grade El. E. Bound Lane: Pier 1: 891.77; Pier 2: 891.69
W. Bound Lane: Pier 1: 891.71; Pier 2: 891.76
Top of Pier El. E. Bound Lane: Pier 1: 882.50; Pier 2: 882.42
W. Bound Lane: Pier 1: 882.44; Pier 2: 882.50

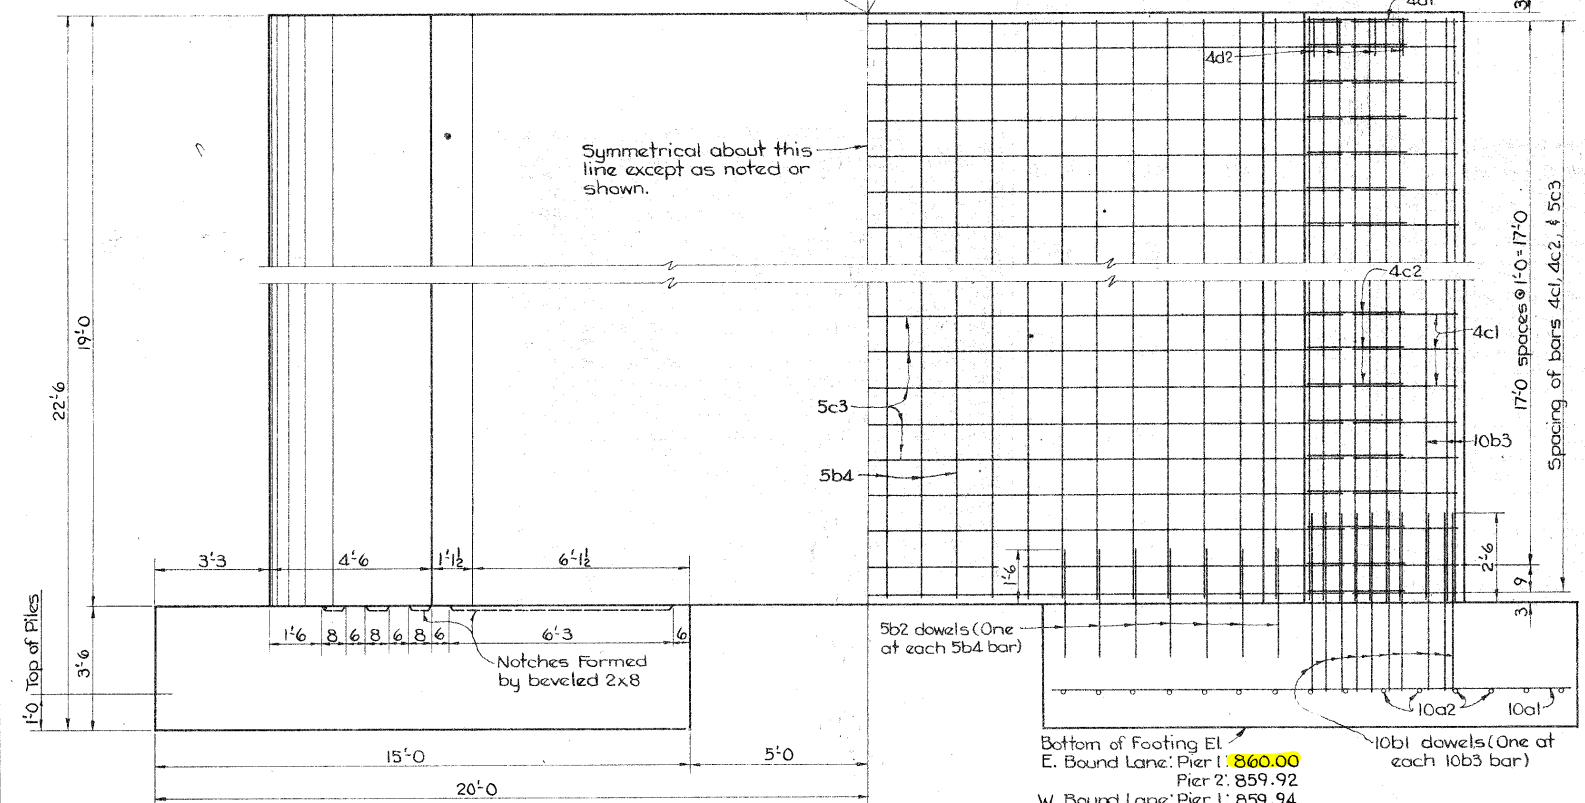


ELEVATION
(Piles not shown)

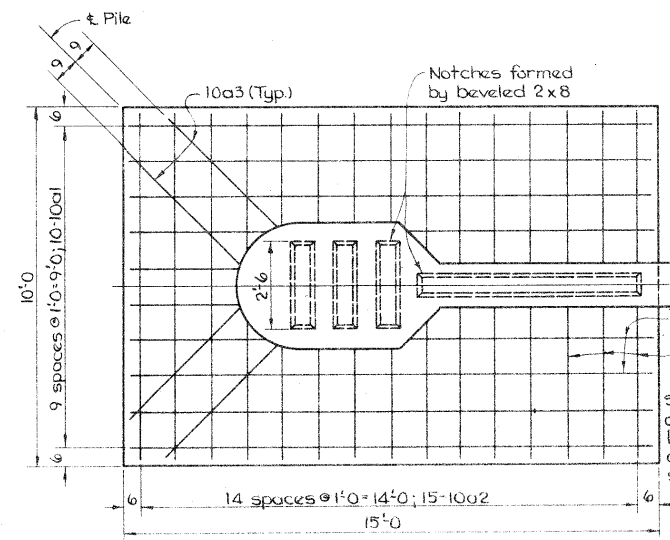


HALF PLAN


Showing Footing Reinforcing Layout

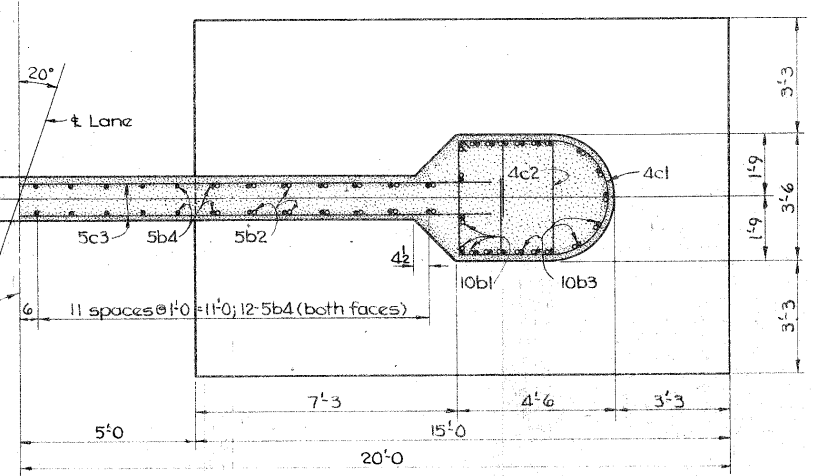


HALF SECTION

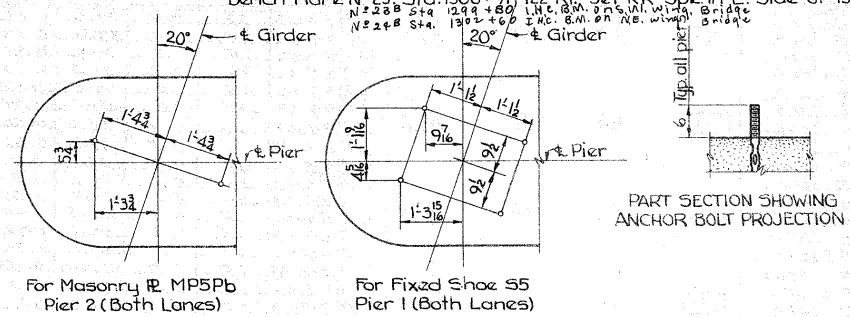


ANCHOR BOLT SETTING DETAILS

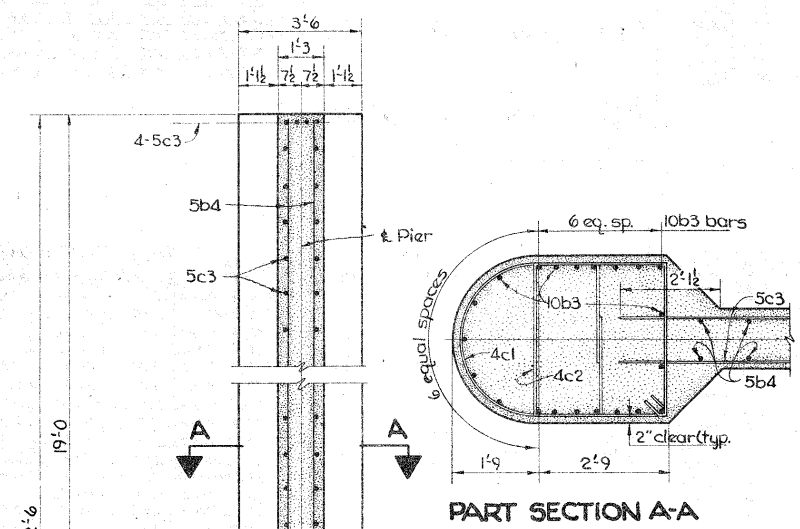

PART SECTION A-A

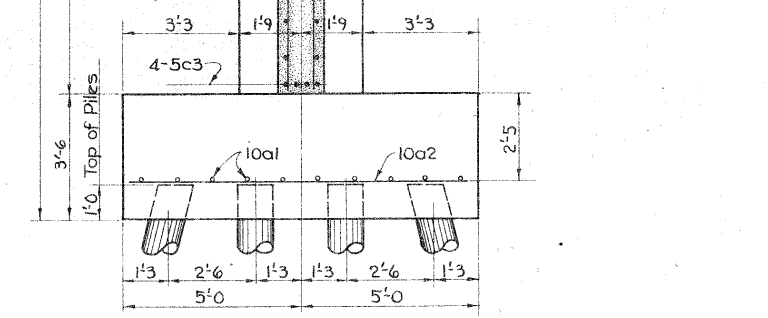

SECTION

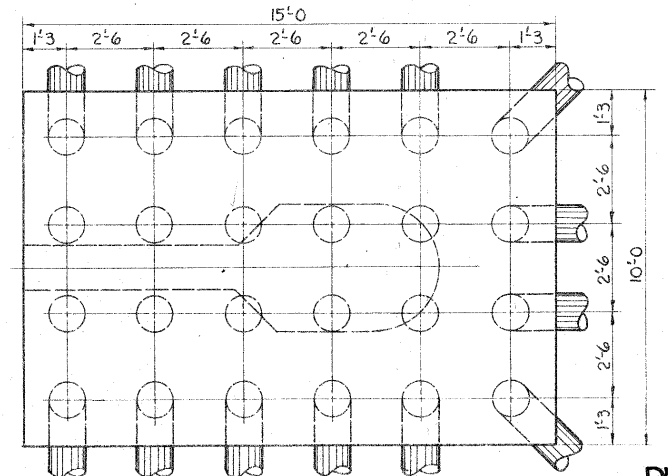

FOOTING PLAN

Note: Battered piles shall be battered 1/4 in direction indicated. Pile spacing is at bottom of footing.
48'-35' Untreated Wood Piles are required for each pier.

REINFORCING STEEL ~ ONE PIER					
Bar	Location	Shape	Nº	Length	Weight
10a1	Footing, Longitudinal		20	14'-8"	1262
10a2	Footing, Transverse		30	9'-8"	1248
10a3	Footing, Outside Corners		8	6'-6"	224
10b1	Column Dowels		42	5'-0"	904
5b2	Diaphragm Dowels		28	3'-0"	88
10b3	Column, Vertical		42	18'-9"	3389
5b4	Diaphragm, Vertical		48	18'-8"	935
4c1	Column Hoops	D	40	11'-7"	309
4c2	Column Hoops		40	12'-6"	334
5c3	Diaphragm, Horizontal		44	26'-6"	1216
4d1	Column, Top, Longitudinal		4	3'-0"	8
4d2	Column, Top, Transverse		8	4'-8"	25
Total					9942 lbs.


BENT BAR DETAILS	
Note: All dimensions are out to out. Radii are to center of bar.	

CONCRETE PLACEMENT QUANTITIES ~ ONE PIER		
Footings	2 @ 18.7	37.4
Column		43.6
Total		81.0 c.y.

ESTIMATED QUANTITIES ~ FOUR PIERS	
Item	Quantity
Concrete	324.0 c.y.
Reinforcing Steel	39,768 lbs.
Untreated Wood Piling (Oak or Gumwood) 192 @ 35'	6720 l.f.
Class 20 Excavation	140 c.y.
Class 21 Excavation	520 c.y.

PIER NOTES:
All exposed corners of 90° or sharper are to be filleted with a 3" dressed and beveled strip.
Reinforcing steel shall be securely wired in place before concrete is placed.
Minimum clear distance from face of concrete to near reinforcing bar is to be 2" unless otherwise noted or shown.
Anchor bolts shall be set during placing of concrete in accordance with Section 2405.09 of the Standard Specifications. Weight of anchor bolts is included in superstructure "Structural Steel" estimate.
Piling shall be 35' untreated oak or gum wood. Required piling length shall be determined by desired penetration of piling. Piling shall be driven and jacked as close as practicable to desired penetration, but to at least 20 tons bearing value.
A test-load pile shall be driven at Pier 1, East Bound Lane. See General Plan, sheet 2, for details.


Design for 20° Skew
DUAL 320'-0" x 30" CONTINUOUS WELDED GIRDER BRIDGES AND WELDED WIRE RETARD
97% End Spans
Concrete Floor & Substructure
125% Interior Span
Tubular Handrail
PIER DETAILS
Station: 1301 + 20.00
Project Nº FU-1035(10)
STORY COUNTY
Iowa State Highway Commission
December 1962
Design Nº 3061
Story County
Sheet 7 of 15
File Nº 21503

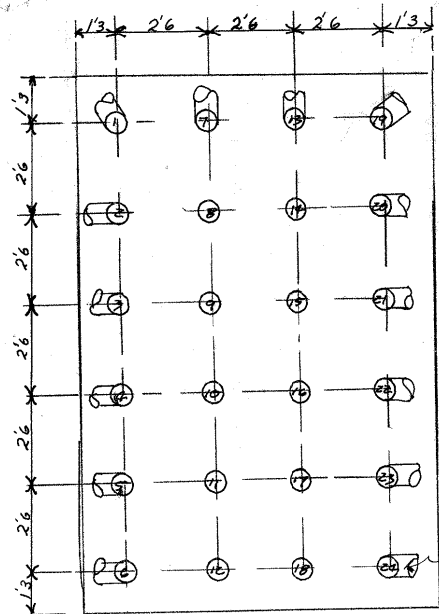


Pier No 1 West Bound Lane

Pile No.	Date Driven	Length in feet	Length cut off	Length in feet	Ave. Pen. in feet	Drop in feet	Bearing in tons
B1	8-16-63	35	1.0	34.0	1.35	8	28.9
B2	8-16-63	35	2.1	32.9	0.80	8	32.2
B3	8-16-63	35	2.2	32.8	1.30	8	28.5
B4	8-16-63	35	1.4	33.6	1.30	8	28.8
B5	8-16-63	35	1.1	33.9	1.05	8	28.8
B6	8-16-63	35	0.9	34.1	1.00	8	28.8
B7	8-16-63	35	1.8	33.2	1.05	8	28.8
B8	8-16-63	35	1.4	33.6	0.95	8	31.7
B9	8-16-63	35	1.7	33.3	1.10	8	28.4
B10	8-16-63	35	1.4	33.6	0.75	8	32.4
B11	8-16-63	35	1.7	33.3	0.80	8	35.5
B12	8-16-63	35	2.3	32.7	0.85	8	32.5
B13	8-16-63	35	1.0	34.0	0.85	8	32.4
B14	8-16-63	35	1.3	33.7	0.75	8	37.4
B15	8-16-63	35	1.4	33.6	0.70	8	39.2
B16	8-16-63	35	1.2	33.8	1.10	8	28.0
B17	8-16-63	35	1.6	33.4	0.80	8	35.8
B18	8-16-63	35	1.2	33.8	0.85	8	38.3
B19	8-16-63	35	1.7	33.3	1.10	8	26.9
B20	8-16-63	35	2.3	32.7	0.95	8	30.0
B21	8-16-63	35	1.5	33.5	1.00	8	28.8
B22	8-16-63	35	1.7	33.3	0.90	8	31.5
B23	8-16-63	35	1.3	33.7	1.05	8	27.8
B24	8-16-63	35	2.1	32.9	0.55	8	43.3

Battered 1:4

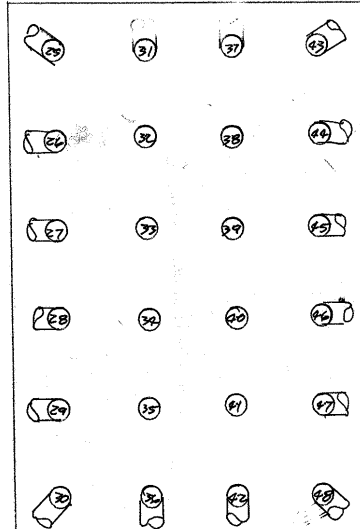


Pile No.	Date Driven	Length in feet	Length cut off	Length in feet	Ave. Pen. in feet	Drop in feet	Bearing in tons
B25	8-16-63	35	1.0	34.0	0.80	8	33.2
B26	8-16-63	35	0.1	34.9	0.875	8	31.6
B27	8-16-63	35	1.6	33.4	0.85	8	32.6
B28	8-16-63	35	0.3	34.7	1.10	8	26.9
B29	8-16-63	35	1.4	33.6	1.25	8	22.9
B30	8-16-63	35	0.4	34.6	0.85	8	32.4
B31	8-16-63	35	1.4	33.6	1.20	8	26.6
B32	8-16-63	35	1.4	33.6	0.80	8	35.8
B33	8-16-63	35	1.5	33.5	1.20	8	26.6
B34	8-16-63	35	1.8	33.2	0.85	8	38.3
B35	8-16-63	35	1.7	33.3	1.10	8	28.4
B36	8-16-63	35	1.7	33.3	1.25	8	28.0
B37	8-16-63	35	1.9	33.1	0.75	8	32.4
B38	8-16-63	35	1.7	33.3	1.10	8	28.4
B39	8-16-63	35	1.6	33.4	0.95	8	32.7
B40	8-16-63	35	2.1	32.9	0.625	8	53.2
B41	8-16-63	35	1.4	33.6	0.95	8	31.7
B42	8-16-63	35	1.4	33.6	0.95	8	30.0
B43	8-16-63	35	1.7	33.3	1.10	8	26.5
B44	8-16-63	35	1.0	34.0	1.80	8	22.2
B45	8-16-63	35	1.4	33.6	0.90	8	31.2
B46	8-16-63	35	0.6	34.4	1.05	8	27.8
B47	8-16-63	35	1.0	34.0	0.95	8	30.0
B48	8-16-63	35	0.3	34.7	1.20	8	25.2

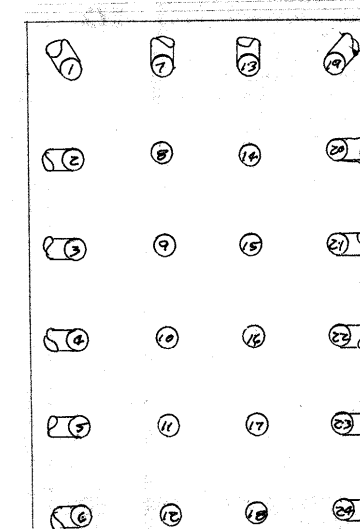

N 1/2 Pier No 2 East Bound Lane

Pile No.	Date Driven	Length in feet	Length cut off	Length in feet	Ave. Pen. in feet	Drop in feet	Bearing in tons
B49	9-6-63	35	0.8	34.2	1.30	8	26.2
B50	9-6-63	35	1.0	34.0	1.10	8	26.9
B51	9-6-63	35	1.1	33.9	0.85	8	32.4
B52	9-6-63	35	0.7	34.3	1.00	8	30.5
B53	9-6-63	35	1.3	33.7	0.90	8	31.2
B54	9-6-63	35	1.1	33.9	1.25	8	28.3
B55	9-6-63	35	0.9	34.1	1.10	8	26.9
B56	9-6-63	35	0.8	34.2	0.85	8	38.3
B57	9-6-63	35	0.8	34.2	0.85	8	38.3
B58	9-6-63	35	0.8	34.2	1.00	8	30.5
B59	9-6-63	35	0.7	34.3	1.50	8	21.1
B60	9-6-63	35	0.6	34.4	1.10	8	26.9
B61	9-6-63	35	0.7	34.3	0.90	8	32.0
B62	9-6-63	35	0.8	34.2	0.60	8	48.4
B63	9-6-63	35	1.1	33.9	0.50	8	58.5
B64	9-6-63	35	0.9	34.1	0.85	8	35.3
B65	9-6-63	35	0.9	34.1	1.00	8	30.5
B66	9-6-63	35	0.8	34.2	0.85	8	38.3
B67	9-6-63	35	0.9	34.1	1.30	8	26.9
B68	9-6-63	35	1.0	34.0	0.85	8	38.3
B69	9-6-63	35	1.0	34.0	1.10	8	28.4
B70	9-6-63	35	1.3	33.7	1.35	8	22.9
B71	9-6-63	35	0.9	34.1	0.65	8	58.7
B72	9-6-63	35	1.1	33.9	0.85	8	38.3
B73	9-6-63	35	0.7	34.3	0.75	8	43.3
B74	9-6-63	35	1.1	33.9	0.75	8	43.3
B75	9-6-63	35	0.3	34.7	0.90	8	36.2
B76	9-6-63	35	1.0	34.0	0.75	8	35.4

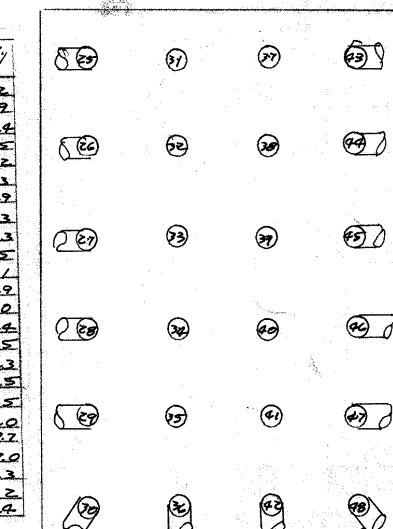


S 1/2 Pier No 2 East Bound Lane

Pile No.	Date Driven	Length in feet	Length cut off	Length in feet	Ave. Pen. in feet	Drop in feet	Bearing in tons
B77	9-6-63	35	1.4	33.6	1.10	8	26.9
B78	9-6-63	35	1.1	33.9	1.20	8	25.2
B79	9-6-63	35	1.1	33.9	0.90	8	31.2
B80	9-6-63	35	1.0	34.0	0.80	8	32.0
B81	9-6-63	35	1.0	34.0	0.90	8	31.2
B82	9-6-63	35	1.4	33.6	1.05	8	27.8
B83	9-6-63	35	0.9	34.1	0.80	8	35.8
B84	9-6-63	35	0.8	34.2	0.85	8	38.3
B85	9-6-63	35	1.1	33.9	0.85	8	38.3
B86	9-6-63	35	1.2	33.8	0.70	8	39.2
B87	9-6-63	35	1.1	33.9	0.875	8	32.6
B88	9-6-63	35	1.4	33.6	1.05	8	27.8
B89	9-6-63	35	0.8	34.2	1.00	8	30.5
B90	9-6-63	35	0.5	34.5	1.25	8	22.5
B91	9-6-63	35	0.9	34.1	1.30	8	26.9
B92	9-6-63	35	1.1	33.9	0.85	8	38.3
B93	9-6-63	35	1.0	34.0	1.10	8	28.4
B94	9-6-63	35	1.2	33.8	1.00	8	28.8
B95	9-6-63	35	1.1	33.9	1.05	8	22.8
B96	9-6-63	35	2.4	32.6	1.10	8	26.9
B97	9-6-63	35	1.0	34.0	0.90	8	31.2
B98	9-6-63	35	1.4	33.6	0.85	8	32.4
B99	9-6-63	35	1.3	33.7	0.90	8	33.0

Pier No 2 West Bound Lane


Pile No.	Date Driven	Length in feet	Length cut off	Length in feet	Ave. Pen. in feet	Drop in feet	Bearing in tons
B1	9-6-63	35	0.8	34.2	0.65	8	40.0
B2	9-6-63	35	1.2	33.8	0.60	8	41.0
B3	9-6-63	35	0.7	34.3	0.90	8	31.2
B4	9-6-63	35	0.7	34.3	0.85	8	32.4
B5	9-6-63	35	1.0	34.0	0.50	8	65.9
B6	9-6-63	35	0.9	34.1	0.80	8	51.9
B7	9-6-63	35	0.7	34.3	0.825	8	32.1
B8	9-6-63	35	0.8	34.2	0.625	8	42.3
B9	9-6-63	35	0.9	34.1	0.80	8	38.8
B10	9-6-63	35	0.9	34.1	1.00	8	30.5
B11	9-6-63	35	0.8	34.2	1.05	8	29.4
B12	9-6-63	35	0.7	34.3	1.30	8	26.9
B13	9-6-63	35	0.9	34.1	0.975	8	27.4
B14	9-6-63	35	0.9	34.1	0.70	8	34.2
B15	9-6-63	35	1.0	34.0	0.85	8	38.3
B16	9-6-63	35	0.9	34.1	0.80	8	35.8
B17	9-6-63	35	0.7	34.3	0.70	8	38.2
B18	9-6-63	35	0.6	34.4	0.75	8	38.0
B19	9-6-63	35	1.3	33.7	0.80	8	33.9
B20	9-6-63	35	0.9	34.1	0.80	8	32.4
B21	9-6-63	35	0.9	34.1	0.85	8	32.4
B22	9-6-63	35	0.5	34.5	1.00	8	28.8
B23	9-6-63	35	1.6	33.6	0.80	8	33.9
B24	9-6-63	35	1.0	34.0	0.60	8	41.0

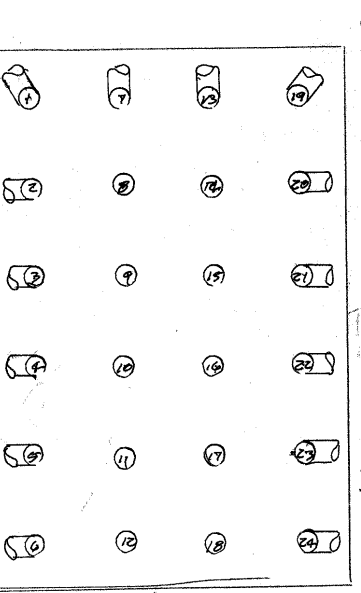

Pier No 1 East Bound Lane

Pile No.	Date Driven	Length in feet	Length cut off	Length in feet	Ave. Pen. in feet	Drop in feet	Bearing in tons
B1	8-12-63	35	1.7	33.3	1.075	8	27.3
B2	8-12-63	35	2.2	32.8	0.975	8	27.4
B3	8-12-63	35	0.9	34.1	0.90	8	31.2
B4	8-12-63	35	1.0	34.0	0.85	8	32.4
B5	8-12-63	35	1.1	33.9	1.10	8	26.9
B6	8-12-63	35	1.2	33.8	0.60	8	41.0
B7	8-12-63	35	1.9	33.6	1.35	8	22.9
B8	8-12-63	35	2.0	33.0	0.80	8	35.8
B9	8-12-63	35	1.0	34.0	0.675	8	40.2
B10	8-12-63	35	1.6	33.4	1.05	8	29.4
B11	8-12-63	35	0.8	34.2	1.085	8	27.4
B12	8-12-63	35	1.7	33.3	1.05	8	27.4
B13	8-12-63	35	1.5	33.5	1.10	8	26.2
B14	8-12-63	35	2.8	32.2	0.70	8	39.2
B15	8-12-63	35	1.3	33.8	0.95	8	31.7
B16	8-12-63	35	2.1	32.9	1.45	8	22.9
B17	8-12-63	35	1.0	34.0	0.90	8	33.0
B18	8-12-63	35	2.8	32.2	0.80	8	35.8
B19	8-12-63	35	1.1	33.9	1.10	8	26.9
B20	8-12-63	35	1.4	33.6	0.875	8	31.6
B21	8-12-63	35	0.9	34.1	0.875	8	31.6
B22	8-12-63	35	1.8	33.2	0.85	8	32.4
B23	8-12-63	35	0.7	34.3	1.075	8	27.3
B24	8-12-63	35	1.6	33.4	0.70	8	37.1


Pile No.	Date Driven	Length in Leads	Length cut off	Length in Structure	Ave. Pen last 5 ft	Drop in feet	Bearing in tons
B25	8-9-63	35	1.5	33.5	0.85	8	32.4
B26	8-9-63	35	1.5	33.5	0.675	8	38.0
B27	8-9-63	35	1.2	33.8	1.10	8	26.9
B28	8-9-63	35	1.3	33.7	1.185	8	26.6
B29	8-8-63	35	1.4	33.6	1.45	8	26.6
B30	8-10-63	35	1.5	33.5	1.60	8	20.0
B31	8-10-63	35	1.1	33.9	1.25	8	25.7
B32	8-9-63	35	1.1	33.9	1.35	8	23.2
B33	8-9-63	35	1.1	33.9	1.285	8	25.3
B34	8-9-63	35	1.2	33.8	0.90	8	28.9
B35	8-10-63	35	1.3	33.7	0.85	8	38.3
B36	8-10-63	35	1.2	33.8	1.20	8	23.2
B37	8-9-63	35	1.0	34.0	0.95	8	30.0
B38	8-10-63	35	2.0	33.0	1.00	8	30.5
B39	8-10-63	35	2.1	32.9	0.85	8	38.3
B40	8-10-63	35	2.2	33.6	1.175	8	27.0
B41	8-10-63	35	2.3	32.7	0.815	8	33.8
B42	8-10-63	35	1.8	33.2	1.25	8	24.3
B43	8-9-63	35	0.7	34.3	1.25	8	26.7
B44	8-10-63	35	1.1	33.9	1.15	8	28.0
B45	8-9-63	35	0.6	34.4	1.10	8	26.9
B46	8-10-63	35	0.9	34.1	1.025	8	28.3
B47	8-9-63	35	0.9	34.1	1.225	8	24.7
B48	8-9-63	35	0.5	34.5	1.225	8	29.7

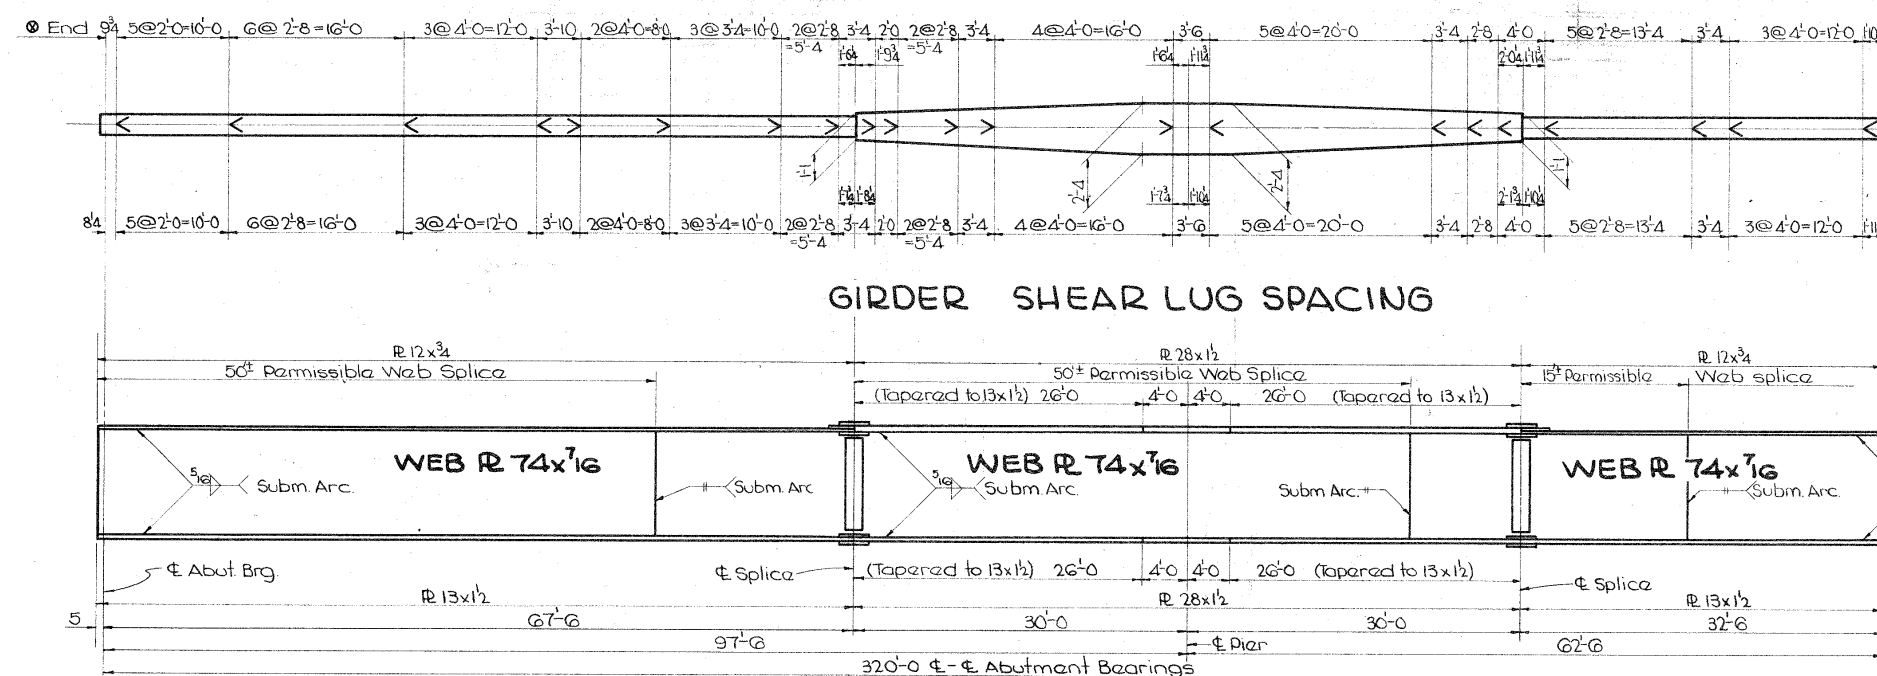


GIRDER SHEAR LUG SPACING

WELD NOTE:

The design drawings indicate AWS prequalified welded joints and, unless otherwise noted the design joint details are for manual shielded metal arc welding. Alternate joint details may be submitted for approval. Flange to web tee joints ~~will~~ not require full penetration of submerged arc fillet weld. Except as noted above, Article 2408.14 of the Iowa State Highway Commission Standard Specifications shall apply.

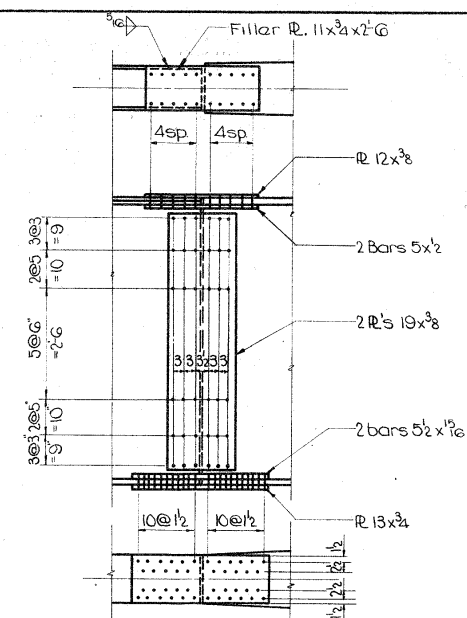

GIRDER SPLICE DETAIL

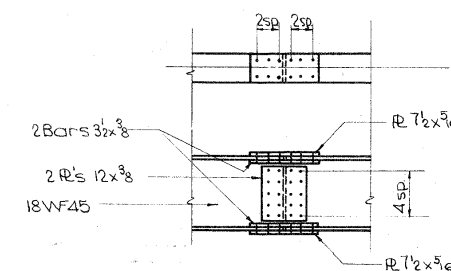

STRINGER SPLICE DETAIL


Note: Positive Moments due to D.L. No 2, Live Load and Impact are resisted by composite action of girder and slab. Shear lugs are used to insure composite action. D.L. No 1 includes weight of slab, girders, stringers, floor beams and diaphragms. D.L. No 2 includes weight of curbs, rail and future wearing surfaces. Max Neg Mom increase at Pier is 17.7%

and future wearing surfaces. Max Neg Mom increase at Pier is 1

MAXIMUM MOMENTS & REACTIONS

ITEM	LOAD (Kips/ft)	Max Positive Moments		Max Neg M	Max Reactions	
		End Span	Cntr Span	At Pier	About	Pier
D.L. #1	1.980	1085.0	910.0	2940.0	66.3	250.3
D.L. #2	0.697	445.0	480.0	879.0	25.0	86.5
C.L.L.*	2146/3100	/	/	4292/	/	/31
U.L.L.	0.763			1083.8		100.4
H20-S16	38.15	1420.0	1491.0		79.8	
Imp.		318.0	298.0	320.0	17.0	27.8
TOTAL				5652.0	184.1	496.6


* Upper figure is for Moment, lower figure is for shear.

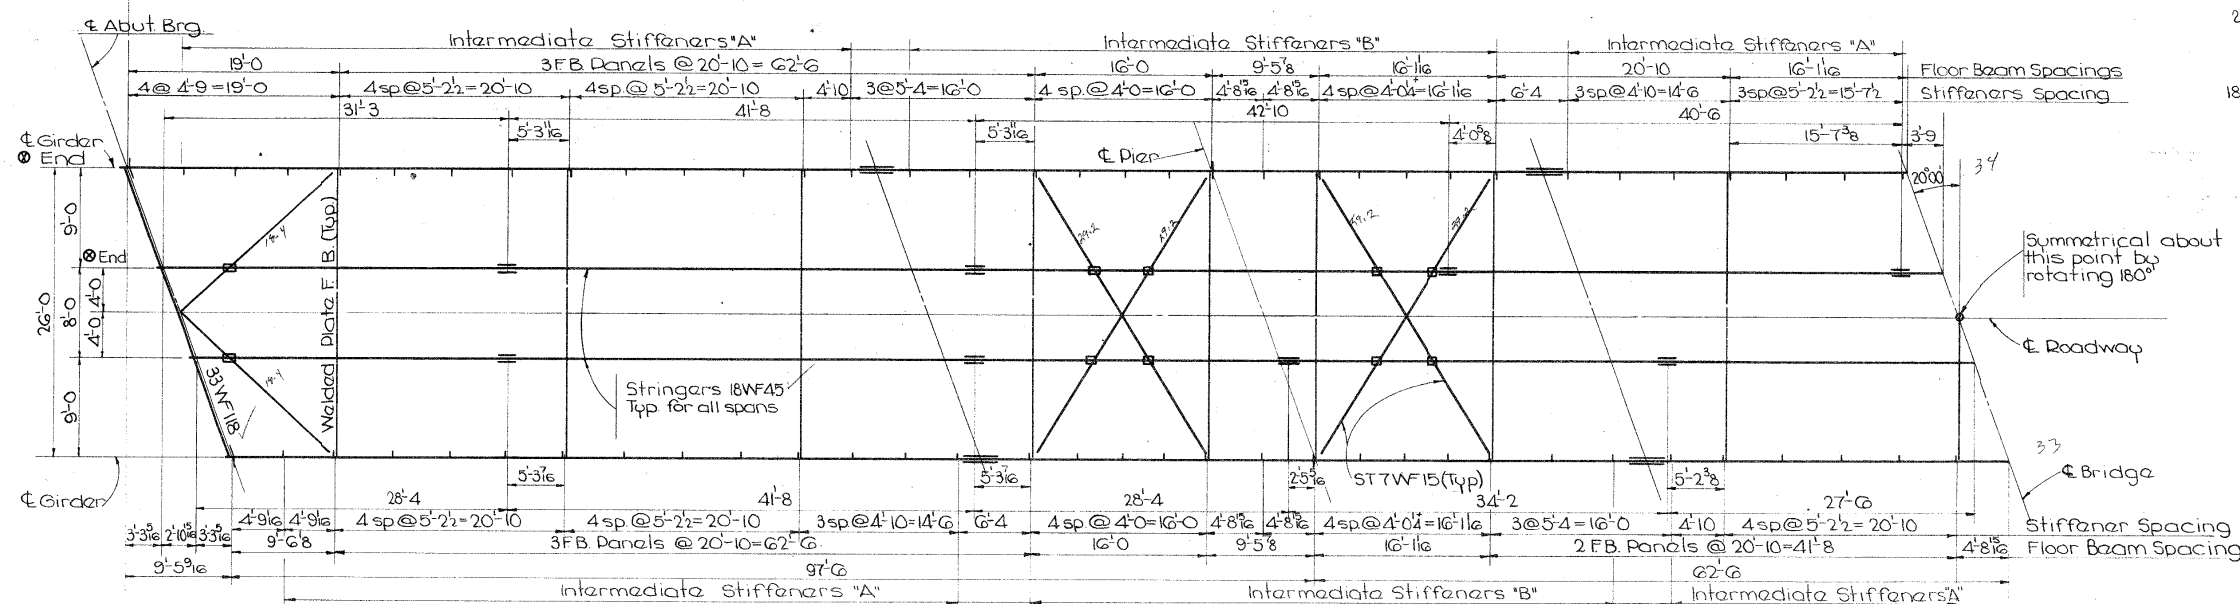

Note: Connecting stiffeners on girder at each end of floor beam are to be staggered as shown to facilitate the erection of floor beam.

- Indicates cross bracing hangers.
See hanger detail Sheet No 9.

STRUCTURAL STEEL LAYOUT

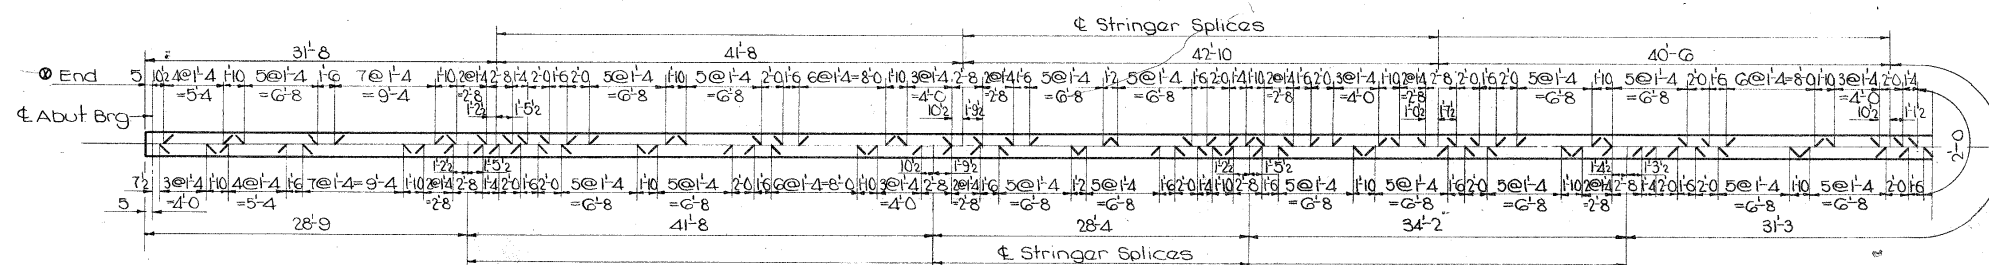

STRINGER SHEAR LUG SPACING

Design for 20° skew
DUAL 320'-0" x 30' CONTINUOUS WELDED GIRDER
BRIDGES
AND WELDED WIRE RETARD

97'-6" End Spans ; 125'-0" Interior Span
Concrete floor & substructure Tubular handrail

SUPERSTRUCTURE DETAILS

Station: 1301+20.00 Project No. FU-1065(10)

Iowa State Highway Commission

December 1962






Dorian No. 3061

Stacy Co


Sheet 8 of 1

File No. 2150

Design No 3061 Story Co. File No 21508

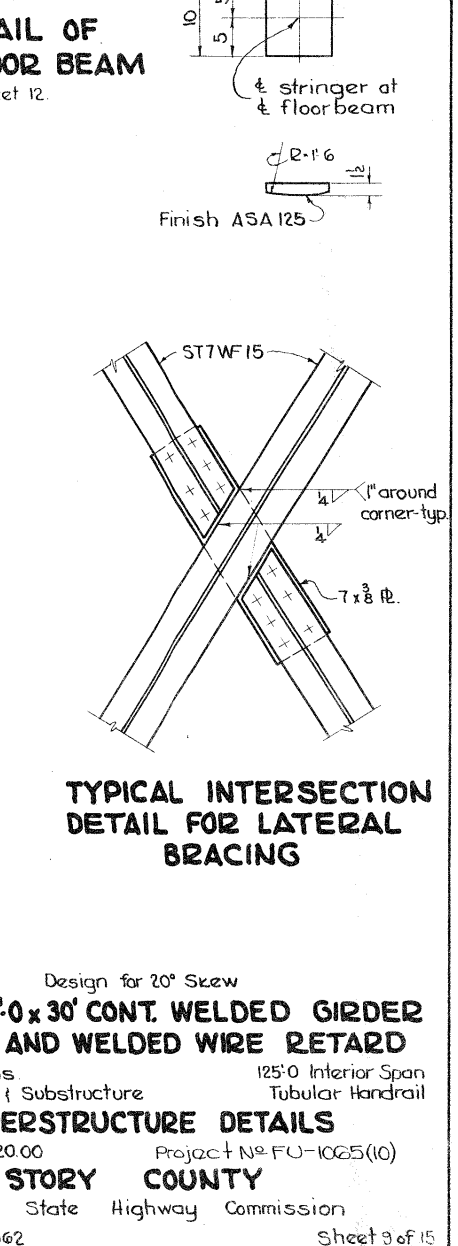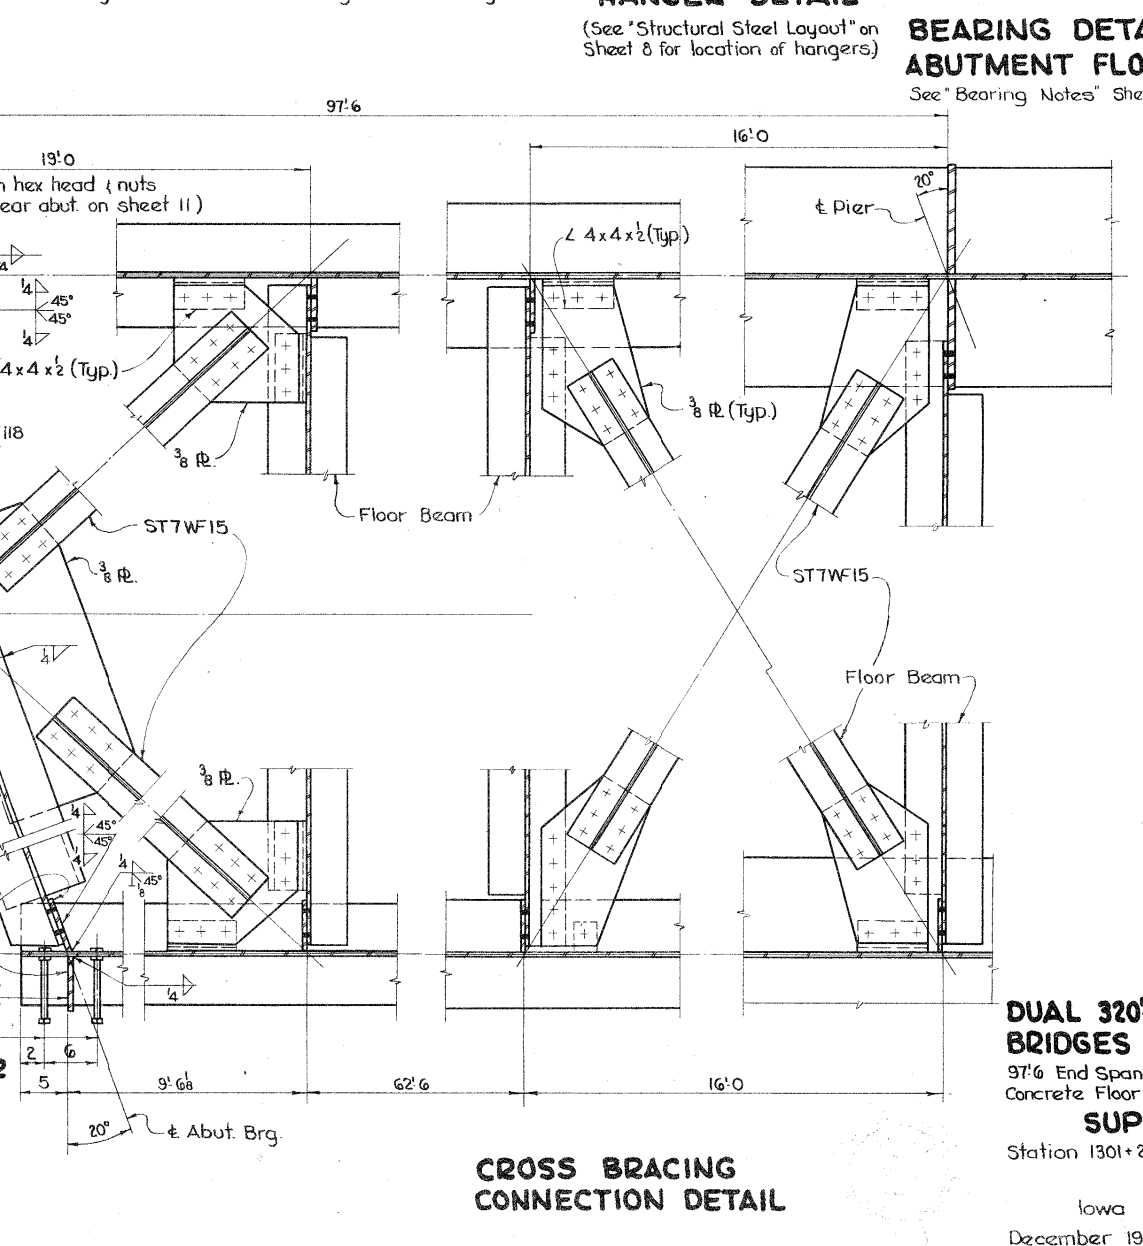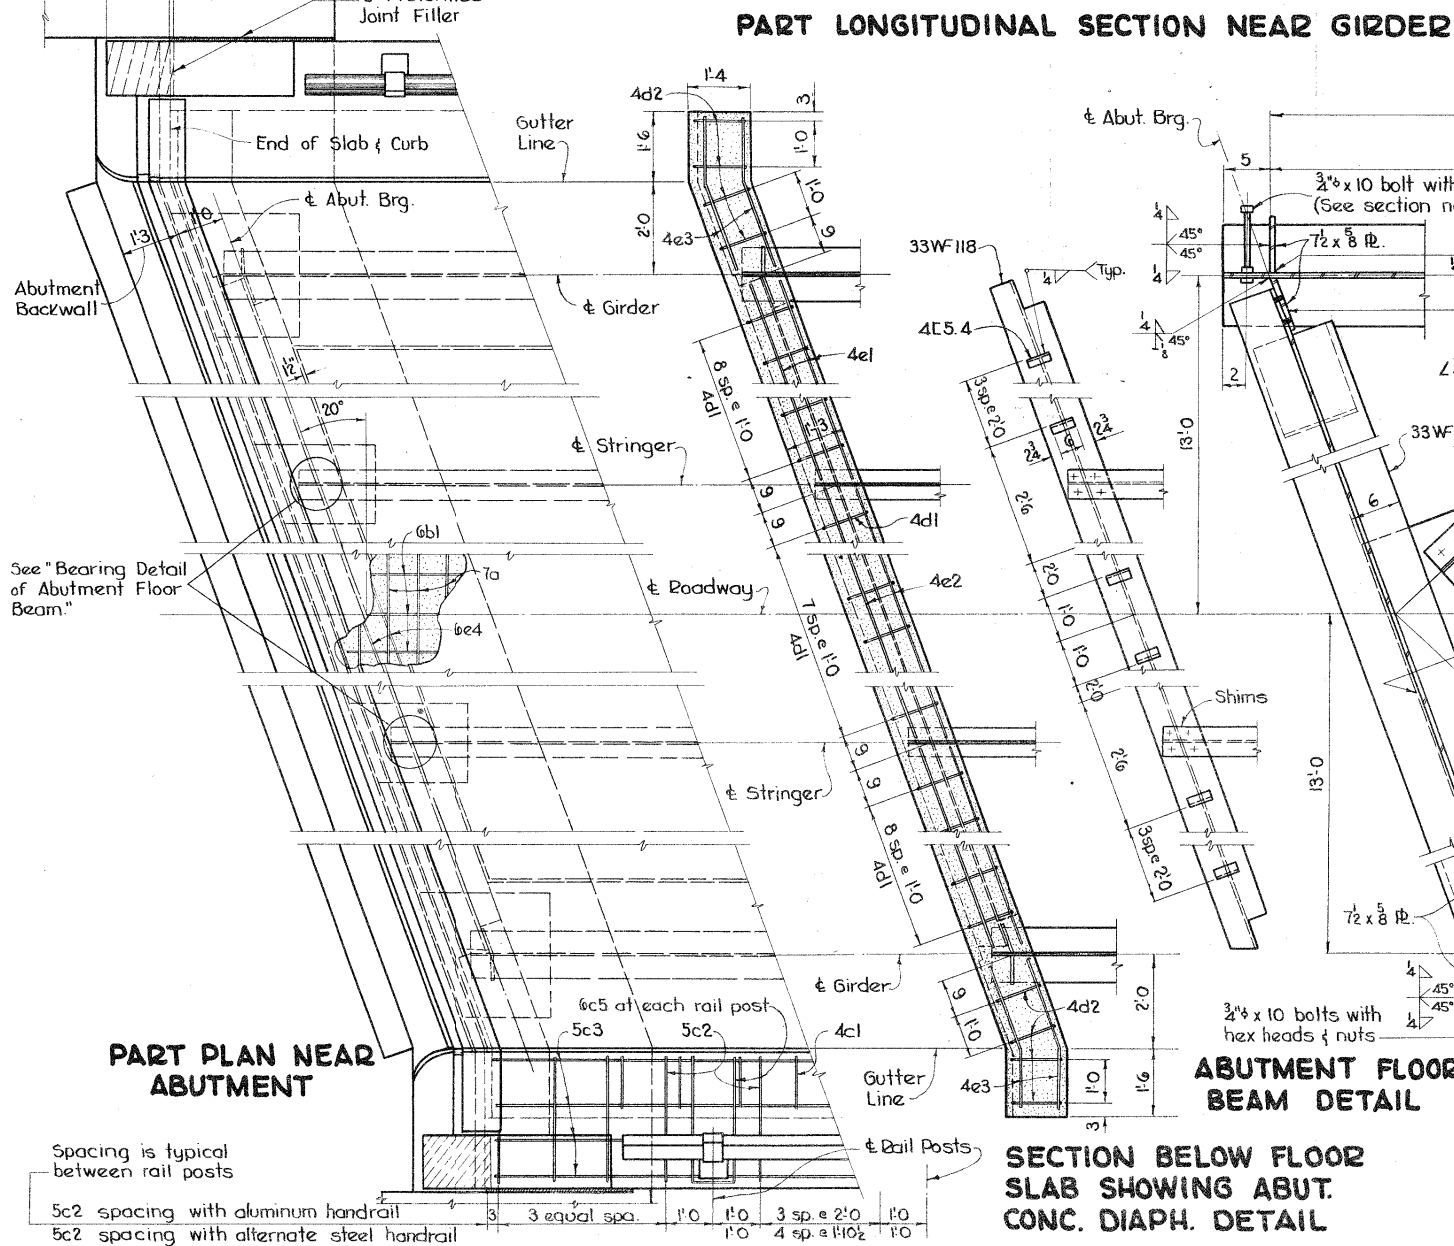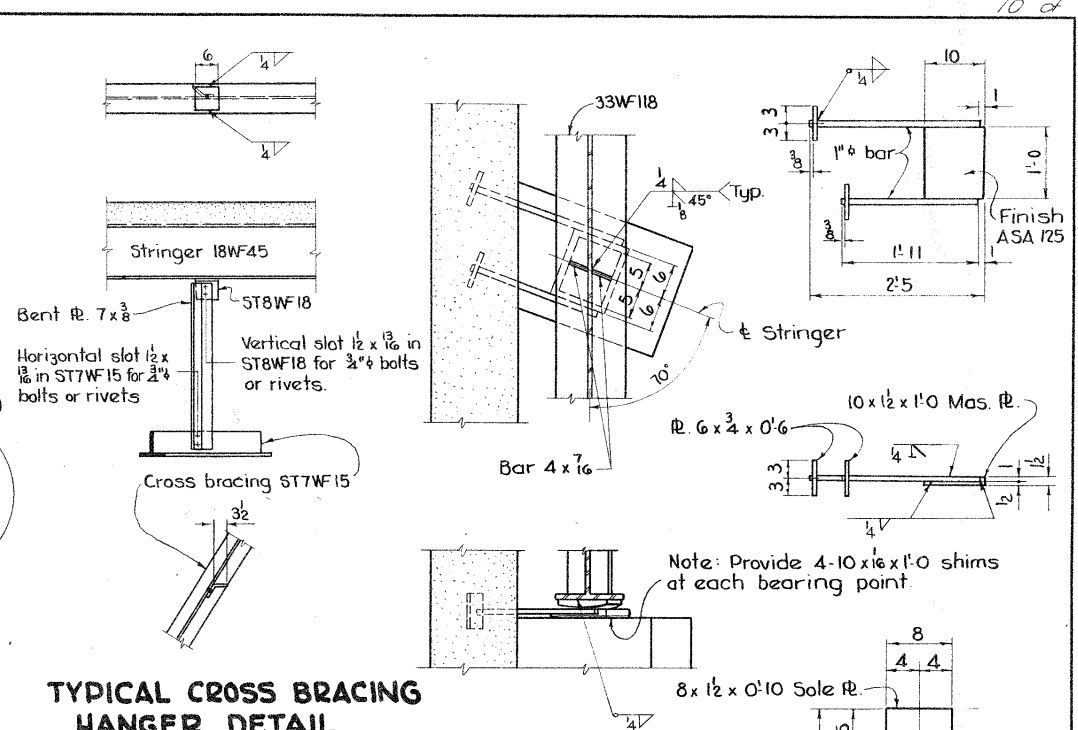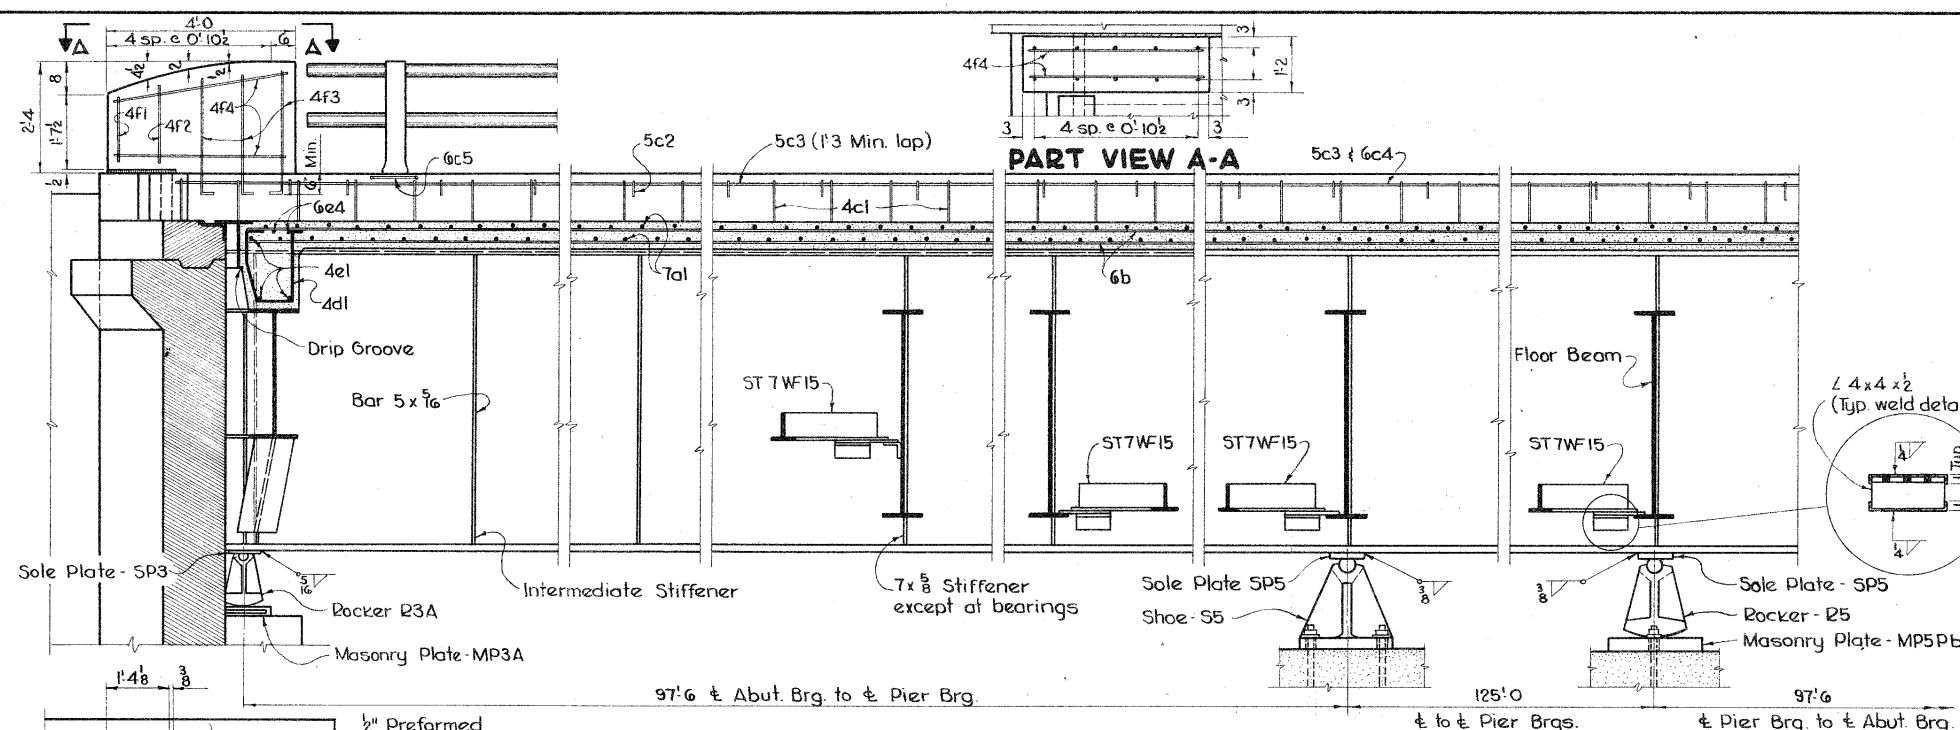

Design for 20° Skew
DUAL 320'0" x 30' CONT. WELDED GIRDER BRIDGES AND WELDED WIRE RETARD
 97'6" End Spans 125'0" Interior Span
 Concrete Floor & Substructure Tubular Handrail
SUPERSTRUCTURE DETAILS
 Station 1301+20.00 Project No. FU-1025(10)
STORY COUNTY
 Iowa State Highway Commission
 December 1962 Sheet 3 of 15
 Design 3061 Story County File No. 21508


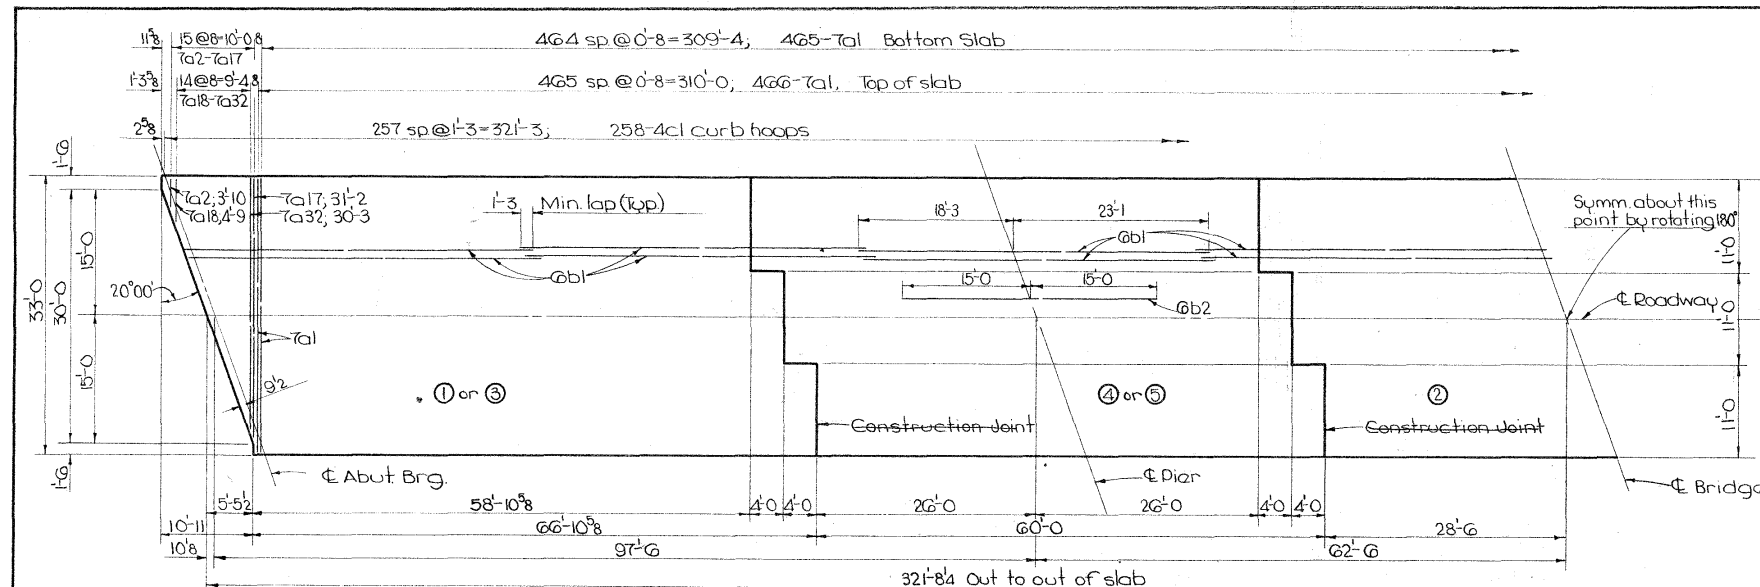


Note: Roadway slab shall be placed in sections and in sequences as indicated in circled numbers and preferably at intervals not exceeding 24 hours. Curbs may be placed continuously.

Alternate procedures for placing concrete may be submitted for approval together with a statement of the proposed method and evidence that the contractor possesses the necessary equipment and facilities to accomplish the required result.




[illegible]

* For Aluminum Rail. (See sheet 15 for steel rail.)

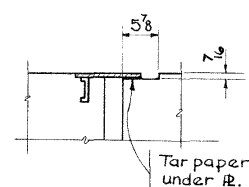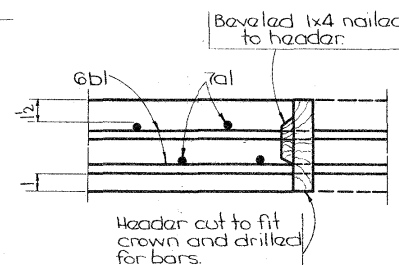


	E. Abut.	W. Abut.
Temp.	"D"	"D"
10°	3 $\frac{3}{4}$ "	2 $\frac{13}{16}$ "
50°	2 $\frac{1}{2}$ "	2 $\frac{1}{2}$ "
90°	1 $\frac{13}{16}$ "	2 $\frac{3}{4}$ "




Note: Proportionate values ~~were~~ to be used for other temperatures.

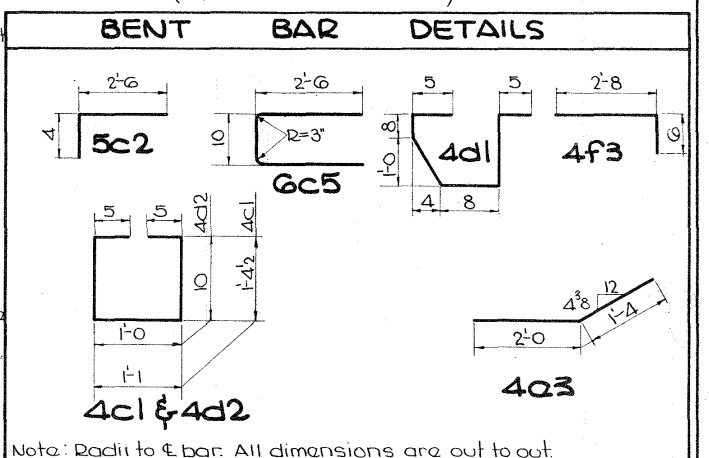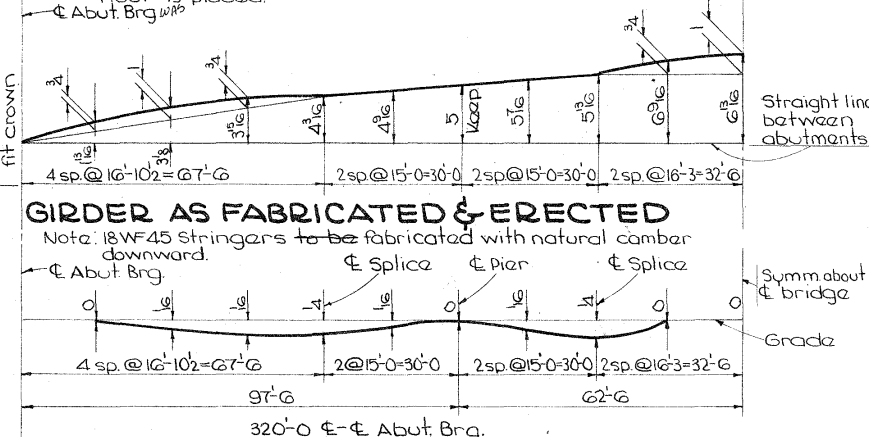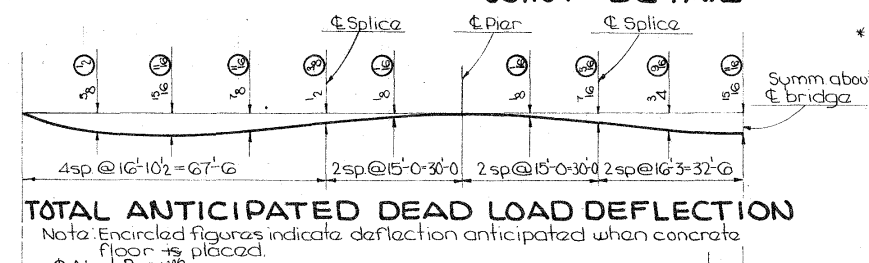

Note: Radii to ϕ bar. All dimensions are out to out.

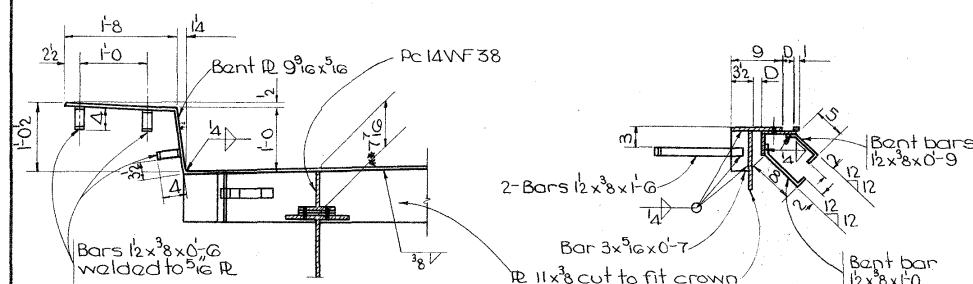

**Includes 2-6³/₄x¹/₈ shims
Furnish 4 shims

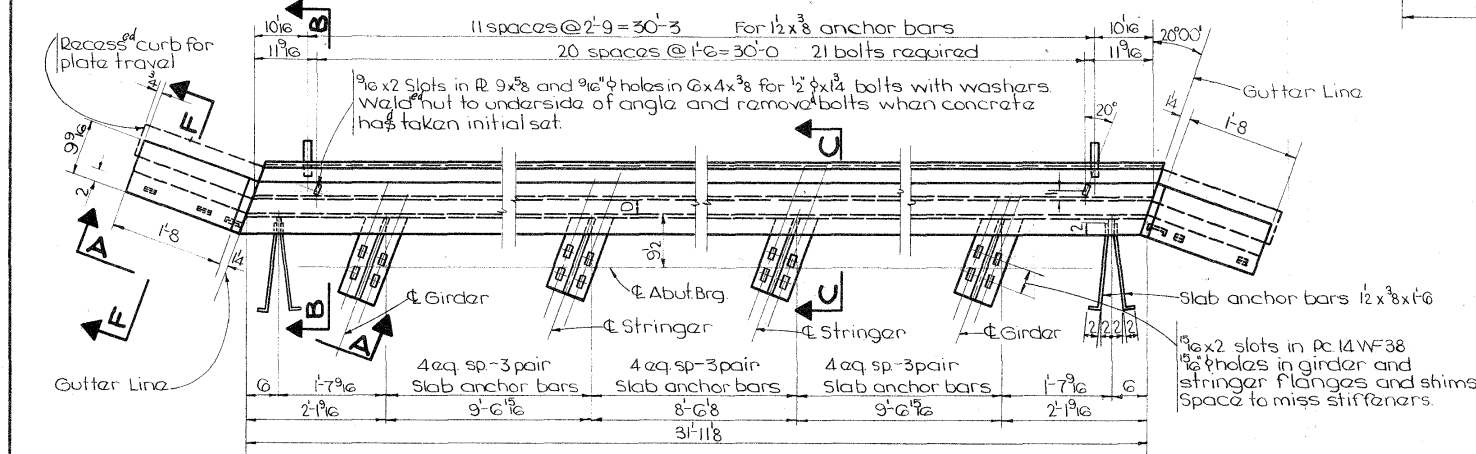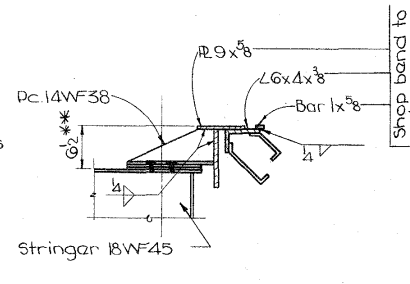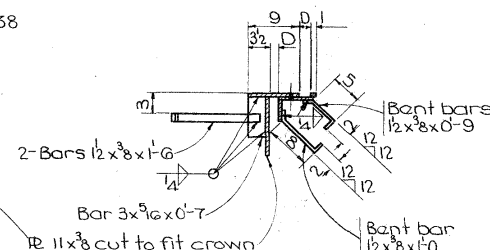

EXPANSION PLATE DETAILS
Two required for each bridge
Wt. = 1772 lbs each

ROCKER SETTINGS				
	West Abut	PIER No 1	PIER No 2	East Abut
Temperature at time of setting				
10°	-5/16	Fixed	-3/8	-11/16
50°	0		0	0
90°	+5/16		+3/8	+11/16

Rocker positions shown indicate + dimensions
Proportionate values are ^{used} to be used for other temperatures


Design for 20° Skew
DUAL 320'-Ox 30' CONTINUOUS WELDED GIRDER
BRIDGES

BRIDGES
AND WELDED WIRE RETARD
97'-6 End Spans 125'-0 Interior Span
Concrete floor & substructure Tubular handrail
SUPERSTRUCTURE DETAILS
Station 1301+20.00 Project N^o FU-1065 (10)
STORY COUNTY
Iowa State Highway Commission
December 1962 Sheet 1 of 15

Design No 3061 Story Count 5 File No 21508


Designed by: 9/1/01 Traced by: 9 Checked by: 9/1

Designed by: H.B.M. Traced by: D Checked by: AA

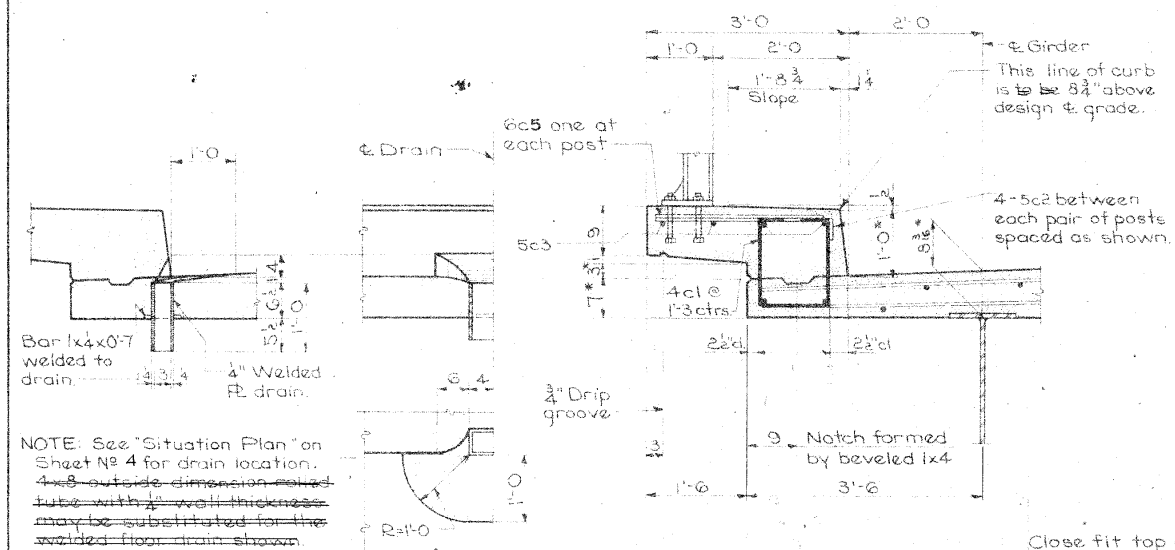

CURB DETAILS

Drain Details

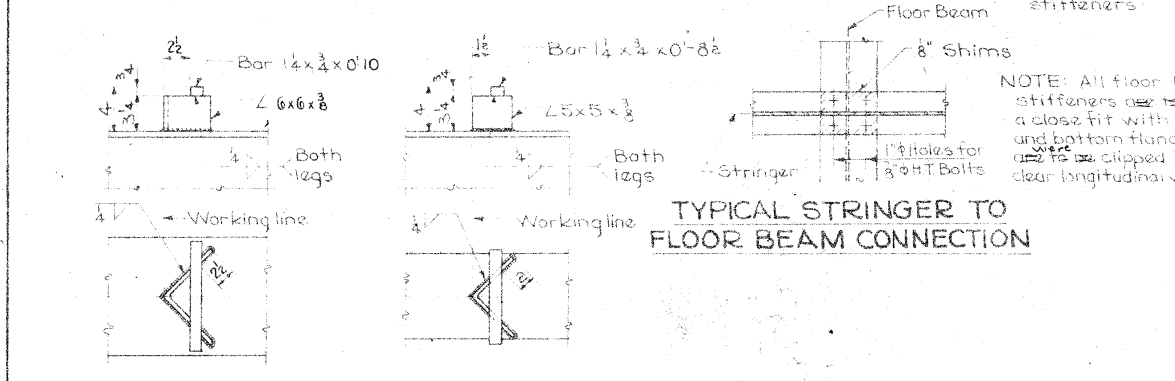

TYPICAL STRINGER TO FLOOR BEAM CONNECTION

Wt. 7.12 lb each 200 req'd. Ea. Bridge

Wt. 5.96 lb each 432 req'd. Ea. Bridge

SHEAR LUGS FOR GIRDERS

SHEAR LUGS FOR STRINGERS

SUPERSTRUCTURE NOTES:

This bridge is designed for H20-44 loading and alternate loading designated in the Bureau of Public Roads, R.M. 20-4, Section C, plus 19 lb. per sq. ft. of roadway for future wearing surface.

The floor slab as shown includes 2" of wearing surface.

All field connections, except as noted, are to be welded or bolted using high tensile strength bolts. The estimated weight of the bridge is 125,000 lb. The estimated weight of the bridge is 125,000 lb.

Unless otherwise noted, all bolts are to be 1/2" diameter and all open holes are to be 1 1/2" diameter.

The girder splices are to be supported by floor beams or other approved means as directed by the Engineer, and adjusted as closely as possible to the dimensions shown on the diagram "Girder As Fabricated and Erected" before welding and bolting is completed.

The parts of structural steel inaccessible after erection are to be given three coats of paint in the shop.

All structural steel is to be ASTM A36 steel.

All flange plates, flange splice plates and web splice plates are to be U.M. plates except flange plates that are cut to taper.

The flange plates for all floor beams except the abutment shall be open near side on one end and far side on the other end.

Flange and web plates of main floor beam girders, stringers, bearing stiffeners, and splice plates shall conform to A.S.T.M. Specification for A36 Carbon Steel. All other structural steel, except as noted, shall conform to the A.S.T.M. Specifications for A7, A373, or A36 Carbon Steel.

Approved stud shear connectors may be used as an alternate for the angle shear connectors shown. If studs are used, each angle lug 5x5x3/8 is to be replaced by a group of 8-7/8x4" studs, and each angle lug 6x6x3/8 is to be replaced by a group of 10-3/8x4" studs. The centroid of the stud group is to be in the approximate location of the angle lug replaced. Maximum spacing between rows of studs is to be 24" and where the angle lug spacing exceeds 24" the equivalent studs are to be located in two or more rows so that the maximum spacing is not exceeded. Studs are to be welded in the shop at the location shown on shop drawings approved by the Iowa State Highway Commission.


Shear lugs are spaced in multiples of the slab transverse reinforcing bar spacing and are located so as to clear bottom transverse bars.

Paint is to be omitted on tops of top flanges and all other steel surfaces in contact with concrete.

The forms for roadway slab and curbs are to be supported by stringers, floor beams and girders.

SPECIFICATIONS:


DESIGN: A.A.S.H.O., Series of 1961.
CONSTRUCTION: Iowa State Highway Commission Standard Specifications, Series of 1960, plus current Special Provisions and Supplemental Specifications.

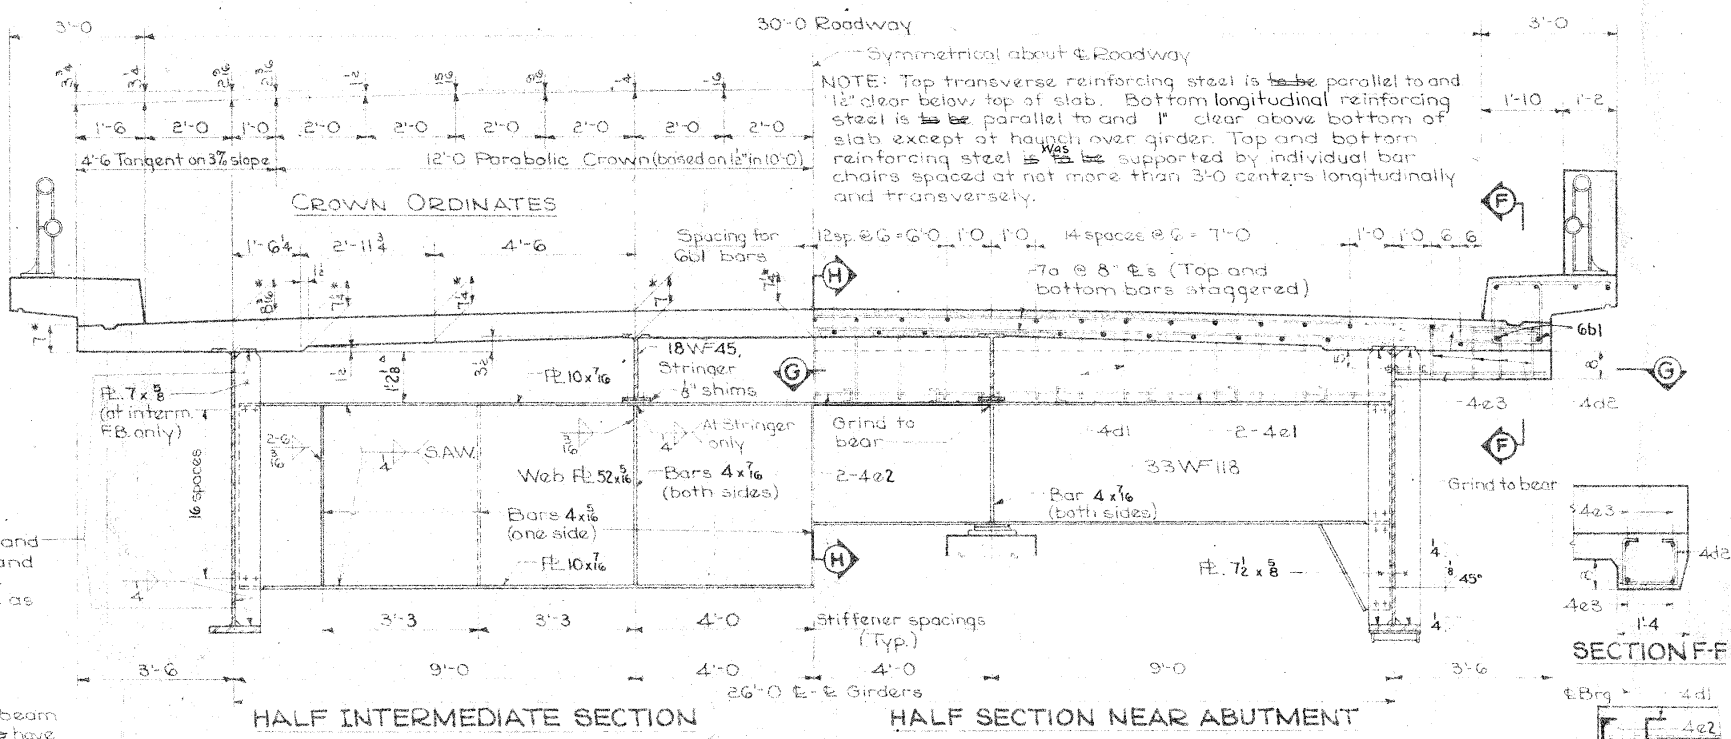


HALF INTERMEDIATE SECTION

HALF SECTION NEAR ABUTMENT

Gross Sectional Area of Slab = 20.454 sq. ft.
Gross Sectional Area of One Curb = 2.089 sq. ft.

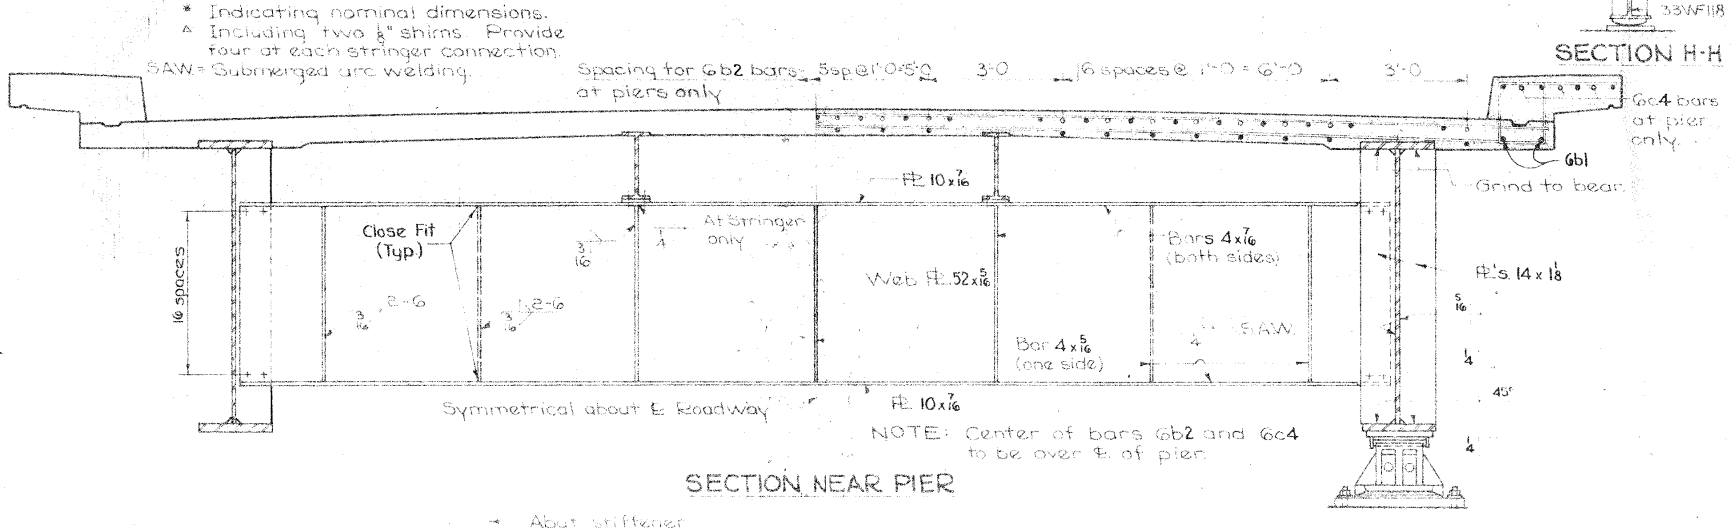


SECTION NEAR PIER

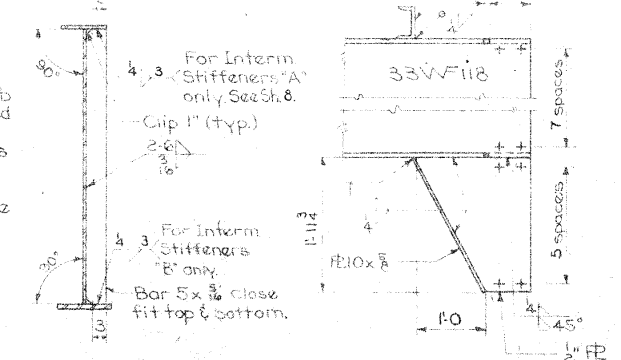

TYPICAL INTERM. STIFFENER DETAIL (Main Girder)
ABUTMENT FLOOR BEAM END CONNECTION DETAIL


Revised 2-27-63; Superstructure Notes changed to designate use of different steels.

Design for 20' Skew
DUAL 320'-0" x 30' CONTINUOUS WELDED GIRDER BRIDGES AND WELDED WIRE RETARD
97'-6" End Spans
Concrete Floor & Substructure
Station 1301+20.00
Iowa STATE HIGHWAY
December 1962
Design No 3061
Story County
File No 21508
125'-0" Interior Span
Tubular Handrail
Project No FU-1065(10)
COMMISSION
Sheet 11 of 15
Checked by J.B.M.

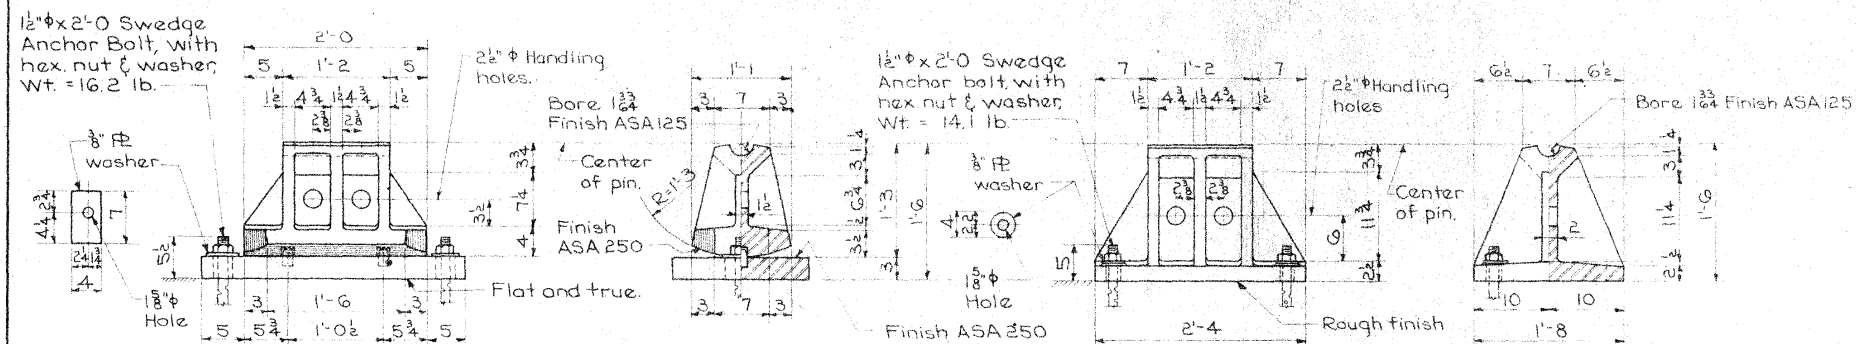


ROCKER R4
Wt. = 464 lb.

2" ϕ Holes. Face casting around holes to seat 4" ϕ x 3/8" washers.

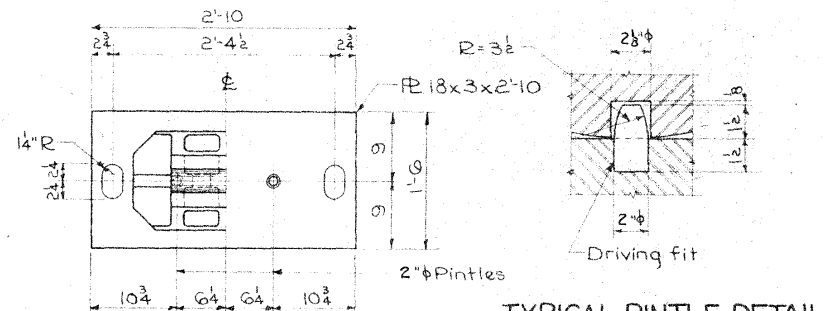


TYPICAL PINTLE DETAIL

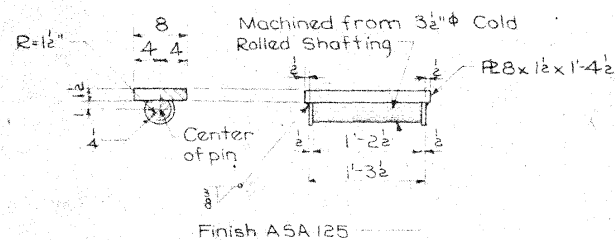

SOLE PLATES SP4 FOR R4 & S4
Wt. = 85 lb

PIER MASONRY PLATE MP4P
Wt. = 497 lb.

FIXED SHOE S4
Wt. = 735 lb.

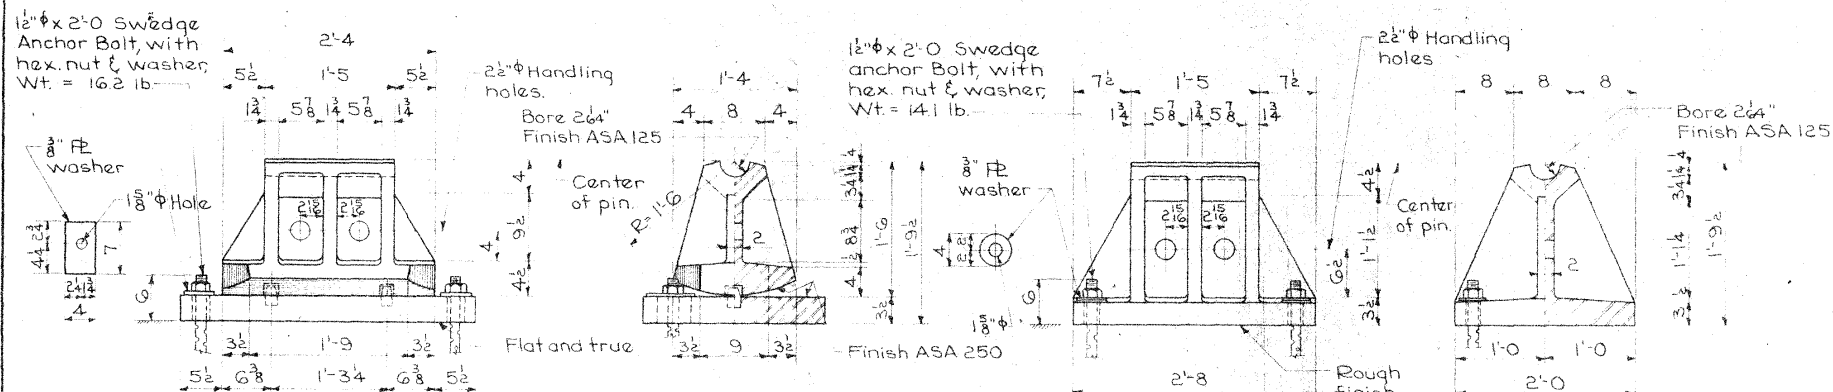

ROCKER R5
Wt. = 776 lb.

* Note: Sole Plate is to be thickened by amounts shown and at locations shown in the following table.


Lane	Pier	Girder	Amount
W.B.	1	S.	5/16
E.B.	1	S.	1/4
W.B.	2	N.	1/4
E.B.	2	N.	5/16

DISTANCE FROM TOP OF SOLE PLATE TO BRIDGE SEAT	
Rockers & Fixed Shoes	
R4 & S4	* 1'-8 1/2"
R5 & S5	* 2'-0 1/2"

* Including 1/2" point and canvas. Varies with changes in sole plate thickness, as shown in table at left.

MAXIMUM REACTION (In Kips)	
R4 S4	R5 S5
475	650


Note: Used SP5, S5, R5, and MP5Pb from this sheet for pier bearing material.

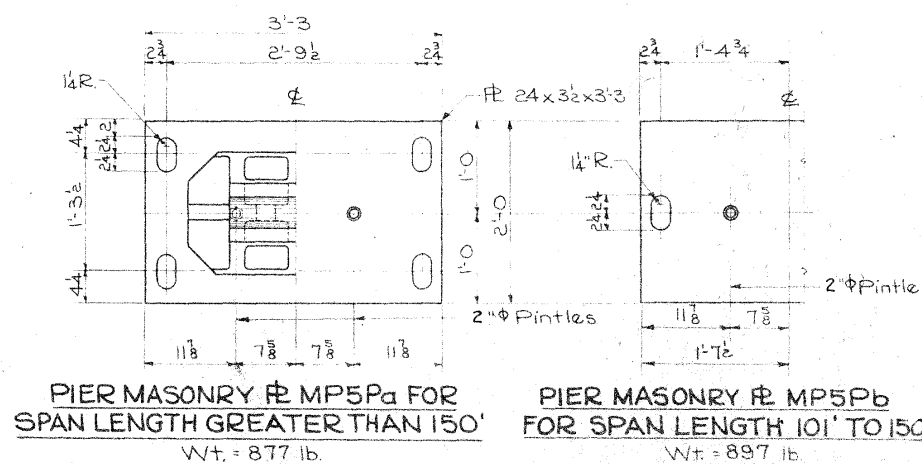


PIER MASONRY PLATE MP5Pa FOR SPAN LENGTH GREATER THAN 150'
Wt. = 877 lb.

PIER MASONRY PLATE MP5Pb FOR SPAN LENGTH 101' TO 150'
Wt. = 897 lb.

2" ϕ Holes. Face casting around holes to seat 4" ϕ x 3/8" washers.

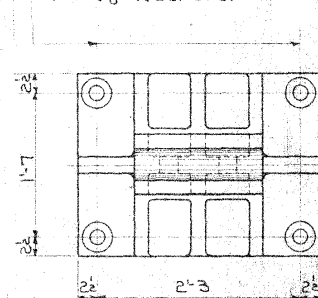

FIXED SHOE S5
Wt. = 1274 lb.

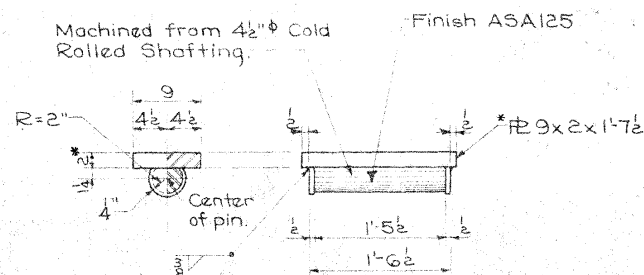

SOLE PLATES SP5 FOR R5 & S5
Wt. = 159 lb

BEARING NOTES:

Nodular Iron Castings shall comply with Article 4153.04 of the Standard Specifications and with ASTM A-339, Grade 60-45-10.

The following shall be Nodular Iron Castings:

R4 MP4P S4
R5 MP5Pb S5

All plates and bars shall comply with ASTM A-36. Pins shall comply with Article 4153.02 of the Standard Specifications and with ASTM A-108.


All bearings are to be set in paint and canvas. Anchor bolts shall be set in accordance with Article 2408.46 of the Standard Specifications.

After, masonry plates, rockers and shoes are in correct location, pour mortar around anchor bolts to fill slotted holes.

The weight of bearings shown does not include the weight of paint.

Surface finished with an ASA 125 Finish shall be shop coated with an application of white lead and tallow as soon as the surfacing process is done. The shop coated surfaces shall be wiped clean and then a field coat of white lead and tallow is to be applied just before the erection of structural steel in the field.

Design for 20' Skew
DUAL 320'0 x 30' CONTINUOUS WELDED GIRDER BRIDGES AND WELDED WIRE RETARD
97'6" End Spans
Concrete Floor & Substructure
125'0" Interior Span
Tubular Handrail
BEARING DETAILS
Station 1301+20.00
Project No. FU-1065(10)
STORY COUNTY
Iowa State Highway Commission
December 1962
Bearing Standard Sheet 1009
Sheet 12 of 15
Design 3061
Story County
File No. 21508

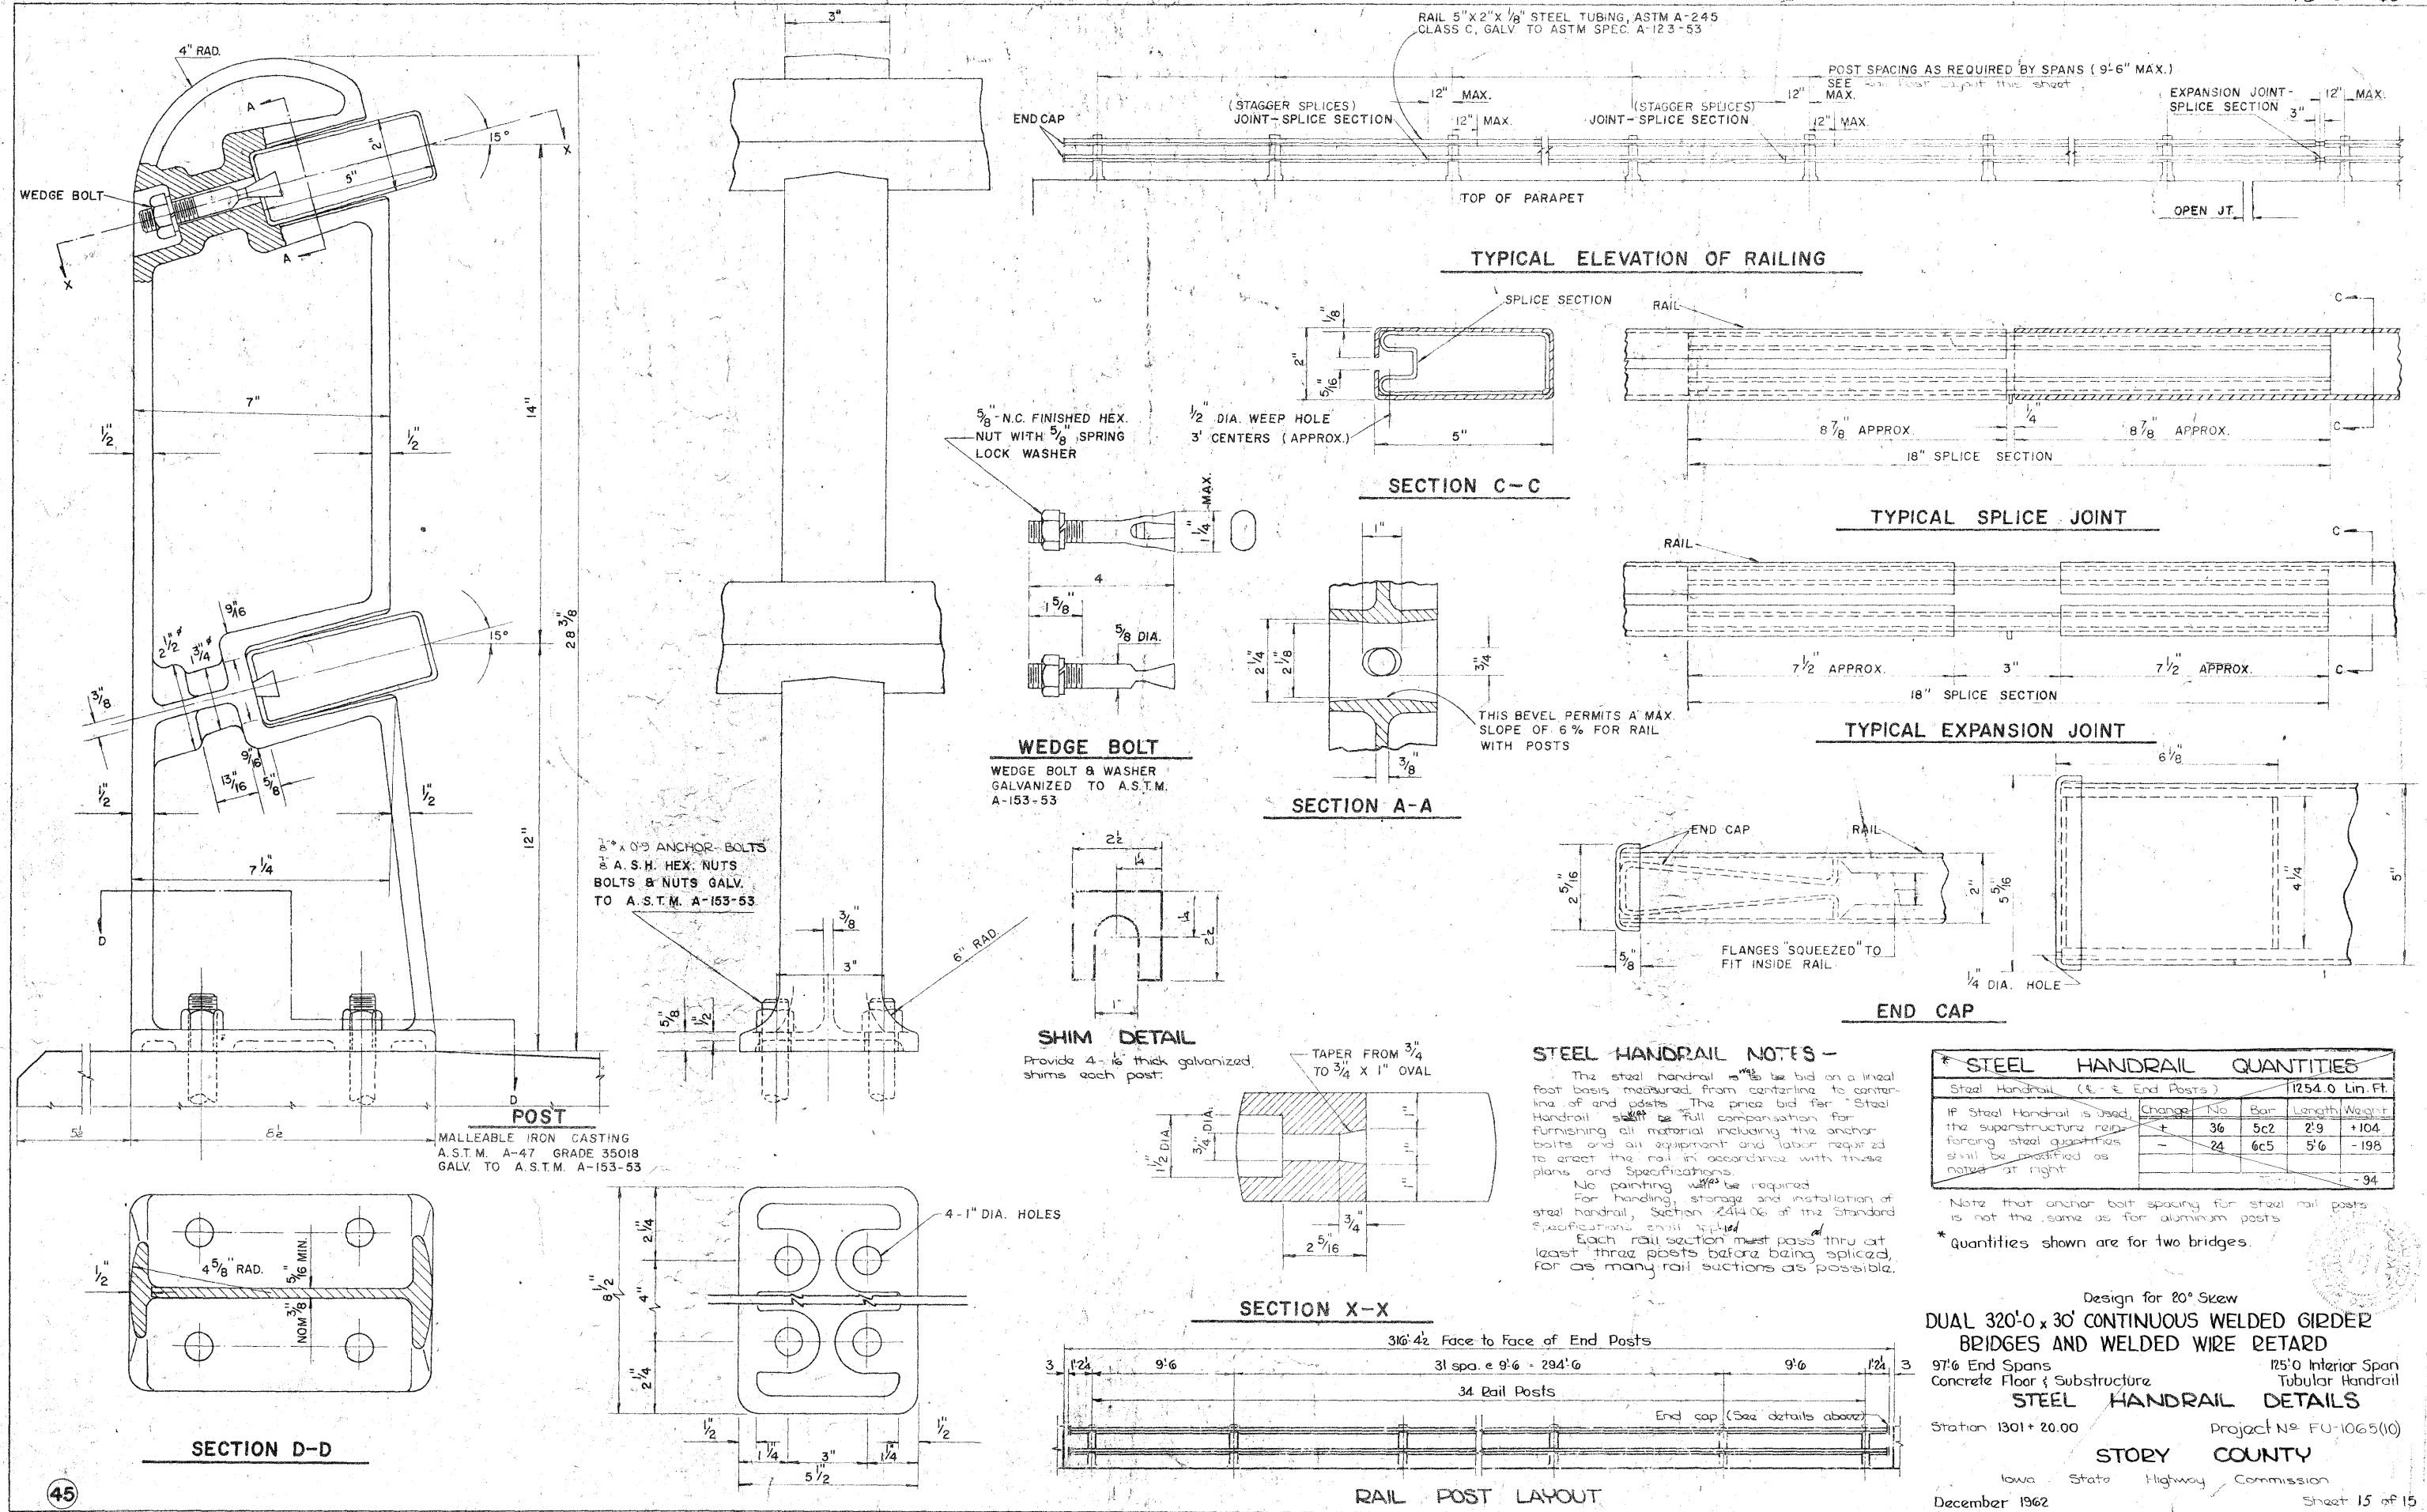

10-20-61
10-24-62 - Rails made continuous thru 3 posts