


BRIDGE DECK REPAIR
FN-62-1(10)--21-49

JACKSON COUNTY

CONVENTIONAL SIGNS

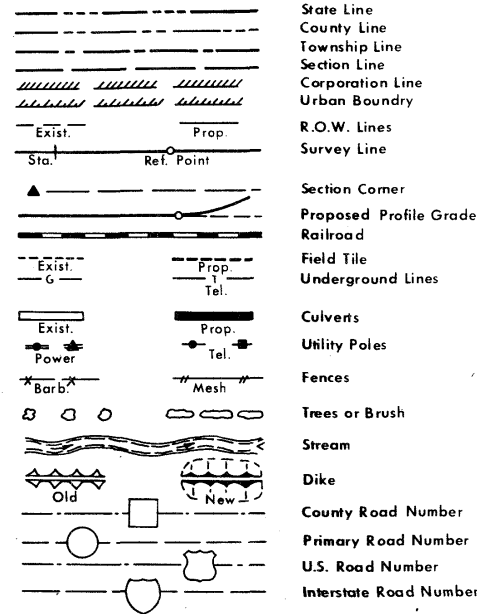

IOWA
DEPARTMENT OF TRANSPORTATION
Highway Division

PLANS OF PROPOSED IMPROVEMENTS ON THE
PRIMARY ROAD SYSTEM
JACKSON COUNTY


BRIDGE DECK REPAIR

2 1/2 MILES N.E. OF ANDREW ON IA. NO. 62

SCALES: As Noted

The standard specifications, series of 1984
of the Iowa Department of Transportation,
shall apply to construction work on this project.

(PLUS CURRENT SUPPLEMENTAL SPECIFICATIONS AND SPECIAL PROVISIONS)

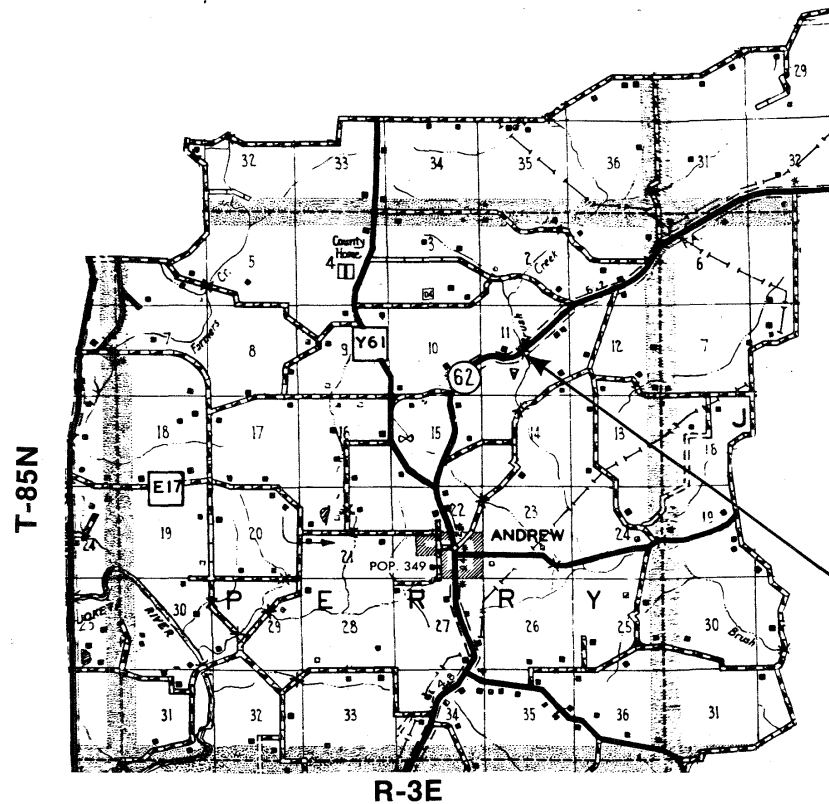

CONSTRUCTION PLANS SHOWING PROJECT AS BUILT

Plan Preparation Supervised By: Bruce Kuehl
Resident Construction Engineer
Date 11-12-86 Iowa Reg. No. 8371

REVIEWED AND FORWARDED TO AMES

District Construction Engineer
One 50% Reduced and Two Full-Size Prints To Be Made and Returned To

R. C. Henely
District Engineer

AFTER MICROFILMING RETURN ORIGINAL
TO DISTRICT NO. Six

THIS AS BUILT PLAN INCLUDES
YEAR WORK CONTRACTOR PROJ. INSPECTOR
1986 Bridge Deck Repair Muscantine Bridge Co., Inc. S. White

DESIGN NO. 185

* 135 *

STATE	FHWA Region	F.Y.	SHEET	TOTAL
IOWA	7		1	10
PROJECT NUMBER				
FN-62-1(10)--21-49				
R.O.W. PROJECT NUMBER				
PIN NUMBER				

INDEX OF SHEETS

NO.	DESCRIPTION
1	TITLE SHEET
2 - 8	BRIDGE DESIGN SHEETS - DESIGN NO. 185
9 - 10	ROAD DESIGN SHEETS - DESIGN NO. 185

STANDARD ROAD
PLANS

IDENT	DATE	IDENT	DATE
RS-2	8-20-85		
RS-3	8-20-85		

STANDARD BRIDGE
PLANS

STANDARD	ISSUED	REVISED

REVISIONS

Iowa Department
of Transportation

Highway Division



AUTHORIZED FOR LETTING
10-21-85
DEPUTY CHIEF ENGINEER DATE

I hereby certify that this plan was prepared under
my supervision and that engineering decisions with
regard to the design were made by me or by other
duly Registered Professional Engineers under the
laws of the State of Iowa.


Name Wm. A. [Signature]
Iowa Registration No. 4999 Date 10/21/85

U.S. DEPARTMENT OF TRANSPORTATION
FEDERAL HIGHWAY ADMINISTRATION
APPROVED

FOR THE DIVISION ADMINISTRATOR DATE

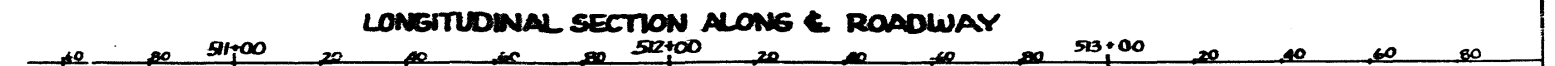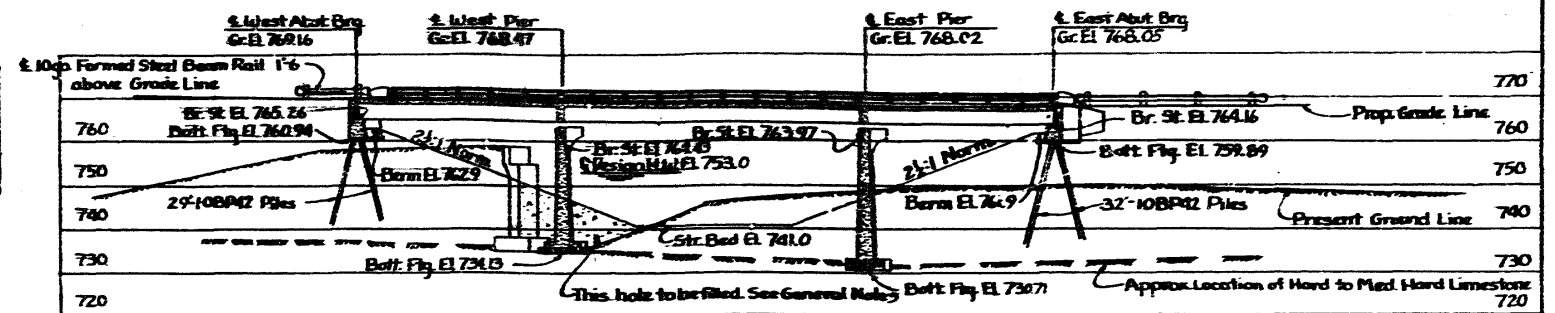

LONGITUDINAL SECTION ALONG E. ROADWAY

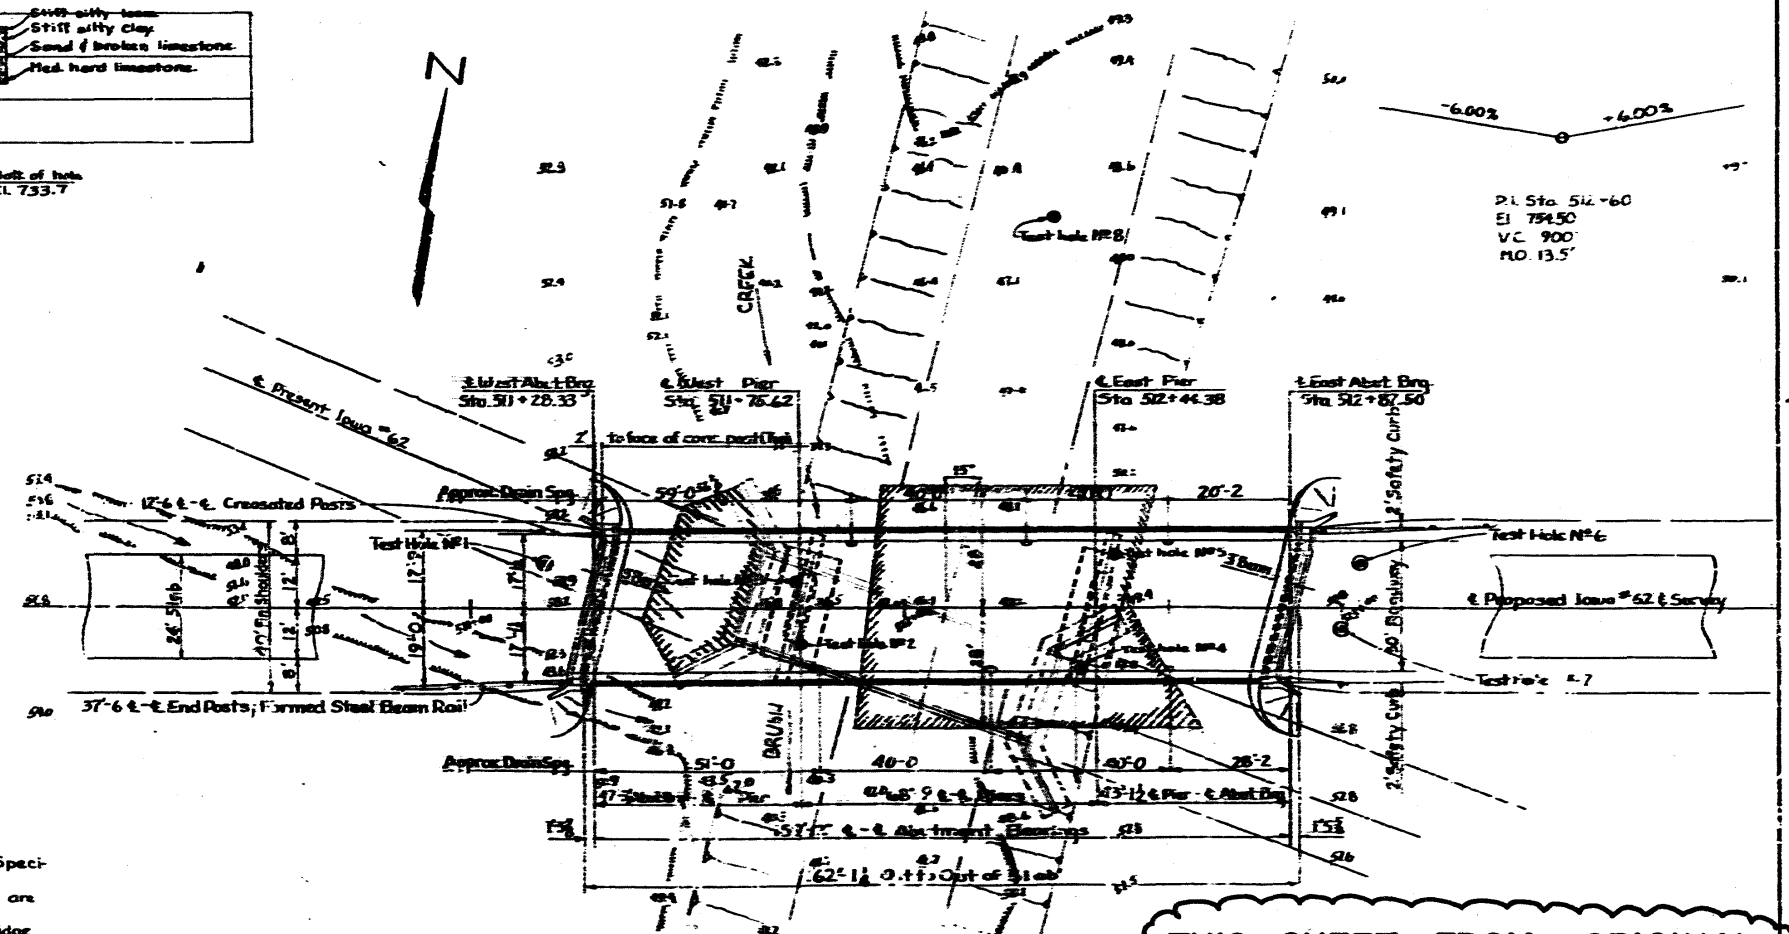

GENERAL PLAN
Scale: 1" = 100'

TOTAL ESTIMATED QUANTITIES				
Item	Page structure	2 Abutments	2 Piers	Total
Concrete	1621cy	56.7	176.0	404.8 cy
Reinforcing Steel	30,922	5032	2,982	39,936 lbs.
Aluminum Rail (A-C End Posts)	301.7			301.7 Lb
Pretensioned	46'-8"	8		8 beams
Prestressed Concrete	47'-6"	8		8 beams
Beams	42'-6"	8		8 beams
10BP42 Steel	Finish	9832, 9829		549 LF
Piles	Drive	9832, 9829		549 LF
Formed Steel Beam Rail (A-C)				100 LF
Crossed Rails (A-C)				12 posts
Class 20 Excavation		98		98 cy.
Class 23 Excavation			270	270 cy.
Class 10 Channel Excavation				650 cy.
Removal of Old Structure				1000 Sq


SITUATION PLAN
Scale 1"=20'

LOCATION
Jackson County
T-85N R-3E
Perry Twp
Sec 11
Over Brush Creek
On Iowa 44-62


159'-2x30' PRETENSIONED PRESTRESSED
CONCRETE BEAM BRIDGE

DESIGN NO.	185
FILE NO.	28166
DES. SH. NO.	4 OF 9


Detailed by off Traced by car Checked by off

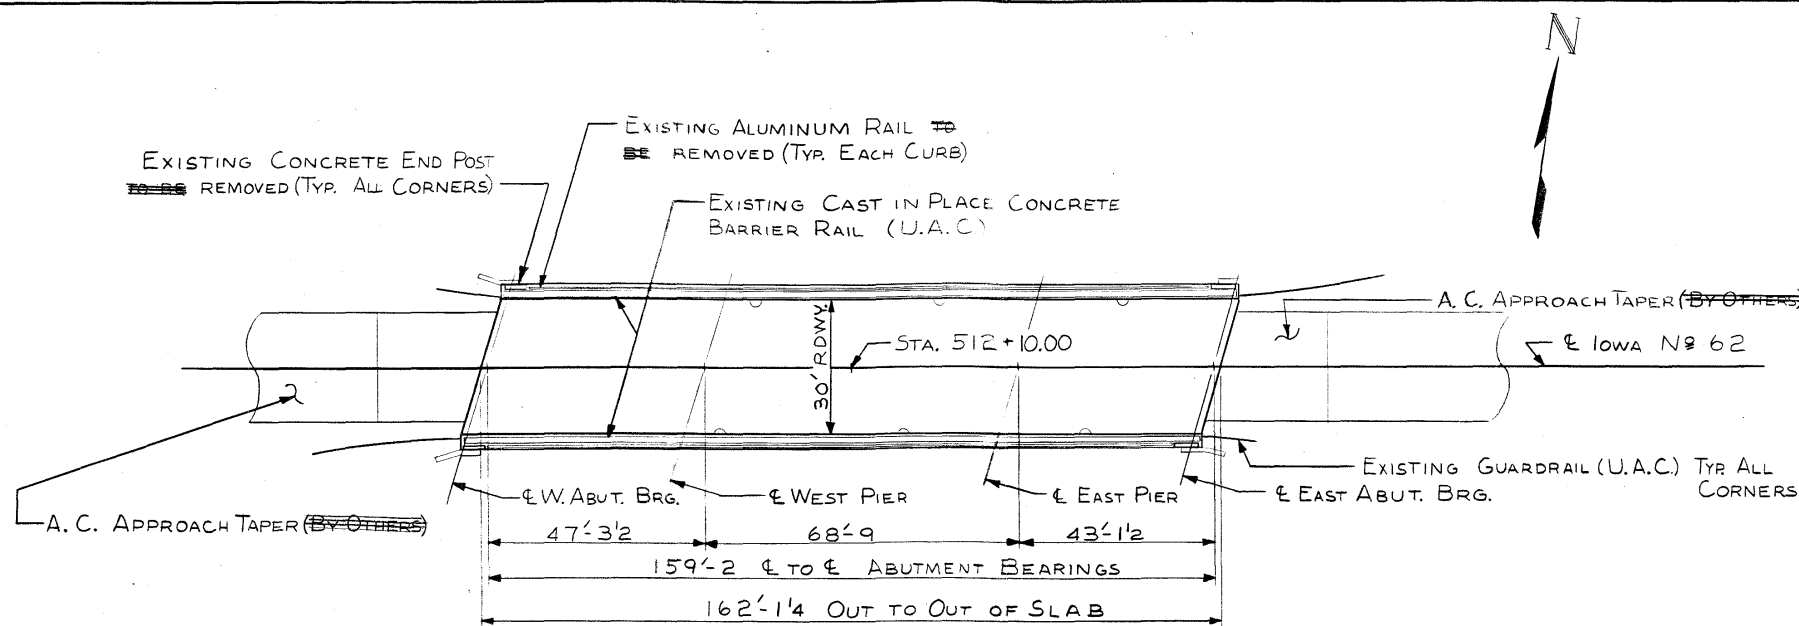

SITUATION PLAN

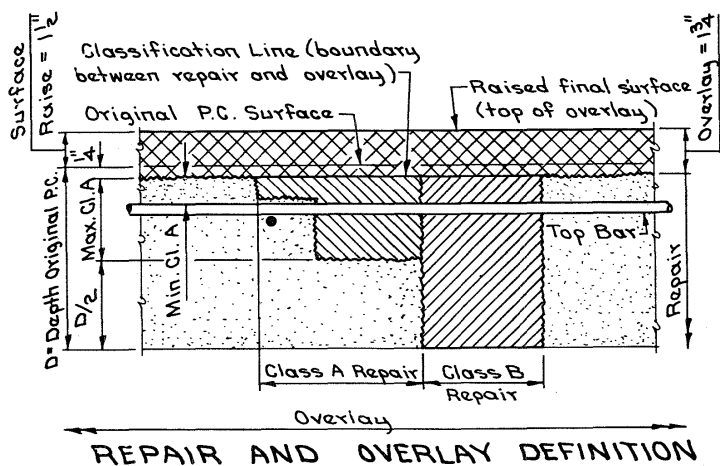

REPAIR AND OVERLAY DEFINITION

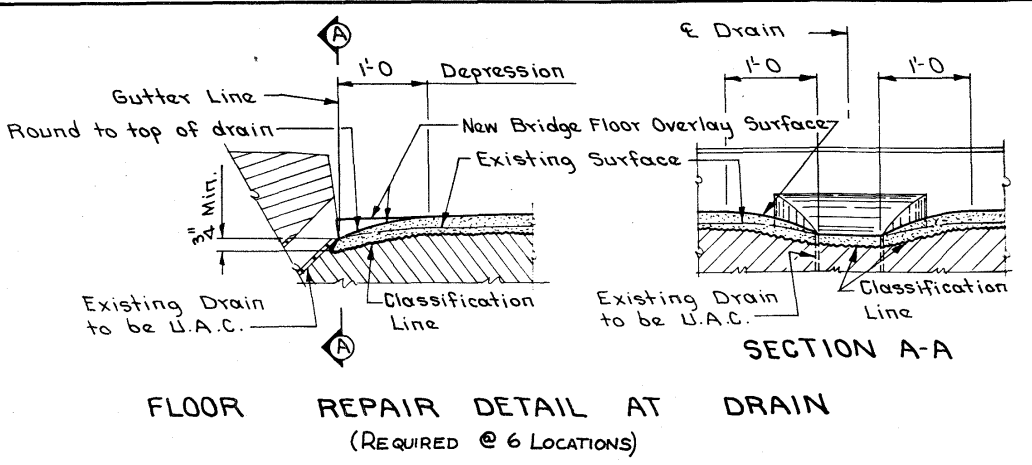

NOTE
For Roadway Quantities
see Des. Sh.

SPECIFICATIONS:
CONSTRUCTION: IOWA DEPARTMENT OF TRANSPORTATION SPECIFICATION, SERIES OF 1984, PLUS CURRENT SUPPLEMENTAL SPECIFICATIONS AND SPECIAL PROVISIONS.

DESIGN STRESSES:
DESIGN STRESSES FOR THE FOLLOWING MATERIALS ARE IN ACCORDANCE WITH THE AASHTO STANDARD SPECIFICATIONS FOR HIGHWAY BRIDGES, SERIES OF 1983.
REINFORCING STEEL IN ACCORDANCE WITH SECTION 8, GRADE 40 AND GRADE 60.
CONCRETE IN ACCORDANCE WITH SECTION 8, FC = 3,500 PSI
STRUCTURAL STEEL IN ACCORDANCE WITH SECTION 10, ASTM A-36,

I HEREBY CERTIFY THAT THIS PLAN WAS PREPARED BY ME OR UNDER MY DIRECT PERSONAL SUPERVISION AND THAT I AM A DULY REGISTERED PROFESSIONAL ENGINEER UNDER THE LAWS OF THE STATE OF IOWA
10-17-85 DATE
LeRoy Phillips
LE ROY PHILLIPS
REG. NO. 4138

LOCATION:
Maintenance N# 4909.75062
IOWA N# 62 OVER
BRUSH CREEK
T85N R3E SECTION 11
PERRY TOWNSHIP
JACKSON COUNTY

DETAILS FOR REPAIRS TO A 15°00' SKEW
15'4 1/2 x 30' PRETENSIONED, PRESTRESSED CONCRETE BEAM BRIDGE
43'-1 1/2' AND 47'-3 1/2' END SPANS 68'-9' INTERIOR SPAN
REPAIR DETAILS AND QUANTITIES
STATION 512+10.00
Sept., 1985
JACKSON COUNTY
IOWA DEPARTMENT OF TRANSPORTATION-HIGHWAY DIVISION
Design Sheet No.: 1 Of 9 File No.: 28166 Design No.: 185

TOTAL ESTIMATED BRIDGE QUANTITIES			
Item N ^o	Item	Unit	Quantity
1	Class A Bridge Floor Repair	Sq. Yd.	9.268
2	Bridge Floor Overlay	Sq. Yd.	540.26
3	Temporary Floodlighting	L.S.	Lump Sum \$2,000.00
4	Pavement Markings	Sta.	84.04
5	Traffic Control	L.S.	Lump Sum \$3500.00
6	Temporary Barrier Rail - Furnish Only	L.F.	380
7	Temporary Barrier Rail - Place Only	L.F.	760
8	Concrete Sealer as per Plan	Sq. Ft.	648.0
9	TEMPORARY TRAFFIC SIGNALS	L.S.	LUMP SUM \$3000.00
10	HAULING AND STORING EXISTING HANDRAIL	L.S.	LUMP SUM \$1200.00
11	Mobilization	L.S.	\$6,500.00
12	Stackpiled Materials	only	0
8001	Place A.C.C. Runouts (Permanent)	L.S.	\$2250.00

- Item N^o ESTIMATE REFERENCE INFORMATION
- 4 Includes 28.3 Sta. removal of pavement markings, 36.82 Sta. of yellow temporary and permanent pavement markings, and 18.92 Sta. of white temporary and permanent pavement markings.
- 6 & 7 All Temporary Barrier Rail shall be nominal 10' long concrete units.
- 9 TRAFFIC SIGNALS ARE TO BE REMOVED AND ARE TO REMAIN THE PROPERTY OF THE CONTRACTOR.

DESIGN HISTORY AT THIS SITE	
DES. NO.	TYPE OF WORK
4659	ORIGINAL DESIGN
185	BRIDGE FLOOR REPAIR

GENERAL NOTES

THIS DESIGN IS FOR REPAIR TO THE EXISTING 159'-2x30' PRETENSIONED PRESTRESSED CONCRETE BEAM BRIDGE, ORIGINAL DESIGN NO. 4659 JACKSON COUNTY. PLANS OF THE EXISTING STRUCTURE MAY BE OBTAINED AT THE AMES OFFICE OF THE IOWA D.O.T. HIGHWAY DIVISION. REPAIRS SHALL CONSIST OF BRIDGE FLOOR REPAIR, BRIDGE FLOOR OVERLAY AND REMOVAL OF EXISTING ALUMINUM RAIL.

PLAN QUANTITY OF FLOOR REPAIR IS BASED ON THE "SURVEY PLOT" AS SHOWN ON DESIGN SHEET 3. HATCHED PORTIONS REPRESENT CLASS A BRIDGE FLOOR REPAIR; CROSS HATCHED PORTIONS, IF SHOWN, REPRESENT CLASS B BRIDGE FLOOR REPAIR. ACTUAL SPALLED AND HOLLOW AREAS, AS DETERMINED BY THE ENGINEER AT THE TIME OF CONSTRUCTION, SHALL BE REPAIRED. THE ENTIRE CONCRETE SURFACE OF THE BRIDGE FLOOR, INCLUDING AREAS OVER BRIDGE FLOOR REPAIR, SHALL HAVE BRIDGE FLOOR OVERLAY.

NO PRELIMINARY FLOOR SURVEY IS SHOWN. THE PLAN QUANTITY FOR "CLASS A BRIDGE FLOOR REPAIR" IS ESTIMATED AS % OF THE TOTAL FLOOR AREA. THE ACTUAL QUANTITY WILL BE DETERMINED BY THE ENGINEER AT THE TIME OF CONSTRUCTION. ACTUAL SPALLED AND HOLLOW AREAS, AS DETERMINED BY THE ENGINEER, SHALL BE REPAIRED. THE ENTIRE CONCRETE SURFACE OF THE BRIDGE FLOOR, INCLUDING AREAS OVER BRIDGE FLOOR REPAIR, SHALL HAVE BRIDGE FLOOR OVERLAY.

NO PRELIMINARY FLOOR SURVEY IS SHOWN. THE PLAN QUANTITY FOR "CLASS A BRIDGE FLOOR REPAIR" IS ESTIMATED AS 50% OF THE TOTAL FLOOR AREA. THE ACTUAL QUANTITY WILL BE DETERMINED BY THE ENGINEER AFTER THE A.C. SURFACING HAS BEEN REMOVED. ACTUAL SPALLED AND HOLLOW AREAS AS DETERMINED BY THE ENGINEER SHALL BE REPAIRED. THE ENTIRE CONCRETE SURFACE OF THE BRIDGE FLOOR, INCLUDING AREAS OVER BRIDGE FLOOR REPAIR, SHALL HAVE BRIDGE FLOOR OVERLAY.

PRESENT FLOOR THICKNESS IS ABOUT 6 INCHES. THE CONTRACTOR WILL BE REQUIRED TO EXERCISE CARE IN REMOVING CONCRETE IN ORDER TO PREVENT UNNECESSARY UNBONDING OF REINFORCING STEEL.

PRESENT FLOOR THICKNESS IS ABOUT INCHES. THE CONTRACTOR SHALL EXERCISE EXTREME CARE IN ORDER TO PREVENT UNNECESSARY REMOVAL OF CONCRETE BELOW THE TOP OF THE TOP REINFORCING. THE ENERGY OF HAND TOOLS SHALL BE RESTRICTED NEAR THE BOTTOM OF THE DESIGNATED CLASS A REPAIR AREAS IN ORDER TO PREVENT UNBONDING OF REINFORCING. NO CONCRETE SHALL BE REMOVED BELOW THE TOP OF THE TOP LONGITUDINAL REINFORCING WITHOUT PRIOR PERMISSION FROM THE BRIDGE ENGINEER.

PRESENT FLOOR THICKNESS IS ABOUT INCHES. FLOOR REINFORCING IS QUITE SHALLOW FOR A PORTION OF THE FLOOR AREA. IN THOSE AREAS WHERE REINFORCING IS LESS THAN 1/4" CLEAR BELOW THE ORIGINAL FINISHED SURFACE, THE BOTTOM LIMIT OF BRIDGE FLOOR OVERLAY WILL BE CONSIDERED AS THE TOP OF THE TOP REINFORCING. UNSOUND CONCRETE BELOW THE TOP OF THE TOP REINFORCING SHALL BE REPAIRED AS CLASS A BRIDGE FLOOR REPAIR. THE CONTRACTOR WILL BE REQUIRED TO CAREFULLY REGULATE SCARIFYING DEPTH AND EMPLOY HAND METHODS AS NECESSARY IN ORDER TO PREVENT DAMAGE OR UNBONDING OF REINFORCING.

CONSTRUCTION SHALL BE DONE IN STAGES, WITH AT LEAST ONE LANE OF TRAFFIC MAINTAINED AT ALL TIMES IN ACCORDANCE WITH THE "TRAFFIC CONTROL PLAN" NOTE.

CONSTRUCTION STAGES I & II AS DETAILED ON THESE PLANS MAY BE REVERSED AT THE CONTRACTOR'S OPTION SUBJECT TO THE ENGINEER'S APPROVAL.

SURFACE RAISE, AS SHOWN ON THE PLANS, SHALL BE CONSIDERED A MINIMUM. IN ORDER TO LIMIT THE ADDITIONAL DEAD LOAD, SURFACE RAISE SHALL BE RESTRICTED TO A MAXIMUM OF 1/2" MORE THAN SHOWN ON THE PLANS. PROFILE MAY BE ADJUSTED TO THE EXTENT POSSIBLE WITHIN THESE LIMITS.

ALL DIMENSIONS AND DETAILS SHOWN ON THESE PLANS PERTINENT TO NEW CONSTRUCTION SHALL BE VERIFIED IN THE FIELD BY THE CONTRACTOR BEFORE STARTING CONSTRUCTION.

BEFORE PROCEEDING WITH BRIDGE FLOOR OVERLAY AND BRIDGE FLOOR REPAIR THE CONTRACTOR MAY COMPLETE ALL STAGES OF OTHER CONSTRUCTION. ANY CONSTRUCTION SHALL HAVE STAGE LIMITS, TEMPORARY BARRIER RAIL AND TRAFFIC CONTROL AS DETAILED ON THESE PLANS. TEMPORARY BARRIER RAIL AND TRAFFIC CONTROL MAY BE ADJUSTED TO FIT THE ACTUAL WORK AND STORAGE AREA. WHEN BACKWALLS AND/OR APPROACH SECTIONS ARE TO BE REBUILT TO A RAISED SURFACE, AND WHEN FLOOR OVERLAY IS NOT A PART OF THE SAME STAGE, THE CONTRACTOR SHALL PROVIDE FOR PROFILE TRANSITION WITH A.C. SURFACING. PROFILE TRANSITION SHALL BE TAPERED AT A RATE OF 25' FOR 1 1/2 INCHES OF RAISE. THE A.C. TRANSITION MATERIAL SHALL BE A COMMERCIAL GRADE HOT SURFACING MIX OR A MIX APPROVED BY THE ENGINEER. A.C. MAY BE PLACED BY HAND METHODS AND MAY BE COMPACTED BY ANY APPROVED METHOD. ALL COSTS FOR ADDITIONAL TRAFFIC CONTROL, REPOSITIONING OF BARRIER AND A.C. SURFACING SHALL BE BORNE BY THE CONTRACTOR.

FAINT LINES ON PRINTS AND ON TRACINGS INDICATE EXISTING PORTION OF THE BRIDGE.

THE EXISTING FORMED STEEL BEAM GUARD RAIL AT BOTH ABUTMENTS SHALL BE USED AS CONSTRUCTED.

THE TOP OF ABUTMENT BACKWALLS BETWEEN GUTTER LINES AS SHOWN SHALL BE REPAIRED IN ACCORDANCE WITH THE SPECIFICATIONS FOR CLASS A BRIDGE FLOOR REPAIR AND BRIDGE FLOOR OVERLAY WITH THE FOLLOWING EXCEPTIONS:

1. THE LOWER LIMIT FOR CLASS A BRIDGE FLOOR REPAIR SHALL BE TO SUITABLE EXISTING CONCRETE, AS DETERMINED BY THE ENGINEER, BUT TO AT LEAST 2 INCHES BELOW THE BOTTOM LIMIT FOR BRIDGE FLOOR OVERLAY.
2. IF MACHINE FINISHING FOR THE TOP OF BACKWALL IS NOT PRACTICABLE, A MANUAL TYPE SCREED OR METAL PLATE, WITH APPROVED VIBRATORS ATTACHED, SHALL BE USED.

THE EXPOSED TOP OF BACKWALL AREAS AS SHOWN HAVE BEEN INCLUDED IN THE QUANTITIES SHOWN FOR CLASS A BRIDGE FLOOR REPAIR AND FOR BRIDGE FLOOR OVERLAY.

SCREED EXTENSION OR OVERLAY BEYOND THE LONGITUDINAL CONSTRUCTION JOINT MAY BE LESS THAN THE 6 INCHES REQUIRED BY SUB-ARTICLE 2413.03C.1. THE ENGINEER MAY REQUIRE ADDITIONAL VIBRATION OR SPECIAL FINISHING PROCEDURES ADJACENT TO THE LONGITUDINAL CONSTRUCTION JOINT.

THE 1 1/2" THICK RAISE PLATES FOR THE EXPANSION DEVICE ARE TO BE BLAST CLEANED AND PAINTED AFTER FIELD WELDING TO THE EXISTING EXPANSION PLATE. THE BLAST CLEANING PREPARATION IS TO COMPLY WITH THE STEEL STRUCTURES PAINTING COUNCIL SPECIFICATIONS SSPC-SP7, BSAL. THE RAISE PLATES ARE TO BE GIVEN ONE COAT OF RUST-OLEUM PRIMER AND ONE COAT OF RUST-OLEUM FINAL COAT OR AN APPROVED EQUAL PRIMER AND FINAL COAT. THE COLOR OF THE DRY PAINT SHOULD APPROXIMATE THE COLOR OF CONCRETE.

THE BID ITEM "STRUCTURAL STEEL" SHALL INCLUDE ALL COSTS ASSOCIATED WITH FURNISHING AND INSTALLING RAISE PLATES FOR EXPANSION DEVICES AS SHOWN.

THE BID ITEM "STEEL EXTRUSION JOINT WITH NEOPRENE" IS TO INCLUDE ALL COSTS FOR FURNISHING AND INSTALLING THE STEEL EXTRUSION AND GLAND, AND ALL MATERIAL NECESSARY FOR THE FABRICATION AND INSTALLATION (INCLUDING CURB PLATES AND TEMPORARY ERECTION MATERIAL) OF THE STRIP SEAL EXPANSION DEVICE AS DETAILED.

THE REINFORCEMENT SUPPLIED FOR THIS STRUCTURE MAY BE GRADE 40, 50 OR 60 IN ACCORDANCE WITH THE STANDARD SPECIFICATIONS. THE DESIGN STRESSES FOR ALL GRADES ARE BASED ON GRADE 40 REINFORCEMENT.

MINIMUM CLEAR DISTANCE FROM FACE OF CONCRETE TO NEAR REINFORCING BAR IS TO BE 2" UNLESS OTHERWISE NOTED OR SHOWN.

IN ADDITION TO THE REQUIREMENTS OF ARTICLE 2413.09, CONCRETE SEALER IS TO BE APPLIED TO THE TOP OF CLASS D STRUCTURAL CONCRETE AT THE END OF THE BRIDGE, FULL ROADWAY WIDTH, AS SHOWN. THE SEALER MATERIAL, SURFACE PREPARATION AND APPLICATION SHALL BE IN ACCORDANCE WITH 2409.23(D).

QUANTITY OF "CONCRETE SEALER, AS PER PLAN" IN SQUARE FEET, TO BE PAID FOR WILL BE COMPUTED FROM MEASUREMENTS OF AREAS ACTUALLY COVERED AND ARTICLE 1109.03 SHALL NOT APPLY. PLAN QUANTITY IS BASED ON P.C. CONCRETE FLOOR OVERLAY.

REMOVALS AND DISPOSALS OF ITEMS SCHEDULED FOR REMOVAL SHALL BE IN ACCORDANCE WITH SECTION 2401 OF THE SPECIFICATIONS. ANY DAMAGE TO ANY STEEL OR CONCRETE NOT TO BE REMOVED SHALL BE THE RESPONSIBILITY OF THE CONTRACTOR AND REPAIRED BY HIM AT NO EXTRA COST TO THE STATE.

THE PRICE BID FOR "REMOVAL OF PAVEMENT" SHALL INCLUDE ALL COSTS ASSOCIATED WITH THE REMOVAL AND DISPOSAL OF THE P.C. APPROACH PAVEMENT AS NOTED.

THE A.C. RUNOUT TAPER AT THE ENDS OF THE BRIDGE AS SHOWN WILL BE PLACED BY LOCAL HIGHWAY DIVISION MAINTENANCE FORGES BEFORE TRAFFIC IS SHIFTED TO NEW CONSTRUCTION. THE CONTRACTOR SHALL GIVE ADEQUATE PRIOR NOTICE SO THAT THE A.C. MAY BE PLACED DURING NORMAL WORKING HOURS AND WORKING DAYS OF MAINTENANCE.

THE CONTRACTOR SHALL CONSTRUCT NEW BRIDGE APPROACH PAVEMENT AS NOTED AND SHOWN. THE PRICE BID FOR "BRIDGE APPROACH SECTION, REINFORCED AS PER PLAN" SHALL BE FULL COMPENSATION FOR FURNISHING AND INSTALLING P.C. CONCRETE APPROACH PAVEMENT, INCLUDING EXCAVATION, REINFORCING STEEL AND JOINT MATERIAL REQUIRED.

BACKFILL BEHIND THE NEW ABUTMENT BACKWALL BETWEEN WINGS IS TO BE GRANULAR BACKFILL AS SHOWN. ANY REMAINING ABUTMENT EXCAVATION IS TO BE BACKFILLED WITH SOIL.

THE TOP OF THE ABUTMENT BACKWALLS AS SHOWN SHALL BE CONSTRUCTED USING STRUCTURAL CONCRETE CLASS D. IF MACHINE FINISHING FOR THE TOP OF THE BACKWALL IS NOT PRACTICAL A MANUAL TYPE SCREED OR METAL PLATE, WITH APPROVED VIBRATORS ATTACHED, SHALL BE USED.

AREAS OF CURB INDICATED ON THE "SURVEY PLOT" OR DESIGNATED BY THE ENGINEER, ARE TO BE REPAIRED AS CLASS A BRIDGE FLOOR REPAIR EXCEPT THAT THE UPPER OR OUTER LIMIT SHALL BE THE ORIGINAL SURFACE. NO OVERLAY QUANTITY WILL BE INCLUDED FOR THE CURB AREAS. THE REPAIR AREAS WITHOUT OVERLAY SHALL RECEIVE A SURFACE FINISH PER ART. 2403.23, AND THEY SHALL RECEIVE A CURE AS SPECIFIED FOR BRIDGE FLOOR OVERLAY. THE ENGINEER MAY RELAX THE SLUMP REQUIREMENTS OF STIFF MIX TO A MAXIMUM OF 2 1/2 INCHES IN FORMING THE BATTER FACE. A MANUAL TYPE SCREED OR METAL PLATE WITH APPROVED VIBRATORS ATTACHED WILL BE REQUIRED FOR HORIZONTAL CURB SURFACES.

THE CONTRACTOR SHALL PLACE PORTLAND CEMENT CONCRETE OVERLAY ON THE BRIDGE APPROACH PAVEMENT AS NOTED AND SHOWN. PAYMENT FOR THIS WORK SHALL BE AS NOTED ON THE P.C.C. OVERLAY DETAIL SHEET INCLUDED IN THESE PLANS.

ANY A.C. WORK THAT MAY BE NECESSARY TO BRING THE ROADWAY SHOULDERS UP TO THE FINAL GRADE OF THE P.C. APPROACH PAVEMENT WILL BE DONE BY THE CONTRACTOR BEFORE TRAFFIC IS SHIFTED TO NEW CONSTRUCTION. COST OF THIS WORK IS TO BE CONSIDERED INCIDENTAL TO THE COST OF THE PORTLAND CEMENT CONCRETE OVERLAY.

REMOVAL AND DISPOSAL OF EXISTING SHOULDER MATERIAL SHALL BE CONSIDERED INCIDENTAL TO THE BID ITEM "BASE, TYPE B, CLASS 1, ASPHALT CEMENT CONCRETE".

THE PRICE BID FOR "REMOVAL OF ASPHALT CEMENT CONCRETE SURFACING" SHALL BE CONSIDERED FULL COMPENSATION FOR REMOVAL AND DISPOSAL OF THE EXISTING A.C. OVERLAY TO THE LIMITS SHOWN.

THE BID ITEM "HAULING AND STORING EXISTING HANDRAIL" SHALL INCLUDE ALL COSTS ASSOCIATED WITH THE DISMANTLING, HAULING AND STORING OF THE EXISTING ALUMINUM HANDRAILS (APPROXIMATELY 301.7± L.F. AND 42 POSTS). THE ALUMINUM HANDRAILS AND POSTS ARE TO BE HAULED TO THE IOWA D.O.T. MAINTENANCE YARD AS DIRECTED BY THE ENGINEER. THIS BID ITEM SHALL ALSO INCLUDE ALL COSTS INVOLVED IN REMOVING THE FOUR CONCRETE END POSTS.

THE EXISTING RAILPOST ANCHOR BARS AND VERTICAL REINFORCING BARS IN CONCRETE END POSTS SHALL BE CUT OFF FLUSH WITH OR SLIGHTLY BELOW CONCRETE SURFACE AND THE REMAINING EXPOSED ENDS PAINTED WITH TWO COATS OF ZINC RICH PAINT. THE COST OF CUTTING AND PAINTING IS TO BE INCLUDED IN THE PRICE BID FOR "HAULING AND STORING EXISTING HANDRAIL".

TRAFFIC CONTROL PLAN

108-23
11-10-83

1. THROUGH TRAFFIC WILL BE MAINTAINED ON THE PROJECT AT ALL TIMES.
2. TRAFFIC CONTROL ON THIS PROJECT SHALL BE IN ACCORDANCE WITH LAYOUTS CONTAINED IN THE PLANS. FOR ADDITIONAL COMPLEMENTARY INFORMATION, REFER TO CURRENT SUPPLEMENTAL SPECIFICATION FOR TRAFFIC CONTROLS.
3. WHEN SPECIAL TRAFFIC CONTROL SHEET ENTITLED, "TRAFFIC CONTROL LAYOUT ONE-LANE TRAFFIC ON BRIDGES" IS NOT USED, STANDARD ROAD PLAN RS-2 SHALL BE USED FOR UNFINISHED WORK OR WORK WITHIN 12 FEET OF THE TRAVELED WAY, AND STANDARD ROAD PLAN RS-3 FOR WORK IN PROGRESS THAT ENCROACHES ON THE TRAVELED WAY.
4. ALL TRAFFIC CONTROL DEVICES SHALL BE FURNISHED, ERECTED, MAINTAINED AND REMOVED BY THE CONTRACTOR.
5. WHERE POSSIBLE, ALL POST MOUNTED SIGNS SHALL BE PLACED A MINIMUM OF TWO FEET CLEAR OF THE SHOULDER.
6. THE LOCATION FOR STORAGE OF EQUIPMENT BY THE CONTRACTOR DURING NON-WORKING HOURS WILL BE AS APPROVED BY THE ENGINEER IN CHARGE OF CONSTRUCTION.
7. THE ENGINEER MAY REQUIRE MODIFICATION OF, OR ADDITIONS TO, PAVEMENT MARKING DETAILS SHOWN. CONFLICTING PERMANENT EDGELINES OR CENTERLINES SHALL BE REMOVED AND REPLACED WITH APPROPRIATE TEMPORARY LINES. AS APPLICABLE, PERMANENT EDGELINES AND CENTERLINES SHALL BE RESTORED BEFORE THE ROADWAY IS RETURNED TO NORMAL TRAFFIC.
8. PROPOSED SIGN SPACING MAY BE MODIFIED, AS APPROVED BY THE ENGINEER, TO MEET EXISTING FIELD RESTRICTIONS OR TO PREVENT OBSTRUCTION OF THE MOTORIST'S VIEW OF PERMANENT SIGNING.
9. PROPOSED CHANGES IN THE TRAFFIC CONTROL PLAN (INCLUDES LAYOUT SHEET) SHALL BE REVIEWED WITH THE OFFICE OF CONSTRUCTION BEFORE CHANGES ARE MADE.
10. THE BID ITEM "TRAFFIC CONTROL" SHALL INCLUDE THE COST OF ALL TRAFFIC CONTROL MEASURES REQUIRED OF THE CONTRACTOR EXCEPT THOSE WHICH ARE SEPARATE BID ITEMS OR ARE INCIDENTAL TO OTHER BID ITEMS.

DETAILS FOR REPAIRS TO A 150' SKEW
159'-2x30' PRETENSIONED, PRESTRESSED
CONCRETE BEAM BRIDGE
43'-11/2 AND 47'-3/2 END SPANS 68'-9 INTERIOR SPAN
NOTES

STATION 512+10.00 Sept., 1985

JACKSON COUNTY

IOWA DEPARTMENT OF TRANSPORTATION-HIGHWAY DIVISION

Design Sheet No.: 2 Of 9 File No.: 28166 Design No.: 185

JACKSON COUNTY

PROJECT NUMBER

STATE

FWHA

Region

FISCAL

YEAR

SHEET

NO.

3

TOTAL

SHEETS


10

DESIGNED BY

LeRoy Ornborg

DETAILED BY

Shawn Foutch

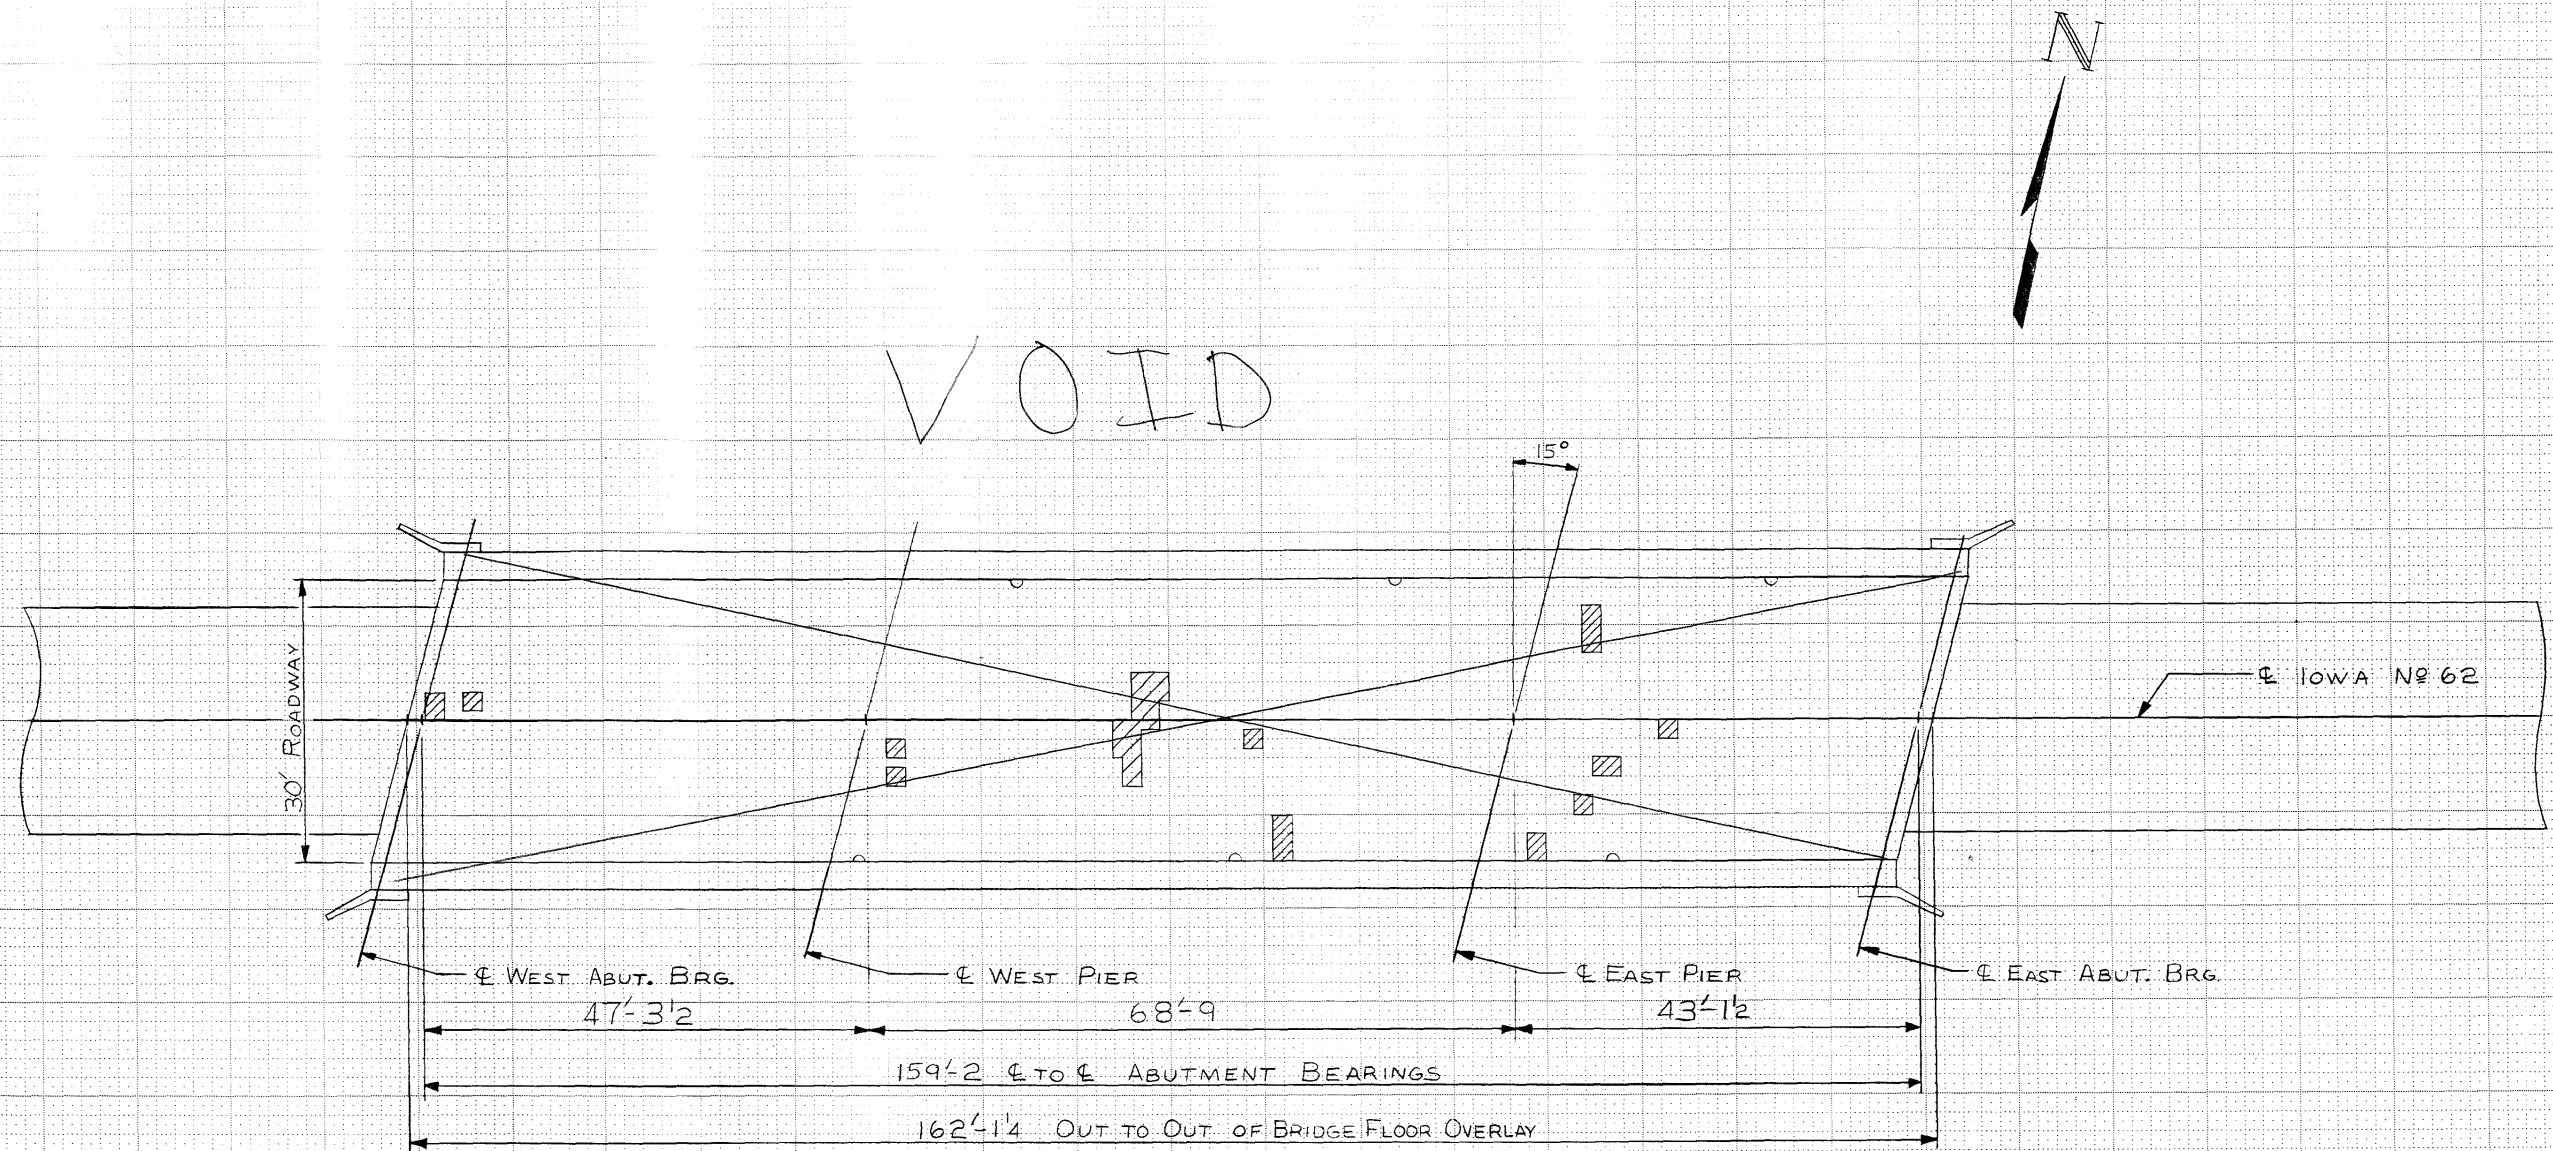

SURVEY PLOT

DATED 8-26-85

DETAILS FOR REPAIRS TO A 1500' SKEW
 15'-2x30' PRETENSIONED, PRESTRESSED
 CONCRETE BEAM BRIDGE
 43'-1 1/2' AND 47'-3 1/2' END SPANS 68'-9' INTERIOR SPAN
 SURVEY PLOT
 STATION 512+10.00 Sept., 1985
 JACKSON COUNTY
 IOWA DEPARTMENT OF TRANSPORTATION - HIGHWAY DIVISION
 DESIGN SHEET 3 OF 9 FILE 28166 DESIGN 185

DESIGNED BY: LeRoy Ormrod
 DETAILED BY: Shawn Eitzen


TRACED BY: _____
 CHECKED BY: _____

JACKSON COUNTY

PROJECT NUMBER

STATE	FHWA Region	FISCAL YEAR	SHEET NO.	TOTAL SHEETS
IOWA	7		4	

N

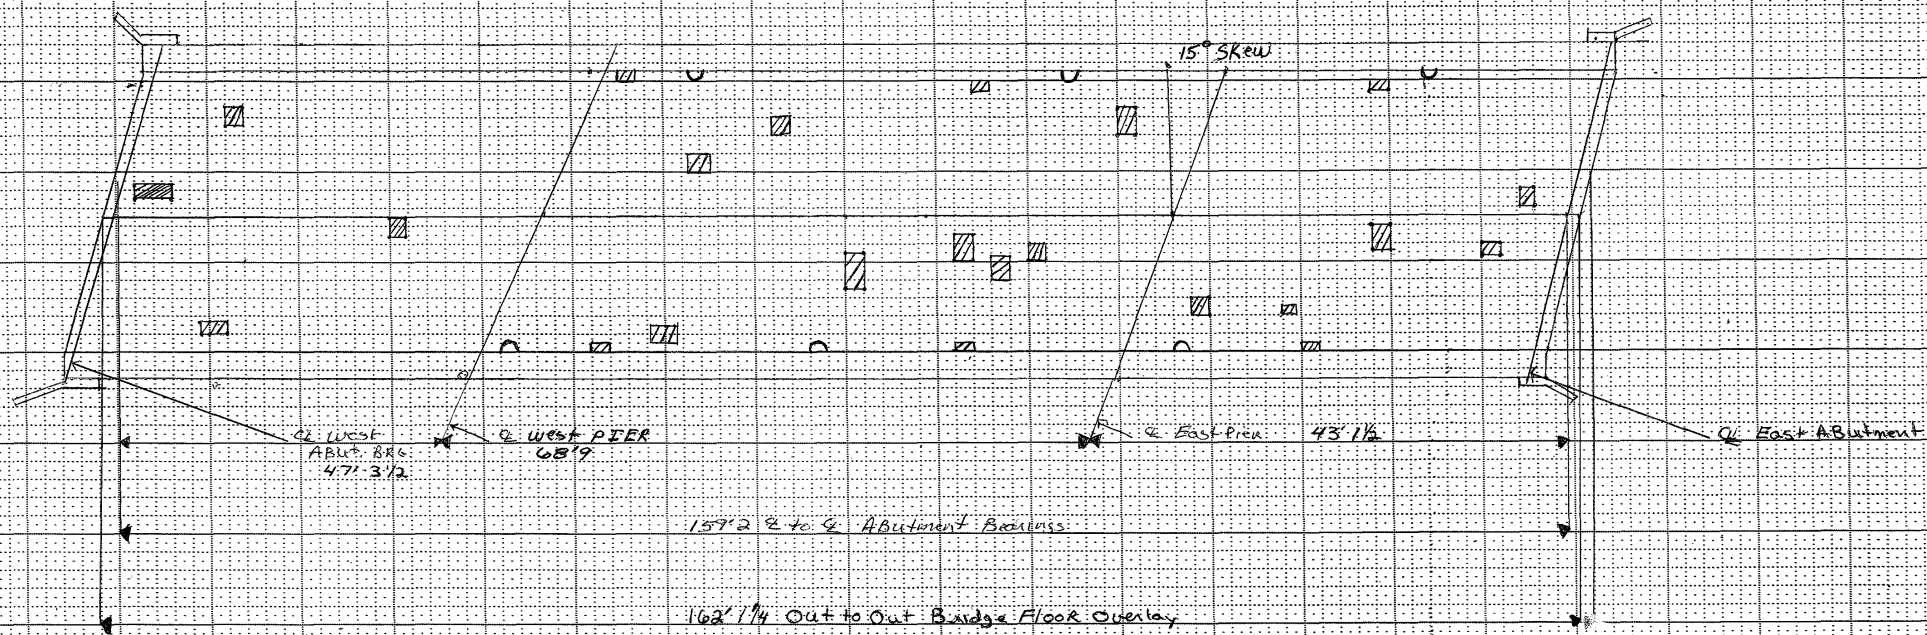

Actual Repair Areas

DETAILS OF REPAIRS TO A 15° SKEW
154'-2 1/2' PRETENSIONED PRESTRESSED
CONCRETE BEAM BRIDGE
43'-1 1/2' AND 47'-3 1/2' END SPANS 68'-9' INTERIOR SPAN
STATION 512+10
JACKSON COUNTY







BRUNING 63300

DESIGNED BY: _____ TRACED BY: _____
DETAILED BY: _____ CHECKED BY: _____

Jackson COUNTY

PROJECT NUMBER

STATE	FHWA Region	FISCAL YEAR	SHEET NO.	TOTAL SHEETS
IOWA	7			

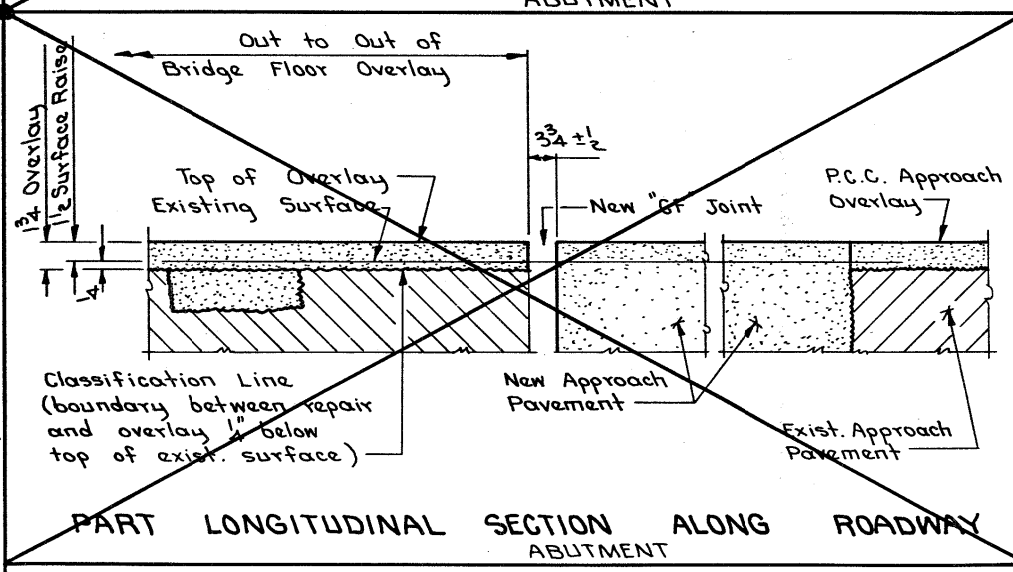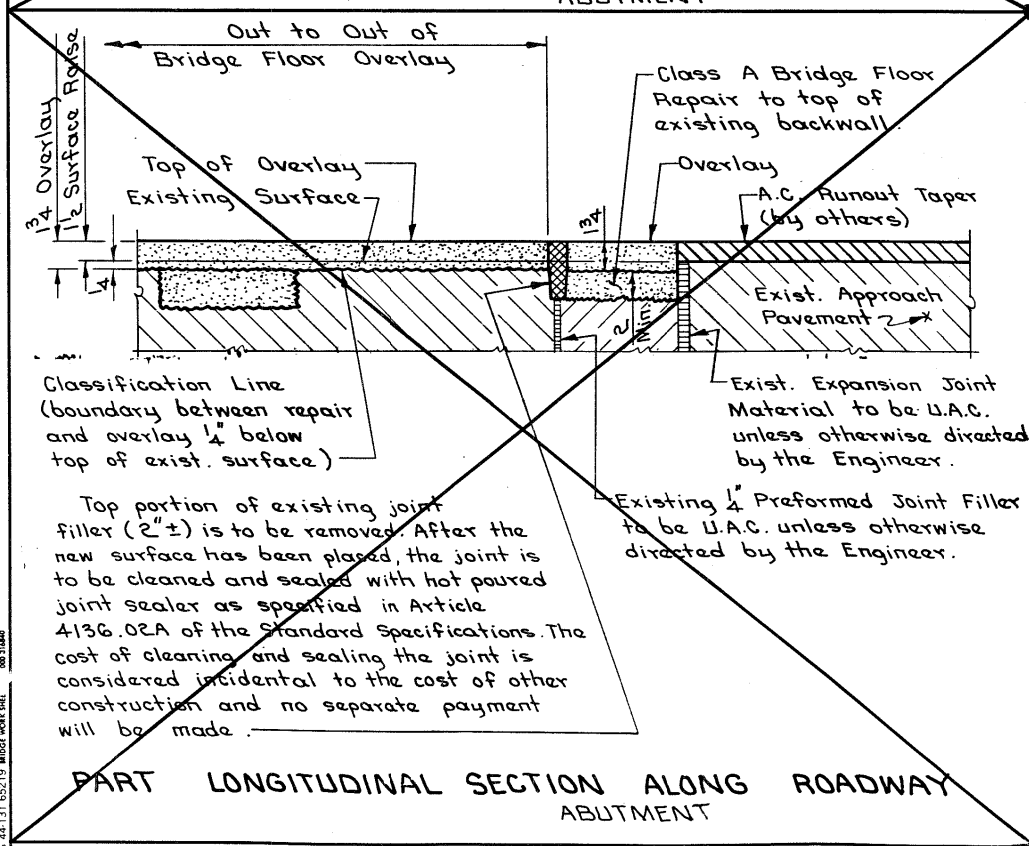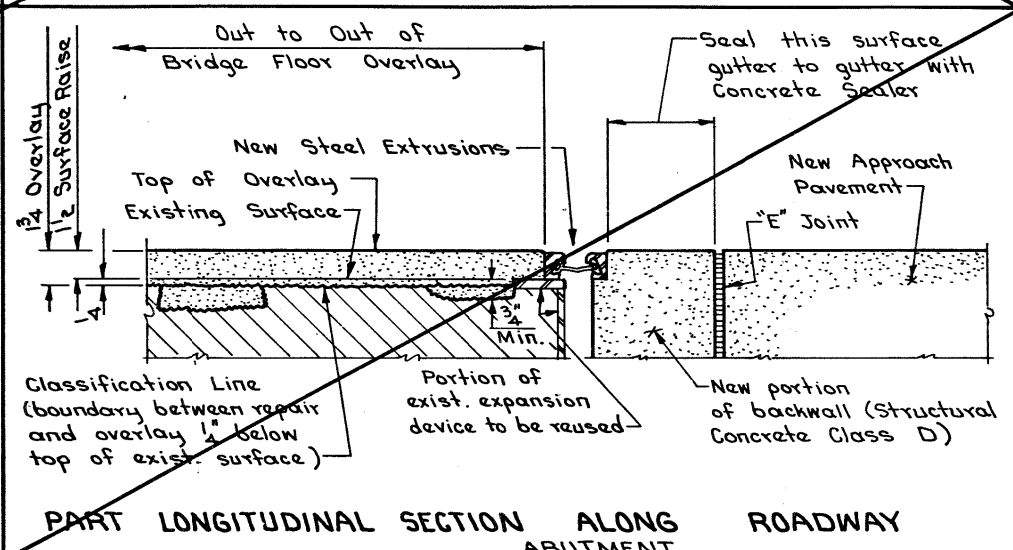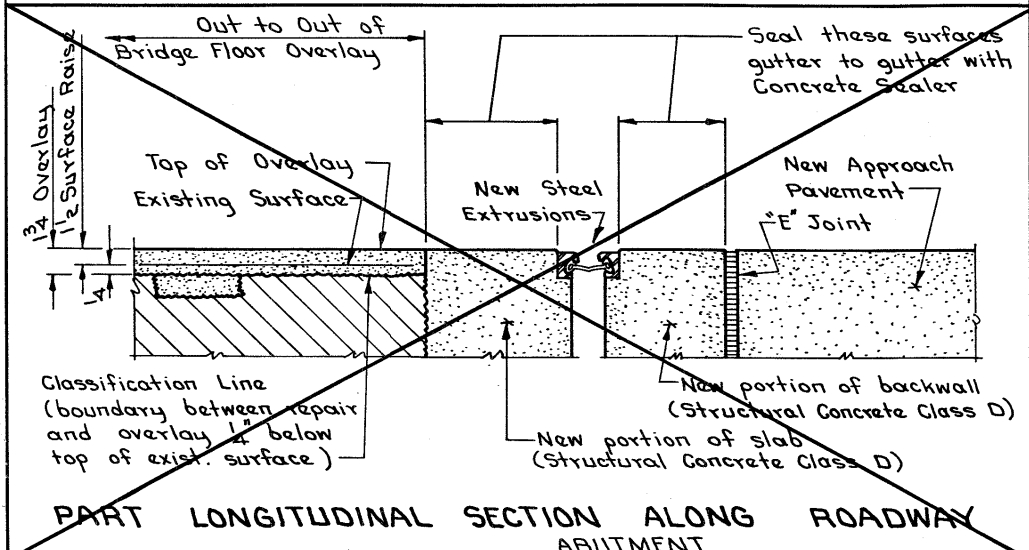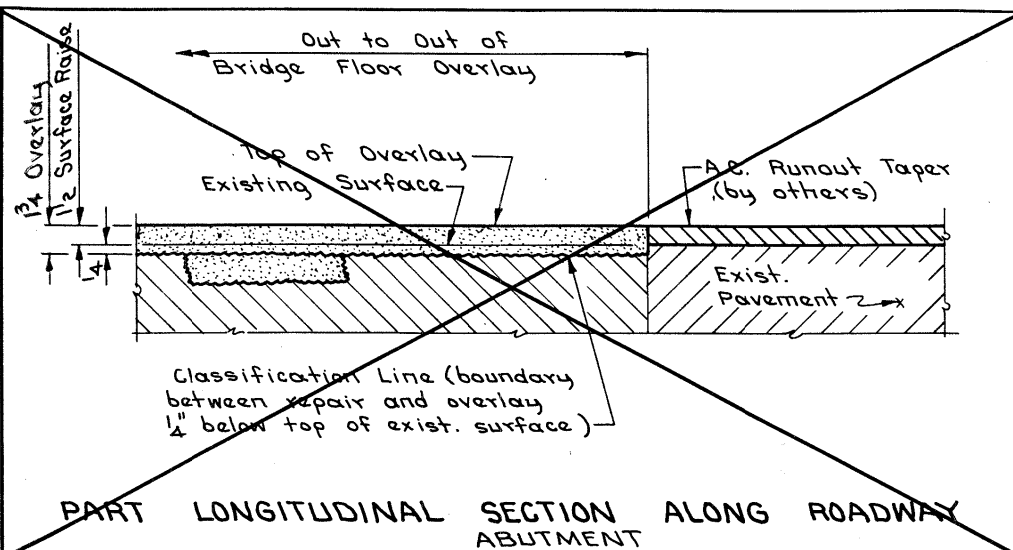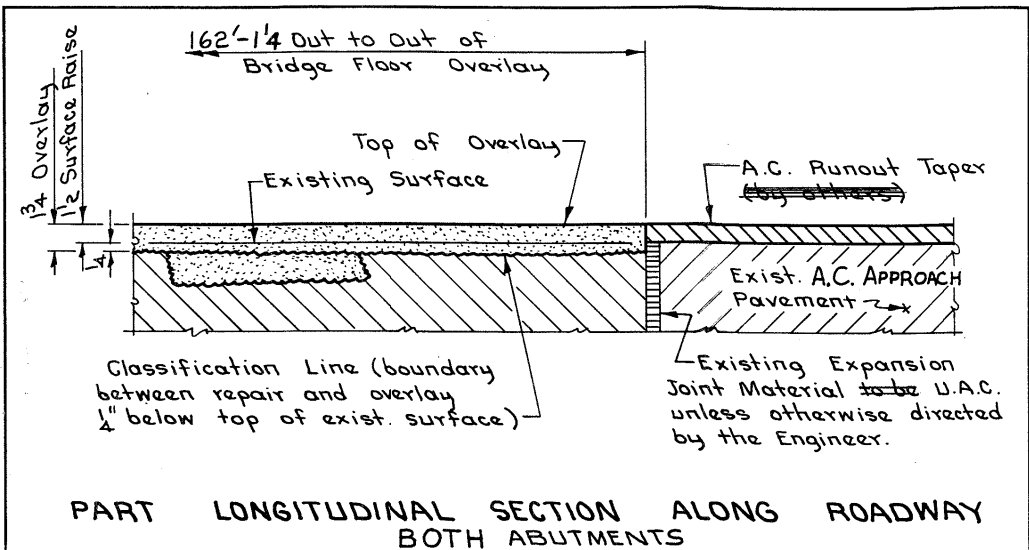



DESIGNED BY: LeRoy Ornborg
 DETAILED BY: Shawn Foster
 TRACED BY: _____
 CHECKED BY: _____

JACKSON COUNTY

DETAILS FOR REPAIRS TO A 15°00' SKEW
 154'2x30' PRETENSIONED, PRESTRESSED
 CONCRETE BEAM BRIDGE
 43'-1/2 AND 47'-3/2 END SPANS 68'-9" INTERIOR SPAN
 REPAIR DETAILS
 STATION 512+10.00 Sept., 1985
 JACKSON COUNTY
 IOWA DEPARTMENT OF TRANSPORTATION-HIGHWAY DIVISION
 Design Sheet No.: 6 Of 9 File No.: 28166 Design No.: 185

STATE	FWHA Region	FISCAL YEAR	SHEET NO.	TOTAL SHEETS
IOWA	7		7	10

Revised: 10/15/79. Reflector requirement was not changed.
Revised: 7-17-81; Reflector requirement changed. Bridge and
Reworked 09-05-79

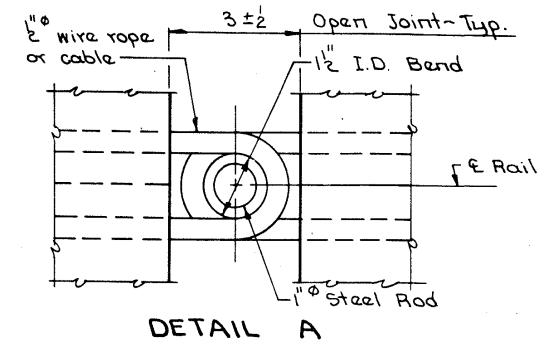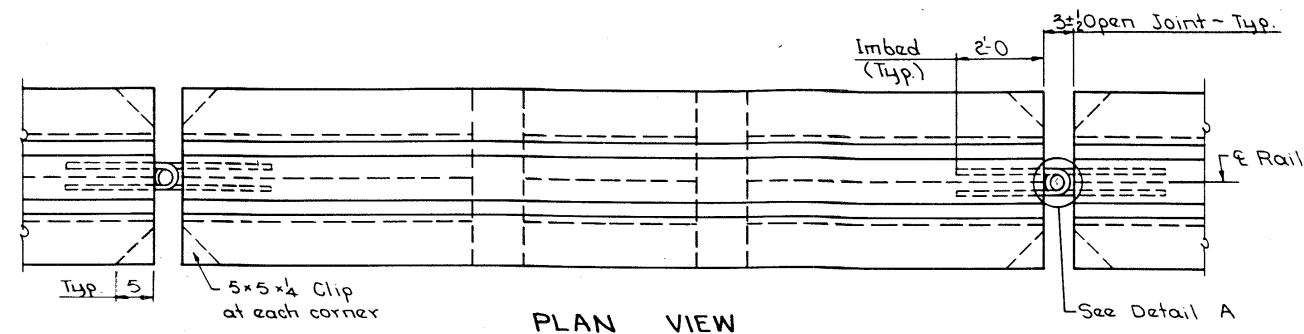

NOTE:

No stationary equipment or construction material is to be placed in front of the temporary barrier at any time.




Traffic reflectors shall be a retro-reflective type, approved by the engineer, and they shall be located as shown on this sheet. The contractor shall maintain the reflectors and shall promptly replace any missing or damaged units. All costs for furnishing, installing and maintaining reflectors shall be included in the price bid for "Temporary Barrier Rail, Place Only".

Refer to other details, notes and quantity items, elsewhere on these plans, for traffic control to be established in conjunction with the temporary barrier rail.

Shoulder width at this bridge site is 10 feet, therefore 12 concrete barrier rail sections are required for bridge end "B".

NOTE:

NOTE: Cost of 1" ϕ steel rods and 1" ϕ wire rope or cable to be considered incidental to furnishing the "Temporary Barrier Rail". Section 2403 shall not apply for the construction of temporary barrier rail. Minimum concrete strength shall be f'c = 3000 psi.

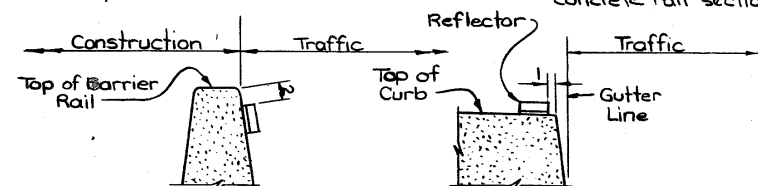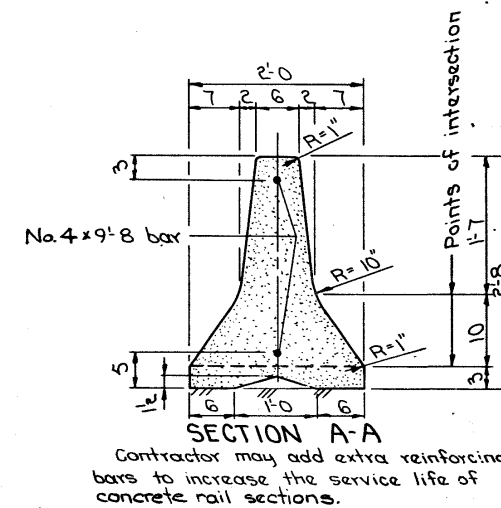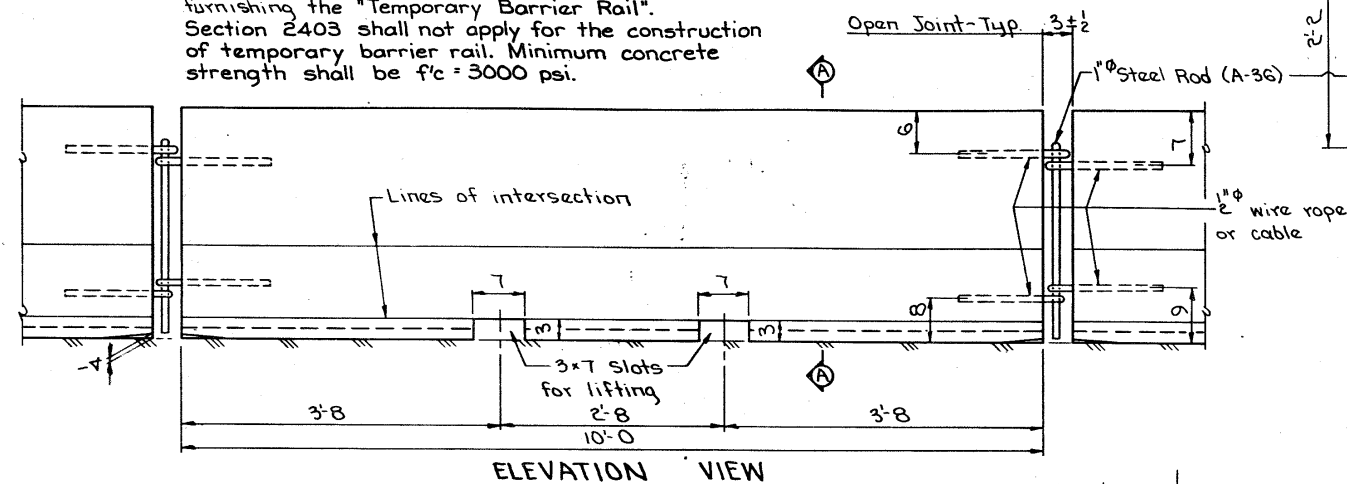


REFLECTOR DETAILS

Item Reference:

All Temporary Barrier Rail shall be nominal 10' long concrete units.

ESTIMATED QUANTITIES	
Item	Amount
Temporary Barrier Rail, Furnish Only	380 L.F.
Temporary Barrier Rail, Place Only	760 L.F.

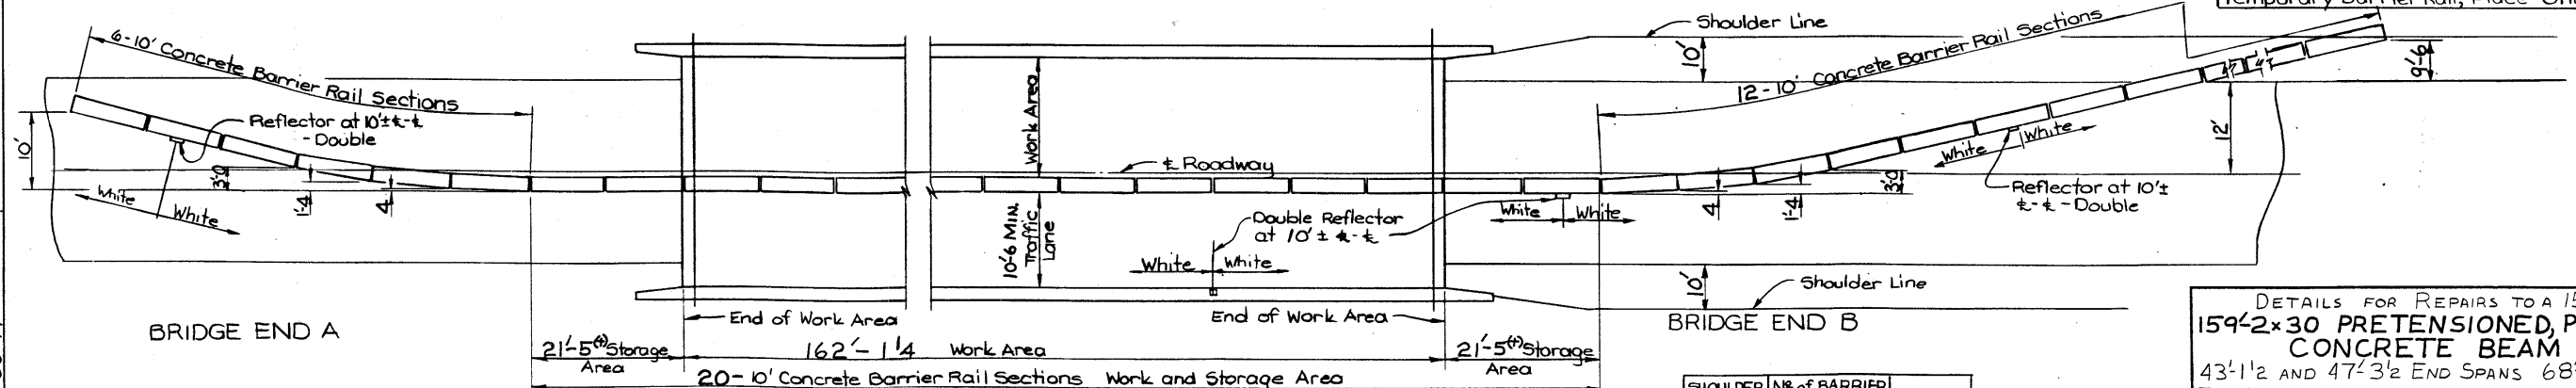

TEMPORARY CONCRETE BARRIER RAIL LAYOUT FOR TWO WAY TRAFFIC

Note: The layout shown is for one stage of construction and would be the same for the other stage by rotating 180° .

SHOULDER WIDTH (S)	N ^o of BARRIER RAIL SECTIONS (N)	D
4 ft.	9	2.5 ft.
6 ft.	10	5 ft.
8 ft.	11	7 ft.
10 ft.	12	9.5 ft.

DETAILS FOR REPAIRS TO A 15'00" SKEW
159'2" x 30' PRETENSIONED, PRESTRESSED
CONCRETE BEAM BRIDGE
43'11" AND 47'3 1/2" END SPANS 68'-9" INTERIOR SPAN
TEMPORARY BARRIER RAIL- CONCRETE
STATION 512+10.00 Sept., 1985

JACKSON COUNTY

IOWA DEPARTMENT OF TRANSPORTATION-HIGHWAY DIVISION

Design Sheet No.: 7 Of 9 File No.: 28/66 Design No.: 185

DESIGNED BY: LeRoy Ornberg
 DETAILED BY: Shawn Foutch

TRACED BY _____
CHECKED BY _____

TEMPORARY BARRIER RAIL - CONCRETE

STANDARD 1033

JACKSON COUNTY

PROJECT NUMBER	
----------------	--

STATE	FED. ROAD DIST. NO.	FISCAL YEAR	SHEET NO.	TOTAL SHEETS
IOWA	5		8	10