

FED. ROAD DIST. NO.	STATE	FED. AID PROJ. NO.	FISCAL YEAR	SHEET NO.	TOTAL SHEETS
5	IOWA	144		1	1

STATE OF IOWA

STATE HIGHWAY COMMISSION

PLAN AND PROFILE OF PROPOSED IMPROVEMENT

ON THE

PRIMARY ROAD SYSTEM

FEDERAL AID PROJECT NO. 144

JACKSON COUNTY

FROM BELLEVUE SOUTHWEST


PLAN 1 INCH = 100 FT

PROFILE HOR. 1 INCH = 100 FT. VERT. 1 INCH = 10 FT.


MILEAGE SUMMARY

Sta. 450+33.0 to Sta. 1099+34.0.....

TYPICAL CROSS SECTIONS

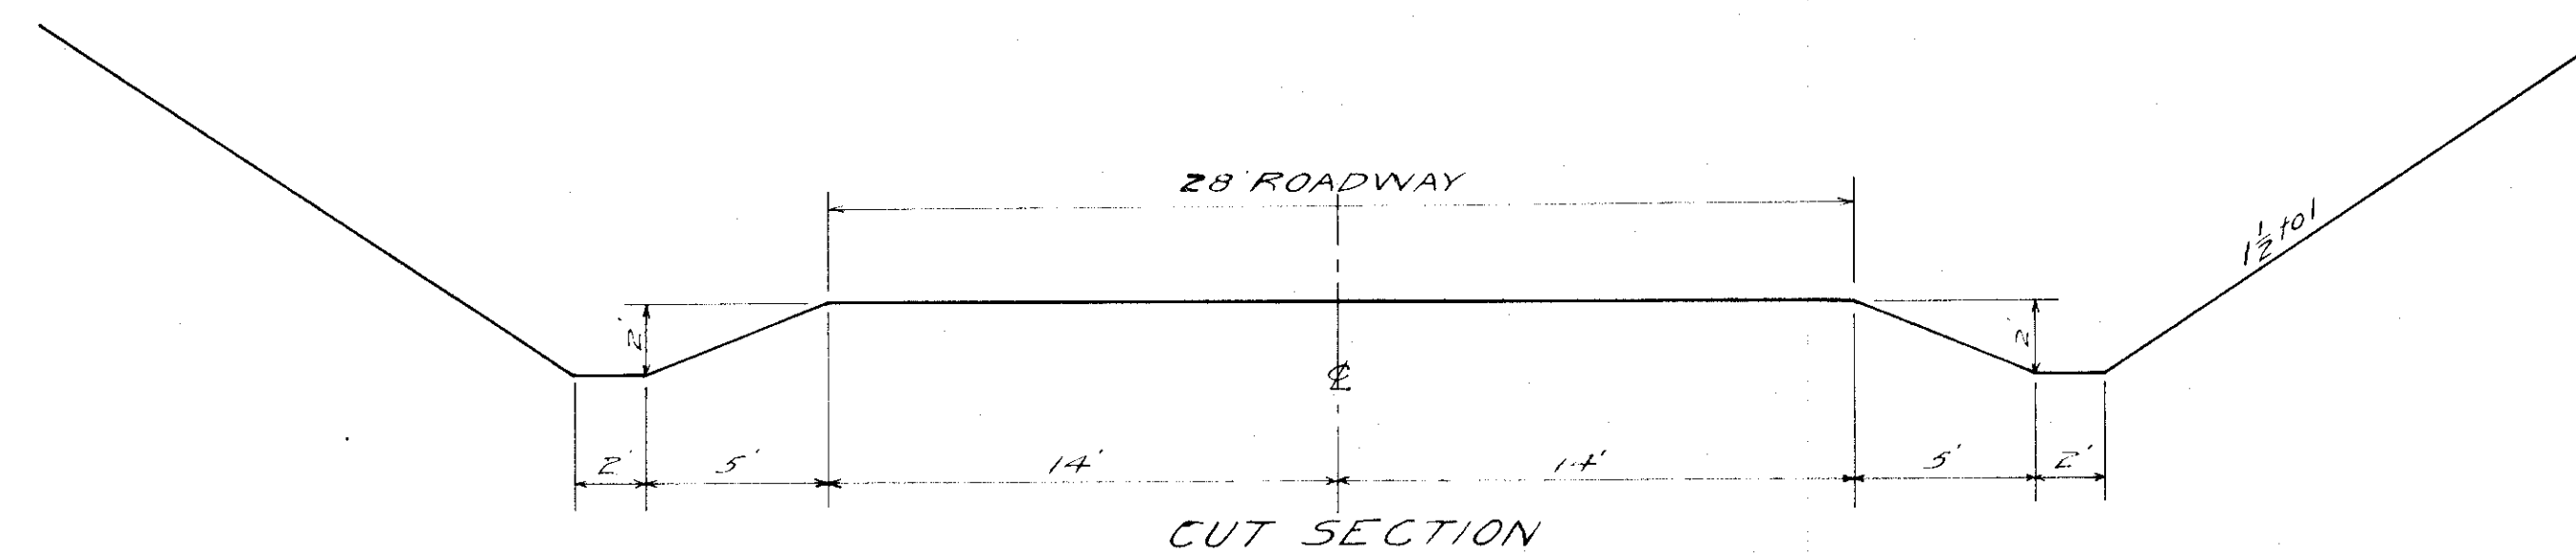

Above section to be used except in Rock cuts or where otherwise noted on plans.

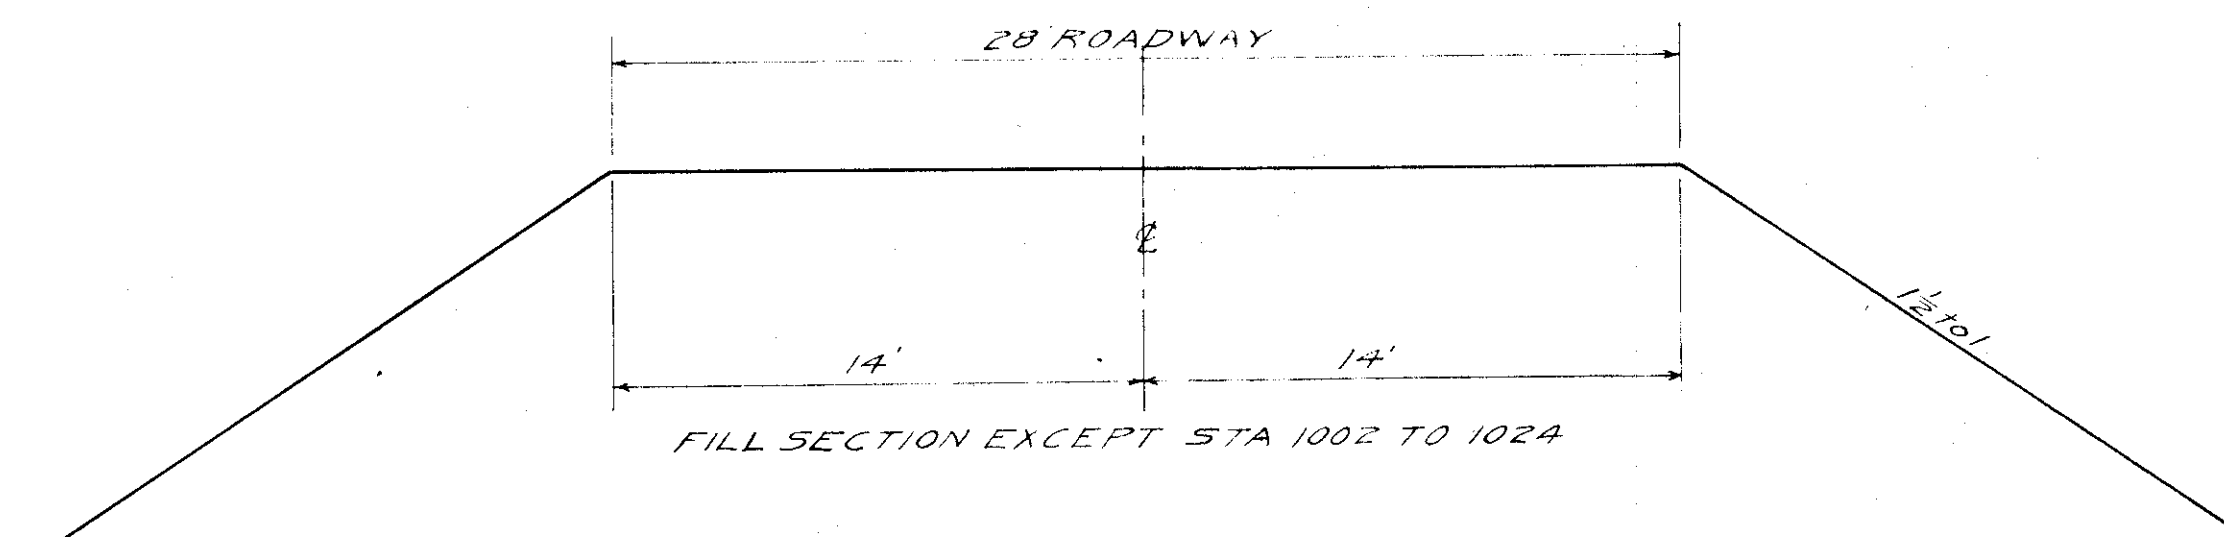

PERRY TOWNSHIP
T.85N. R.3E.
SEC. 1

JACKSON TOWNSHIP
T.85N. R.4E.
SEC. 6

WM. OBERMAN

E.D. SOMMERS

CULTIVATED

PASTURE

CULTIVATED

CULTIVATED

