

100
P.C.C. PAVING
NHS-100-1(23)--19-57

LINN COUNTY

NHSX-100-1(23)--19-57
NHSX-100-1(22)--19-57
P.C.C. PAVING
EROSION CONTROL

Form 52003 12-97

I hereby certify that this project was constructed in accordance with the contract documents, the "as-built" plans were prepared under my supervision, and that I am a duly licensed Professional Engineer under the laws of the State of Iowa.

Kenneth A. Yanna July 13, 2004
Project Engineer Date

My license renewal date is December 31, 2004

1996 Fred Carlson, Inc. Mark Pollet
Year Contractor Project Inspector

IOWA
DEPARTMENT OF TRANSPORTATION
Project Development Division
PLANS OF PROPOSED IMPROVEMENTS ON THE
PRIMARY ROAD SYSTEM
LINN COUNTY
P.C.C. PAVING

MARION BY-PASS FROM FIRST AVENUE IN CEDAR RAPIDS
THRU MARION TO U.S. #151
SCALE: As Noted



The Iowa Department of Transportation Standard Specifications for Highway and Bridge Construction, series of 1992, plus current Supplemental Specifications and Special Provisions shall apply to construction work on this project.

Value Engineering Saves. Refer to Standard Notation 203-4 on Sheet C.05.

Equation:
P.O.T. Sta. 179+52.06 (O.R.) (Back)
P.O.T. Sta. 179+06.68 (Sur.) (Ahead)

Sta. 116+63.38 (O.R.)
Begin Project
Mile Post 4.085

Sta. 306+00.00 (O.R.)
End Project
Mile Post 7.798

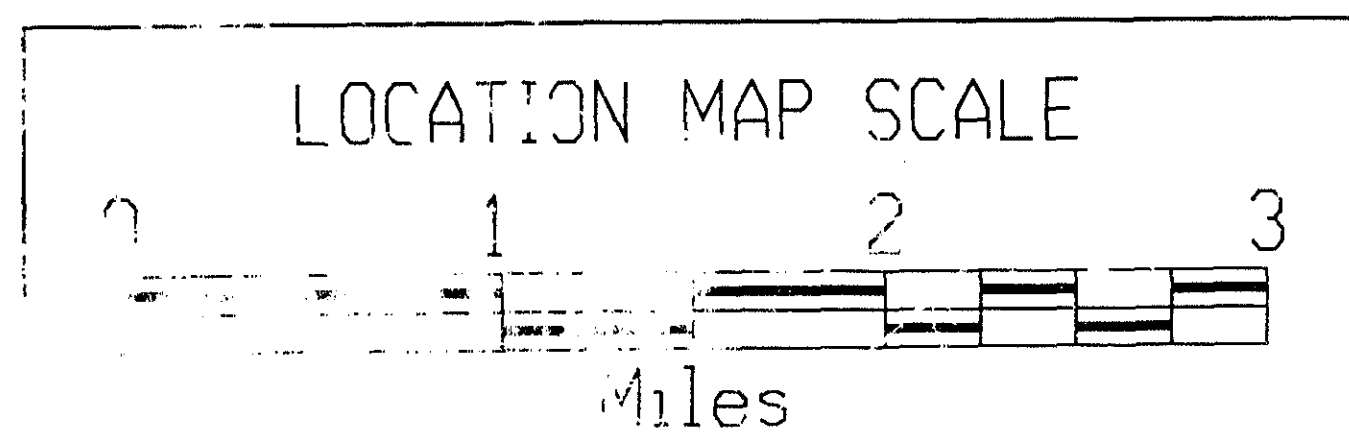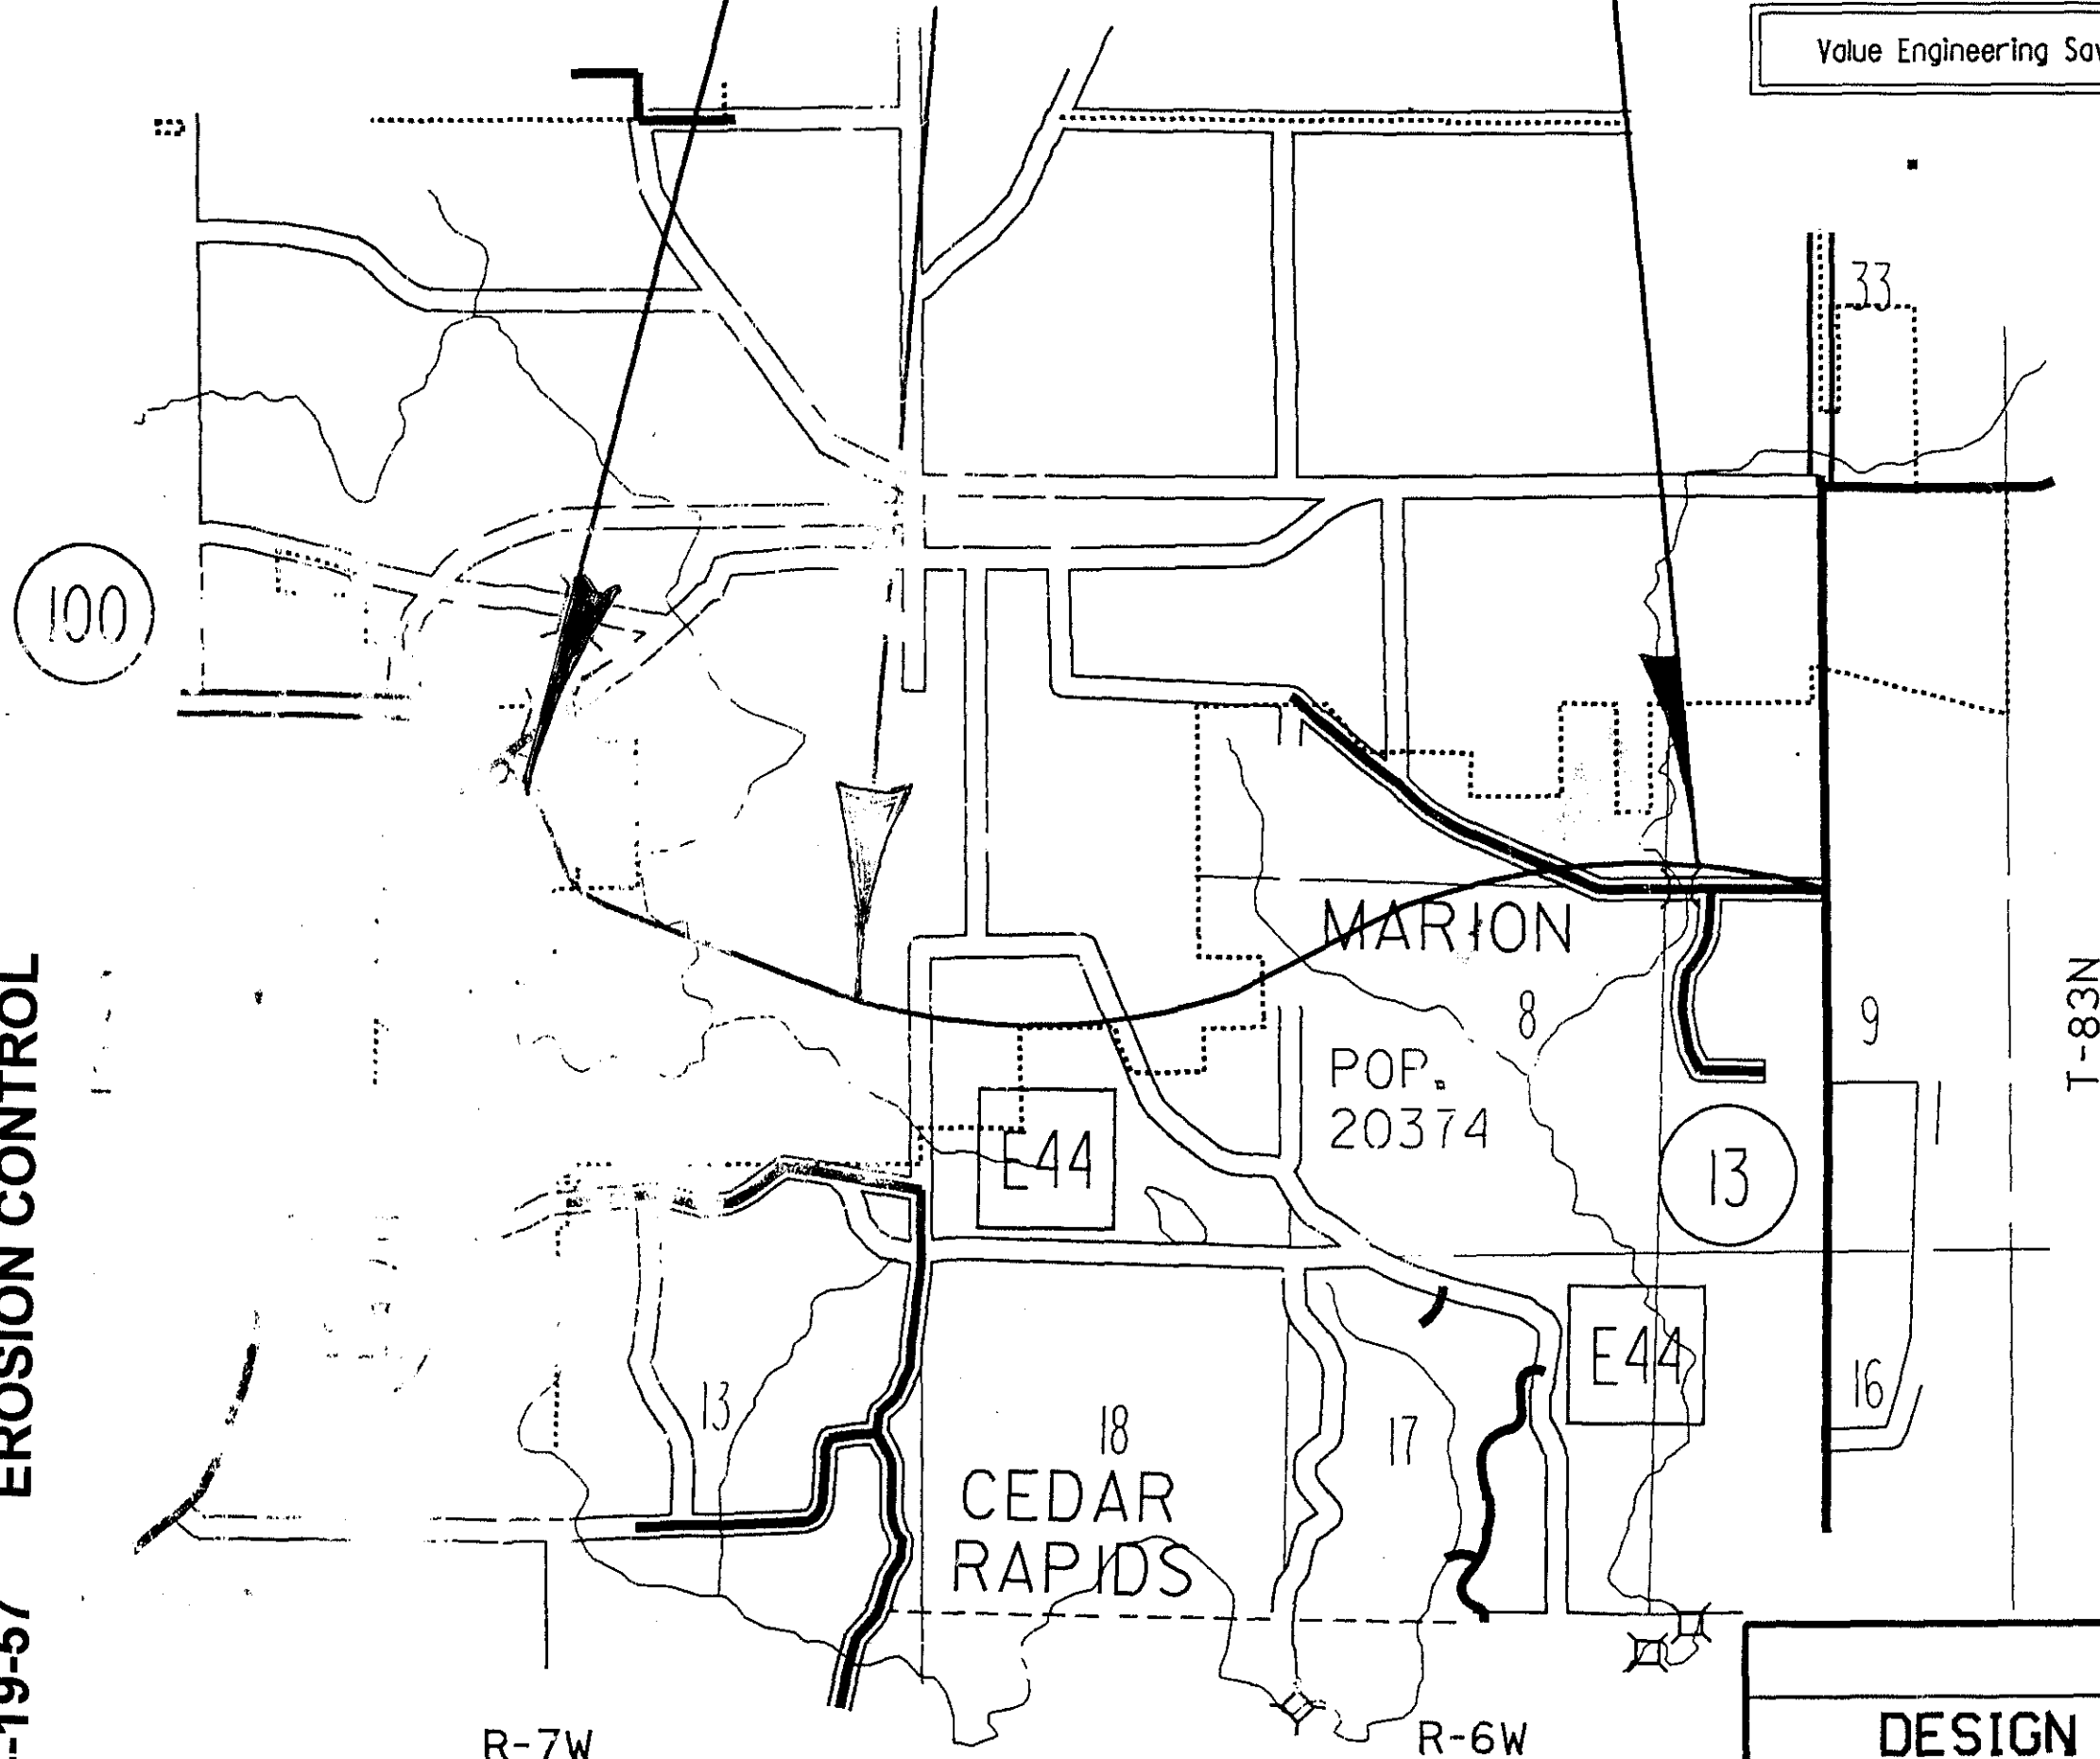

MILEAGE SUMMARY			
		105-1	
		03-15-94	
DIV.	LOCATION	LIN. FT.	MILES
1.	URBAN : Sta. 116+63.38 (O.R.) To Sta. 238+29.63 (Sur.) Sta. 260+32.14 (Sur.) To Sta. 285+63.44 (Sur.) EQUATION : P.O.T. Sta. 179+52.06 (O.R.) (Back) =P.O.T. Sta. 179+06.68 (Sur.) (Ahead) LENGTHENS LINE Deduct for Bridge @ Sta. 153+00.00 (O.R.)	12,166.25 2,531.30 45.38 506.00	2.304 0.479 0.009 0.096
	NET LENGTH OF ROADWAY- DIVISION #1	14,236.93	2.696
	NET LENGTH OF BRIDGES- DIVISION #1	506.00	0.096
	TOTAL LENGTH OF DIVISION #1	14,742.93	2.792
2.	RURAL : Sta. 238+29.63 (Sur.) To Sta. 260+32.14 (Sur.) Sta. 285+63.44 (O.R.) To Sta. 306+00.00 (O.R.) NET LENGTH OF ROADWAY- DIVISION #2	2,202.51 2,036.56 4,239.07	0.417 0.386 0.803
	TOTAL LENGTH OF DIVISION #2	4,239.07	0.803
	NET LENGTH OF ROADWAY IN PROJECT	18,476.00	3.499
	NET LENGTH OF BRIDGES IN PROJECT	506.00	0.096
	TOTAL LENGTH OF PROJECT	18,982.00	3.595

DESIGN DATA IA. #100 HIGHWAY			
1995 AADT	11,900	V.P.D.	
2015 AADT	15,900	V.P.D.	
2015 DHV	1,600	V.P.H.	
TRUCKS	5	%	

175



I hereby certify that this plan was prepared under my supervision and that engineering decisions with regard to the design were made by me or by other duly Registered Professional Engineers under the laws of the State of Iowa.

Name Daniel E. East
Iowa Registration No. 10267 Date 7/27/95

U.S. DEPARTMENT OF TRANSPORTATION
FEDERAL HIGHWAY ADMINISTRATION
APPROVED

FOR THE DIVISION

LINN COUNTY

PROJECT NO. NHS-100-1(23)--19-57

Total Sheets = 145
PROJECT NUMBER
NHS-100-1(23)--19-57
R.O.W. PROJECT NUMBER
PROJECT IDENTIFICATION NUMBER
90-57610-3

INDEX OF SHEETS

NO.	DESCRIPTION
A.01	Title Sheet
A.02	Urban Map of the Cities of Cedar Rapids and Marion
A.03	Symbols and Information Sheet
B.01-B.07	Typical Sections
C.01-C.14	Estimate of Quantities and general information
D.01-D.09	Mainline Plan and Profile Sheets
E.01-E.08	Sidewalk Plan and Profile Sheets
F.01-F.03	Detour Plan and Profile Sheets
G.01-G.06	Reference Ties and Bench Marks
H.01-H.16	Staging and Traffic Control Sheets
I.01-I.38	Intersection Geometries, Staking, Edge Profiles and jointing Sheets
M.01-M.10	Storm Sewer, Water main and Sanitary Sewer Sheets
O.01-O.04	Soils Sheets
R.01	Borrow Sheets
S.01	Schematic Haul Diagram
T.01-T.03	Tabulation of Earthwork Quantities
U.01-U.14	500 Series Detail Sheets
V.01-V.04	Bridge and Culvert Situation Plans
W.01	BENCH MARKS

STANDARD ROAD PLANS

The following Standard Road Plans shall be considered applicable to construction work.

NUMBER	DATE	NUMBER	DATE	NUMBER	DATE
RA-1	02-23-93	RA-8(1)	08-08-89	RA-8(2)	08-08-89
RA-8(3)	08-08-89	RA-3B	01-19-88	RA-27	01-19-88
		RB-6	11-10-92	RC-16	04-28-92
RE-2A	02-17-87	RE-2B	10-22-93	RE-7	04-28-92
RE-12A	10-11-88	RE-12B	10-11-88	RE-47	11-10-87
RE-46A	06-15-93	PE-5	02-23-93	PE-65	01-07-92
RE-68	03-08-89	RE-6	10-22-93	RF-1	09-03-76
RF-3	11-10-92	RF-5	11-10-92	RF-14	04-28-92
RF-19C	04-28-92	RF-5	11-10-92	RF-30A	03-28-95
RF-30B	03-28-95	RF-31	03-28-95	RF-32	03-28-95
Rh-22	11-10-92	RH-31	11-10-92		08-23-92
RH-50	03-28-95	RH-51	03-28-95		08-07-94
RK-19A	09-29-92	RK-1	11-10-92		08-07-94
RL-7	07-16-91	RL-11	07-16-91	RS-2	
RS-3	02-23-93	RS-6	02-23-93	RS-15	

REVISIONS

U.S. DEPARTMENT OF TRANSPORTATION
FEDERAL HIGHWAY ADMINISTRATION
APPROVED

FOR THE DIVISION

EROSION CONTROL
NHS-100-1(22)--19-57

LETTING DATE
Oct 29, 1996

LINN CO.

DESIGN TEAM SKAAR

IOWA
DEPARTMENT OF TRANSPORTATION
Project Development Division
PLANS OF PROPOSED IMPROVEMENTS ON THE
PRIMARY ROAD SYSTEM
LINN COUNTY
EROSION CONTROL
MARION BY-PASS FROM FIRST AVE. IN CEDAR RAPIDS
THRU MARION TO U.S. 151


SCALES: As Noted

The Iowa Department of Transportation Standard Specifications for Highway and Bridge Construction, series of 1992, plus current Supplemental Specifications and Special Provisions shall apply to construction work on this project.


Value Engineering Saves. Refer to Standard Notation 203-4 on Sheet C.O.1

EQUATION:
STA. 179+52.06 OR BACK
= STA. 179+06.68 SUR AHD

STA. 166+63.38
BEGIN PROJECT
M.P.= 4.085

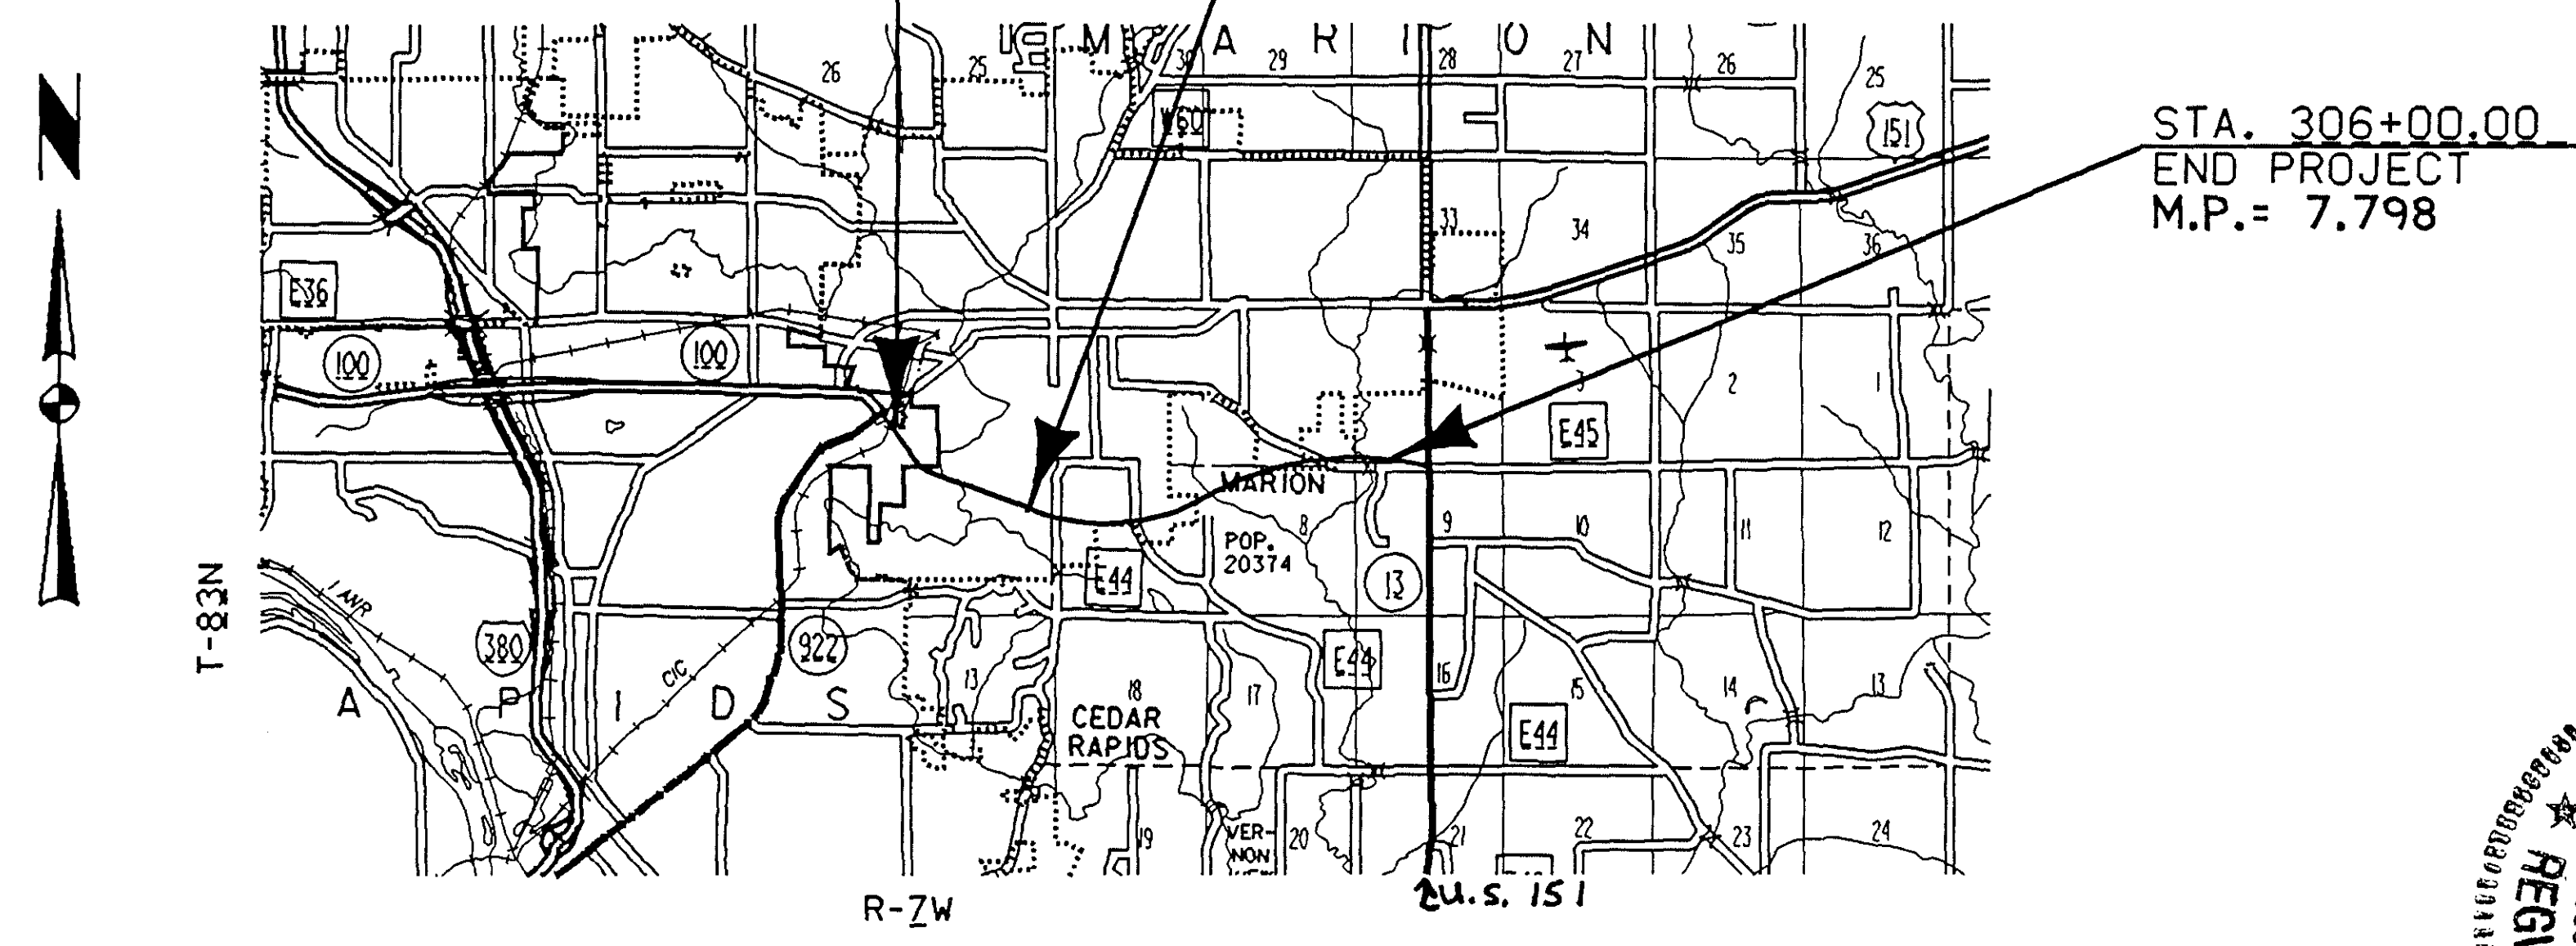

STA. 306+00.00
END PROJECT
M.P.= 7.798

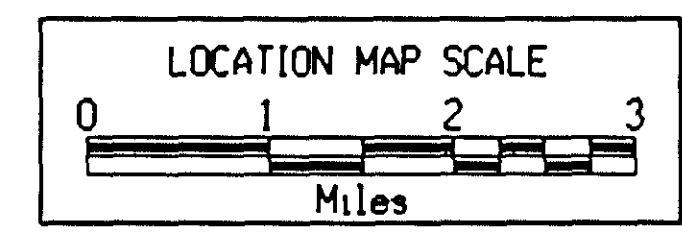

* 80 *

TOTAL	5
PROJECT NUMBER	NHS-100-1(22)--19-57
R.O.W. PROJECT NUMBER	
PROJECT IDENTIFICATION NUMBER	90-57010-3

INDEX OF SHEETS		105-3 02-21-82
NO.	DESCRIPTION	
A.01-A	TITLE SHEET	
C.01-A	SUMMARY SHEET EROSION CONTROL WORK	
C.0-A 2,3,4	GENERAL INFORMATION	

STANDARD ROAD PLANS						105-4 06-12-72
The following Standard Road Plans shall be considered applicable to construction work on this project.						
NUMBER	DATE	NUMBER	DATE	NUMBER	DATE	
RC-5	9-23-86	RC-14	9-23-86	RS-72	6-7-94	
RS-73	6-7-94					

REVISIONS

Iowa Department of Transportation
Project Development Division
AUTHORIZED FOR LETTING
Donald L. Enders
DESIGN ENGINEER
Iowa Registration No. 5545 Date 8-15-96

I hereby certify that this plan was prepared under my supervision and that landscaping decisions with regard to the design were made by me or by other duly Registered Professional Landscape Architects under the laws of the State of Iowa.
Name *Mark Masteller*
Iowa Registration No. 269 Date 8-14-96

U.S. DEPARTMENT OF TRANSPORTATION
FEDERAL HIGHWAY ADMINISTRATION
APPROVED
FOR THE DIVISION ADMINISTRATOR DATE




LINN COUNTY


PROJECT NO. NHS-100-1(22)--19-57

SHEET NO. A.01-A


P.2

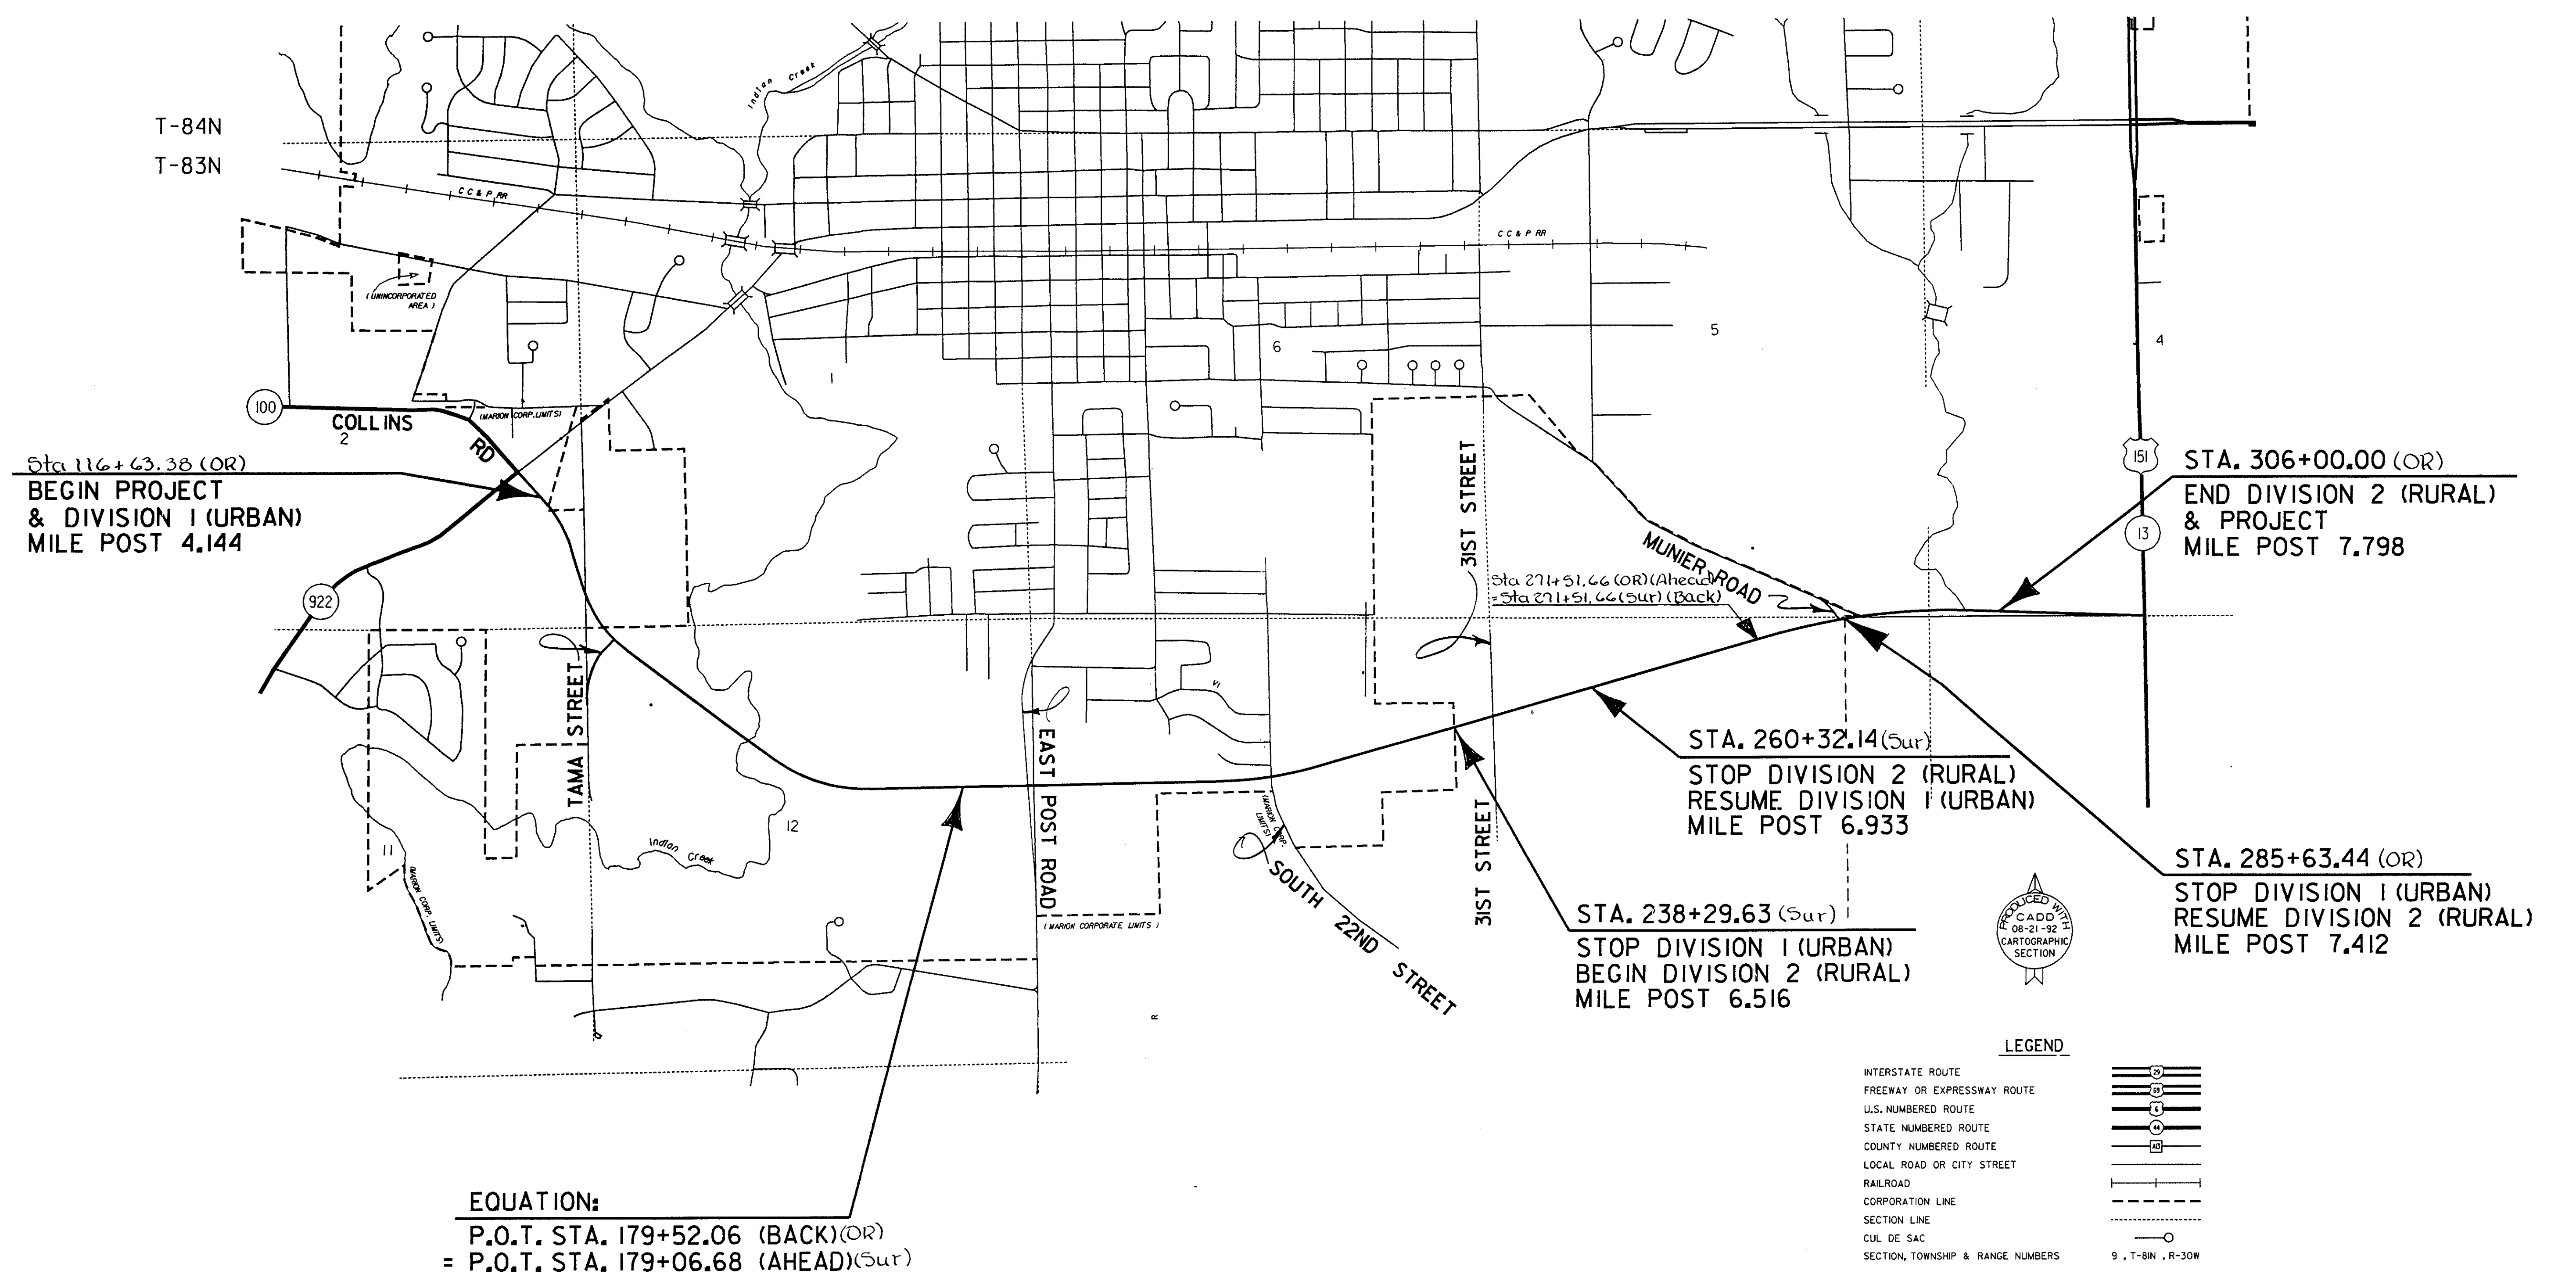

EQUATION:
P.O.T. STA. 179+52.06 (BACK)(OR)
= P.O.T. STA. 179+06.68 (AHEAD)(Sur)

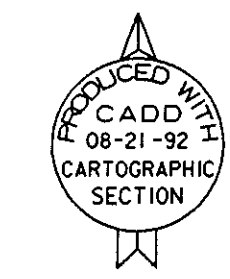

- LEGEND
- INTERSTATE ROUTE
 - FREEWAY OR EXPRESSWAY ROUTE
 - U.S. NUMBERED ROUTE
 - STATE NUMBERED ROUTE
 - COUNTY NUMBERED ROUTE
 - LOCAL ROAD OR CITY STREET
 - RAILROAD
 - CORPORATION LINE
 - SECTION LINE
 - CUL DE SAC
 - SECTION, TOWNSHIP & RANGE NUMBERS

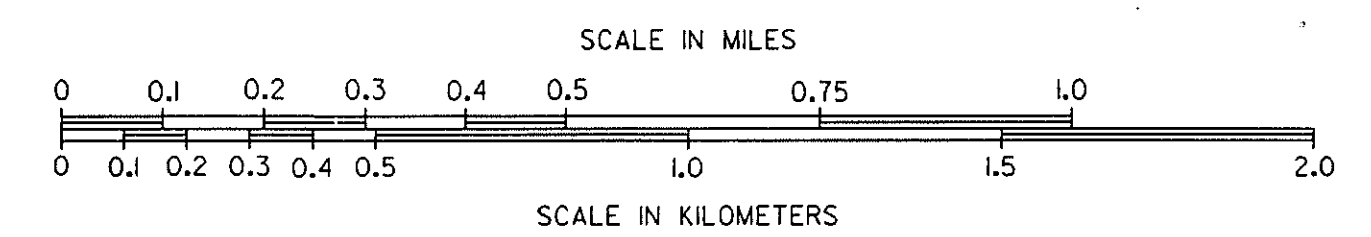

HIGHWAY AND STREET MAP
OF
CEDAR RAPIDS AND MARION
IOWA

STANDARD SYMBOLS

	Interstate Highway Symbol		Fire Hydrant
	U.S. Highway Symbol		Water Hydrant (Rural)
	Iowa Highway Symbol		Septic Tank
	County Road Highway Symbol		Cistern
	Evergreen Tree		L.P. Gas Tank (No Footing)
	Deciduous Tree		Underground Storage Tank
	Fruit Tree		Latrine
	Shrub (Bushes)		Luminaire
	Timber		Traffic Signal
	Hedge		Traffic Signal with Luminaire
	Stump		Telephone Pedestal
	Swamp		TVP Television Pedestal
	Rock Outcrop		Telephone Pole
	Broken Concrete		Telephone Pole (Second Company)
	Revetment (Rip Rap)		Telephone Pole (Third Company)
	Cemetery		Telephone Pole (Fourth Company)
	Grave		Telephone Pole (Fifth Company)
	Cave		Power Pole
	Sink Hole		Power Pole (Second Company)
	Board Fence		Power Pole (Third Company)
	Chain Link Fence		Power Pole (Fourth Company)
	Barbwire Fence		Power Pole (Fifth Company)
	Security Fence		Electrical Highline Tower (Metal or Concrete)
	Woven Fence		Telephone Riser Pole
	Barbwire and Woven Fence		Power Riser Pole
	Terrace		Telegraph Pole
	Earth Dam or Dike (Existing)		Satellite TV Dish
	Earth Dam or Dike (Proposed)		Existing Water Line
	Tile Outlet		Existing Water Line (Second Company)
	Edge of Water		Existing Sanitary Sewer Line
	Existing Drainage		Existing Telephone Line
	Proposed Drainage		Existing Telephone Line (Second Company)
	Right of Way Rail or Lot Corner		Existing Fiber Optics Telephone Line
	Concrete Monument		Existing Storm Sewer Line
	Well		Existing Gas Line
	Windmill		Existing High Pressure Gas Line
	Beehive Intake		Existing Gas Line (Second Company)
	Existing Intake		Existing High Pressure Gas Line (Second Company)
	Proposed Intake		Existing Power Line
	Existing Utility Access (Manhole)		Existing Power Line (Second Company)
	Proposed Utility Access (Manhole)		Cable Television Line

	Guardrail (Beam or Cable)
	Guard Post (one or two)
	Guard Post (over two)
	Filler Pipe
	Gas Valve
	Water Valve
	Speed Limit Sign
	Mile Marker Post
	SIGN Sign
	Radio Tower
	Tower Anchor
	Electric Box
	Traffic Signal Control Box
	Rail Road Signal Control Box
	Telephone Switch Box

UTILITY LEGEND

	Iowa Electric Light & Power
	City of Cedar Rapids Water
	City of Cedar Rapids Sanitary Sewer
	U.S. West Direct
	City of Marion Water
	City of Marion Sanitary Sewer
	Iowa Electric Light & Power
	Iowa Electric Light & Power
	Iowa Illinois Gas & Electric

RIGHT OF WAY LEGEND

	Proposed Right of Way
	Existing Right of Way
	Existing and Proposed Right of Way
	Easement and Existing Right of Way
	Borrow
	Easement (Temporary)
	Easement
	Excess
	Property Line
	Access Control

UNIQUE SYMBOLS FOR THIS PROJECT

CONVENTIONAL SIGNS


	Survey Line
	Section Corner
	Proposed Profile Grade
	Railroad
	Field Tile
	Culverts
	Stream

Legend And Symbol Information Sheet

(Symbols are Typical Only,
actual size may vary)

Typical Cross Section of 4 Lane P.C.C. Pavement With Curbed Median.

Spec.
Typ. # 1

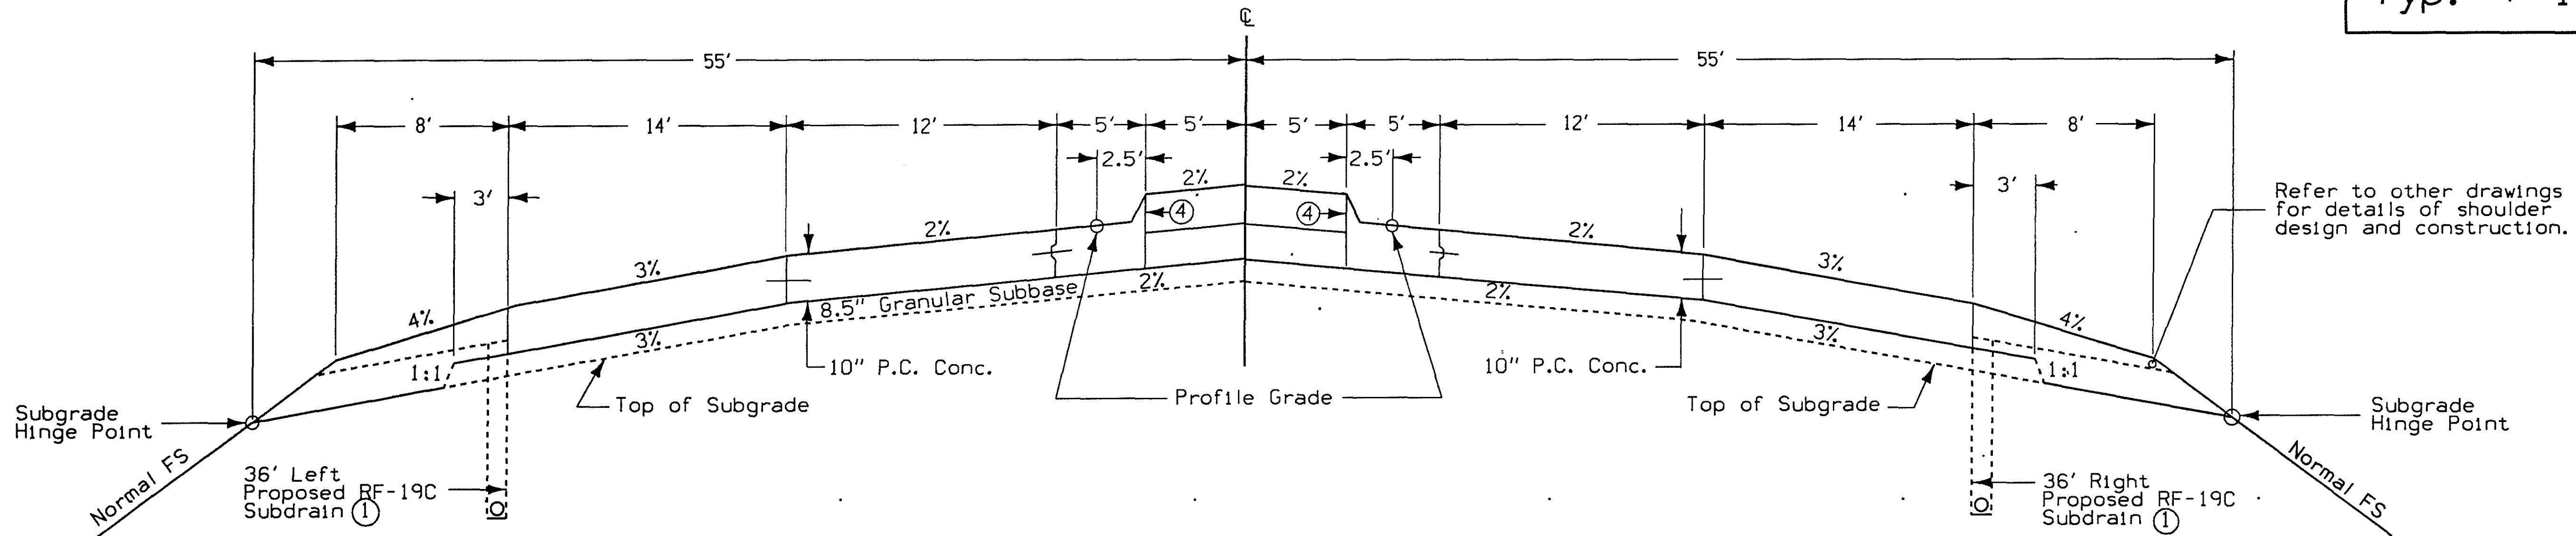

Note: Normal section shown may appropriately modified for areas specifically designed by the engineer such as intersections or superelevated curves.




Note: Refer to Typical Section 2205 (Modified) for P.C.C. Auxiliary Lane.

Note: Refer to appropriate cross sections thru areas of superelevation.



Ident.	Station	to Station	Shoulder	Remarks
Ia #100	116+63.38 (OR)	179+52.06 (OR)	6" Type "A"	④
Ia #100	179+06.68 (Sur)	306+00.00 (OR)	6" Type "A"	④
East Post Rd.	1174+00.00	1200+00.00 (OR)	6" Type "A"	②③④

Ia #100 Equations: Sta 179+52.06 (OR Back)
=Sta 179+06.68 (Survey Ahead)
P.C. Sta 271+51.66 (Survey Back)
=P.C. Sta 271+51.66 (OR Ahead)

- ① If subdrain is proposed refer to Standard Road Plan RF-19C.
- ② 3'-0" Curb & Gutter Proposed for East Post Rd.
- ③ Refer to East Post Rd. Geometric Sheets for Variable Width Dimensions.
- ④ Refer to Typical Sections 6124 (Modified), 6125 (Modified), 6140 (Modified) and 6142 (Modified) for Additional Information.

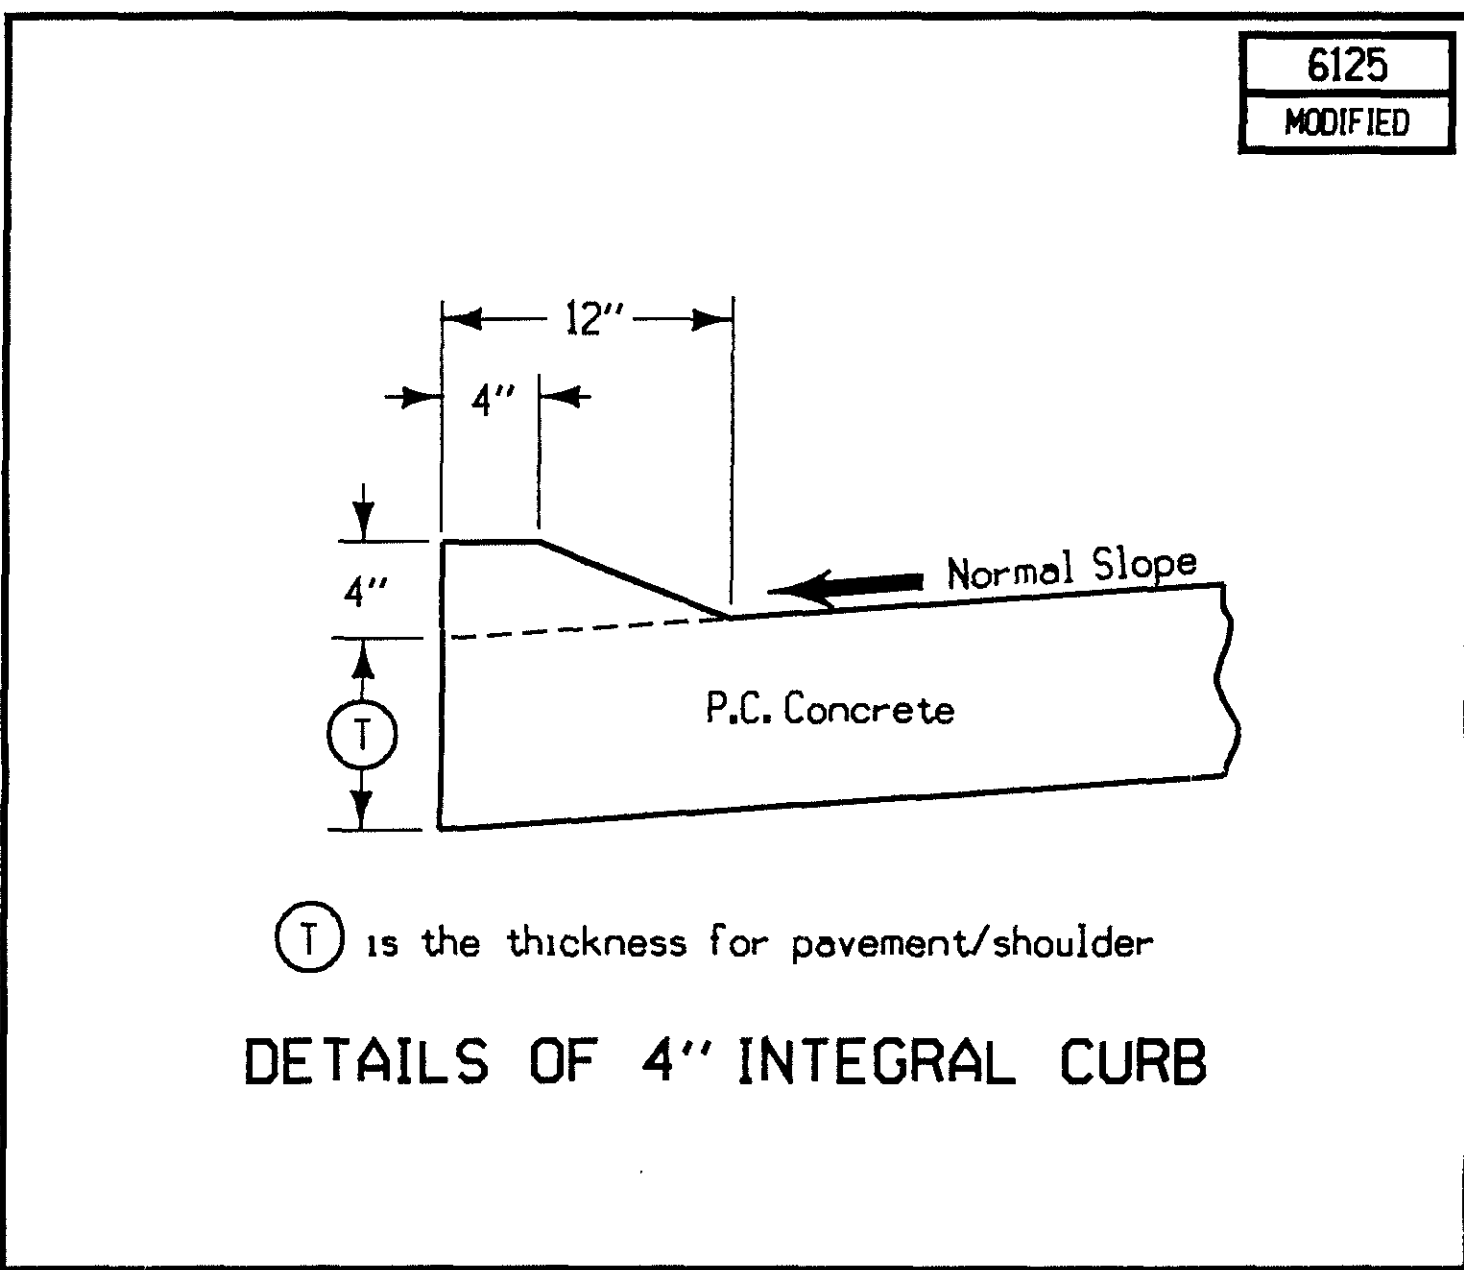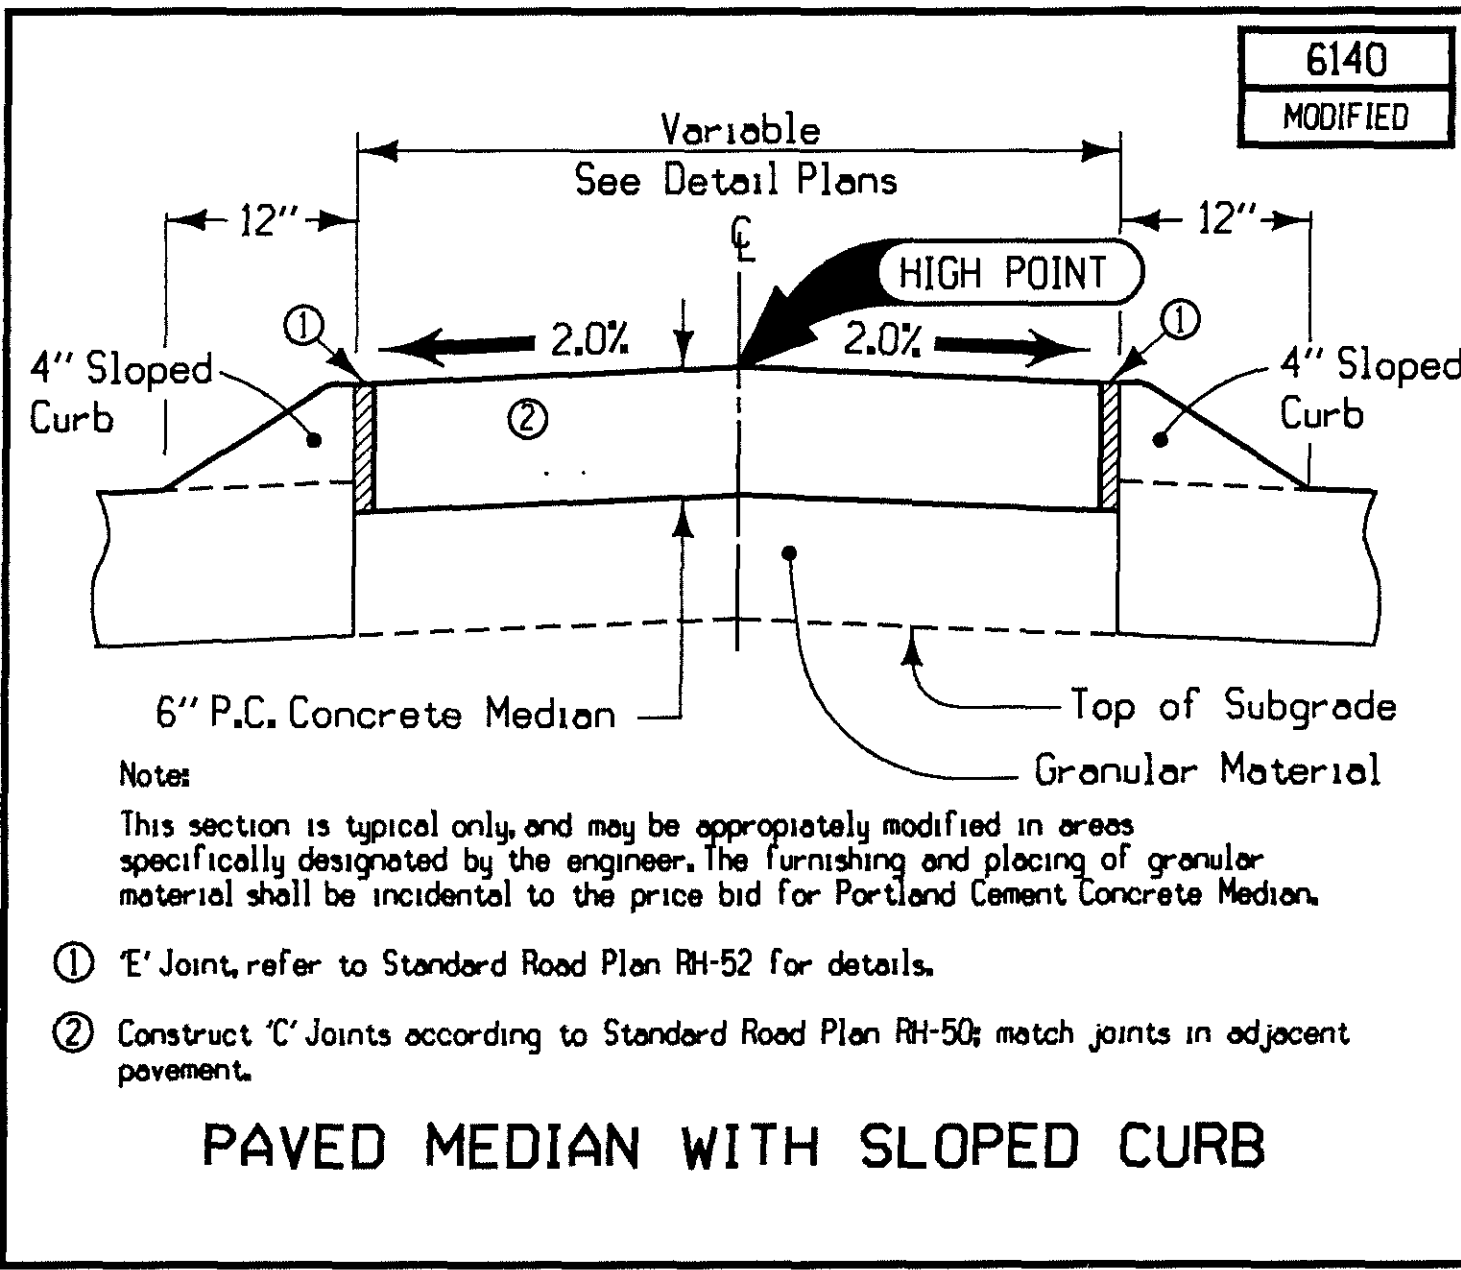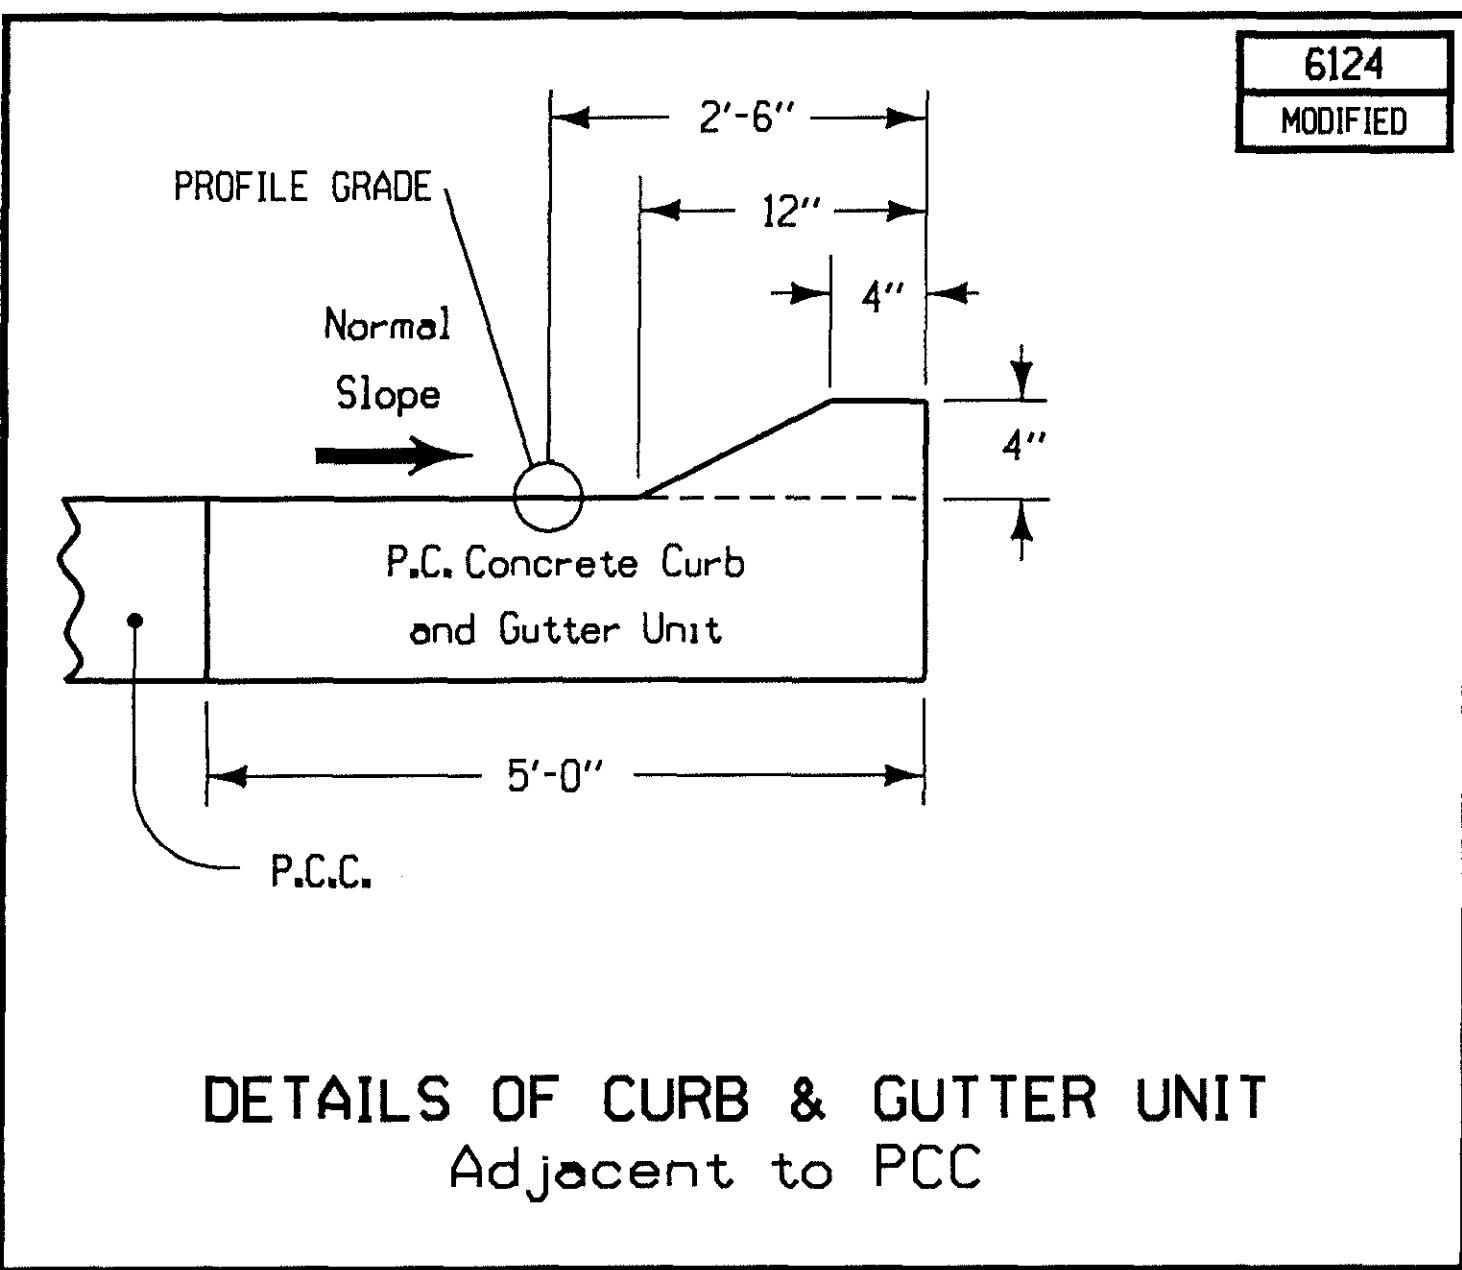








Typical Cross Section of 4 Lane P.C.C. Pavement With
Left Turn Storage Lane and Curbed Median.

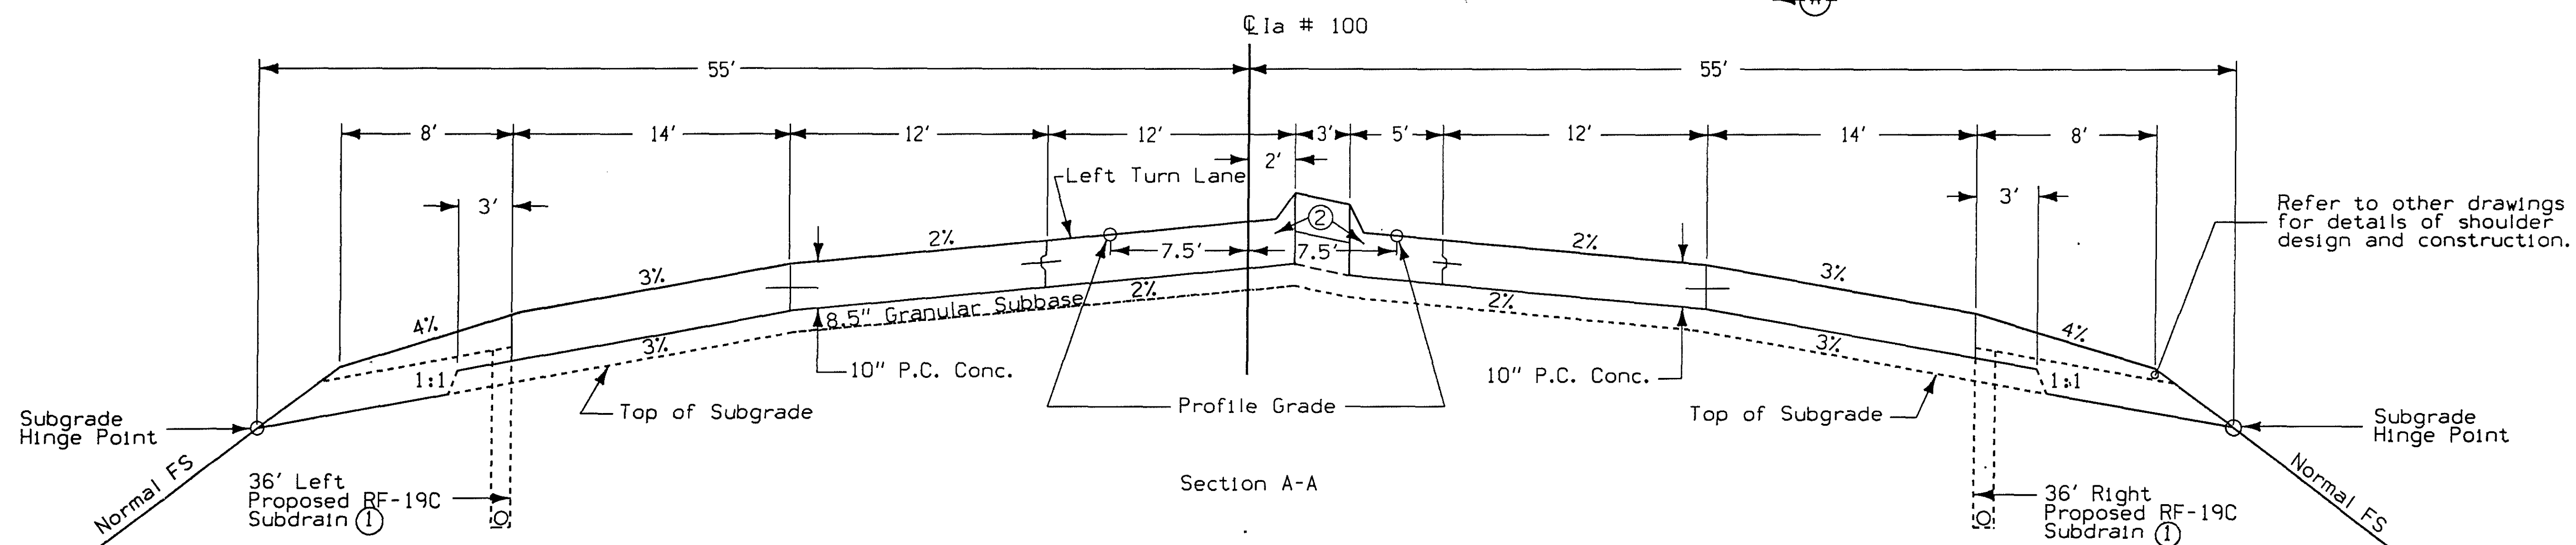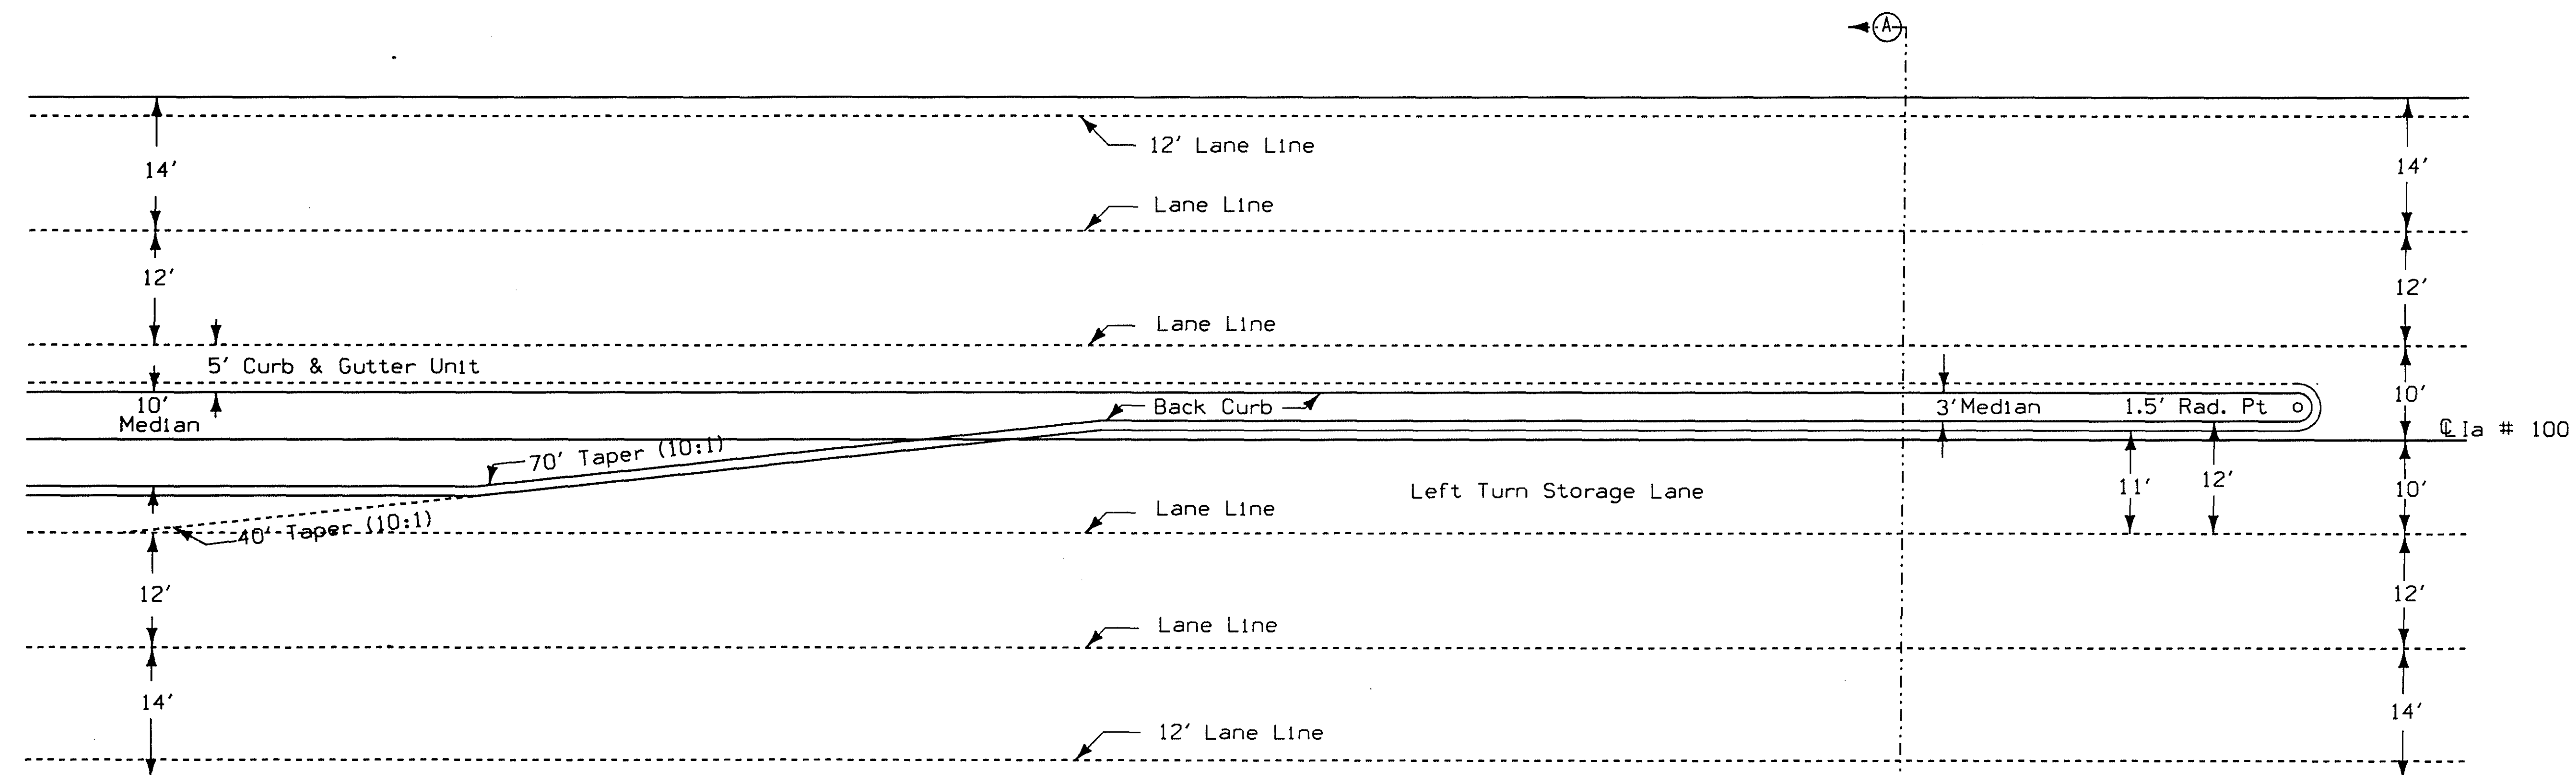


Note: Normal section shown may appropriately modified for areas specifically designed by the engineer such as intersections or superelevated curves.

Note: Refer to appropriate cross sections thru areas of superelevation.

- ① If subdrain is proposed refer to standard Road Plan RF-19C.
- ② Refer to Typical Sections 6124 (Modified), 6125 (Modified), 6140 (Modified) and 6142 (Modified) for Paved Median with 4" Sloped Curb.

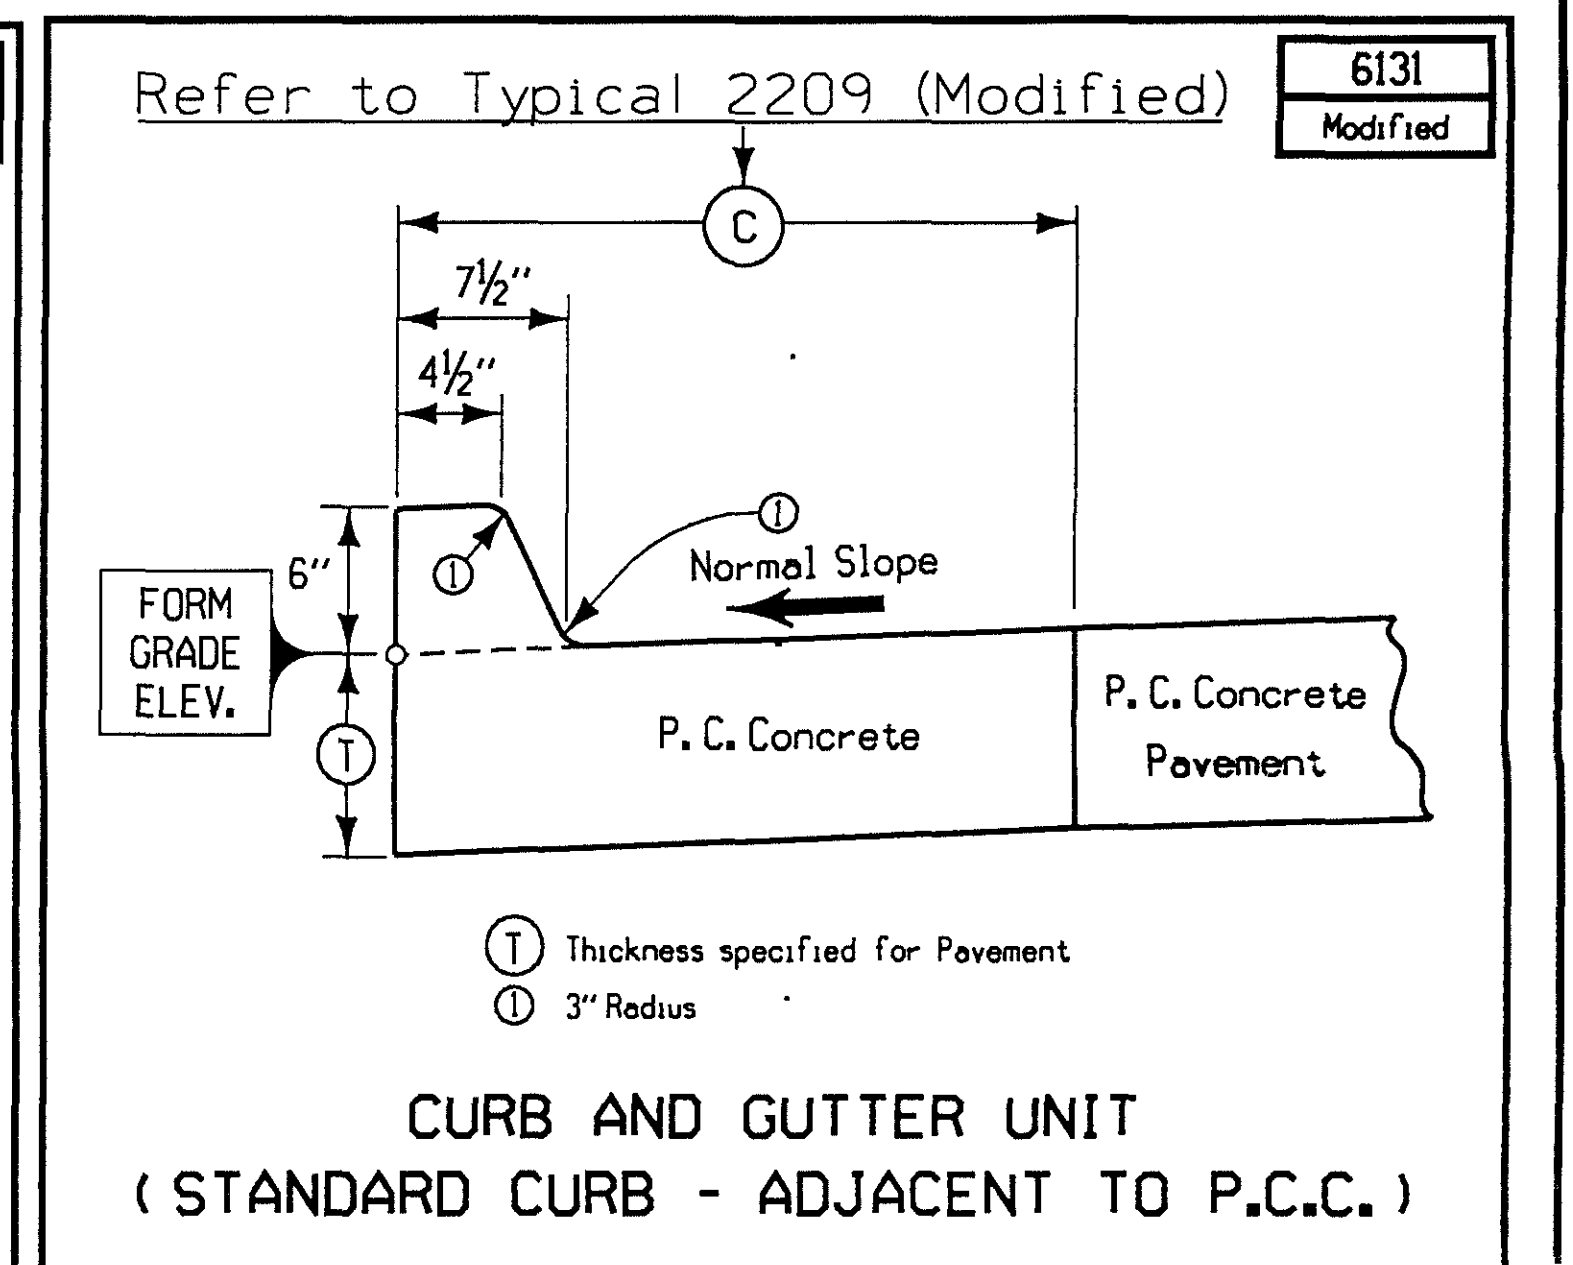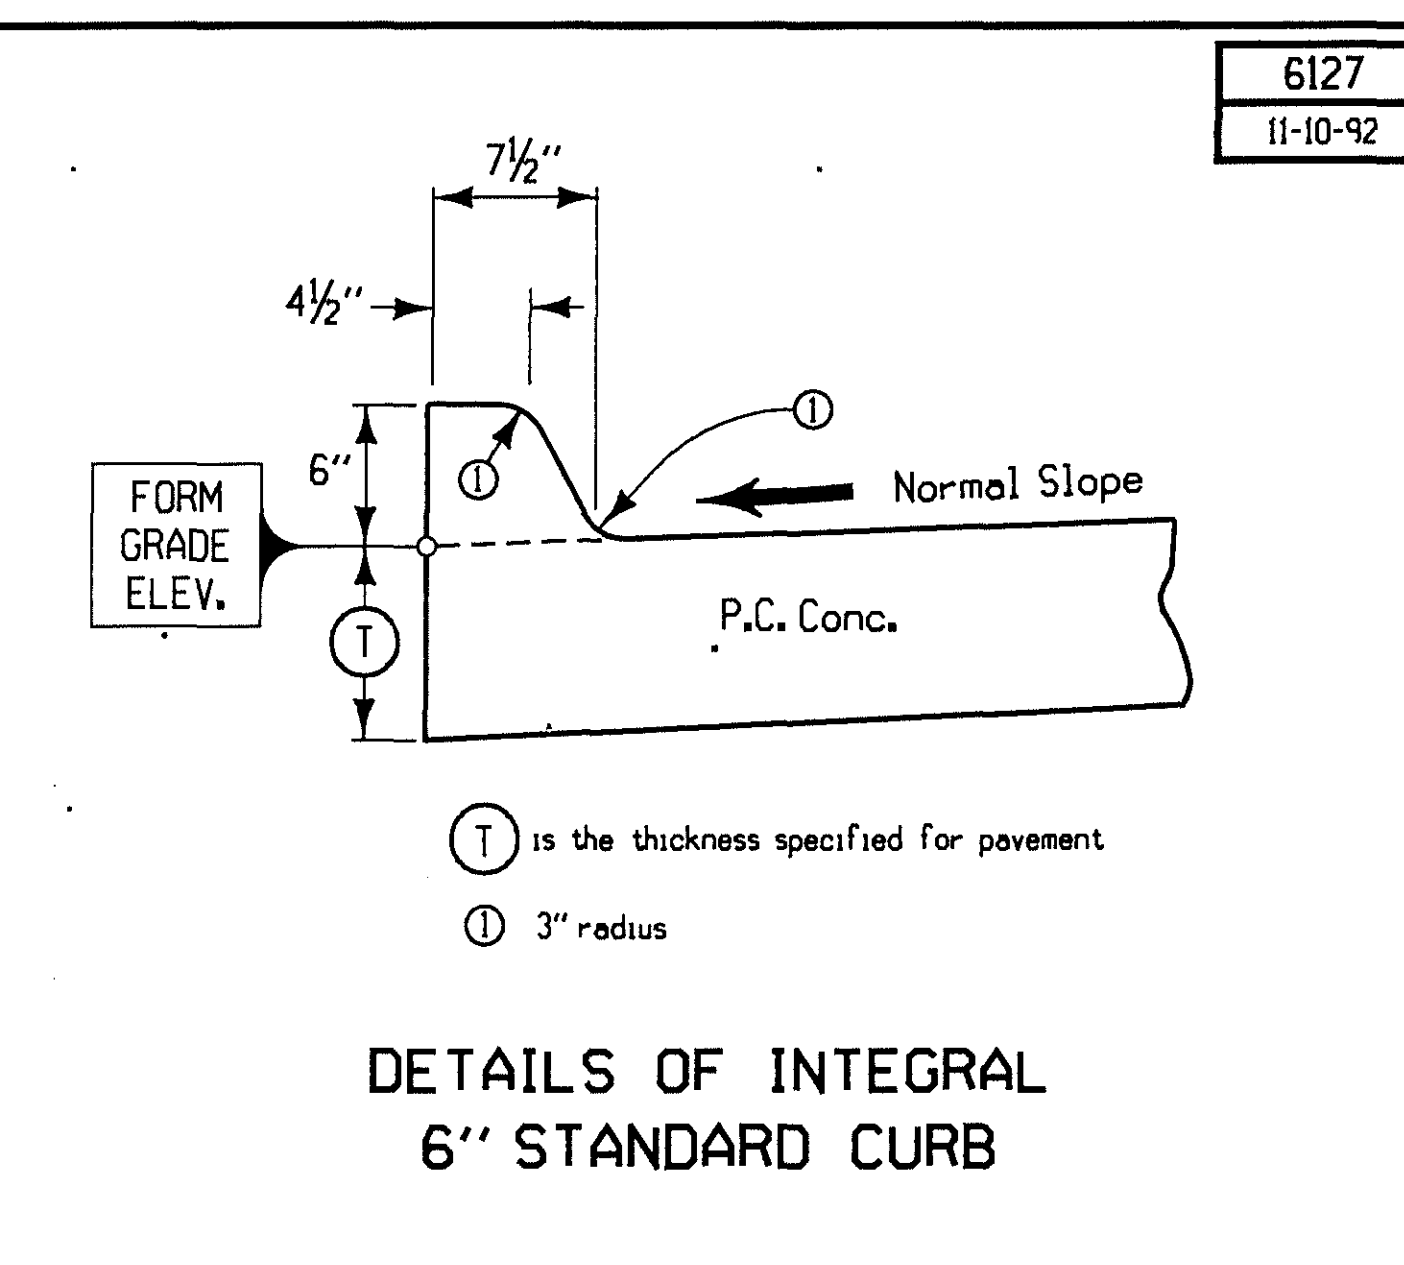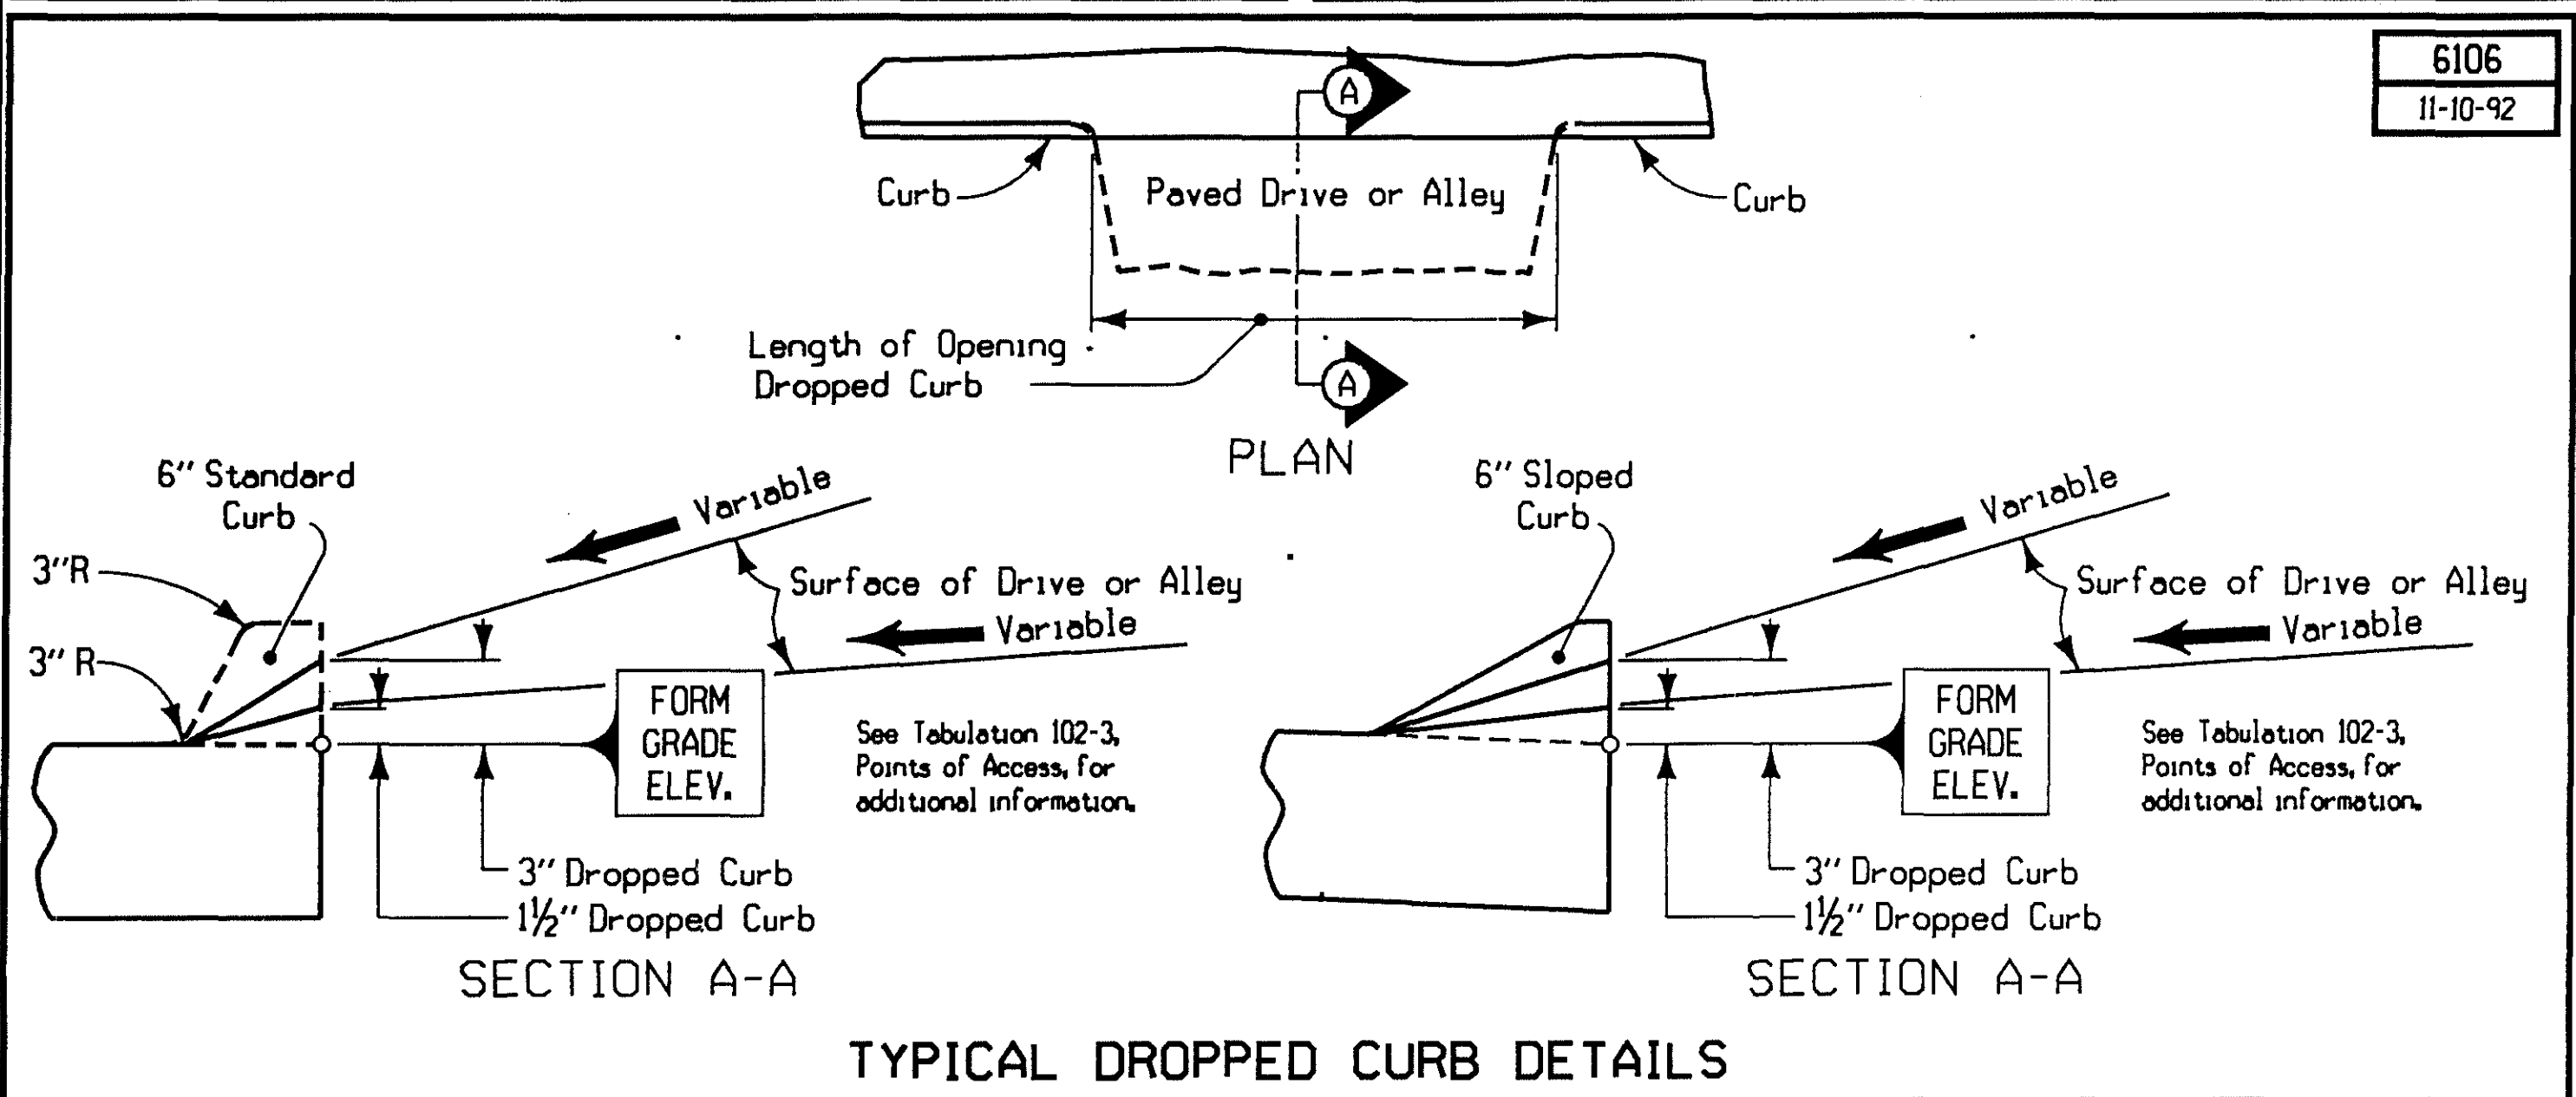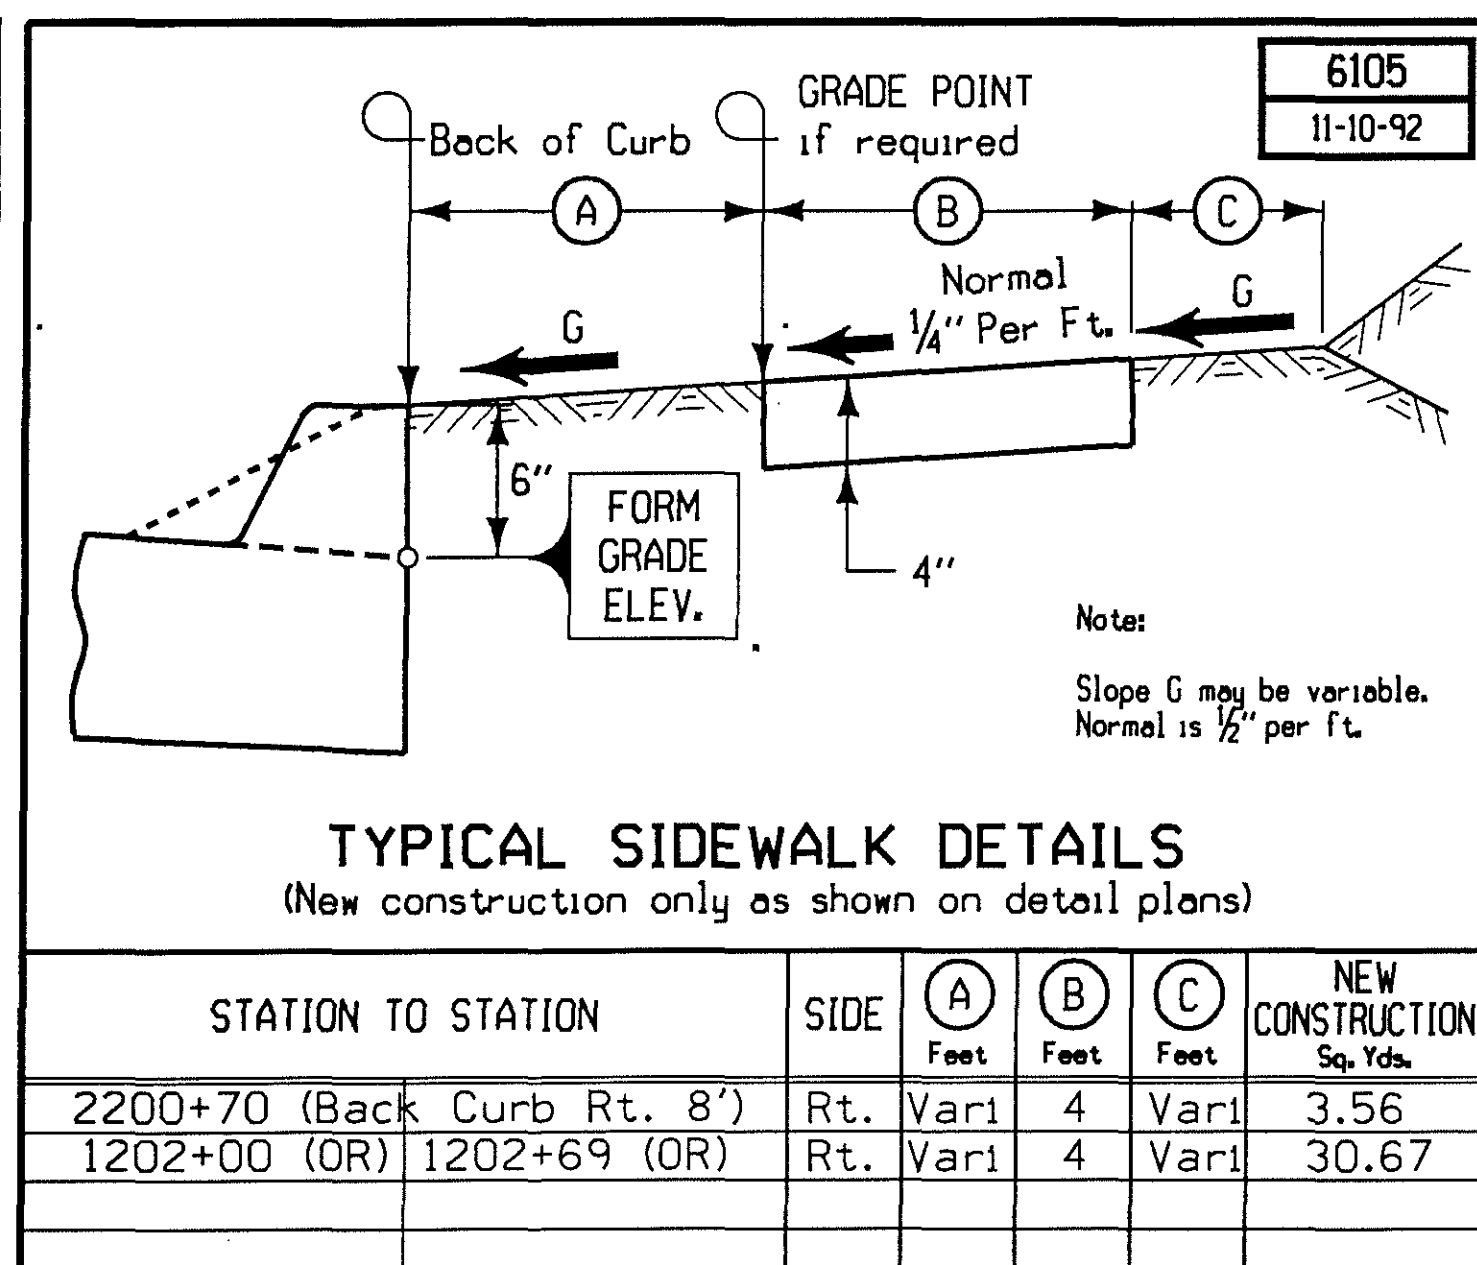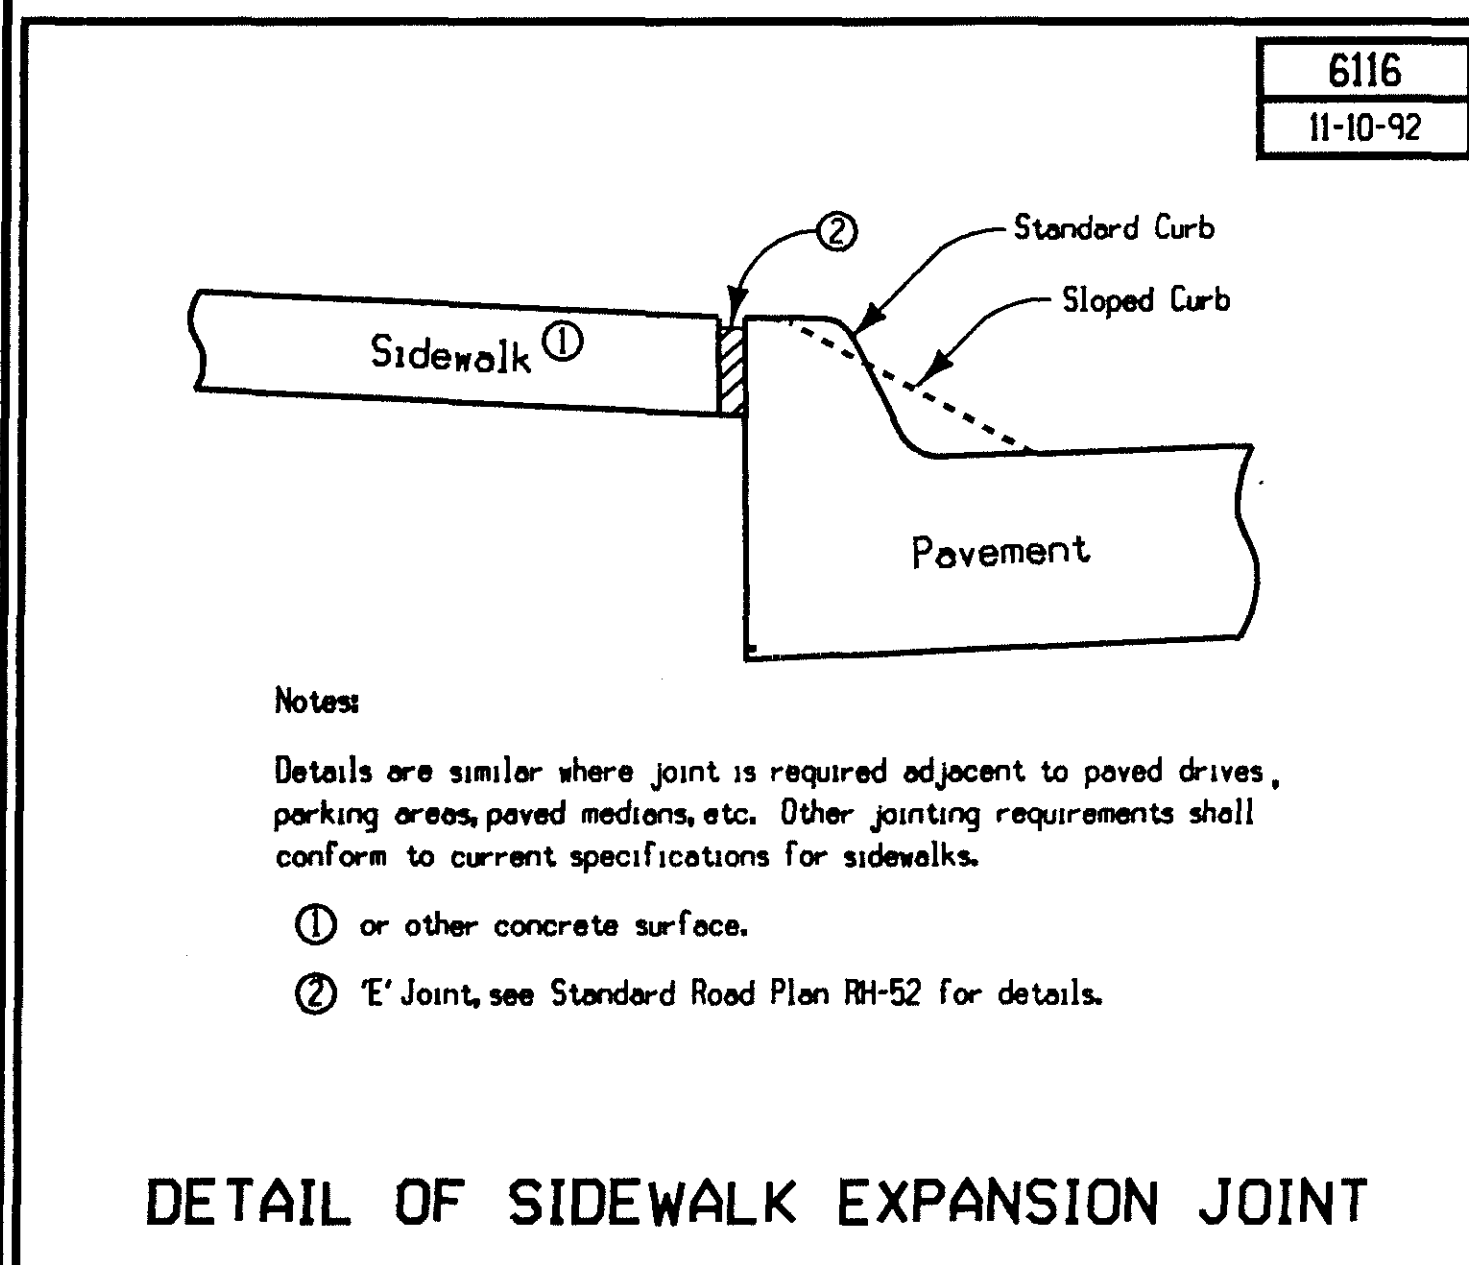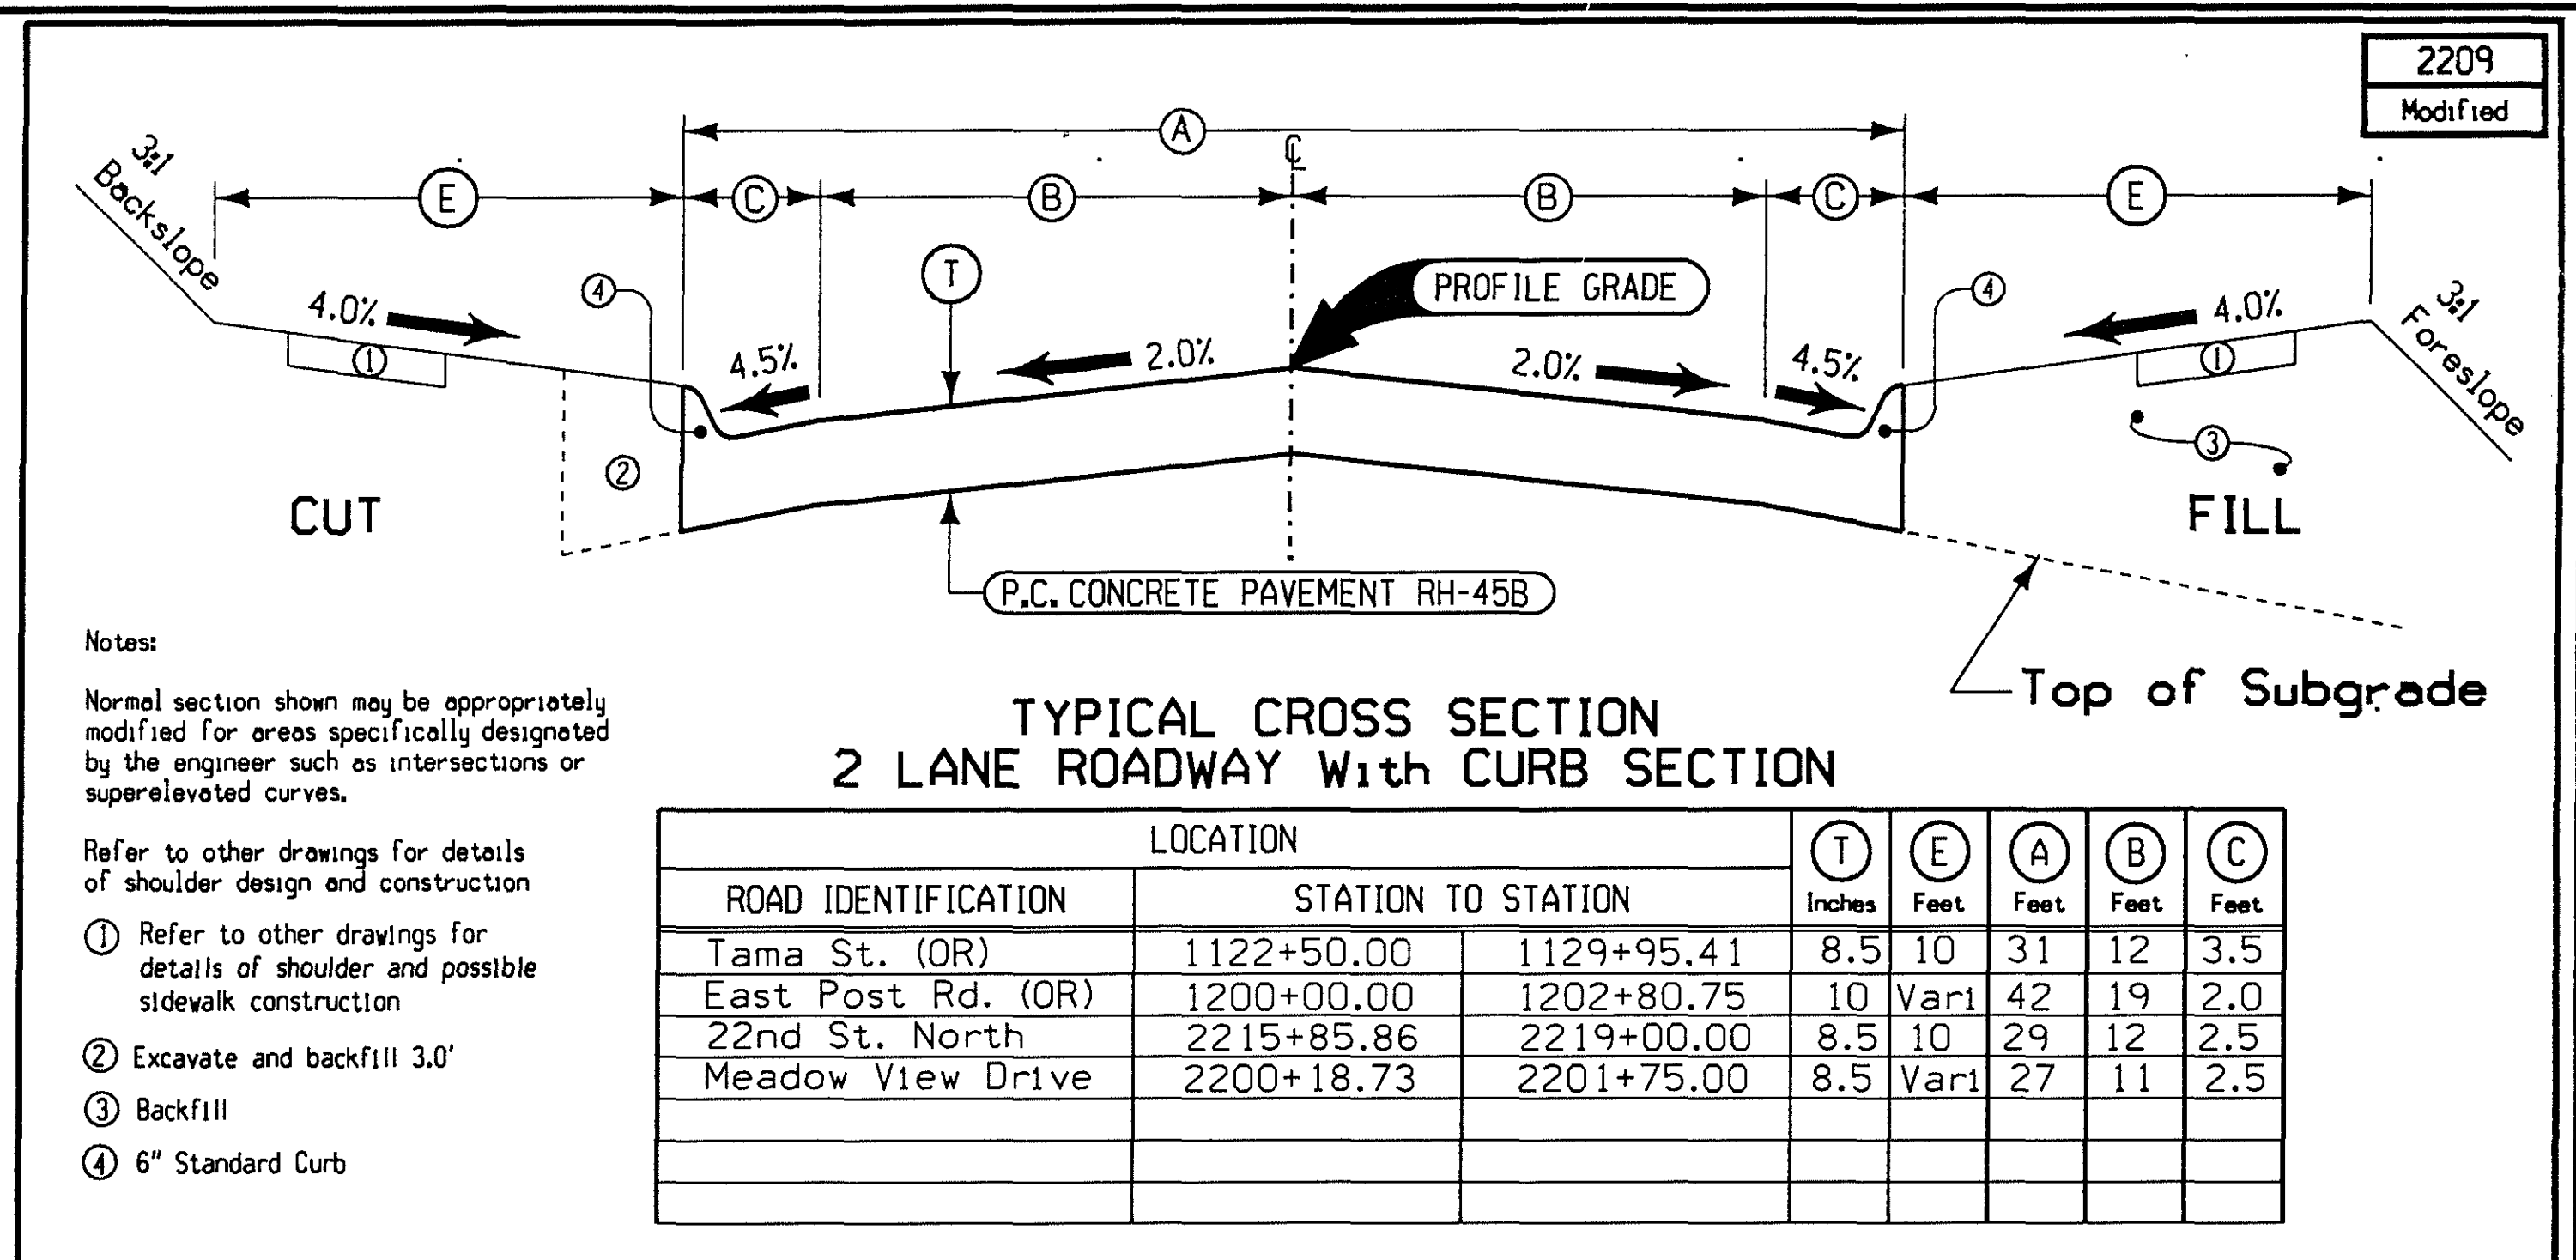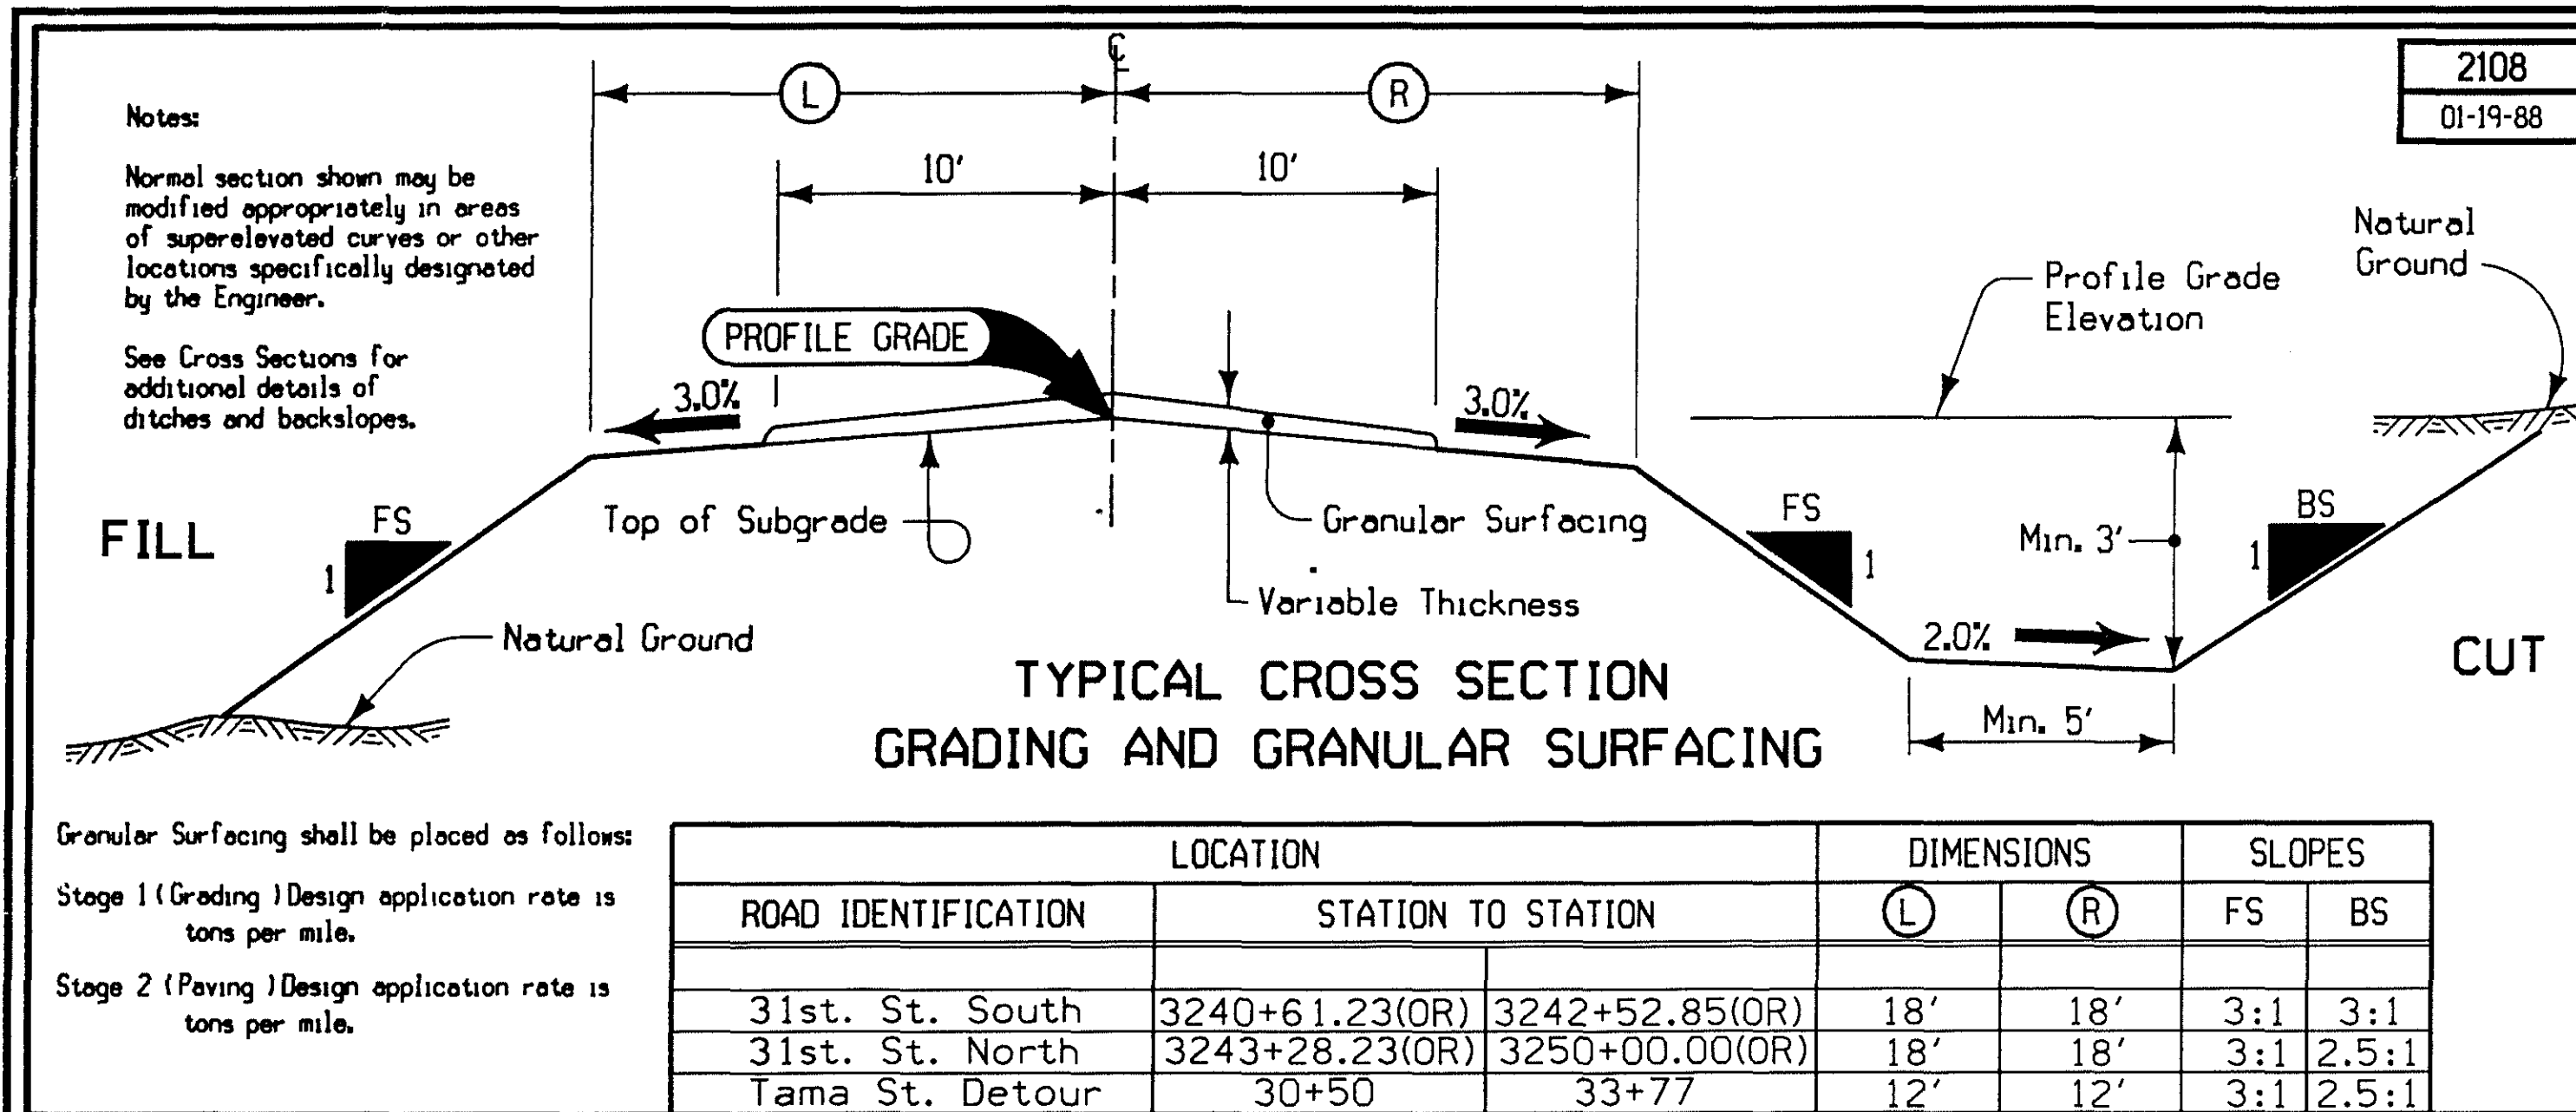



6147
11-10-92

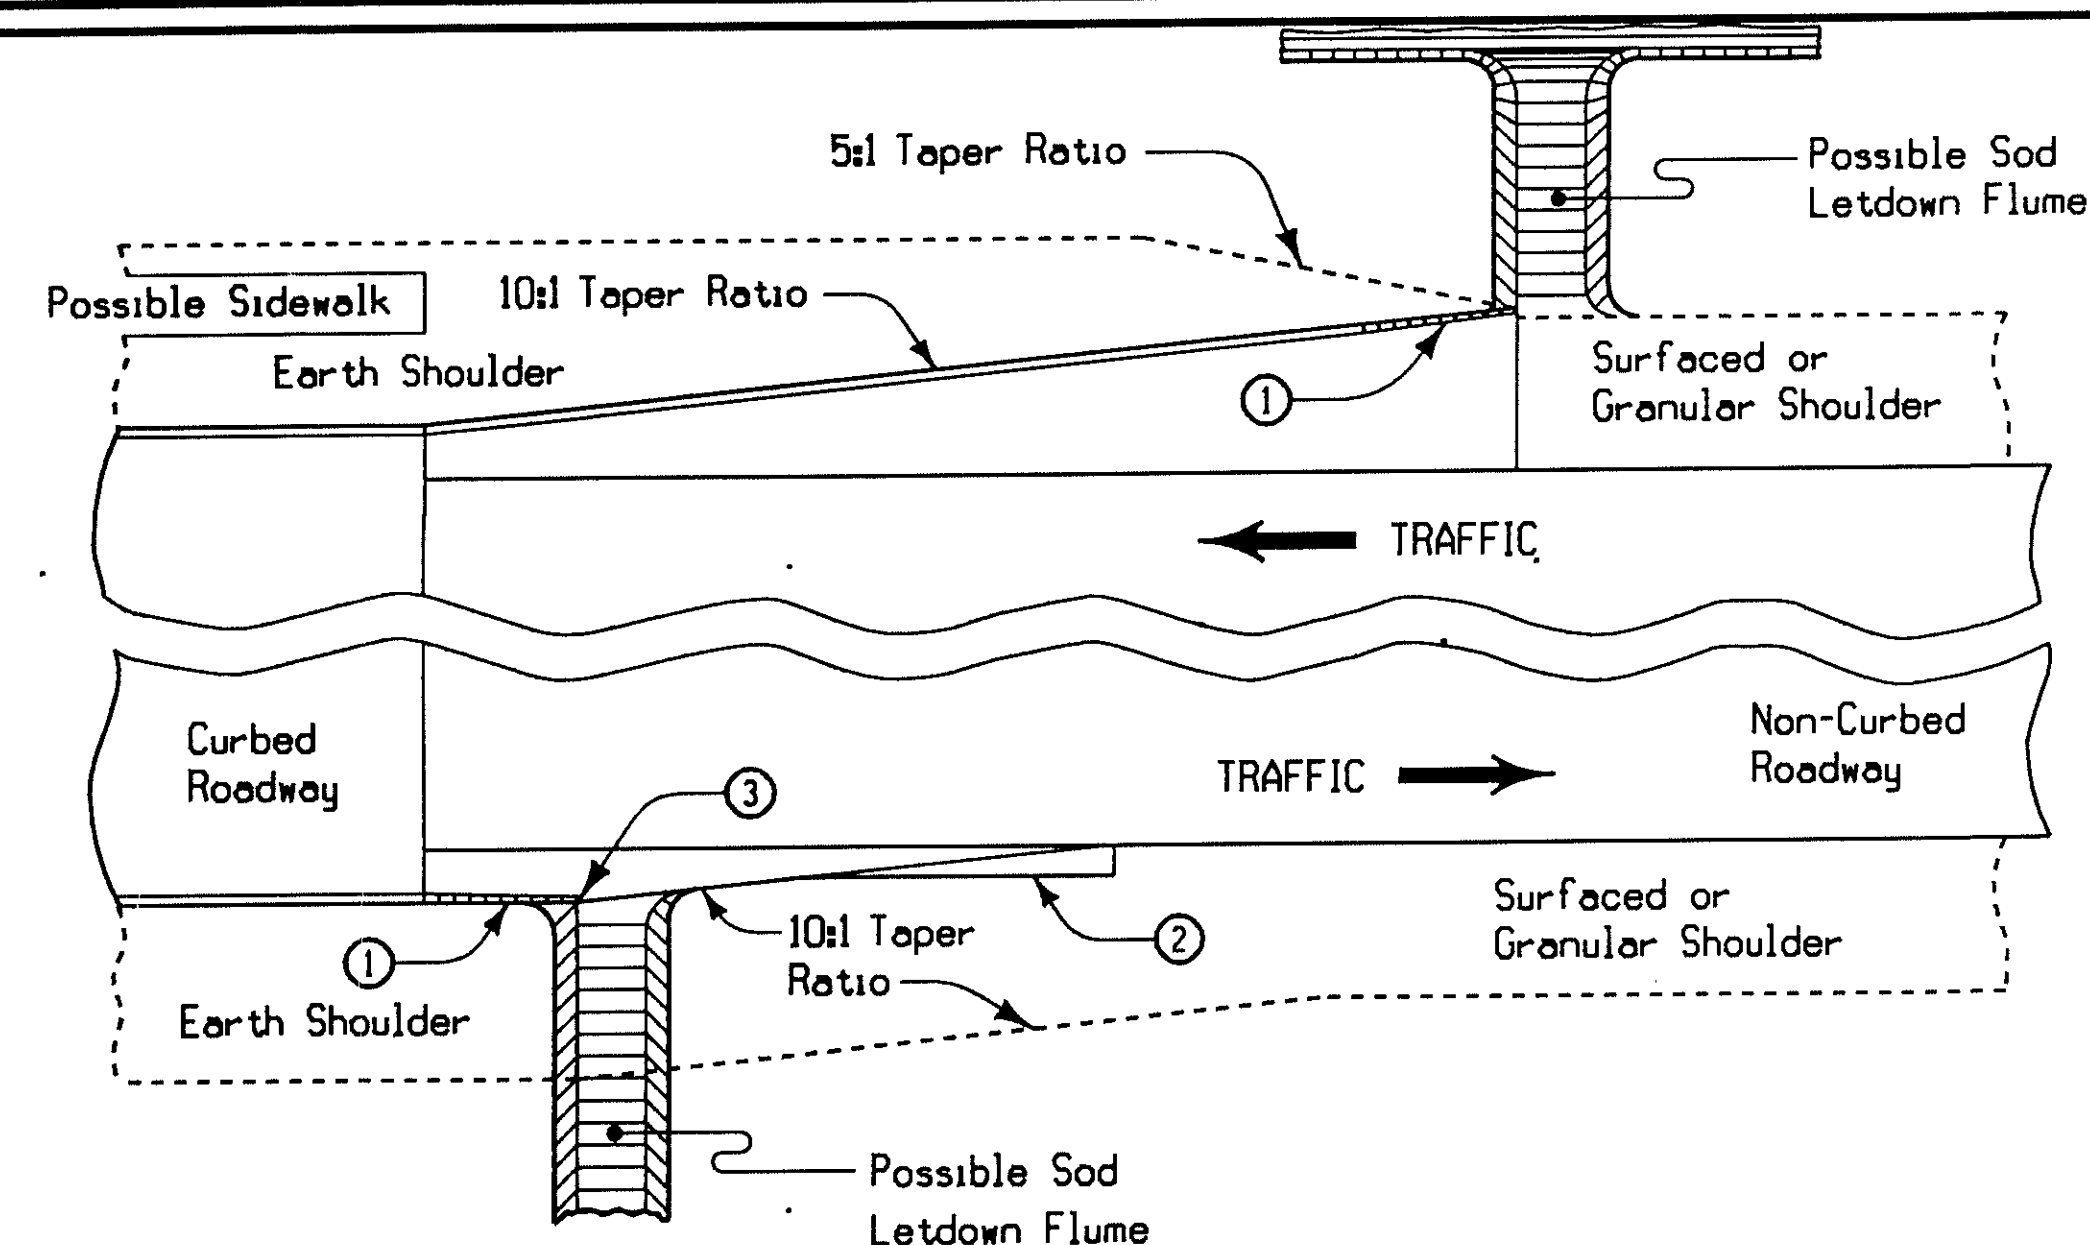

- ① Runout curb in 10.0'
- ② End of Taper Details see Typical Detail 7101
- ③ End earth shoulder at the end of the curb transition when no flume is needed.

TRANSITION
BETWEEN CURBED AND
NON-CURBED ROADWAYS


6148
11-10-92

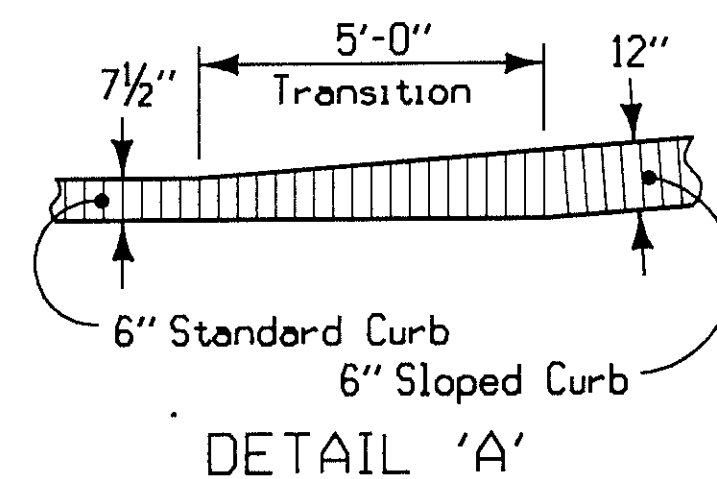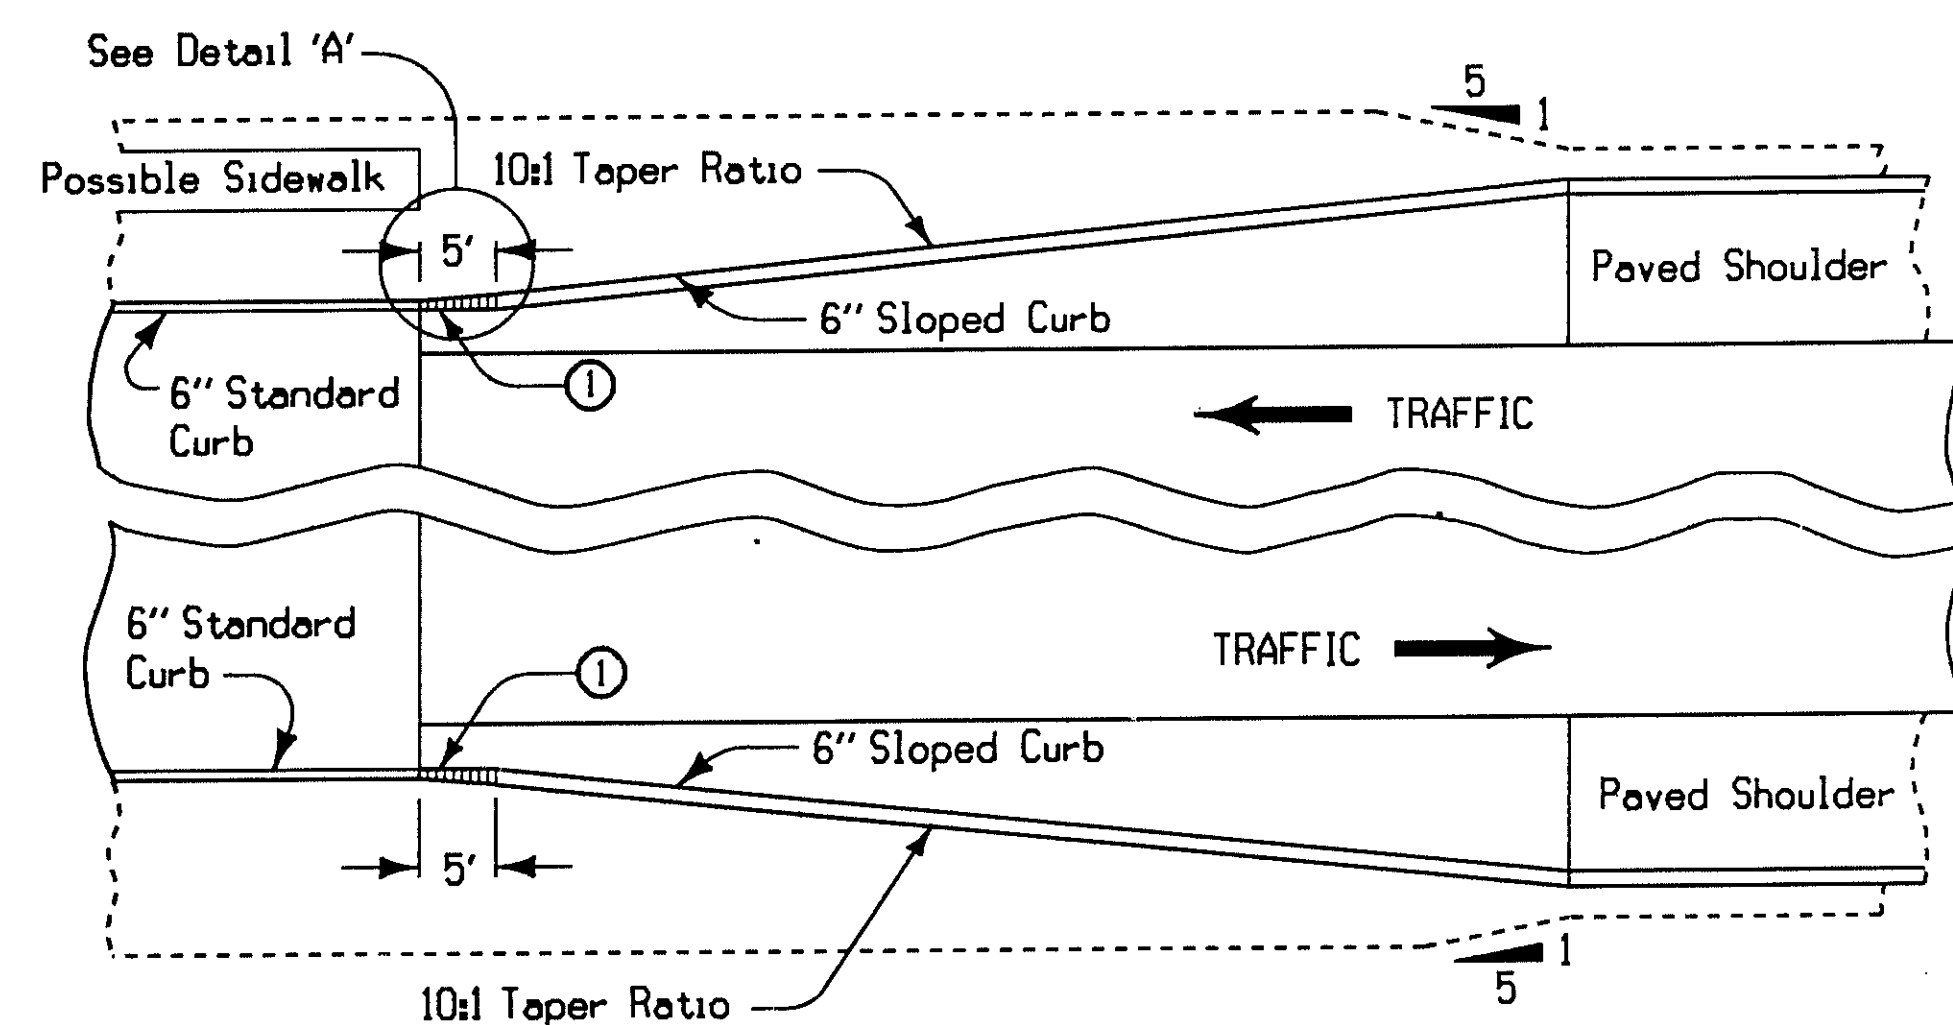

- ① Transition to sloped curb in 5'.


TRANSITION BETWEEN
STANDARD CURB AND
SLOPED CURB ON SHOULDER

7101
08-08-89

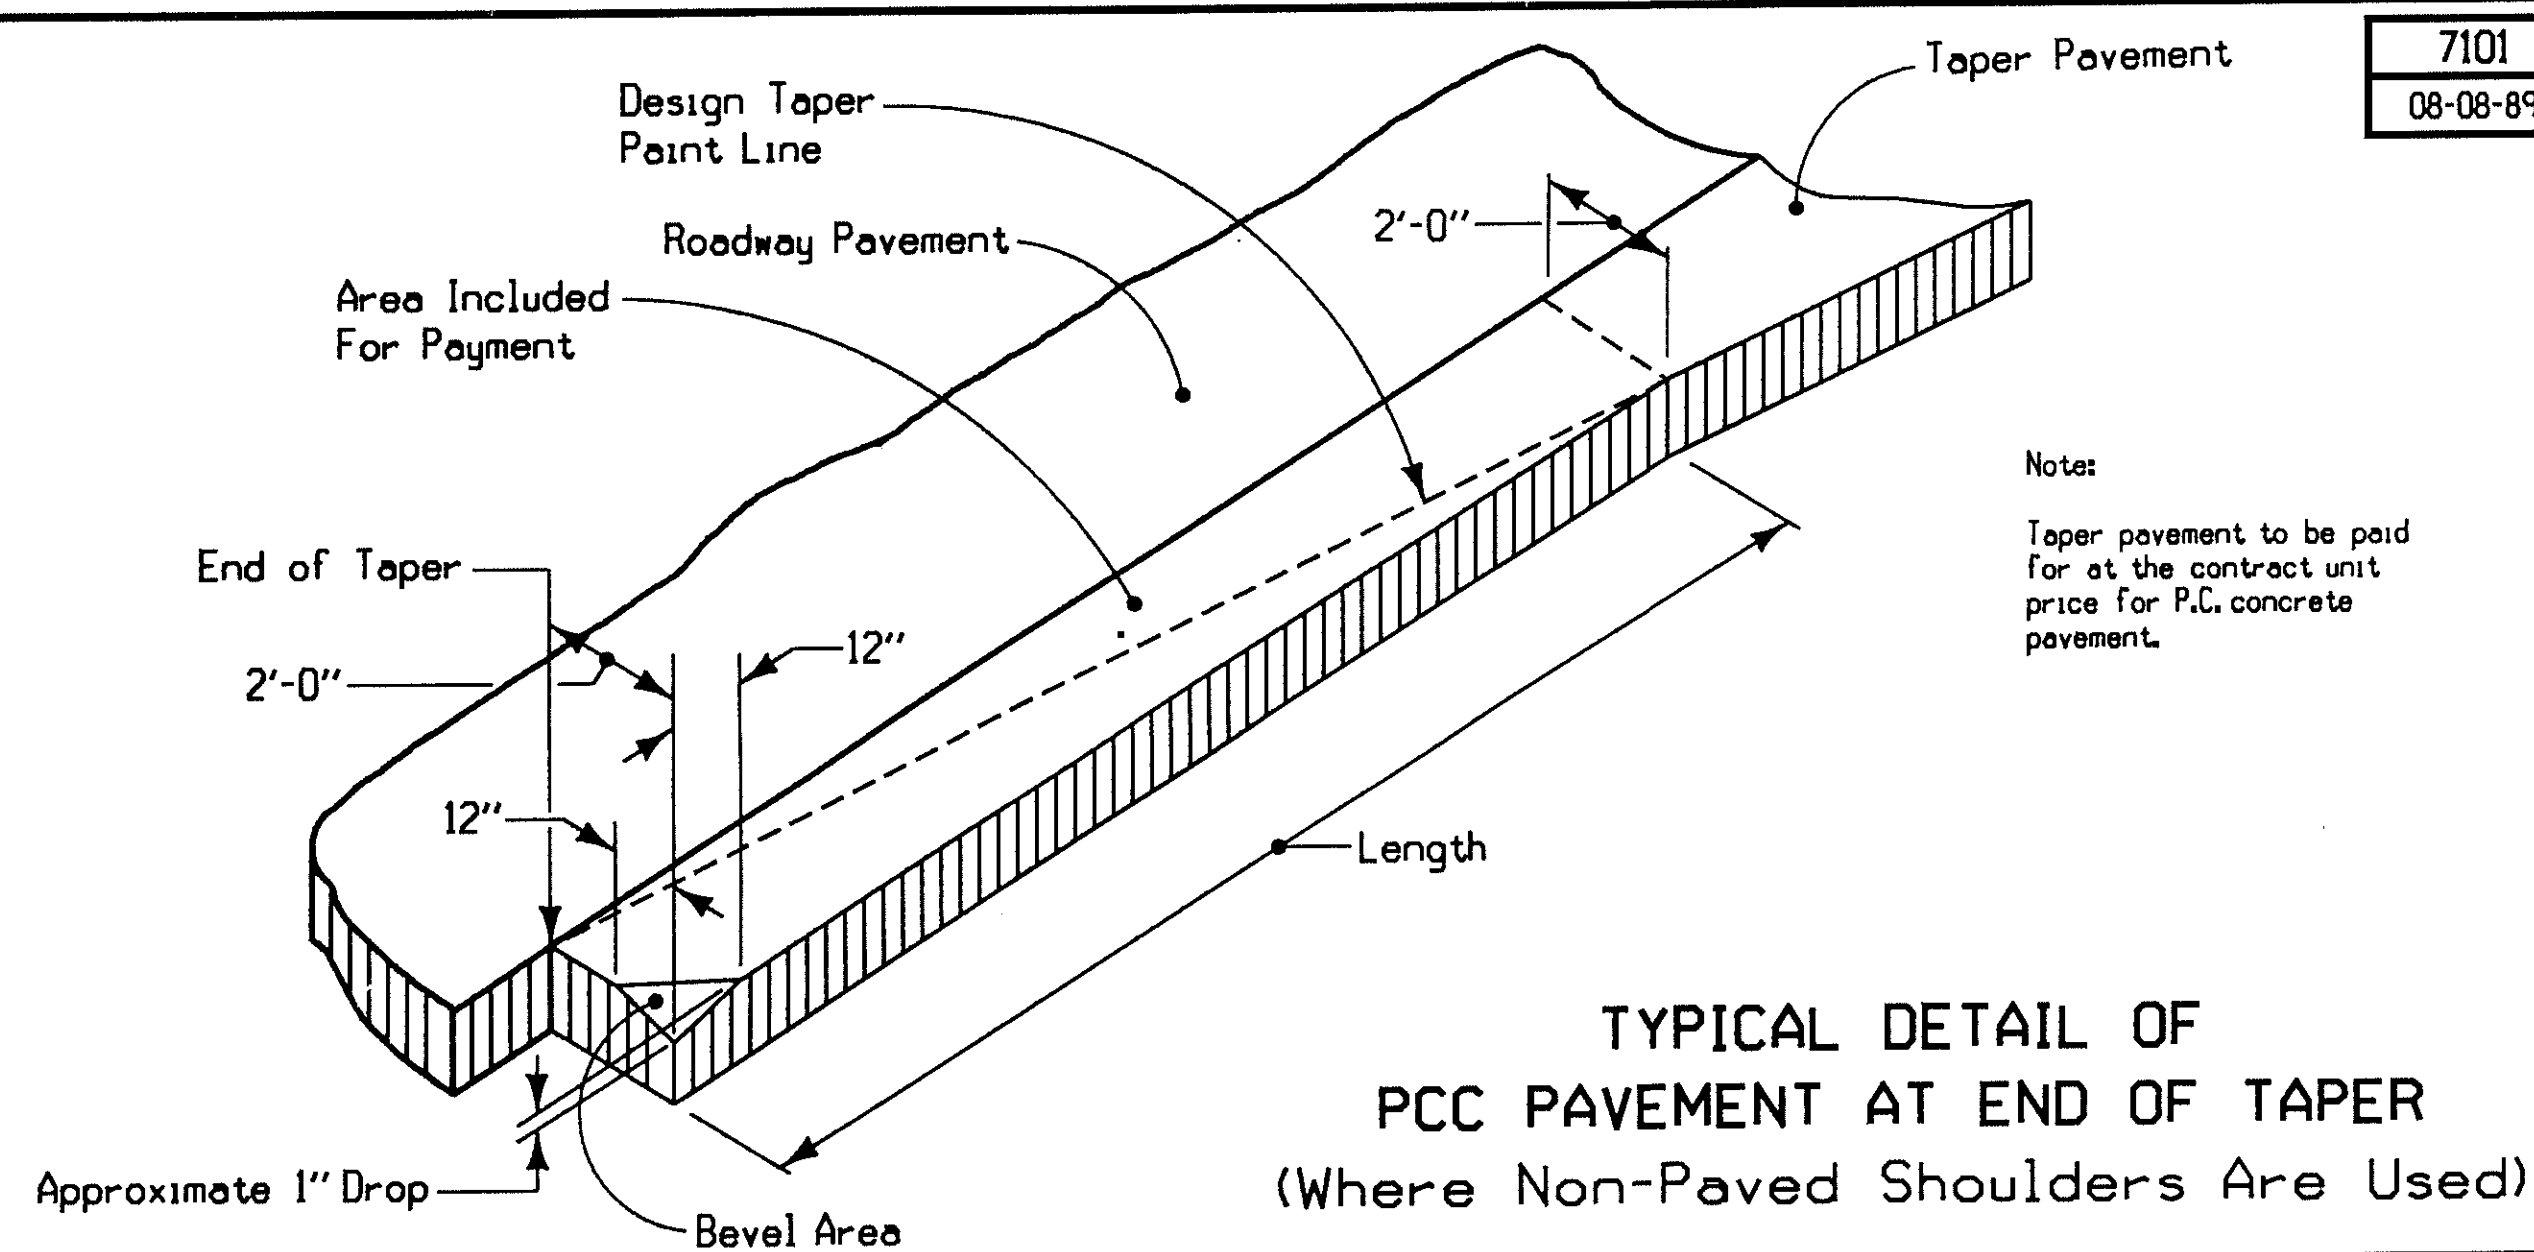

TYPICAL DETAIL OF
PCC PAVEMENT AT END OF TAPER
(Where Non-Paved Shoulders Are Used)

7110
07-16-91

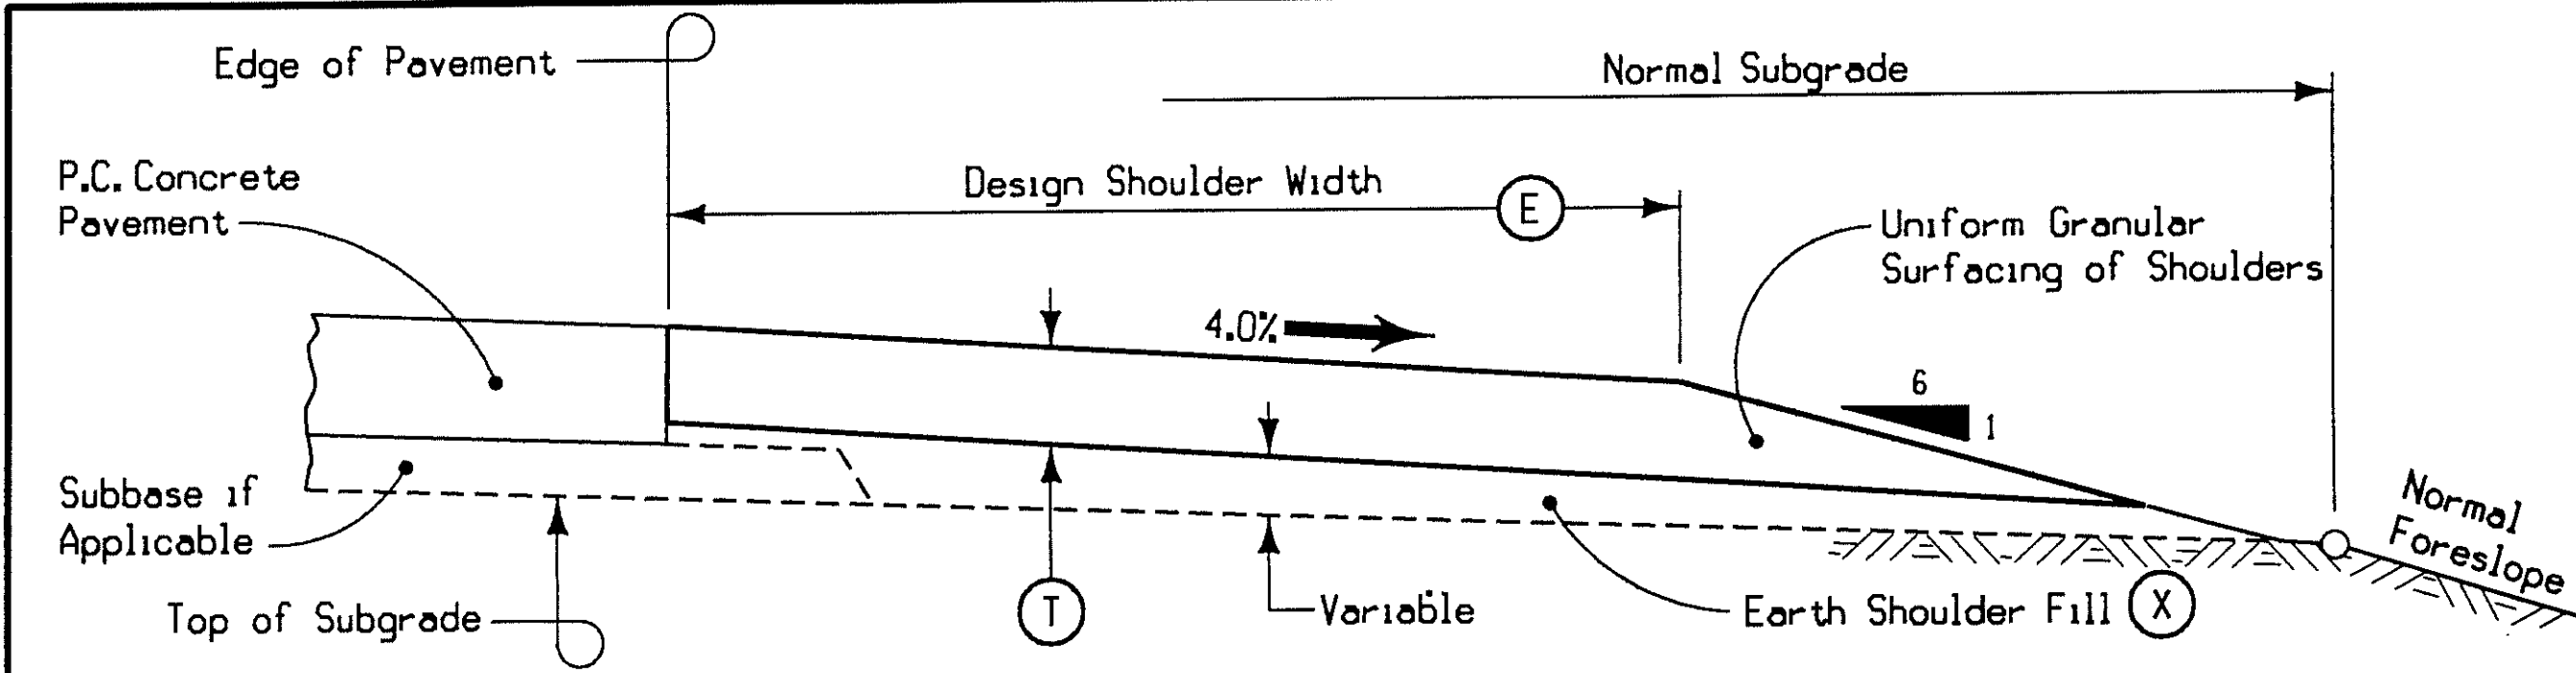

TYPICAL SECTION
TYPE 'A' GRANULAR SHOULDER
Adjacent to PCC Pavement


- ① Refer to Typical 7127 for areas of proposed Paved Shoulders on left.

Notes:
Earth Shoulder fill requires approximately ② cubic yards of excavation, including 60% for shrinkage, per station.

ROAD IDENTIFICATION	LOCATION		STATION TO STATION ①		SIDE	②
			Feet	Inches		
Ia# 100	116+63.38	306+00.00	8	6	Both	72.7
East Post Road	1174+00.00	1200+00.00	10	6	Both	80.1
Munier Road	4281+04.08	4287+00.00	6	6	Both	6.2
22nd St. South	2211+50.00	2215+11.91	6	6	Both	6.2

See Standard Road Plan RH-370 for construction requirements.

7127
06-07-94

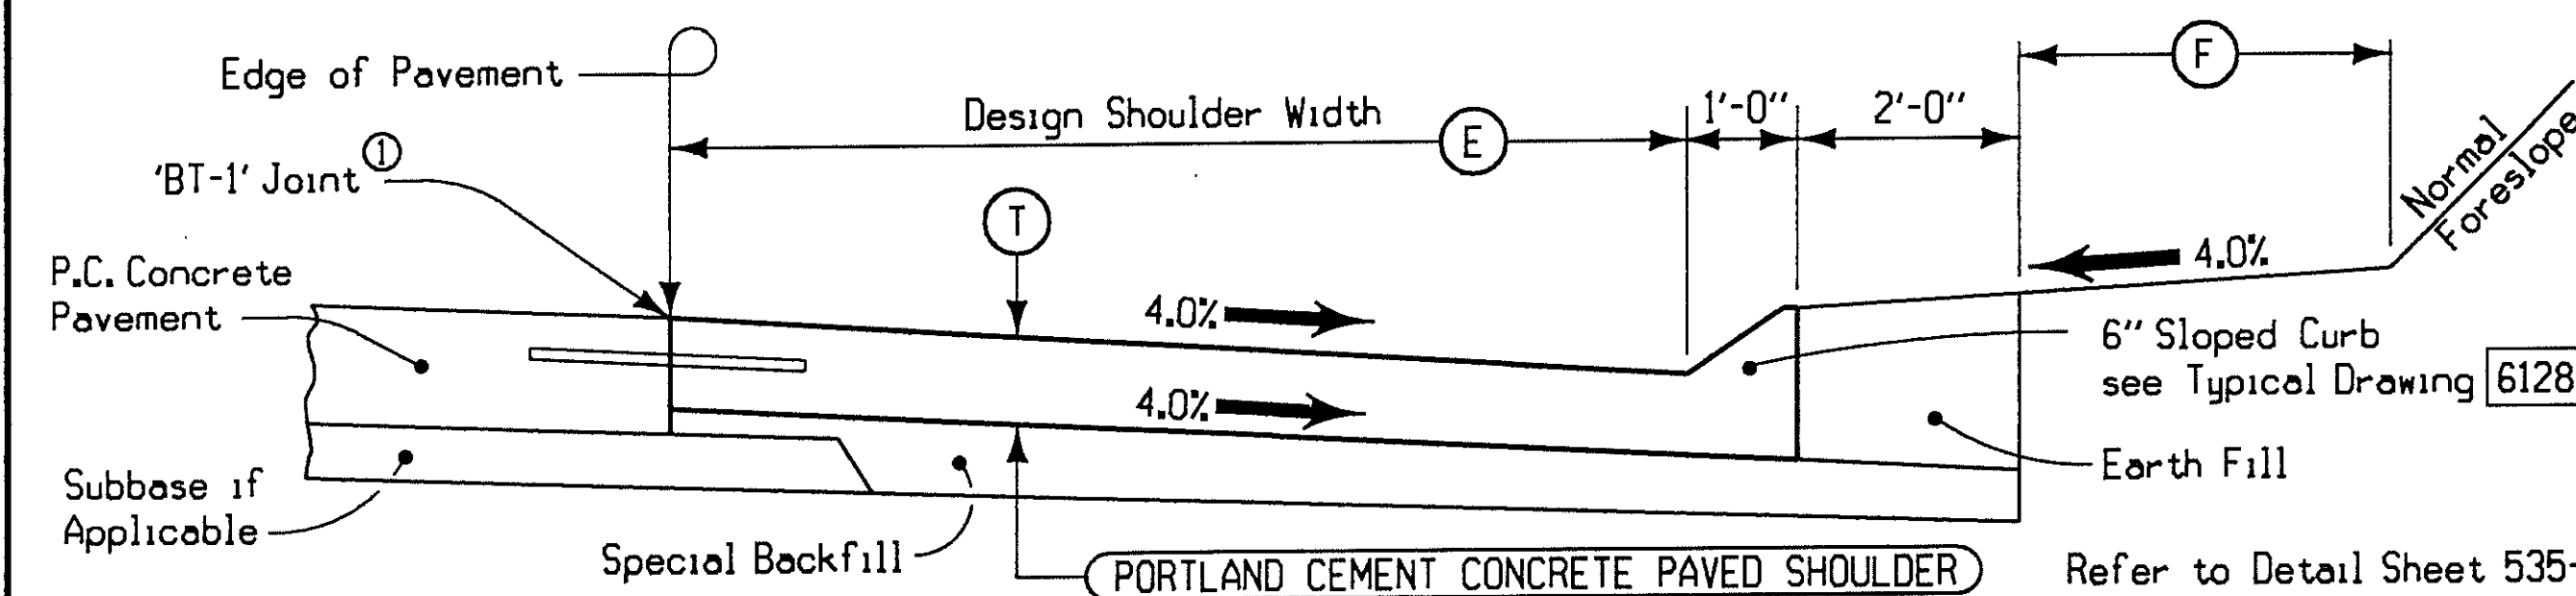


TYPICAL SECTION
PCC PAVED SHOULDER WITH SLOPED CURB

Refer to Detail Sheet 535-1

LOCATION				DIMENSIONS			QUANTITIES ②		
ROAD IDENTIFICATION	STATION TO STATION		SIDE	T	E	F	SURFACE AREA ③ Sq. Yds.	VOLUME Cu. Yds.	SPECIAL ③ BACKFILL Tons
				Inches	Feet	Feet			
Ia# 100	116+63.38	133+00.00	Lt.	7	8	10	100	20.495	53.64
Ia# 100	203+00.00	215+10.01	Lt.	7	8	10	100	20.495	53.64


- Notes:
- ① See Standard Road Plan RH-51.
 - ② Per Station Per Side.
 - ③ Bid Items

6128
11-10-92

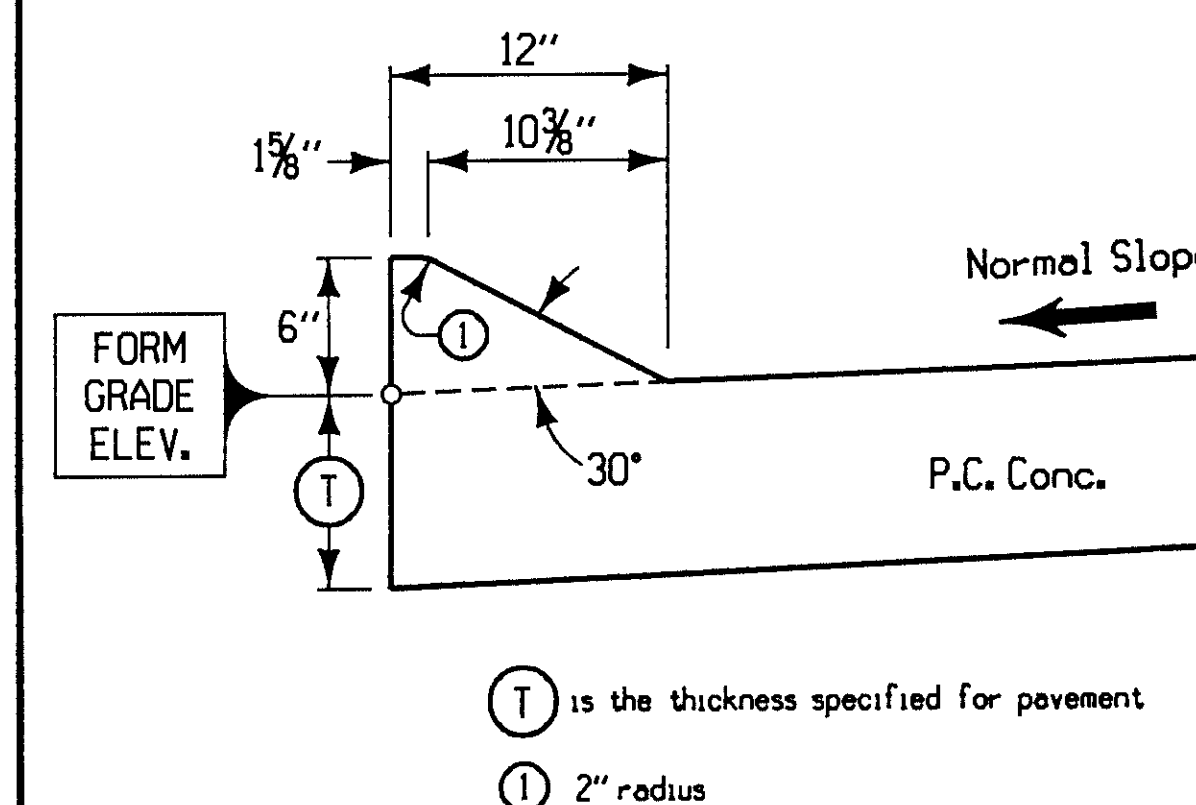


- ① is the thickness specified for pavement
- ② 2" radius

DETAILS OF INTEGRAL
6" SLOPED CURB

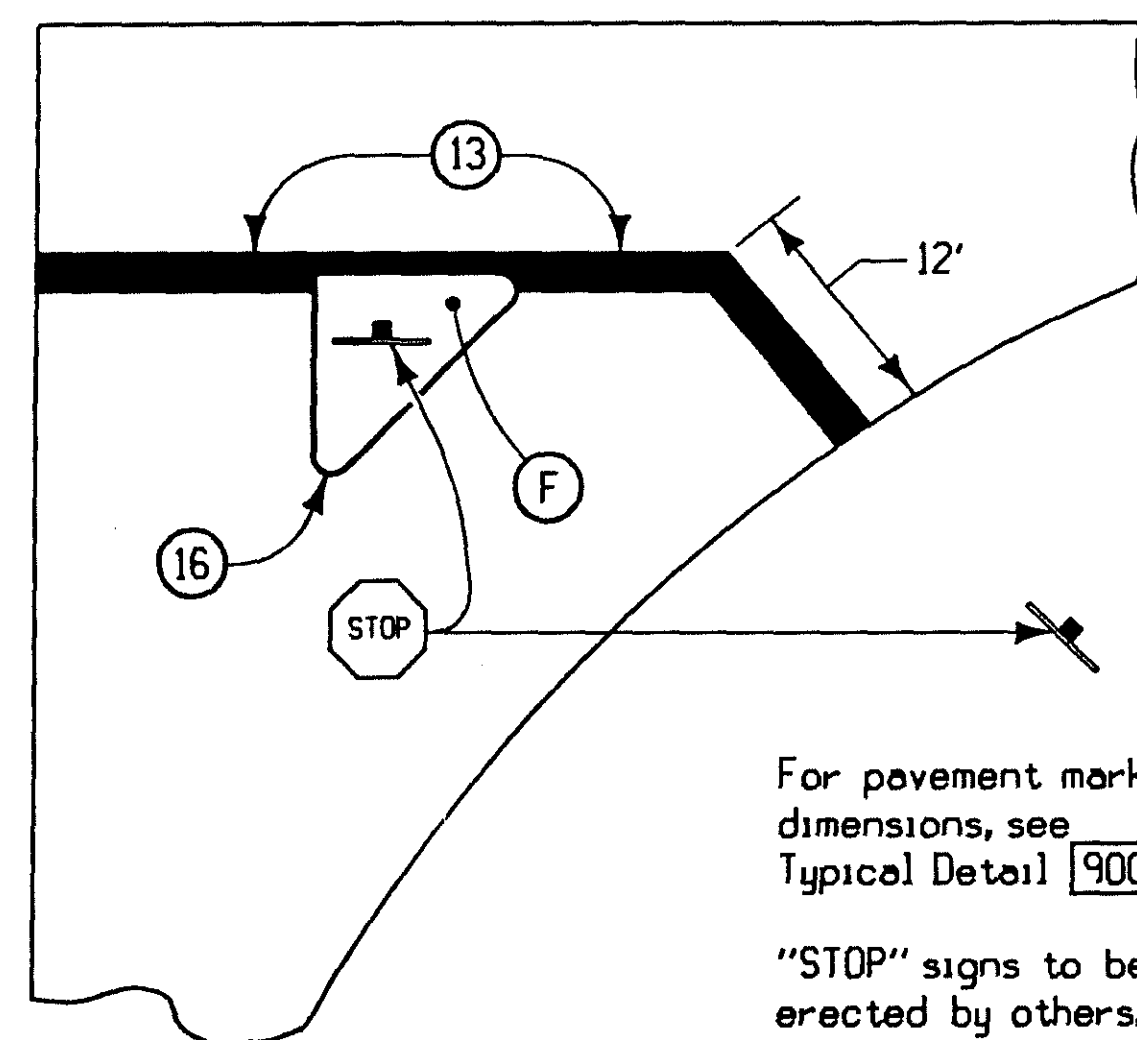


CURBED ISLAND

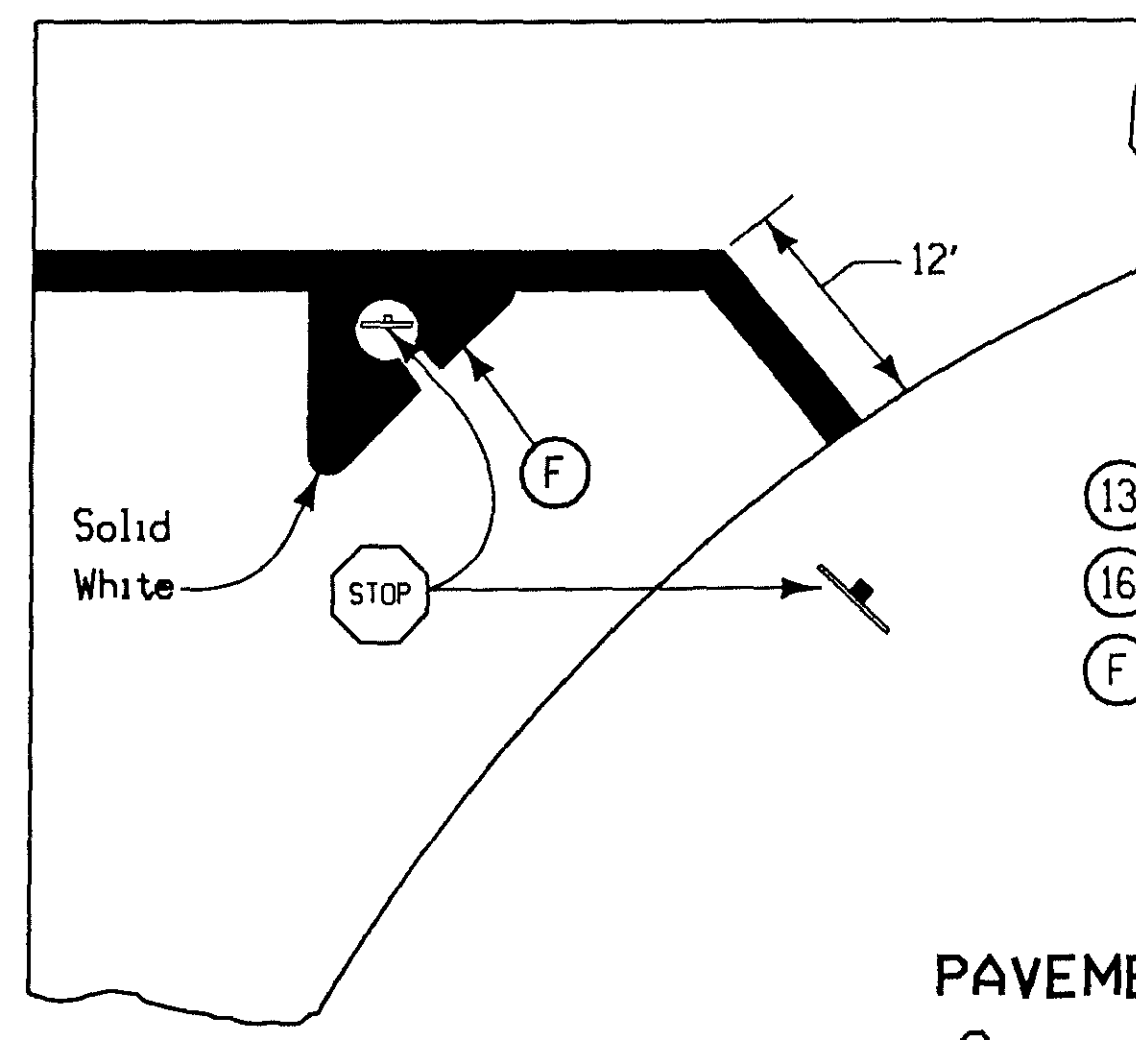

LOW RISE ISLAND

PAVEMENT MARKINGS
Stop Sign Islands
and Stop Lines

9501
10-08-91

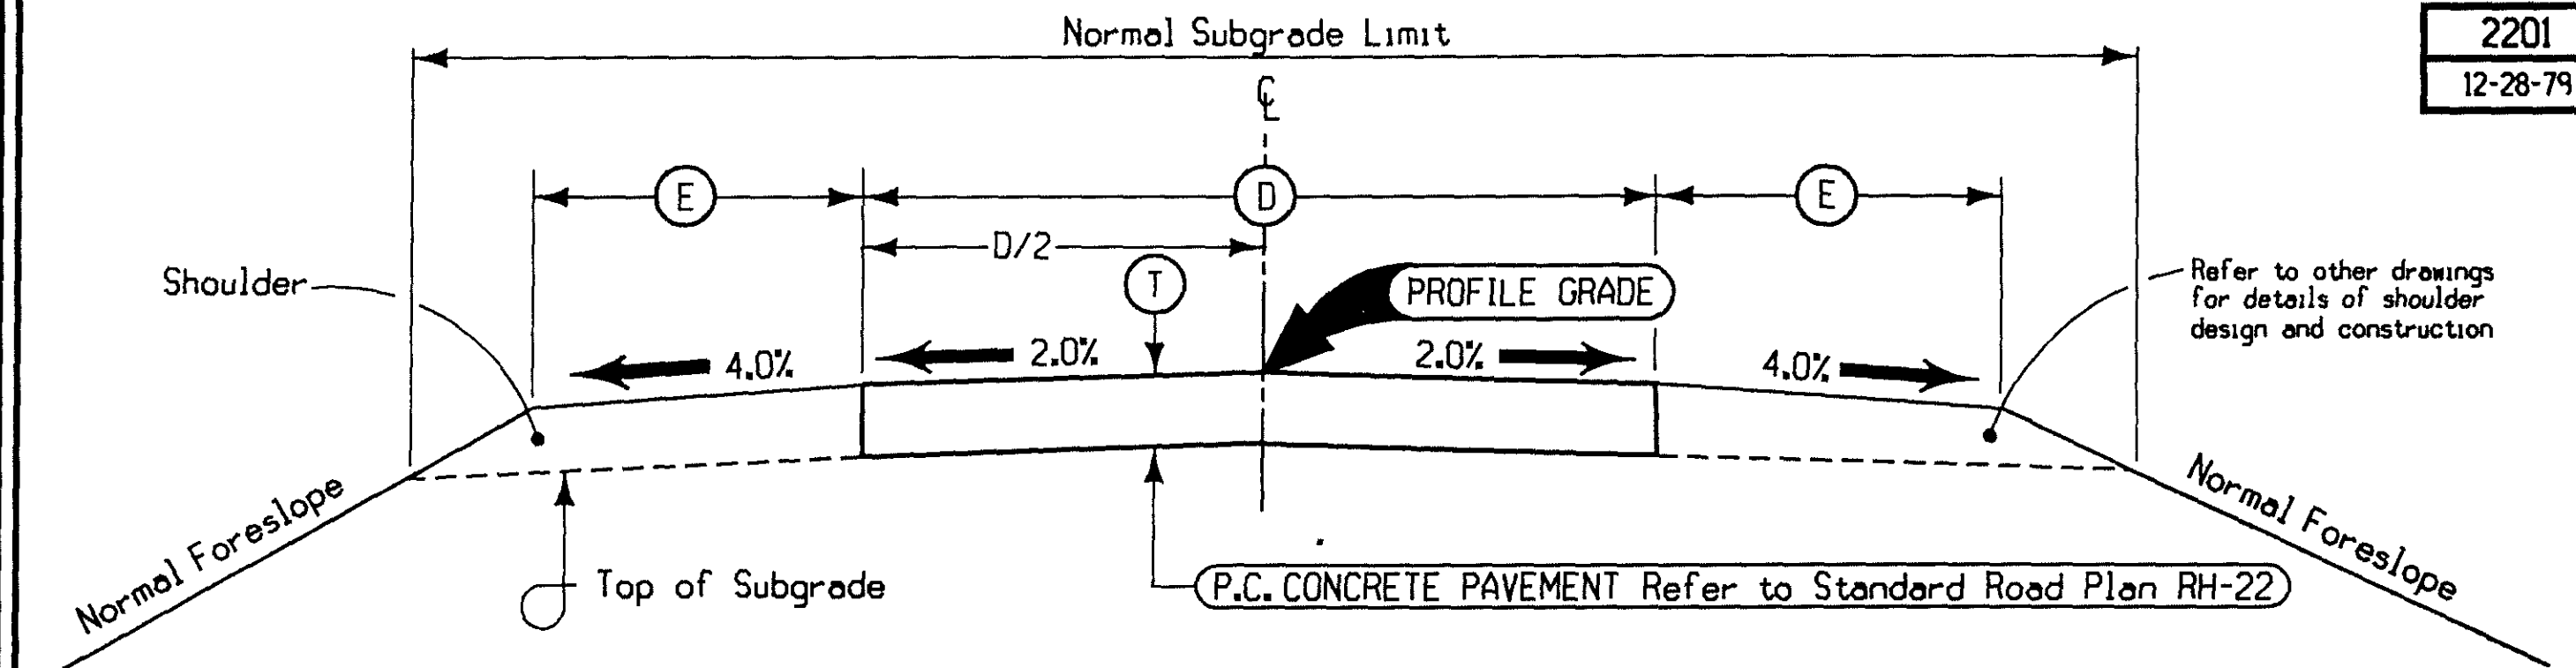


TYPICAL CROSS SECTION
2 LANE ROADWAY

Notes:
Normal sections shown may be appropriately modified for areas specifically designated by the engineer such as intersections or super-elevated curves.


LOCATION			D	T	E	SHOULDER TYPE
ROAD IDENTIFICATION	STATION TO STATION		Feet	Inches	Feet	
Munier Road	4281+04.08	4287+00.00	24	8.5	6	Type A
22nd St. South	2211+50.00	2215+11.91	24	8.5	6	Type A

2201
12-28-79

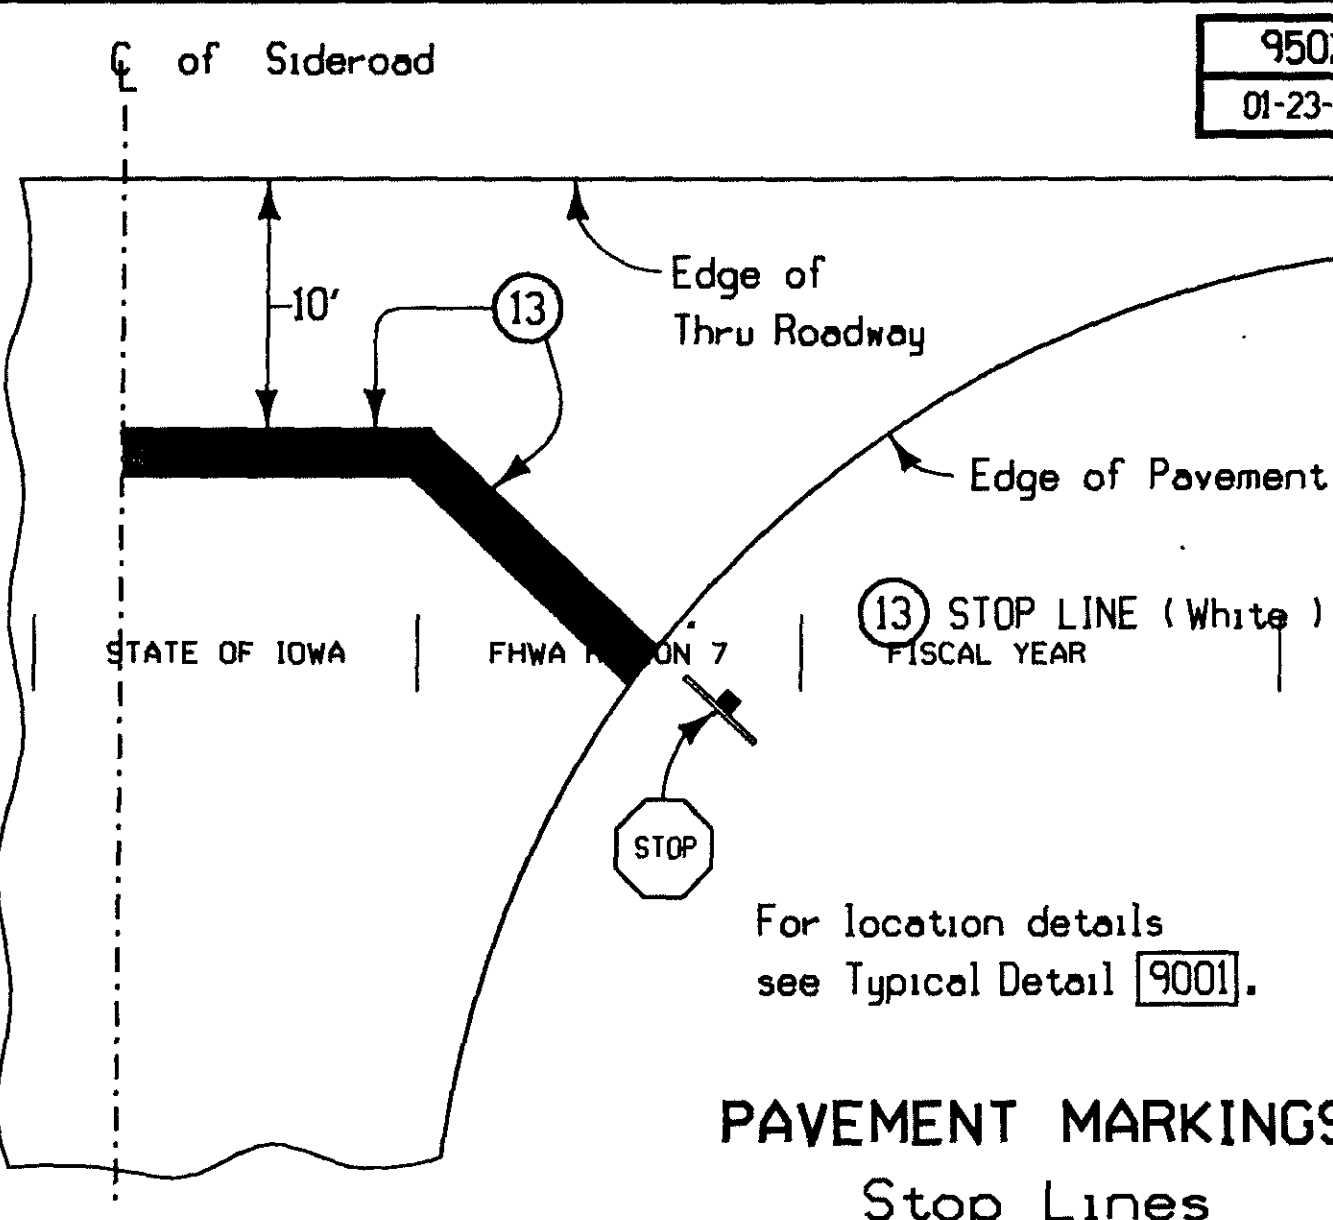


PAVEMENT MARKINGS
Stop Lines

9502
01-23-86

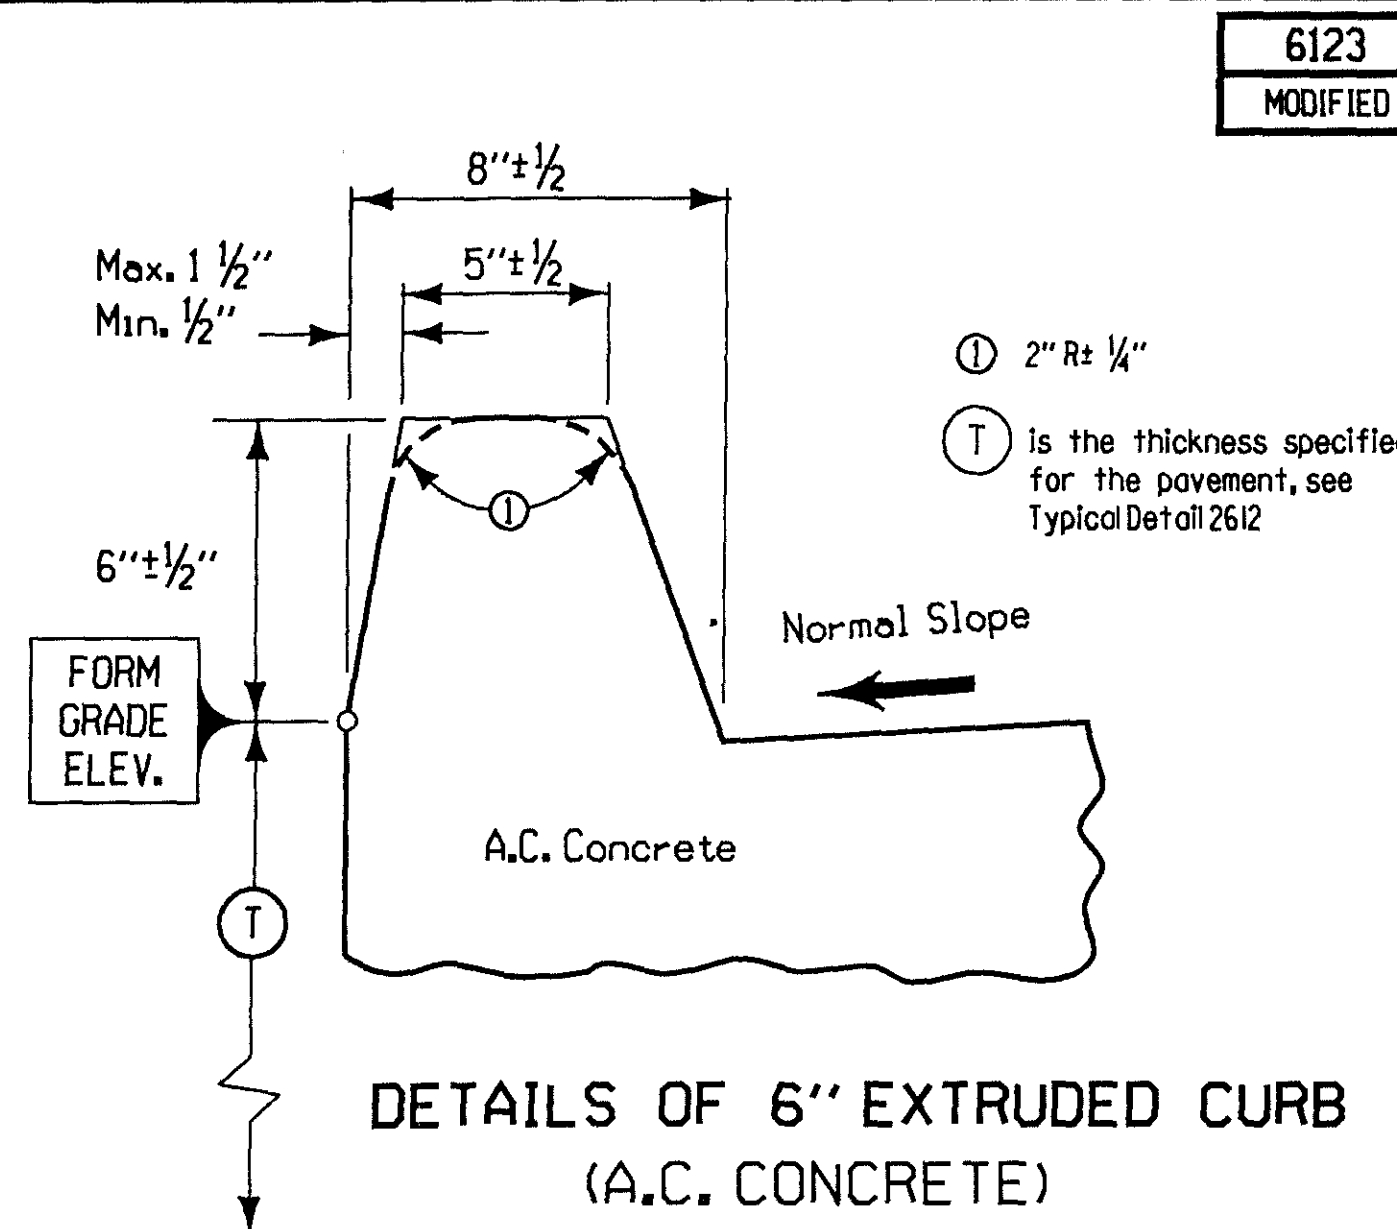

DETAILS OF 6" EXTRUDED CURB
(A.C. CONCRETE)

6123
MODIFIED

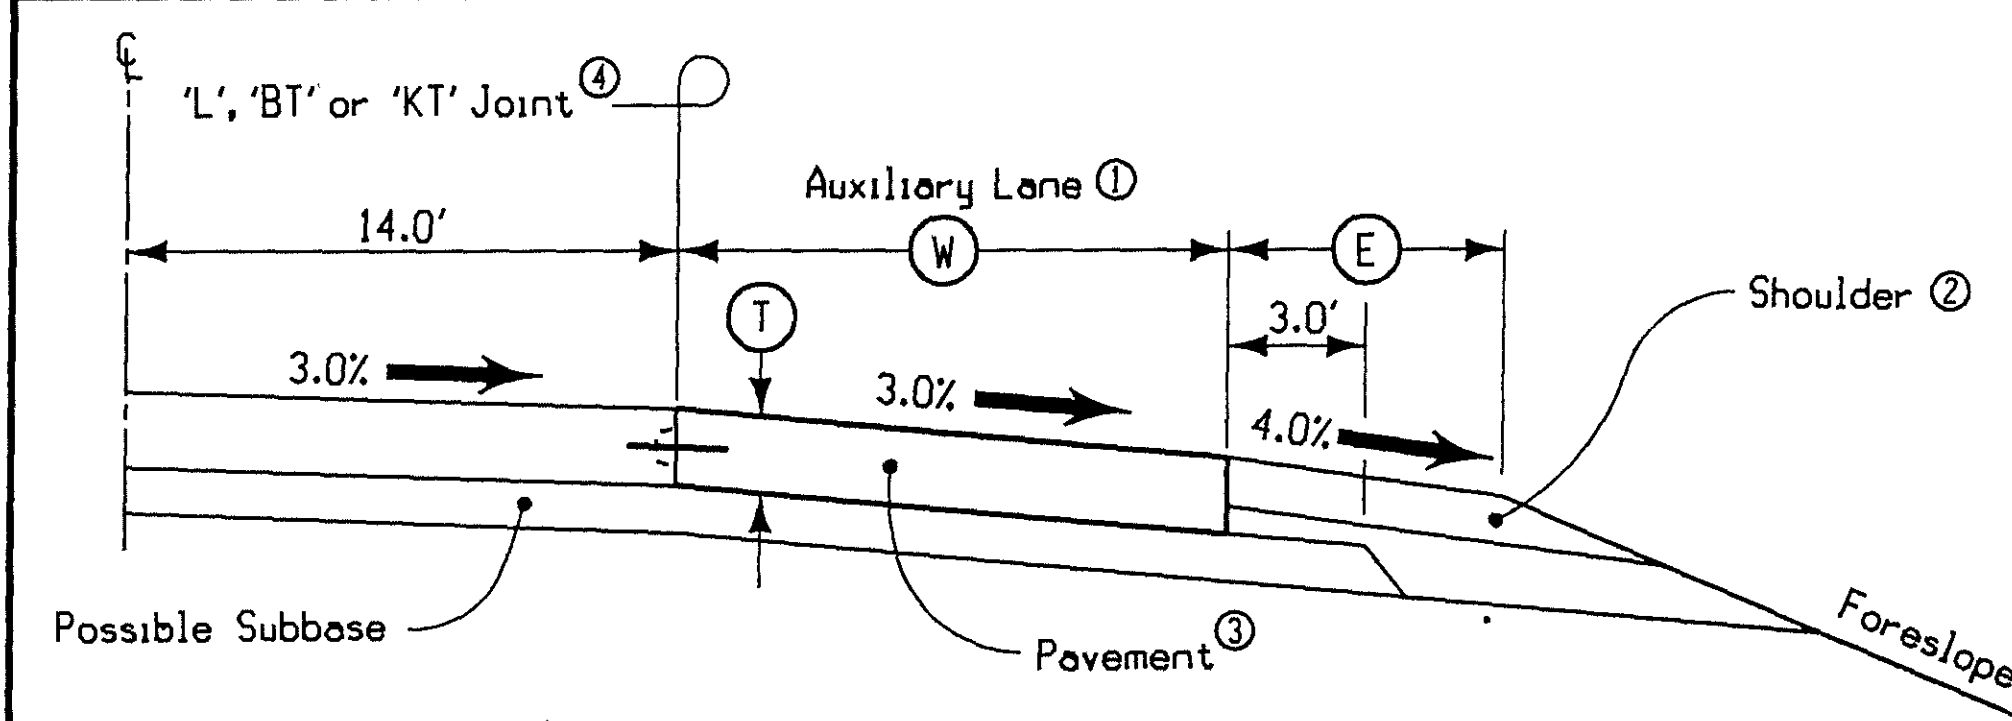


TYPICAL HALF SECTION
PCC AUXILIARY LANE

Notes:
① Details shall be similar for construction on either side (by stationing) of roadway.
② Refer to other drawings for details of shoulder design and construction.
③ Pavement for auxiliary lane shall be constructed according to requirements specified for through roadway pavement.
④ For Joint details see Standard Road Plan RH-51.

LOCATION				E	W	T
ROAD IDENTIFICATION	STATION TO STATION		SIDE	Feet	Feet	Inches
Ia# 100	179+36.82	185+86.44	Rt.	10	10	10

2205
MODIFIED

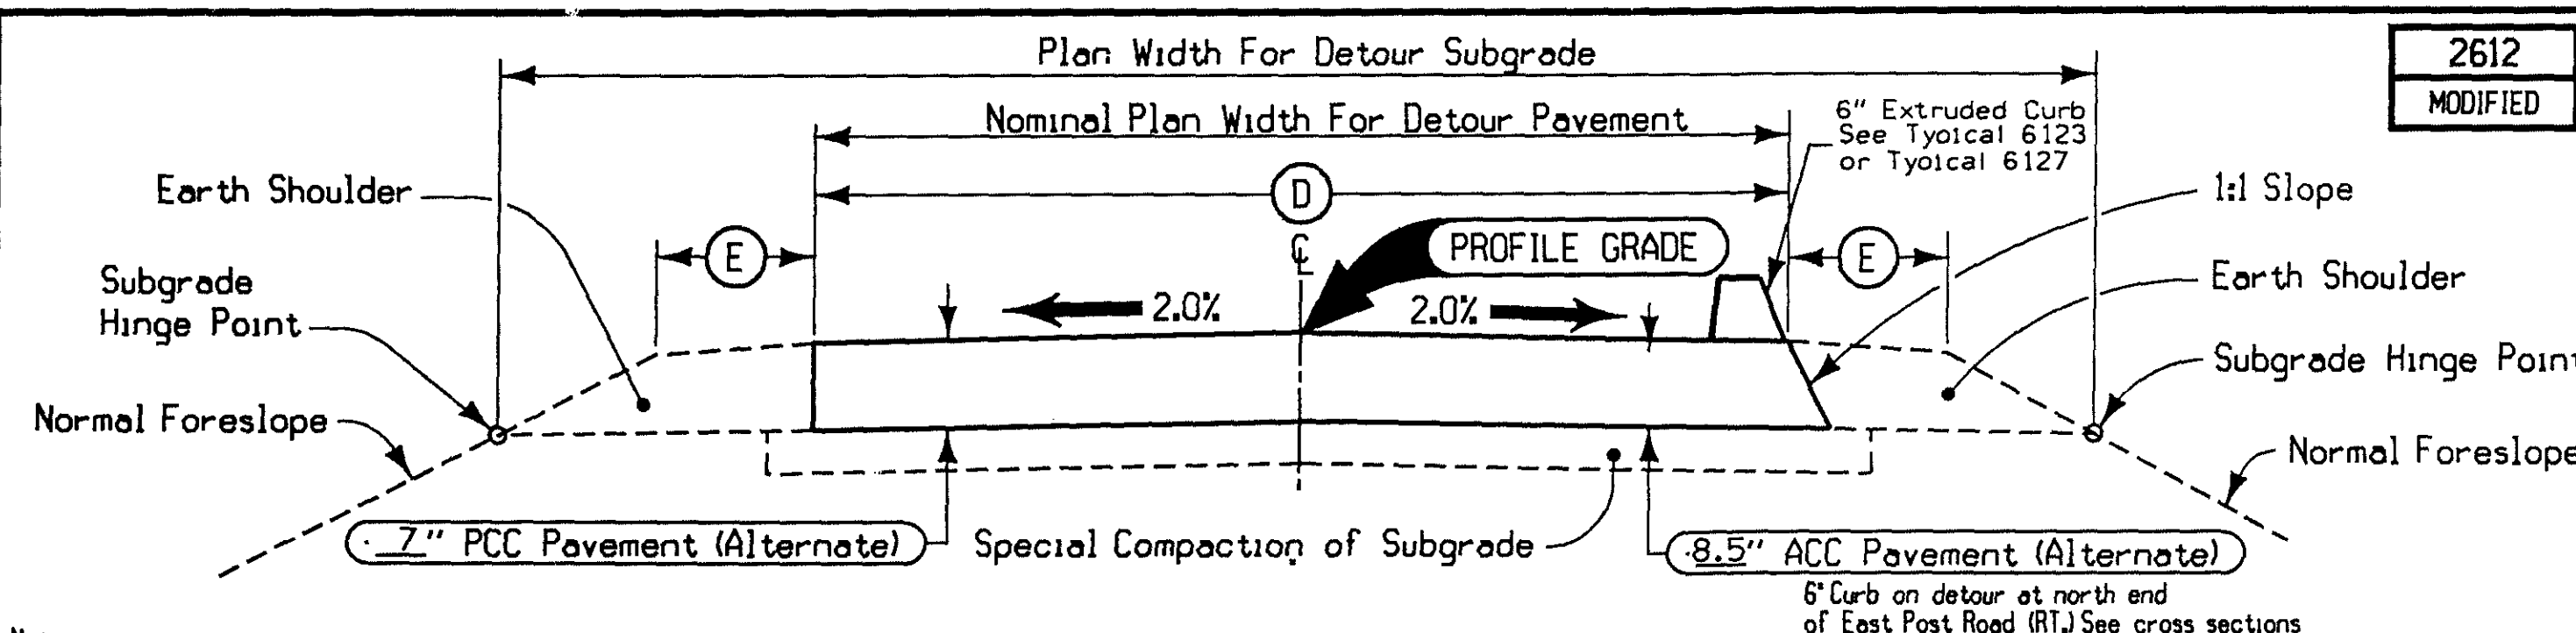

TYPICAL CROSS SECTION
DETOUR PAVEMENT ALTERNATES

Notes:
Details indicated herein illustrate the general requirements for the construction of a paved detour section where the pavement may be constructed as either of two types at the option of the contractor.

The P.C. Concrete option shall be constructed in conformance with current specifications for Class "A" P.C. Concrete Pavement. Transverse joints, center tie bars and sealing of the center longitudinal joint are not required.


Special compaction of subgrade is required and will be constructed and paid for in conformance with current specifications. (See Section 2109)

LOCATION		Ⓓ Feet	Ⓔ Feet	EARTH SHOULDER MATERIAL (Cu. Yds.) ① ②
STATION TO STATION				
72+12.52	78+55.04	24	3	16.34
9+76.49	13+93.30	24	3	57.36
③ 1171+90.7-LT	1181+25.0-LT	Var	3	16.34

Notes:
The Asphalt Cement Concrete option shall be constructed in conformance with current specifications for Type "B" Asphalt Cement Concrete Base (Class 1), an approved commercial mix or a mix of higher quality. The price bid for "Detour Pavement" in sq. yds. will be considered full compensation for building the detour pavement as detailed herein.

① Per Shoulder Per Station
② Quantity Include 60% for Shrinkage
③ Special Compaction of Subgrade Not Required


2612
MODIFIED

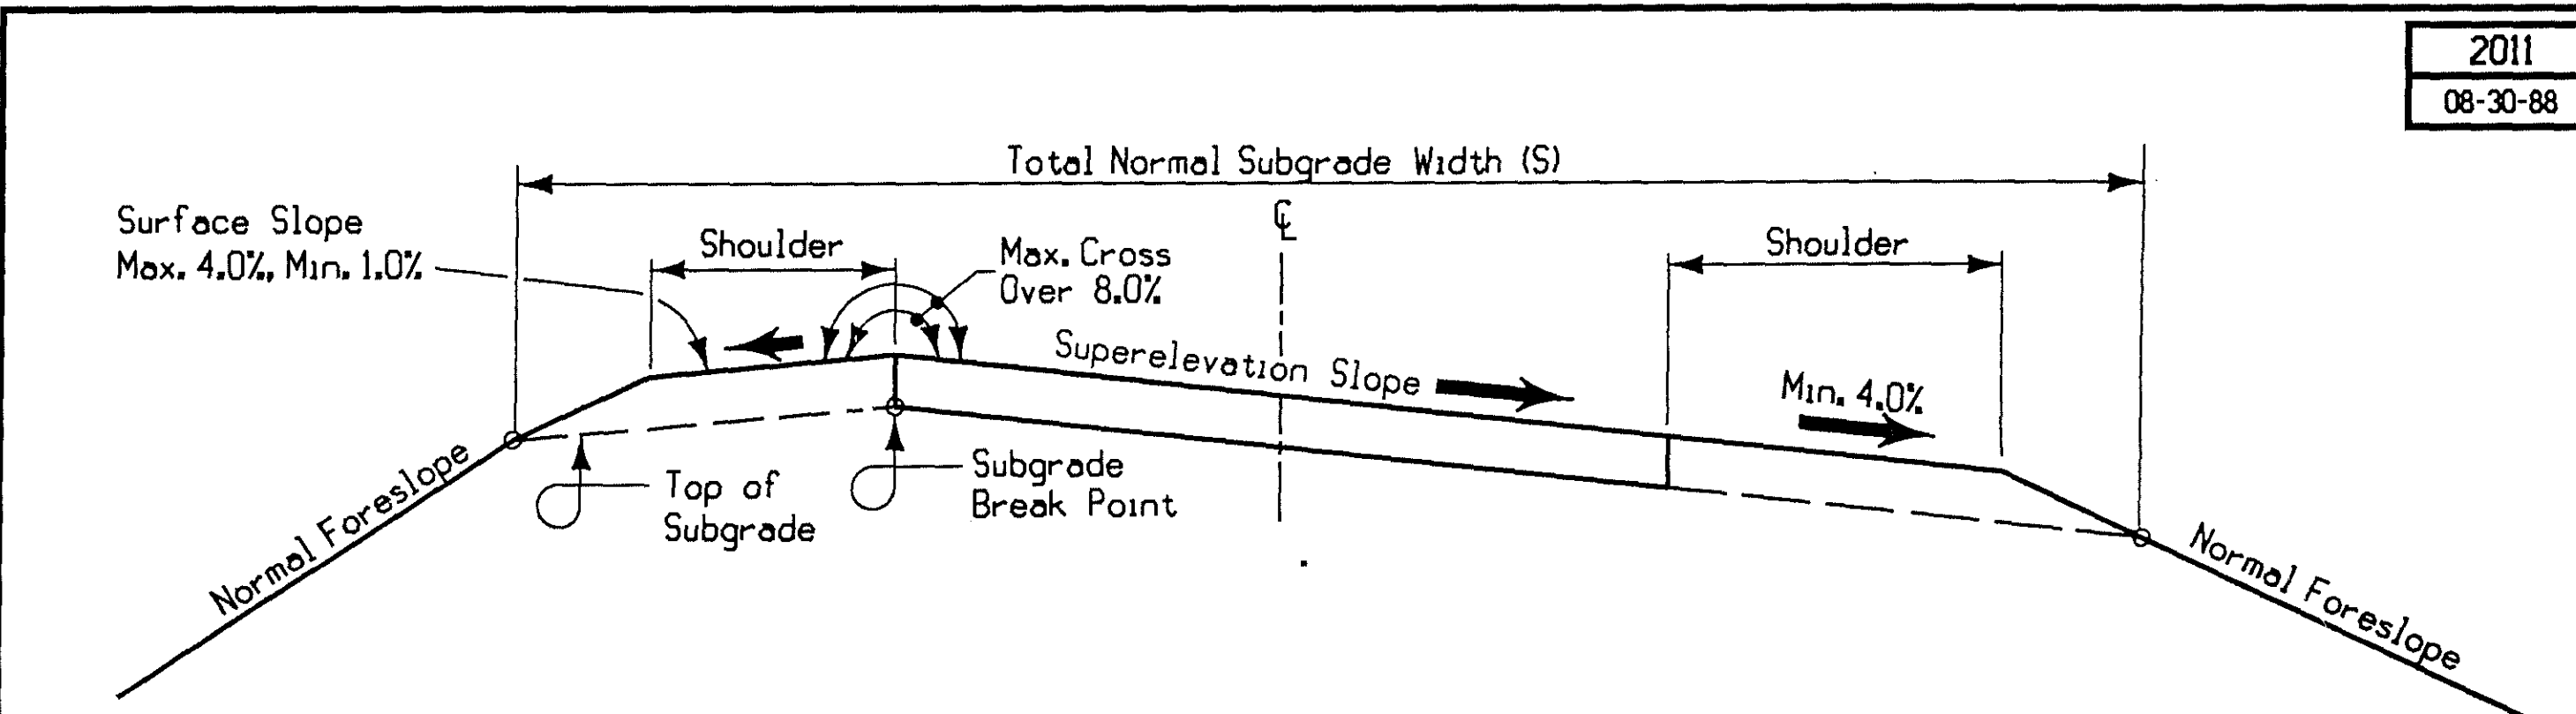


SUPERELEVATION (UP TO 7.0%)
TYPICAL CROSS SECTION
ALL NON-PAVED GRANULAR and EARTH SHOULDERS

Notes:
High Side: The shoulder slope shall be maintained at the normal rate of 4.0% unless this slope produces a grade break with adjacent pavement of more than 8.0%. The shoulder slope shall then be determined by a 8.0% break with adjacent pavement. If super-elevation slope exceeds 7.0%, use Typical [2014] for high side shoulder.
Low Side: The shoulder slope shall be maintained at normal rate of 4.0% unless the adjacent pavement slope is steeper, in which case the shoulder will slope at the same slope as adjacent pavement.


2011
08-30-88

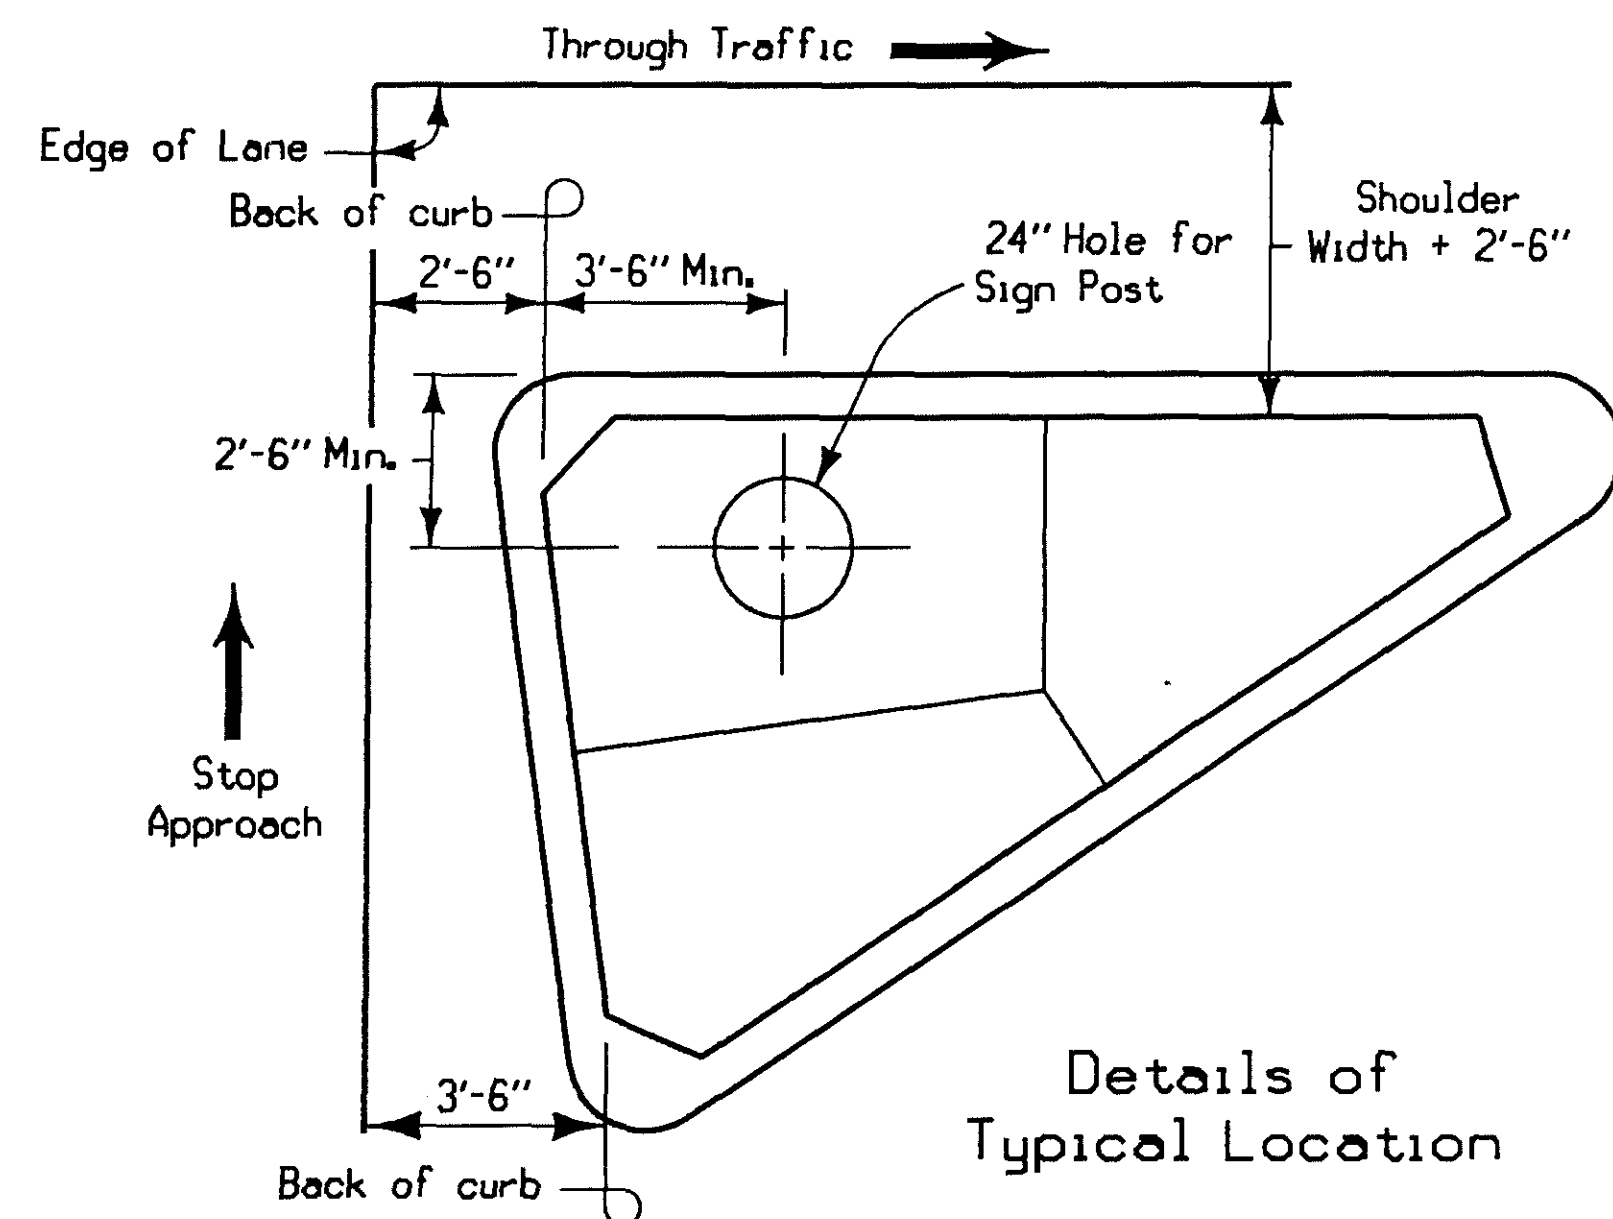

Details of
Typical Location

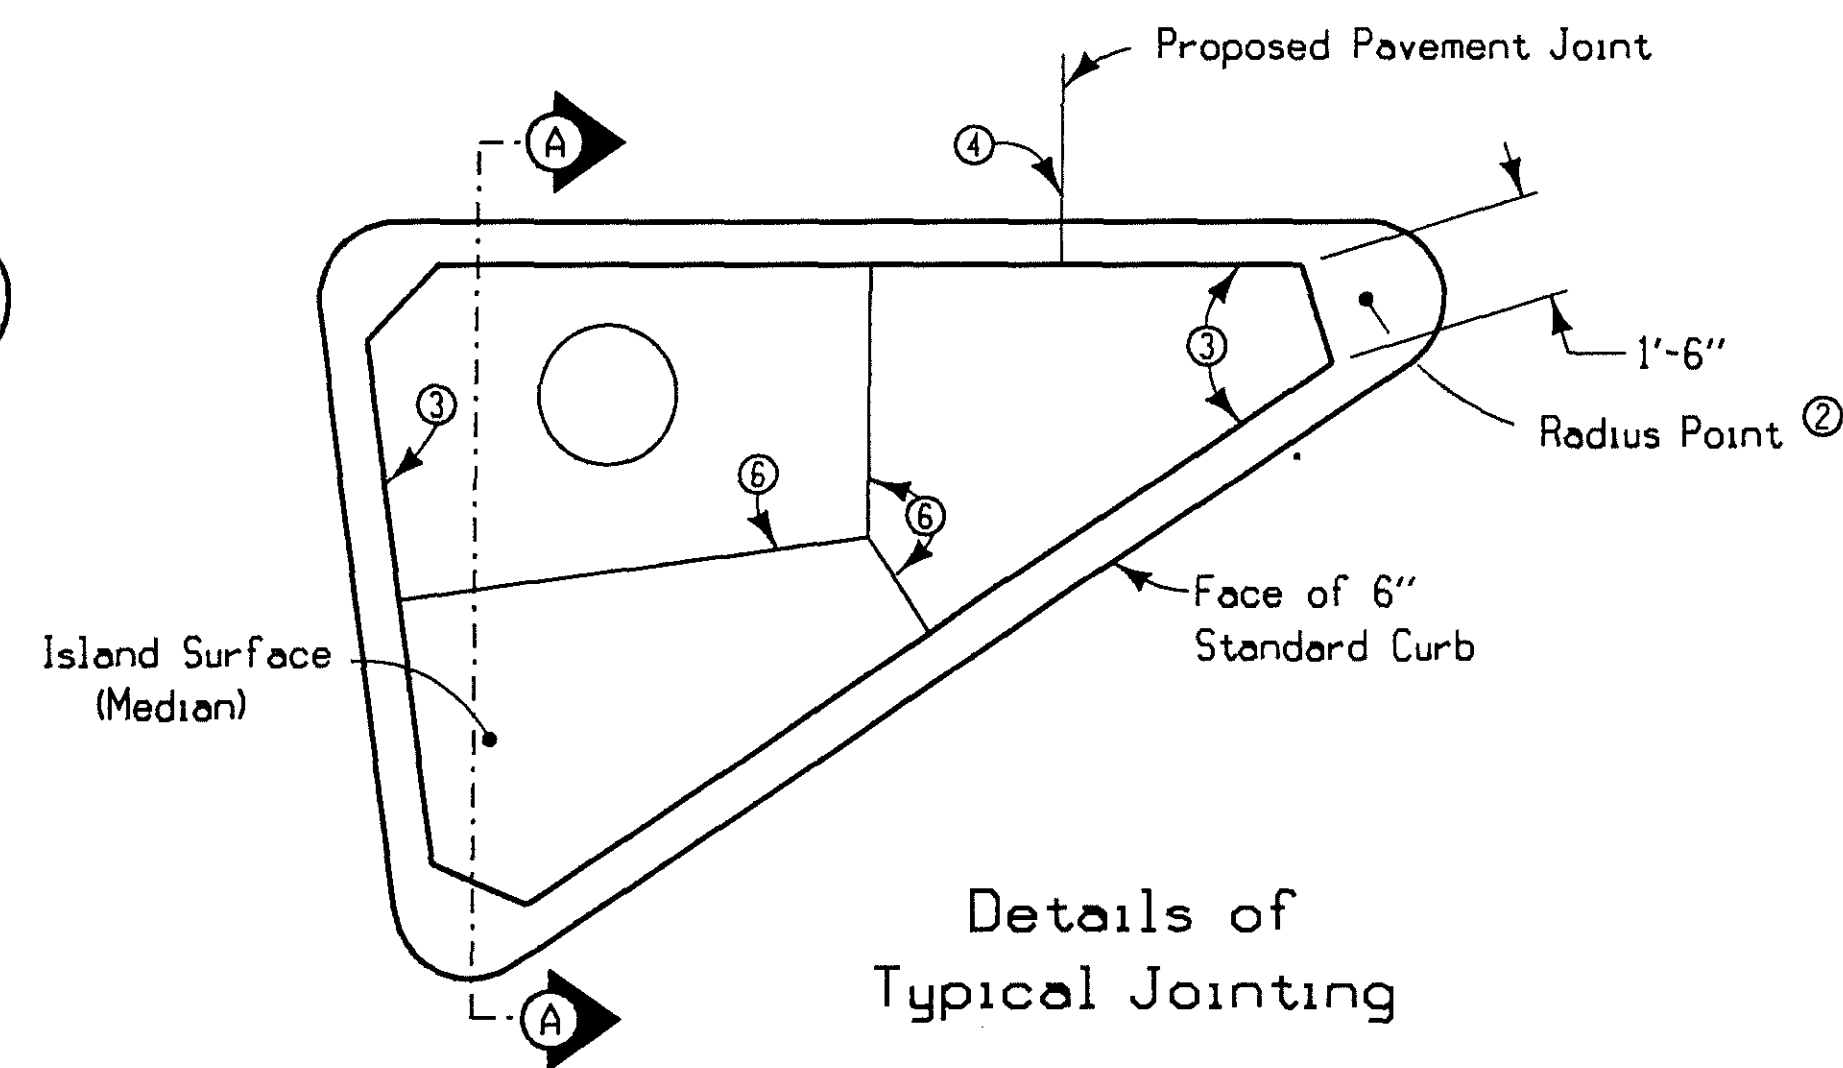


Details of
Typical Jointing

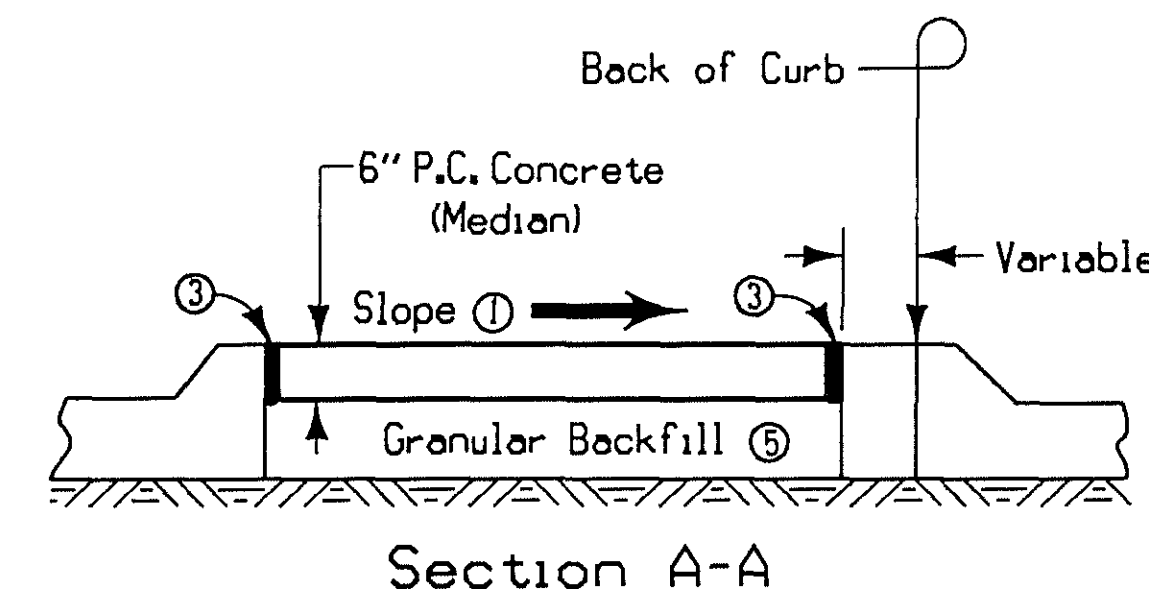


Section A-A

- Notes:
- ① Surface of island shall be shaped as necessary to drain.
 - ② Radius point is determined by a 0.5' radius to back of curb line. Contractor shall pave across and between curbs on a straight line as indicated.
 - ③ 'E' Joint, refer to Standard Road Plan RH-52 for details.
 - ④ Construct 'C' Joint in Curb as needed to continue intersection pavement joints. See Standard Road Plan RH-50.
 - ⑤ The furnishing and placing of granular backfill shall be incidental to the price bid for Portland Cement Concrete Median.
 - ⑥ 'C' Joints as required. See Standard Road Plan RH-50.

TRAFFIC ISLAND WITH STANDARD CURB

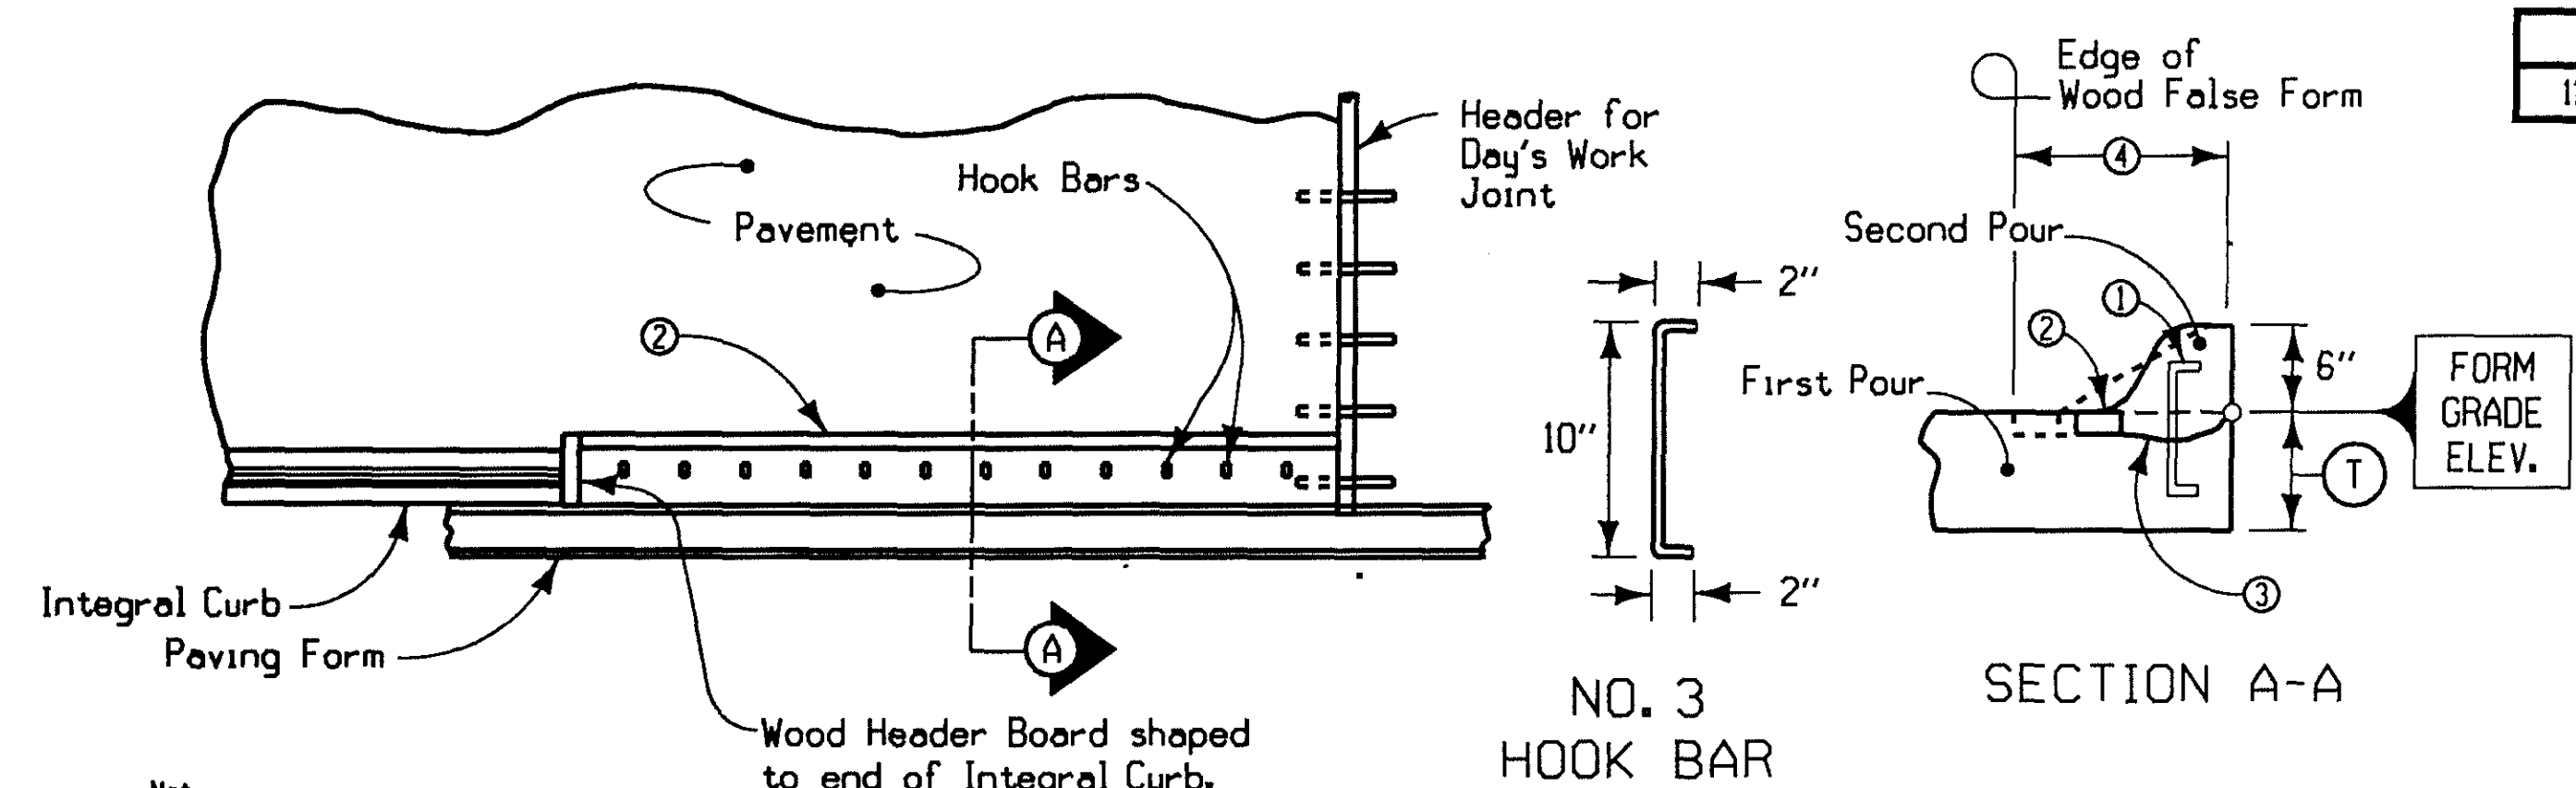


CONSTRUCTION WHERE CURB IS
OMITTED AT END OF DAY'S RUN

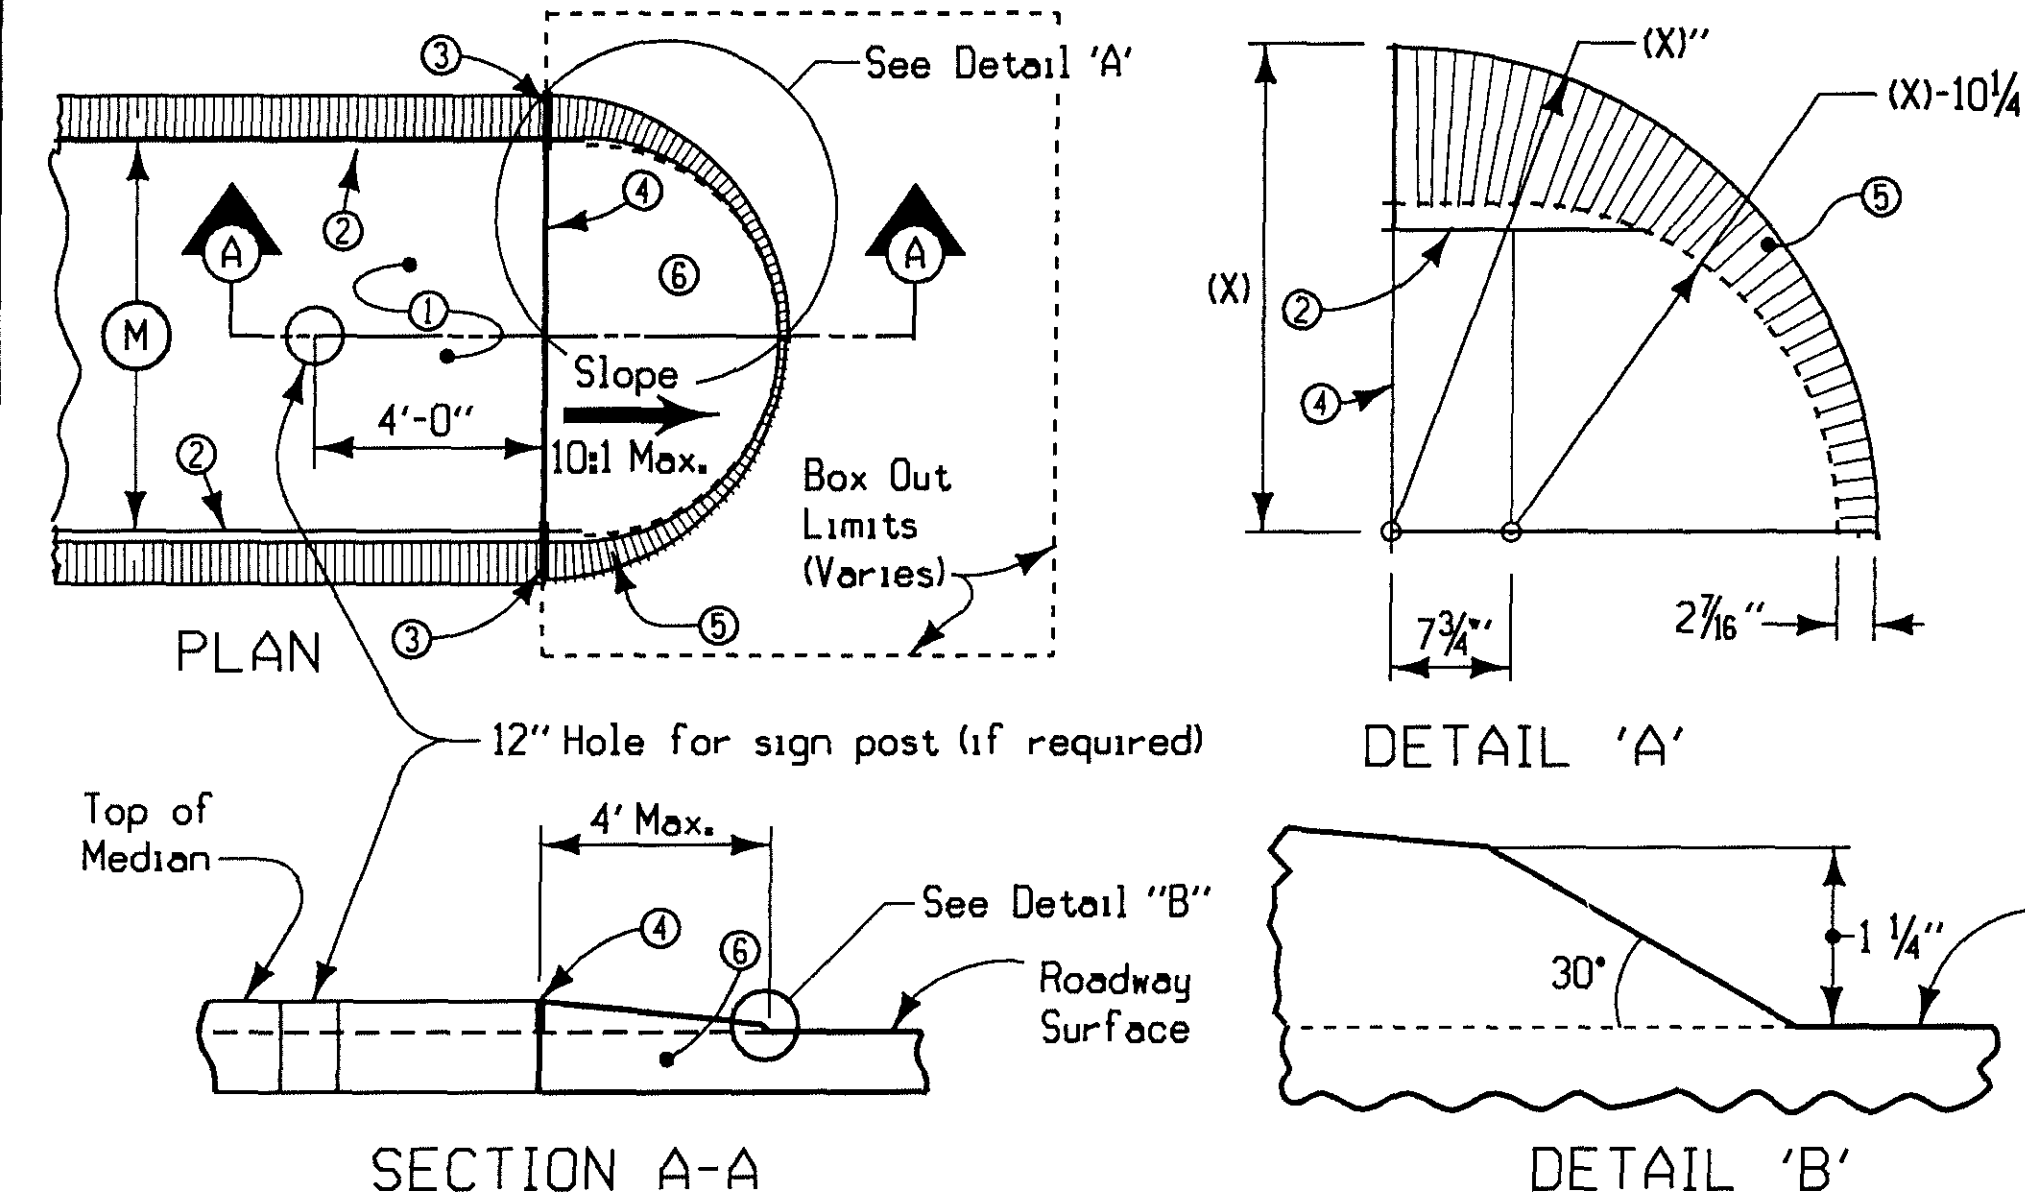

- Notes:
- For (M) of 8 feet or less, a ramped median nose should be used. For (M) over 8 feet see other detail plan.
- (X) = M/2 + 12"
- ① For details of paved median see Detail 6140
 - ② Back of Curb
 - ③ 'EE' Joint, see Standard Road Plan RH-52
 - ④ 'E' Joint, see Standard Road Plan RH-52
 - ⑤ Special Shaping of Curb
 - ⑥ Quantities for Ramped Median Nose area shall be included in the quantities for roadway pavement in sq. yds.

RAMPED MEDIAN NOSE
(4° SLOPED CURB)

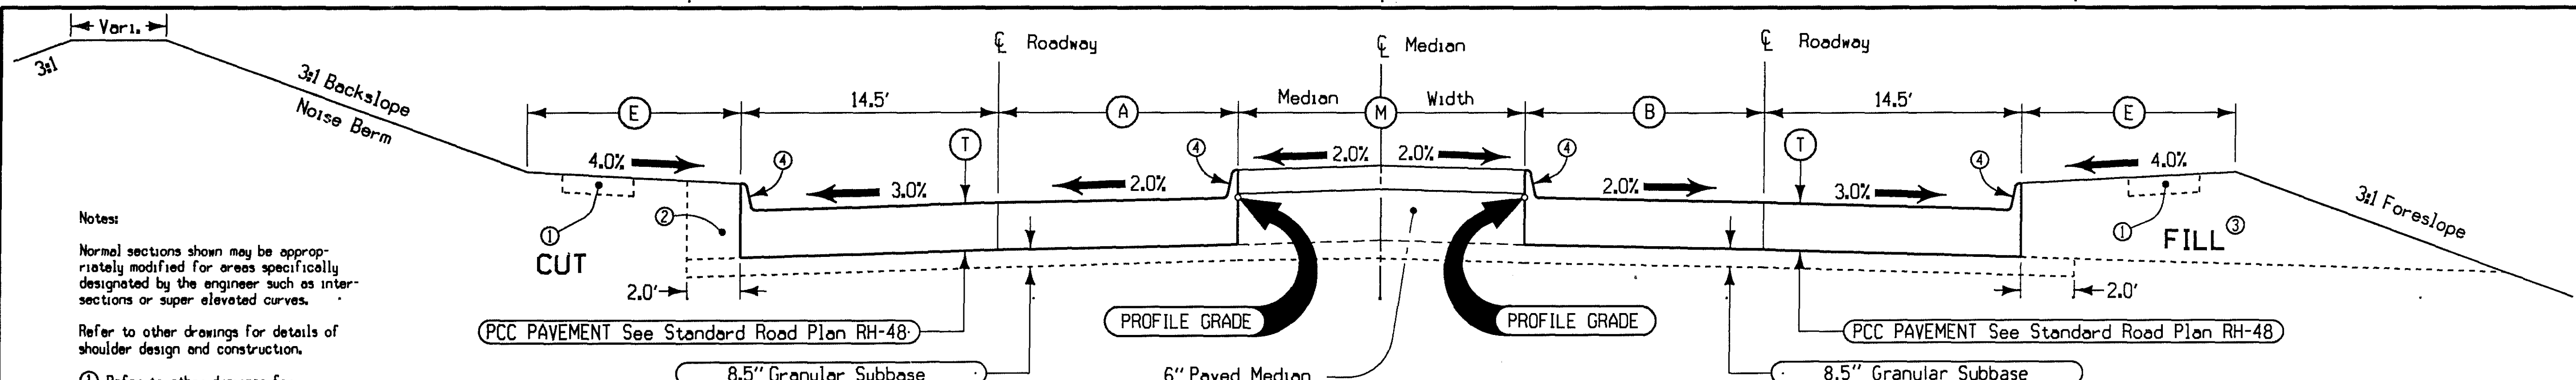



- Notes:
- Normal sections shown may be appropriately modified for areas specifically designated by the engineer such as intersections or super elevated curves.
- Refer to other drawings for details of shoulder design and construction.
- ① Refer to other drawings for details of shoulder and possible sidewalk construction.
 - ② Excavate and backfill 2.0'
 - ③ Backfill
 - ④ See Typical 6127 for details of 6" Integral Curb

Note: Begin 8.5" Granular Subbase @ Sta. 113+50.00


LOCATION		T	E	M	A	B
ROAD IDENTIFICATION	STATION TO STATION	Inches	Feet	Feet	Feet	Feet
1a. 100	116+20.50 116+63.38	10	*	10	17	17

* 9' Paved Shoulder from Sta. 116+20.50 to Sta. 116+63.38, Left Side.


TYPICAL CROSS SECTION
4 LANE PCC PAVEMENT
WITH CURBS

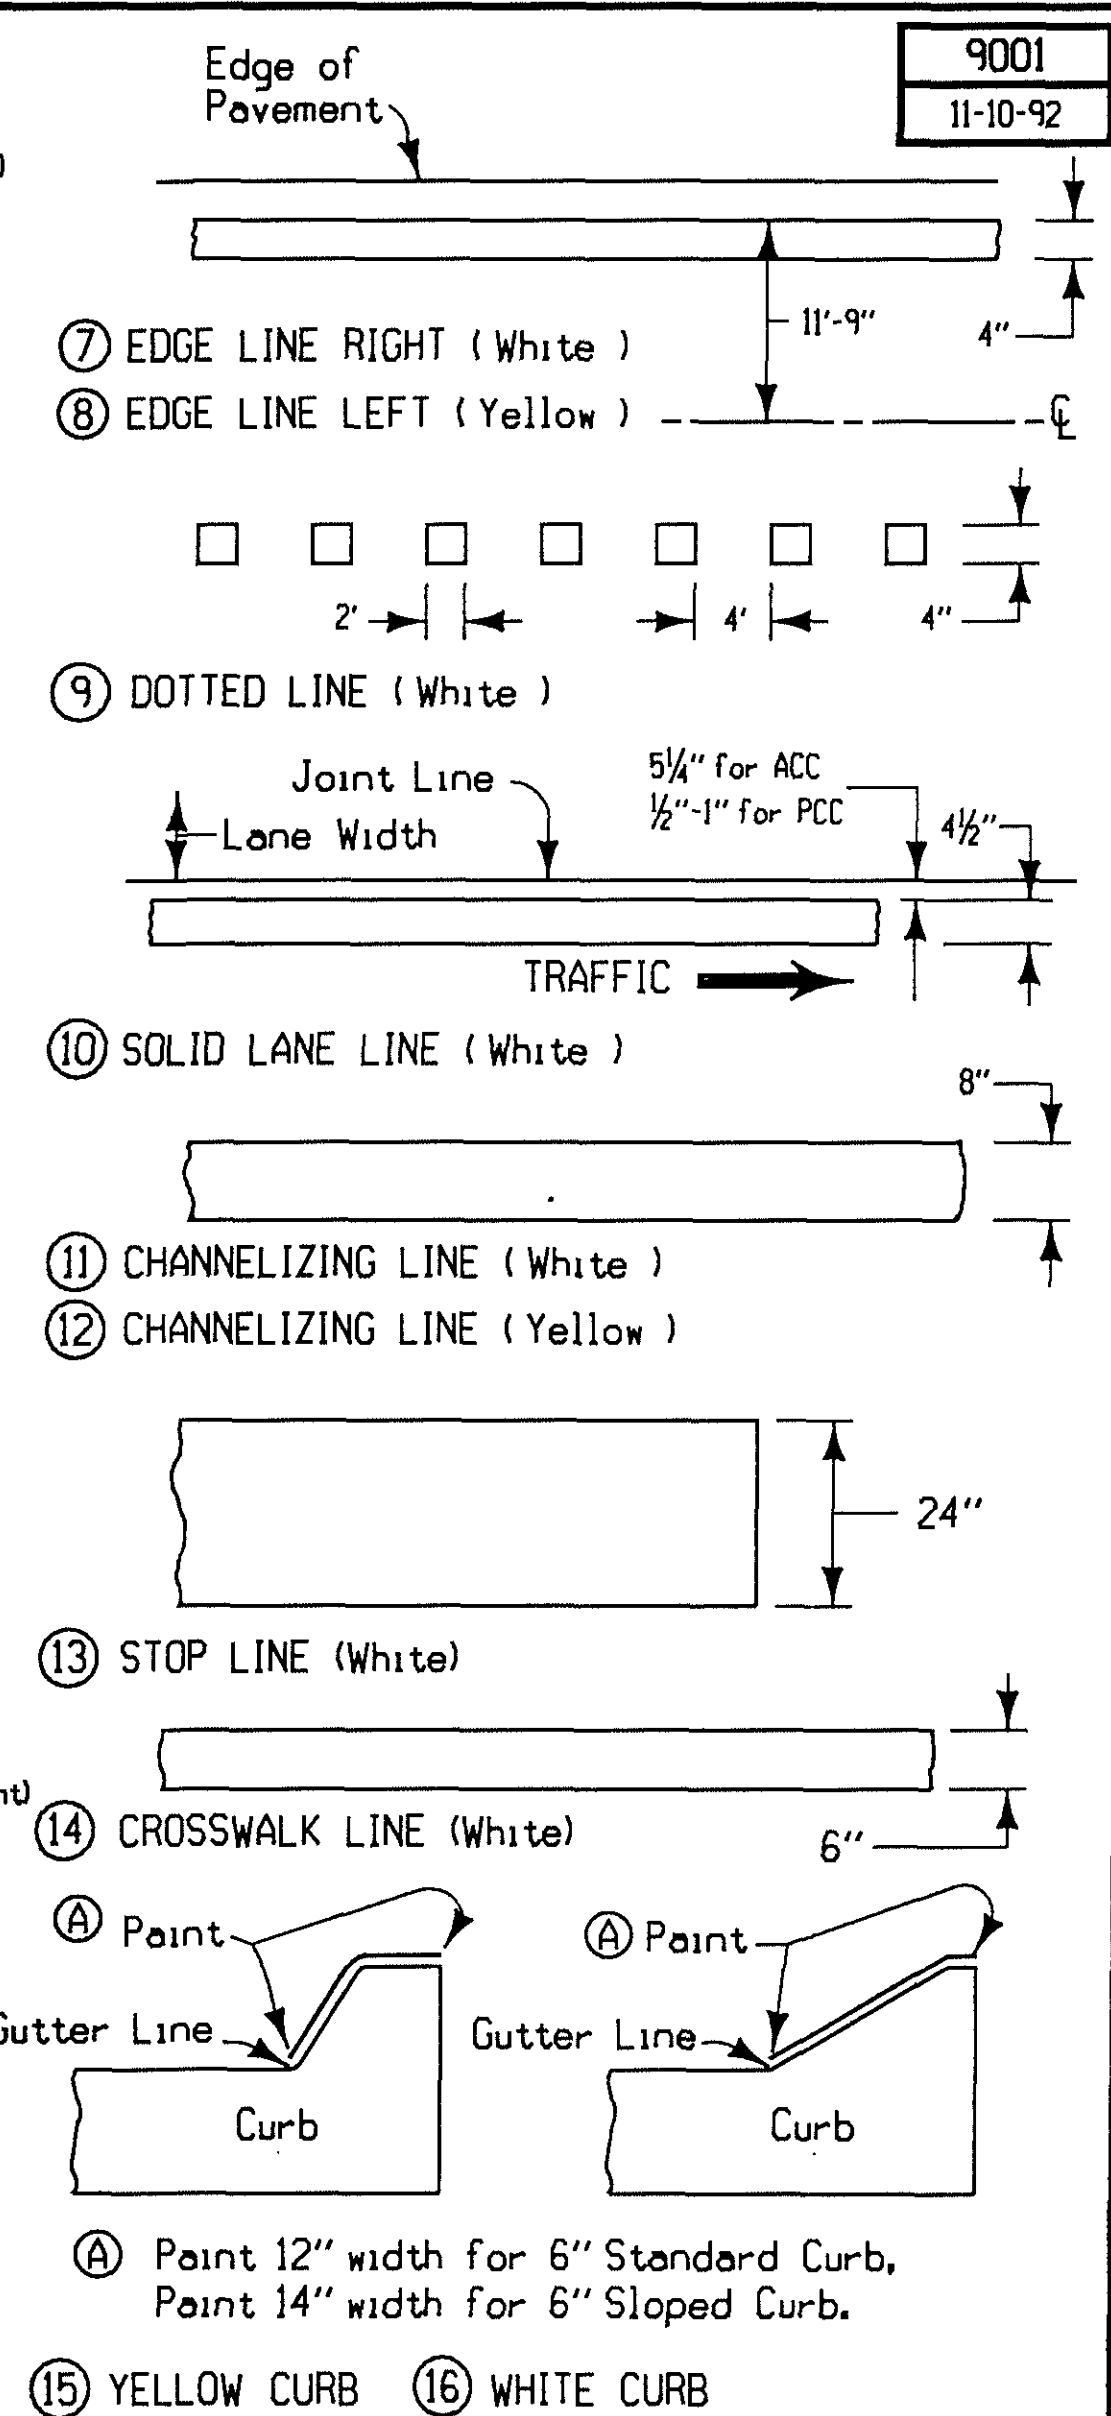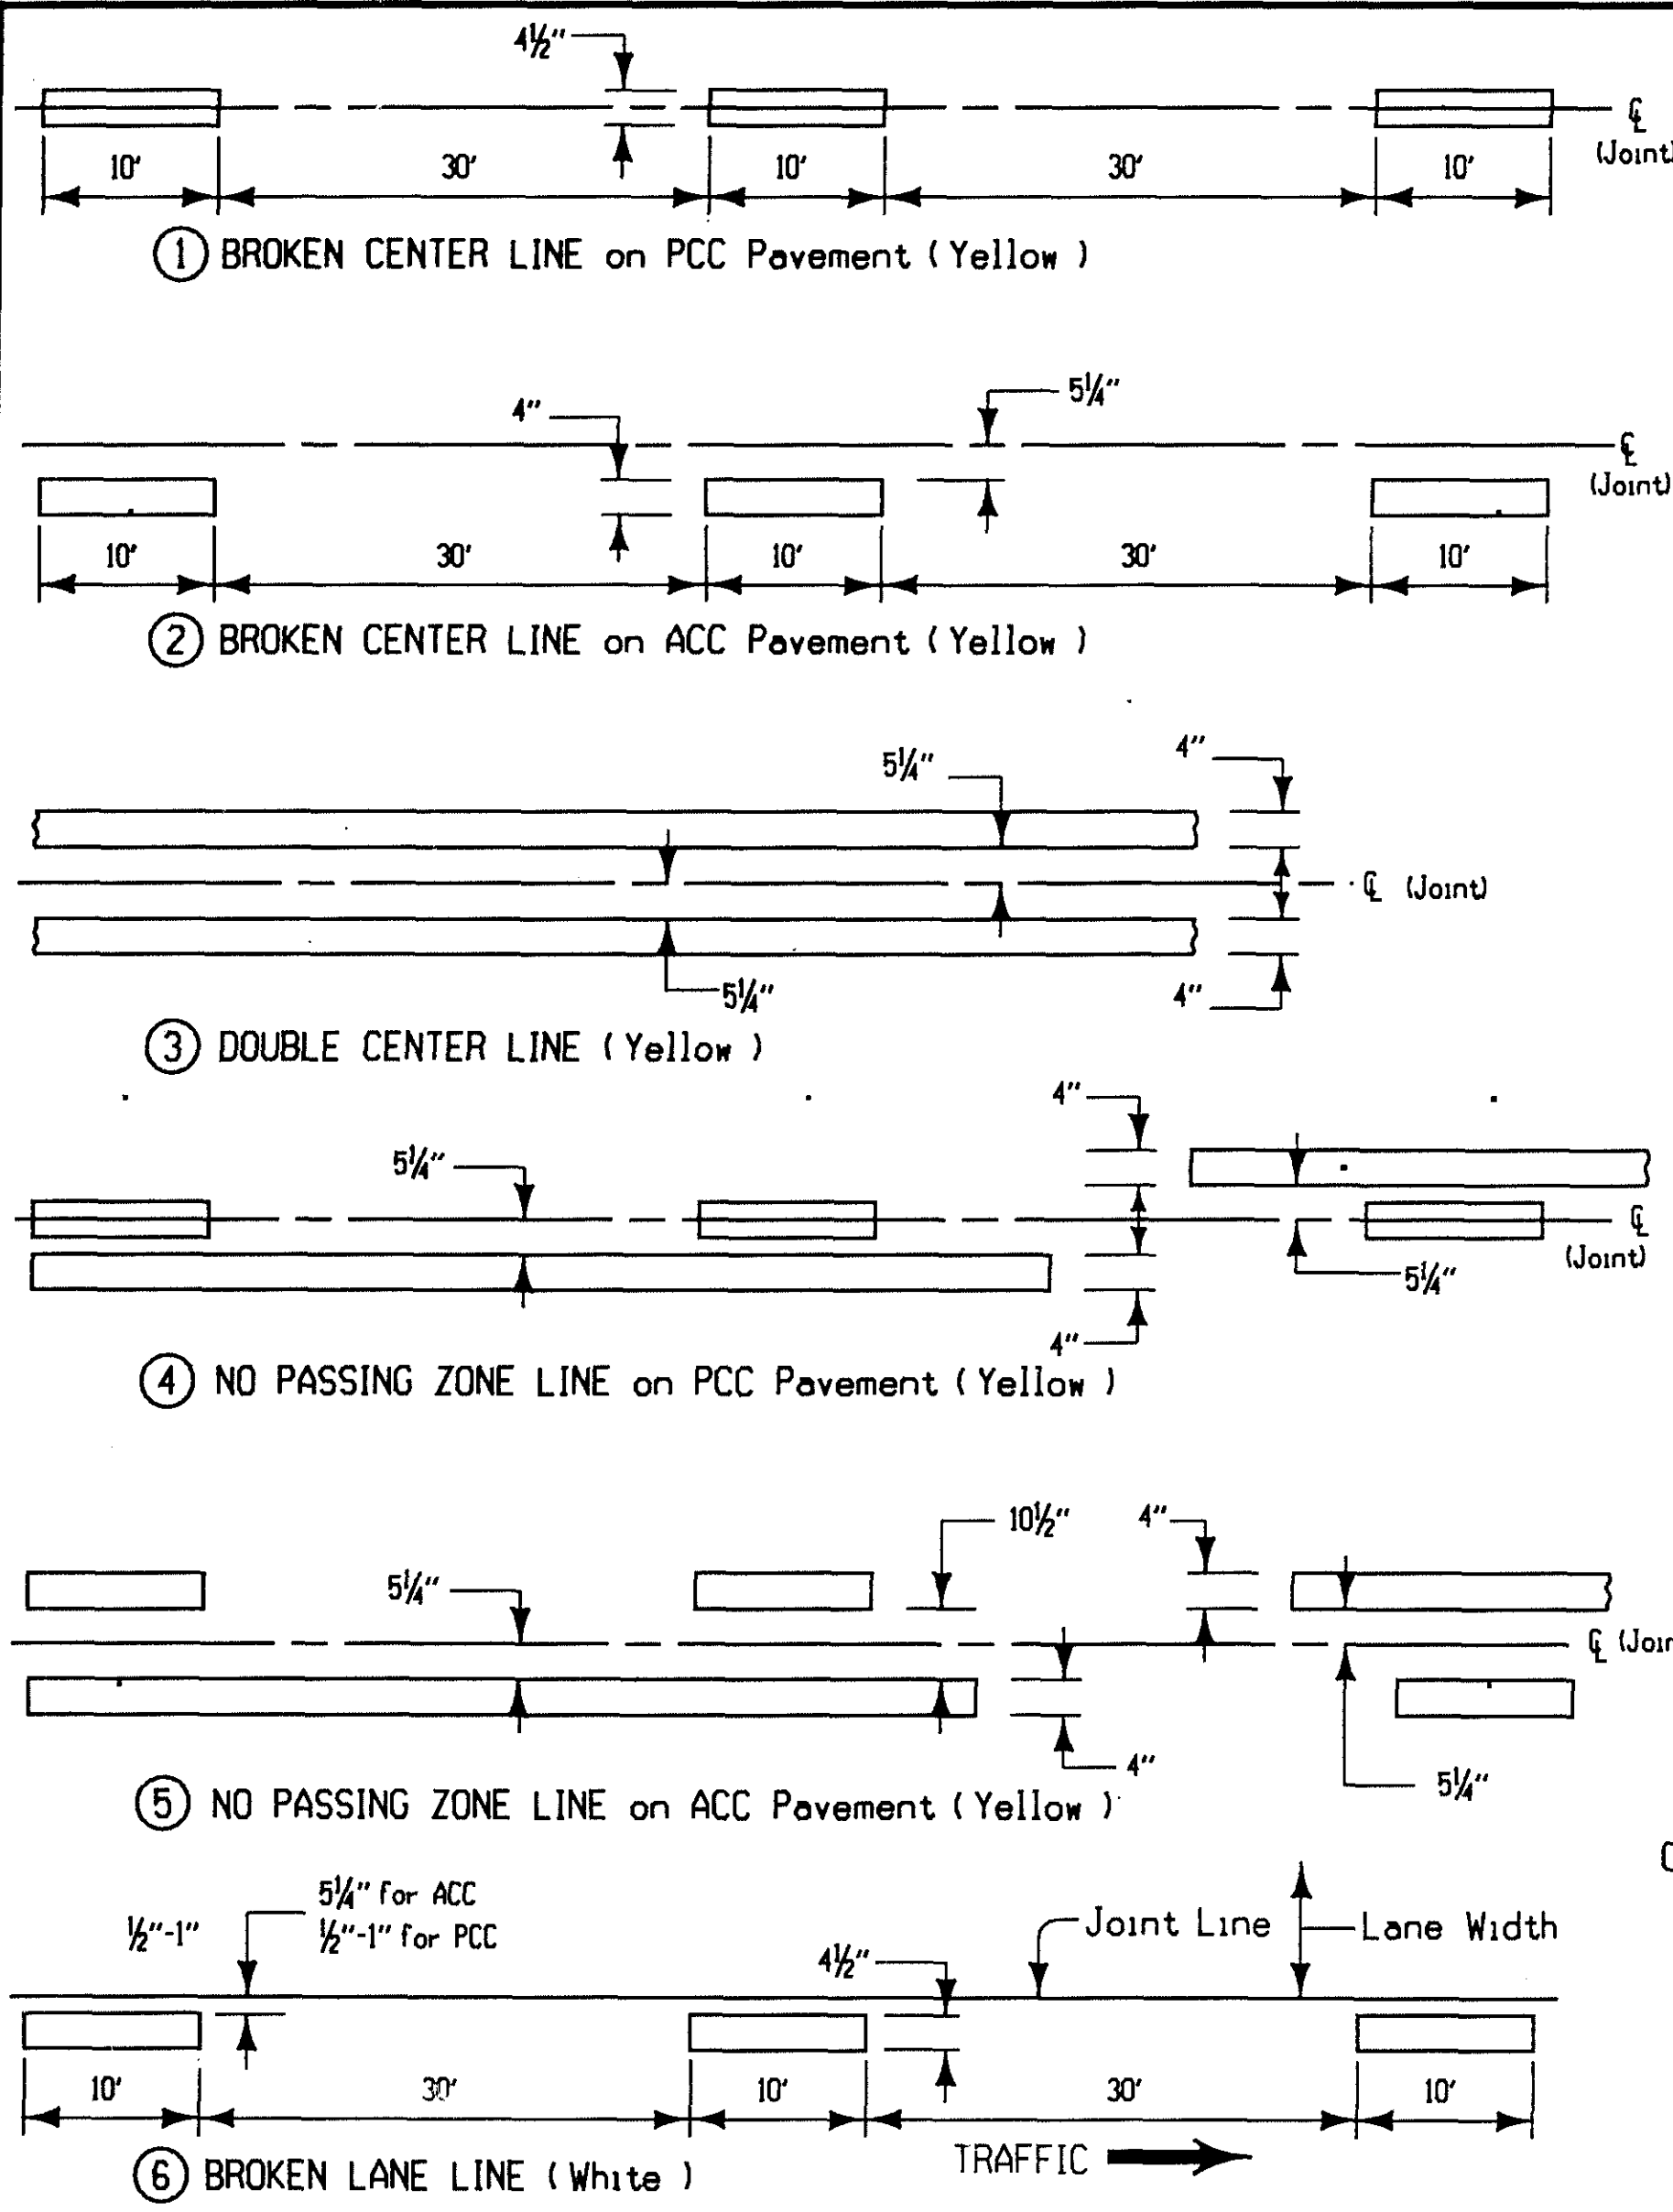


STANDARD TYPES OF PAVEMENT MARKINGS

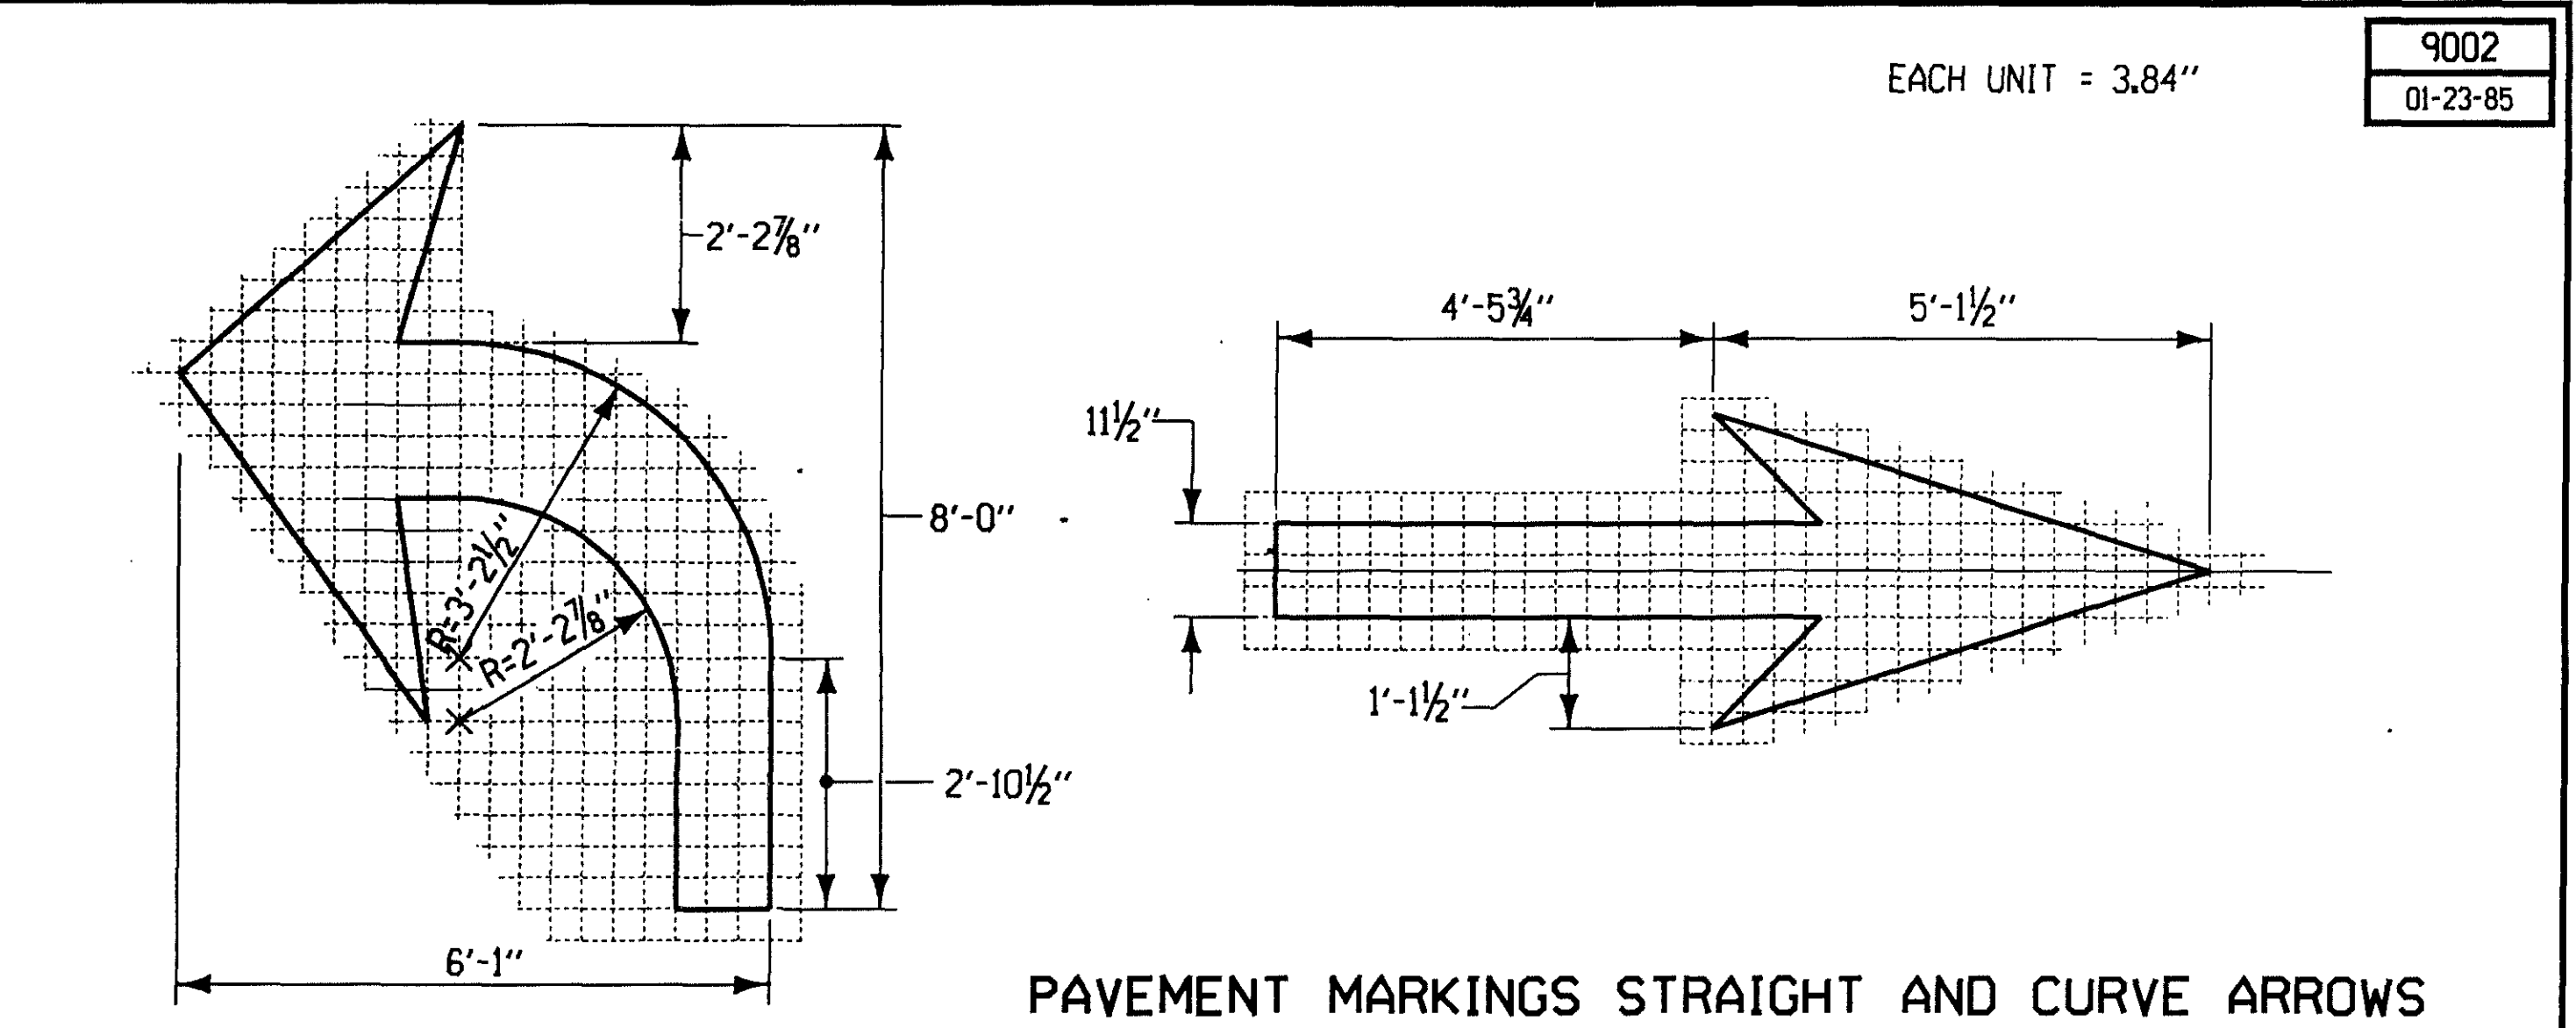


PAVEMENT MARKINGS STRAIGHT AND CURVE ARROWS

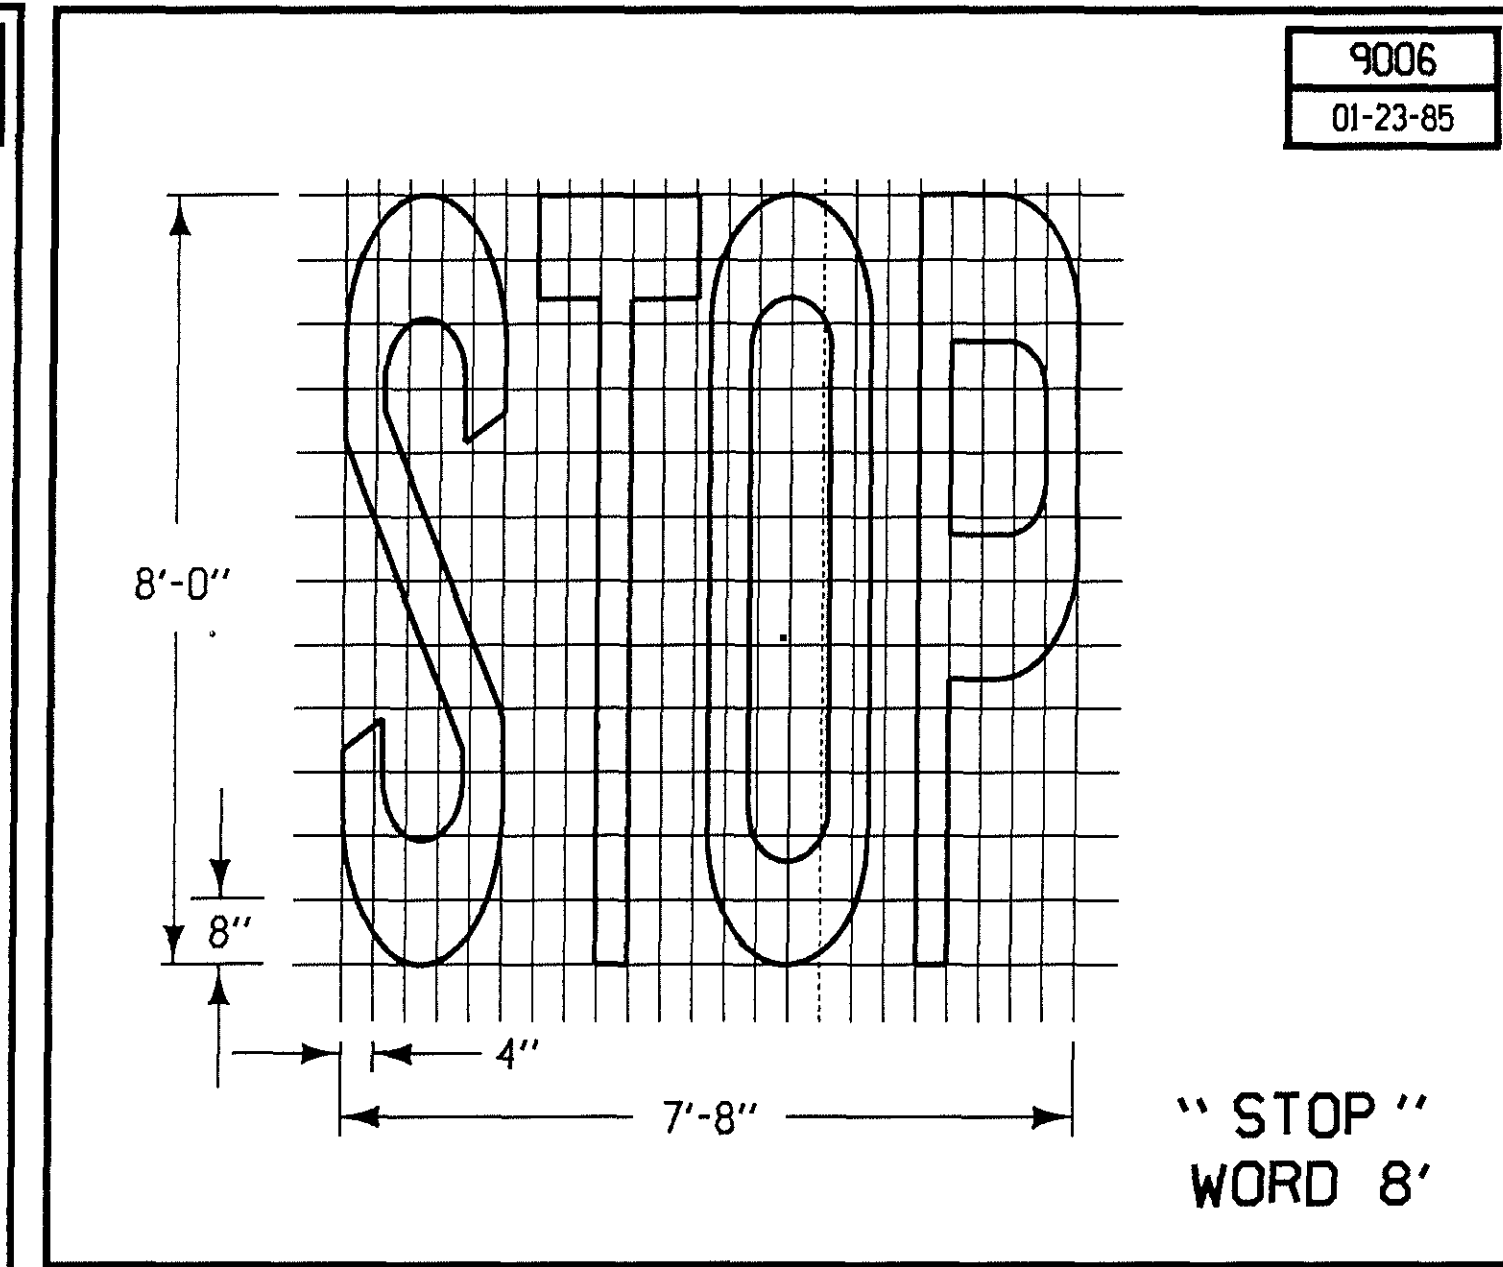


"STOP" WORD 8'

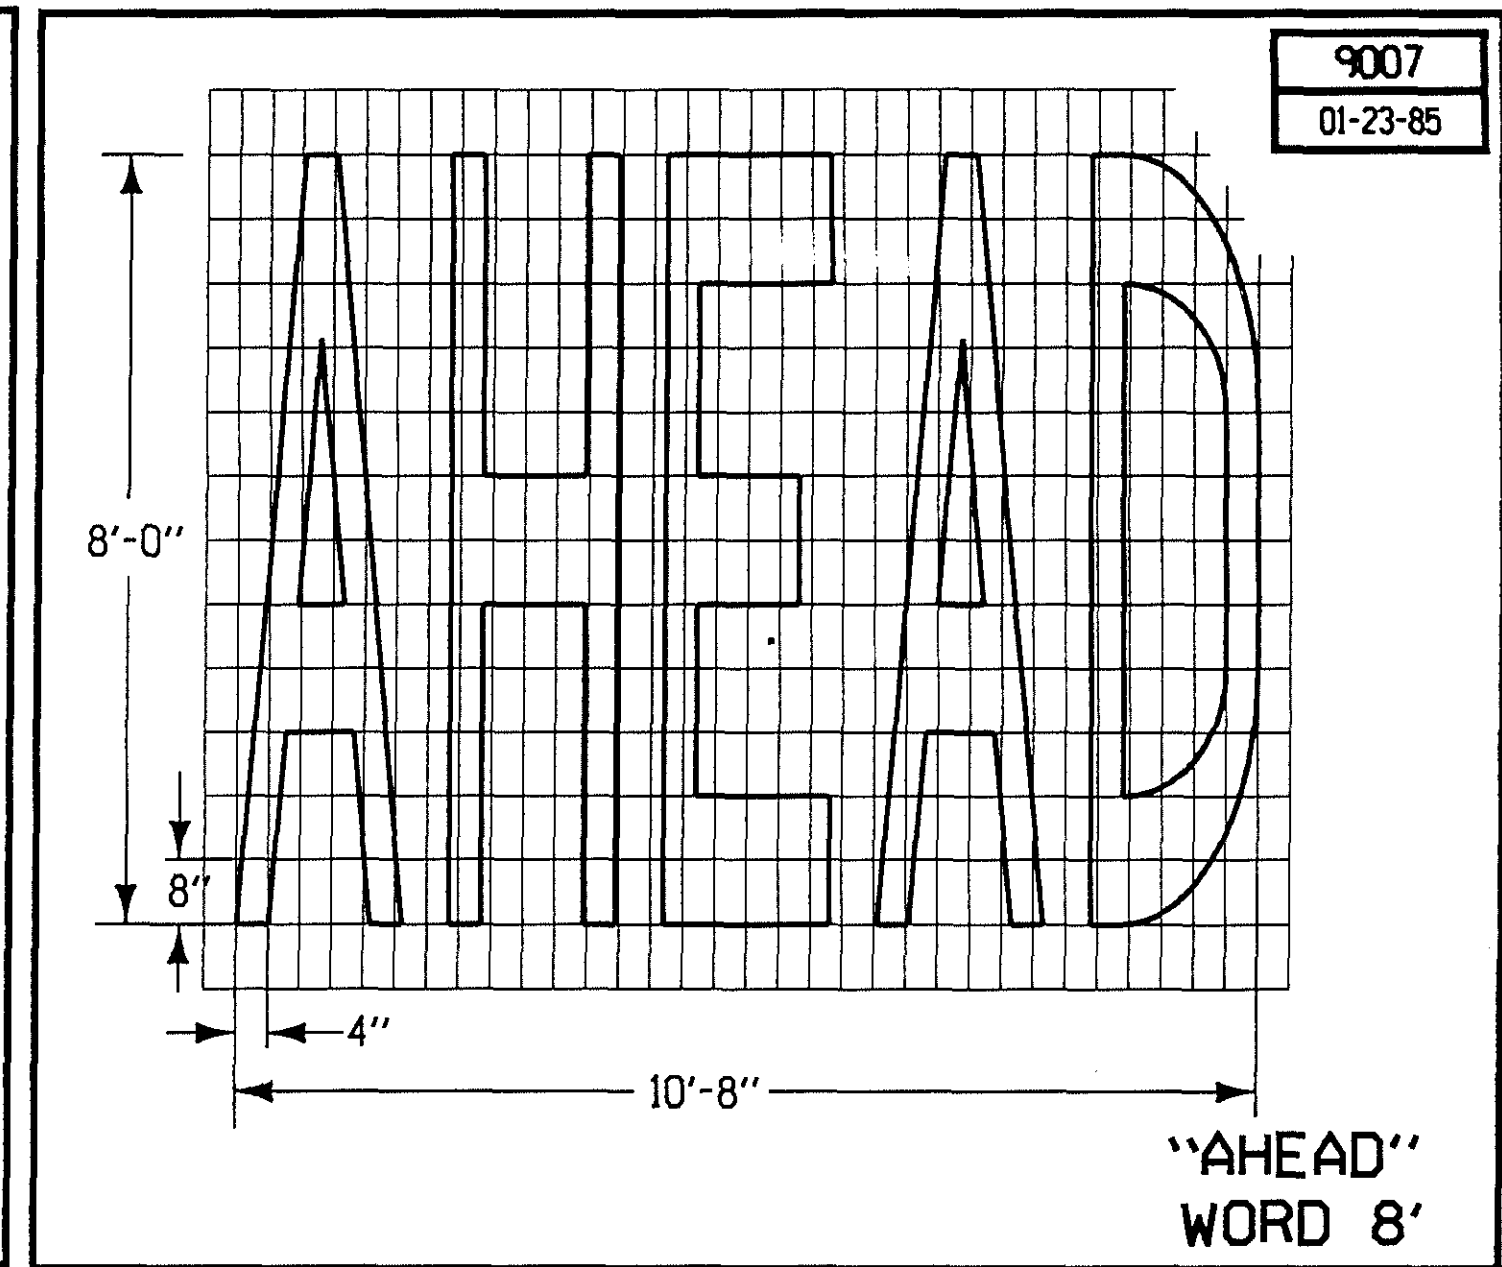

"AHEAD" WORD 8'

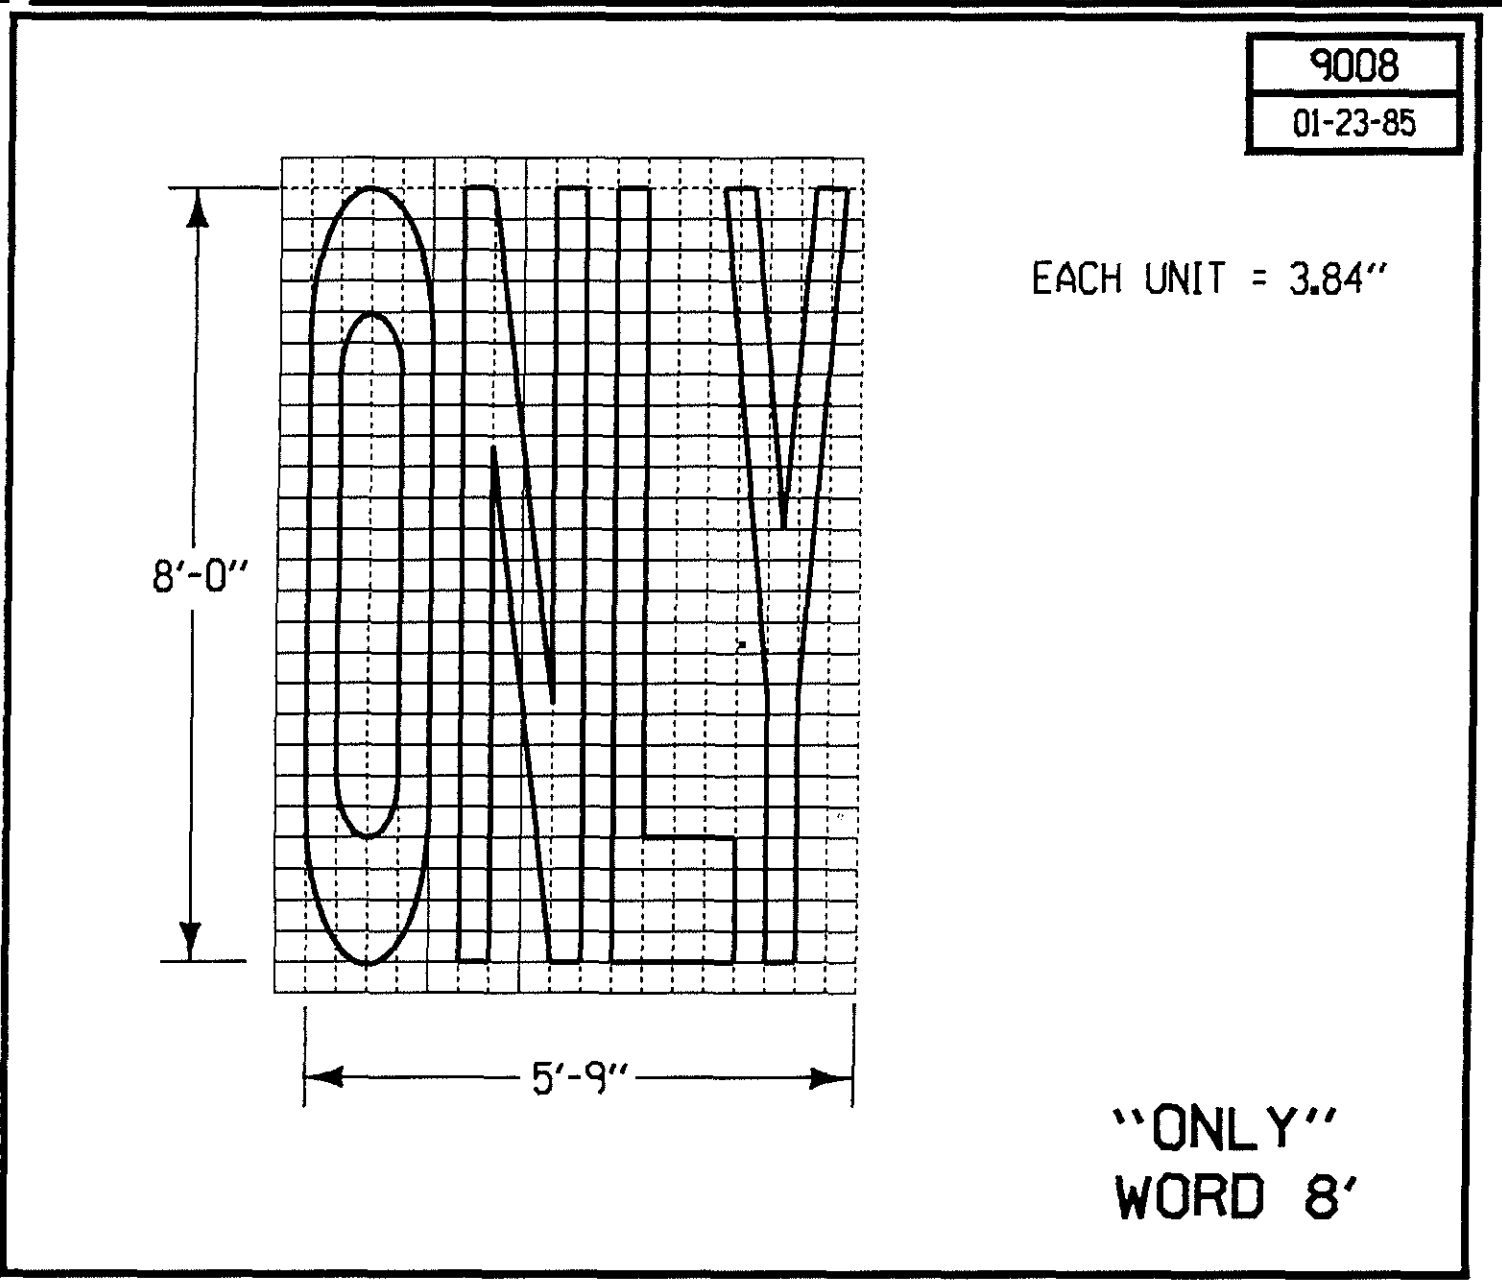

"ONLY" WORD 8'

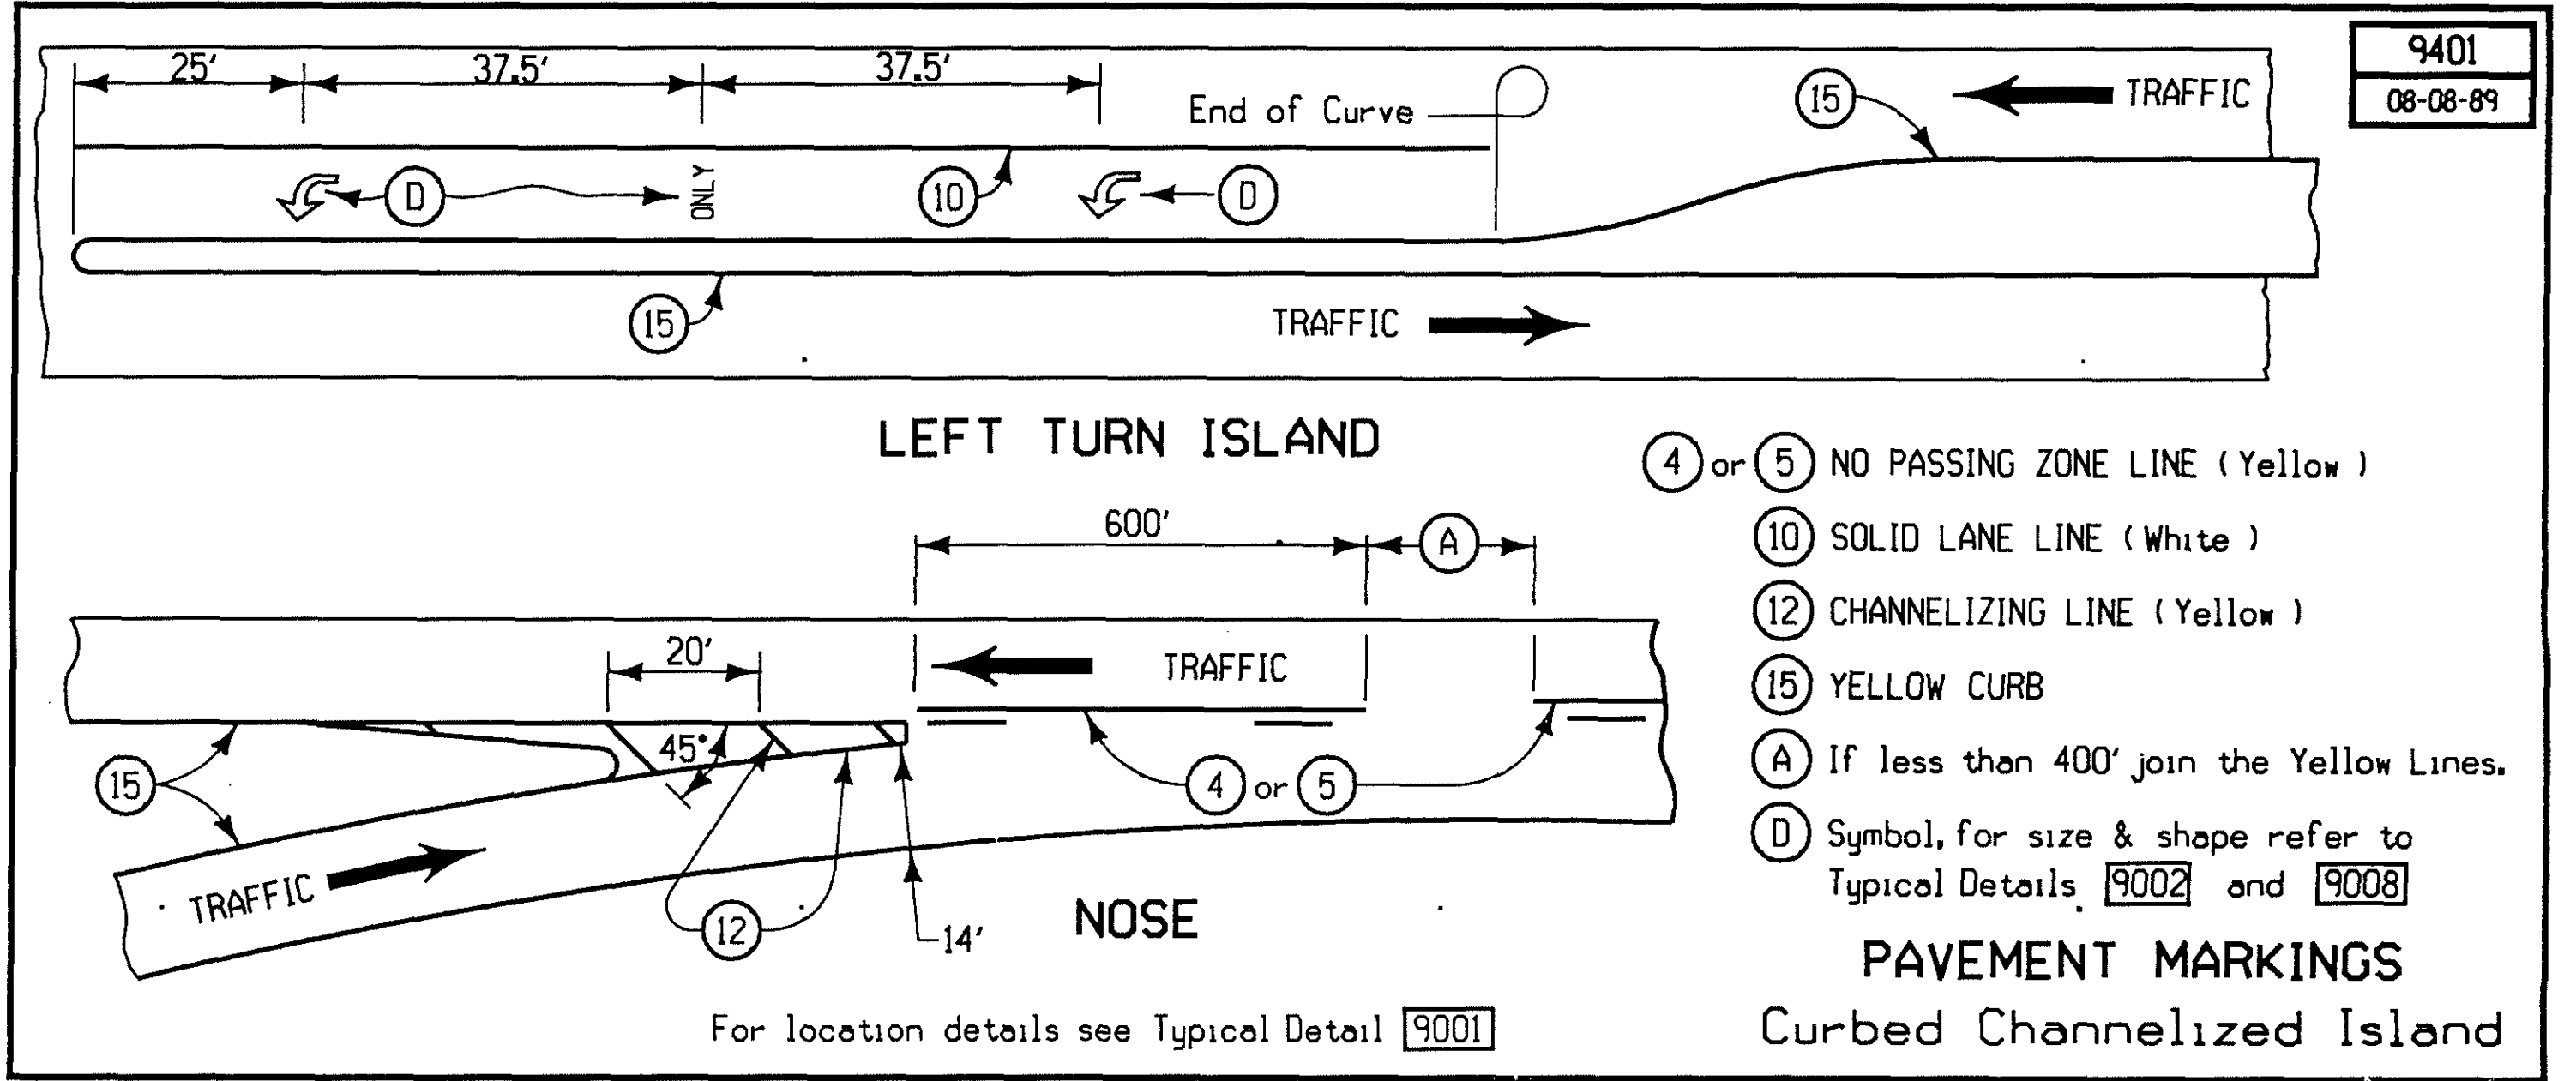

LEFT TURN ISLAND

NOSE

PAVEMENT MARKINGS Curbed Channelized Island

P.11

100-1C
03-29-94

NOTE: QUANTITIES LISTED IN DIVISION 3 ARE CITY OF MARION PARTICIPATION QUANTITIES.

P. 12

ESTIMATE REFERENCE INFORMATION		100-4 03-29-94
Data listed below is for informational purpose only and shall not constitute a basis for any extra work orders.		
ITEM CODE	DESCRIPTION	
2102-0425048	Backfill, Selected, Sand For use as treatment on Tama St. and is available from stockpile as designated by the engineer. Refer to Tab. Form 103-3 on Sheet C.09 for details.	
2102-0425050	Backfill, Selected, Soil Refer to Tab. Form 103-3 on Sheet C.09 for details.	
2102-0425070	Backfill, Special Refer to Tab. Form 103-3 on Sheet C.09 for details, required 288 tons of material for sand subgrade treatment and 1527 tons for paved shoulders (see Typical 7127 on Sheet B.04). Also requires 1114 tons for bridge approach section considered incidental to that item.	
2102-2710070	Class 10 Excavation, Roadway & Borrow Includes 38,658 cu. yds. of material to be wasted by the contractor as per Standard Notation 213-1. No payment for overhaul of material to be wasted will be allowed. Includes 124 cu. yds. of material for grading at guardrail installations and 306 cu. yds. for "Earth Shoulder Construction" at detour at south end of East Post Road. Material is available from the borrow area or from material to be wasted as directed by the engineer. No payment for overhaul will be allowed.	
2105-8425011	Topsoil, Spreading Refer to Tab. Form 103-4 for details. Material is available from the stockpile in the Tama St. vicinity as designated by the engineer.	
2107-0875100	Compaction with Moisture Control Refer to Tab. Form 103-6 for details.	
2108-5025000	Overhaul Includes 855 sta. yds. calculated from a mass diagram and 27546 sta. yds. by assuming a center of mass of the borrow area.	

ESTIMATE REFERENCE INFORMATION		100-4 03-29-94
Data listed below is for informational purpose only and shall not constitute a basis for any extra work orders.		
ITEM CODE	DESCRIPTION	
2109-8225100	Special Compaction of Subgrade Refer to Typical 2612 on Sheet B.05 for details. Includes 4.28 Sta's for detour at south end of East Post Rd. & 2.50 Sta's at north end of East Post Rd.	
2111-8174100	Granular Subbase Refer to "Spec. Typ. #1 on Sheet B.01 for details. For placement under Ia. #100 & East Post Road paving. Includes 63,520 tons in Div. 1 & 15,991 tons in Div. 2.	
2213-6745500	Removal of Curb. For detour at north end of East Post Road. See Sheet F.03.	
2121-7425010	Type A Granular Shoulders Includes 22,372 cu. yds. (Div. 1) & 6,164 cu. yds. (Div. 2) of earth shoulder fill which shall be considered incidental. Material is available from the borrow area or from material to be wasted as directed by the engineer. No payment for overhaul will be allowed.	
2122-5190006	7" P.C. Conc. Paved Shoulders Refer to Typical 7127 for details. Requires 1527 tons of "Special Backfill". Rumble strips (RH-41D) will not be required.	
2123-7450000	Earth Shoulder Construction For detours @ south end of East Post Road and requires 306 cu. yds. which is included in the Class 10. Refer to Typical 2612 for details.	
2123-745020	Earth Shoulder Finishing For use in areas with curb and requires 3,240 cu. yds. of material which has a 60% shrinkage factor included and is available from the borrow area or from material to be wasted as directed by the engineer. No payment for overhaul will be allowed.	

ESTIMATE REFERENCE INFORMATION		100-4 03-29-94
Data listed below is for informational purpose only and shall not constitute a basis for any extra work orders.		
ITEM CODE	DESCRIPTION	
2301-0685100	Bridge Approach Section Refer to Tab. Form 112-6 on Sheet C.07 for details.	
2301-4875006	6" P.C. Median Concrete Requires 6929 tons of Granular Material in Div. 1 & 1795 tons of Granular Material in Div. 2 which shall be considered incidental to the bid item. Refer to Typical 6140 Modified for details. Also includes stop sign islands.	
2301-5162310	10" Class 3 P.C. Conc., Stand. or Slip Form Requires skewed CD Joints and Class 3 aggregate durability. Ia. 100 mainline only will require Class 3I aggregate. Includes 130,507 sq. yds. of mainline pavement and 18,484 sq. yds. of sideroad paving (East Post Road).	
2301-5163385	8.5" Class 3 P.C. Conc., Stand. or Slip Form. Requires skewed CD Joints and Class 3 aggregate durability.	
2312-8260051	Class A Crushed Stone on Road Includes 94 tons for sideroads estimated @ the rate of 400 tons per mile and 54 tons estimated @ the rate of 10 tons per sta. length of entrance.	
2399-5145000	Detour Pavement Refer to Typical 2612 Modified on Sheet B.05 for details. Includes 250' of 6" curb which shall be considered incidental to the bid item.	
2402-2720100	Class 20 Excavation Refer to Tab Form 104-3 on Sheet C.08 for details.	

ESTIMATE REFERENCE INFORMATION		100-4 03-29-94
Data listed below is for informational purpose only and shall not constitute a basis for any extra work orders.		
ITEM CODE	DESCRIPTION	
2416-1400024 2416-0125024	24" Conc. Roadway Pipe, Install Only & Apron Refer to Tab. Form 104-3 on Sheet C.08 for details.	
2422-0360024	Aprons, Unclassified, 24". Refer to Tab. Form 102-3 on Sheet C.07 for details.	
2422-1722024	Culvert, Unclassified Entrance Pipe, 24". Refer to Tab. Form 102-3 on Sheet C.07 for details.	
2502-8212024	4" Longitudinal Backslope Subdrain. Requires 50 cu. yds. of porous backfill which shall be considered incidental to the bid item. Refer to Tab. Form 104-9 on Sheet C.09 for details.	
2502-8212034	4" Longitudinal Shoulder Subdrain. Refer to Tab. Form 104-9 on Sheet C.10-C.13 for details. Requires 4419 cu. yds. of porous backfill and 106 cu. yds. of Class A Crushed Stone which shall be considered incidental to the bid item.	
2502-8220196	RF-19E Subdrain Outlet. Refer to Tab. Form 104-9 on Sheet C.10-C.13 for details.	
2502-8220105	Subdrain Outlet, As Per Plan Refer to Tab. Form 104-9 on Sheet C.09 for details.	

ROADWAY DESIGN

I hereby certify that this plan was prepared under my supervision and that engineering decisions with regard to the design were made by me or by other duly Registered Professional Engineers under the laws of the State of Iowa.

Name *Daniel E. Ohman*

Iowa Registration No. *10267* Date *4/28/94*

OFFICE OF DESIGN • CADD • PRODUCED

STATE OF IOWA

FHWA REGION 7

FISCAL YEAR

LINN

COUNTY

PROJECT NUMBER

NHS-100-1(23)--19-57

SHEET NUMBER

C.02

P.13

ESTIMATE REFERENCE INFORMATION	
Data listed below is for informational purpose only and shall not constitute a basis for any extra work orders.	
ITEM CODE	DESCRIPTION
2503-4400000	Intake, Top Only, As Per Plan Refer to Tab. Form 104-5A on Sheet C.06 and Sheets U.01 and U.02 for details.
2503-4450083	RA-8 Intake, Top Only Refer to Tab. Form 104-5A on Sheet C.06 for details.
2505-4020152 2505-4020250 2505-4020251 2505-4020400 2505-4021690	Steel Beam Guardrail Items Refer to Tab. Form 108-8A on Sheet C.07 for details.
2510-6745575	Removal of Detour Refer to Typ. 2108 (Tama St. detour) on Sheet B.03 and Typ. 2612 Modified on Sheet B.05 for details. Refer to Standard Notation 213-1 & 213-7 on Sheet C.05 for additional information. Includes removal of 1141 sq. yds. of detour pavement at south end of East Post Rd. and 201 sq. yds. at north end.
2510-6745850	Removal of Pavement Refer to Tab. Form 102-5 and 110-1 on Sheet C.06 for details. Refer to Standard Notations 213-1 & 213-7 on Sheet C.05 for additional information. Includes 511 lin. ft. of full depth saw cut which shall be considered incidental to the bid item.
2511-6745900	Removal of Sidewalk Refer to Tab. Form 110-5 on Sheet C.06 for details. Includes 16 lin. ft. of incidental saw cut.

ESTIMATE REFERENCE INFORMATION	
Data listed below is for informational purpose only and shall not constitute a basis for any extra work orders.	
ITEM CODE	DESCRIPTION
2511-7526006	6" P.C. Concrete Sidewalk Refer to Typical 6105 on Sheet B.03 for details. Includes pedestrian curb ramp, see Standard Road Plan RB-6.
2512-1725206	Curb & Gutter, P.C. Concrete, 2.0' For placement at north end of East Post Road between Sta. 1202+58.8 and Sta. 1203+33.0 on right. Refer to Sheet F.03 for further details. Requires 16.5 Sq. yds. P.C. Concrete. Refer to Typical 6131 (Modified) for details.
2515-2475006	6" P.C. Concrete Drives Refer to Tab. Form 102-3 on Sheet C.07 for details.
2515-6745600	Removal of Drives Refer to Tab. Form 110-8 on Sheet C.06 for details. Includes 162 lin. ft. of saw cut which shall be considered incidental to the bid item.
2518-6910000	Safety Closure Refer to Tab. Form 108-13A on Sheet C.06 for details. Adjust in field as necessary as directed by the engineer.
2524-9220030	Type 3 Object Markers Refer to Tab. Form 108-17 on Sheet C.07 for details.
2525-2638030 2525-2638031	Silt Fence & Silt Fence for Ditch Checks Refer to Tab. Form 100-17 & 100-18 on Sheet C.06 for details.

ESTIMATE REFERENCE INFORMATION	
Data listed below is for informational purpose only and shall not constitute a basis for any extra work orders.	
ITEM CODE	DESCRIPTION
2527-9263110 2527-9263180	Pavement Marking Items Includes the following: (Permanent): 4.98 Sta's - Broken Center Line Yellow on P.C.C. 27.54 Sta's - Double Center Line Yellow 19.92 Sta's - No Passing Zone Line on P.C.C. (Yellow) 100.26 Sta's - Broken Lane Line (White) 433.15 Sta's - Edge Line Right (White) 369.68 Sta's - Edge Line Left (Yellow) 24.22 Sta's - Solid Lane Line (White) 35.58 Sta's - Channelizing Line (Yellow) 31.74 Sta's - Stop Line (White) 90.87 Sta's - Yellow Curb 3.48 Sta's - White Curb (Temporary and Removals) (Tape & Paint) White Edge Line 130.36 Sta's, includes 11.71 Sta's of tape to be removed and 38.95 Sta's of paint to be removed. Double Yellow Centerline 124.06 Sta's, includes 21.03 Sta's of tape to be removed and 44.27 Sta's of paint to be removed. No Passing Zone Line 20.50 Sta's, includes 3.20 Sta's of tape to be removed and 17.30 Sta's of paint to be removed. Requires 4.78 Sta's of existing paint removal.
2527-9263140	Painted symbols & Legend (Permanent) 17 Right turn arrows 57 Left turn arrows 39 "Only"
2528-8400051 2528-8400052	Temporary Barrier Rail, Furnish Only Temporary Barrier Rail, Place Only Refer to Detail Sheets J.01 thru J.16 for layout and other details. Includes 1 - 20' section of steel barrier rail (concrete filled).
2528-8400157	Temporary Floodlighting Luminaire For detours at north & south end of East Post Road. See Standard Road Plan RS-8 & Design Detail 570-2 for details.
2528-8400256	Temporary Traffic Signals Refer to Tab. Form 108-28 on Sheet C.07 for details.
2503-8460013	Utility Access, RA-1, Top Only Refer to Tab. Form 104-5A on Sheet C.06 for details.
2599-8580000	Wall, Noise Barrier Refer to Sheets U.11, U.12, and U.13 for details.

ESTIMATE REFERENCE INFORMATION	
Data listed below is for informational purpose only and shall not constitute a basis for any extra work orders.	
ITEM CODE	DESCRIPTION
2601-2632110 2601-2642100 2601-2642120	Fertilizing Fertilizer: Rate - 450 lbs. of 13-13-13 or equivalent chemically combined commercial fertilizer per acre
2601-2632110 2601-2634100	Mulching & Fertilizing Areas disturbed but not seeded with stabilizing crop by September 30 shall be scarified to a 3" depth, fertilized and mulched. All mulch to be consolidated into the soil with the mulch stabilizer.
2601-2634100	Mulch Rate: 1 1/2 tons of dry cereal straw per acre.
2601-2642100	Stabilizing Crop-Seeding & Fertilizing Included for all rural areas of the right of way, including borrow, as designated by the engineer. Seed Mixture (Rural) Spring -- March 1 - May 20 Oats = 2 bu. per acre Annual Ryegrass = 25 lbs. per acre Red Clover = 5 lbs. per acre Timothy = 5 lbs. per acre Summer -- May 21 - July 20 Oats = 3 bu. per acre Annual Ryegrass = 35 lbs. per acre Red Clover = 5 lbs. per acre Timothy = 5 lbs. per acre Fall -- July 21 - September 30 Oats = 2 bu. per acre Annual Ryegrass = 25 lbs. per acre Red Clover = 5 lbs. per acre Timothy = 5 lbs. per acre
2601-2642120	Stabilizing Crop-Seeding & Fertilizing (Urban) Included for all urban areas of the right of way as designated by the engineer. Seed Mixture (Urban) Spring -- March 1 - May 20 Annual Ryegrass = 25 lbs. per acre Bluegrass, Ky. (Park) = 15 lbs. per acre Perennial Ryegrass = 15 lbs. per acre Summer -- May 21 - July 20 Annual Ryegrass = 45 lbs. per acre Bluegrass, Ky. (Park) = 15 lbs. per acre Perennial Ryegrass = 15 lbs. per acre Fall -- July 21 - September 30 Annual Ryegrass = 25 lbs. per acre Bluegrass, Ky. (Park) = 15 lbs. per acre Perennial Ryegrass = 15 lbs. per acre

P.14

108-23
04-04-89

- | |
|----------|
| 108-26A |
| 01-09-90 |

108-26A
01-09-90

01-20-84 Plan and profile sheets included in the project are for the purpose of alignment, location and specific directions for the work to be performed under this contract. Irrelevant data on these sheets is not to be considered a part of this contract.	203-1	09-27-94 Unless otherwise directed or authorized, all asphaltic cement concrete and other bituminous materials which are not specifically addressed or described in the plans shall become the property of the contractor. The contractor, in accordance with current rules and regulations of the Iowa Department of Natural Resources, may: 1. With the approval of the Engineer, blend or otherwise process the material for use with shoulder or special backfill aggregate, for use on the project. 2. With the approval of the Engineer, place with material in areas designated by the Engineer as Soil Aggregate Subbase without extra charge. 3. Remove the material from the project and stockpile for the contractor's future use.	213-7	01-20-84 Where indicated on the plans or when directed by the engineer, existing sewer and drainage pipes which are to be left in place shall be completely blocked with permanent bulkheads composed of either class X concrete or brick masonry. Salvaged brick may be used provided they are sound and meet the approval of the Engineer. This work shall be considered as incidental work and the cost of such removal, disposal and blocking of abandoned sewers and drainage pipes shall be considered to be included in the contract price for other items.	241-2
06-22-84 During construction of this project, the contractor will be required to coordinate his operations with those of other contractors working within the same area. Other work in progress during the same period of the time will include construction of the following projects: Designer to List Projects <u>NHS-100-1(26)--19-57</u> <u>NHS-151-3(95)--19-57</u> <u>NHS-100-1(18)--19-57</u> <u>BRF-100-1(29)--38-57</u> The contractor shall submit to the engineer a schedule for performance of work items, the completion of which is dependent on completion of prior work by other contractors, at the time work begins. This schedule will be coordinated with the schedules of others by the engineer to obtain a schedule that is mutually acceptable. The contractor shall then perform the work as to conform to the accepted schedule.	203-2	01-20-84 Estimated quantity for new concrete pavement includes all integral curb, all street returns and special areas of repairs to connecting pavements.	221-3	01-20-84 Removal of old intakes, other street items necessitating removal, and blocking abandoned sewers and drainage pipes in order to clear the new work shall be considered as incidental work. The cost of such removal, disposal and blocking of abandoned sewers and drainage pipes shall be considered to be included in the contract price for other items.	241-3
09-29-92 The contractor is encouraged to take full advantage of specification 1105.15 - Value Engineering Incentive Proposal. A pamphlet and conceptual proposal form will be available at the preconstruction conference.	203-4	01-20-84 In order to avoid any unnecessary surface breaks or premature spalling, the contractor is cautioned to exercise extreme care when performing any of the necessary saw cutting operations for the proposed pavement removal.	221-4	01-19-88 The contractor shall be responsible to maintain access to individual properties during construction. Relocated access shall be completed to individual properties prior to removal of existing access. If the permanent access cannot be completed prior to removal of the existing access, the contractor shall provide and maintain an alternate access. Temporary Granular Surfacing will be paid for as a contract item or by extra work.	251-1
01-20-84 All holes resulting from operations of the contractor, including removal of guardrail posts, fence posts, utility poles, or foundation studies, shall be filled and consolidated to finished grade as directed by the engineer to prevent future settlement. The voids shall be filled as soon as practical - preferably the day created and not later than the following day. Any portion of the right-of-way or project limits (including borrow areas and operation sites) disturbed by any such operations shall be restored to an acceptable condition. This operation shall be considered incidental to other bid items in project.	204-2	01-20-84 Special care shall be taken when forming at intersections so that the profiles shown on the cross sections and the elevations shown the resident engineer's 10 or 20 scale are obtained. Short lengths of forms or flexible forms may be necessary at these locations.	222-1	06-22-84 The contractor is hereby notified that removal of any existing traffic markers, warning devices or guardrail barriers shall be scheduled subject to the approval of the Engineer. The contractor may be required to place temporary warning devices at certain locations where replacement features are not installed the same day during which any such removals take place.	251-2
01-20-84 Sounding and test boring data shown on plans were accumulated for designing and estimating purposes. Their appearance on the plan does not constitute a guarantee that conditions other than those indicated will not be encountered.	212-1	01-20-84 To obtain the correct form grades at low points where intakes are located, the contractor must exercise extreme care when paving full width pavements. This may require pouring one half of the pavement at a time or other methods approved by the engineer.	222-2	06-22-84 A plan for stage construction of local accesses which are required to remain open to traffic during construction shall be submitted by the contractor for approval by the engineer.	251-3
04-04-89 It shall be the contractor's responsibility to provide waste areas or disposal sites for excess material (excavated material or broken concrete) which is not desirable to be incorporated into the work involved on this project. No payment for overhaul will be allowed for material hauled to these sites. No material shall be placed within the right-of-way, unless specifically stated in the plans or approved by the engineer.	213-1	01-20-84 The contractor shall not disturb desirable grass areas and desirable trees outside the construction limits. The contractor will not be permitted to park or service vehicles and equipment or use these areas for storage of materials. Storage, parking and service area(s) will be subject to the approval of the resident engineer.	232-5	05-10-88 On all new or reconstructed pavements, the location of "NO PASSING" zone lines shall be located in the field. The locations of the proposed "NO PASSING" zone lines shown on the pavement marking tabulation is for estimating quantities only.	251-5
06-22-84 All borrow areas, stockpile areas, haul roads and areas used for equipment on this project will require subsoil tillage to an average depth of 16 inches to 20 inches prior to placement of topsoil and/or stabilizing crop seeding. Such tillage shall be accomplished on maximum of three foot centers and at right angles to the finished slope of the borrow. Equipment used to accomplish the tillage shall be equipped with an arrowhead-type shoe so as to provide lateral displacement and limit the movement of the subsoil to the surface. It shall be approved by the engineer for the use intended. This work will be considered incidental to other work on the project and no payment will be allowed. It is intended that following subsoil tillage, the area remains in a "loosened" condition. Additional compaction or the operation of heavy equipment, other than required for topsoil placement and shaping shall not be allowed on areas which have received subsoil tillage.	213-3	01-09-90 Selective clearing will be required on this project. Any trees outside of the construction limits shall be removed only by the approval of the engineer.	232-6	01-09-90 Blading and shaping as well as any other incidental work in preparation for any maintenance of temporary crossing or detours shall be considered incidental to other work on the project. Additional surfacing needed for temporary crossings or detours during construction shall be furnished and spread at contract price.	252-1
		06-07-94 The top six (6) inches of the disturbed areas shall be free of rock and debris and shall be suitable for the establishment of vegetation, subject to the approval of the Engineer.	232-8	01-20-84 Before performing earthwork, tilling, or excavation within three hundred feet of an existing pipeline, the contractor shall notify the pipeline company and the pipeline company shall mark the location of the pipeline as required by Section 479.47 of the Code of Iowa. The contractor shall exercise all due caution when working in the vicinity of pipelines carrying combustible or toxic materials which are present on this project. Pipeline location shown on the plans represents the best information available at the time of plan preparation.	261-2
		01-20-84 Road contractor is to use due caution in working over and around all tile lines. Breaks in the tile line due to the contractor's carelessness are to be replaced at his expense without cost to the State of Iowa. Any tile lines broken or disturbed by our cut lines will be replaced as directed by the engineer in charge of construction and at the State of Iowa's expense.	241-1		

TABULATION OF SILT FENCES				100-17 11-10-83
STATION TO STATION	SIDE	LIN. FT.	REMARKS	
1122+65 (OR)	1124+00 (OR)	Lt.	135	Tama St.
1124+30 (Sur)	1125+64 (Sur)	Lt.	134	Exist. Tama St
1122+25 (OR)	1125+50 (OR)	Rt.	325	Tama St.
1176+25	1178+00	Rt.	175	East Post Rd.
1181+90	1183+00	Rt.	110	East Post Rd.
1194+00	1199+00	Rt.	500	East Post Rd.

TABULATION OF SILT FENCES FOR DITCH CHECKS				100-18 11-10-83
LOCATION STATION	SIDE	LIN. FT.	REMARKS	
1172+50	Rt.	20'	East Post Rd.	
1178+00	Rt.	10'	East Post Rd.	
1183+00	Rt.	15'	East Post Rd.	
1186+00	Rt.	15'	East Post Rd.	
1189+00	Rt.	20'	East Post Rd.	
1193+00	Rt.	20'	East Post Rd.	
1199+00	Rt.	20'	East Post Rd.	

TABULATION OF SAFETY CLOSURES			108-13A 09-29-92
Refer to Section 2518 of the St'd Specifications			
NO.	STATION	REMARKS	
1	1122+25	Tama St.	
2	1125+75	Existing Tama St.	
3	1202+81 (OR)	East Post Road	
4	2200+50	Meadow View Drive	

LIST OF INTAKES AND UTILITY ACCESSES						104-5A 06-15-93
NUMBER	LOCATION	TYPE OR STANDARD ROAD PLAN	FORM GRADE Elev.	BOTTOM WELL Elev.	NOTE	
1	113+40 - 65' Lt.				Done with grading project	
2	114+00 - 36.5' Lt.	RA-8	47.75	②	Top only-8' curb opening	
3	114+00 - 36.5' Rt.	RA-8	47.75	②	Top only-8' curb opening	
4	117+10 - 68' Lt.	RA-16C	43.50	41.00	Done with grading project	
5	118+00 - 45' Lt.	RA-8	45.71	41.00	Top only-8' curb opening	
6	121+25 - 45' Lt.	RA-8	42.83	38.83	Top only-8' curb opening	
7	124+50 - 45' Lt.	RA-8	37.18	33.18	Top only-8' curb opening	
8	125+25 - 5' Rt.	RA-8	38.06	34.06	Top only-8' curb opening	
9	128+00 - 45' Lt.	RA-8	31.93	27.93	Top only-8' curb opening	
10	128+00 - 5' Rt.	RA-8	33.93	27.65	Top only-8' curb opening	
11	130+70 - 5' Rt.	RA-8	29.88	24.12	Top only-8' curb opening	
12	131+00 - 45' Lt.	RA-8	27.43	21.60	Top only-8' curb opening	
13	133+44 - 2' Lt.	①	25.93	19.93	Top only	
14	135+50 - 5' Rt.	①	22.68	18.68	Top only	
15	159+00 - 5' Rt.	RA-8	86.61	82.61	Top only-8' curb opening	
16	160+20 - 5' Rt.	RA-8	86.94	82.94	Top only-8' curb opening	
17	161+60 - 5' Rt.	RA-8	87.40	83.40	Top only-8' curb opening	
18	164+20 - 5' Rt.	RA-8	88.24	84.24	Top only-8' curb opening	
19	167+20 - 5' Rt.	RA-8	89.13	85.13	Top only-8' curb opening	
20	205+75 - 45' Lt.	RA-8	70.64	65.83	Top only-12' curb opening	
21	208+75 - 45' Lt.	RA-8	64.37	60.37	Top only-12' curb opening	
22	211+75 - 45' Lt.	RA-8	56.81	52.81	Top only-12' curb opening	
23	212+73.5 - 47.25' Lt.	RA-1	54.40	49.78	Top only	
24	212+73.5 - 5' Rt.	RA-8	55.25	51.25	Top only-12' curb opening	
25	214+91 - 2' Lt.	①	50.06	46.06	Top only	
26	215+06.5 - 45' Lt.	RA-8	48.59	42.59	Top only-10' curb opening	
27	218+50 - 5' Rt.	RA-8	41.39	37.39	Top only-12' curb opening	
28	219+50 - 5' Rt.	RA-8	39.27	35.27	Top only-12' curb opening	
29	221+00 - 5' Rt.	RA-8	36.43	32.43	Top only-12' curb opening	
30	222+25 - 5' Rt.	RA-8	34.37	30.37	Top only-12' curb opening	
31	223+50 - 5' Rt.	RA-8	32.57	28.57	Top only-12' curb opening	
32	224+75 - 5' Rt.	RA-8	30.82	26.82	Top only-12' curb opening	
33	226+00 - 5' Rt.	RA-8	29.09	25.09	Top only-12' curb opening	
34	1127+50 - 15.5' Lt.	RA-8	37.79	33.79	Top only-16' curb opening	
35	1127+50 - 15.5' Rt.	RA-8	37.79	32.97	Top only-12' curb opening	
36	1128+50 - 17.75' Rt.	RA-1	30.38	24.77	Top only	
37	1129+38 - 15.5' Lt.	RA-8	26.09	22.09	Top only-8' curb opening	
38	1129+38 - 15.5' Rt.	RA-8	26.09	20.01	Top only-8' curb opening	
① See Sheet U.01 & U.02		② By Others				

REMOVAL OF PAVEMENT				110-1 07-21-87
STATION TO STATION	AREA Sq. Yds.	SAW CUT Lin. Ft.	REMARKS	
1174+00.00(Sur)	1202+80.75	8413	66'	East Post Road
2200+54	2200+75	98	27'	Meadow View Dr.
1202+58.80(Sur)	1203+33(Sur)	47	74'	East Post Road Curb &Gutter on Rt.

REMOVAL OF CONCRETE DRIVES				110-8 04-18-80
LOCATION	AREA	REMARKS		
Station	Side	Sq. Yds.		
1122+51(Tama St)	Lt.	142	Requires 12' of saw cut	
1124+19(Tama St)	Lt.	99	Requires 14' of saw cut	
1125+04(Tama St)	Rt.	116'	Requires 8' of saw cut	
1185+88(E Post Rd)	Rt.	69	Requires 10' of saw cut	
1188+41(E Post Rd)	Rt.	103	Requires 12' of saw cut	
1190+36(E Post Rd)	Rt.	310	Requires 16' of saw cut	
1200+43.3(E Post)	Lt.	170	Requires 43' of saw cut	
1202+14.1(E Post)	Lt.	92	Requires 23' of saw cut	
1202+36.2(E Post)	Rt.	40	Requires 24' of saw cut	

TABULATION OF SIDEWALK REMOVAL				110-5 10-13-72
STATION TO STATION	AREA Sq. Yds.	REMARKS		
1202+00	1202+69	31	East Post Road	
2200+70-Backcurb	Lt. 8'	4	Meadow View Drive	
2200+56-27' Lt	2200+66-27' Lt	5	Meadow View Drive	
1200+36	1200+45	5	East Post Rd.	

TABULATION OF PEDESTRIAN CURB RAMPS				112-4 09-23-86
LOCATION	SIDE	TYPE	Ⓜ	
2200+70	Lt.	A	4'	
Meadow View Drive				

TABULATION OF SPECIAL EVENTS			102-15 10-22-93
EVENT	LOCATION	DATE	
Contact East Central Transportation Center			

TABULATION OF EXISTING PAVEMENT									102-5 02-23-93
NO.	LOCATION	EXISTING PAVEMENT Type	COARSE AGGREGATE			PAVEMENT THICKNESS Inches	REINFORCEMENT Type	DETAIL TYPICAL	
			TYPE GRAVEL	CRUSHED STONE	SOURCE				
1	East Post Road	ACC	*	*	*	4"	Unknown*	*	
		AC-PCC	*	*	*	4"AC-*	Unknown*	*	
2	Meadow View Dr.	27'PCC	*	*	*	6"PCC	Unknown*	*	

Special Ditch Controls				
Wood Excelsior Mat				
Location	Side	Length	Width	Squares
140+00 to 145+00	Rt	500	16	80
145+25 to 148+00	Rt	275	16	44
139+00 to 139+80	Lt	80	8	6.4
139+80 to 140+40	Lt	80	16	9.6
142+60 to 144+40	Lt	180	4	7.2
142+80 to 144+05	Lt	125	8	10
282+20 to 284+10	Lt	190	20	38
284+10 to 284+75	Lt	65	36	23.4
284+75 to 285+63	Lt	88	32	28.2
4282+20 to 4285+20	Lt	300	8	24
4283+40 to 4286+27	Rt	287	12	34.4
285+63 to 286+30	Lt	67	32	21.4
286+30 to 287+55	Lt	125	24	30
287+55 to 288+55	Lt	100	28	28
288+55 to 289+00	Lt	45	24	10.8
288+95 to 291+40	Rt	245	12	29.4

Silt Basins			Rock Ditch checks and Flumes			
Locations	Side	Count	Locations	Side	Engineering Fabric Erosion Stone Rip Rap	
209+00	Rt	1		S. Y.	Tons	Tons
170+00	Lt	2	172+00	Lt	179.17	15.55
170+00	Rt	1	160+00	Lt	81.67	47.37
145+10	Lt	1	165+00	Lt	48.33	31.46
126+00	Rt	1	156+20	Lt	81.67	32.94
190+00	Rt	1	158+40	Lt	81.67	32.05
209+00	Rt	1	138+20	Rt	41.67	
137+10	Lt	1	141+20	Rt	41.67	46.41
240+00	Rt	1	141+50	Lt	66.67	15.64
241+00	Rt	1	143+20	Lt	66.67	14.41
292+00	Rt	1	143+20	Rt	66.67	
292+00	Lt	1	147+30	Rt	66.67	40.01
295+00	Rt	1	144+10	Lt	66.67	15.51
299+00	Rt	1	128+10	Rt	41.67	15.3
			145+10	Lt	105	
			148+00	Rt	166.67	
			172+00	Lt	75	
			160+10	Rt	66.67	78.67
			162+00	Lt	96.67	31.44
			150+10	Rt	48.33	38.11
			145+00	Lt	36.67	15.05
			193+00	Rt	33.33	29.29
			191+10	Rt	33.33	13.67
			188+70	Rt	33.33	13.67
			216+20	Rt	81.67	30.68
			209+00	Rt	35	16.16
			221+00	Rt	71.67	49.78
			229+00	Rt	40	16.28
			245+00	Rt	41.67	30.97
			4283+40	Rt	33.33	11.5
			4284+25	Rt	33.33	11.5
			4284+90	Rt	33.33	11.5

Silt Fence Removal		
Location	Side	Length
135+50	Rt	20
137+00	Rt	20
138+00	Rt	20
140+00	Rt	25
141+00	Rt	25
142+50	Rt	25
144+50	Rt	20
146+00	Rt	20
147+50	Rt	20
139+50	Lt	25
141+00	Lt	25
142+50	Lt	25
144+00	Lt	25
224+00	Rt	20
153+00 to 161+60	Rt	890
208+25 to 209+00	Lt	80
287+00 to 289+50	Lt	240
289+55 TO 290+20	Lt	160

P.17

01-07-92

* Not a bid item

1101
07-21-87



Name Bradley C. Barnett
Iowa Registration No. 11108 Date 4/26/95

P. 19

PROPOSED SUBGRADE TREATMENT													103-3
(For Additional Details see Soils Survey Sheet No. 0.01 to 0.04)													06-07-94
NO.	LOCATION		DESCRIPTION			TYPE		QUANTITY		POLYMER GRID Sq. Yds.	AVAILABLE FROM		REMARKS
	Station to Station		Side	Depth	Width	Material + Shrink %		Cu. Yds.	Tons		Quantity	Station to Station	
1	1122+50	- 1125+50	Both	2'	Trench	Loam F+15%		1095			7887	Borrow A	
2	186+00	- 187+91	Lt.	2'	Trench	Loam F+15%		512			7887	Borrow A	
3	186+00	- 187+91	Rt.	2'	Trench	Loam F+15%		512			7887	Borrow A	
4	1174+00	- 1186+90.62	Both	2'	Trench	Loam F+15%		4311			7887	Borrow A	
5	1187+01.22	- 1202+80.75	Both	2'	Trench	Loam F+15%		2552			7887	Borrow A	
6	1183+00	- 1185+40	Both	2	Trench	Loam F+15%		675			7887	Borrow A	
7	1187+98	- 1193+00	Both	2	Trench	Loam F+15%		460			7887	Borrow A	
8	255+30	- 258+29	4 Turn Lw.	2	Trench	Loam F+15%		113			7887	Borrow A	
	1122+50 - 1125+50		Both	1	35	Special Backfill				116.67		crushed ACC	
	1125+50 - 1125+63		Both	1	29	Special Backfill				204.61		crushed ACC	

① Refer to Standard Road Plan RF-19C.														104-9	
② Refer to Soils Sheets														09-29-92	
TABULATION OF LONGITUDINAL SUBDRAIN SHOULDER AND BACKSLOPE														*Not a bid item	
LOCATION					LONGITUDINAL SUBDRAIN				CMP SUBDRAIN OUTLET RF-19E or RF-22			POROUS * BACKFILL	Class 'A' * Crushed Stone	REMARKS	
Line No.	Road or Lane Ident.	Station to Station		Side	Depth ①	Shoulder ①		Backslope ②		Station Size Type			Cu. Yds.		Cu. Yds.
					Inch.	Size	Lin. Ft.	Size	Lin. Ft.						
1	E POST	1188+86	1192+86	RT	66			4"	407'	1192+86	6"	A	50		RF-19C, Type 11 Installation

TABULATION OF SPREADING TOPSOIL												103-4
												02-12-82
PLACEMENT DESCRIPTION												
AREA No.	QUANTITY Cu. Yds.	LOCATION Station to Station		SIDE L. or R.	SLOPE B. or F.	① In.	TOPSOIL EXCAVATION AVAILABLE FROM Station to Station		REMARKS			
1	1889	1122+50	1125+50	L & R	B & F	12"			Available from stockpile designated by the engineer			
2	14408.8	Borrow "A"	231+75 to 241+65	RT		12"			Extra work order 8020			

EMBANKMENT WITH MOISTURE CONTROL					103-6
					05-22-81
Moisture content shall be within the limits of minus 1 and plus * percentage points of optimum for maximum density within the area described and listed below. * No Upper Limit					
LOCATION		DEPTH	COMPACT	REMARKS	
Station to Station	Lane	Feet	Cu. Yds.		
1122+50 to 1125+50	Both	1'	548	Tama St.	

GEOTECHNICAL DESIGN

I hereby certify that this plan was prepared under my supervision and that geotechnical decisions with regard to the design were made by me or by other duly Qualified Professional Geologists under the laws of the State of Iowa.

Name Kenneth L. Osler

Date 1/27/95

P.20

① Refer to Standard Road Plan RF-19C. ② Refer to Soils Sheets															104-9 09-29-92	
TABULATION OF LONGITUDINAL SUBDRAIN SHOULDER AND BACKSLOPE																
*Not a bid item																
LOCATION					LONGITUDINAL SUBDRAIN				CMP SUBDRAIN OUTLET RF-19E or RF-22			POROUS * BACKFILL	Class 'A' * Crushed Stone	REMARKS		
Line No.	Road or Lane Ident.	Station to Station	Side	Depth ①	Shoulder ①		Backslope ②		Station	Size	Type	Cu. Yds.	Cu. Yds.			
				Inch.	Size	Lin. Ft.	Size	Lin. Ft.								
2	EBL	116+69	120+00	RT	36	4"	370			116+69	6"	E	42.4	0.5		
										120+00	6"	E		0.5		
3	EBL	120+00	123+00	RT	36	4"	348			120+00	6"	E	27.0	0.5		
										123+00	6"	E		0.5		
4	EBL	122+00	125+25	LT	24	4"	326			125+25	6"	C	17.4	0.5	INTO INTAKE, MEDIAN SIDE, CAP DRAIN @ 122+00.	
5	EBL	125+25	128+00	LT	24	4"	260			125+25	6"	C	15.0	0.5	INTO INTAKES, MEDIAN SIDE.	
										128+00	6"	E		0.5		
6	EBL	128+00	131+20	LT	24	4"	324			128+00	6"	C	14.8	0.5	INTO INTAKES, MEDIAN SIDE.	
										131+20	6"	E		0.5		
7	EBL	131+20	133+44	LT	24	4"	224			131+20	6"	C	15.0	0.5	INTO INTAKES, MEDIAN SIDE.	
										133+44	6"	E		0.5		
8	EBL	133+44	135+50	LT	24	4"	215			133+44	6"	C	11.9	0.5	INTO INTAKES, MEDIAN SIDE.	
										135+50	6"	E		0.5		
9	EBL	135+50	136+65	LT	24	4"	151			135+50	6"	C	7.6	0.5	INTO INTAKES @ 135+50, MEDIAN SIDE	
										136+65	6"	E		0.5	INSTALL 19-E OUTLET @ 136+65, MEDIAN SIDE.	
10	EBL	136+85	142+00	RT	42	4"	566			136+85	6"	E	52.3	0.5		
										142+00	6"	E		0.5		
11	EBL	142+00	145+30	RT	42	4"	350			142+00	6"	E	32.4	0.5		
										145+30	6"	E		0.5		
12	EBL	145+30	149+70	RT	42	4"	497			145+30	6"	E	48.1	0.5		
										149+70	6"	E		0.5		
13	EBL	156+46	160+00	RT	42	4"	423			156+46	6"	E	41.7	0.5		
										160+00	6"	E		0.5		
14	EBL	159+00	164+20	LT	24	4"	513			159+00	6"	C	26.4	0.5	INTO INTAKES, MEDIAN SIDE.	
										164+20	6"	E		0.5		
15	EBL	164+20	167+20	LT	24	4"	294			164+20	6"	C	16.2	0.5	INTO INTAKES, MEDIAN SIDE.	
										167+20	6"	E		0.5		
16	EBL	166+00	171+00	RT	42	4"	563			166+00	6"	E	50.9	0.5		
										171+00	6"	E		0.5		
17	EBL	171+00	176+00	RT	42	4"	547			171+00	6"	E	50.9	0.5		
										176+00	6"	E		0.5		
18	EBL	176+00	181+00	RT	42	4"	587			176+00	6"	E	50.9	0.5	EQUATION	
										181+00	6"	E		0.5		
19	EBL	181+00	185+67	RT	42	4"	527			181+00	6"	E	50.9	0.5		
										185+67	6"	E		0.5		
20	EBL	185+67	191+00	RT	42	4"	582			185+67	6"	E	50.9	0.5		
										191+00	6"	E		0.5		
21	EBL	191+00	196+00	RT	42	4"	550			191+00	6"	E	50.9	0.5		
										196+00	6"	E		0.5		
22	EBL	196+00	201+00	RT	42	4"	550			196+00	6"	E	50.9	0.5		
										201+00	6"	E		0.5		
23	EBL	201+00	206+00	RT	42	4"	548			201+00	6"	E	50.9	0.5		
										206+00	6"	E		0.5		
24	EBL	206+00	208+90	RT	42	4"	338			206+00	6"	E	31.5	0.5		
										208+90	6"	E		0.5		
25	EBL	209+10	213+00	RT	42	4"	438			209+10	6"	E	40.7	0.5		
										213+00	6"	E		0.5		
26	EBL	212+73	218+50	LT	24	4"	583			212+73	6"	C	29.0	0.5	INTO INTAKES, MEDIAN SIDE.	
										218+50	6"	E		0.5		
27	EBL	218+50	223+50	LT	24	4"	505			218+50	6"	C	25.5	0.5	INTO INTAKES, MEDIAN SIDE.	
										223+50	6"	E		0.5		
28	EBL	223+50	226+00	LT	24	4"	256			223+50	6"	C	13.9	0.5	INTO INTAKES, MEDIAN SIDE.	
										226+00	6"	E		0.5		
29	EBL	225+00	230+00	RT	42	4"	554			225+00	6"	E	50.9	0.5		
										230+00	6"	E		0.5		
30	EBL	230+00	235+00	RT	42	4"	571			230+00	6"	E	50.9	0.5		
										235+00	6"	E		0.5		
31	EBL	235+00	240+00	RT	42	4"	550			235+00	6"	E	50.9	0.5		
										240+00	6"	E		0.5		
32	EBL	240+00	245+00	RT	42	4"	552			240+00	6"	E	50.9	0.5		
										245+00	6"	E		0.5		
33	EBL	245+00	250+00	RT	42	4"	552			245+00	6"	E	50.9	0.5		
										250+00	6"	E		0.5		
34	EBL	250+00	253+30	RT	42	4"	386			250+00	6"	E	35.2	0.5		
										253+30	6"	E		0.5		
35	EBL	253+60	258+00	RT	42	4"	480			253+60	6"	E	45.4	0.5		
										258+00	6"	E		0.5		
36	EBL	258+00	263+00	RT	42	4"	550			258+00	6"	E	50.9	0.5		
										263+00	6"	E		0.5		

P.21

- ① Refer to Standard Road Plan RF-19C.
② Refer to Soils Sheets

TABULATION OF LONGITUDINAL SUBDRAIN
SHOULDER AND BACKSLOPE

*Not a bid item
104-9
09-29-92

LOCATION					LONGITUDINAL SUBDRAIN					CMP SUBDRAIN OUTLET RF-19E or RF-22			POROUS * BACKFILL	Class 'A' * Crushed Stone	REMARKS
Line No.	Road or Lane Ident.	Station to Station		Side	Depth ①	Shoulder ①		Backslope ②		Station	Size	Type	Cu. Yds.	Cu. Yds.	
					Inch.	Size	Lin. Ft.	Size	Lin. Ft.						
37	EBL	263+00	268+00	RT	42	4"	561			263+00	6"	E	50.9	0.5	
										268+00	6"	E		0.5	
38	EBL	268+00	273+00	RT	42	4"	564			268+00	6"	E	50.9	0.5	
										273+00	6"	E		0.5	
39	EBL	273+00	278+00	RT	42	4"	455			273+00	6"	E	50.9	0.5	
										278+00	6"	E		0.5	
40	EBL	278+00	283+00	RT	42	4"	550			278+00	6"	E	50.9	0.5	
										283+00	6"	E		0.5	
41	EBL	283+00	288+90	RT	42	4"	634			283+00	6"	E	59.3	0.5	
										288+90	6"	E		0.5	
42	EBL	289+10	294+00	RT	42	4"	530			289+10	6"	E	50.0	0.5	
										294+00	6"	E		0.5	
43	EBL	294+00	299+00	RT	42	4"	566			294+00	6"	E	50.9	0.5	
										299+00	6"	E		0.5	
44	EBL	299+00	304+00	RT	42	4"	555			299+00	6"	E	50.9	0.5	
										304+00	6"	E		0.5	
45	EBL	304+00	306+00	RT	42	4"	252			304+00	6"	E	23.1	0.5	
										306+00	6"	E		0.5	
47	WBL	116+69	118+00	LT	24	4"	141			116+69	6"	C	20.8	0.5	
										118+00	6"	E		0.5	
48	WBL	118+00	121+25	LT	24	4"	333			118+00	6"	C	17.4	0.5	INTO INTAKES.
										121+25	6"	E		0.5	
49	WBL	121+25	124+50	LT	24	4"	328			121+25	6"	C	17.4	0.5	INTO INTAKES.
										124+50	6"	E		0.5	
50	WBL	124+50	128+00	LT	24	4"	342			124+50	6"	C	18.5	0.5	INTO INTAKES.
										128+00	6"	E		0.5	
51	WBL	128+00	131+00	LT	24	4"	314			128+00	6"	C	16.2	0.5	INTO INTAKES.
										131+00	6"	E		0.5	
52	WBL	131+20	133+15	LT	24	4"	208			131+20	6"	C	12.3	0.5	INTO INTAKE @ 131+00.
										133+15	6"	E		0.5	INSTALL 19-E OUTLET @ 133+15.
53	WBL	133+35	136+65	LT	42	4"	385			133+35	6"	E	35.2	0.5	
										136+65	6"	E		0.5	
54	WBL	136+85	142+00	LT	42	4"	569			136+85	6"	E	52.3	0.5	
										142+00	6"	E		0.5	
55	WBL	142+00	147+00	LT	42	4"	548			142+00	6"	E	50.9	0.5	
										147+00	6"	E		0.5	
56	WBL	147+00	149+70	LT	42	4"	329			147+00	6"	E	32.4	0.5	
										149+70	6"	E		0.5	
57	WBL	156+46	161+00	LT	42	4"	520			156+46	6"	E	50.9	0.5	
										161+00	6"	E		0.5	
58	WBL	161+00	166+00	LT	42	4"	540			161+00	6"	E	50.9	0.5	
										166+00	6"	E		0.5	
59	WBL	166+00	170+90	LT	42	4"	530			166+00	6"	E	50.0	0.5	
										170+90	6"	E		0.5	
60	WBL	171+10	176+00	LT	42	4"	537			171+10	6"	E	50.0	0.5	
										176+00	6"	E		0.5	
61	WBL	176+00	181+00	LT	42	4"	597			176+00	6"	E	50.9	0.5	
										181+00	6"	E		0.5	
62	WBL	181+00	185+06	LT	42	4"	452			181+00	6"	E	46.3	0.5	
										185+00	6"	E		0.5	
63	WBL	185+00	190+00	LT	42	4"	540			185+00	6"	E	46.3	0.5	
										190+00	6"	E		0.5	
64	WBL	190+00	195+00	LT	42	4"	544			190+00	6"	E	50.9	0.5	
										195+00	6"	E		0.5	
65	WBL	195+00	200+00	LT	42	4"	557			195+00	6"	E	50.9	0.5	
										200+00	6"	E		0.5	
66	WBL	200+00	202+96	LT	42	4"	323			200+00	6"	E	27.8	0.5	
										202+96	6"	E		0.5	
67	WBL	202+50	205+75	LT	24	4"	325			202+50	6"	E	17.4	0.5	INSTALL 19-E OUTLET @ 202+50.
										205+75	6"	C		0.5	INTO INTAKE @ 205+75.
68	WBL	205+75	208+75	LT	24	4"	299			205+75	6"	E	16.2	0.5	INTO INTAKES.
										208+75	6"	E		0.5	
69	WBL	208+75	211+75	LT	24	4"	298			208+75	6"	C	16.2	0.5	INTO INTAKES.
										211+75	6"	E		0.5	
70	WBL	211+75	215+06	LT	24	4"	325			211+75	6"	C	17.6	0.5	INTO INTAKES.
										215+06	6"	E		0.5	
71	WBL	215+06	216+61	LT	24	4"	152			215+06	6"	C	25.2	0.5	INTO INTAKE @ 215+06.
										216+61	6"	E		0.5	INSTALL 19-E OUTLET @ 216+61

LOCATION					LONGITUDINAL SUBDRAIN					CMP			POROUS * BACKFILL	Class 'A' * Crushed Stone	REMARKS
Line No.	Road or Lane Ident.	Station to Station		Side	Depth ①	Shoulder ①		Bckslope ②		SUBDRAIN OUTLET RF-19E or RF-22					
		Inch.	Size		Lin. Ft.	Size	Lin. Ft.	Station	Size	Type	Cu. Yds.	Cu. Yds.			
72	WBL	221+14	222+23	LT	42	4"	151			221+14	6"	E	34.7	0.5	
										222+23	6"	E		0.5	
												E	46.8	0.5	
												E		0.5	
74	WBL	228+11	232+03	LT	42	4"	442			228+11	6"	E	50.9	0.5	
										232+03	6"	E		0.5	
75	WBL	232+36	238+00	LT	42	4"	613			232+36	6"	E	50.9	0.5	
										238+00	6"	E		0.5	
76	WBL	238+00	240+00	LT	42	4"	251			238+00	6"	E	41.7	0.5	
										240+00	6"	E		0.5	
77	WBL	240+00	245+00	LT	42	4"	552			240+00	6"	E	50.9	0.5	
										245+00	6"	E		0.5	
78	WBL	245+00	250+00	LT	42	4"	552			245+00	6"	E	50.9	0.5	
										250+00	6"	E		0.5	
79	WBL	250+00	253+36	LT	42	4"	386			250+00	6"	E	15.3	0.5	
										253+36	6"	E		0.5	
80	WBL	253+60	258+00	LT	42	4"	480			253+60	6"	E	47.7	0.5	
										258+00	6"	E		0.5	
81	WBL	258+00	263+00	LT	42	4"	549			258+00	6"	E	50.9	0.5	
										263+00	6"	E		0.5	
82	WBL	263+00	268+00	LT	42	4"	553			263+00	6"	E	50.9	0.5	
										268+00	6"	E		0.5	
83	WBL	268+00	273+00	LT	42	4"	553			268+00	6"	E	50.9	0.5	
										273+00	6"	E		0.5	
84	WBL	273+00	279+24	LT	42	4"	673			273+00	6"	E	50.9	0.5	
											6"	E		0.5	
											6"	E	50.9	0.5	
											6"	E		0.5	
86	WBL	283+00	288+90	LT	42	4"	625			283+00	6"	E	59.3	0.5	
										288+90	6"	E		0.5	
87	WBL	289+10	294+00	LT	42	4"	550			289+10	6"	E	50.0	0.5	
										294+00	6"	E		0.5	
88	WBL	294+00	299+00	LT	42	4"	566			294+00	6"	E	50.9	0.5	
										299+00	6"	E		0.5	
89	WBL	299+00	304+00	LT	42	4"	555			299+00	6"	E	50.9	0.5	
										304+00	6"	E		0.5	
90	WBL	304+00	306+00	LT	42	4"	252			304+00	6"	E	23.1	0.5	
										306+00	6"	E		0.5	
91	TAMA ST	1125+45	1129+38	RT	42	4"	393			1125+45	6"	E	37.0	0.5	
										1129+38	6"	E		0.5	
92	TAMA ST	1127+50	1129+38	LT	24	4"	186			1127+50	6"	C	11.0	0.5	INTO INTAKES.
										1129+38	6"	E		0.5	
93	E POST	1174+00	1176+80	LT	42	4"	318			1174.00	6"	E	50.9	0.5	
										1176+80	6"	E		0.5	
94	E POST	1177+05	1181+13	LT	42	4"	455			1177.05	6"	E	41.7	0.5	
										1181+13	6"	E		0.5	
95	E POST	1183+00	1185+85	LT	42	4"	327			1183.00	6"	E	40.7	0.5	
										1185+85	6"	E		0.5	
96	E POST	1174+00	1179+00	RT	42	4"	523			1174.00	6"	E	50.9	0.5	
										1179+00	6"	E		0.5	
97	E POST	1179+00	1183+00	RT	42	4"	427			1179.00	6"	E	41.7	0.5	
										1183+00	6"	E		0.5	
98	E POST	1183+00	1185+50	RT	42	4"	275			1183.00	6"	E	40.7	0.5	
										1185+50	6"	E		0.5	
99	E POST	1188+00	1192+75	RT	42	4"	506			1188.00	6"	E	50.9	0.5	
										1192+75	6"	E		0.5	
100	E POST	1193+90	1197+80	RT	42	4"	428			1193.90	6"	E	50.9	0.5	
										1197+80	6"	E		0.5	
102	E POST	1188+75	1192+75	LT	42	4"	433			1188.75	6"	E	50.9	0.5	
										1192+75	6"	E		0.5	
103	E POST	1192+75	1197+90	LT	42	4"	567			1192+75	6"	E	50.9	0.5	
										1197+90	6"	E		0.5	
106	OLD 94	4282+21	4284+00	LT	42	4"	180			4282+21	6"	E	30.4	0.5	
										4284+00	6"	E		0.5	

② Refer to Soils Sheets

* Not a bid item

104-9
09-29-92

OFFICE OF DESIGN • CADD • PRODUCED

SHEET NUMBER

p. 24

POLLUTION PREVENTION PLAN			110-12A 02-23-93								
1. SITE DESCRIPTION			4. MAINTENANCE								
This project is for the construction of a 4-lane facility on IA 100 in Linn County from First Avenue in Cedar Rapids, through Marion to U.S. 151/IA 13. This project covers approximately 200 acres with an estimated 165 acres being disturbed. The project is located in an area of two soil associations, Dinsdale-Tama and Fayette. The estimated average SCS runoff curve number for this project after completion will be 77. Refer to the grading plan (Linn County, NHS-100-1(18)--19-57) for locations of typical slopes, ditch grades, and major structural and non-structural controls. A copy of this plan will be on file at the project engineer's office. Runoff from this project will flow into various unnamed ditches and streams, Indian Creek and Squaw Creek which are tributaries of the Cedar River. POTENTIAL SOURCES OF POLLUTION: Site sources of pollution generated as a result of this project relate to silts and sediment which may be transported as a result of a storm event. However, this project provides conveyance for other (non-project related) operations. These other operations have storm water runoff, the regulation of which is beyond the control of this project. Potentially this runoff can contain various pollutants related to site-specific land uses. Examples are: Rural Agricultural Activities: Runoff from agricultural land use can potentially contain chemicals including herbicides, insecticides, and fungicides. In addition, fertilizers which contain nitrogen, phosphate, potash and various other trace elements. Commercial and Industrial Activities: Runoff from commercial, industrial, and commerce land use may contain constituents associated with the specific operation. Such operations are subject to potential leaks and spills which could be commingled with run-off from the facility. Pollutants associated with commercial and industrial activities are not readily available since they are typically proprietary.			The contractor is required to maintain all temporary erosion control measures in proper working order, including cleaning, repairing, or replacing them throughout the contract period. Cleaning of silt control devices shall begin when the features have lost 50% of their capacity.								
2. CONTROLS			5. INSPECTIONS								
Silt fence will be placed by the grading contractor prior to beginning grading or clearing and grubbing operations along the perimeter of the project at locations in which runoff can move offsite. Vegetation in areas not needed for construction shall be preserved. As areas reach their final grade, additional silt fences, intercepting ditches, letdowns, bridge end drains, and earth dikes shall be installed as specified in the plans and/or as required by the project engineer. This will include using silt fence as ditch checks and to protect intakes. Temporary stabilizing seeding shall be completed as soon as practicable after completion of the final grading. If construction activity is not planned to occur in a disturbed area for at least 21 days, the area shall be stabilized by temporary seeding or mulching within 14 days. No more than 750,000 square feet of exposed erodible area is allowed in any one grading spread without permission of the project engineer. As the project progresses, additional erosion control items shall be installed by the erosion control contractor as determined by the engineer after field investigation. The project will be completed by the establishment of permanent perennial vegetation of all disturbed areas by the erosion control contractor.			The project will be inspected by department personnel every seven calendar days and after each rain event that is 1/2" or greater. The findings of this inspection shall be recorded in the project diary. This plan may be revised based on the findings of the inspection. The contractor shall implement all revisions.								
3. OTHER CONTROLS			6. NON-STORM DISCHARGES								
Contractor disposal of unused construction materials and construction material wastes shall comply with applicable state and local waste disposal, sanitary sewer, or septic system regulations. In the event of a conflict with other governmental laws, rules and regulations, the more restrictive laws, rules or regulations shall apply. APPROVED STATE OR LOCAL PLANS: During the course of this project, it is possible that situations will arise where unknown materials will be encountered. When such situations are encountered, they will be handled according to all federal, state, and local regulations in effect at the time.			This includes subsurface drains (i.e. longitudinal and standard subdrains), slope drains and bridge end drains. The velocity of the discharge from these features may be controlled by the use of patio blocks, Class A stone or erosion control stone.								
ROAD DESIGN • CADD • PRODUCED			STATE OF IOWA	FHWA REGION 7	FISCAL YEAR	LINN	COUNTY	PROJECT NUMBER	NHS-100-1(23)--19-57	SHEET NUMBER	C. 14

P 25 04

SUMMARY SHEET EROSION CONTROL WORK

TRAFFIC CONTROL PLAN

108-23
11-10-83

1. Traffic control on this project shall be in accordance with Standard Road Plans RS-72, and RS-73. For additional complementary information, refer to current supplemental specifications for traffic controls.

2. Traffic control for erosion control work adjacent to the traveled way shall be in accordance with Standard Road Plan RS-73.

3. Traffic control for erosion control work more than 12 feet from the traveled way shall be in accordance with Standard Road Plan RS-72.

4. When work is in progress within or near an interchange, additional "Road Construction Ahead" signs shall be placed on the ramps at a minimum distance of 300 feet in advance of the work area.

5. All traffic control devices shall be furnished, erected, maintained and removed by the contractor.

6. Section 2528.12 of the Standard Specifications requires maintenance of all traffic control devices, including maintenance of the devices during nonworking hours in order to be assured of proper operation. Costs of maintenance will be included in the traffic control bid item.

7. The location for storage of equipment by the contractor during non-working hours will be as approved by the engineer in charge of construction. Parking of unattended equipment within the median or storage of equipment within 50 feet of the edge of pavement will not be allowed.

8. Proposed sign spacing may be modified, as approved by the engineer, to meet existing field restrictions or to prevent obstruction of the motorist's view of permanent signing.

9. Proposed changes in the Traffic Control Plan shall be reviewed with the Office of Construction before changes are made.

10. The bid item "Traffic Control" shall include the cost for all traffic control measures required of the contractor except for those which are separate bid items or are incidental to other bid items.

"The contractor may use either "ROAD CONSTRUCTION AHEAD" signs or "ROAD WORK AHEAD" signs where "ROAD CONSTRUCTION AHEAD" signs or "ROAD WORK AHEAD" signs are called for in the contract documents. "ROAD CONSTRUCTION AHEAD" signs and "ROAD WORK AHEAD" signs shall not be used together on the same project.

This project is intended to be seeded during Spring, 1997 with the initial fertilizer to be applied during March - May.

The second application of fertilizer shall be applied following the final mowing in 1997.

Crawler type or dual wheel tractor equipment shall be required to facilitate construction.

Four wheel drive power equipment without duals may be approved if performance is satisfactory.

The contractor shall provide the necessary equipment and guidance essential to insure the application of seed and fertilizer on all areas.

09-29-92203-4

The contractor is encouraged to take full advantage of specification 1105.15 - Value Engineering Incentive Proposal. A pamphlet and conceptual proposal form will be available at the preconstruction conference.

ESTIMATE REFERENCE INFORMATION

100-4
01-23-85

Data listed below is for informational purpose only and shall not constitute a basis for any extra work orders.

ITEM NO.	DESCRIPTION
2102-2710070	Included for excavation, hauling and shaping of material for filling silt basins, eroded ditches and eroded slopes at locations as designated by the engineer. Material for filling silt basins and eroded ditches and slopes shall be furnished by the contractor and shall be free of rocks and debris and suitable for the establishment of vegetation.
2125-2225050	Includes reshaping of ditches to improve drainage. Silt shall be removed and disposed of off project by the contractor, est. 50 cu. yd. Wet conditions will require appropriate equipment to expedite the work.
2507-3250005	Engineering fabric shall be material as specified for embankment erosion control, Article 4196.01C. Material shall be measured in sq. yds. of actual area covered. Refer to details.
2507-8029000	For construction of rock ditch checks and splash basins at various locations. Material shall be nominal 6 in. (-3"+4") well graded stone as approved by the engineer. All necessary excavation and shaping to provide a uniform flowline in the center of the ditch shall be incidental to this work. No additional compensation will be allowed. Location as directed by the engineer. Refer to details and tab.
2525-2638030	Included for installing and maintaining new and existing silt fence as designated by the engineer.
2525-6745930	Includes removal of existing silt fence, ditch checks and posts. All material shall become the property of the contractor. Disturbed areas shall be seeded with Fescue, Ky. 31 Rate: 2 lbs. per 1,000 sq. ft. and fertilized--Rate: 10 lbs. of 6-24-24 per 1,000 sq. ft. Seed and fertilizer shall be incidental to this item. Silt fence shall be cut off at the ground line.
2528-8445110	Refer to traffic control plans.
2601-2633100	Estimate based on four mowings of all seeded areas and as designated by the engineer. The initial mowing shall be made prior to the seeding with the remainder of the mowings to be designated by the engineer. Areas inaccessible to field equipment shall be cut with appropriate hand equipment. All trimming work shall be kept current with the mowing of adjacent areas.
2601-2634100	Included for areas requiring reshaping and seedbed preparation as designated by the engineer.
2601-2634500	Included for overseeding areas that can't be drilled. Refer to sht. C.02 for respective seed mixtures. Seed and fertilizer for the item "Overseeding and Fertilizing" shall be applied with ground driven equipment. Two passes required.
2601-2636015	Included for seeding all rural areas outside 15' adj to shoulders. See sheet C.02 for respective seed mixtures and fertilizer. All seed for "Seeding, Native Grass" shall be applied with ground driven equip. Seed for areas not requiring seedbed preparation shall be applied with a native grass drill with no-till attachment. Includes areas requiring seedbed preparation including reshaping of foreslopes and backslopes that are extensively eroded at various locations and as designated by the engineer. (Est. 3 ac.) Two passes will be required when drilling. The second pass shall be offset from the first pass.

ACTUAL PROJECT QUANTITIES

100-1A
10-01-93

CONSTRUCTION USE ONLY	ITEM CODE	ITEM	UNIT	TOTAL	AS BUILT QUAN.
	2102-2710070	Excavation, Class 10, Roadway & Borrow	CY	1723.000	
	2125-2225050	Ditch Reshaping	Sta	21.100	
	2507-3250005	Fabric Engineering	SY	2068.300	
	2507-8029000	Stone, Erosion	Ton	701.820	
	2525-2638030	Silt Fence	LF	928.000	
	2525-6745930	Removal of Silt Fence	LF	13220.000	
	2528-8445110	Traffic Control	LS	600.000	
	2533-4980005	Mobilization	LS	4000.000	
	2601-2633100	Mowing	Acre	329.320	
	2601-2634100	Mulching	Acre	7.940	
	2601-2634500	Overseeding & Fertilizing	Acre	0.000	
	2601-2636015	Seeding, Native Grass	Acre	87.450	
	2601-2636043	Seeding & Fertilizing (Rural)	Acre	17.170	
	2601-2636044	Seeding & Fertilizing (Urban)	Acre	3.190	
	2601-2636054	Seeding, Wildflower	Acre	5.900	
	2601-2638350	Slope Protection, Wood Excelsior Mat	SO	5299.200	
	2601-2640350	Special Ditch Control, Wood Excelsior Mat	SO	1770.100	
	2601-2643110	Watering, For Special Ditch Control and Slope Protection	MGal	237.640	

ESTIMATE REFERENCE INFORMATION

100-4
01-23-85

Data listed below is for informational purpose only and shall not constitute a basis for any extra work orders.

ITEM NO.	DESCRIPTION
2601-2636043, 2601-2636044	Included for seeding and two applications of fertilizer for area 15' adj. to shoulders and as directed by the engineer. See sht. C.02 for respective seed mixtures and fertilizer. All seed and fertilizer for "Seeding and Fertilizing (Rural)" & (Urban) shall be applied with ground driven equipment. Seed for areas not requiring seedbed preparation shall be applied with a native grass drill with no-till attachment. Includes areas requiring seedbed preparation including reshaping of foreslopes that are extensively eroded at various locations and urban areas and as designated by the engineer. (Est. 6 ac.) Two passes will be required when drilling. The second pass shall be offset from the first pass.
2601-2636054	Includes seeding of wildflower on areas as designated by the engineer. Refer to sheet C.02 for seed mixture. The contractor shall furnish and apply to the existing vegetation (Glyphosate) a broad spectrum, non-selective systemic herbicide. A waiting period following the herbicide application of 10 days will be required before applying the seed. Any regrowth of vegetation shall be retreated before seeding and at the contractor's expense. Application rate: 3 qt. per acre - (glyphosate) herbicide shall be in accordance with the manufacturer's recommendation. Apply to foliage when plants are actively growing. The contractor shall apply the seed with a native grass drill with a no till attachment. Two passes will be required when drilling. The second pass shall be offset from the first pass. The herbicide shall be applied by a certified pesticide applicator. Sequence of operations for wildflower seeding. A. Apply herbicide (glyphosate) 10 days prior to seeding. B. Mow 1 day prior to seeding. C. Apply seed with native grass drill May 1 - June 30, 1997. D. Mow as directed to control weed growth. The furnishing and application of the (glyphosate) herbicide shall be incidental to seeding and no add. compensation will be allowed. Approximate locations: As designated by the engineer.

ESTIMATE REFERENCE INFORMATION

100-4
01-23-85

Data listed below is for informational purpose only and shall not constitute a basis for any extra work orders.

ITEM NO.	DESCRIPTION
2601-2638350	Locations to be designated by the engineer. Shaping of eroded slopes will be incidental to this item.
2601-2640350	Locations to be designated by the engineer. Shaping of eroded ditches and silt basins will be incidental to this item. The seed mixture under the wood excelsior mat shall be the seed mixture "E".
2601-2643110	Estimate based on one watering of the special ditch control and slope protection. Rate: 1 gal. per sq. ft. Article 2601.19 shall apply. Additional waterings (3) may be required at the discretion of the engineer subject to local weather conditions and paid by extra work order.

NOTE: DURING CONSTRUCTION OF THIS PROJECT, THE CONTRACTOR WILL BE REQUIRED TO COORDINATE HIS OPERATIONS WITH THOSE OF OTHER CONTRACTORS WORKING WITHIN THE SAME AREAS.

OFFICE OF DESIGN • CADD • PRODUCED

STATE OF IOWA

FHWA REGION 7

FISCAL YEAR

LINN

COUNTY

PROJECT NUMBER

NHS-100-1(22)--19-57

SHEET NUMBER

C.01-A

20-AUG-1996 07:59

oskar

E:\ord\rsd\MAST\A81.RSD

P 24

MAST ~ A81.m(427.road6b) oskar@road6b. Tue Aug 20 07:55:37 CDT 1996

Seed mixtures for this project:

Seed mixture "A" for "Seeding & Fertilizing (Rural)": (Est. 11 acres to be drilled and 2 acres with seedbed preparation.)
(For area 15' adj. to shoulders.) (Two fertilizer applications)

Fescue, 'Ky. 31', or Fawn (Festuca arundinacea)	45 lbs. per acre
Ryegrass, Perennial (Pennfine, Derby, Manhattan, or equivalent) (Lolium perenne)	35 lbs. per acre
Birdsfoot Trefoil (Empire) (Lotus corniculatus)	5 lbs. per acre

Seed mixture "B" for "Seeding and Fertilizing (Urban)". Seeding rate: 3 lbs. per 1,000 square feet (Est. 4.1 acres)
(Two fertilizer applications)

Bluegrass, Kentucky (Ram-1, Park, or equiv.) (Poa pratensis)	70%
Fescue, Creeping Red (Festuca rubra)	20%
Ryegrass, Perennial (Pennfine, Derby, Manhattan, or equivalent) (Lolium perenne)	10%

Seed Mixture "C" for "Seeding, Native Grass" and "Overseeding and Fertilizing" (Est. 2 acre to be overseeded, 67 acres to be drilled, and 3 acres with seedbed preparation.) (One fertilizer application)

Annual Ryegrass (Lolium perenne, var. italicum)	35 lbs. per acre
Fescue, 'Ky. 31', or Fawn (Festuca arundinacea)	25 lbs. per acre
Switchgrass (Blackwell, NE. 28, Pathfinder, or Cave-in-Rock) (Panicum virgatum)	2 lbs. PLS per acre
*Big Bluestem (Kaw, Roundtree, or Champ) (Andropogon gerardi)	5 lbs. PLS per acre
*Indiangrass (NE. 54, Otto, or Holt) (Sorghastrum nutans)	8 lbs. PLS per acre
*Little Bluestem (Blaze, Aldous, or Camper) (Andropogon scoparius)	5 lbs. PLS per acre
Sideoats Grama (Butte, or Trailway) (Bouteloua curtipendula)	10 lbs. PLS per acre
Purple Prairieclover (Petalostemum purpureum)	4 oz. PLS per acre
Blackeyed Susan (Rudbeckia hirta)	4 oz. PLS per acre
Prairie Blazing Star (Liatris pycnostachya)	4 oz. PLS per acre
Purple Coneflower (Echinacea purpurea)	4 oz. PLS per acre
Plains Coreopsis (Coreopsis tinctoria)	4 oz. PLS per acre
Grayhead Prairie Coneflower (Ratibida pinnata)	4 oz. PLS per acre

*Note: Big Bluestem, Indiangrass, and Little Bluestem shall be bearded or equal to facilitate the application.

Seed mixture "D" for "Seeding, Wildflower". (Est. 5 acre) (No fertilizer required)

Grayhead Prairie Coneflower (Ratibida pinnata)	8 oz. PLS per acre
Purple Coneflower (Echinacea purpurea)	8 oz. PLS per acre
Plains Coreopsis (Coreopsis tinctoria)	8 oz. PLS per acre
Pale Purple Coneflower (Echinacea pallida)	4 oz. PLS per acre
Blackeyed Susan (Rudbeckia hirta)	8 oz. PLS per acre
Butterfly Milkweed (Asclepias tuberosa)	2 oz. PLS per acre
New England Aster (Aster novae-angliae)	2 oz. PLS per acre
Mexican Red-Hat (Ratibida columnaris)	4 oz. PLS per acre
Purple Prairieclover (Petalostemum purpureum)	4 oz. PLS per acre
Prairie Blazing Star (Liatris pycnostachya)	4 oz. PLS per acre
Leadplant (Amorpha canescens)	4 oz. PLS per acre
Sideoats Grama (Butte or Trailway) (Bouteloua curtipendula)	8 lbs. PLS per acre
*Little Bluestem (Blaze, Aldous, or Camper) (Andropogon scoparius)	5 lbs. PLS per acre

*Note: Little Bluestem shall be bearded or equal to facilitate the application.

Seed mixture "E" for seeding area under "Special Ditch Control (Wood Excelsior Mat)" (Two fertilizer applications (Est. 5 acres))

Fescue, 'Ky. 31', or Fawn (Festuca arundinacea)	35 lbs. per acre
Ryegrass, Perennial (Pennfine, Derby, Manhattan, or equivalent) (Lolium perenne)	25 lbs. per acre
Switchgrass (Blackwell, NE. 28, Pathfinder, or Cave-in-Rock) (Panicum virgatum)	4 lbs. PLS per acre
Birdsfoot Trefoil (Empire) (Lotus corniculatus)	2 lbs. per acre

Fertilizer--Two applications required for the item "Seeding and Fertilizing (Rural)", "Seeding and Fertilizing (Urban)", and seeding under "Special Ditch Control (Wood Excelsior Mat)" Seed Mixtures "A", "B" and "E".

Fertilizer--One application required for the item "Overseeding and Fertilizing" & "Seeding, Native Grass, Seed Mixture "C".

Initial application--To be applied in April or May, 1997. Chemically combined commercial fertilizer shall be used at the following rate per acre: 600 lbs. of 6-24-24 or equivalent.

Second application of fertilizer--To be applied following the Fall mowing in 1997. Chemically combined commercial fertilizer shall be used at the following rate per acre: 400 lbs. of 6-24-24 or equivalent.



All fertilizer shall be chemically combined and applied in the dry form as a top-dress application.

Mulch: Rate: 1½ tons of dry cereal straw per acre. All mulch to be consolidated into the soil with the mulch stabilizer.

Form 520004
12-88

EXTRA WORK ORDERS

NO.	DESCRIPTION	UNIT	TOTAL
8001	Revetment, C.I.D., Rip Rap	Tons	237.640
8002	Bridge End Drain	Each	2.000
8003	Native Grass Seeding	Acres	3.900

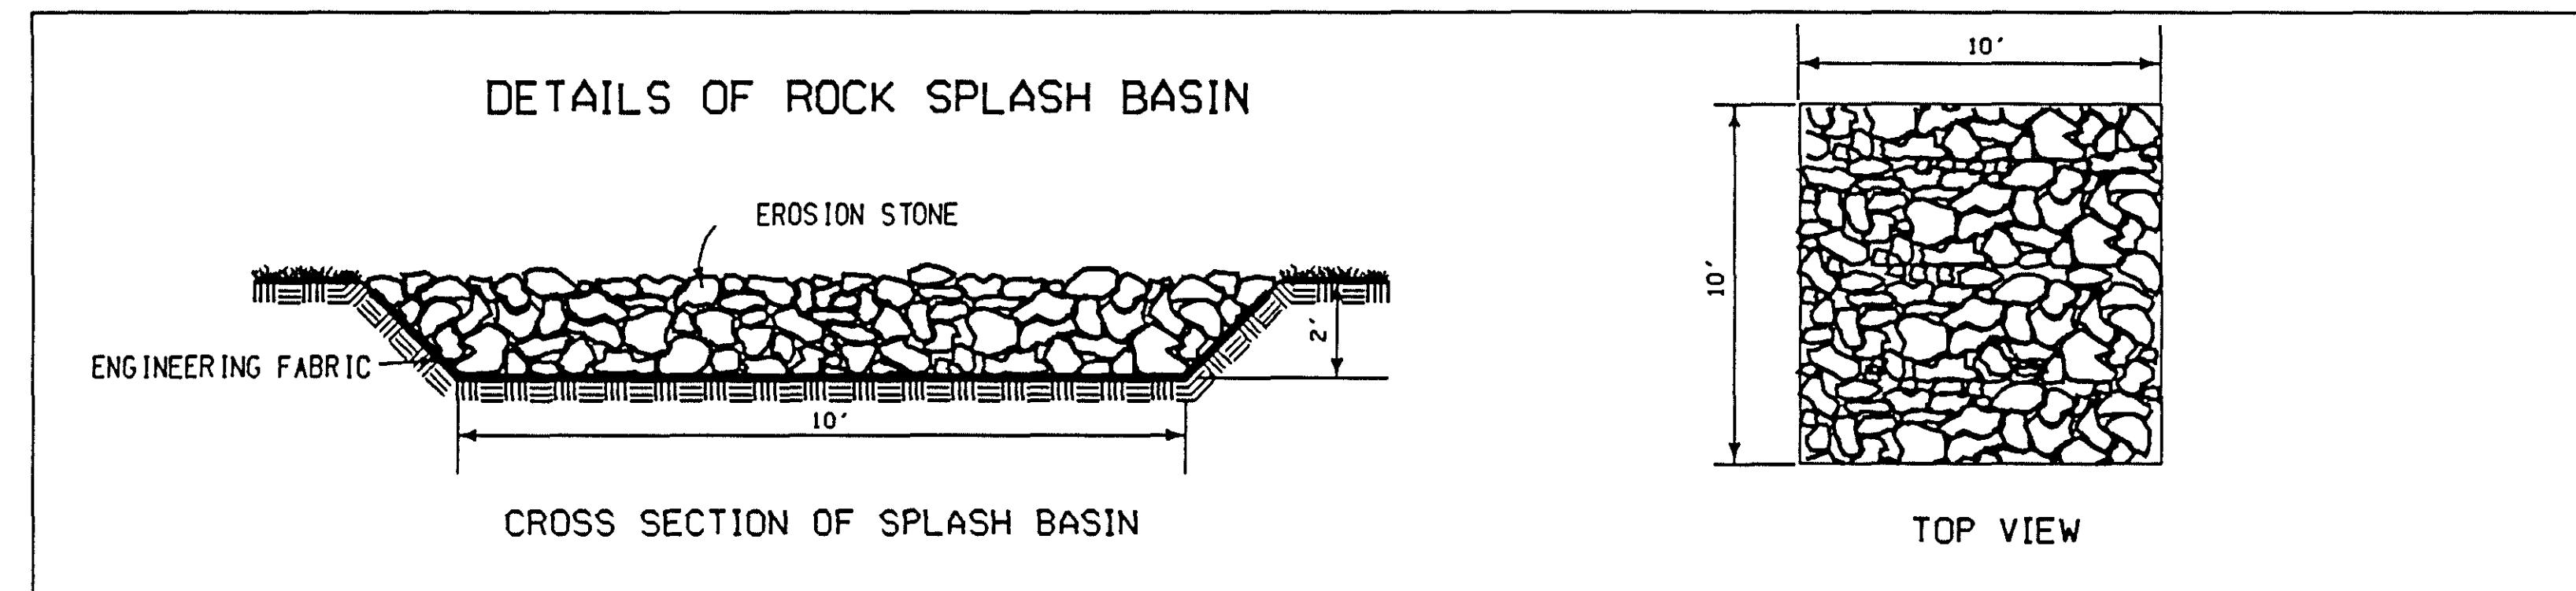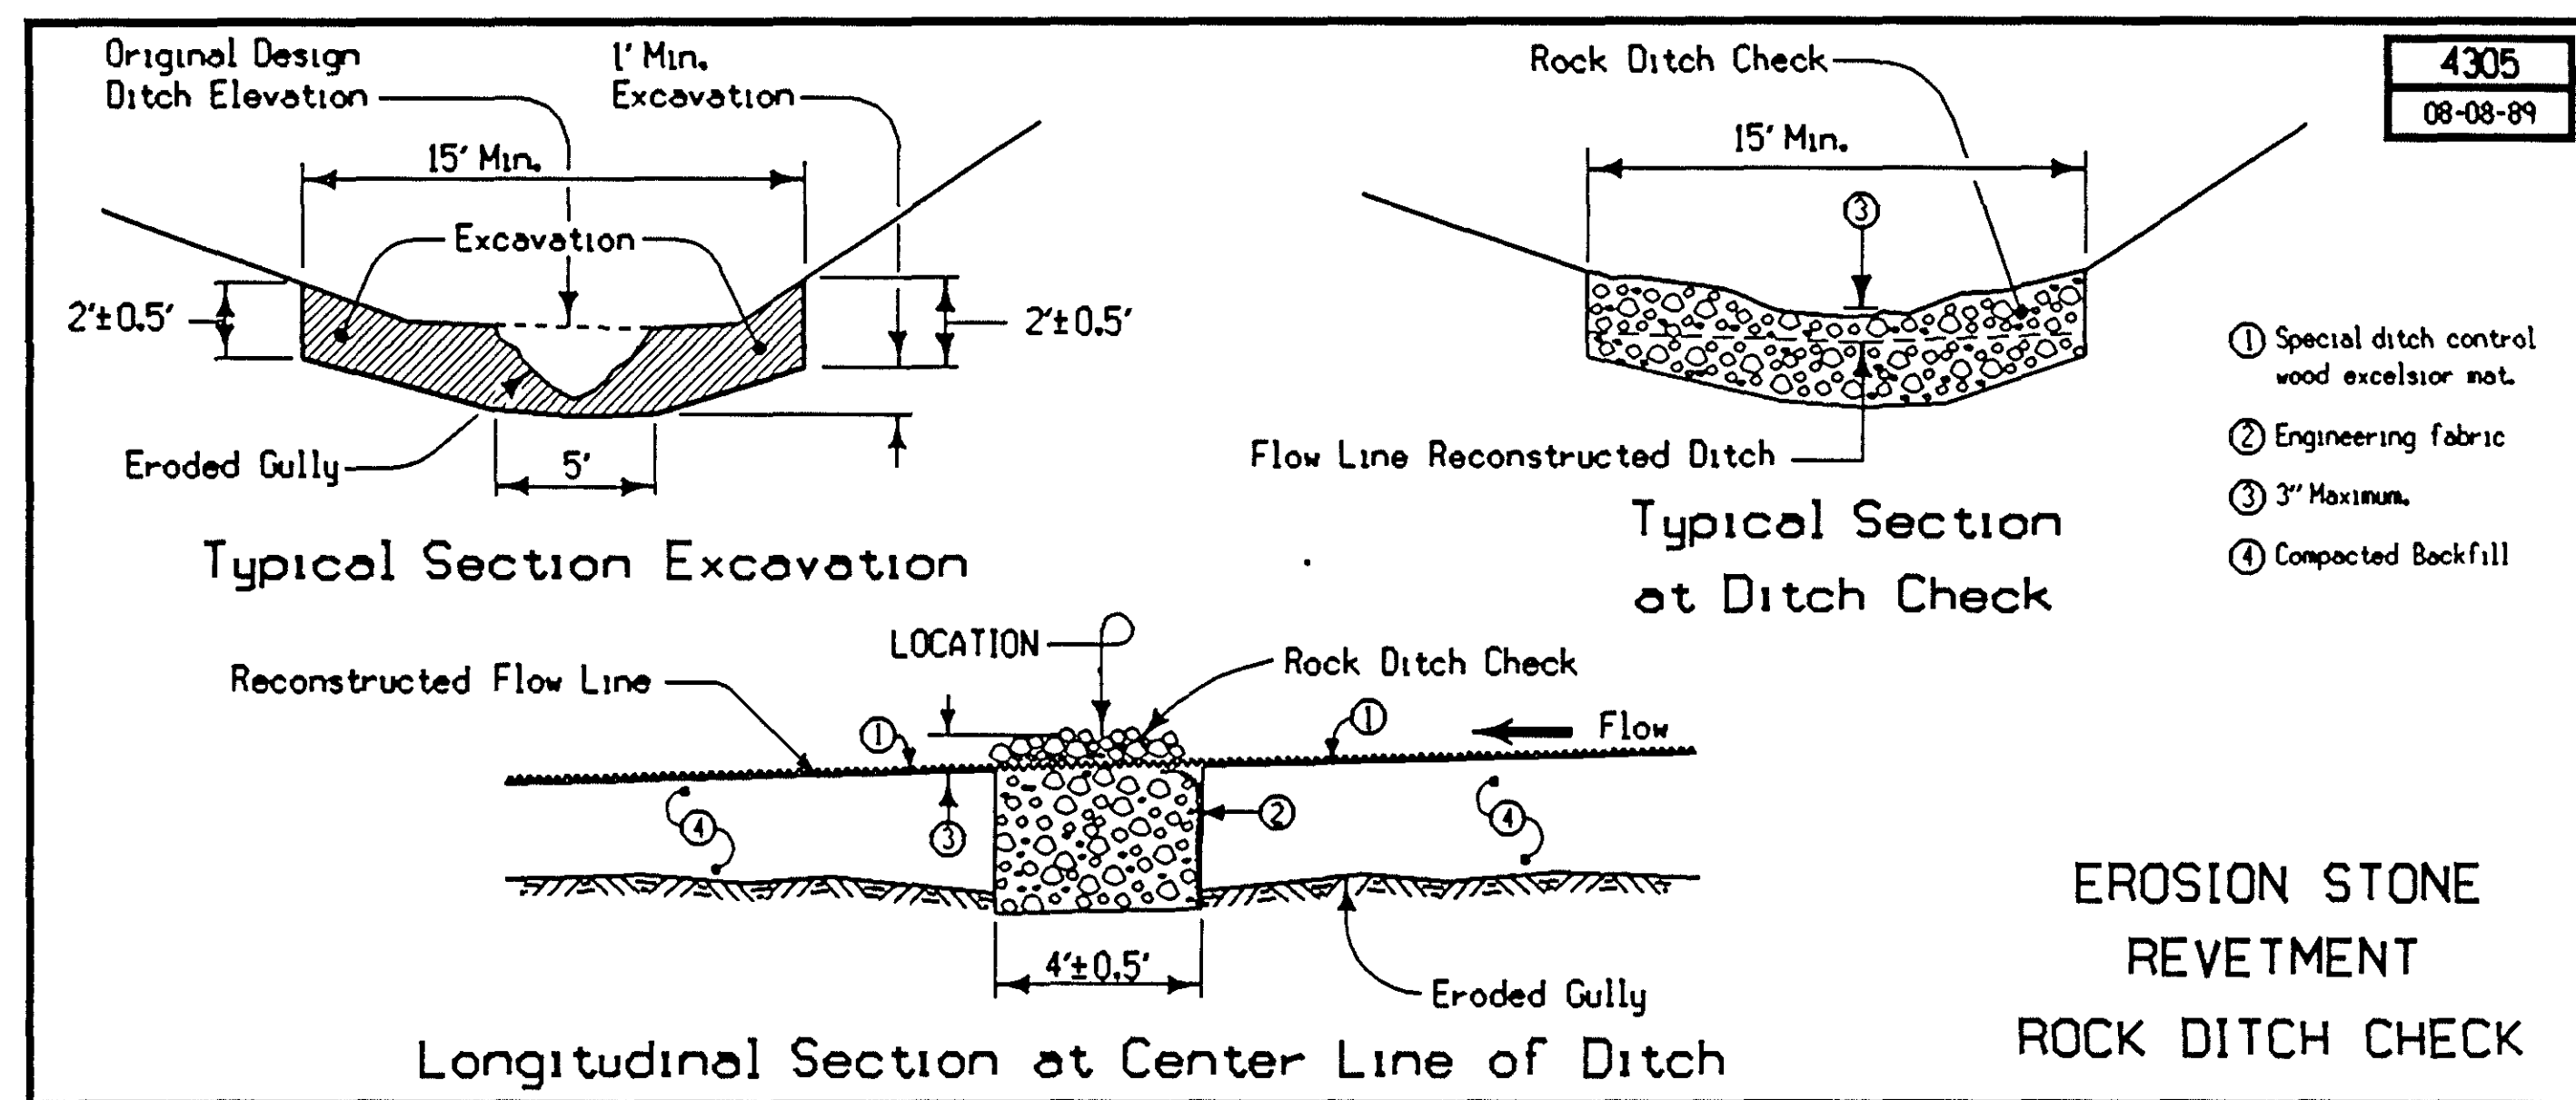

ROCK DITCH CHECKS/ROCK FLUMES						
LOCATION	STATION	LT.	CHECK	EROSION STONE	TONS	FABRIC SQ. YD.
		RT.	FLUME	RIP RAP		
MAINLINE	188+50	RT.	ROCK CHECK	EROSION STONE	7	4
MAINLINE	189+50	RT.	ROCK CHECK	EROSION STONE	7	4
MAINLINE	263+25	RT.	SPLASH BASIN	EROSION STONE	11	12
MAINLINE	267+00	RT.	SPLASH BASIN	EROSION STONE	11	12
MAINLINE	269+50	RT.	SPLASH BASIN	EROSION STONE	11	12

SPECIAL DITCH CONTROL & SLOPE PROTECTION			
STATION TO STATION	WIDTH	NO. SQUARES	REMARKS
116+00 - 131+00 RT.	12'	18	SLOPE PROT. ADJ SD.RD. RET.
117+00 - 131+00 LT.	12'	168	SLOPE PROT. ADJ. CURB
120+00 - 129+50 RT.	12'	114	DITCH
125+50 - 130+50 LT.	12'	60	DITCH - BACK SIDE OF BERM
131+00 - 133+50 RT.	12'	30	DITCH
1122+50 - 1124+00 LT.&RT.	12'	36	SLOPE PROT. ADJ. CURB
1125+00 - 1129+50 LT.&RT.	20'	160	SLOPE PROT. ADJ. CURB
134+00 RT.	20'	30	SLOPE PROT. ADJ SD.RD. RET.
134+50 - 148+75 RT.	12'	171	DITCH
138+00 - 145+00 LT.	12'	84	DITCH
138+00 - 185+00 LT.	12'	564	SLOPE PROT. ADJ SHLDR.
138+00 - 160+00 RT.	12'	264	SLOPE PROT. ADJ SHLDR.
155+00 - 162+00 LT.	20'	183	DITCH
165+00 - 185+00 LT.	12'	240	DITCH
168+00 - 185+00 RT.	12'	204	SLOPE PROT. ADJ SHLDR.
169+75 - 185+00 RT.	12'	183	DITCH
186+90 LT.&RT.	12'	36	SLOPE PROT. ADJ SD.RD. RET.
188+00 - 277+00 LT.	12'	1068	SLOPE PROT. ADJ SHLDR.
188+00 - 211+00 RT.	12'	276	SLOPE PROT. ADJ SHLDR.
1173+25 - 1179+50 LT.	4'x12'	40	SD. RD. DITCH
1188+50 - 1193+00 RT.	40'	190	SLOPE PROT. SD.RD. BACKSLOPE
188+00 - 194+00 LT.	12'	72	DITCH
188+00 - 198+00 RT.	12'	120	DITCH
203+00 - 215+25 LT.	16'	196	SLOPE PROT. ADJ. CURB
204+00 - 215+00 RT.	12'	132	DITCH
215+50 RT.	12'	9	SLOPE PROT. ADJ SD.RD. RET.
216+50 - 231+75 RT.	12'	183	DITCH
224+00 - 232+25 LT.	12'	99	DITCH
226+00 - 306+00 RT.	12'	960	SLOPE PROT. ADJ SHLDR.
235+00 - 242+00 LT.	12'	84	DITCH
239+00 - 242+00 RT.	12'	36	DITCH
242+93 RT.	12'	18	SLOPE PROT. ADJ SD.RD. RET.
3244+00 - 3246+00 LT.&RT.	12'	80	SLOPE PROT. ADJ SHLDR.
270+00 - 279+00 LT.	12'	108	DITCH
280+70 LT.	12'	24	SLOPE PROT. ADJ SD.RD. RET.
281+50 - 296+50 LT.	12'	180	DITCH
295+00 - 302+00 RT.	12'	84	DITCH
300+00 - 306+00 LT.	12'	72	SLOPE PROT. ADJ SHLDR.
300+50 - 307+00 LT.	12'	78	DITCH
307+18 RT.	12'	24	DITCH

POLLUTION PREVENTION PLAN

110-12A
02-23-93

1. SITE DESCRIPTION

This project is for the construction of a 4-lane facility on IA 100 in Linn County from First Avenue in Cedar Rapids, through Marion to U.S. 151/IA 13.

This project covers approximately 200 acres with an estimated 165 acres being disturbed.

The project is located in an area of two soil associations, Dinsdale-Tama and Fayette. The estimated average SCS runoff curve number for this project after completion will be 77.

Refer to the grading plan (Linn County, NHS-100-1(18)--19-57) for locations of typical slopes, ditch grades, and major structural and non-structural controls. A copy of this plan will be on file at the project engineer's office. Runoff from this project will flow into various unnamed ditches and streams, Indian Creek and Squaw Creek which are tributaries of the Cedar River.

POTENTIAL SOURCES OF POLLUTION:

Site sources of pollution generated as a result of this project relate to silts and sediment which may be transported as a result of a storm event. However, this project provides conveyance for other (non-project related) operations. These other operations have storm water runoff, the regulation of which is beyond the control of this project. Potentially this runoff can contain various pollutants related to site-specific land uses. Examples are:

Rural Agricultural Activities:

Runoff from agricultural land use can potentially contain chemicals including herbicides, insecticides, and fungicides. In addition, fertilizers which contain nitrogen, phosphate, potash and various other trace elements.

Commercial and Industrial Activities:

Runoff from commercial, industrial, and commerce land use may contain constituents associated with the specific operation. Such operations are subject to potential leaks and spills which could be commingled with run-off from the facility. Pollutants associated with commercial and industrial activities are not readily available since they are typically proprietary.

2. CONTROLS

Silt fence will be placed by the grading contractor prior to beginning grading or clearing and grubbing operations along the perimeter of the project at locations in which runoff can move offsite. Vegetation in areas not needed for construction shall be preserved. As areas reach their final grade, additional silt fences, intercepting ditches, letdowns, bridge end drains, and earth dikes shall be installed as specified in the plans and/or as required by the project engineer. This will include using silt fence as ditch checks and to protect intakes. Temporary stabilizing seeding shall be completed as soon as practicable after completion of the final grading. If construction activity is not planned to occur in a disturbed area for at least 21 days, the area shall be stabilized by temporary seeding or mulching within 14 days. No more than 750,000 square feet of exposed erodible area is allowed in any one grading spread without permission of the project engineer.

As the project progresses, additional erosion control items shall be installed by the erosion control contractor as determined by the engineer after field investigation. The project will be completed by the establishment of permanent perennial vegetation of all disturbed areas by the erosion control contractor.

3. OTHER CONTROLS

Contractor disposal of unused construction materials and construction material wastes shall comply with applicable state and local waste disposal, sanitary sewer, or septic system regulations. In the event of a conflict with other governmental laws, rules and regulations, the more restrictive laws, rules or regulations shall apply.

APPROVED STATE OR LOCAL PLANS:

During the course of this project, it is possible that situations will arise where unknown materials will be encountered. When such situations are encountered, they will be handled according to all federal, state, and local regulations in effect at the time.

POLLUTION PREVENTION PLAN

110-12A
02-23-93

4. MAINTENANCE

The contractor is required to maintain all temporary erosion control measures in proper working order, including cleaning, repairing, or replacing them throughout the contract period. Cleaning of silt control devices shall begin when the features have lost 50% of their capacity.

5. INSPECTIONS

The project will be inspected by department personnel every seven calendar days and after each rain event that is 1/2" or greater. The findings of this inspection shall be recorded in the project diary. This plan may be revised based on the findings of the inspection. The contractor shall implement all revisions.

6. NON-STORM DISCHARGES

This includes subsurface drains (i.e. longitudinal and standard subdrains), slope drains and bridge end drains. The velocity of the discharge from these features may be controlled by the use of patio blocks, Class A stone or erosion control stone.


- 20 Hollis K. Sweet
- 20 Hollis K. Sweet (Fee)
- 20 R.L. & L.J. Sweet (CP)
- 21 Cedar Valley Invest. Corp.
- 28 C.M. St. & P. R.R.
- 31 Robert Mason
- 107 Edward D. Broderick

RAPIDS TWP
T-83N R-7W
SEC. 2

CITY OF CEDAR RAPIDS

UTILITY LEGEND

—●—	IOWA ELEC. LIGHT & POWER
—G—	IOWA ELEC. LIGHT & POWER
—E—	IOWA ELEC. LIGHT & POWER
—T—	U.S. WEST DIRECT
—W—	CITY OF CEDAR RAPIDS
—S—	CITY OF CEDAR RAPIDS
—	SANITARY SEWER

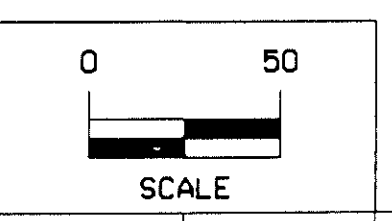


Spiral Data

Δ	= 27°54'52" Rt.
θ	= 4°30'00"
L_s	= 225.00
Prop. Type	D = 468.84
Ent. & Ex. S	= 45.09
P	= 1.47
K	= 112.48
Xc	= 224.86
Yc	= 5.89
LT	= 150.04
ST	= 75.05
LC	= 224.94



Curve Data

Δ	= 18°54'52" Rt.
D	= 4°00'00"
T	= 238.60
L	= 472.86
E	= 19.74
R	= 1432.39


Normal Crown GREEN

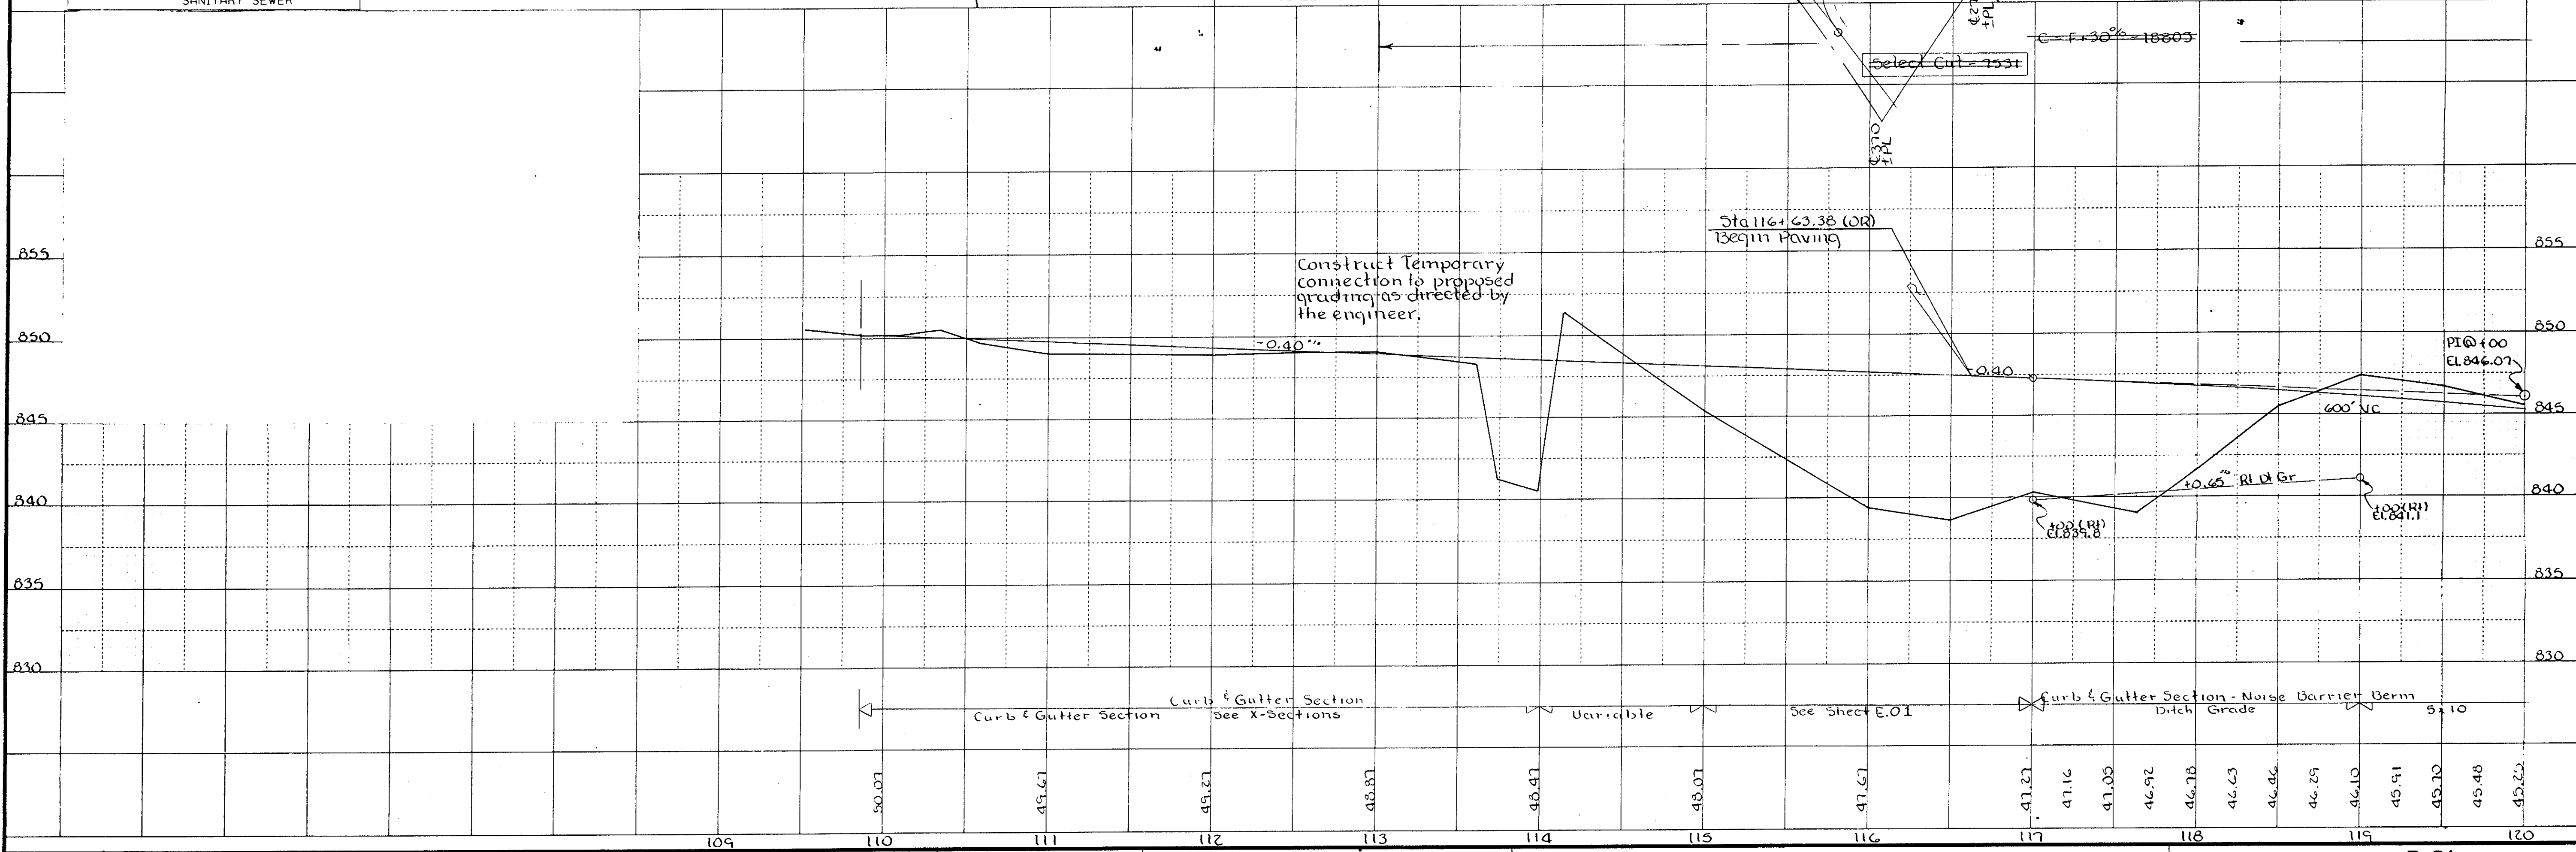



P.30 D4

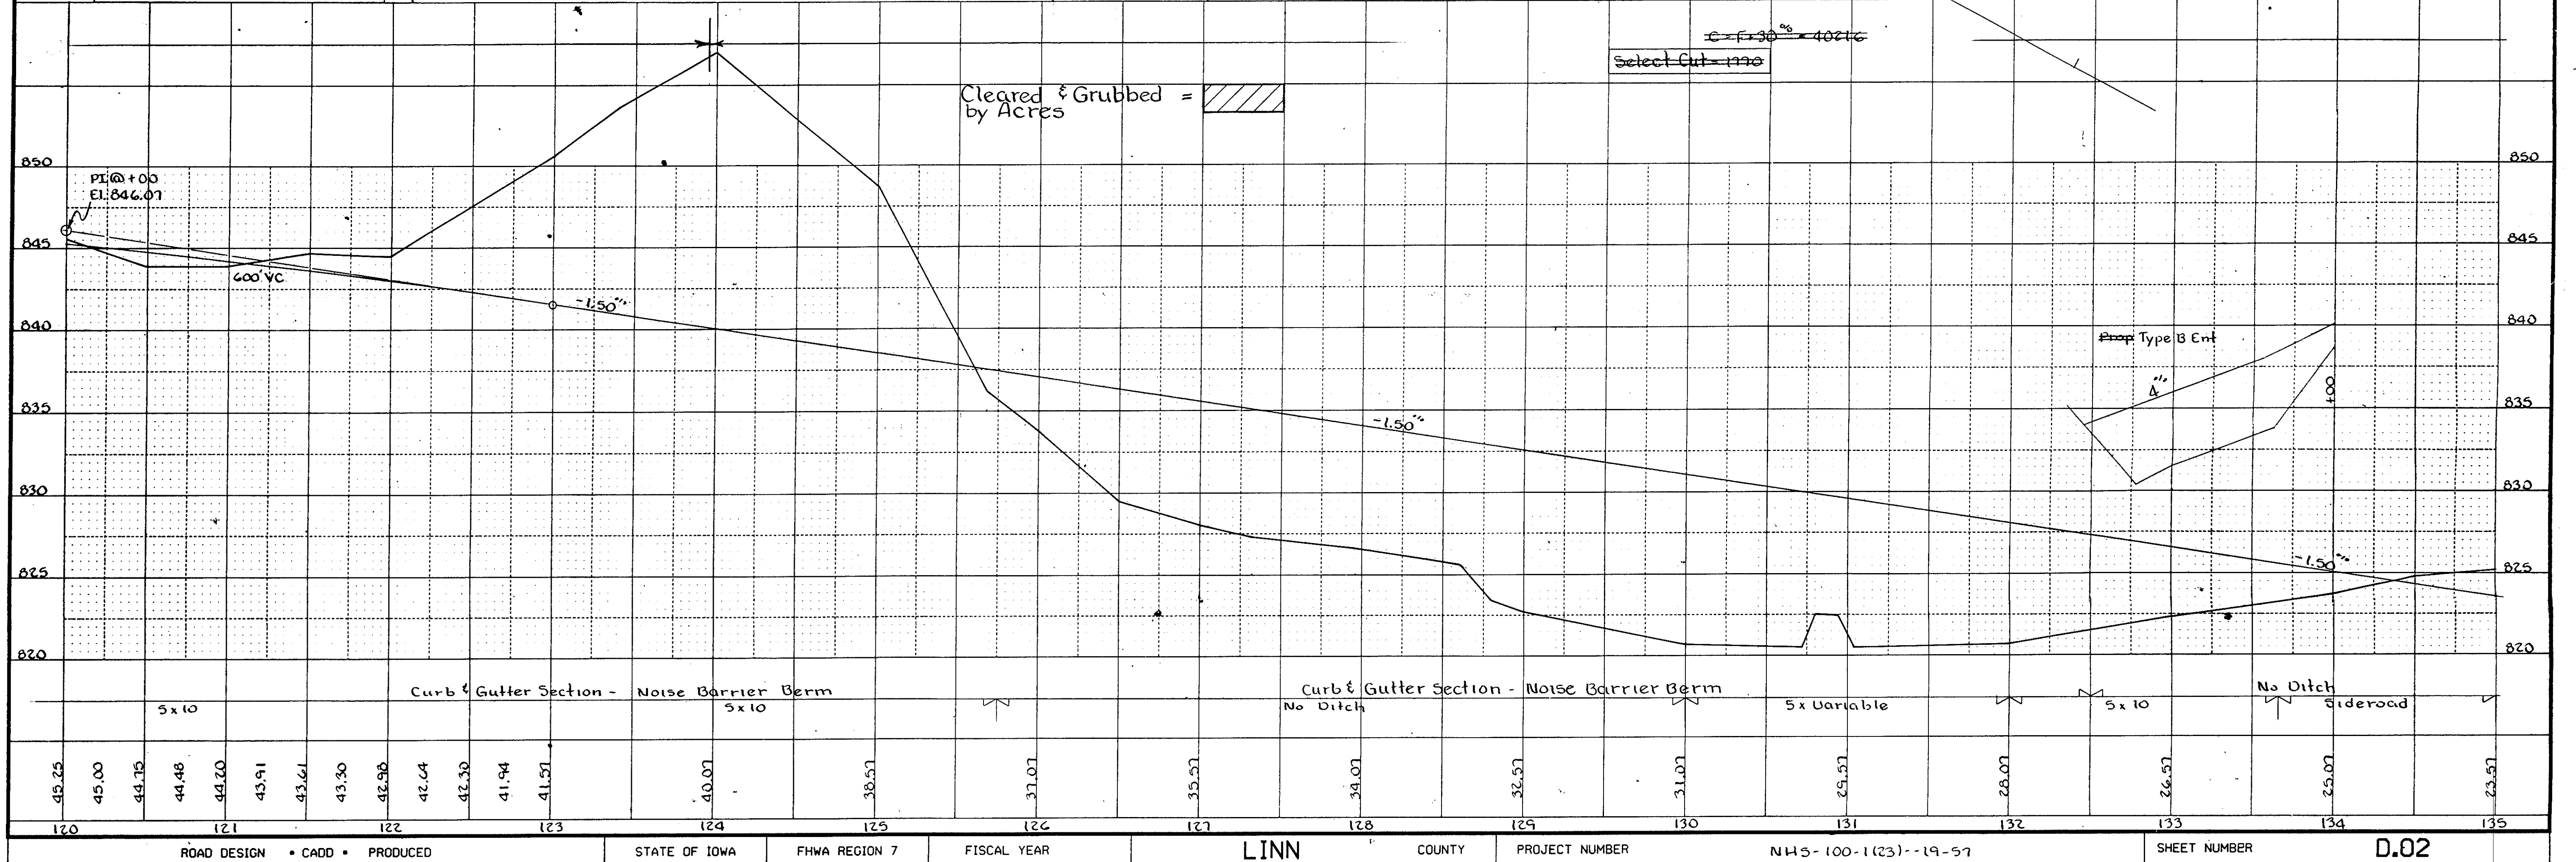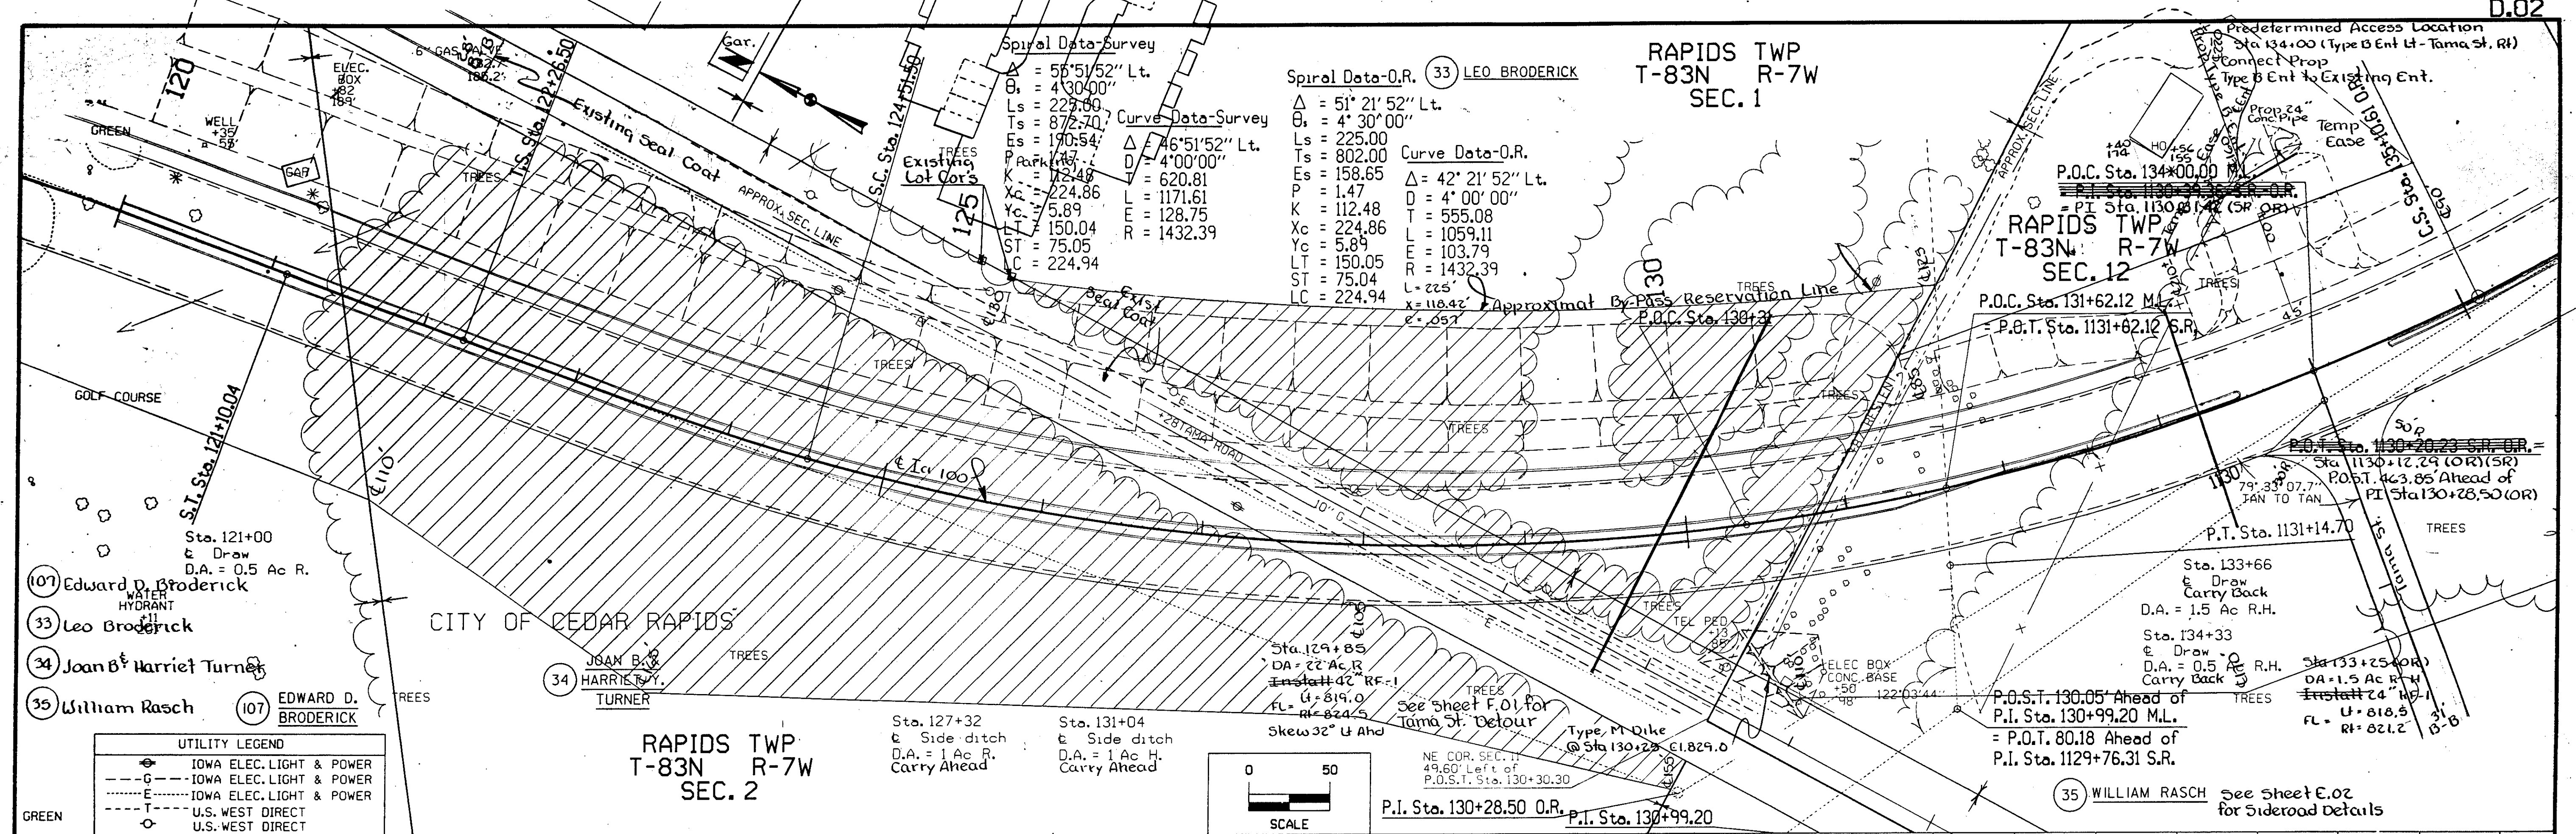


P.31 04

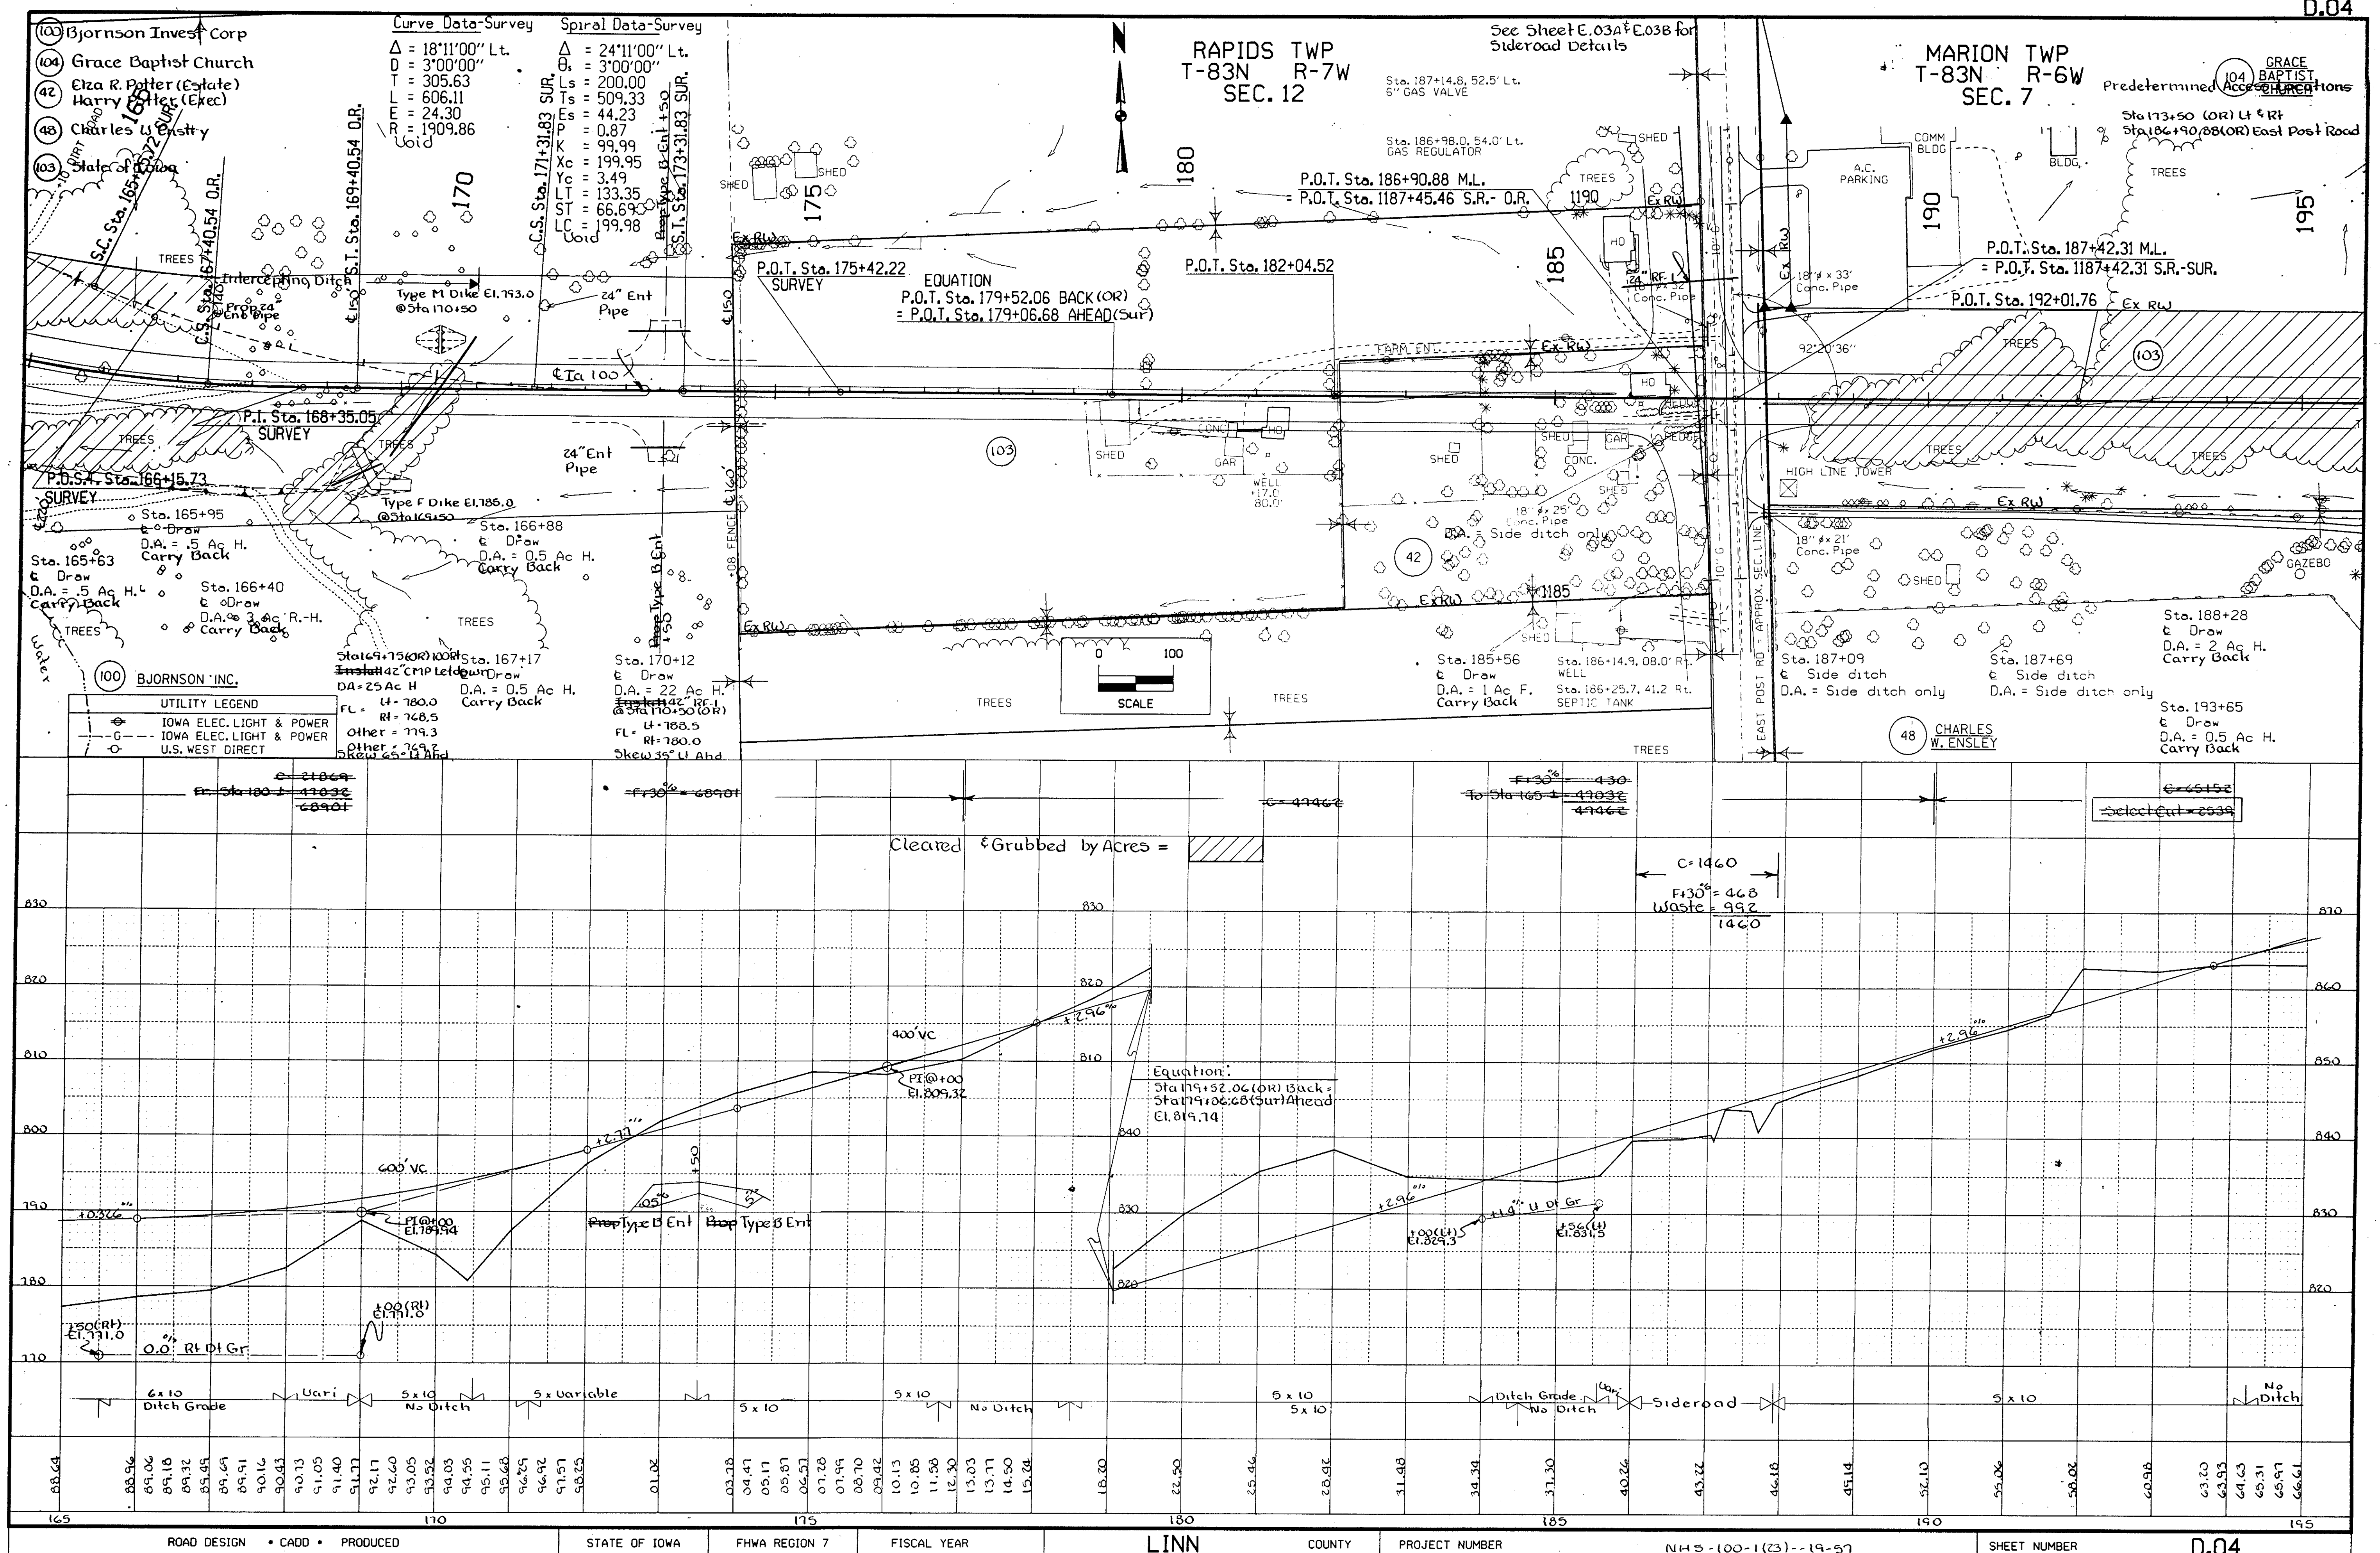

P33 D4

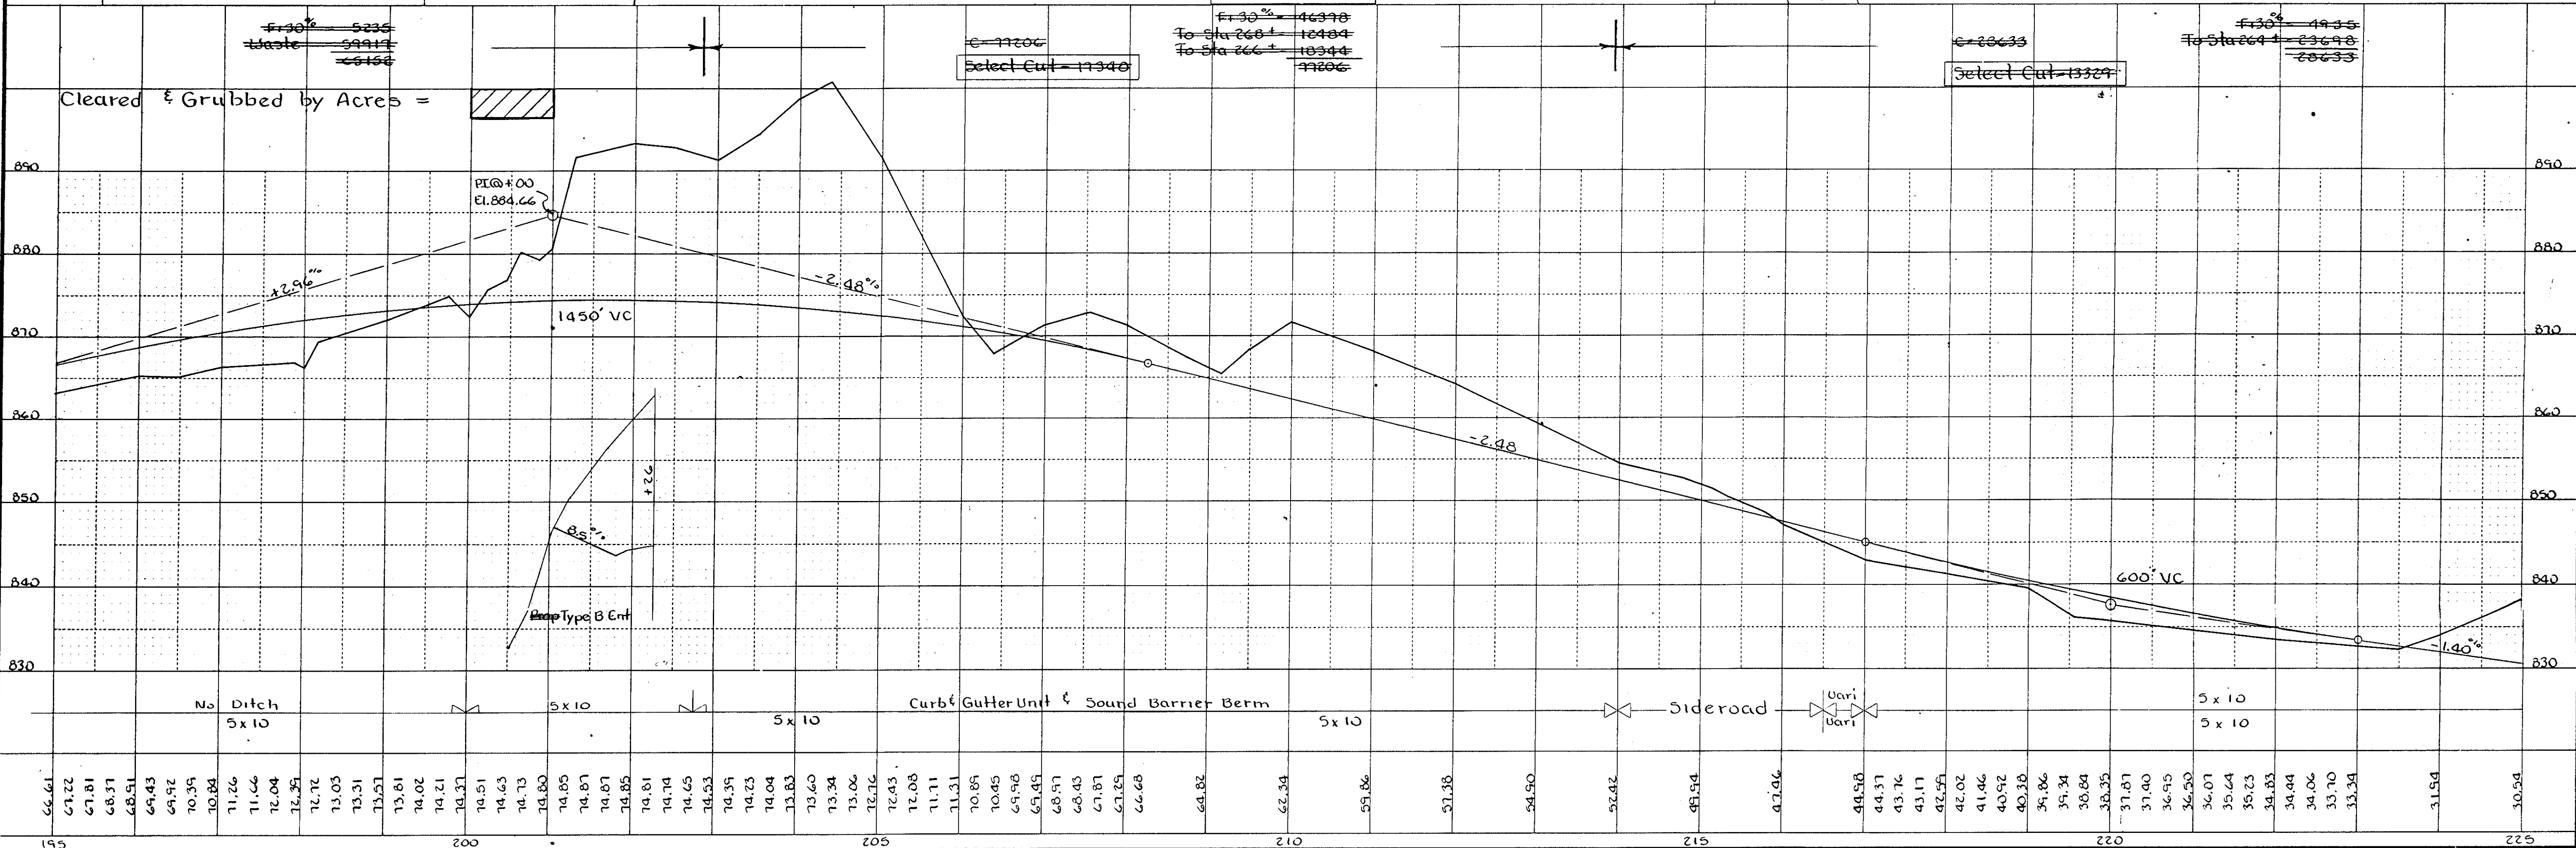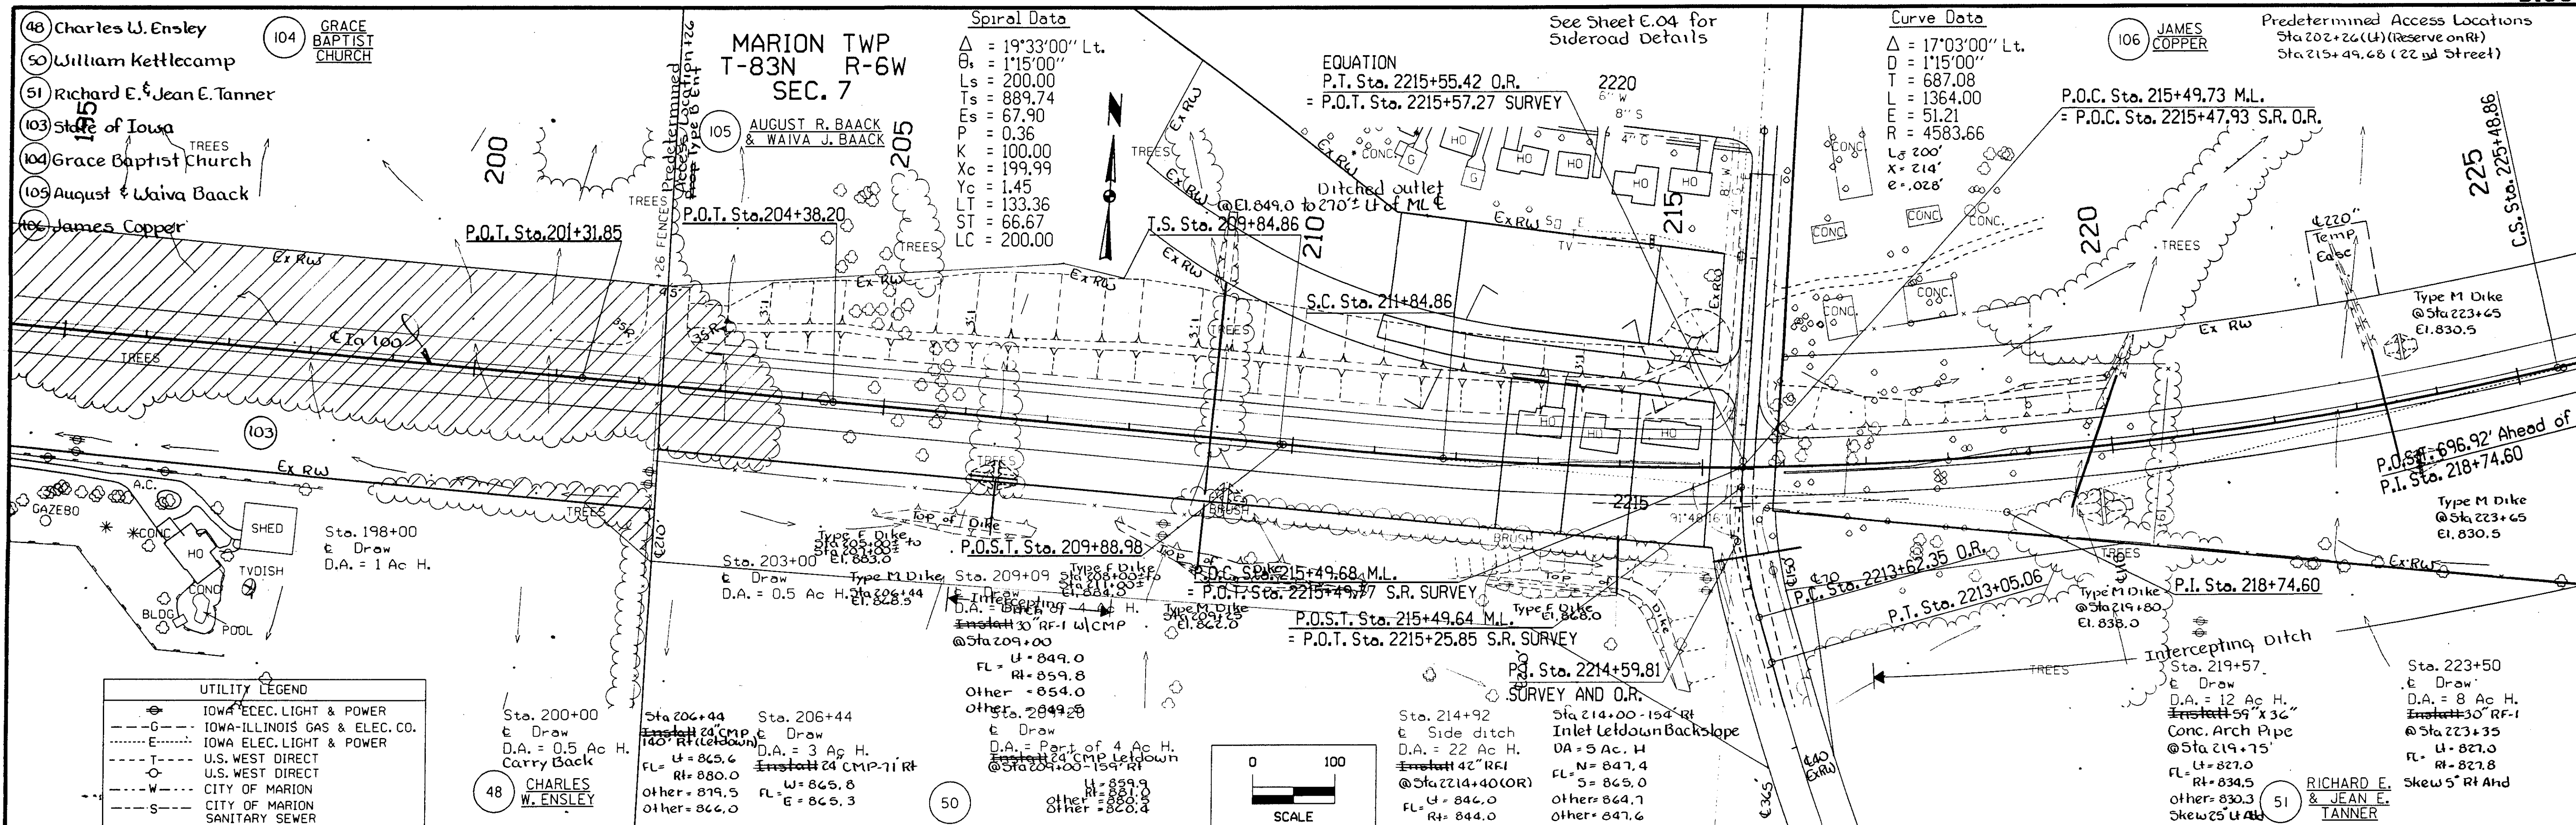

52 THEODORE
C. MUNIER

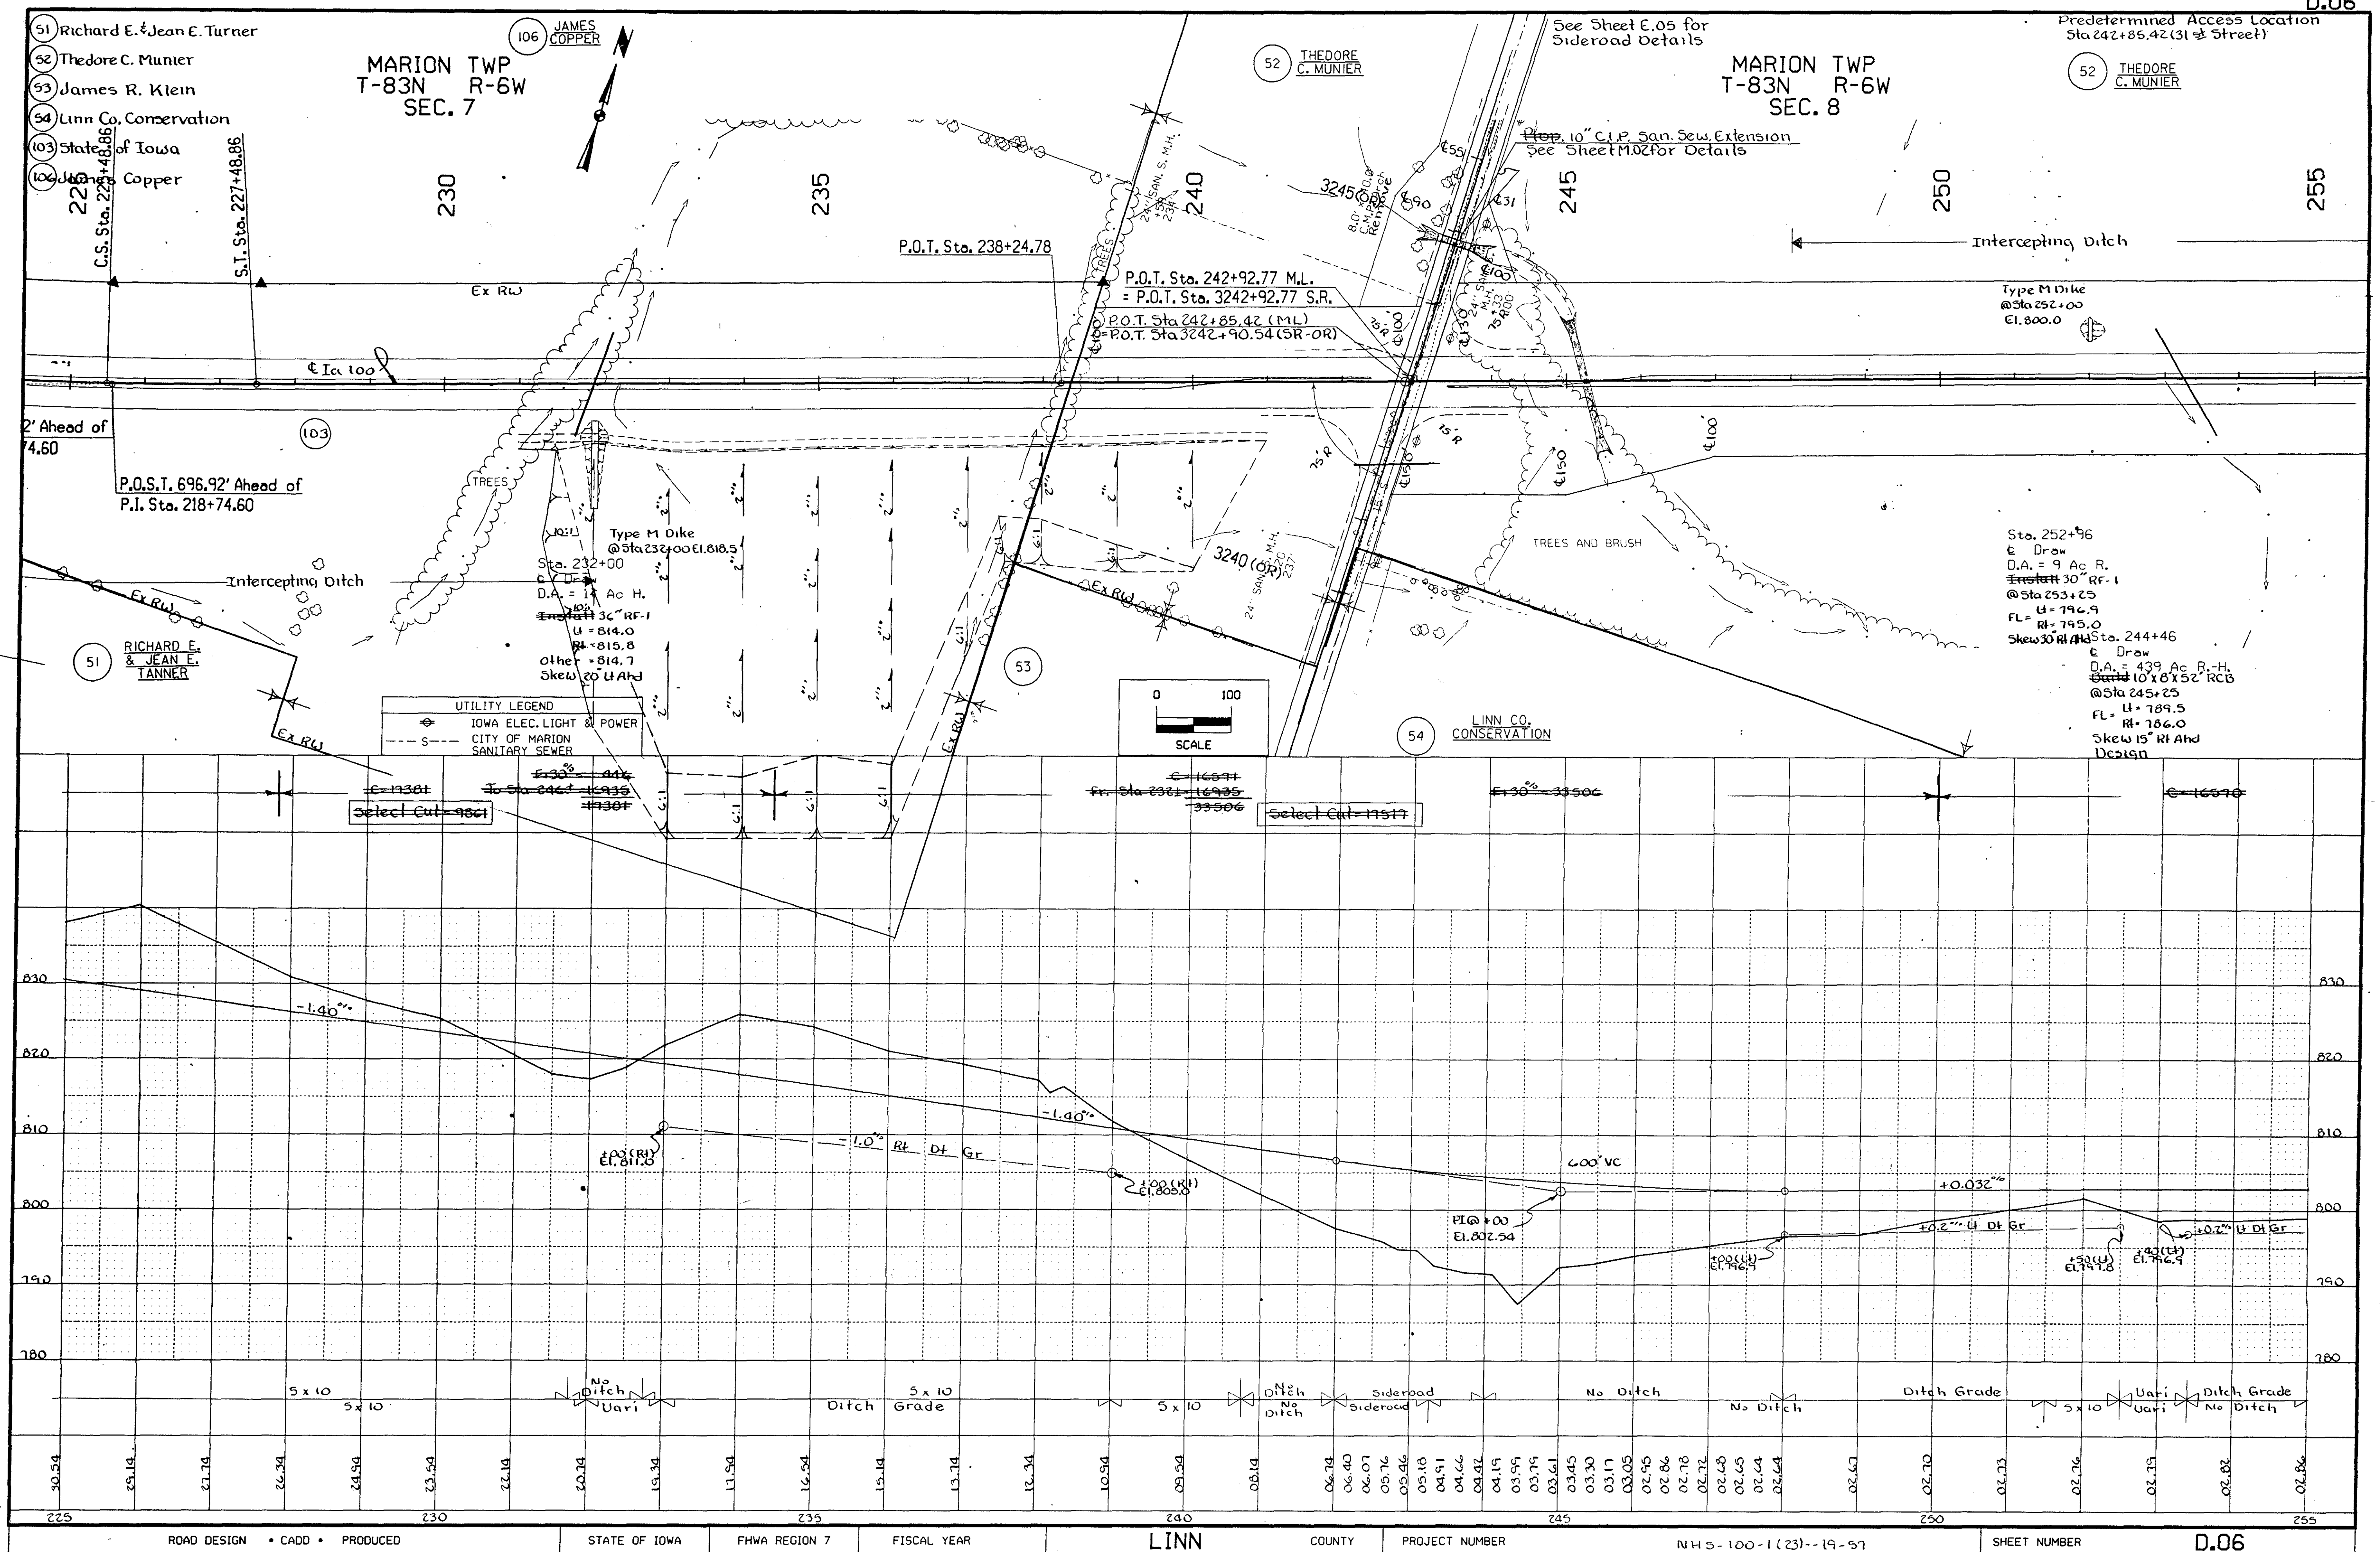

- 52 Theodore C. Munier
- 54 Linn Co. Conservation
- 55 Harold, George, Gene F. & Marilyn K. Munier
- 56 John P. & Frances E. Hennessey

52 THEODORE C. MUNIER

MARION TWP
T-83N R-6W
SEC. 5

Predetermined Access Locations
Sta 260+26 (Lt & Rt)
Sta 280+70.43 (Co Rd U - Type C Ent (Rt))

P.I. Sta. 4283+93.01

56 JOHN P. & FRANCES E. HENNESSEY

P.O.S.T. 126.19' Ahead of
P.I. Sta. 279+52.05 M.L. SUR.
= P.O.T. Sta. 4280+83.36 S.R.

P.O.C. Sta. 280+73.00 M.L. SUR.
= P.O.T. Sta. 4280+73.00 S.R.

P.O.T. Sta. 4281+24.52
= P.O.S.T. 538.55' Back of
P.I. Sta. 286+19.50 (OR)

P.I. Sta. 279+52.05
SURVEY

P.C. Sta. 4281+35.87

P.O.C. Sta. 280+70.43 M.L. - O.R.
= P.I. Sta. 4280+67.89 S.R.
Concentric

SURVEY Void
Curve Data
 $\Delta = 11^{\circ}01'50''$ Rt.
 $D = 3^{\circ}00'00''$
 $T = 184.42$
 $L = 367.69$
 $m = 8.88$
 $R = 1909.86$

SURVEY Void
Spiral Data
 $\Delta = 18^{\circ}31'50''$ Rt.
 $\theta = 3^{\circ}45'00''$
 $L_s = 250.00$
 $T_s = 436.77$
 $E_s = 26.62$
 $P = 1.36$
 $K = 124.98$
 $X_c = 249.89$
 $Y_c = 5.45$
 $LT = 166.70$
 $ST = 83.37$
 $LC = 249.95$

Sta. 278+22
t Draw
D.A. = 0.5 Ac H.
Carry Back
HAROLD GEORGE MUNIER,
GENE F. MUNIER,
& MARILYN K. MUNIER

Type M DiKE
@ Sta 267+00
El. 802.0

Type M DiKE
@ Sta 269+90
El. 808.0



Sta. 269+96
t Draw
D.A. = 15 Ac H.
Intersect 30' R.F. -1
with R.F. -13 @
Sta 269+80
FL = 805.5'
RI = 795.0
Other = 800.0
Skew 18' Lt And

Sta. 267+50
t Draw
D.A. = 8 Ac R
Intersect 30' R.F. -1
@ Sta 267+55
FL = 794.5
RI = 794.5
Skew 20' Lt And

Sta. 261+86
t Draw
D.A. = 89 Ac H.-R.
Intersect 12' R.F. -1
@ Sta 262+65
FL = 792.0
RI = 790.0
Skew 30' Rt And

MARION TWP
T-83N R-6W
SEC. 8

UTILITY LEGEND
IOWA ELEC. LIGHT & POWER

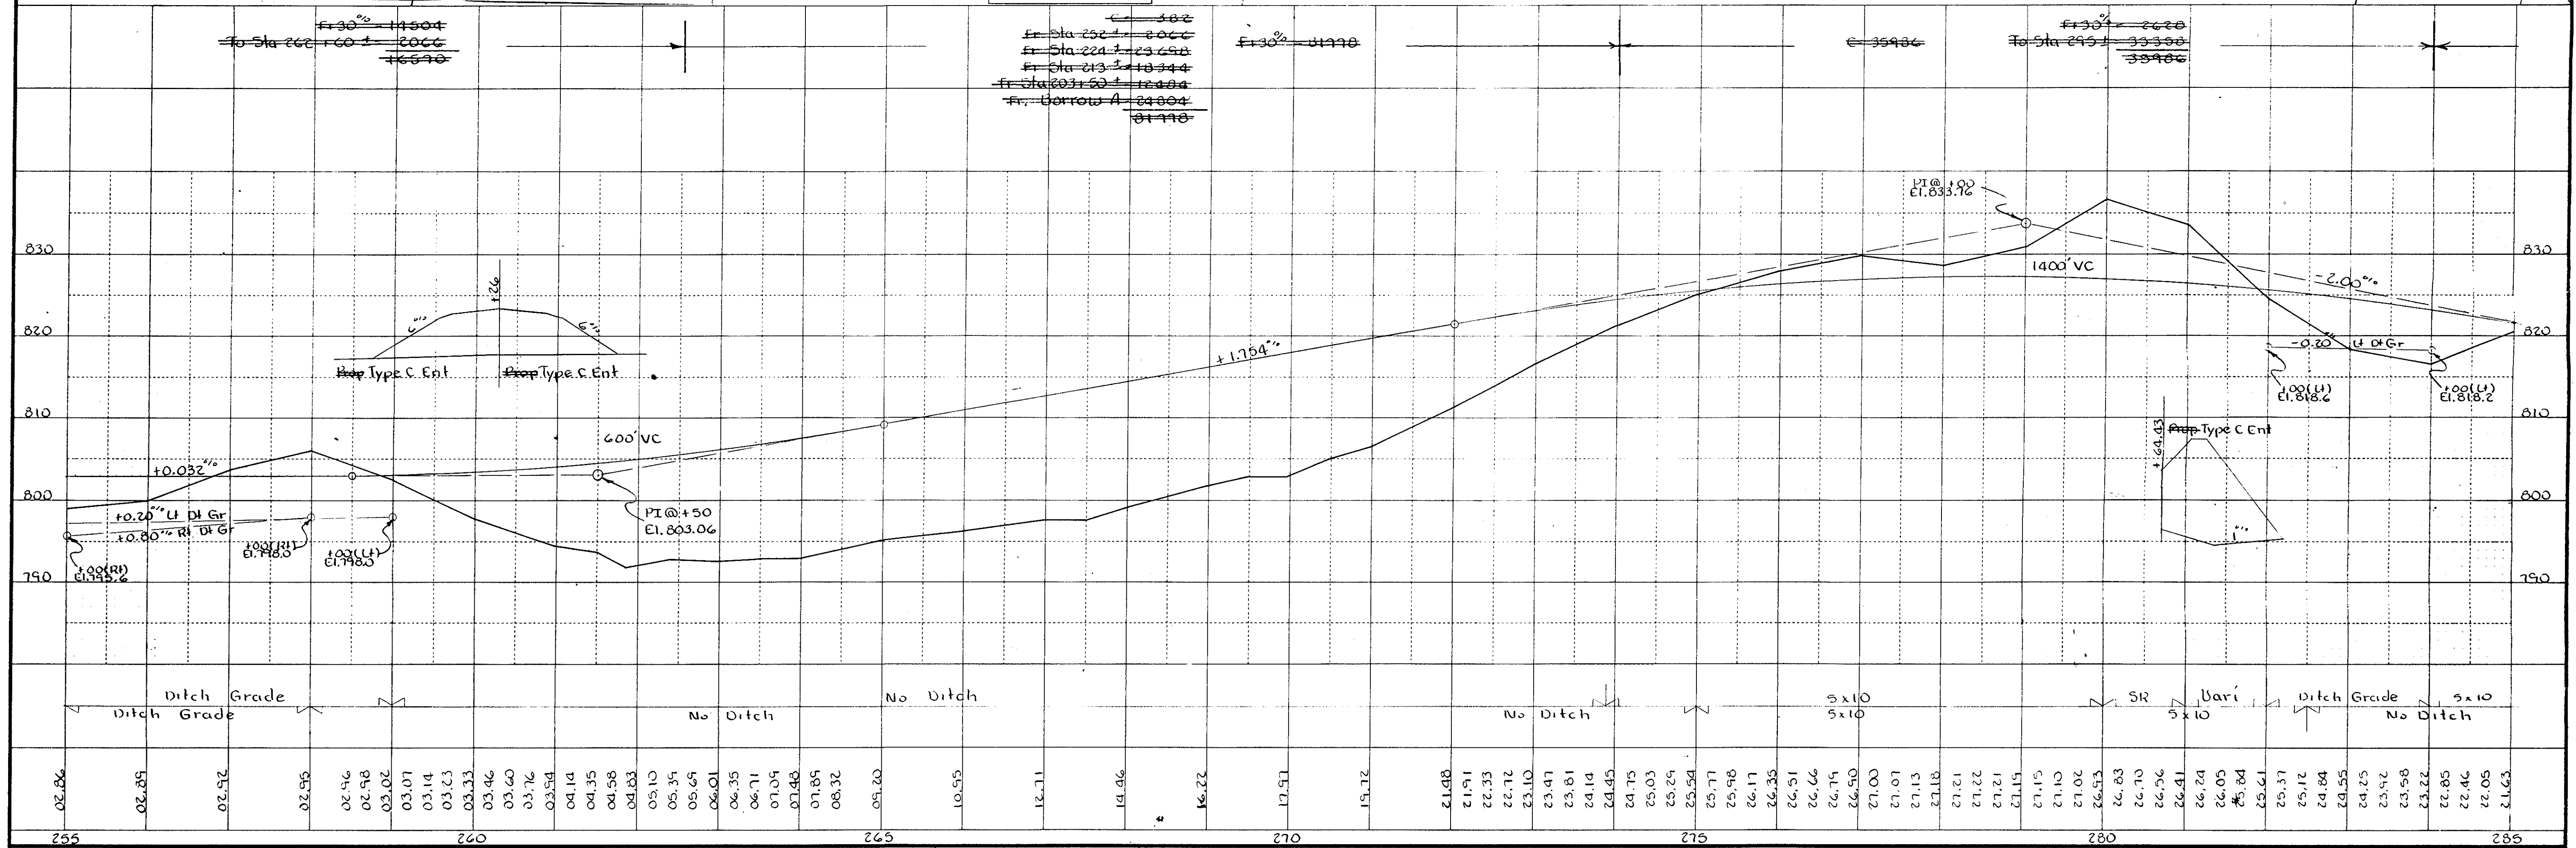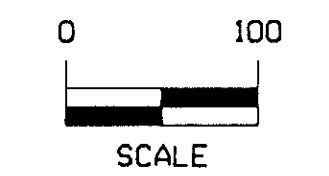



P.36 D4


- 54 Linn Co. Conservation
- 56 John P. & Frances E. Hennessey
- 57 City of Marion
- 58 Irma Holloway



MARION TWP
T-83N R-6W
SEC. 5



Predetermined Access Locations
Sta 292+29.83(OR) PL U Only
Sta 307+18.55(OR) Type C Ent U - Co. Rd Rt

See Sheet R.02 for
Details of Borrow B

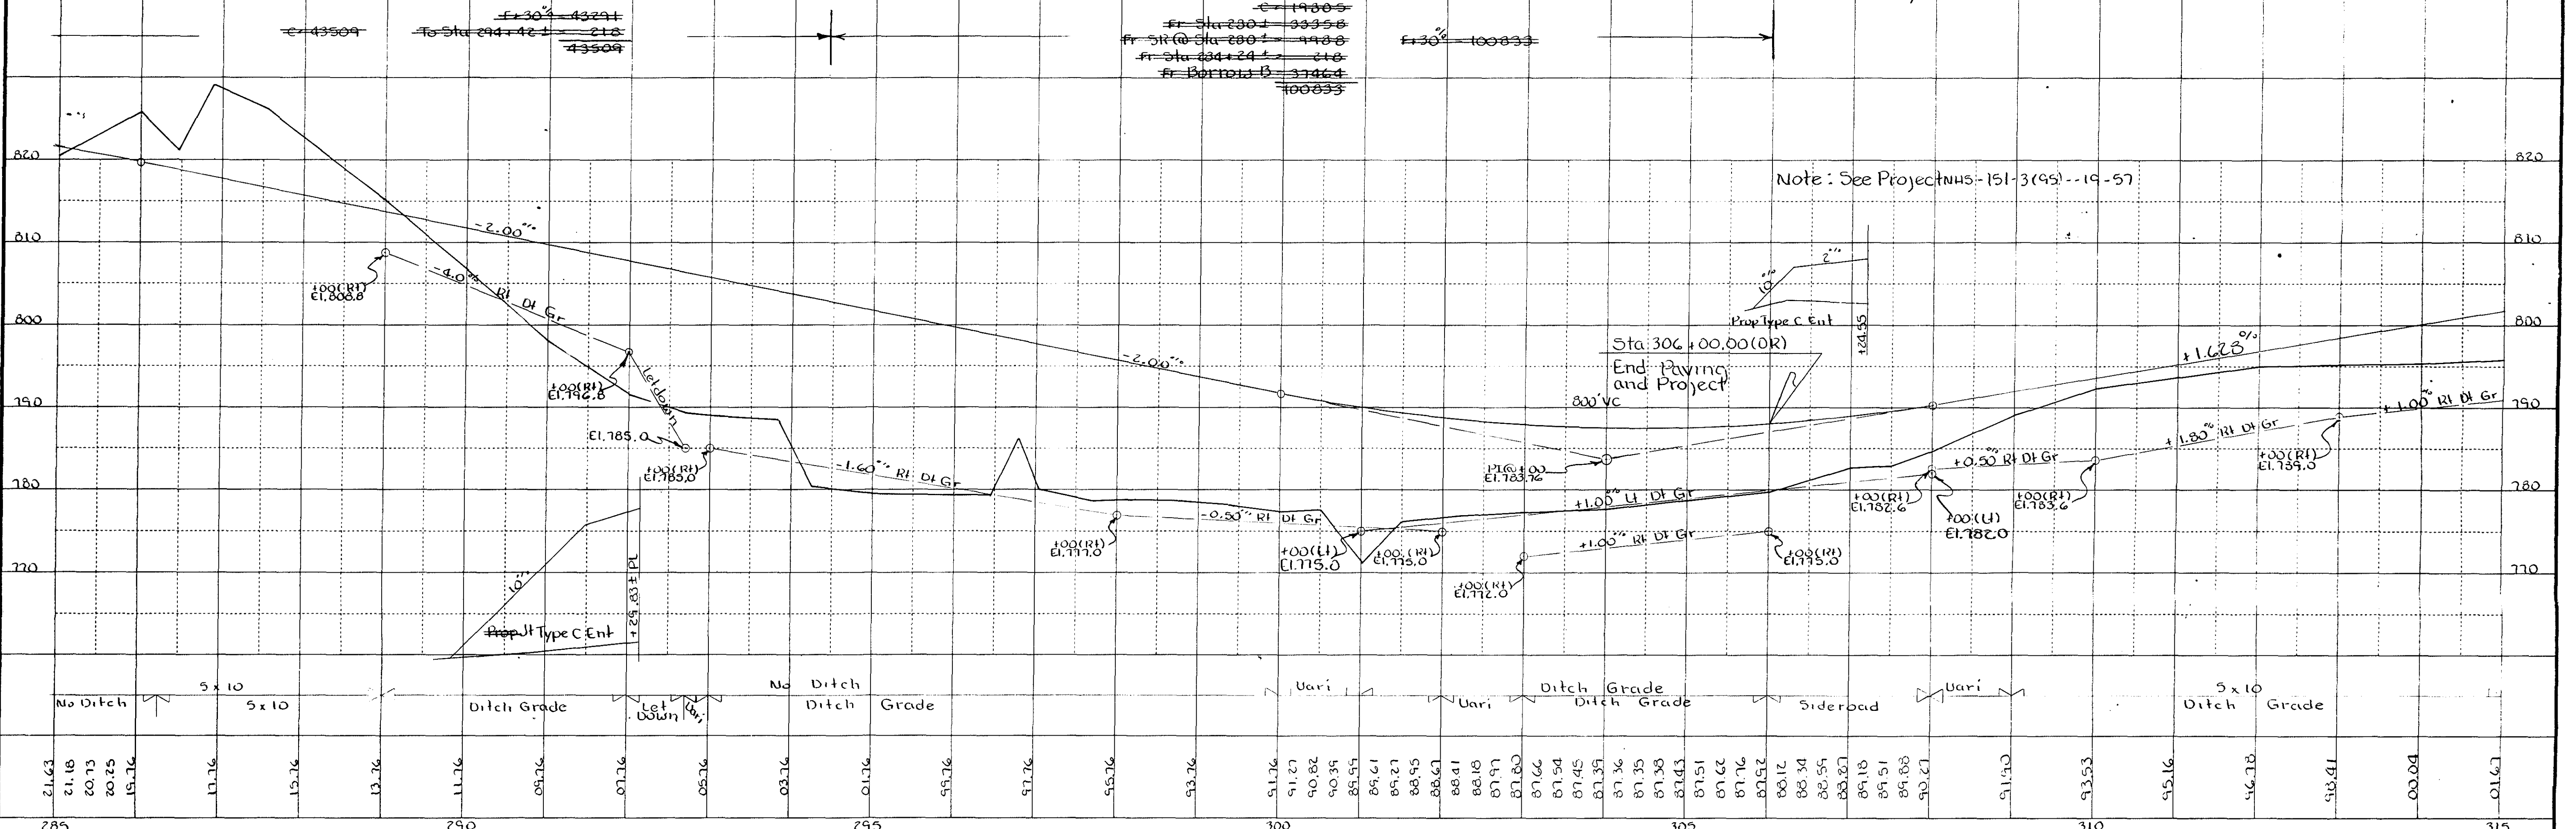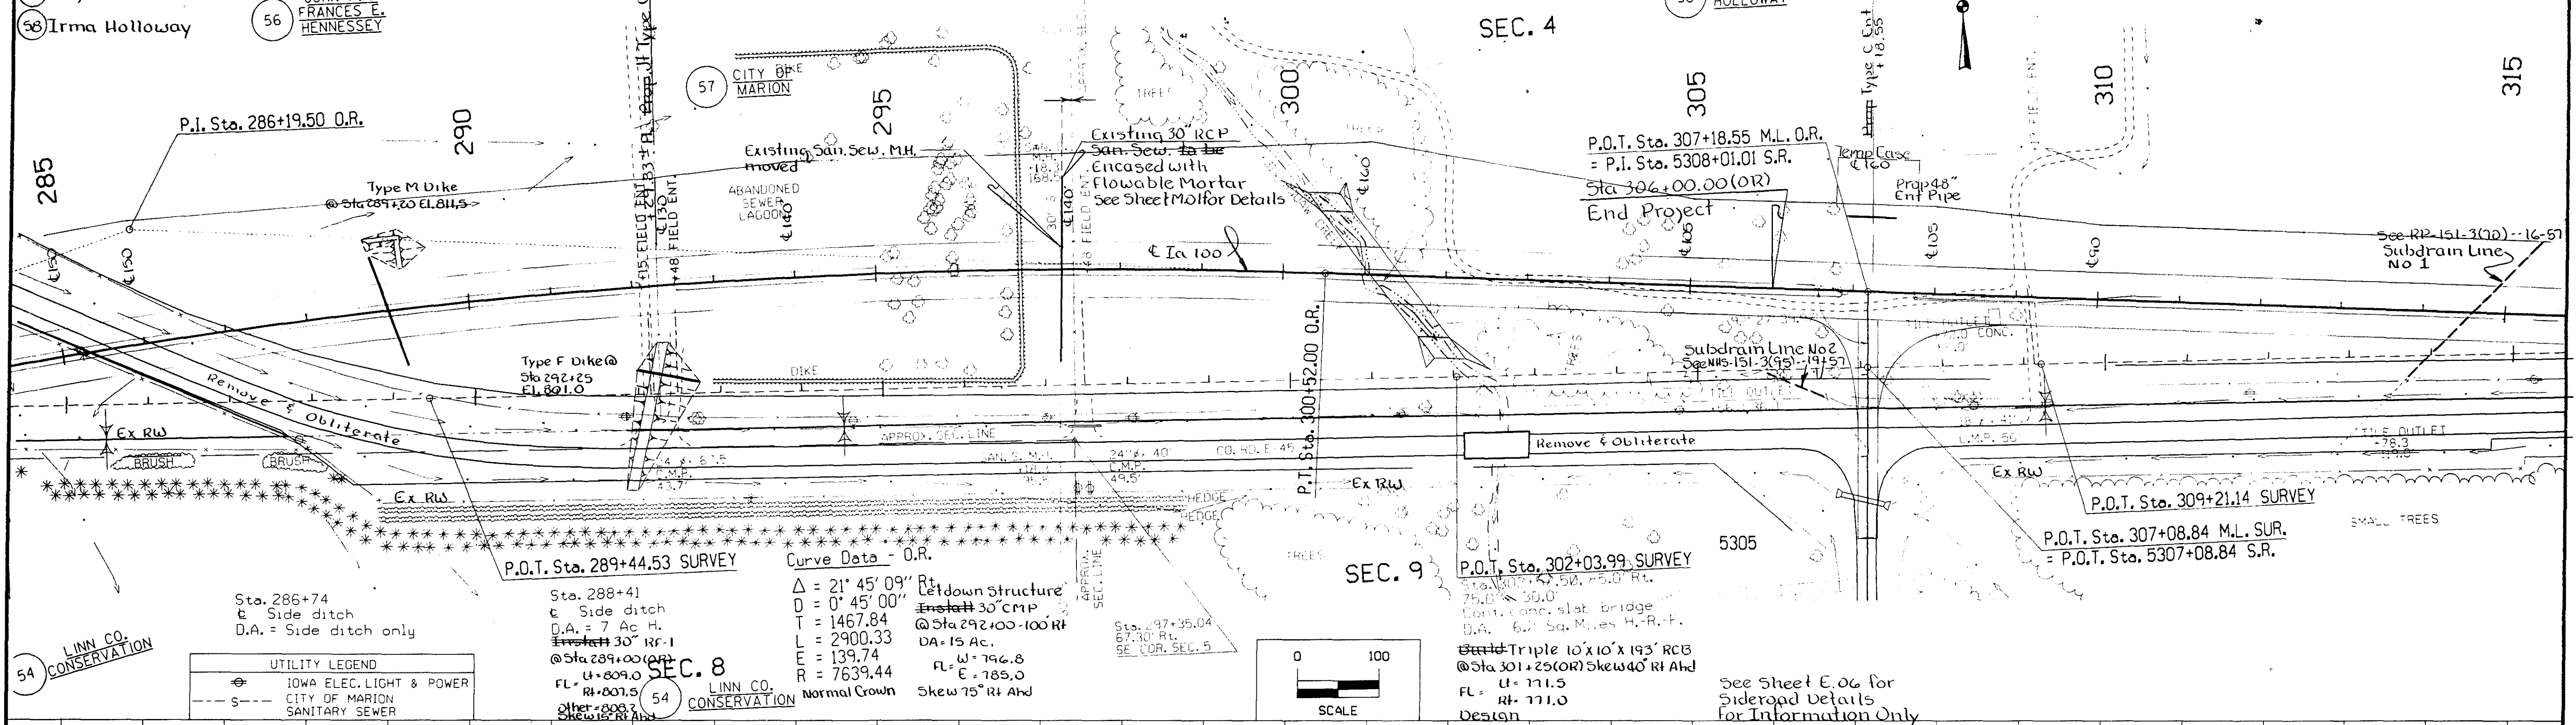

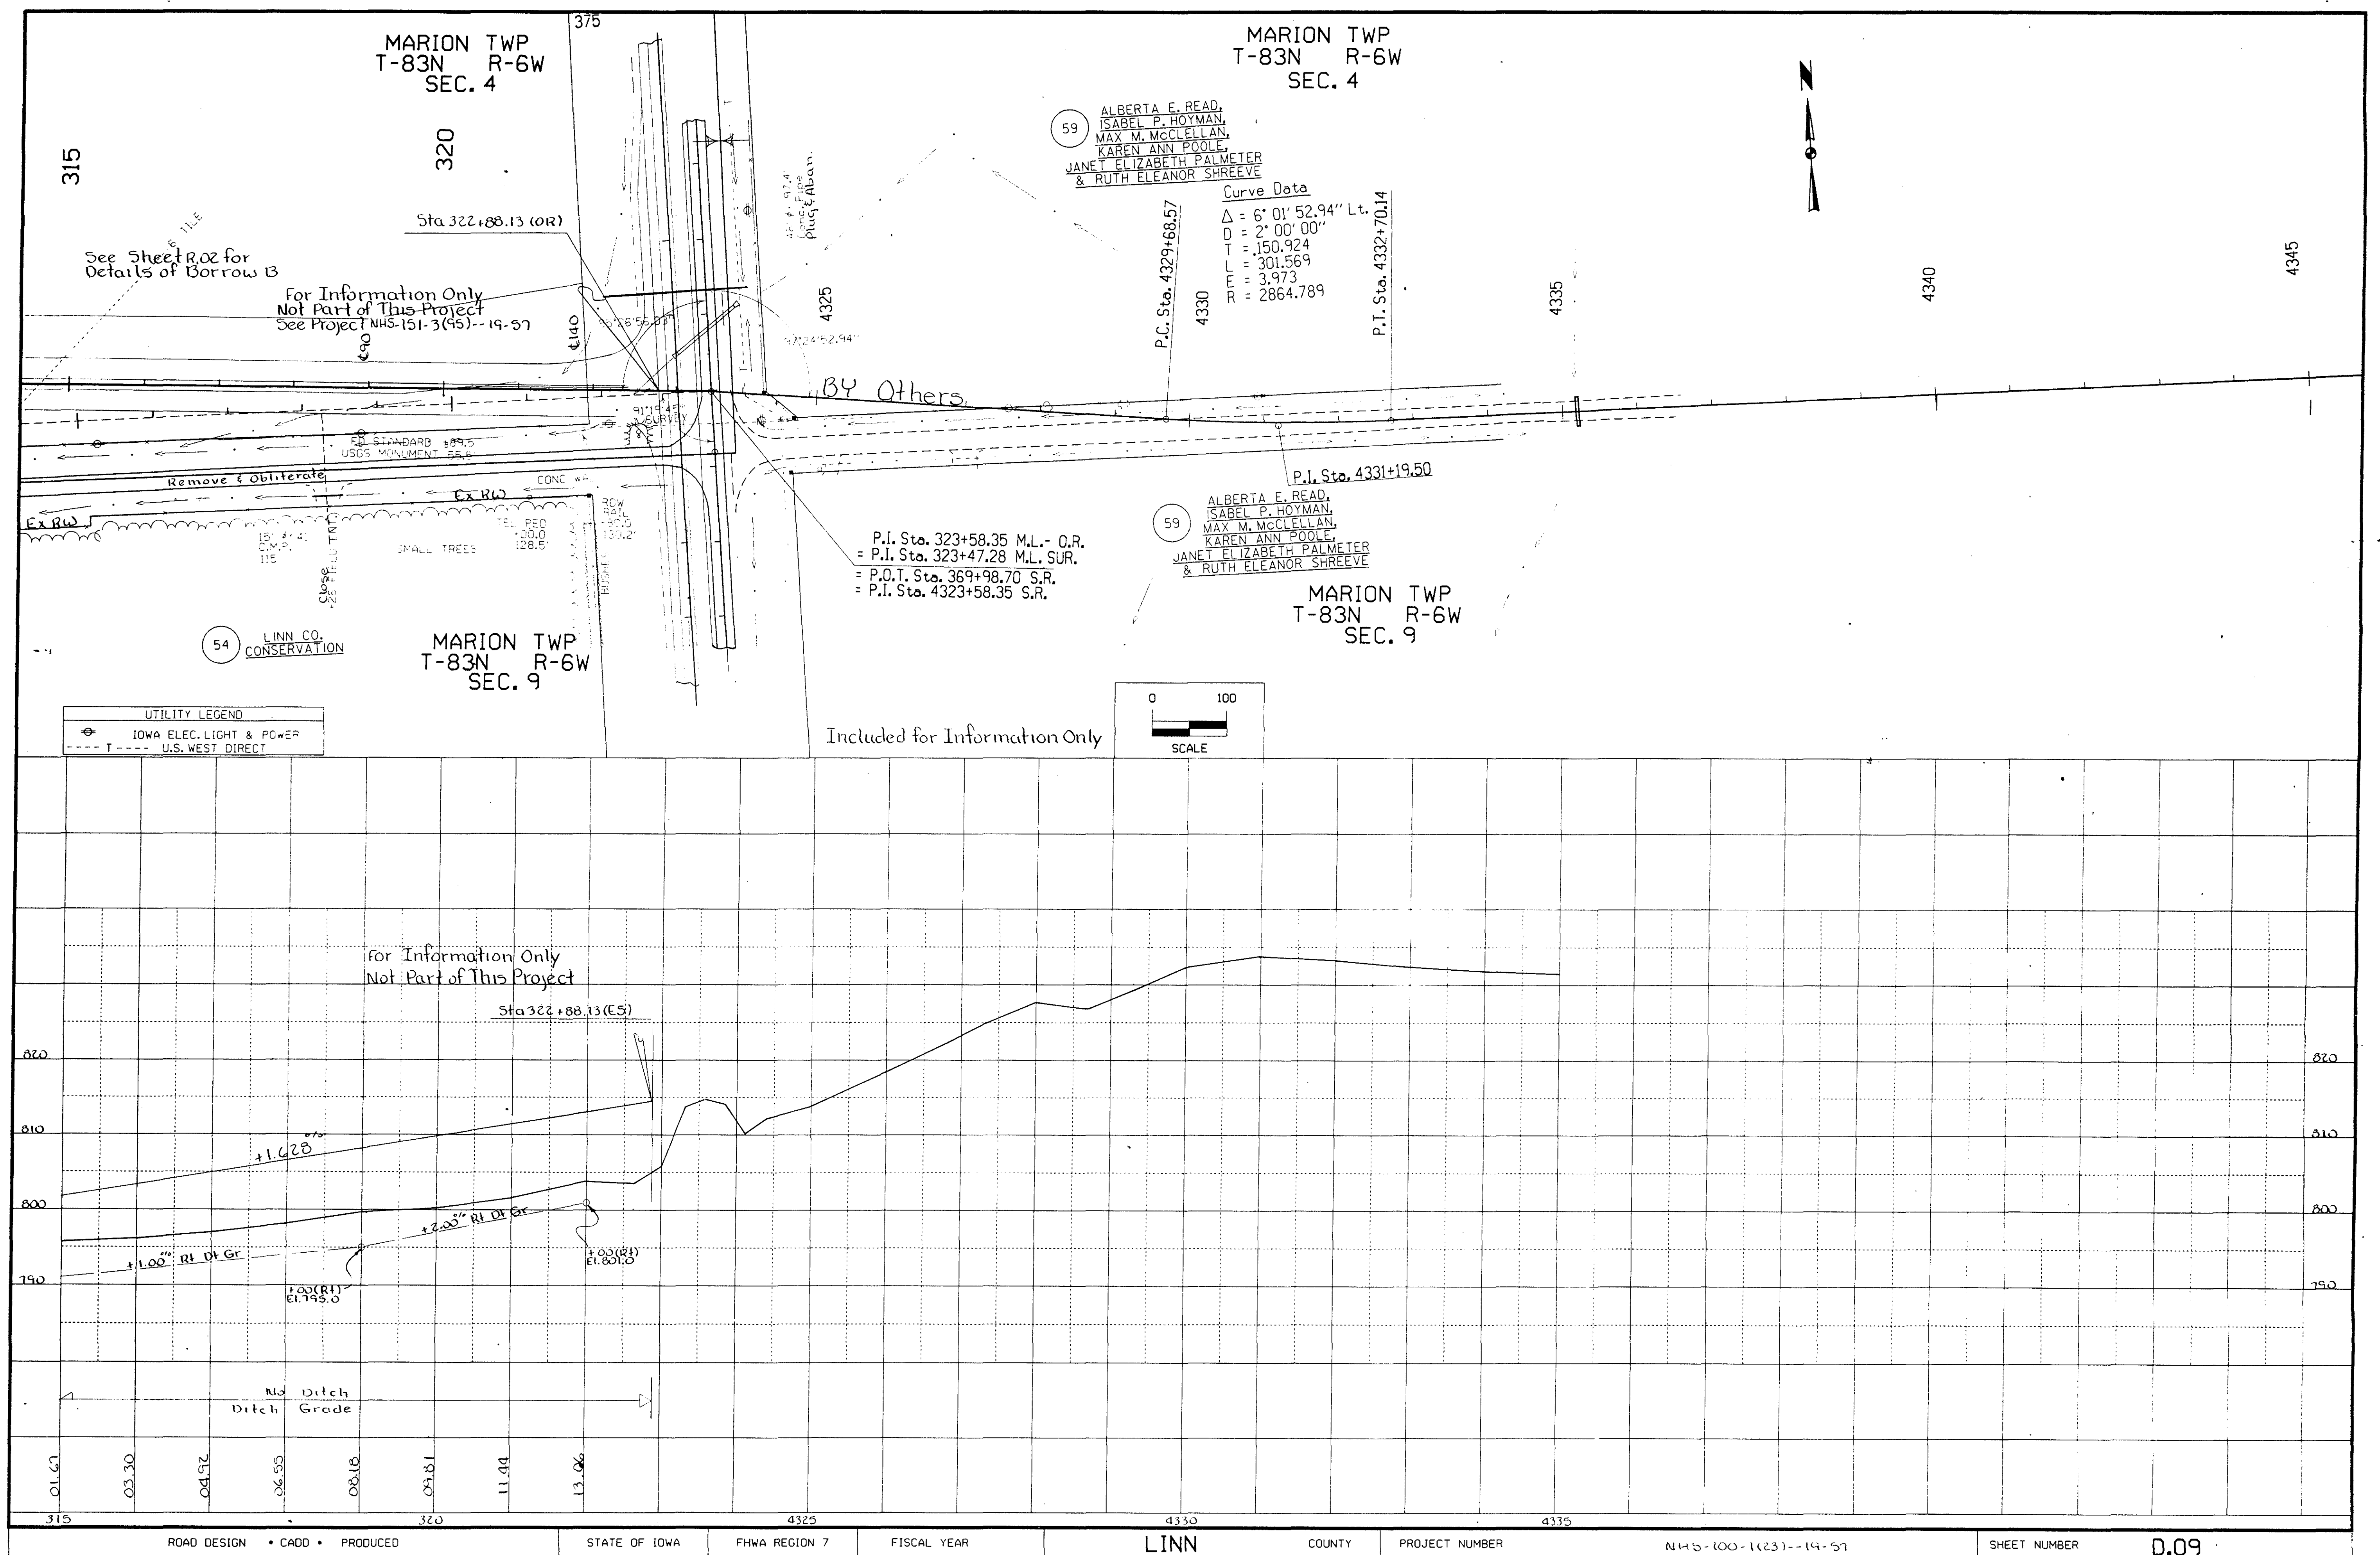

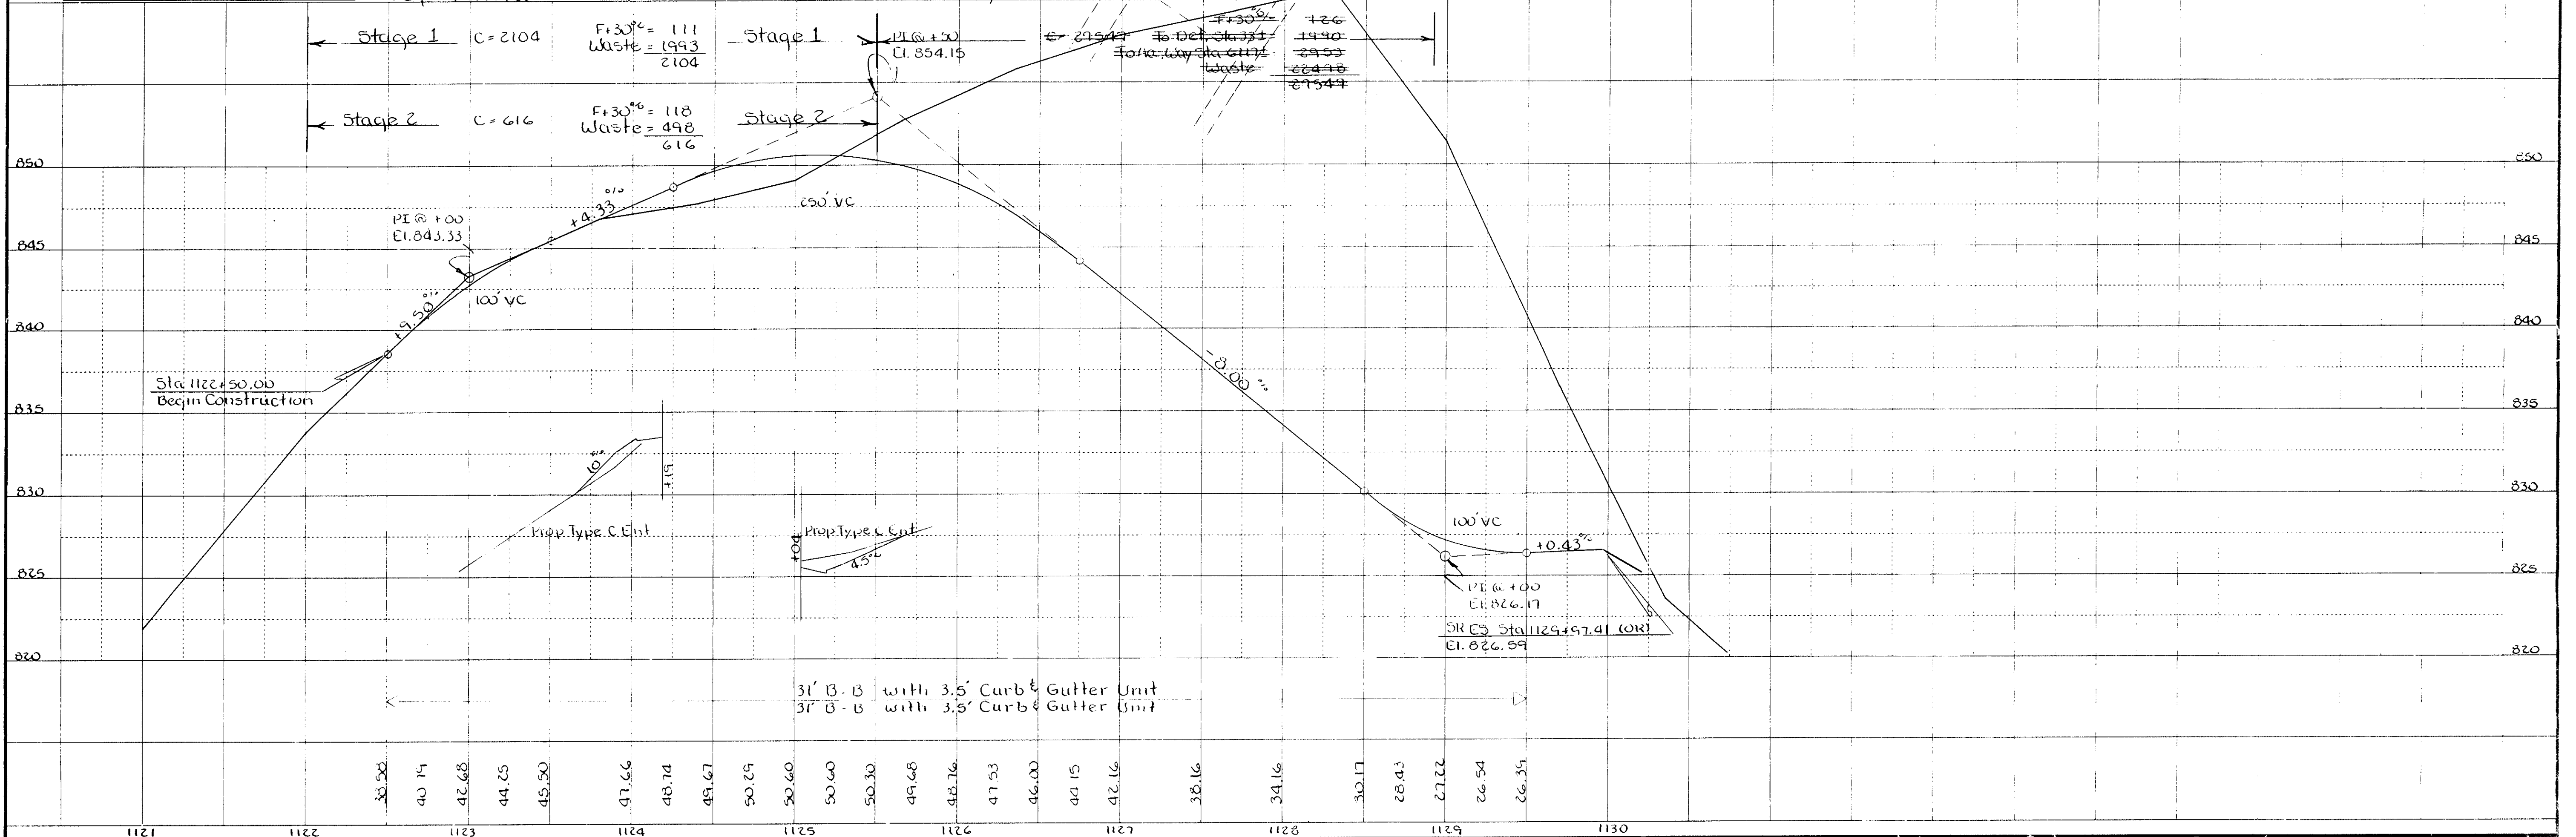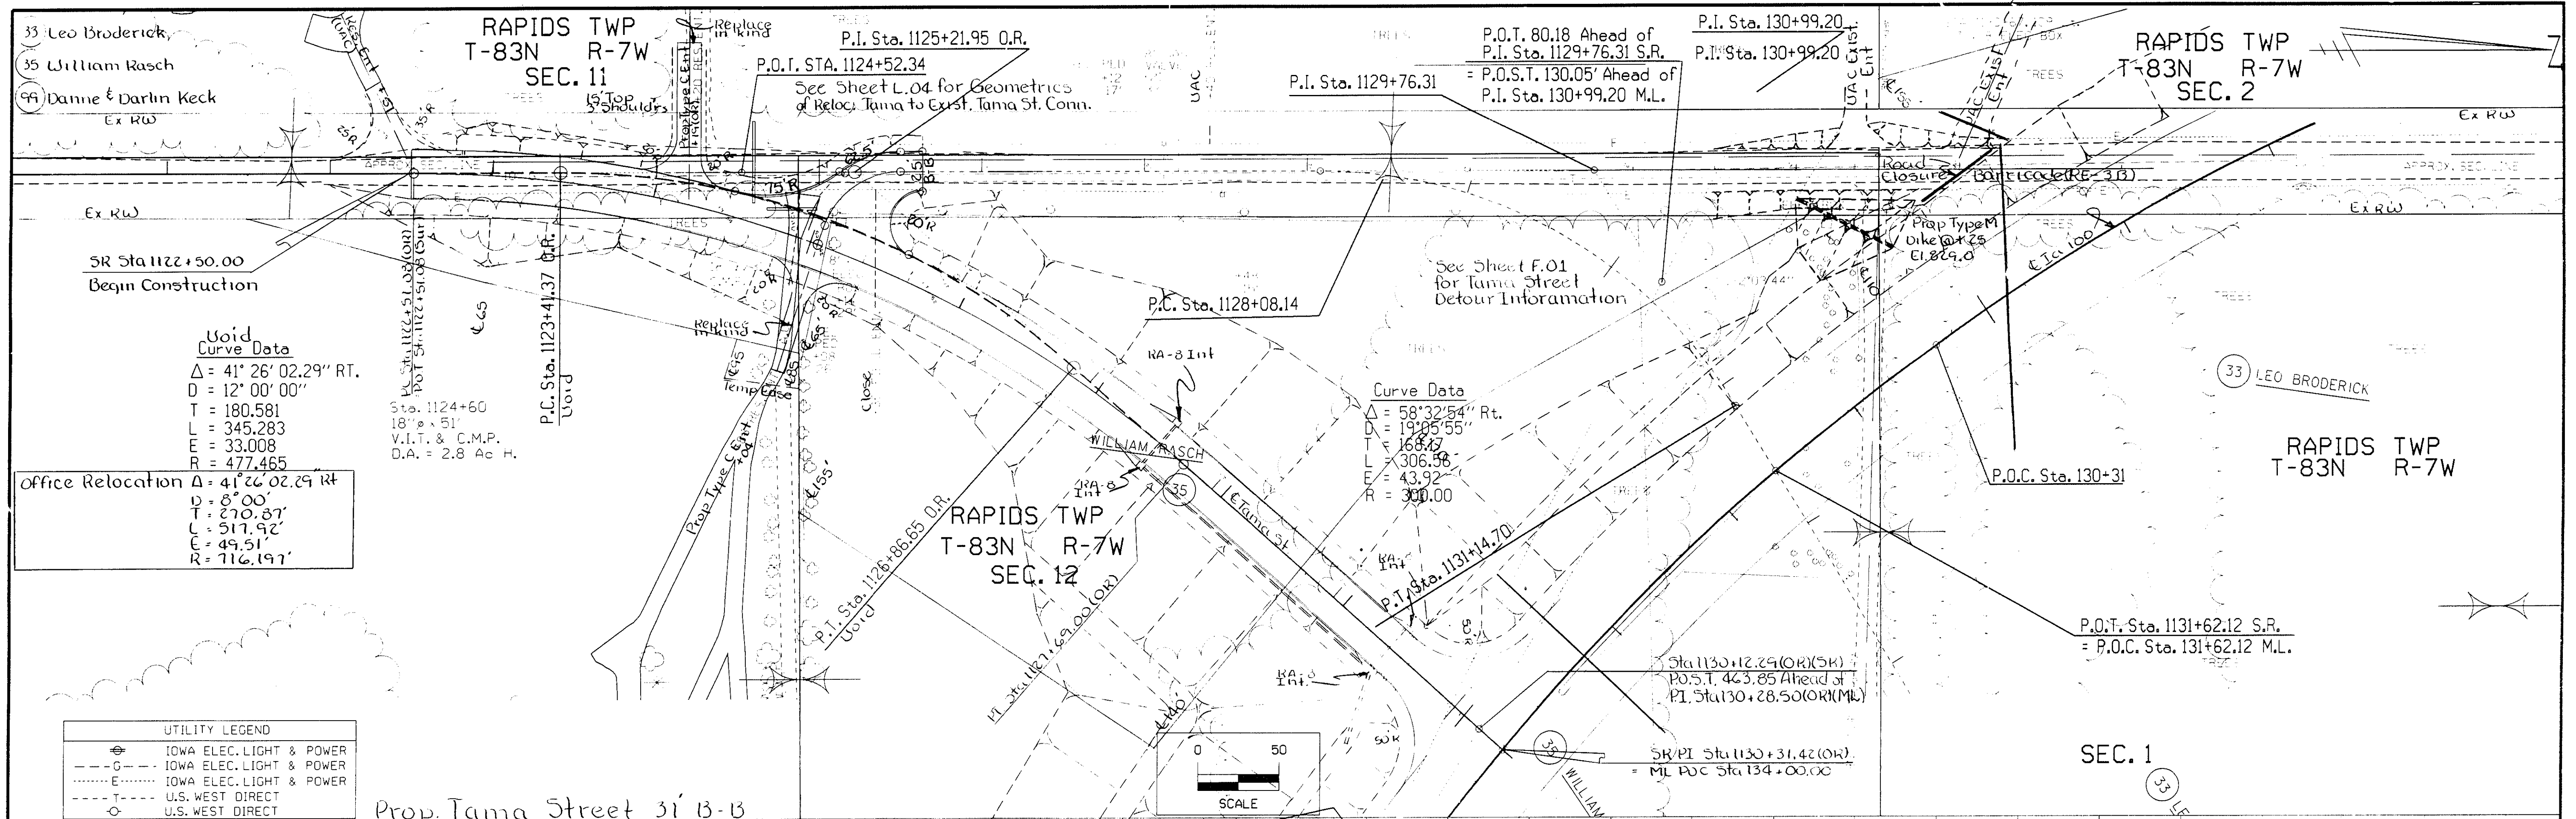

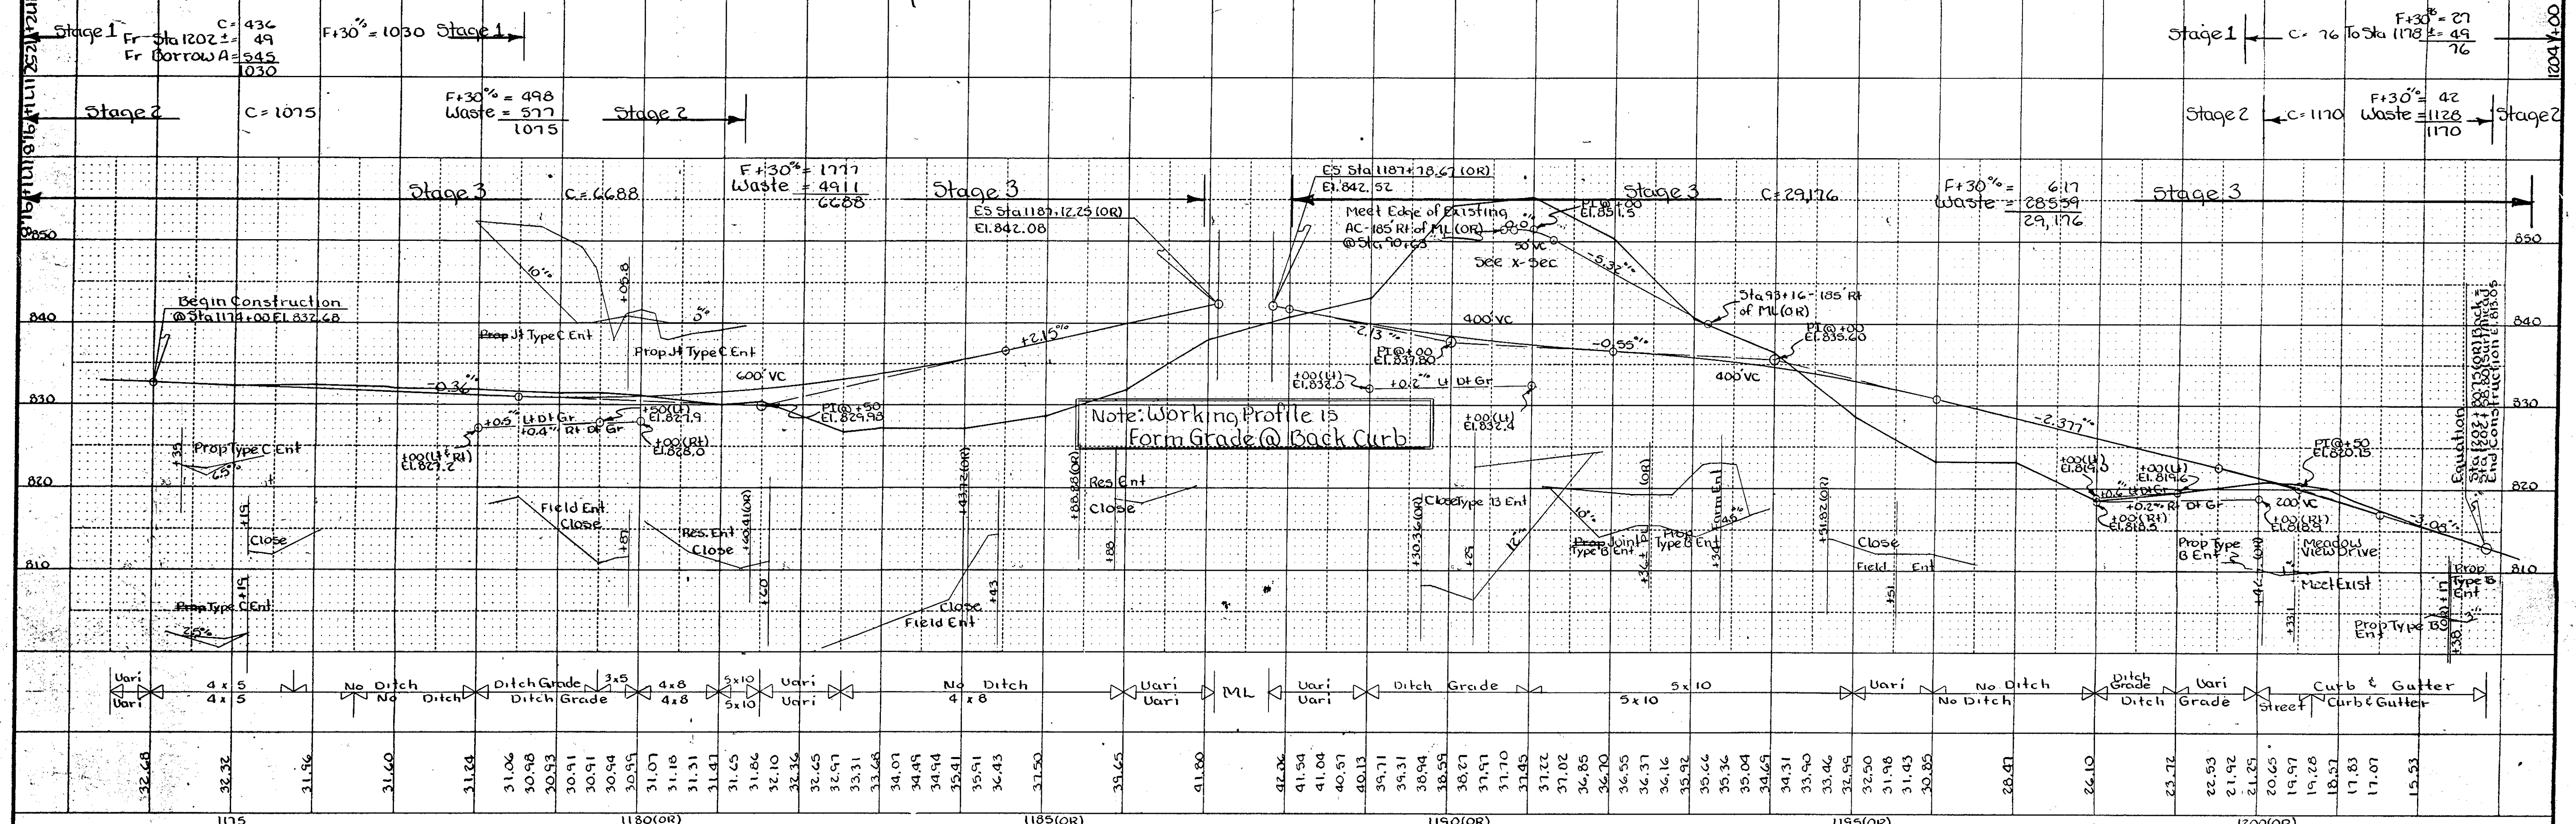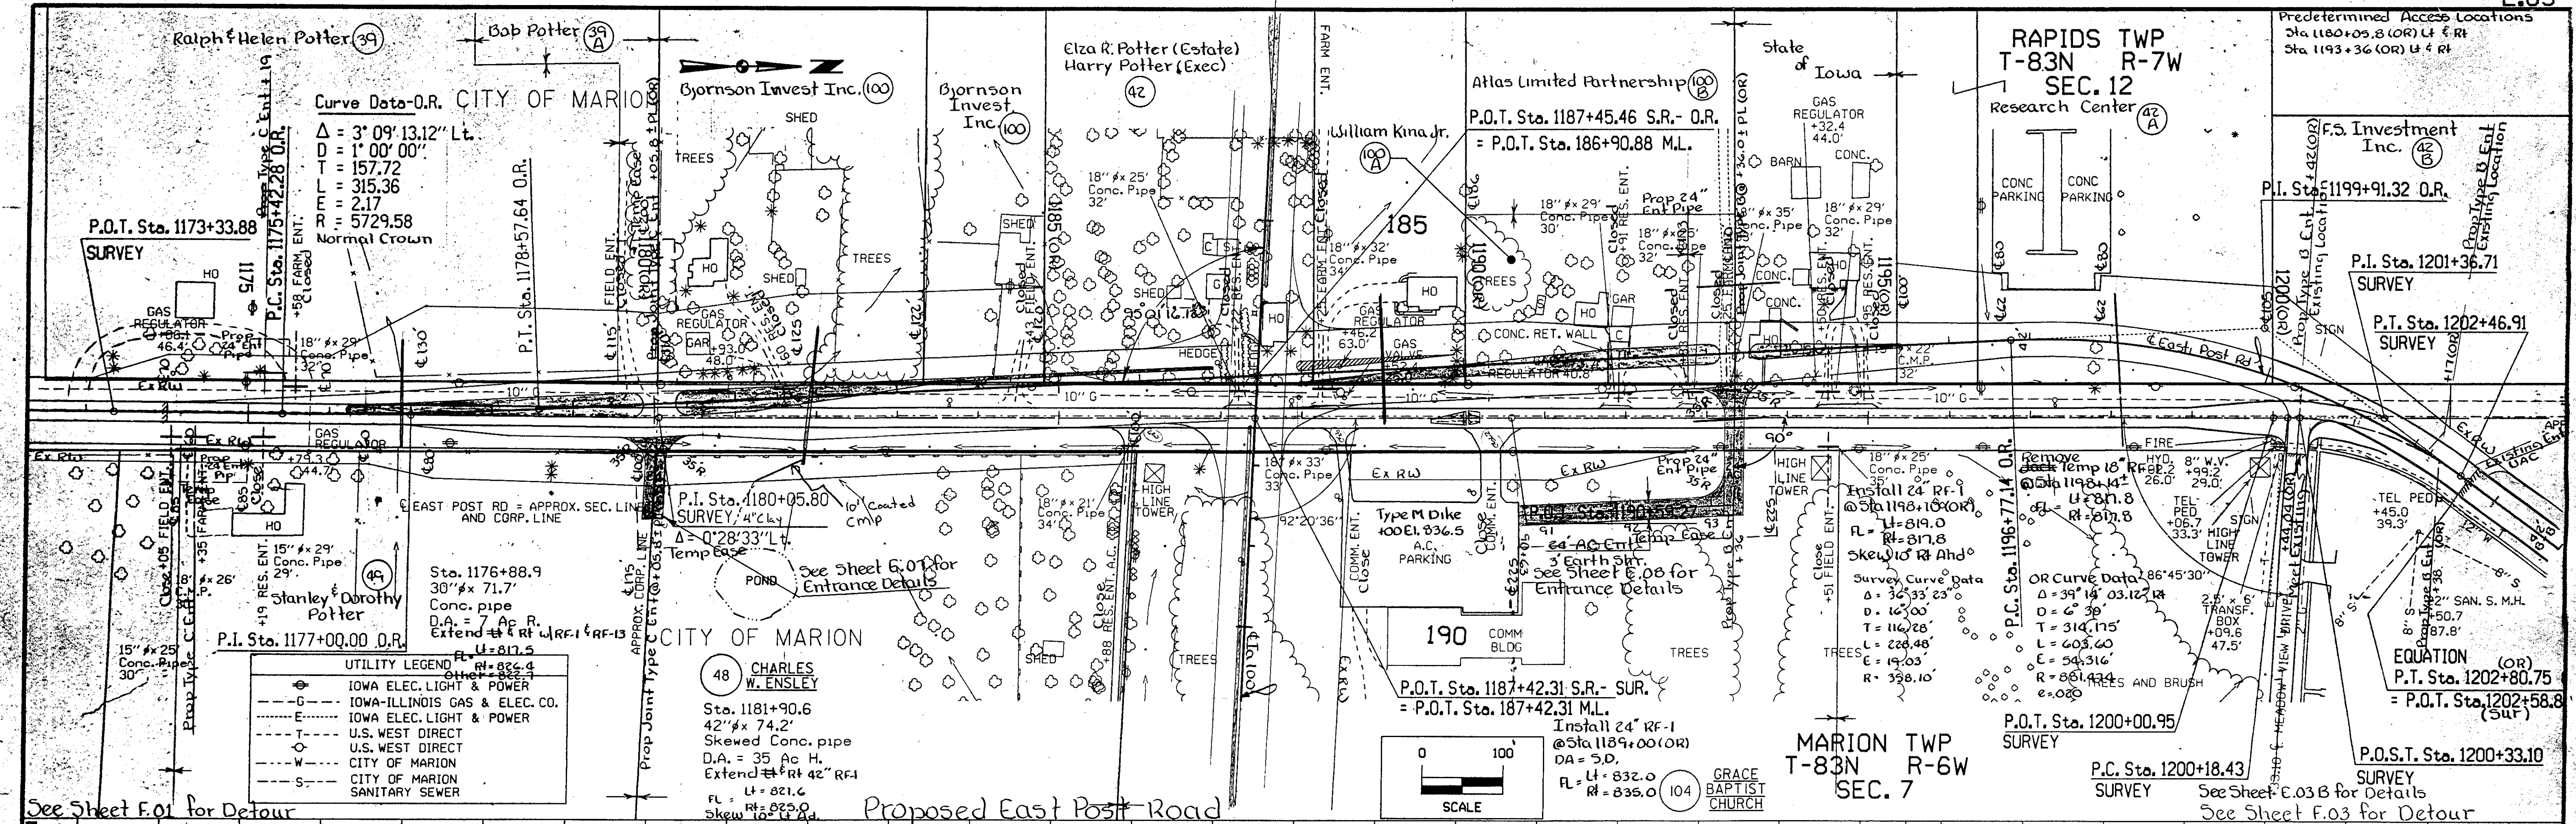

- 50 William Kettlecamp
- 51 Richard E. & Jean E. Tanner
- 103 State of Iowa
- 106 James Copper

P.O.T. Sta. 2215+49.77 S.R. SURVEY
= P.O.C. Sta. 215+49.68 M.L.


P.O.T. Sta. 2215+25.85 S.R. SURVEY
= P.O.S.T. Sta. 215+49.64 M.L.

Sta 2211+50.00
Begin Construction
P.I. Sta. 2214+59.81
SURVEY AND O.R.

P.I. Sta. 2211+35.37

P.I. Sta. 2204+76.52

Curve Data
Δ = 10°53'48" Rt.
D = 2'00'00"
T = 273.24
L = 544.83
E = 13.00
R = 2864.79

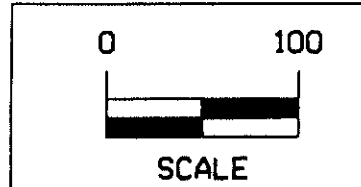

Curve Data
Δ = 6°47'44" Rt.
D = 2'00'00"
T = 170.09
L = 339.78
E = 5.04
R = 2864.79

Sta 2214+92
Side Ditch
D.A. 22 Ac H
12" x 32" Conc Arch Pipe
Sta 2214+40
FL = 845.5
RI = 844.0

Curve Data
Δ = 19°18'25" Rt.
D = 10'00'00"
T = 97.46
L = 193.07
E = 8.23
R = 572.96

Sta. 2219+56.0, 86.0' Lt.
22" SAN.S. M.H.
Sta. 2219+70.4, 36.1' Lt.
8" WATER VALVE

EQUATION
P.T. Sta. 2215+55.42 O.R.
= P.O.T. Sta. 2215+57.27 SURVEY


Sta. 2220+94.3, 16.4' Lt.
24" GRATE INTAKE
Sta. 2222+31.8, 32.5' Lt.
FIRE HYDRANT

Sta. 2222+64.2, 125.3' Lt.
22" SAN.S. M.H.



Sta. 2222+44.0, 30.5' Lt.
3" GAS VALVE



MARION TWP
T-83N R-6W
SEC. 7

UTILITY LEGEND	
	IOWA ELEC. LIGHT & POWER
	IOWA-ILLINOIS GAS & ELEC. CO.
	IOWA ELEC. LIGHT & POWER
	U.S. WEST DIRECT
	U.S. WEST DIRECT
	CITY OF MARION
	CITY OF MARION SANITARY SEWER

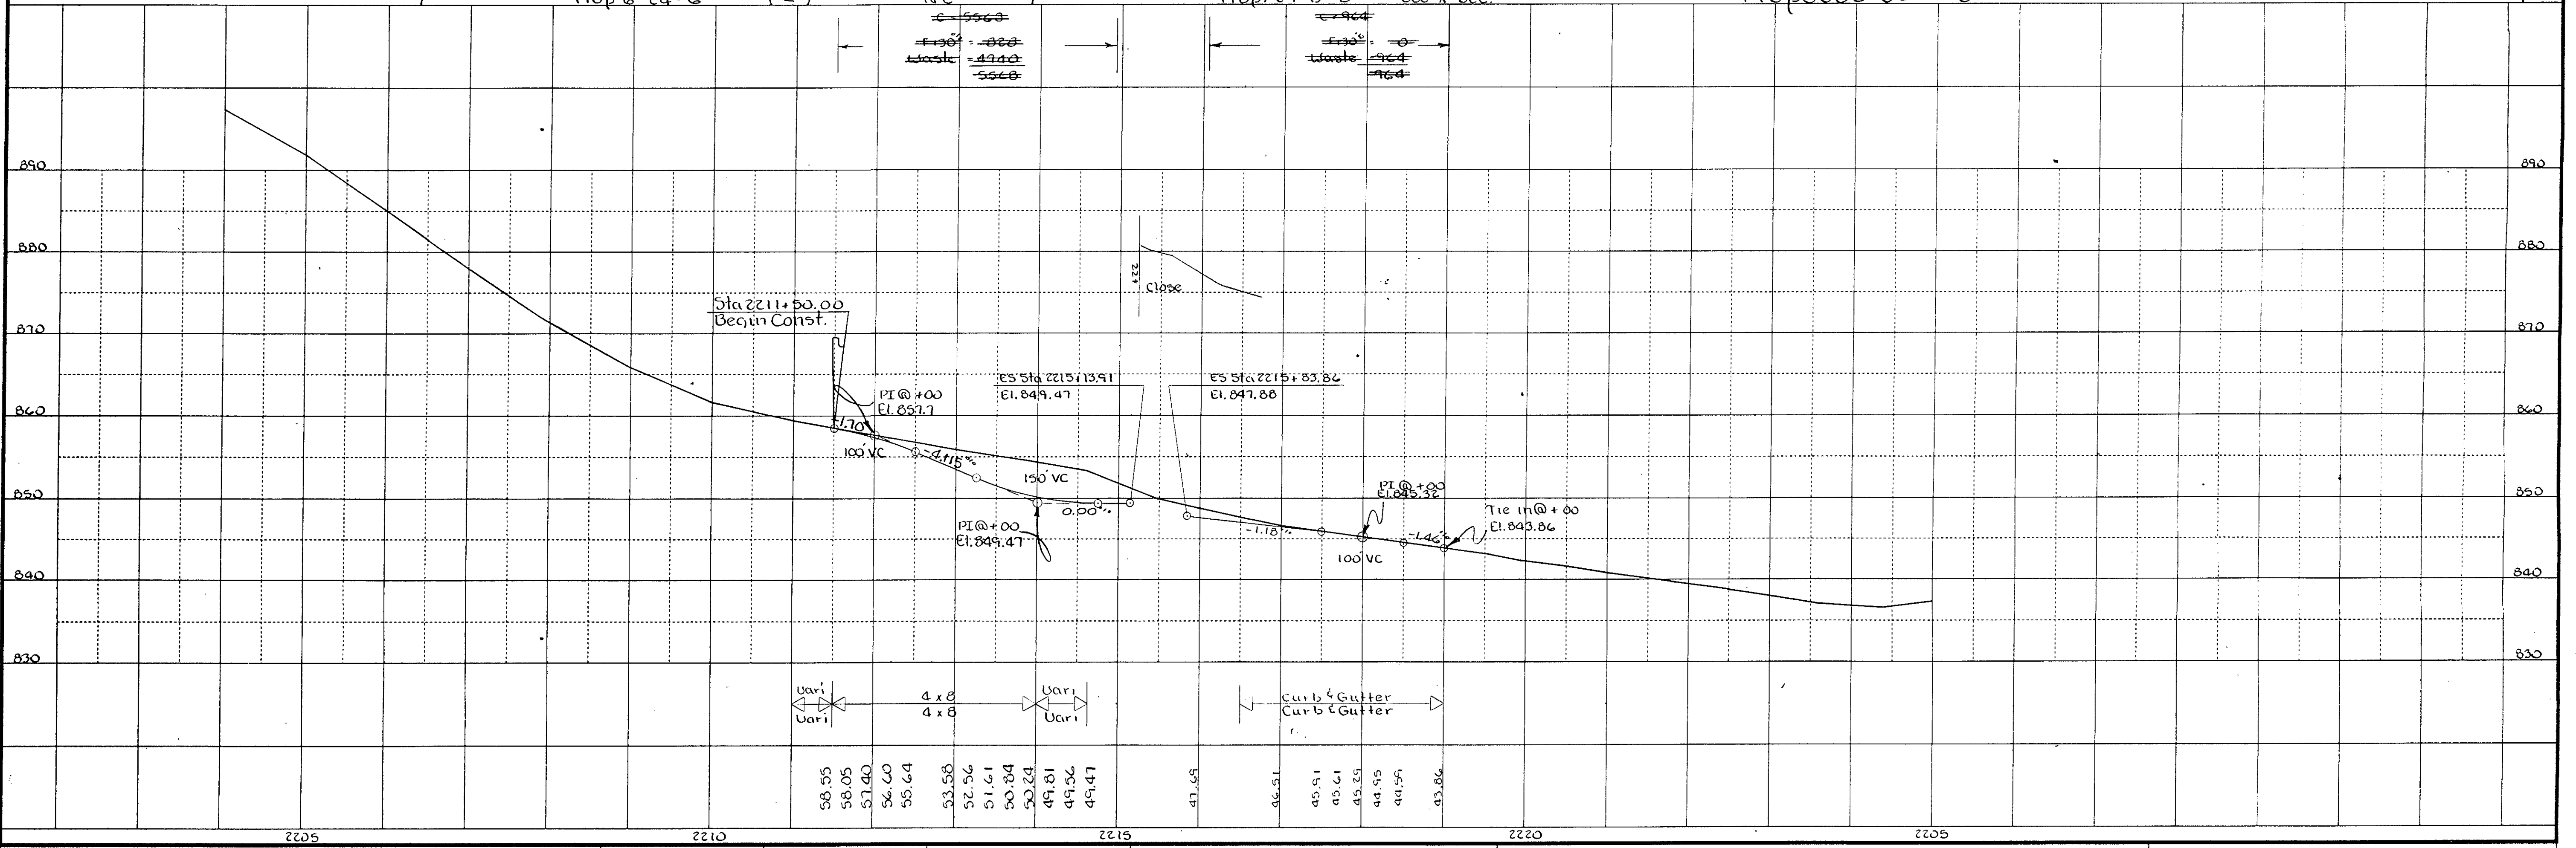



P43

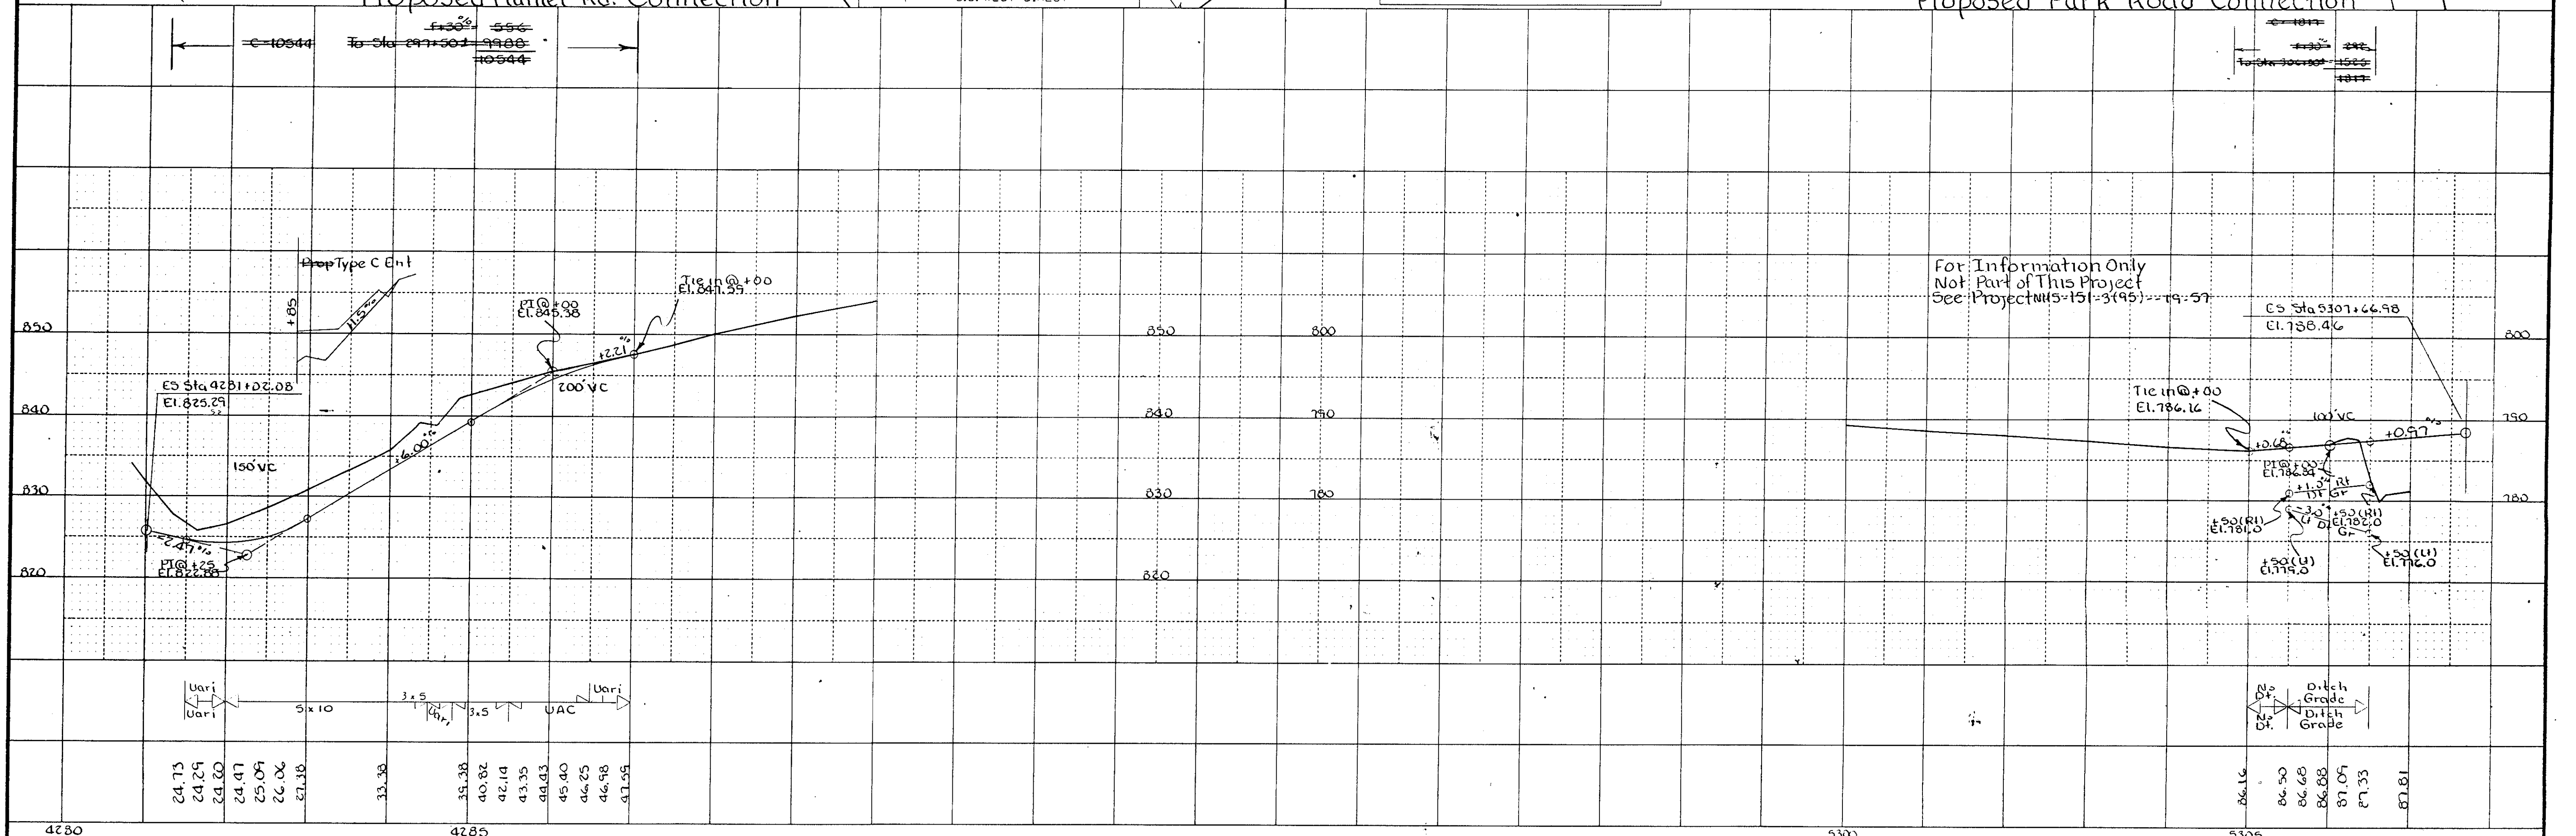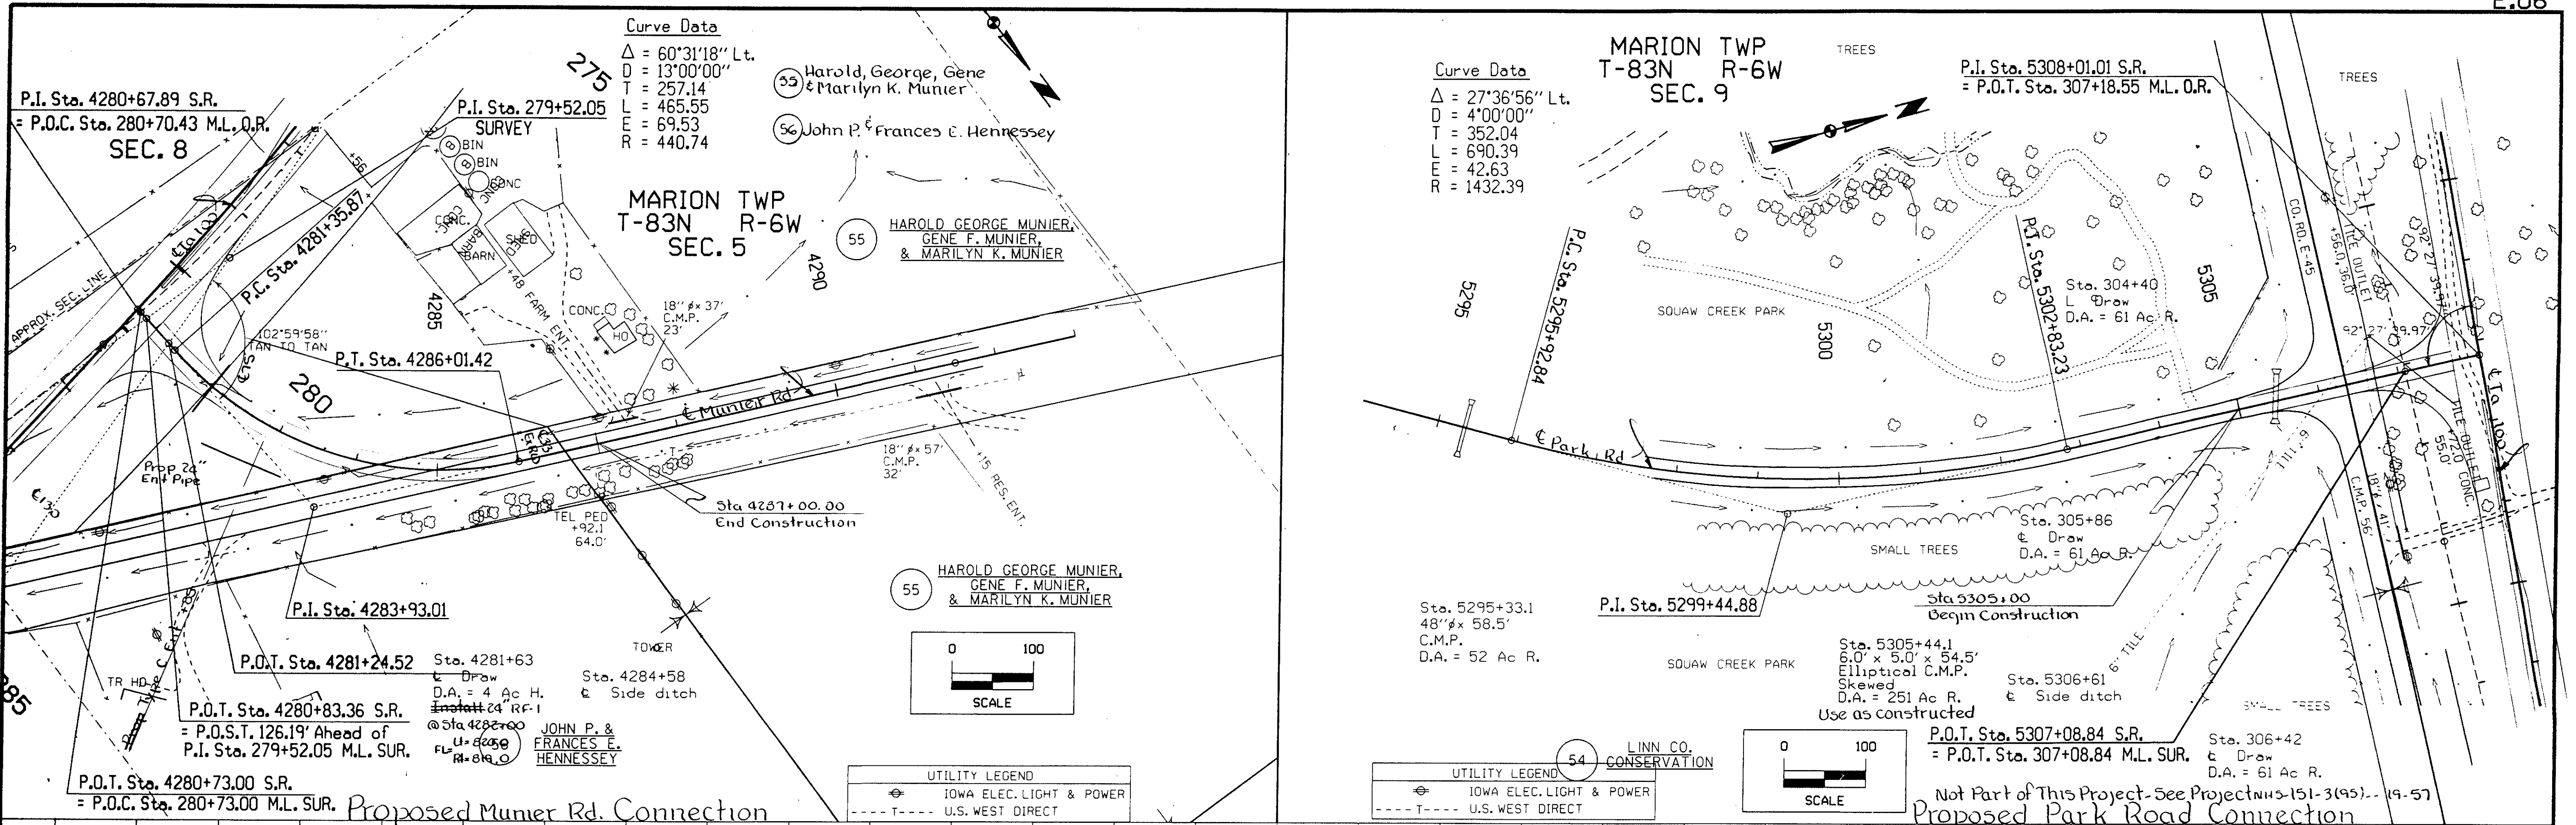

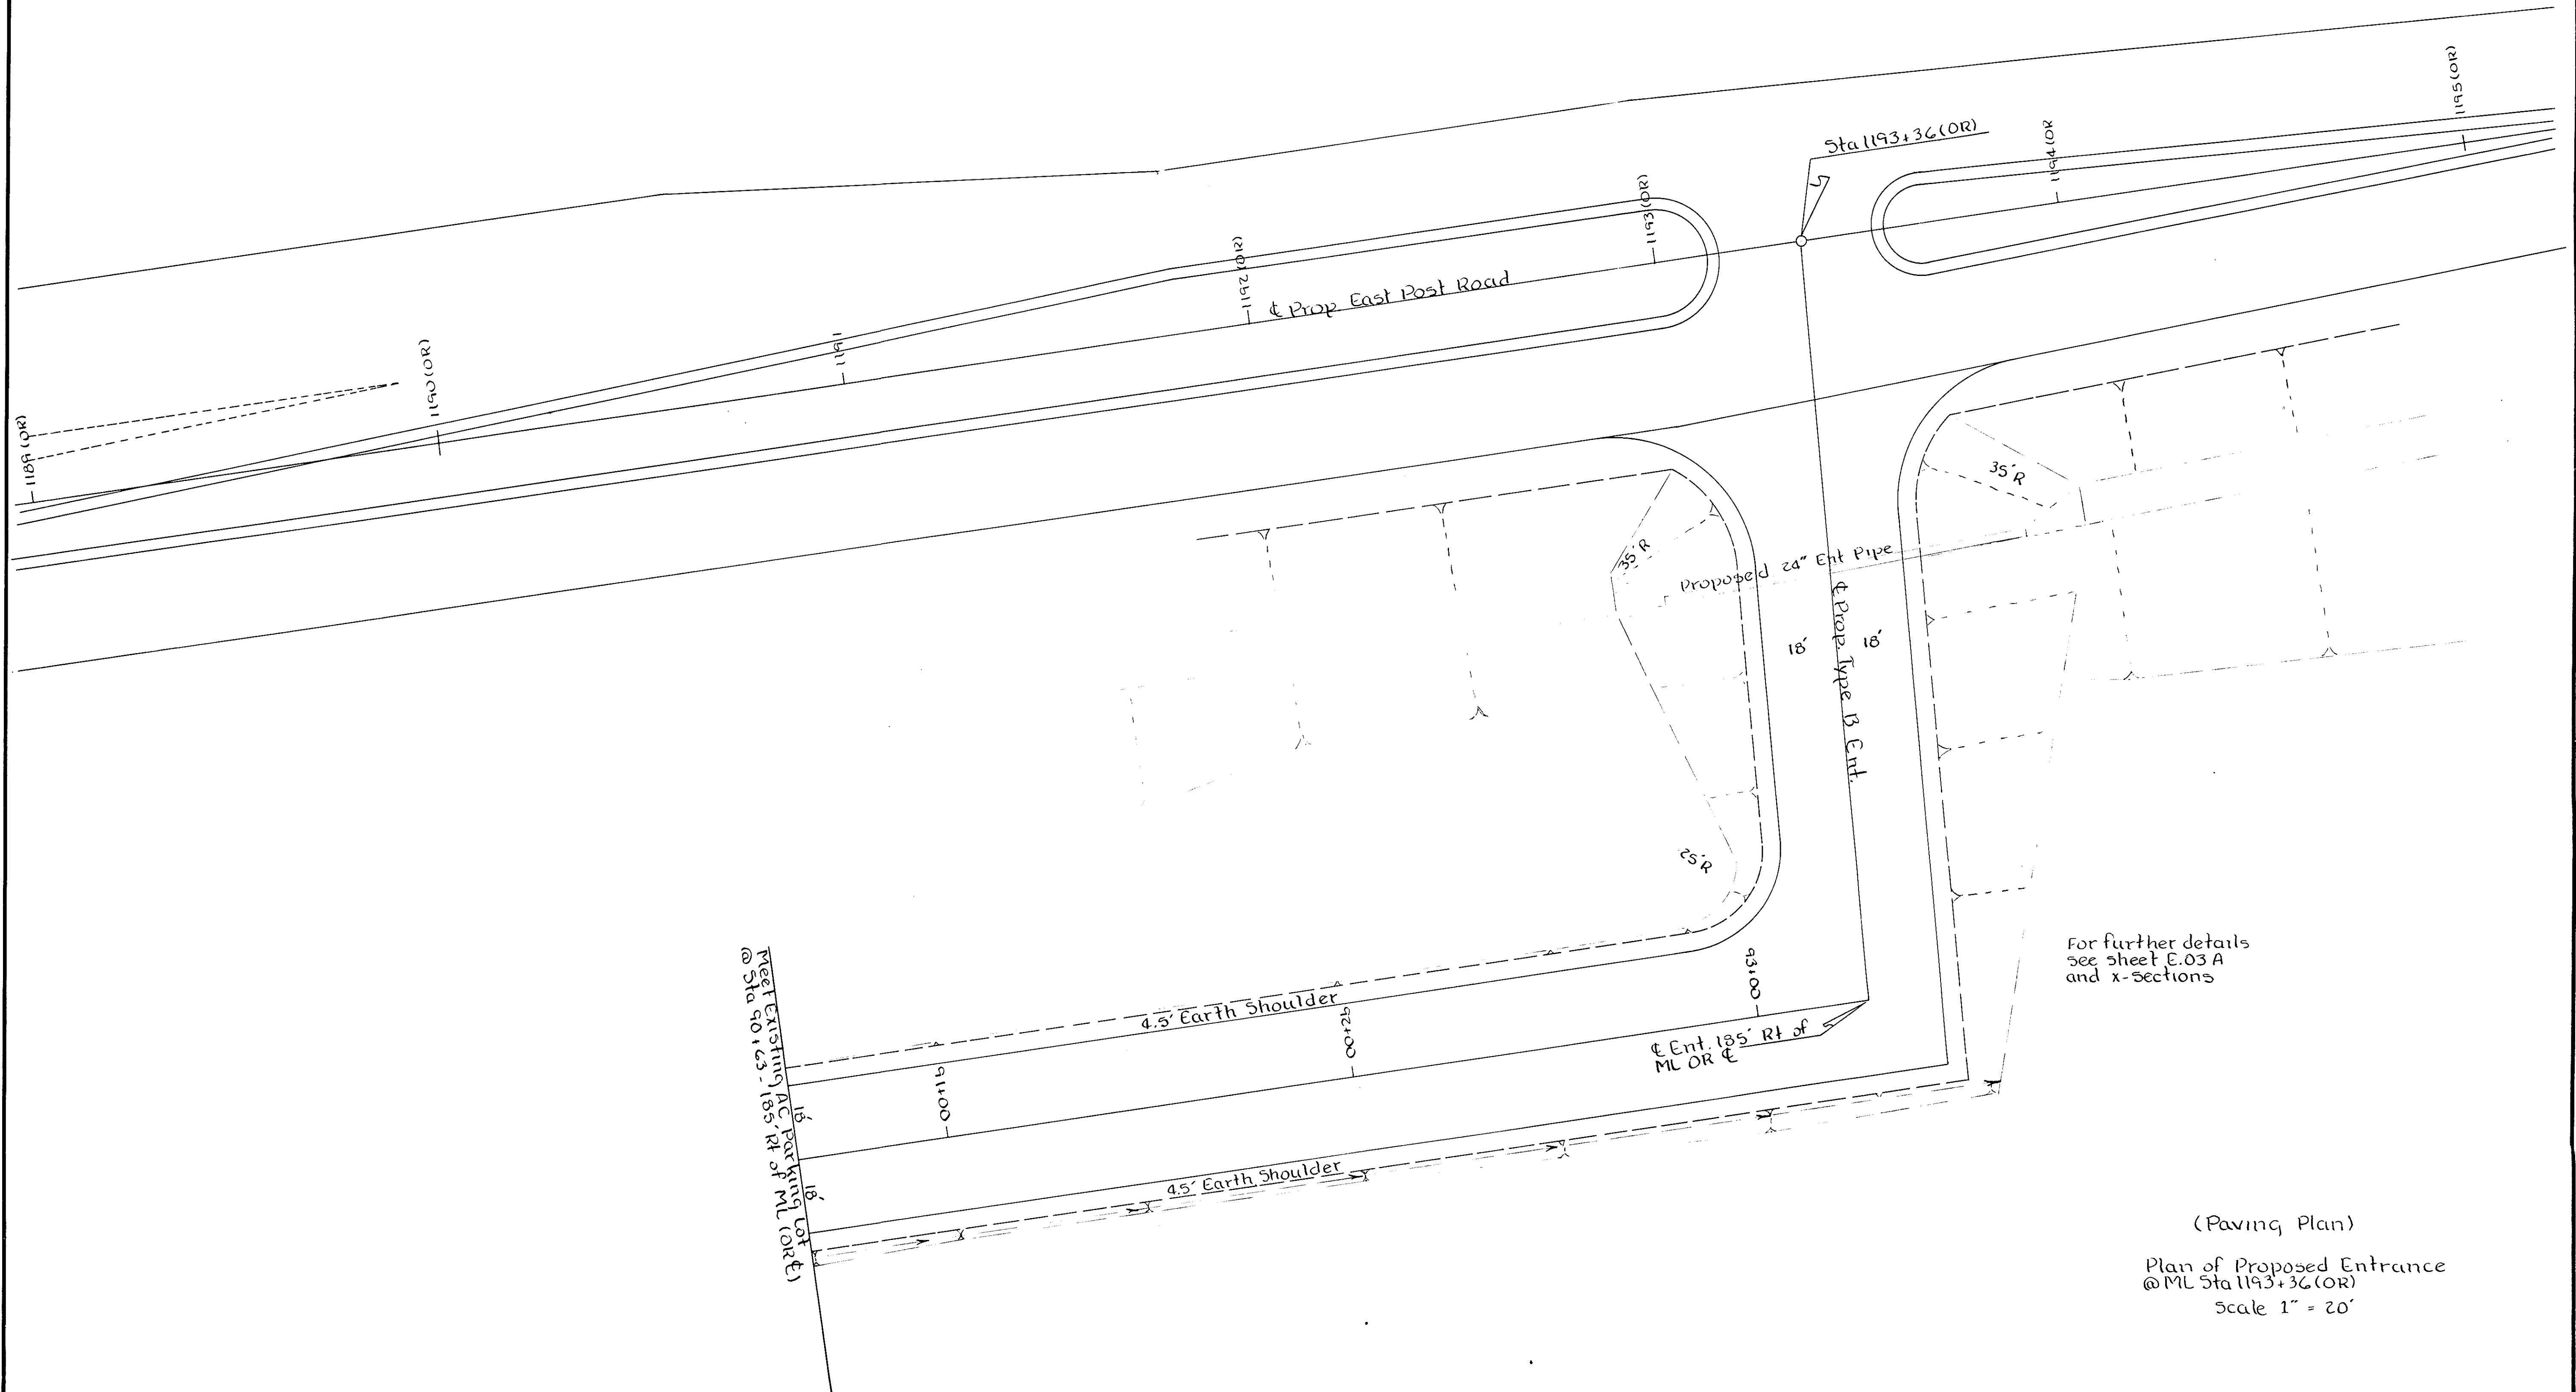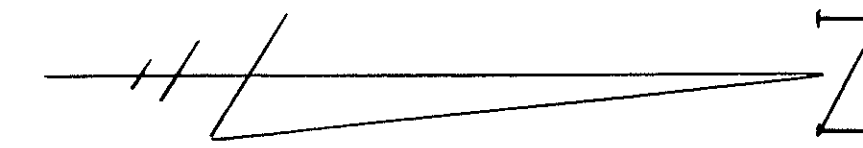



For further details
see sheet E.03 A
and x-sections

(Paving Plan)
Plan of Proposed Entrance
@ ML Sta 1193+36(OR)
Scale 1" = 20'

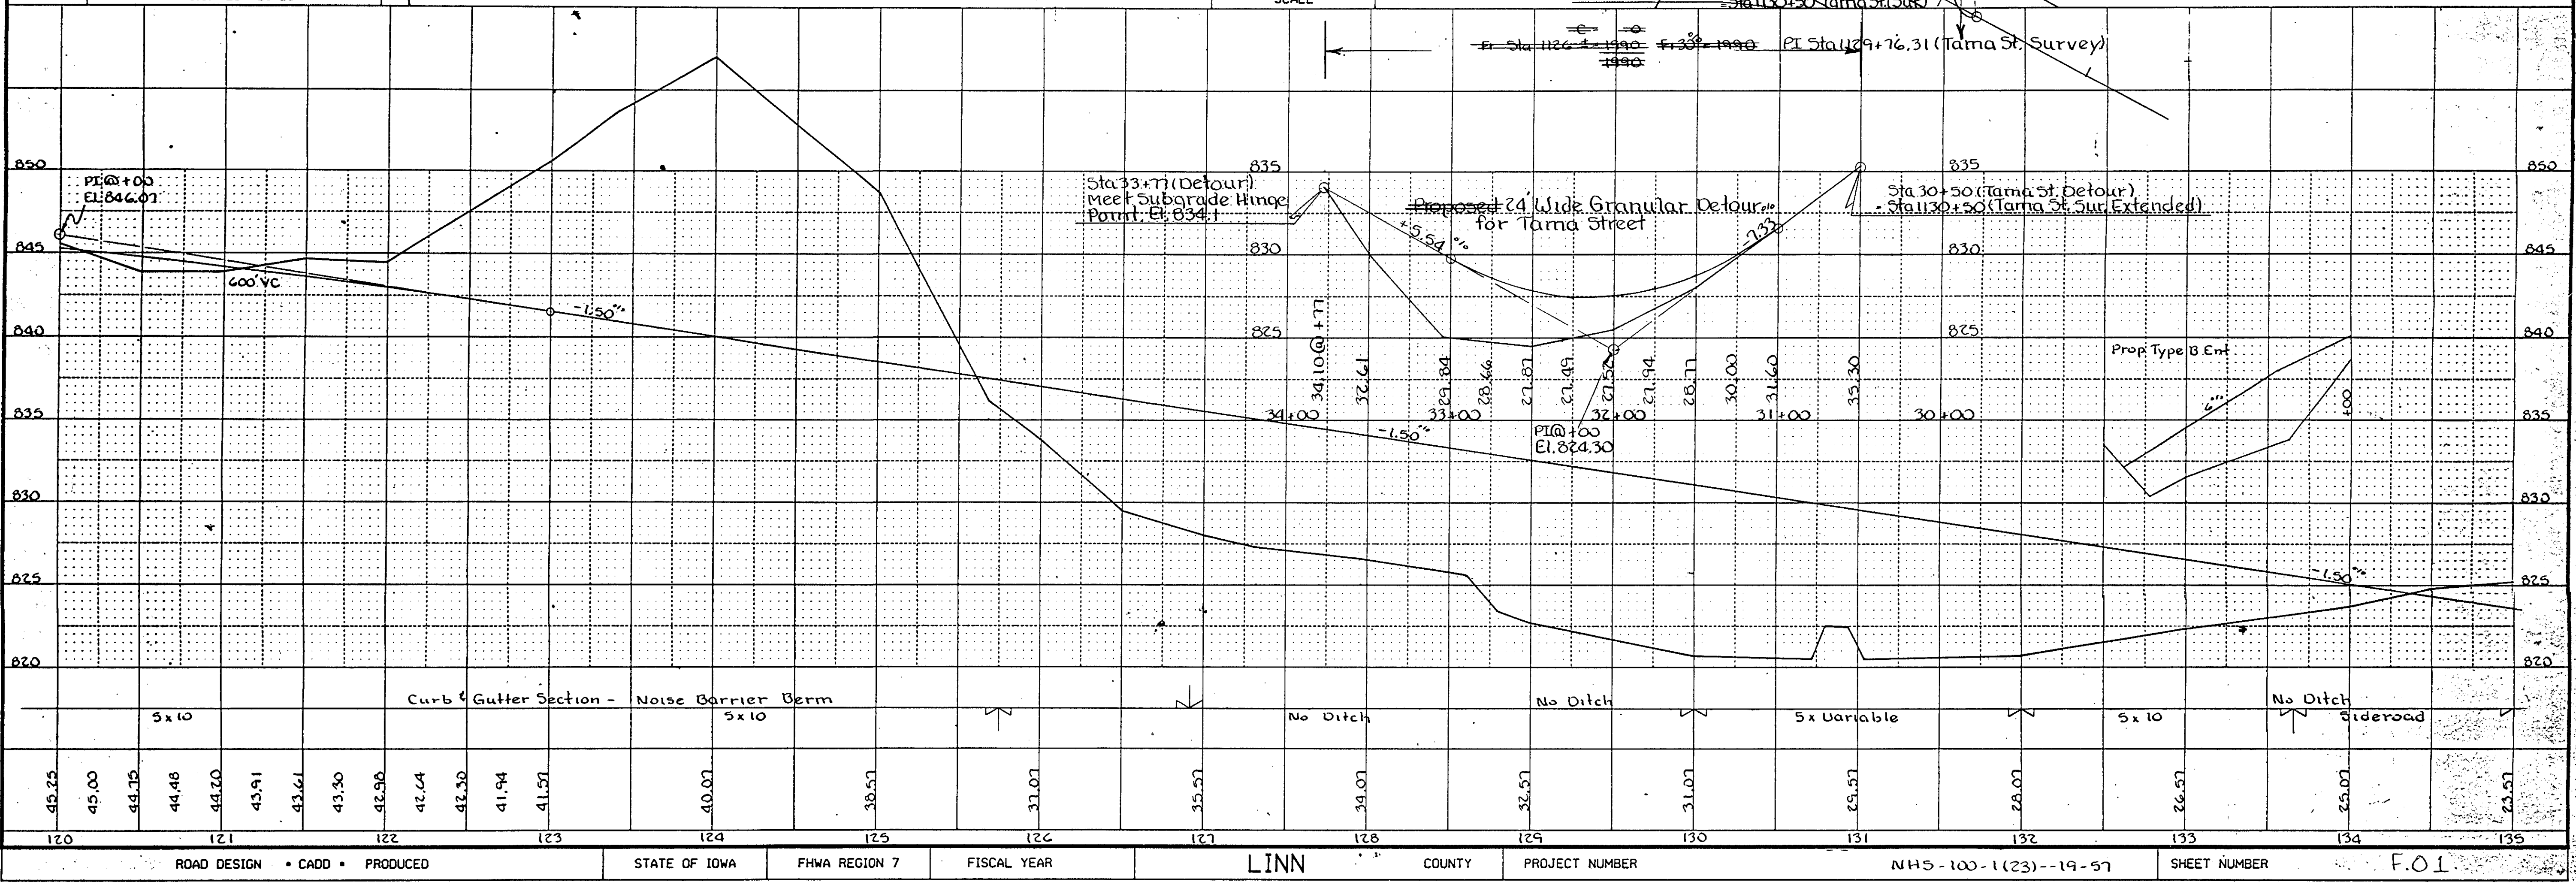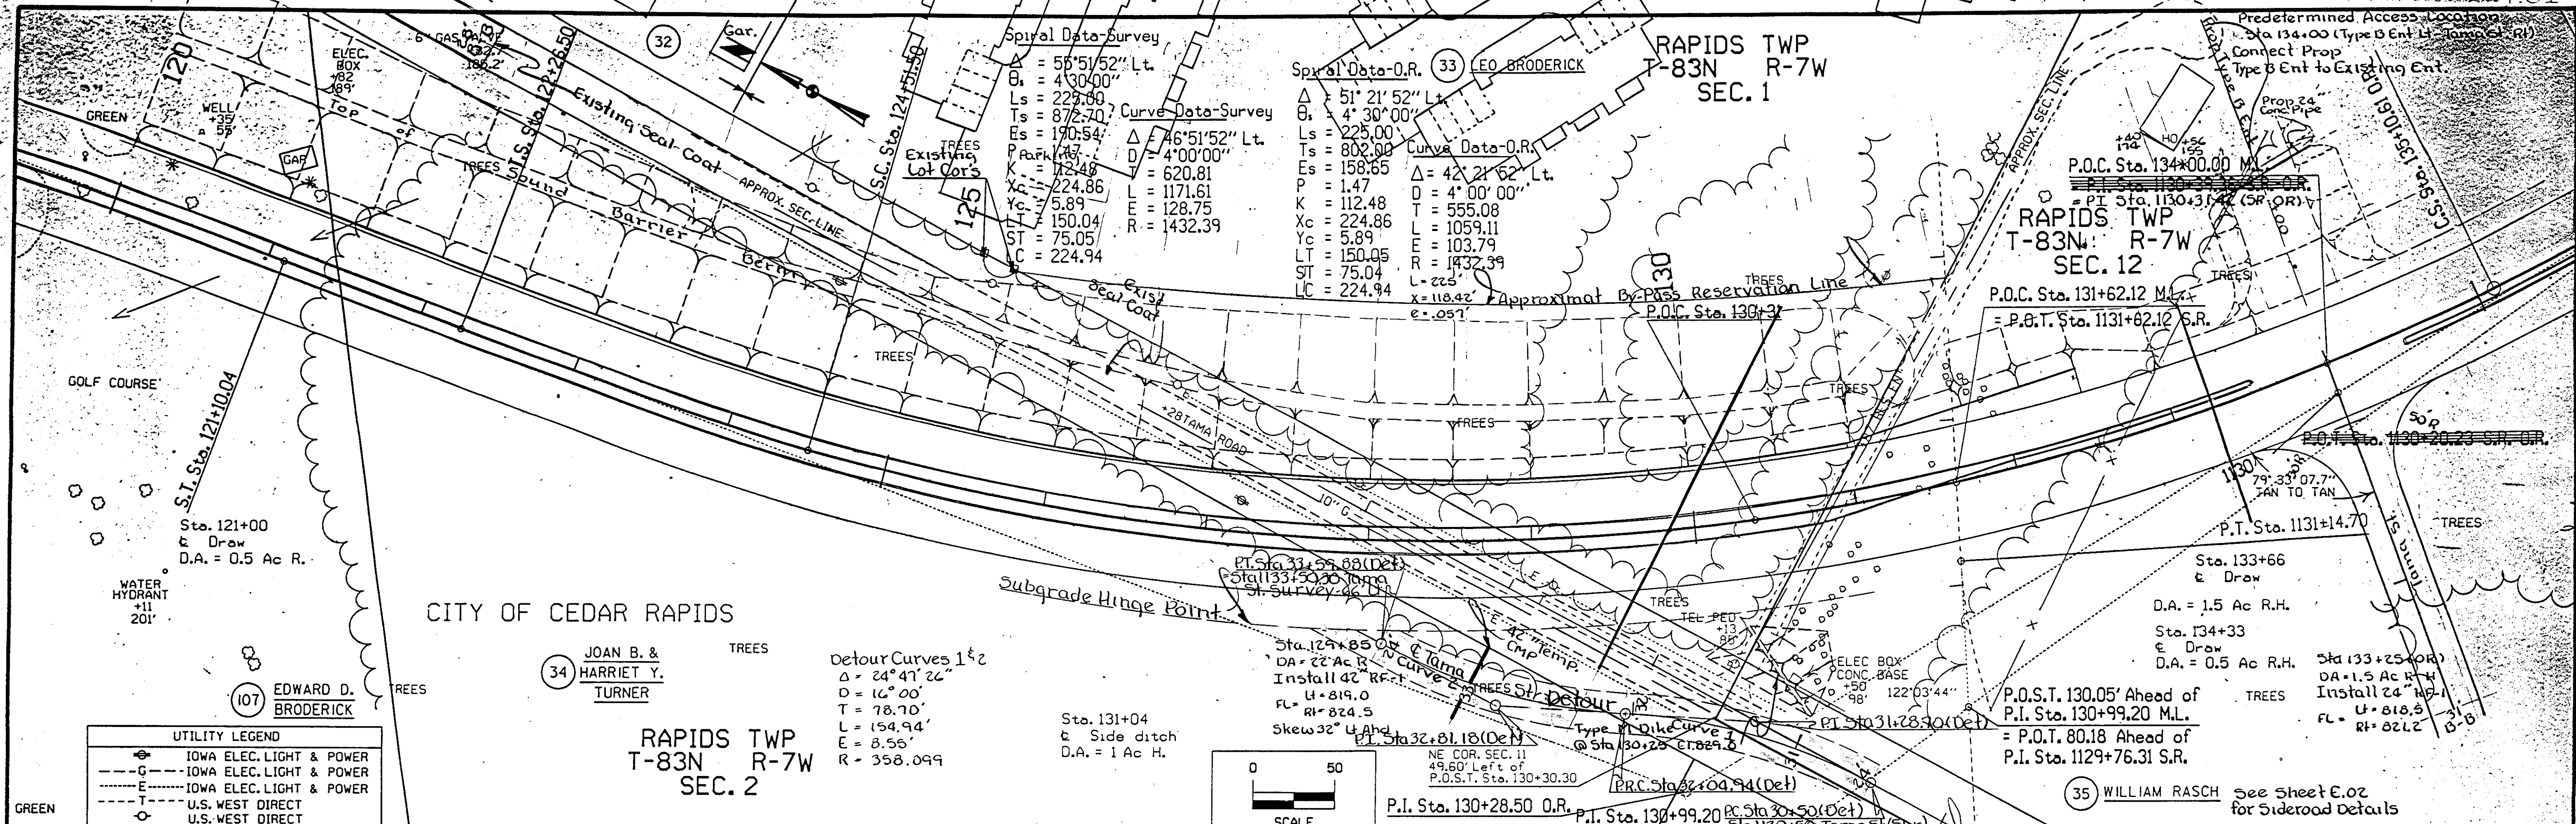

PLAN	DATE
SURVEYED	
ALIGNED	
CHECKED	
NO. OF WAY CHECKED	
NO.	

PROFILE	DATE
SURVEYED	
GRADES CHECKED	
PLOTTED	
NO. OF NOTATIONS CHKD	
NO.	

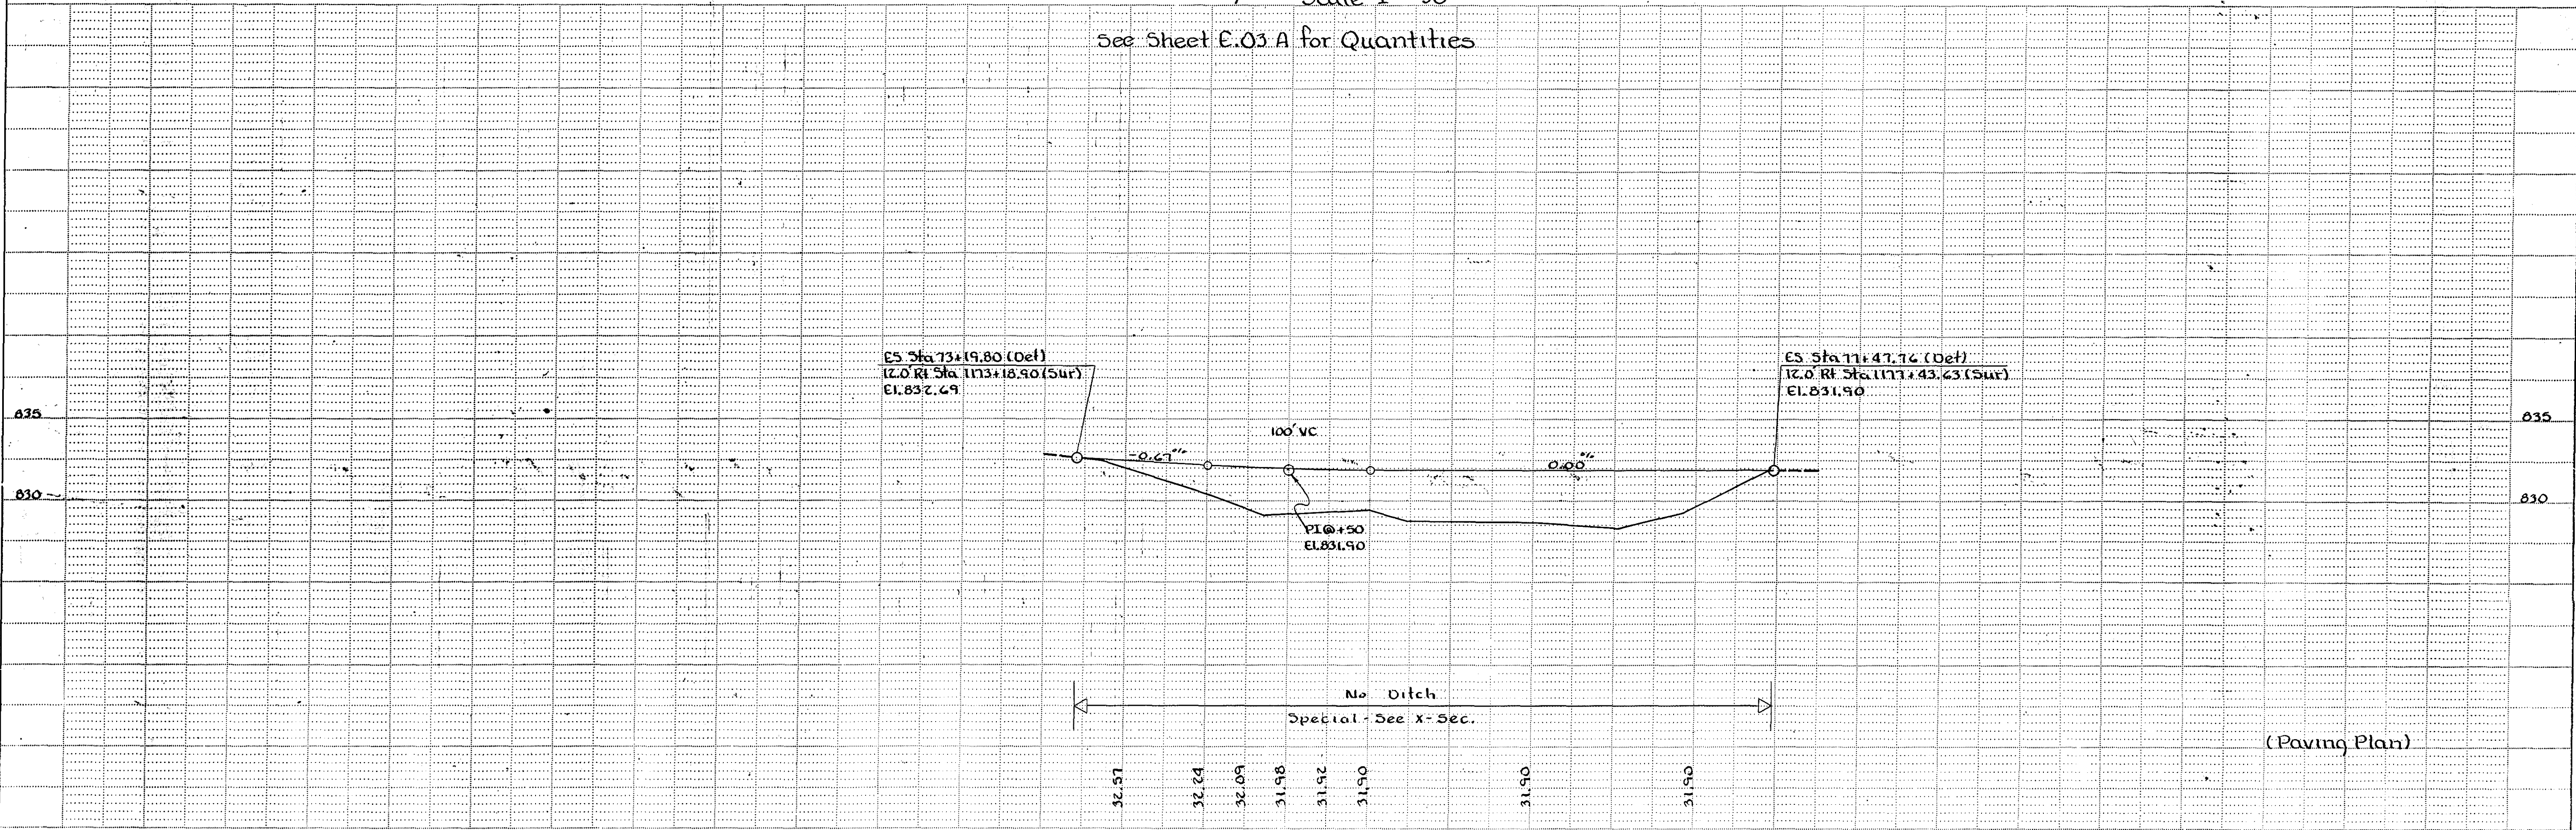
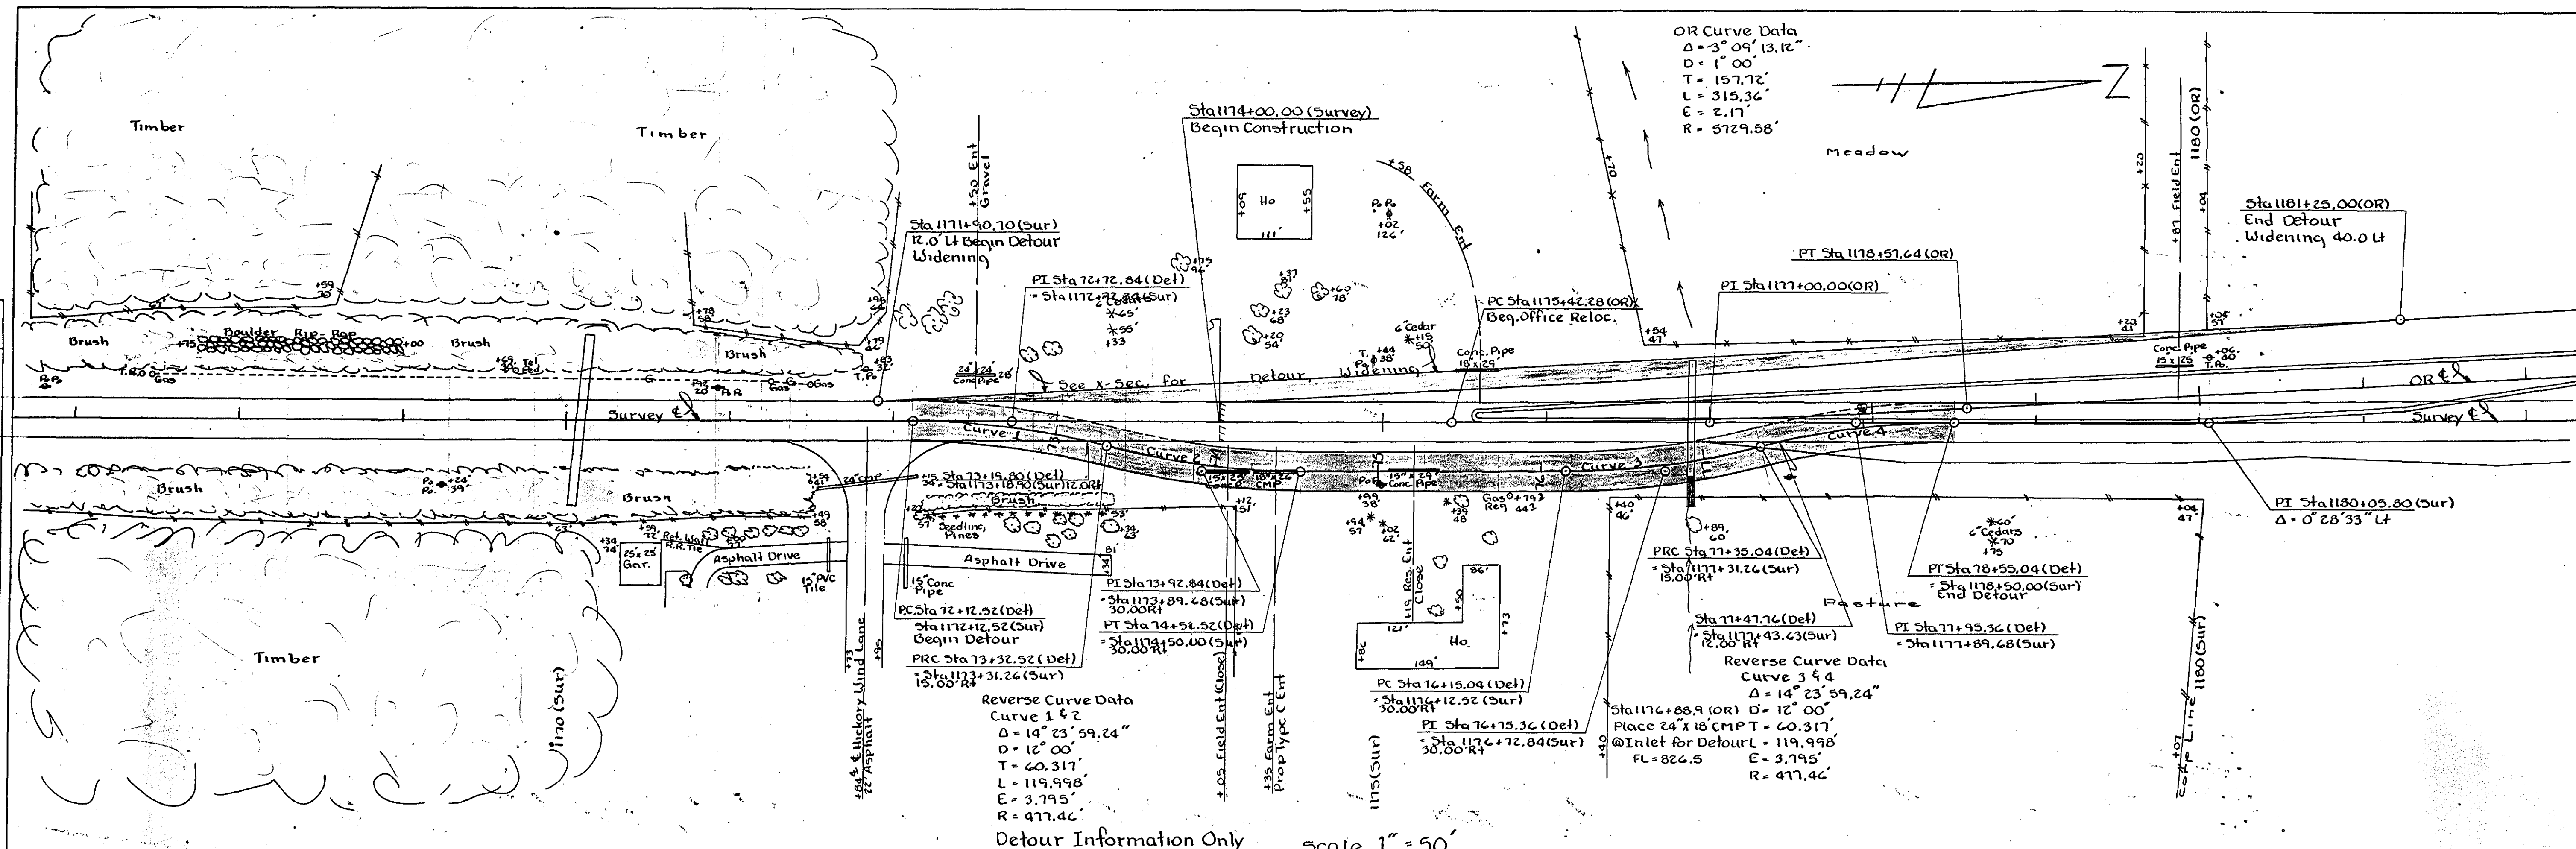


PLAN	SURVEYED	DATE
	ALIGNED	BY
NOTE BOOK	NOTED	NO.
	RT. OF WAY CHECKED	NO.

PROFILE	SURVEYED	DATE
	PLOTTED	BY
NOTE BOOK	NOTED	NO.
	STRUCTURE NOTATION CHKD	NO.


OR Curve Data
A = 39° 14' 03.12"
D = 6° 30'
T = 314.175'
L = 603.60'
E = 54.316'
R = 881.474'
e = 0.20

Survey Curve Data
A = 36° 33' 23"
D = 16° 00'
T = 118.28'
L = 228.48'
E = 19.03'
R = 358.10'

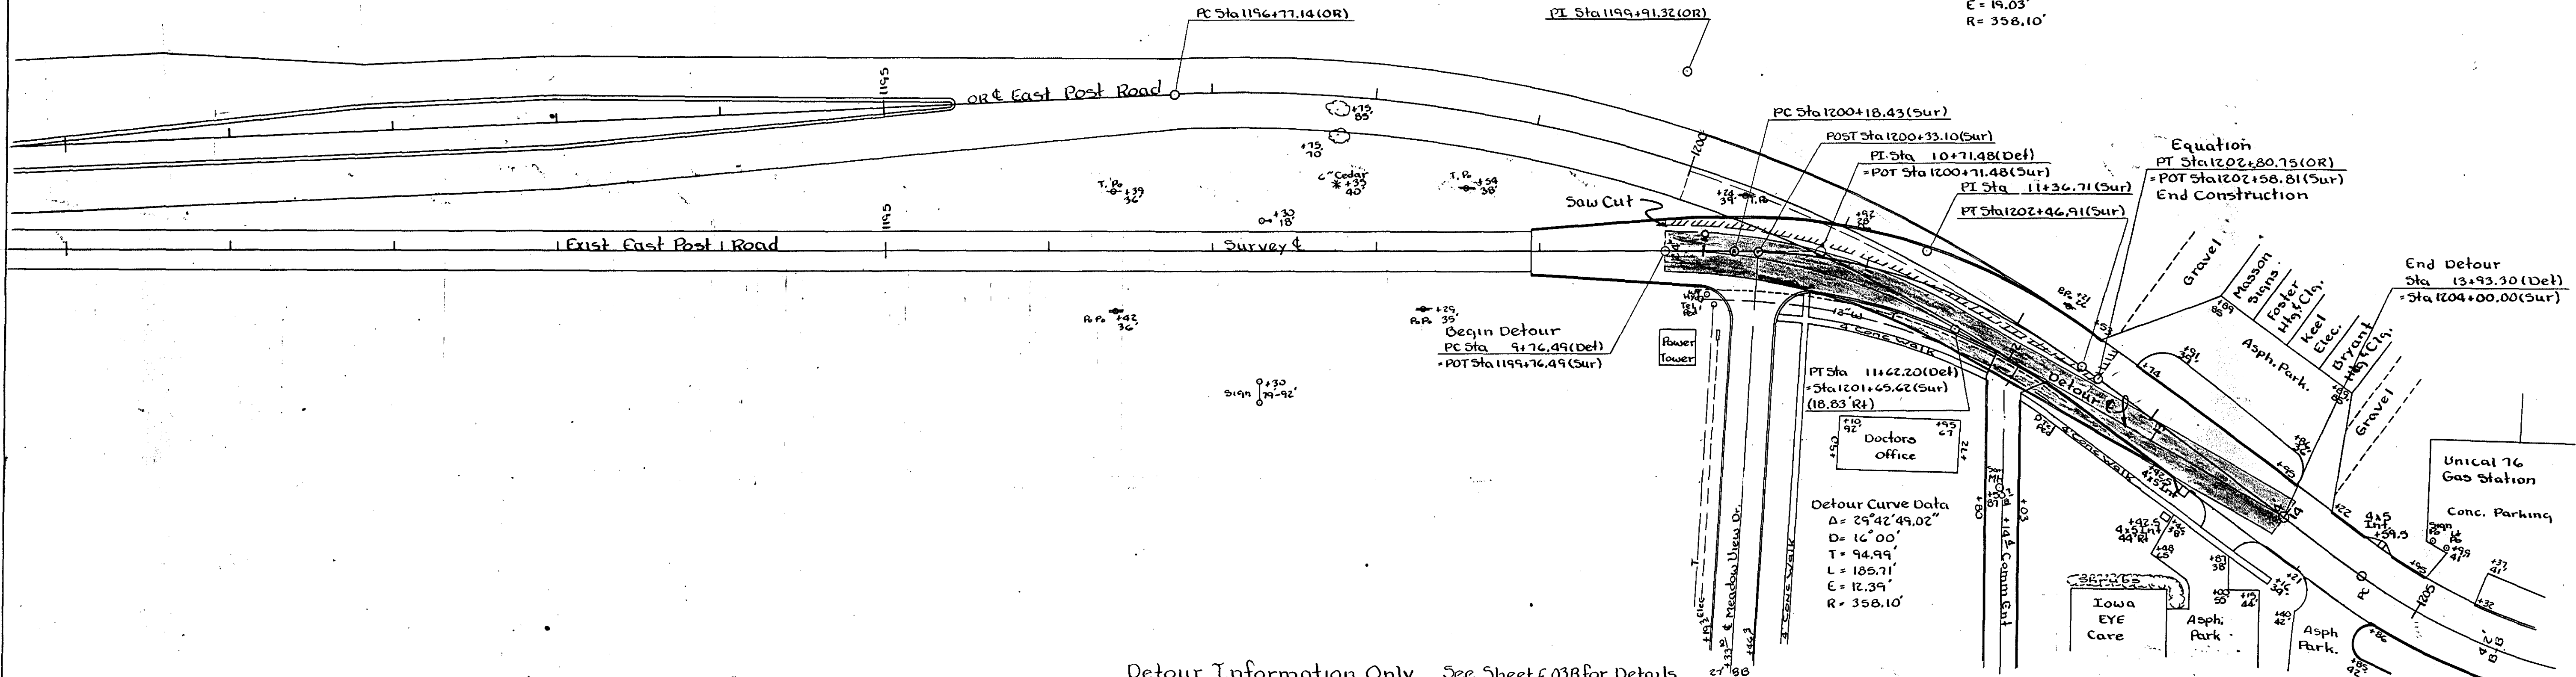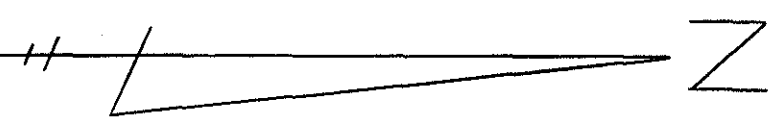

Detour Information Only See Sheet E.03B for Details

See Sheet E.03A for Quantities

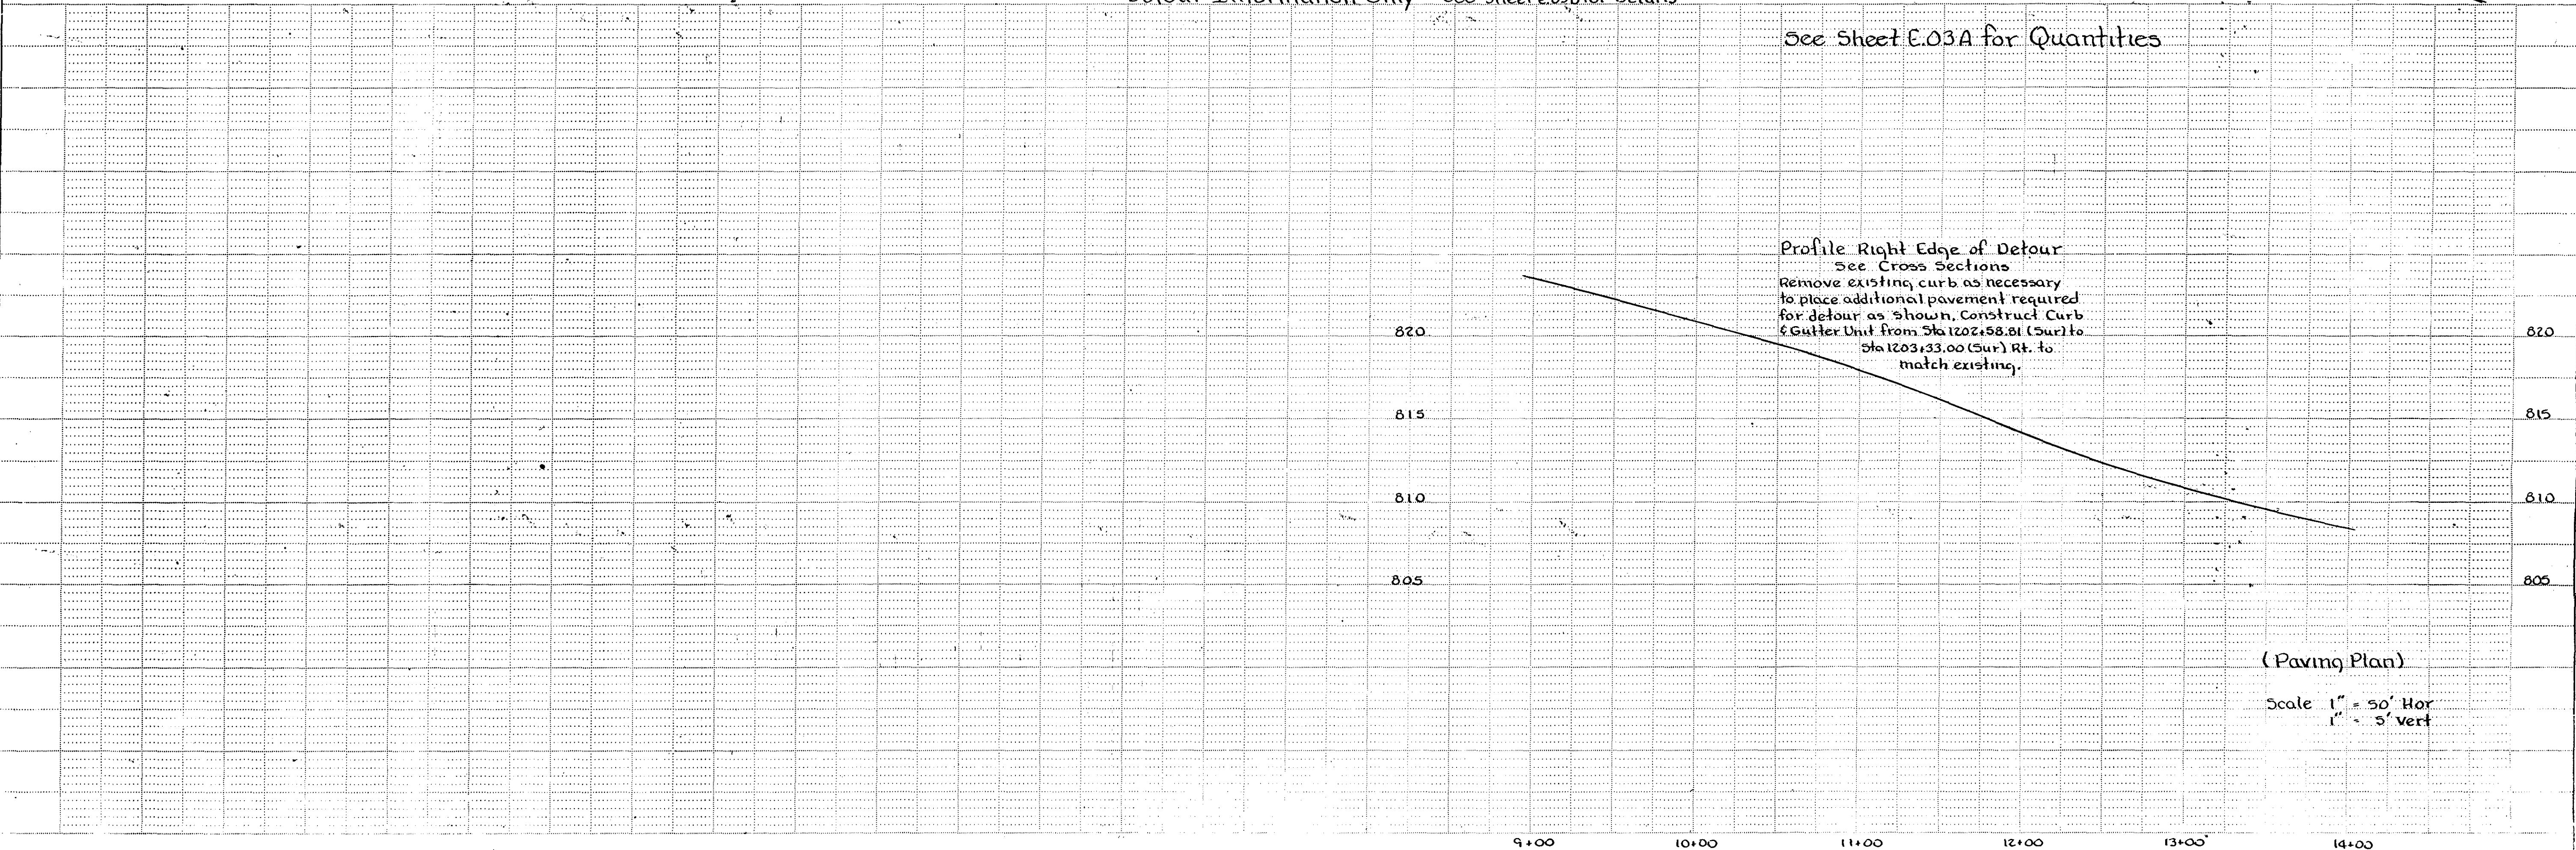

(Paving Plan)
Scale 1" = 50' Hor
1" = 5' Vert

P.50 D4

POT 109+51.91 Nail in ACC.



















T.S. Sta. 111+87.18
"X" cut



















S.C. 114+12.18
"X" cut

C.S. 118+85.04
"X" cut



ST 121+10.04 TS 122+26.50
"X" cut

S.C. 124+51.50
"X" cut

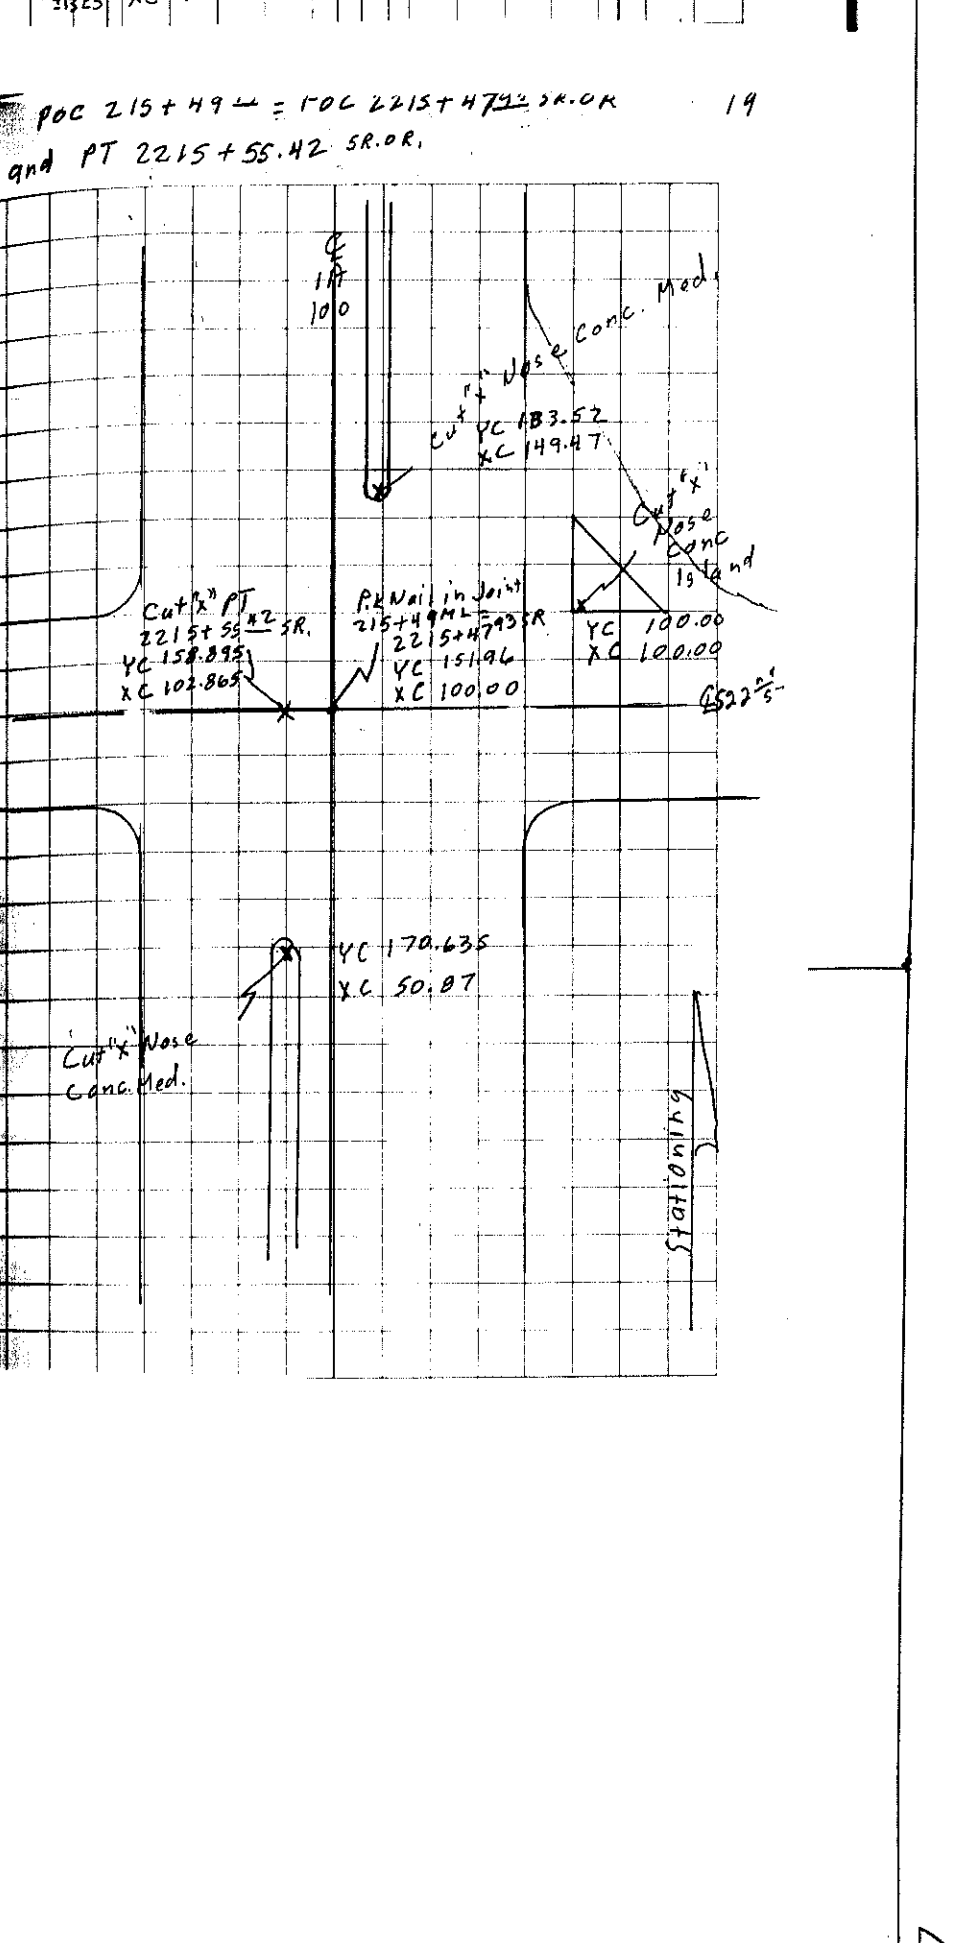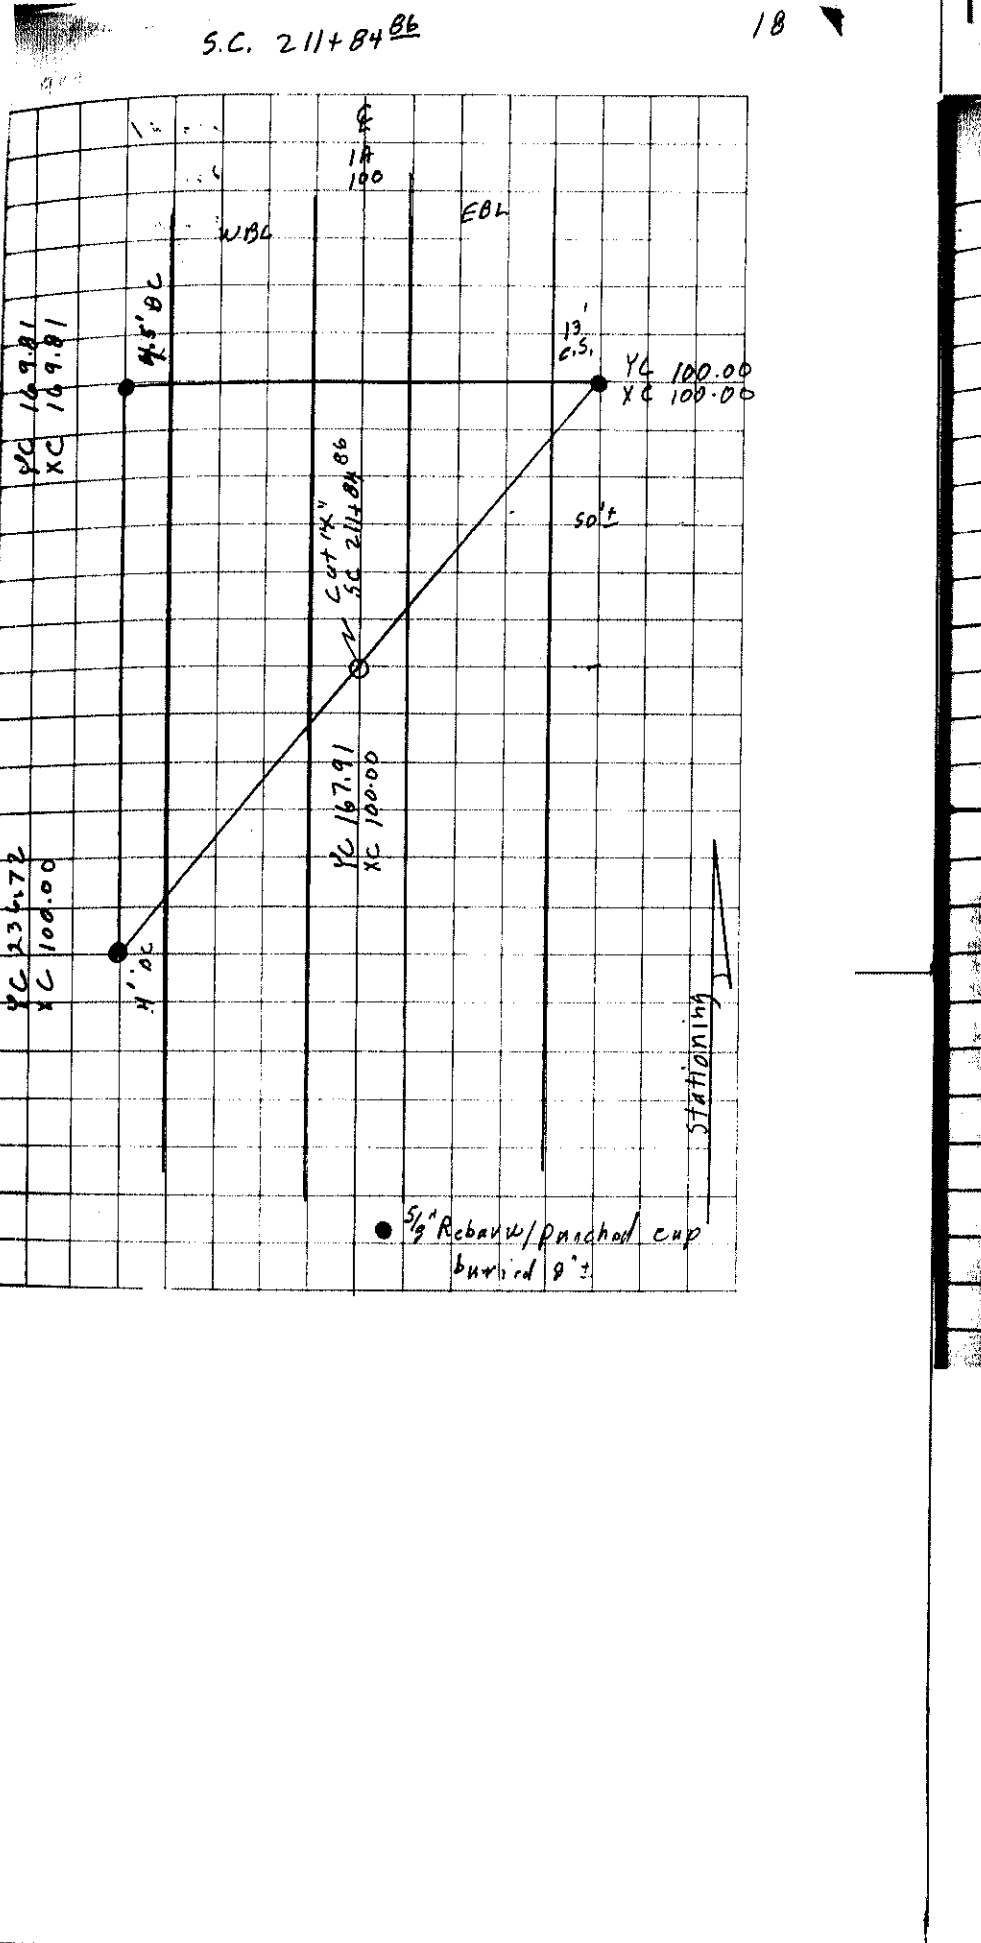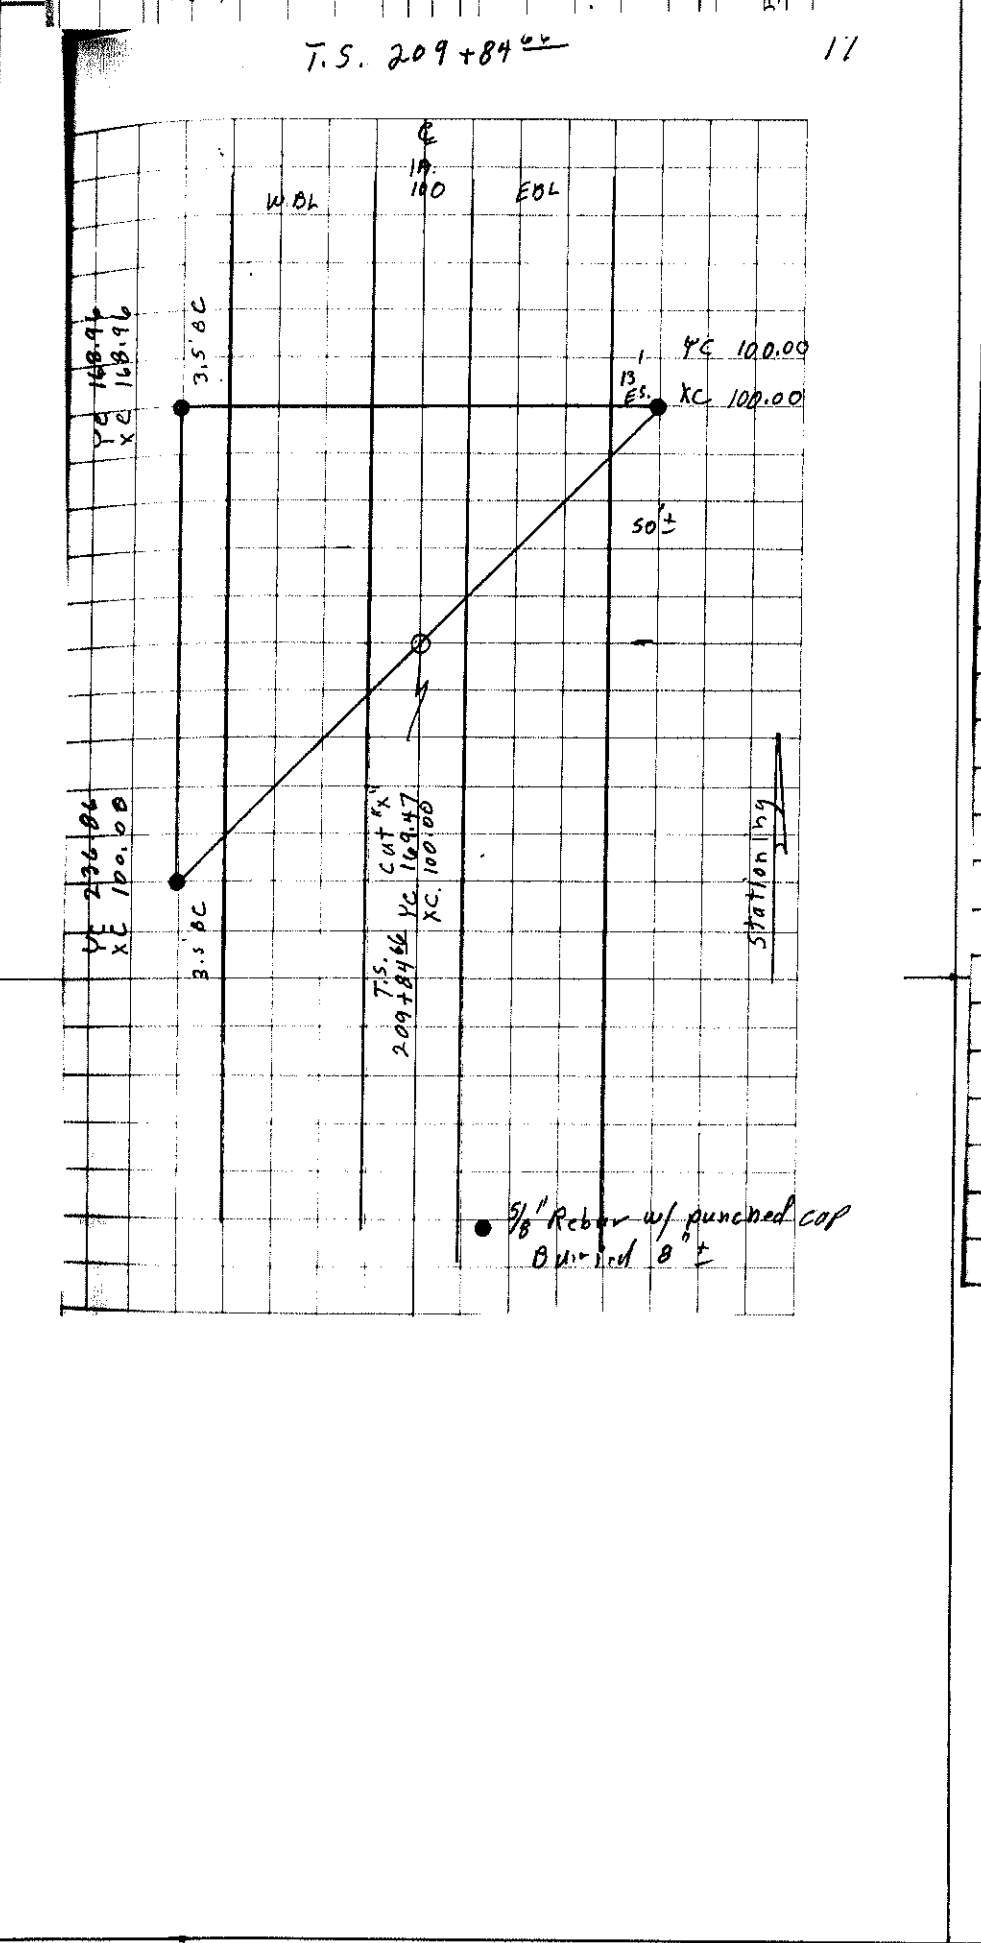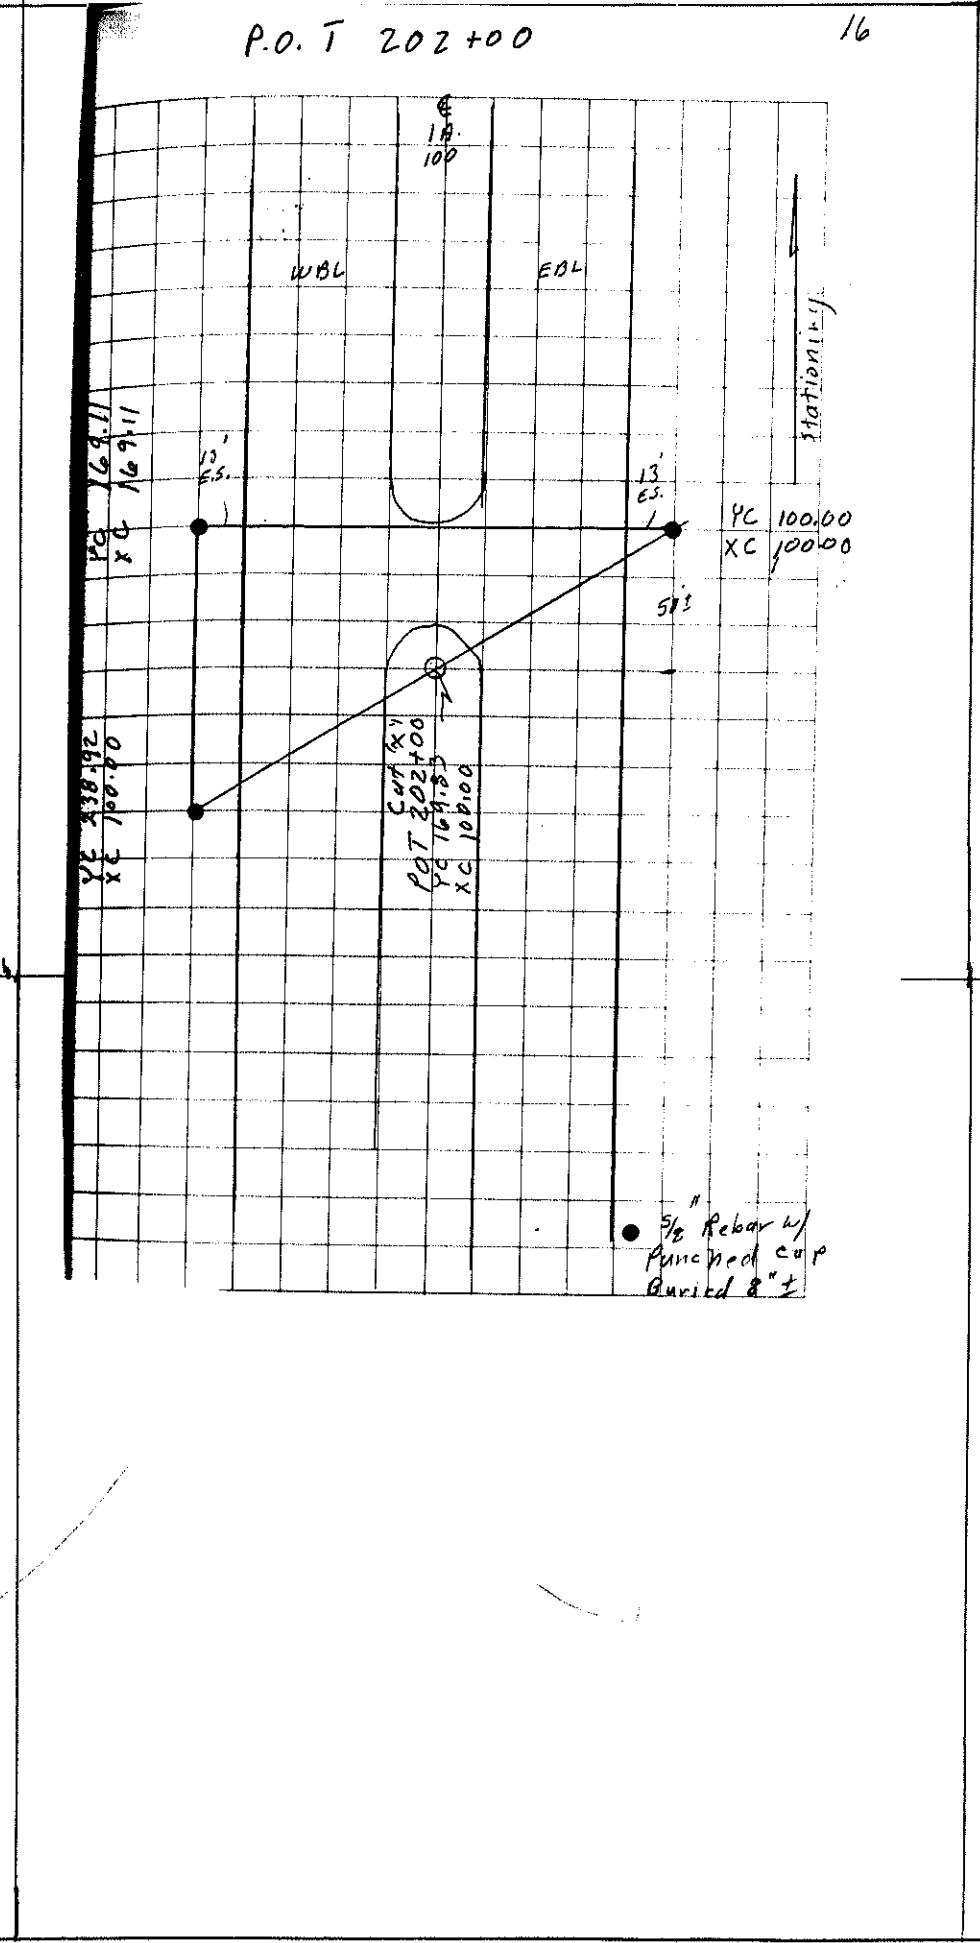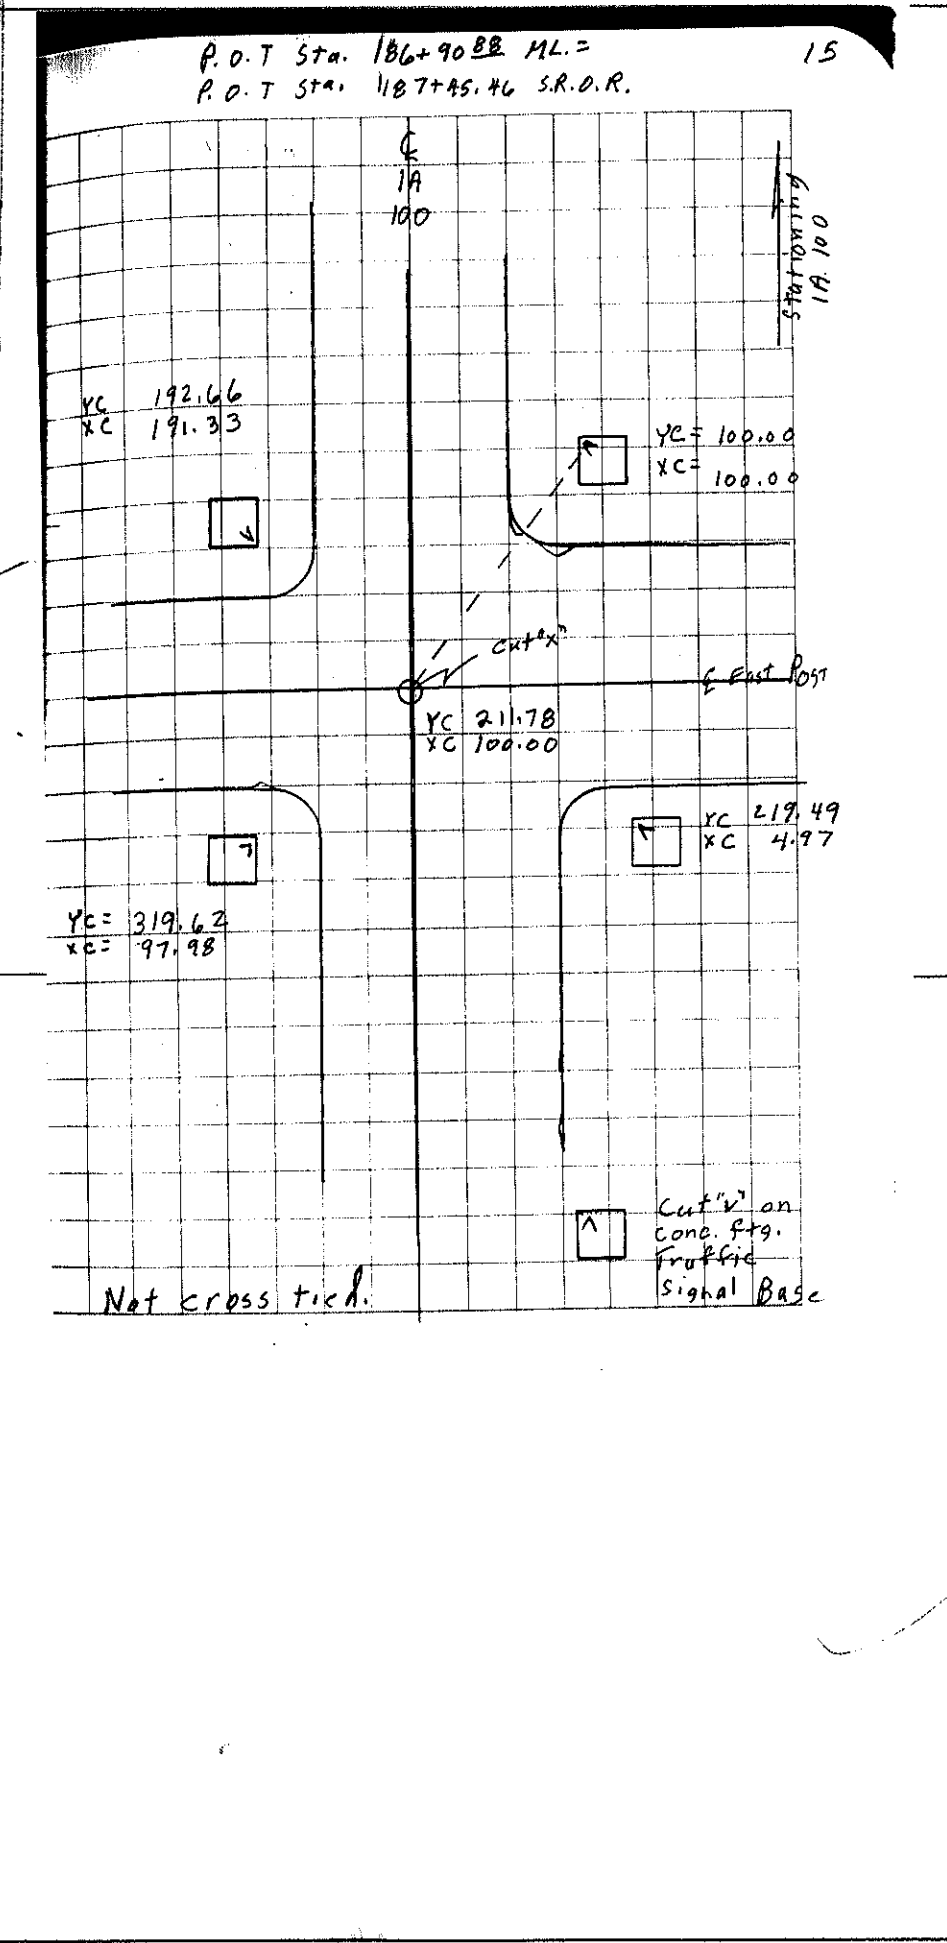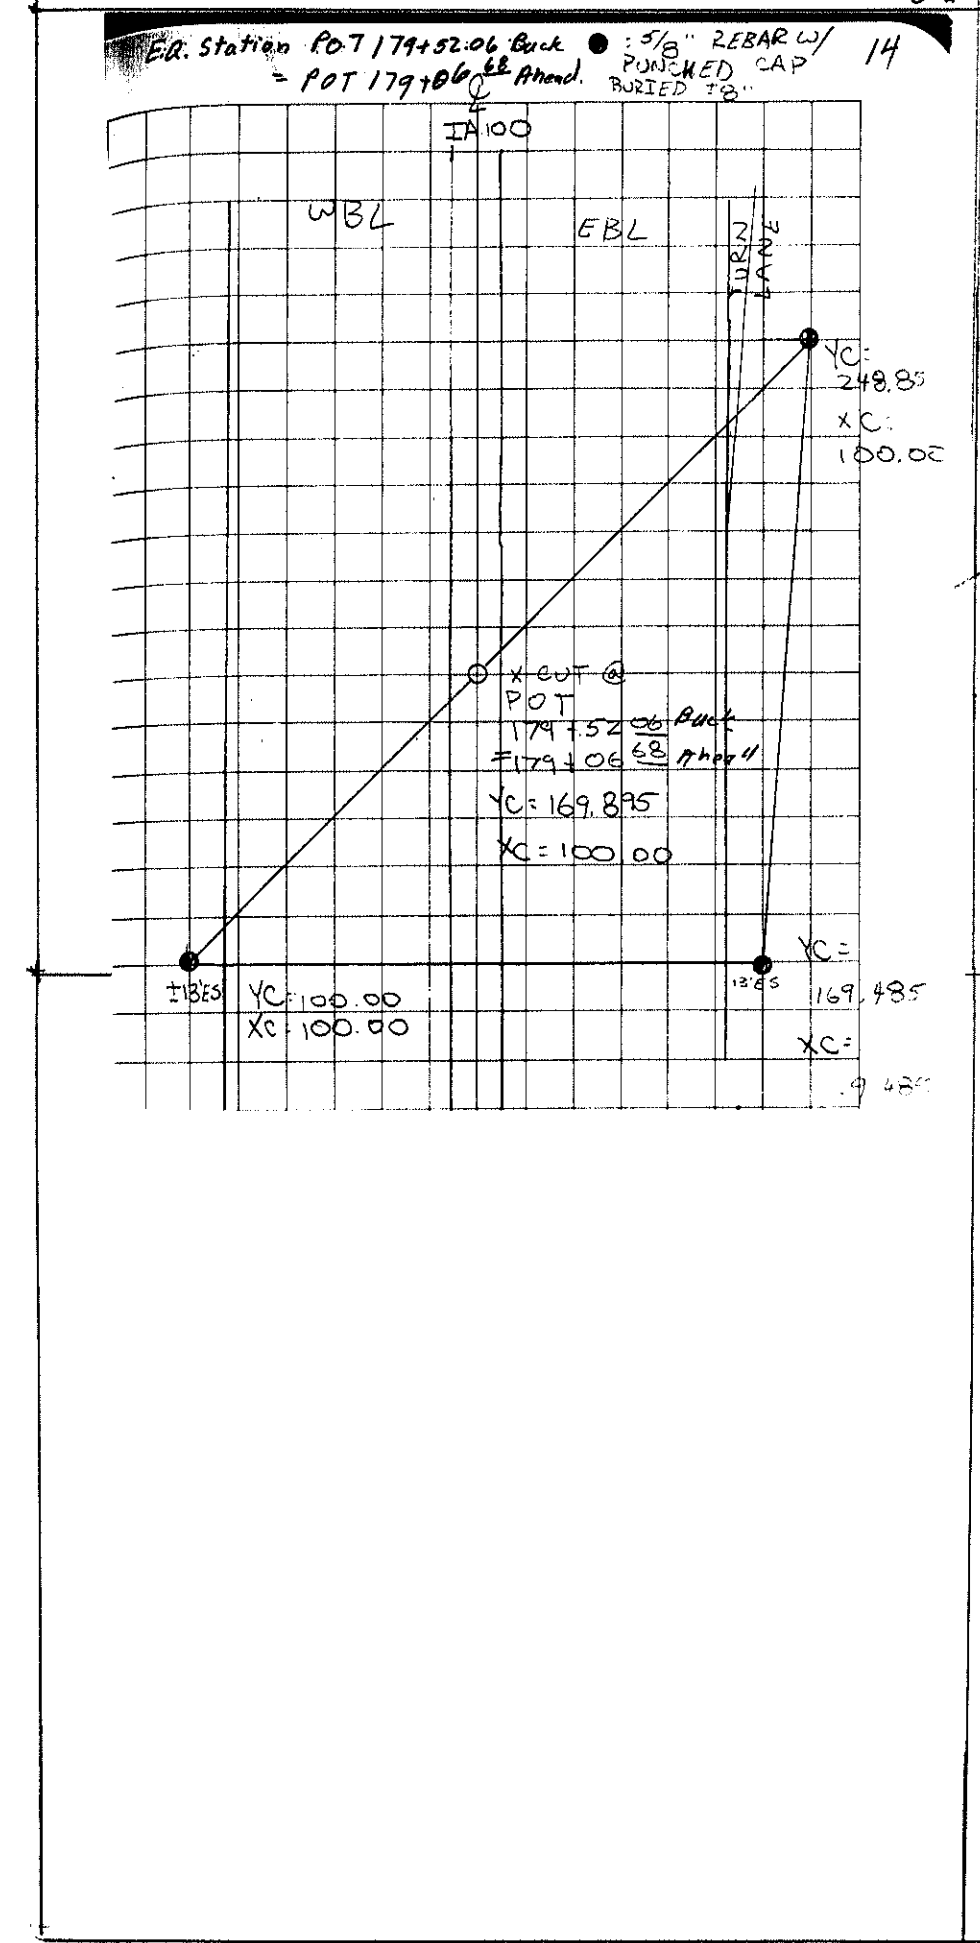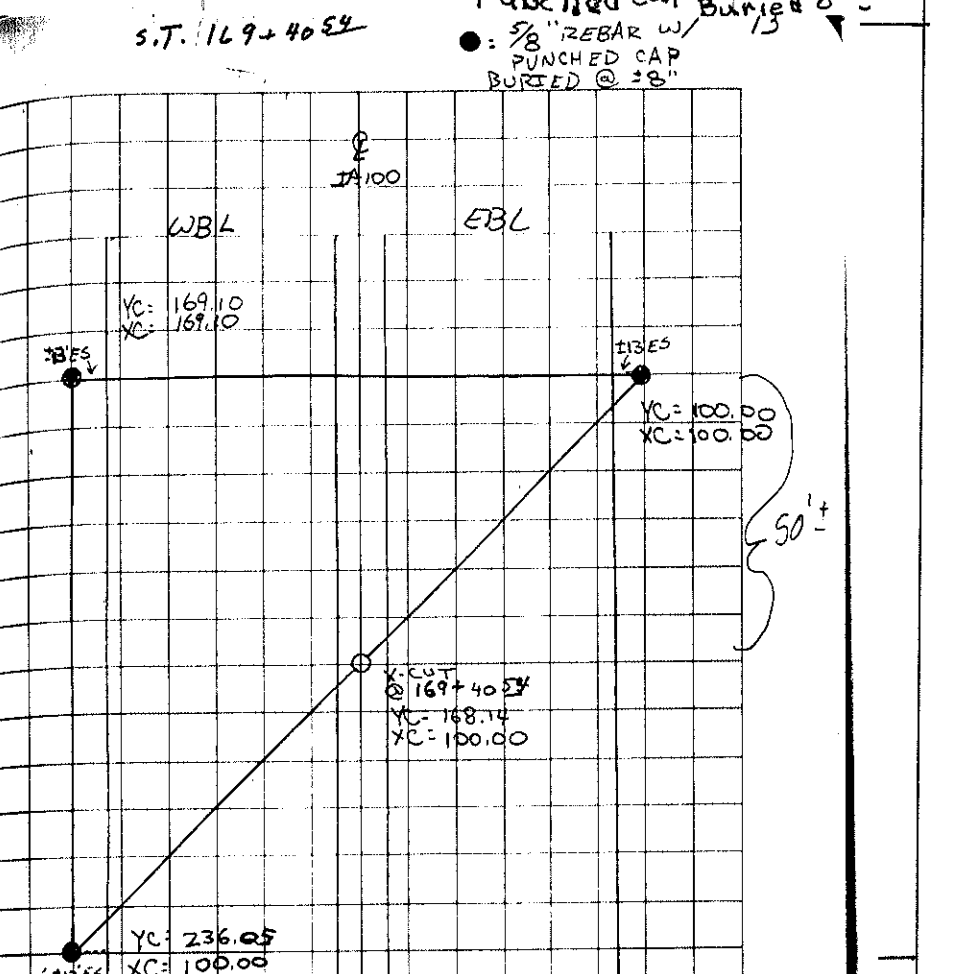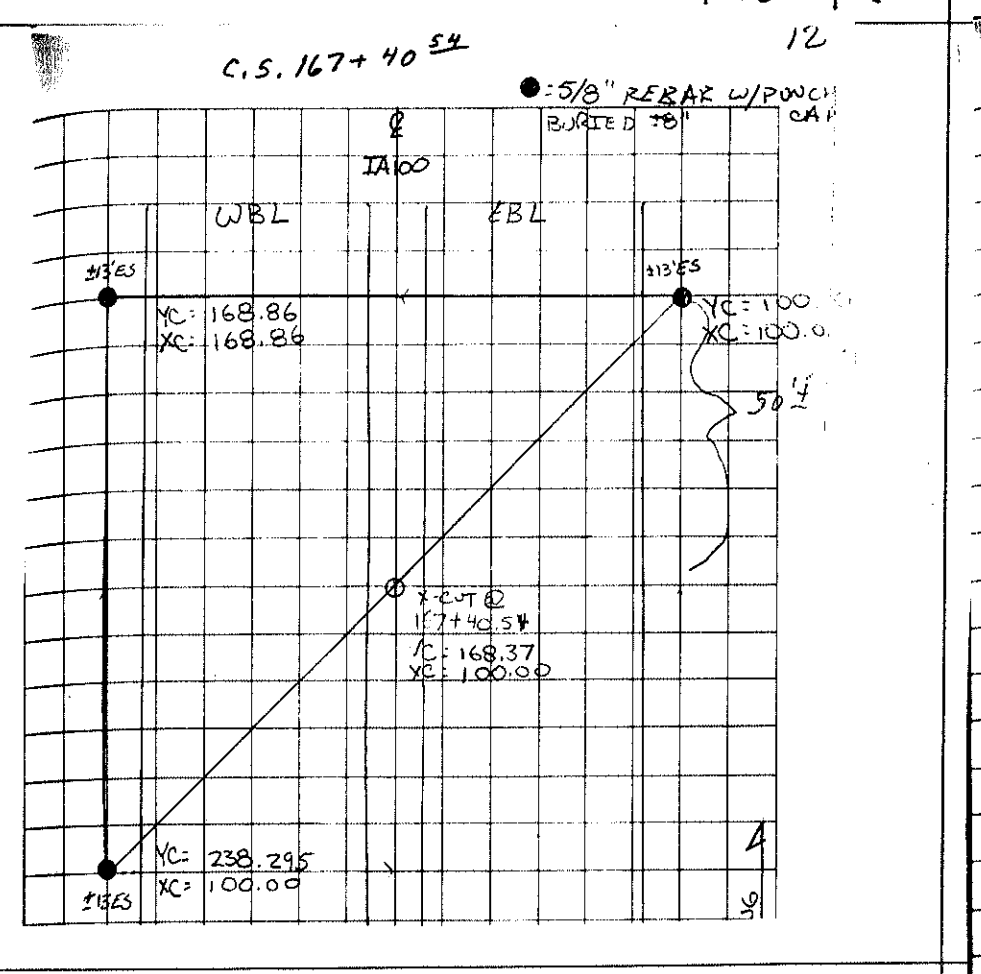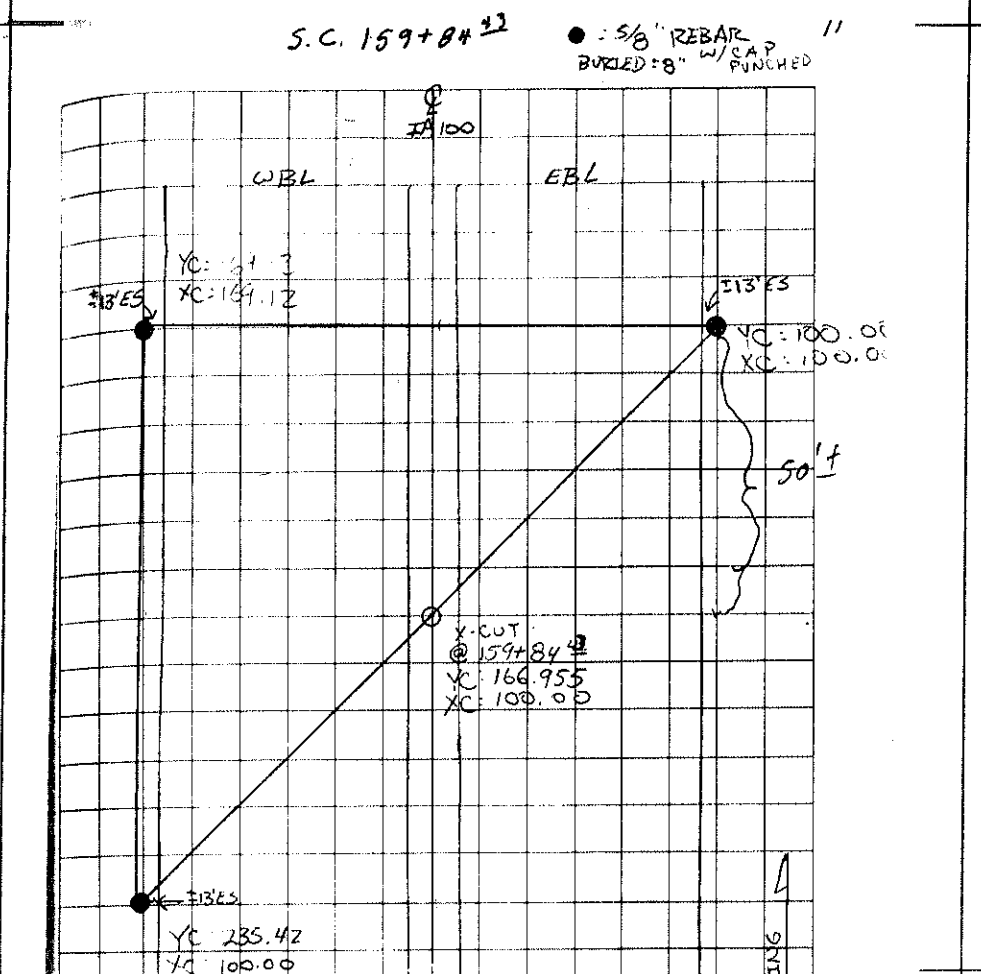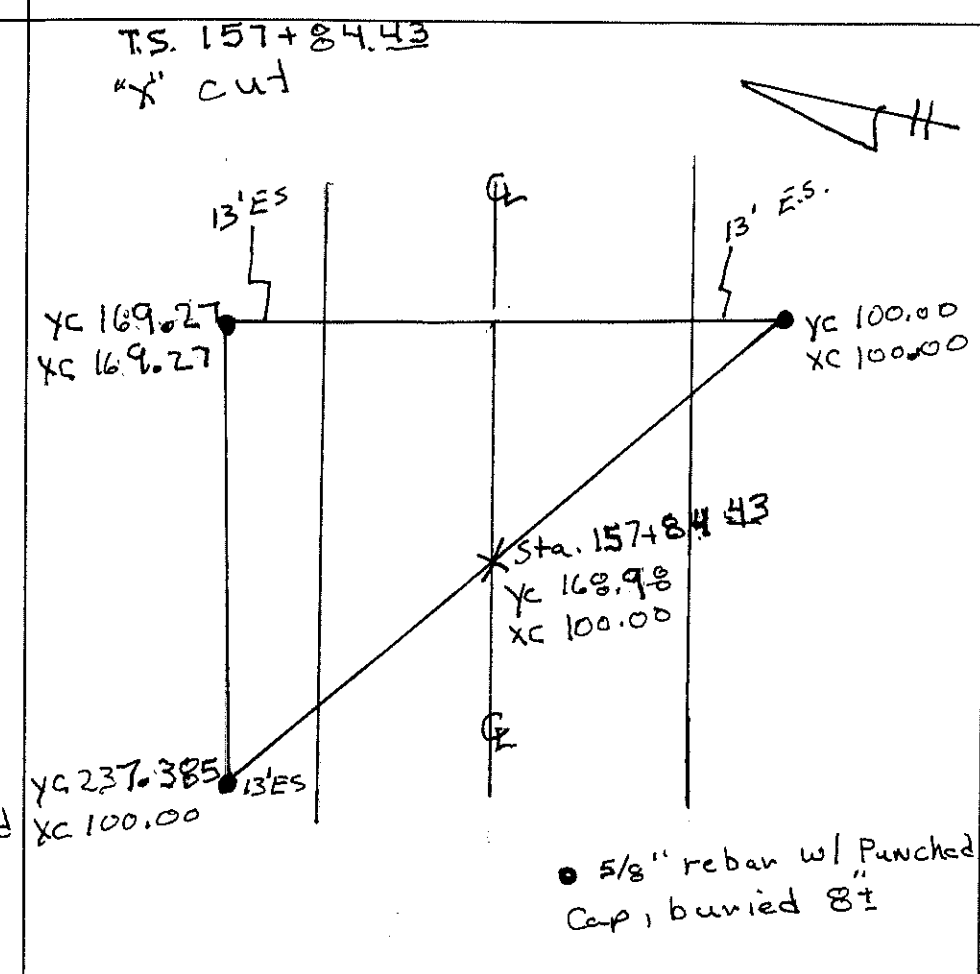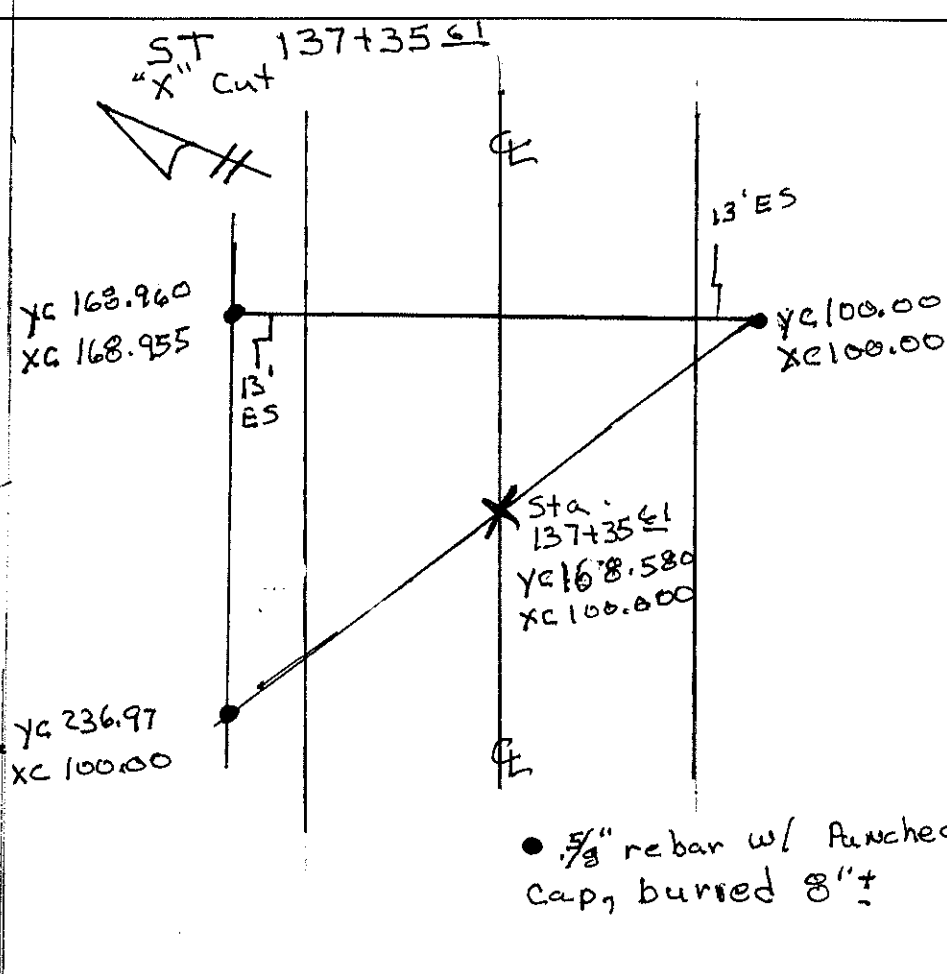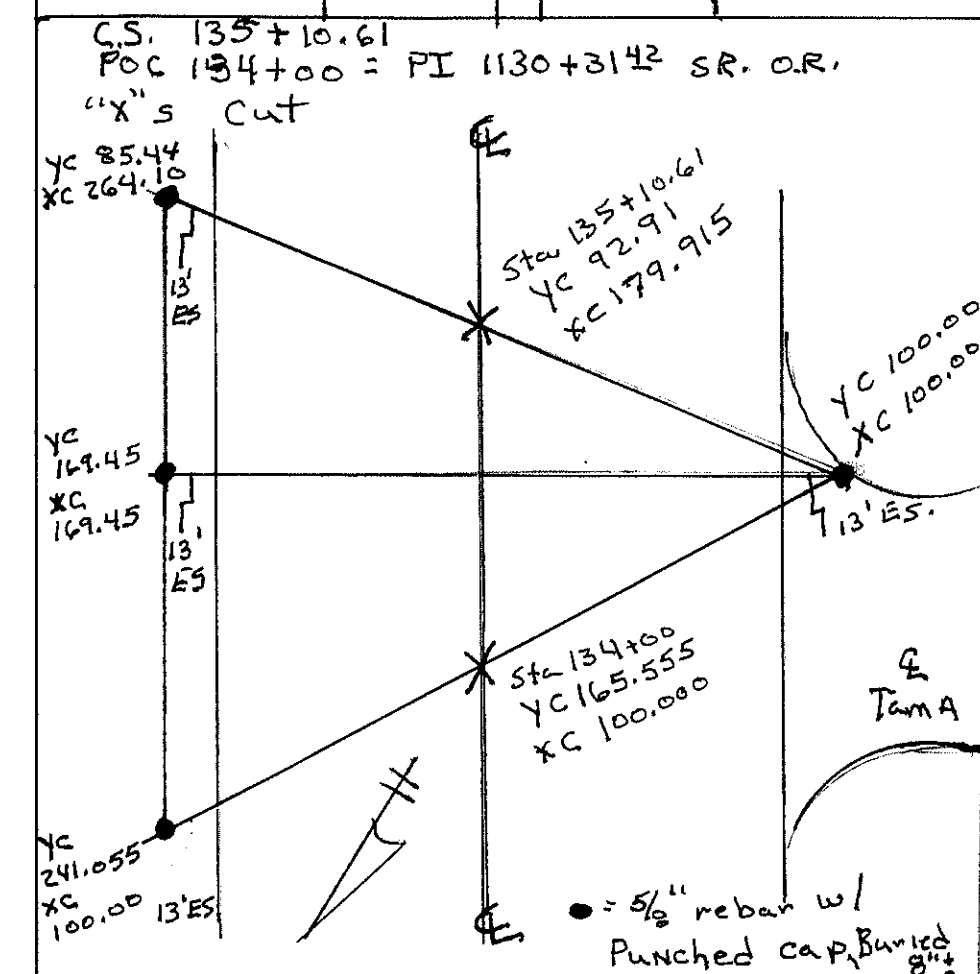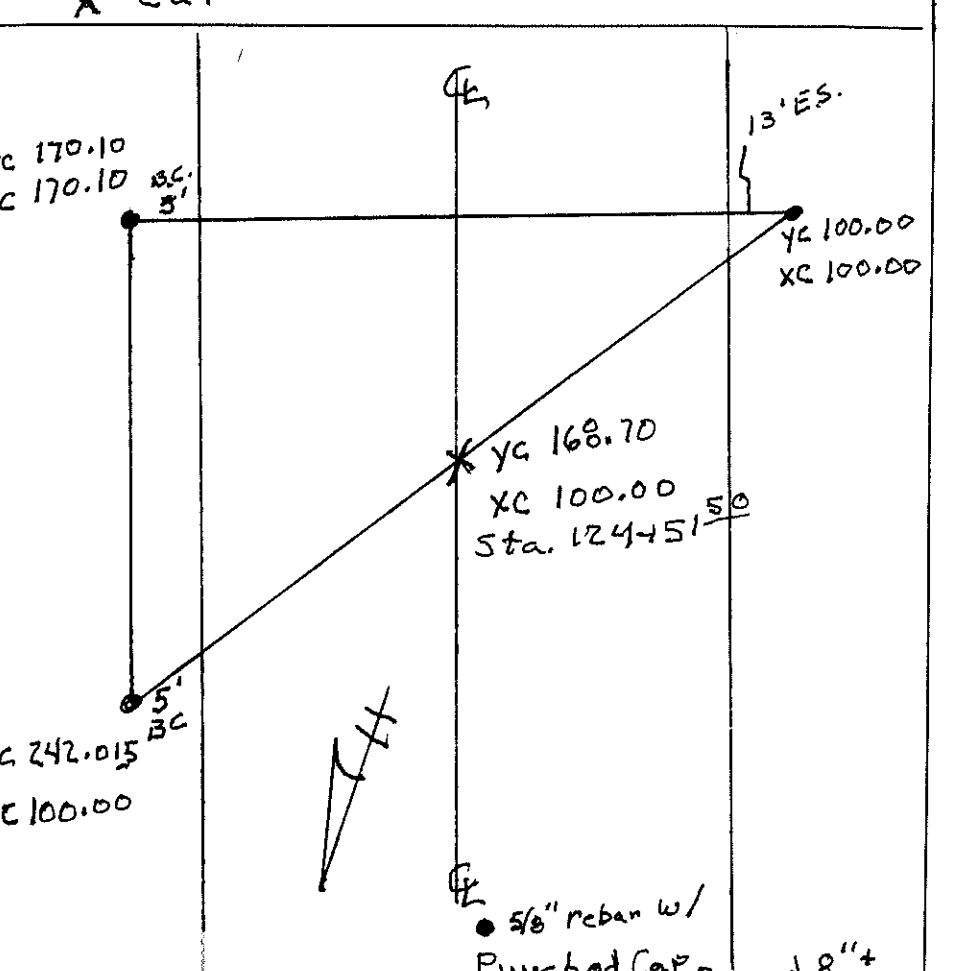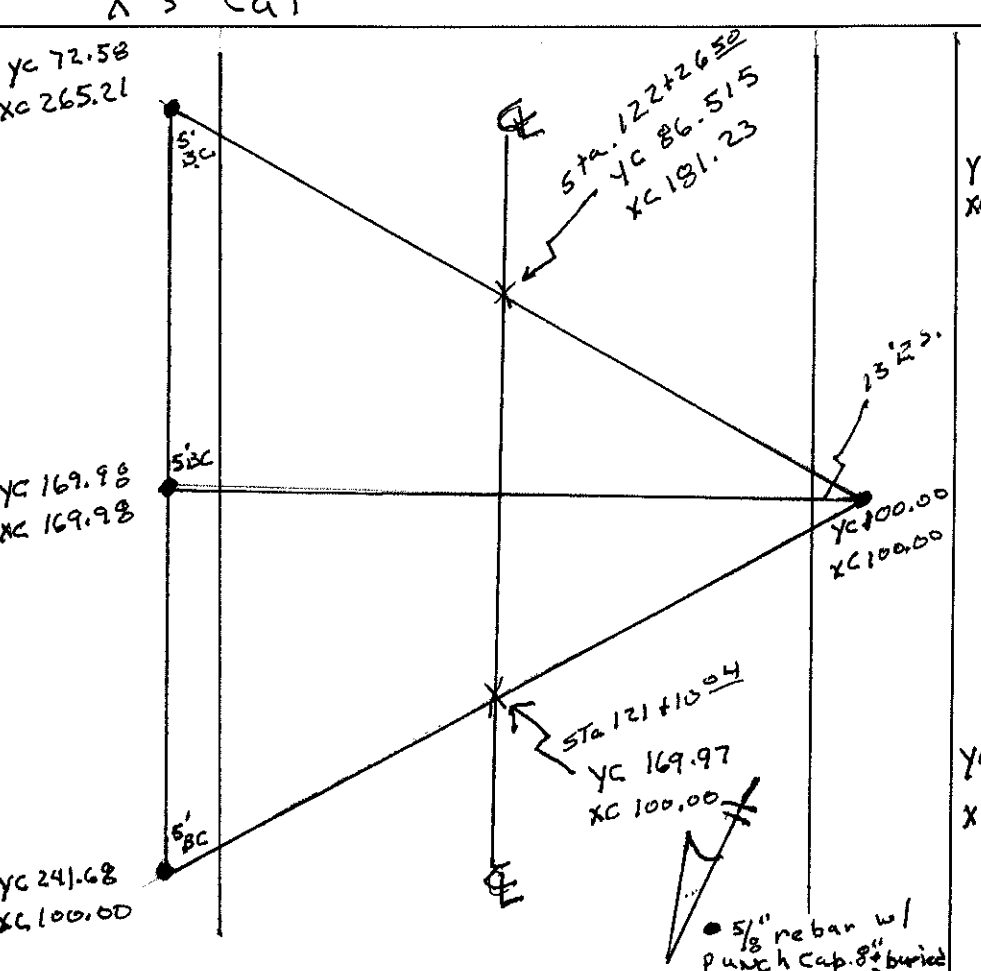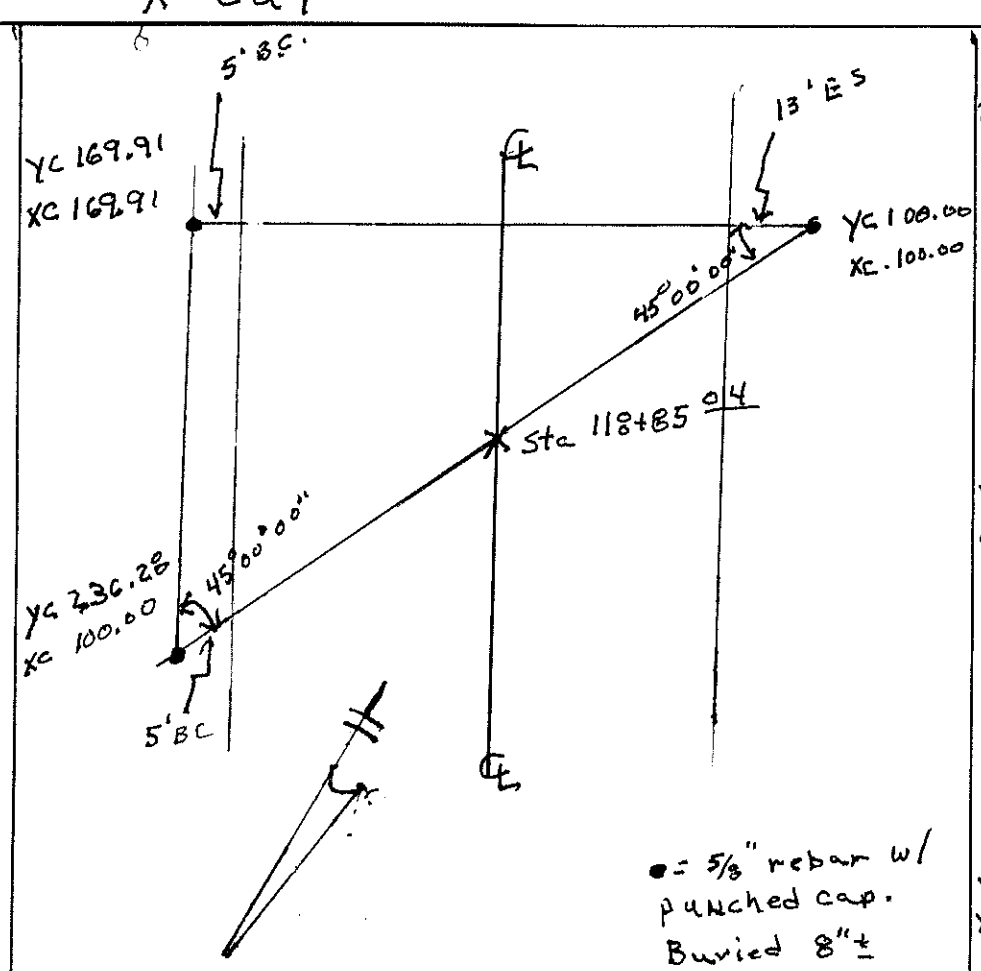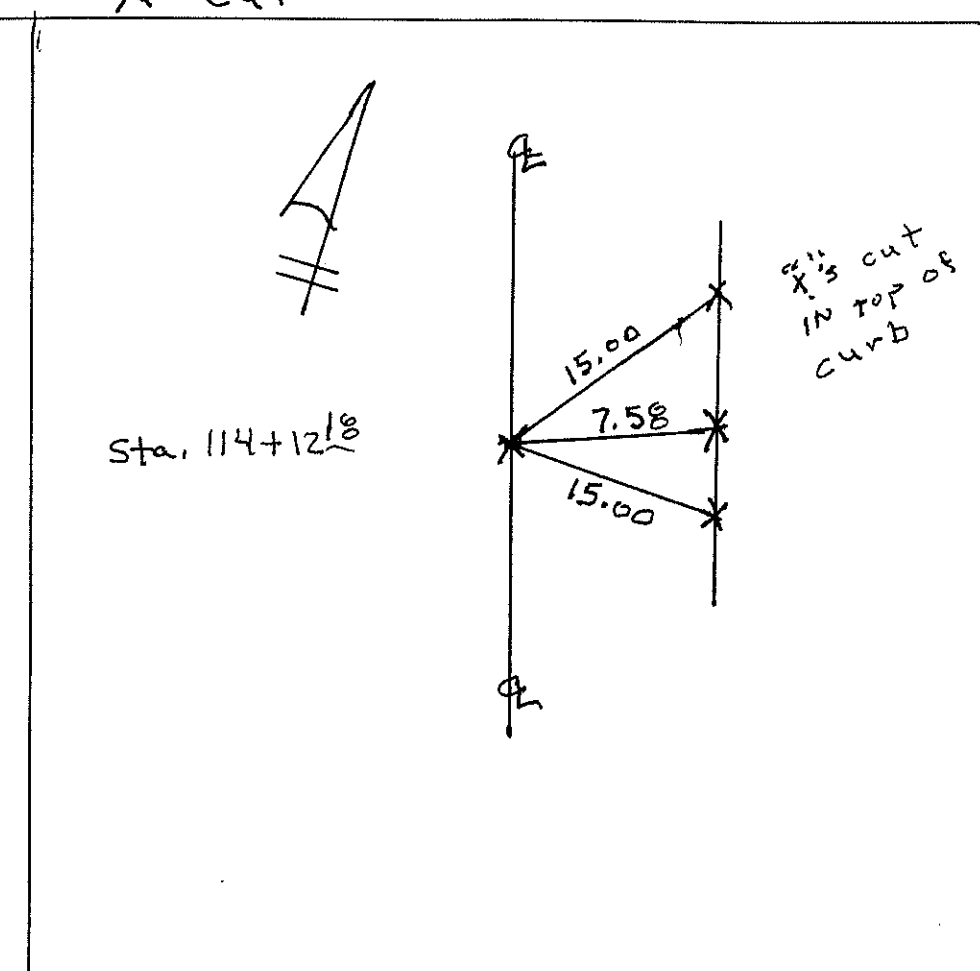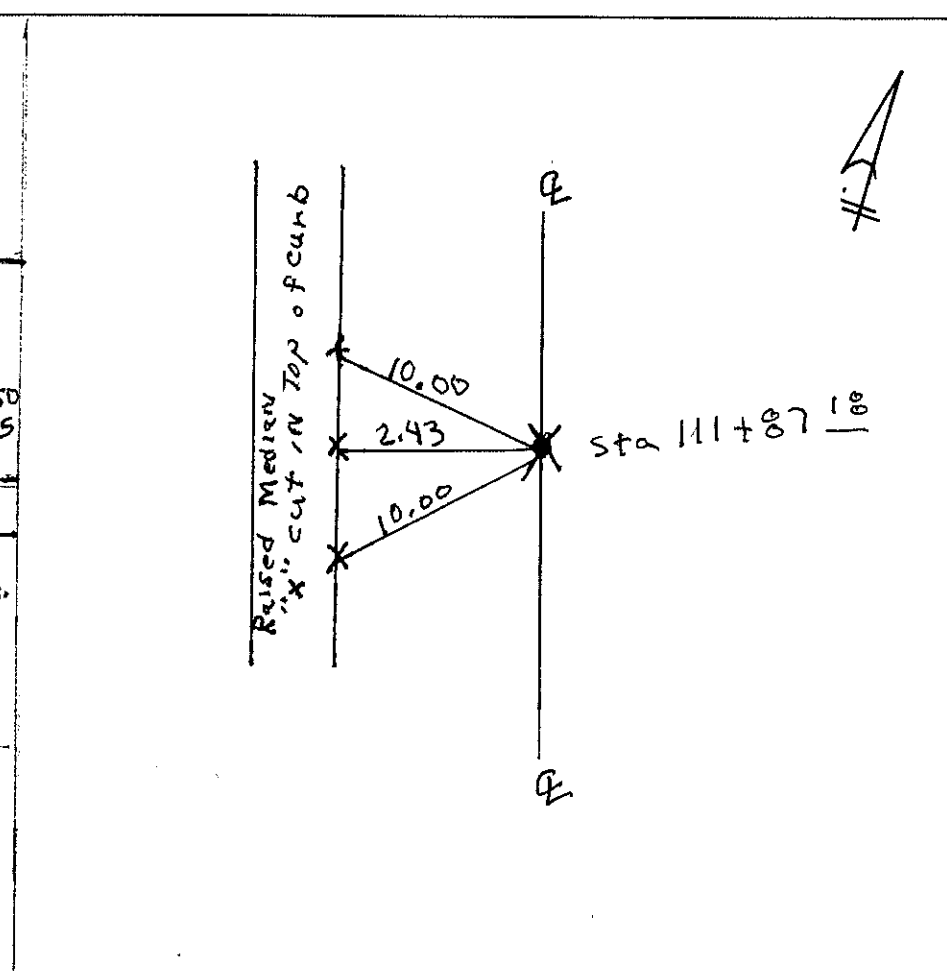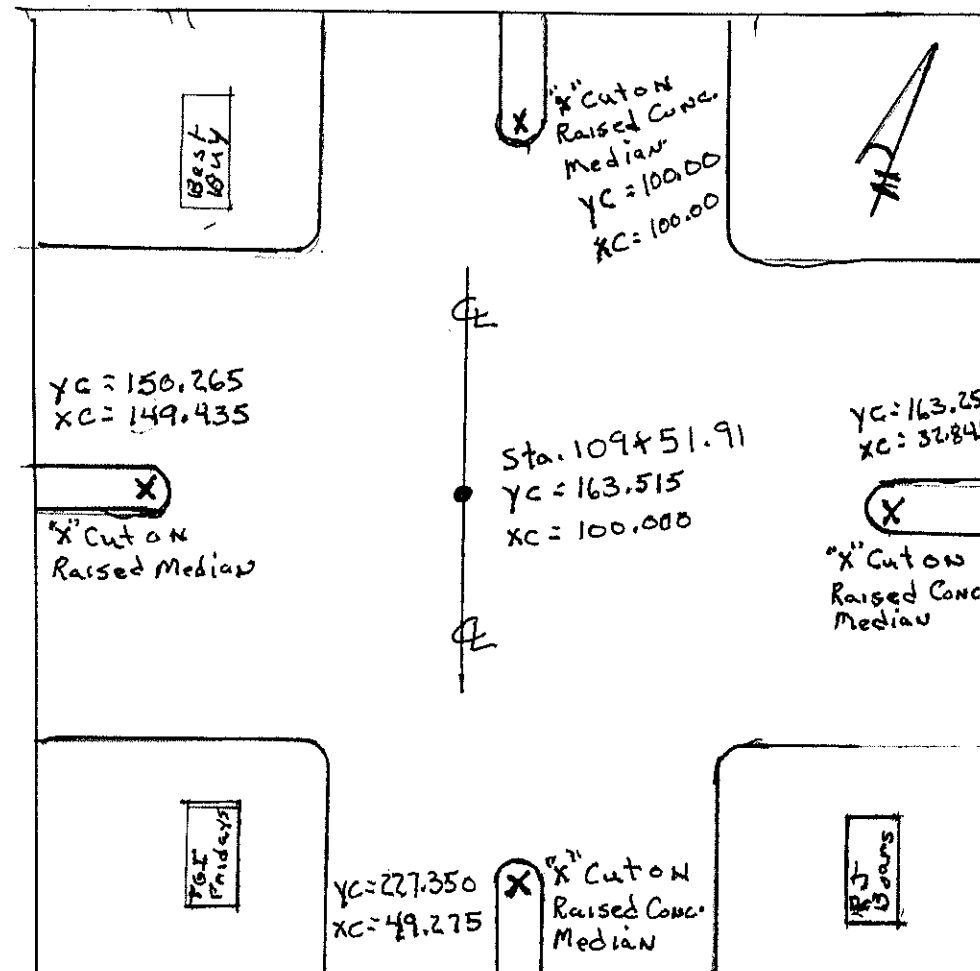

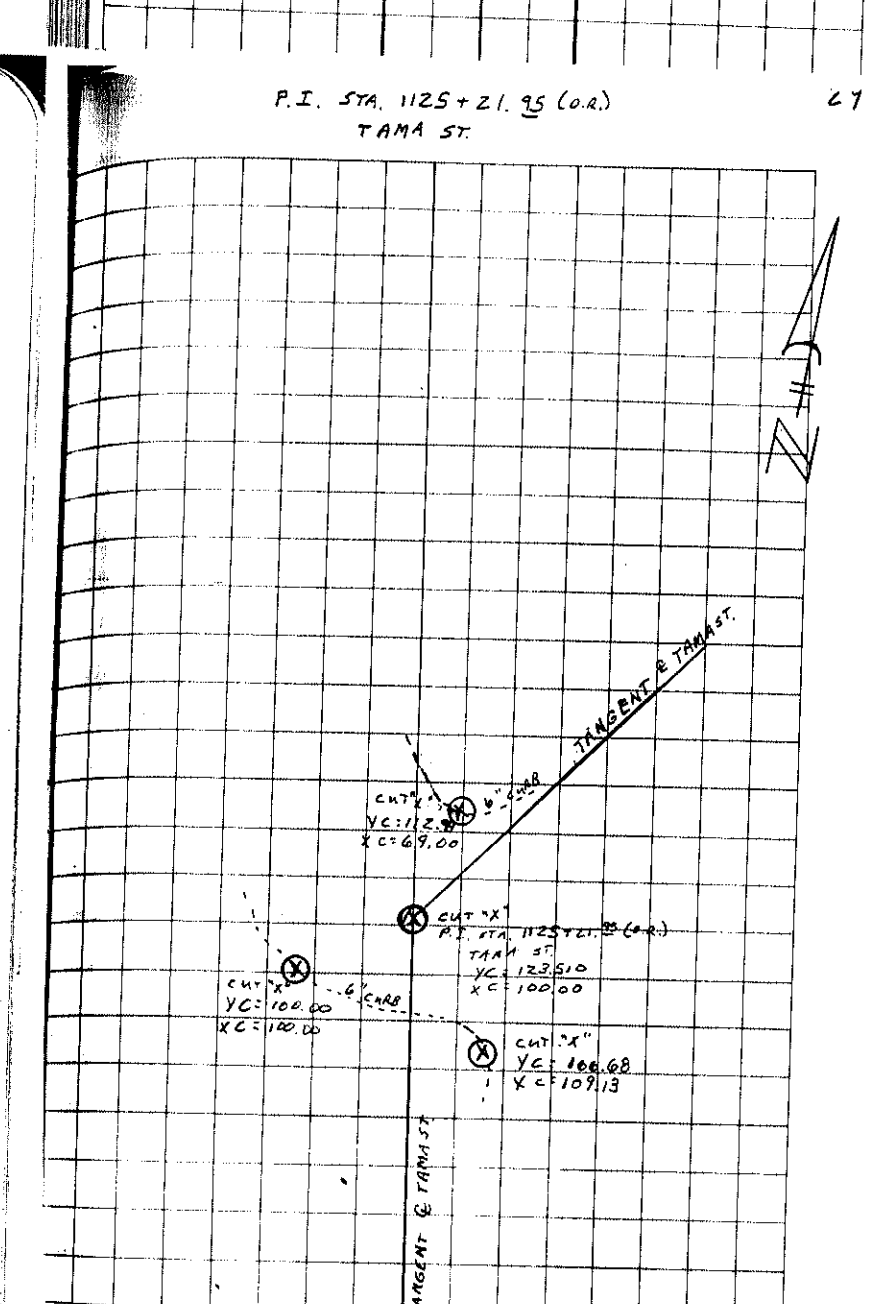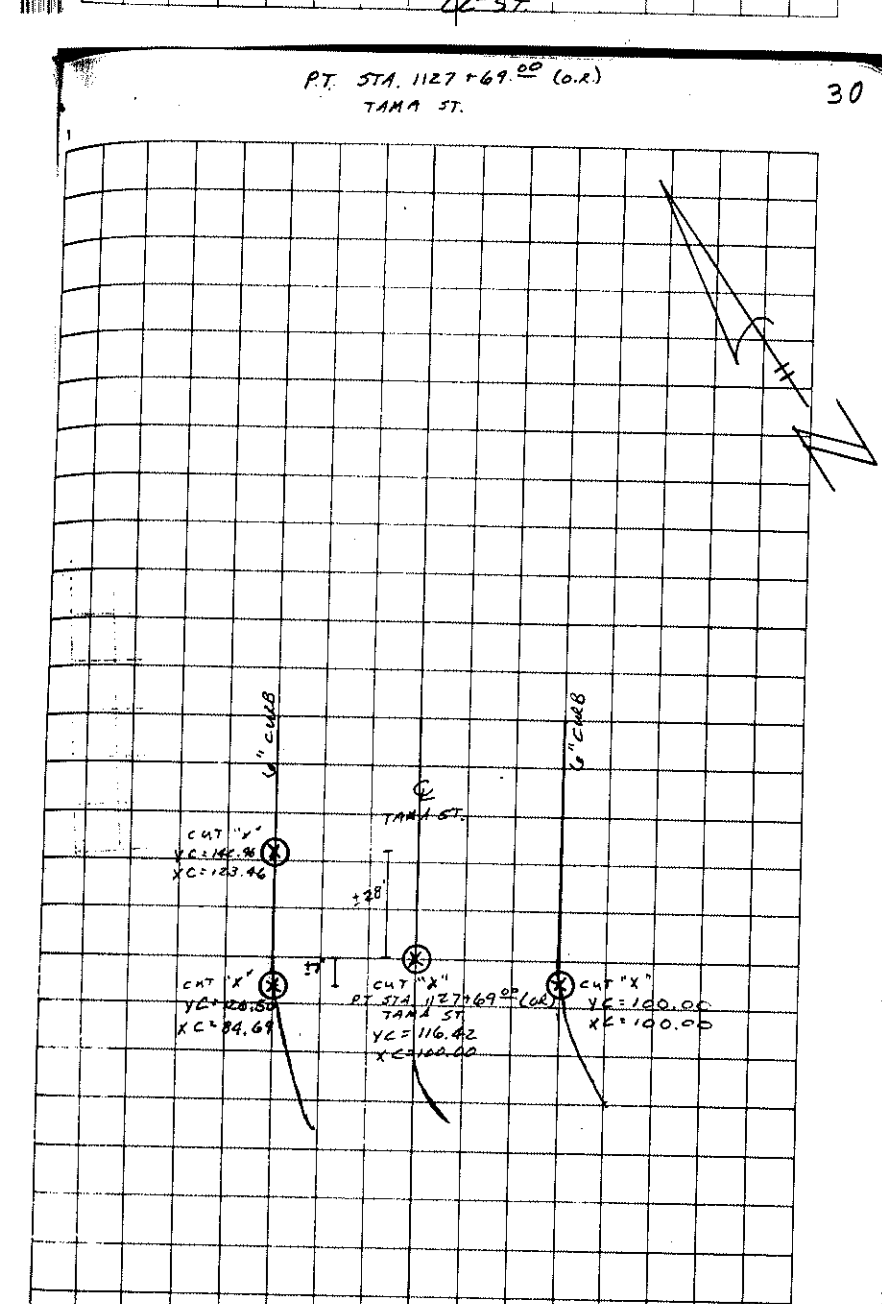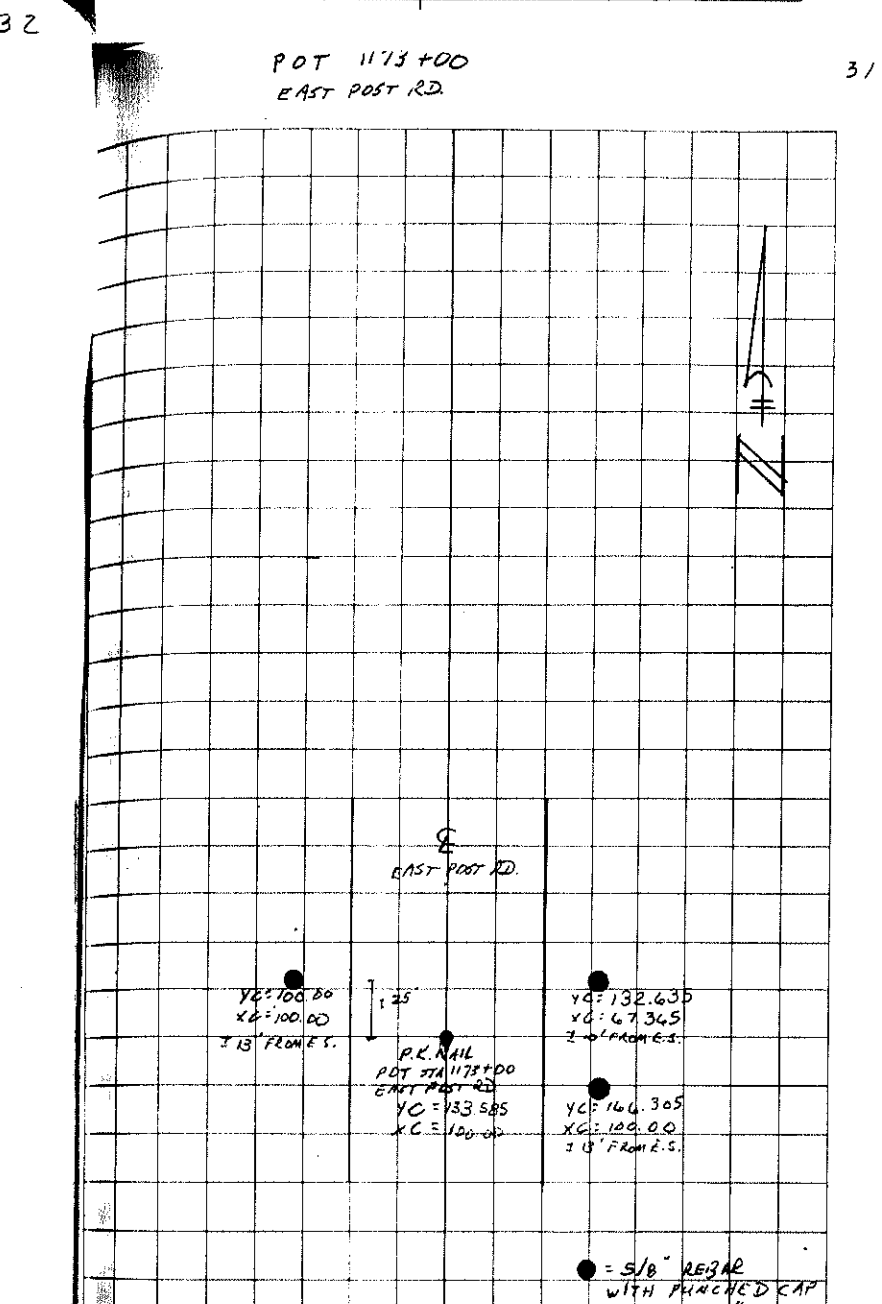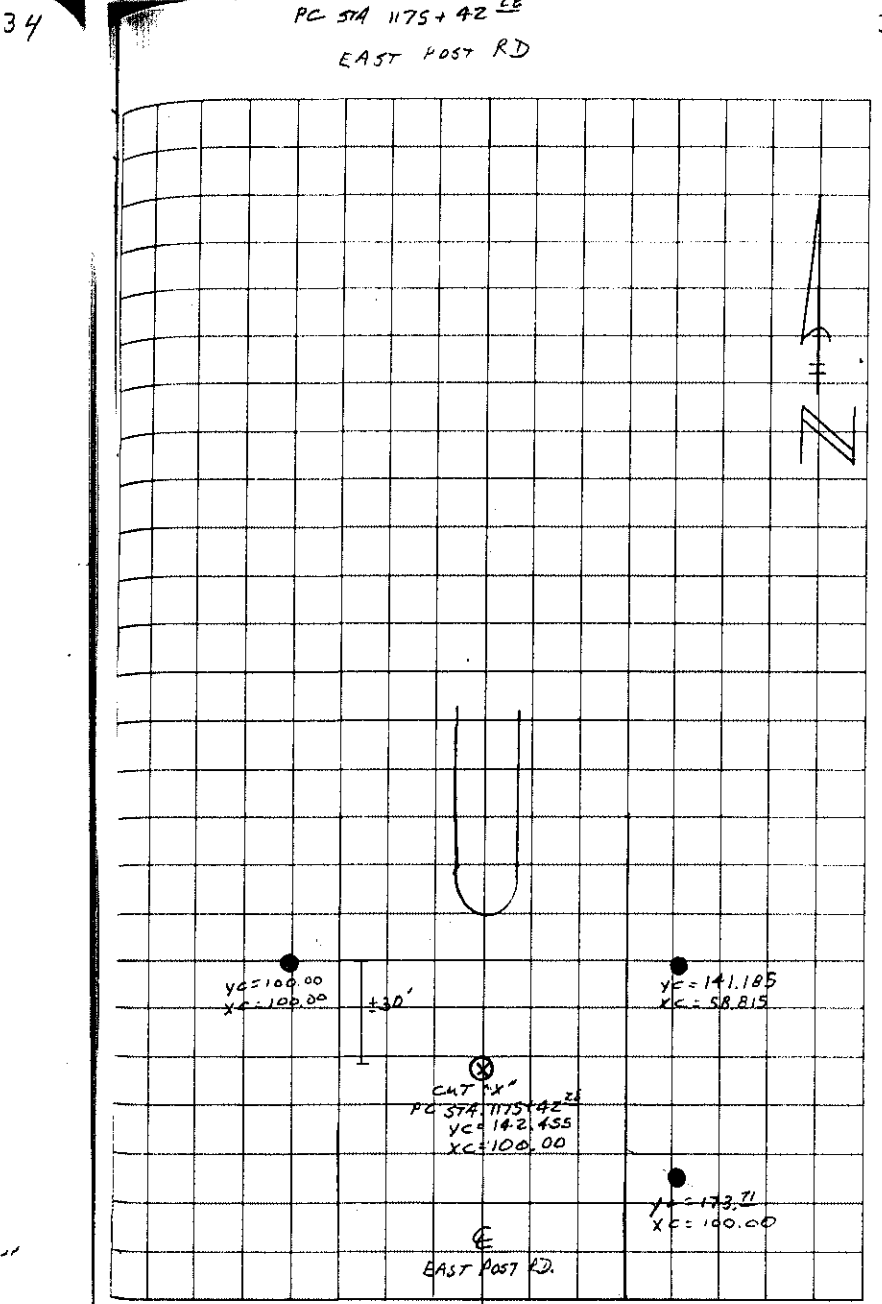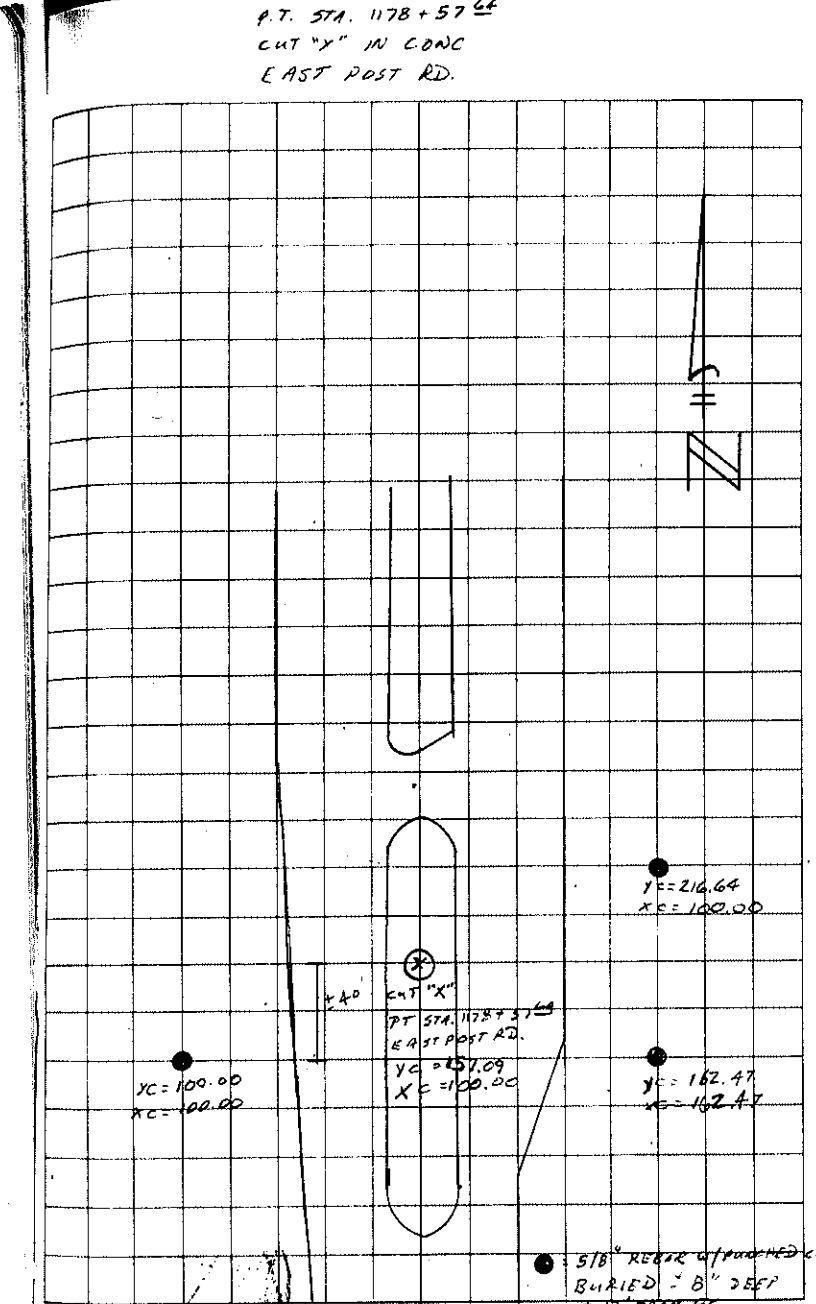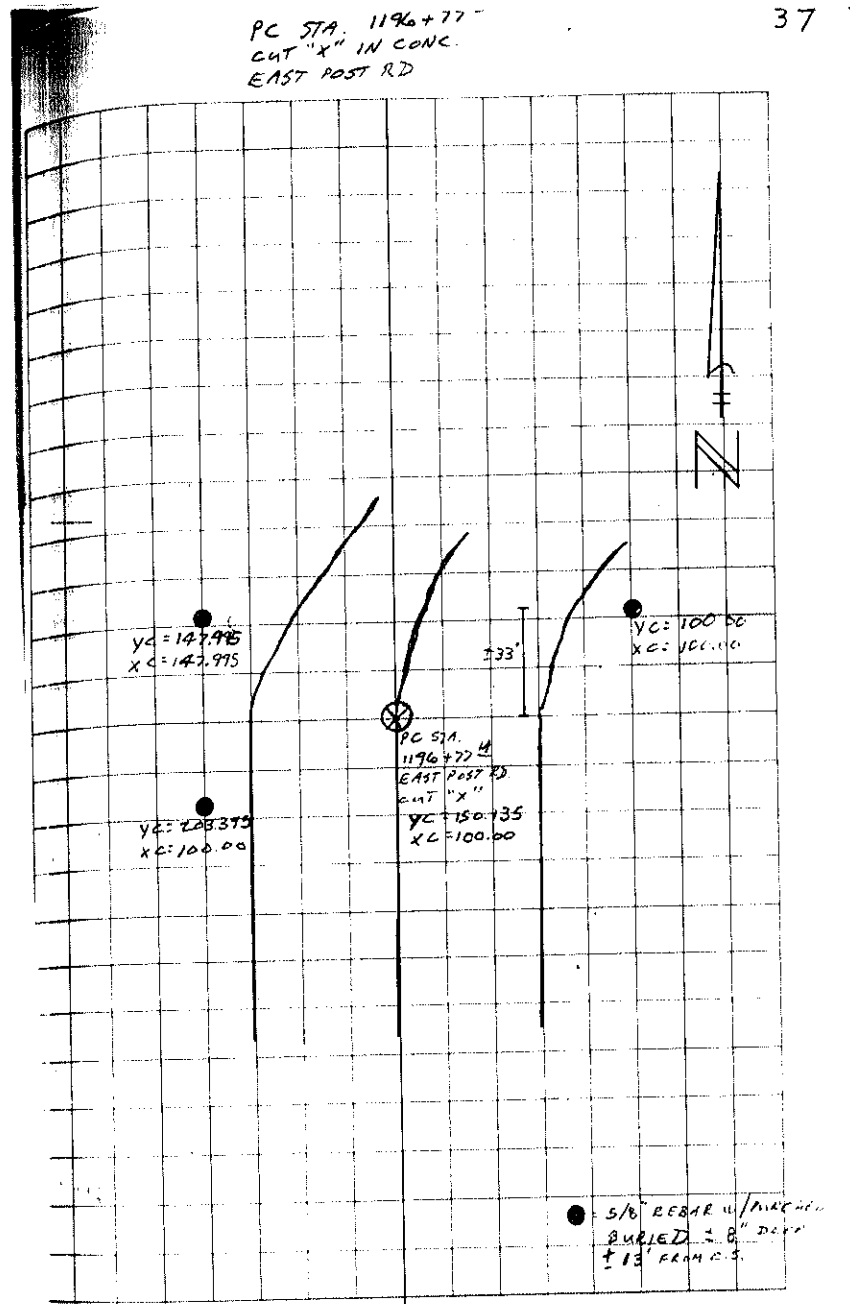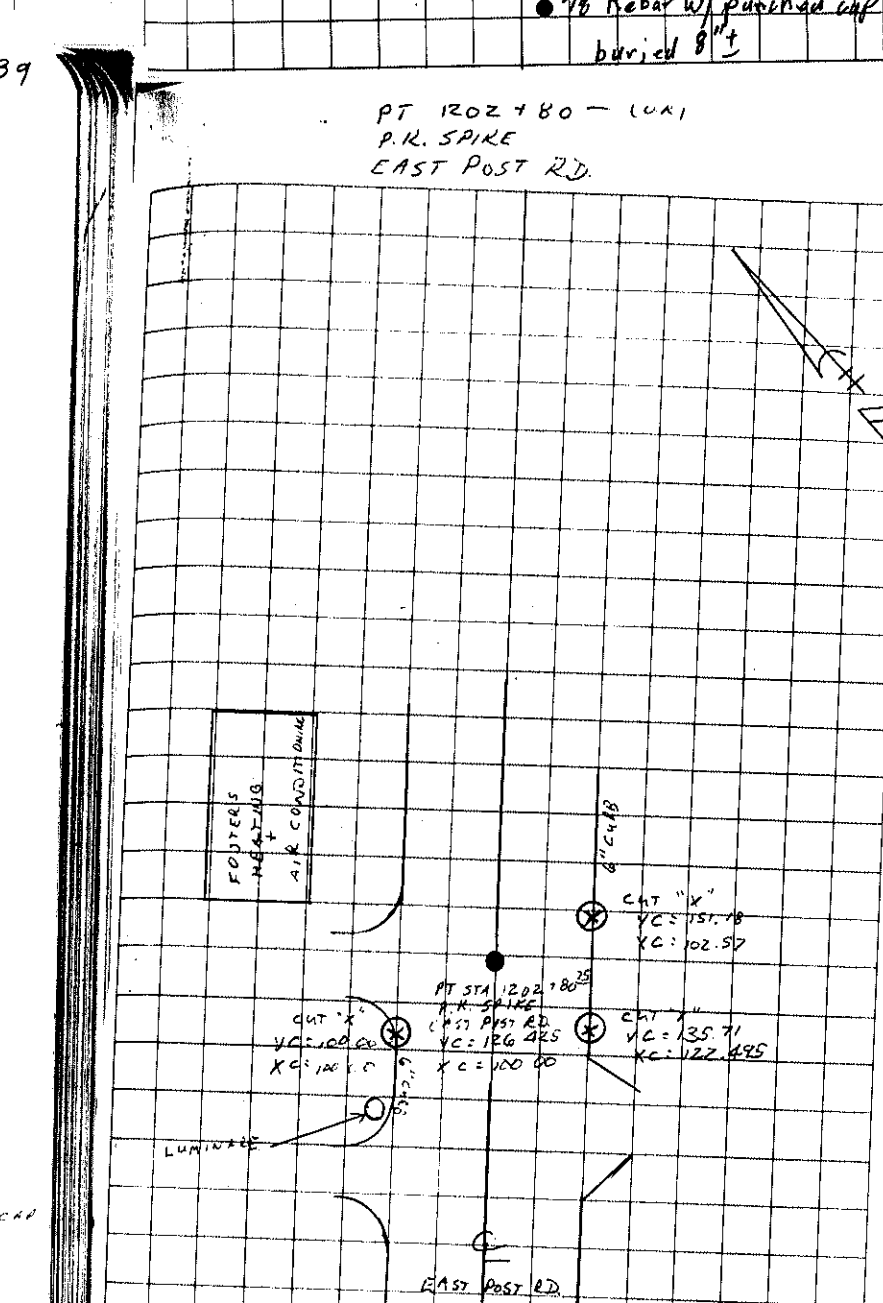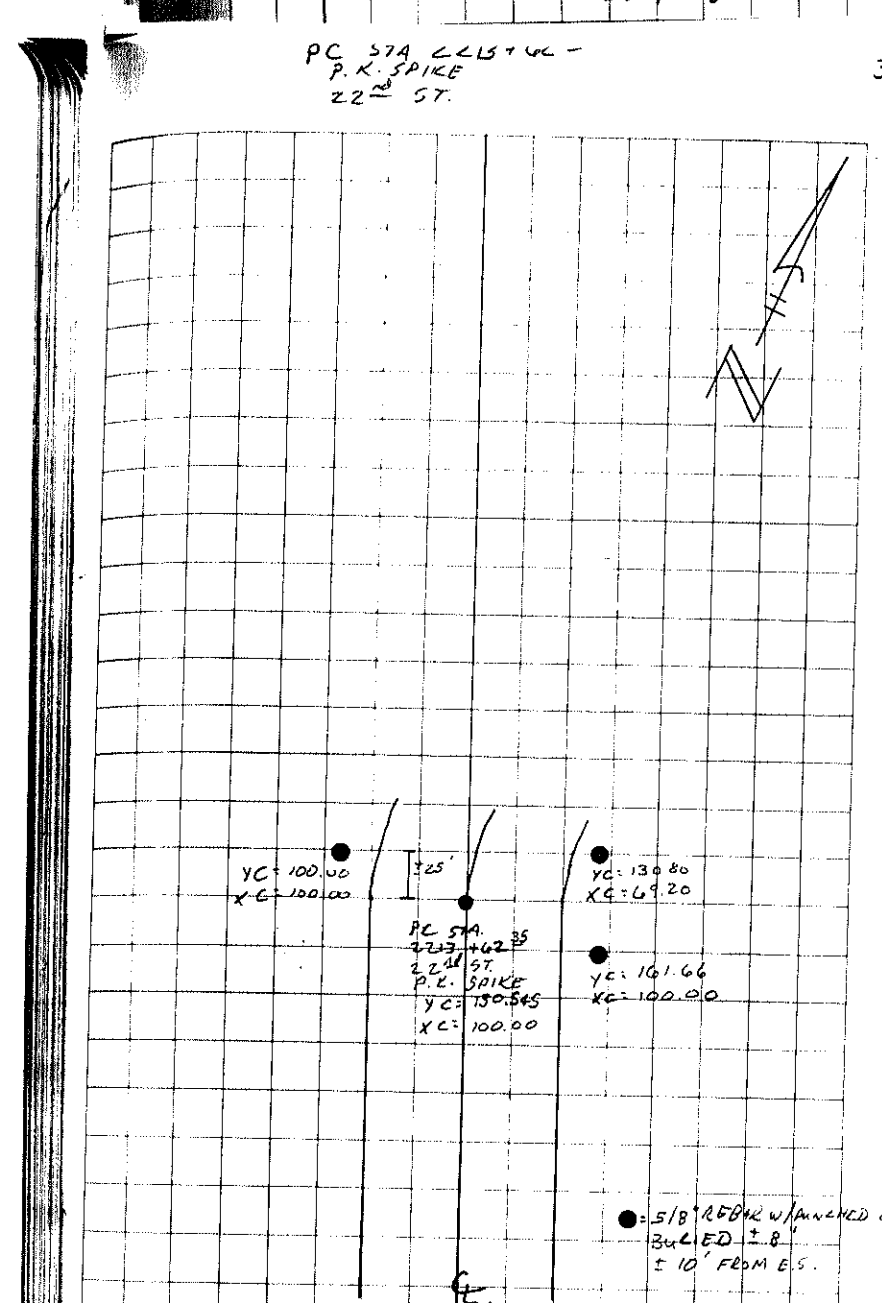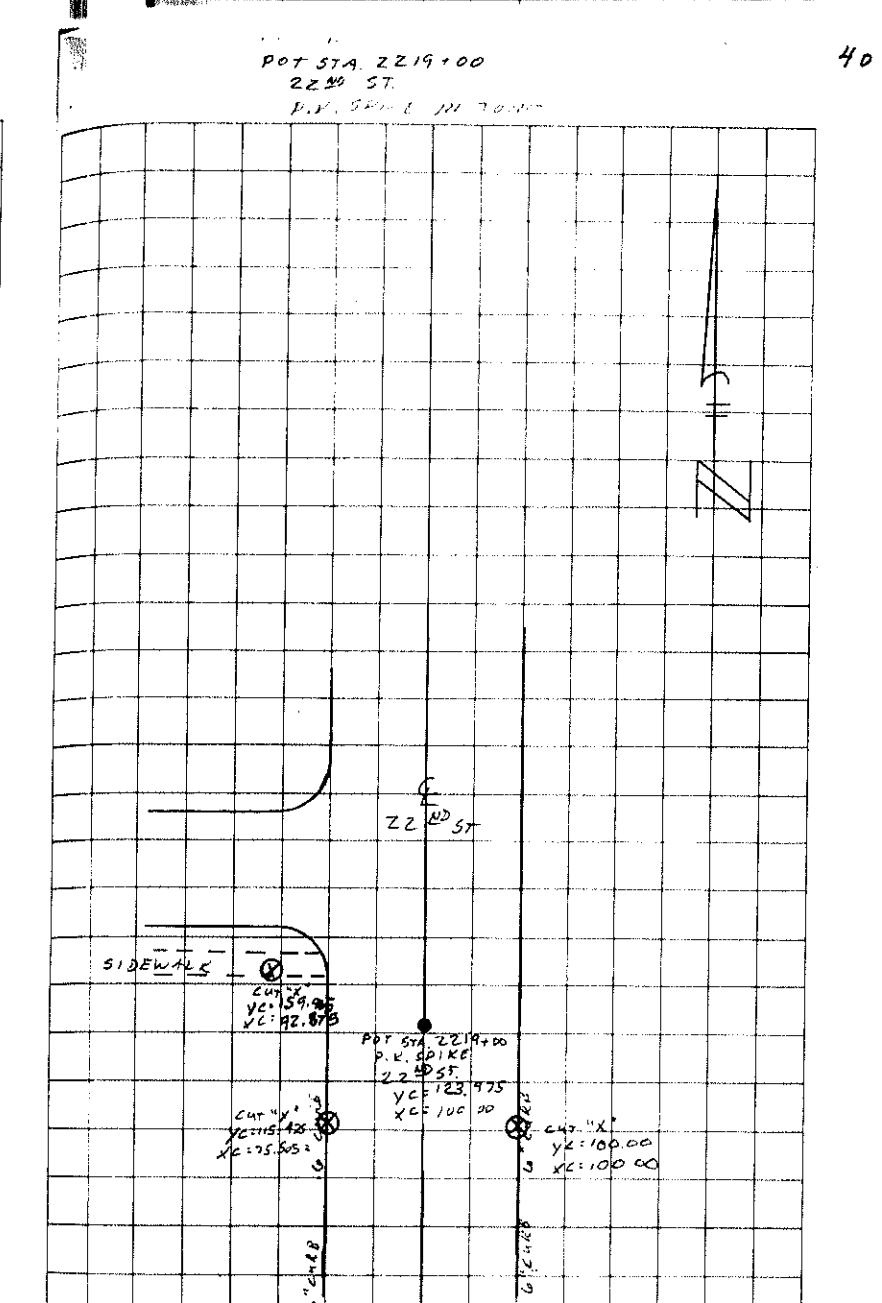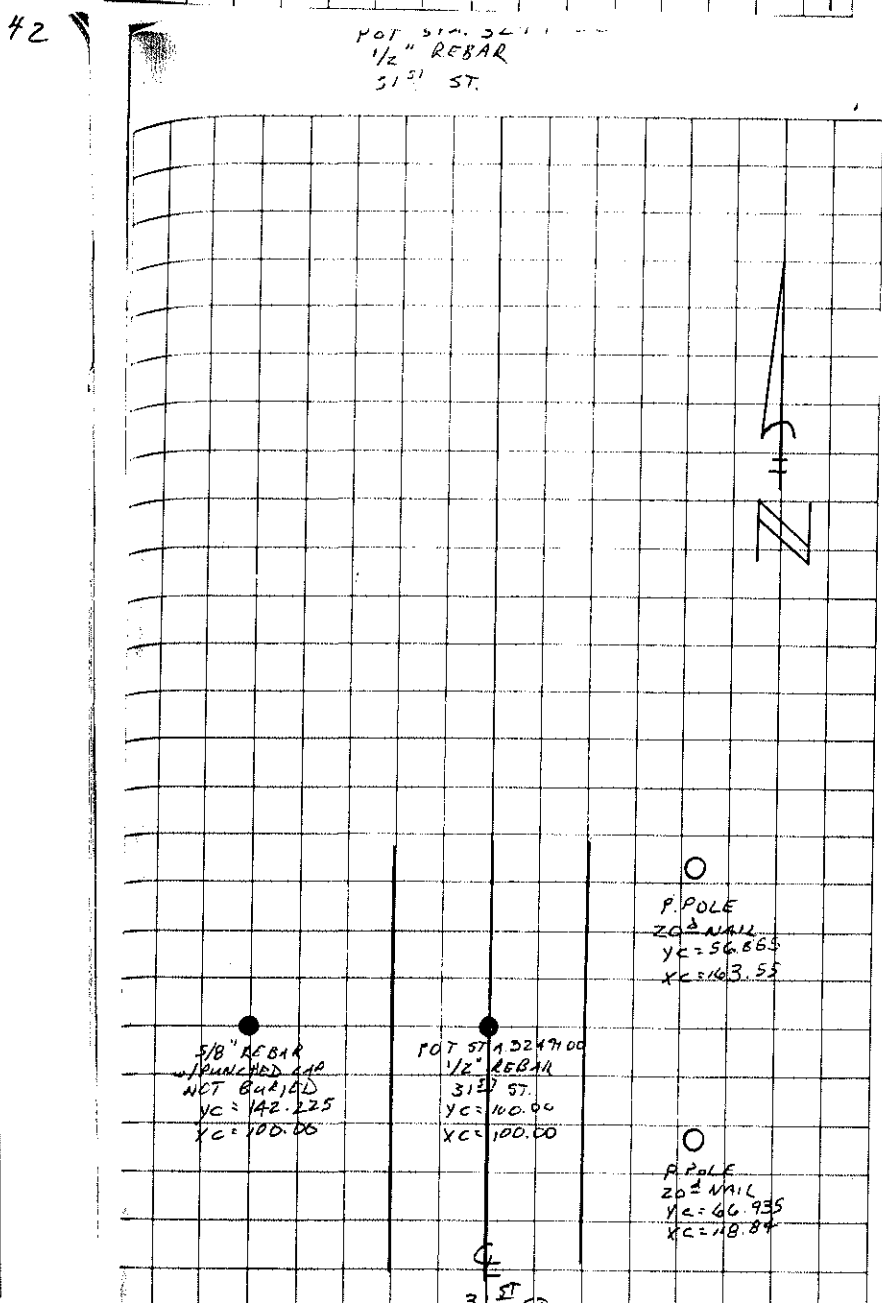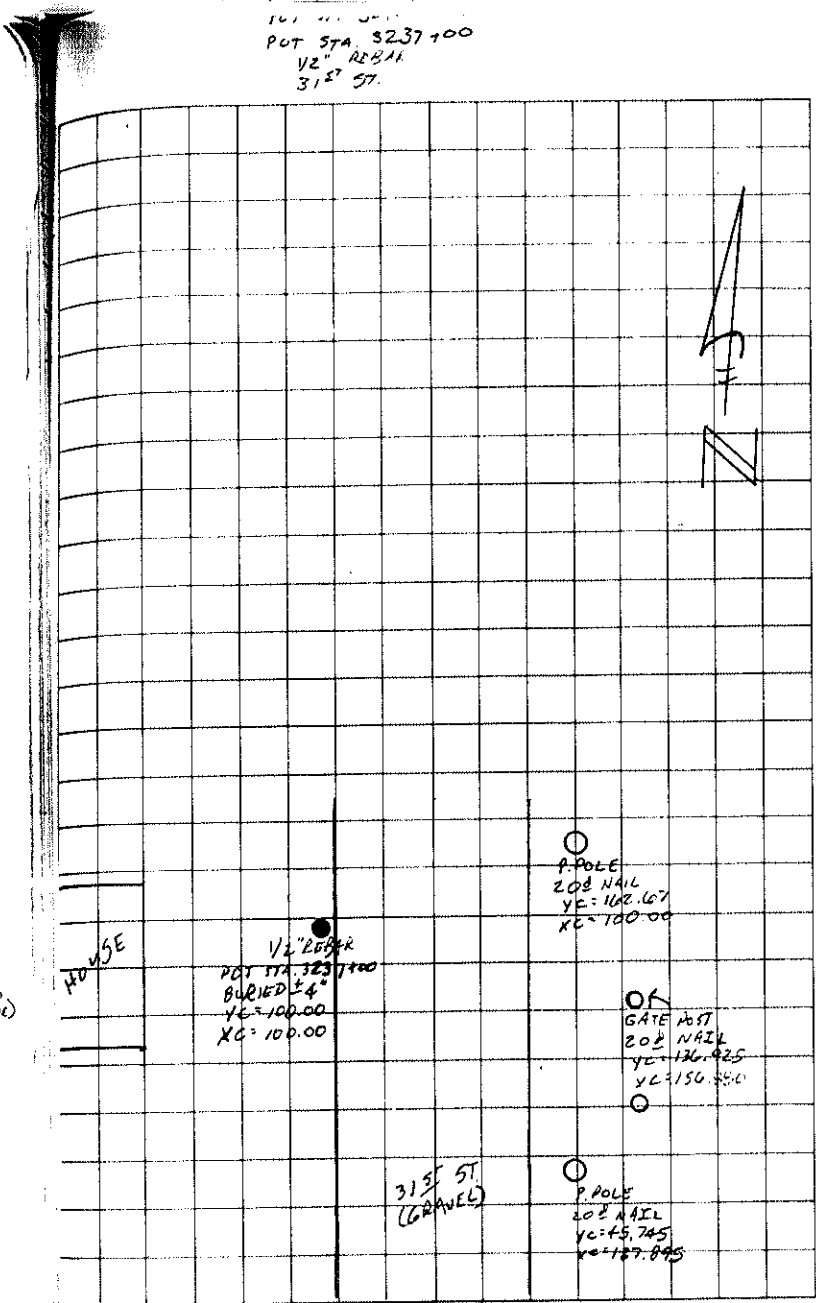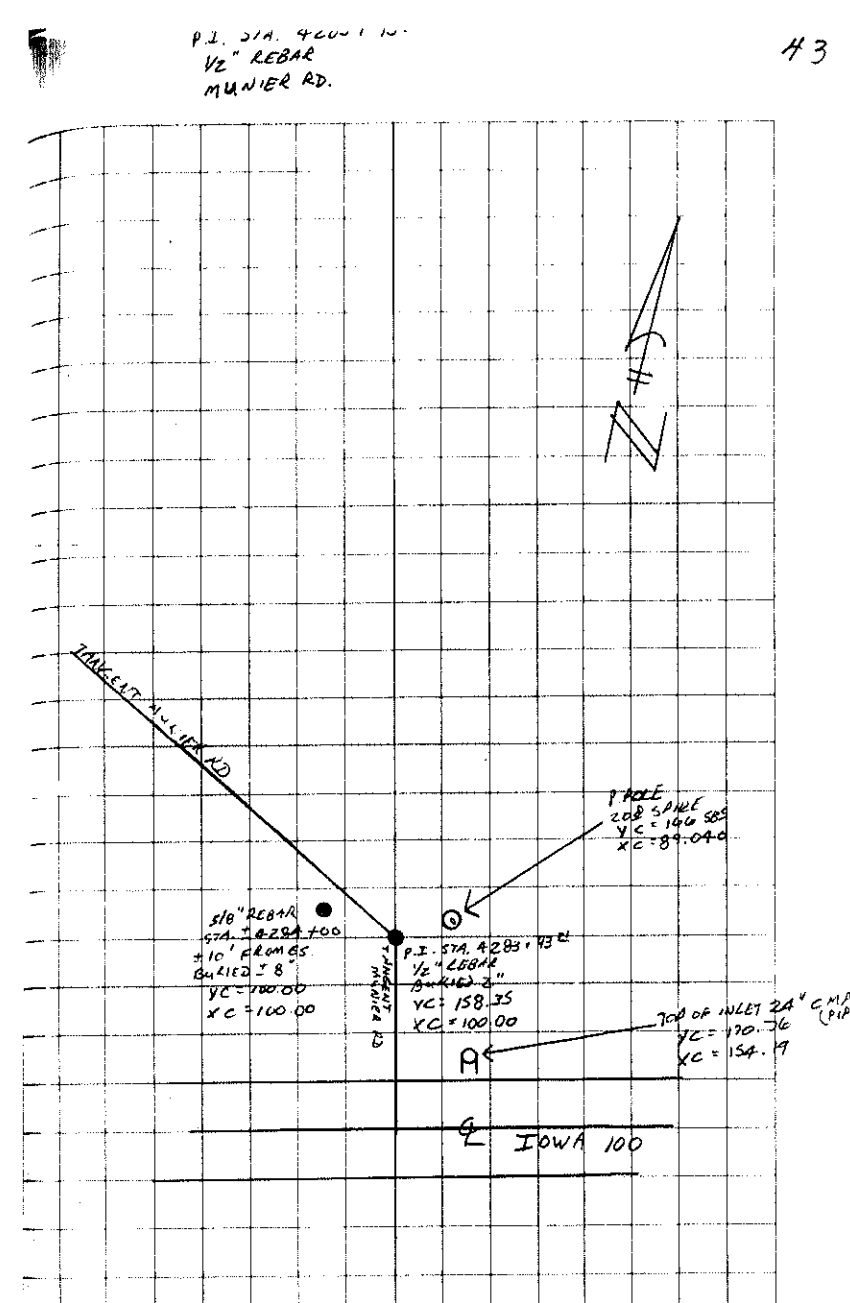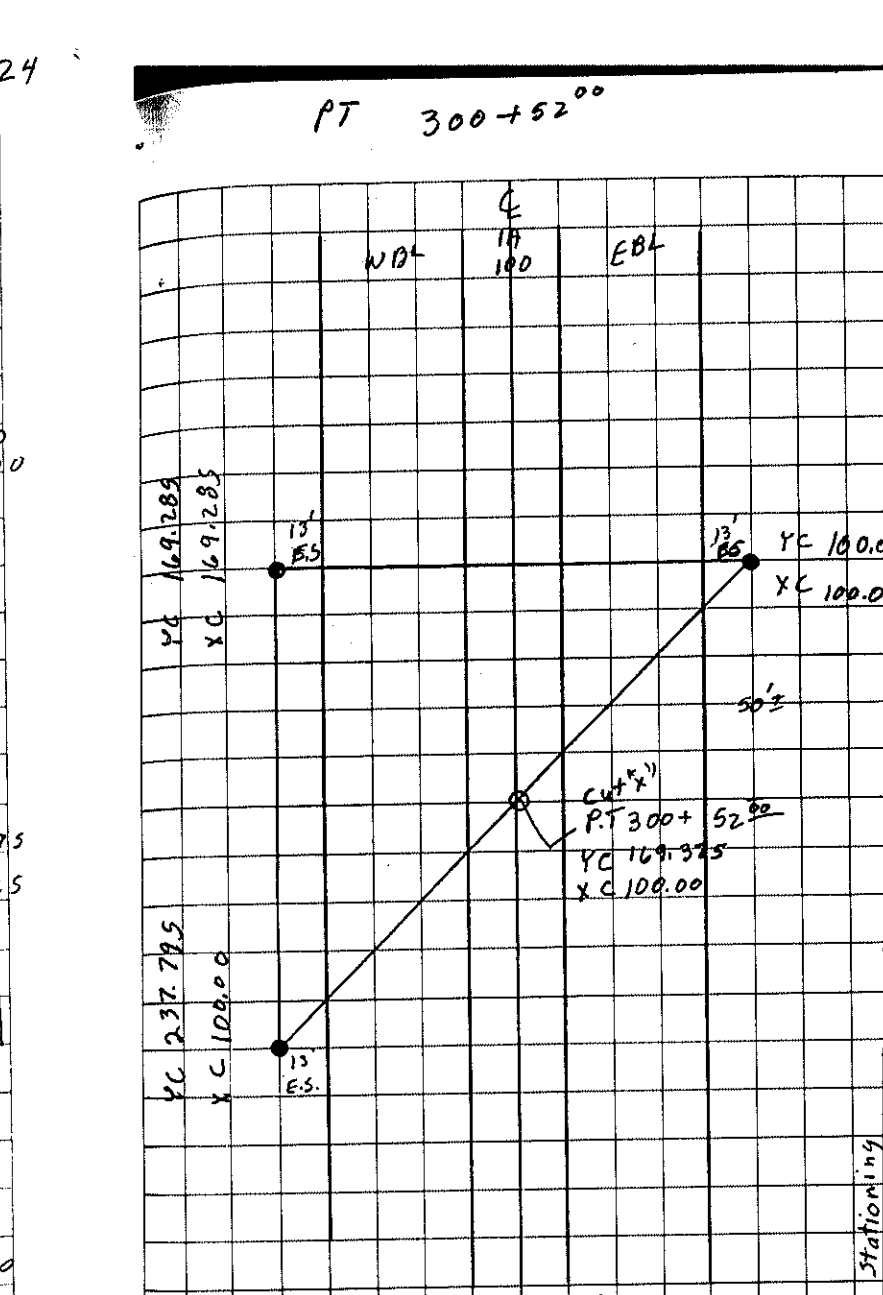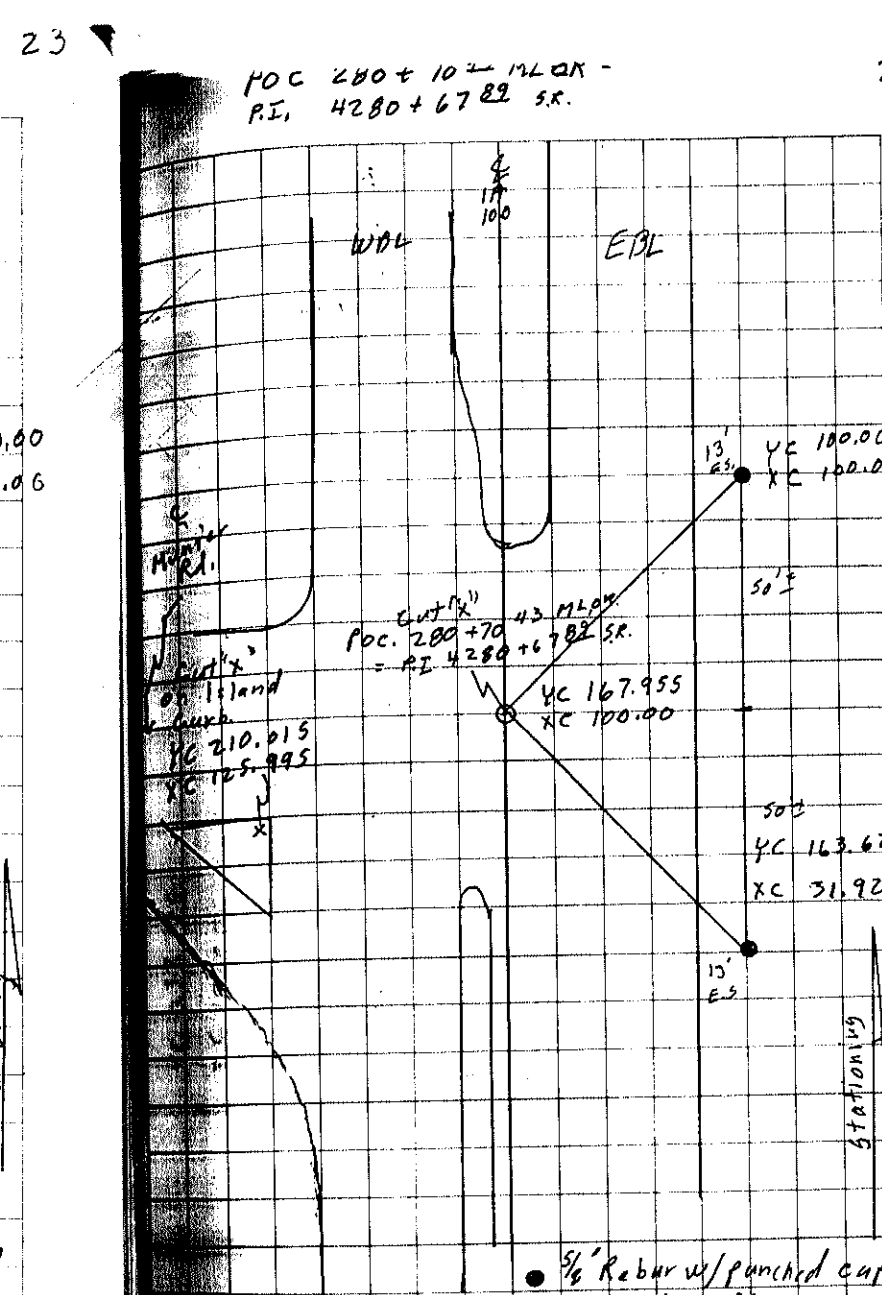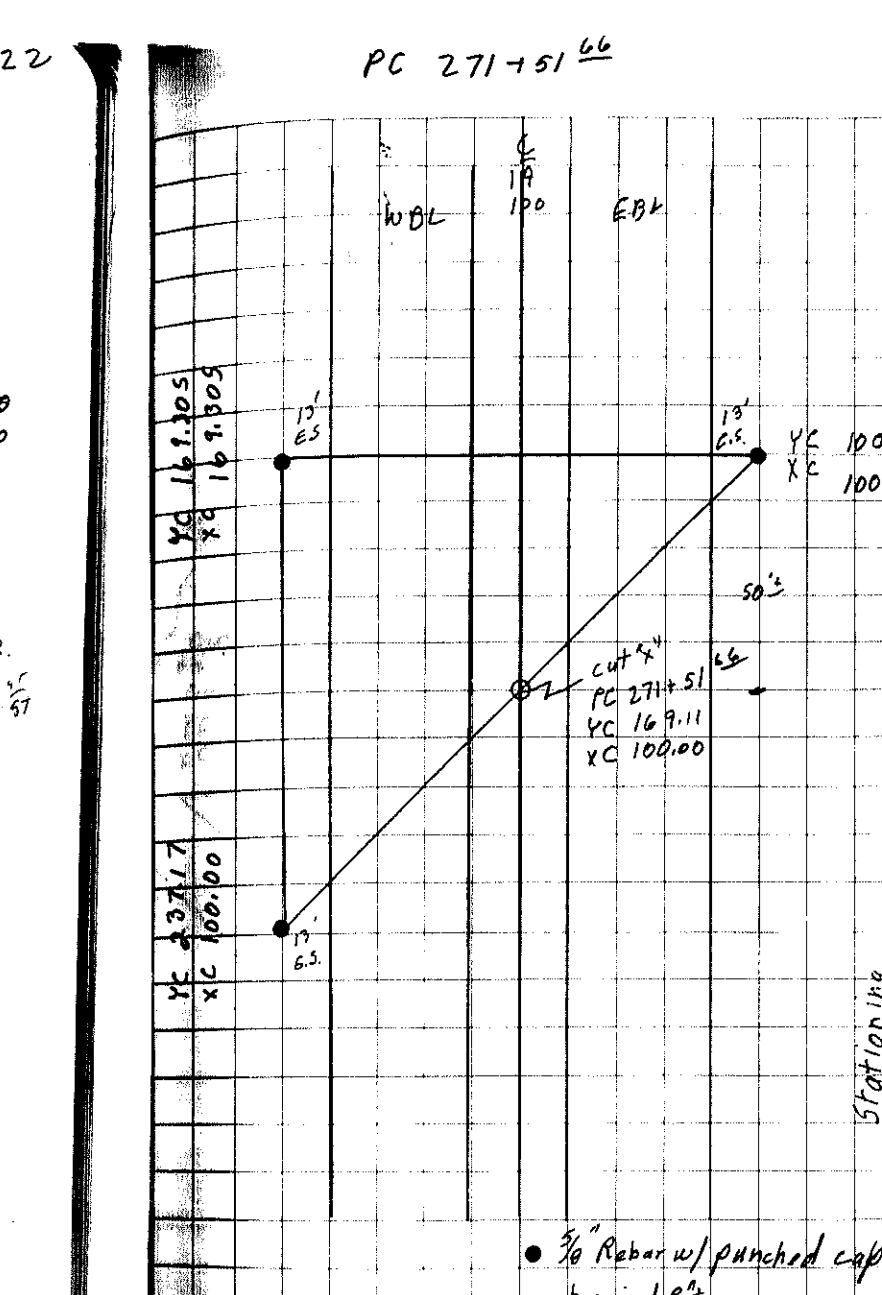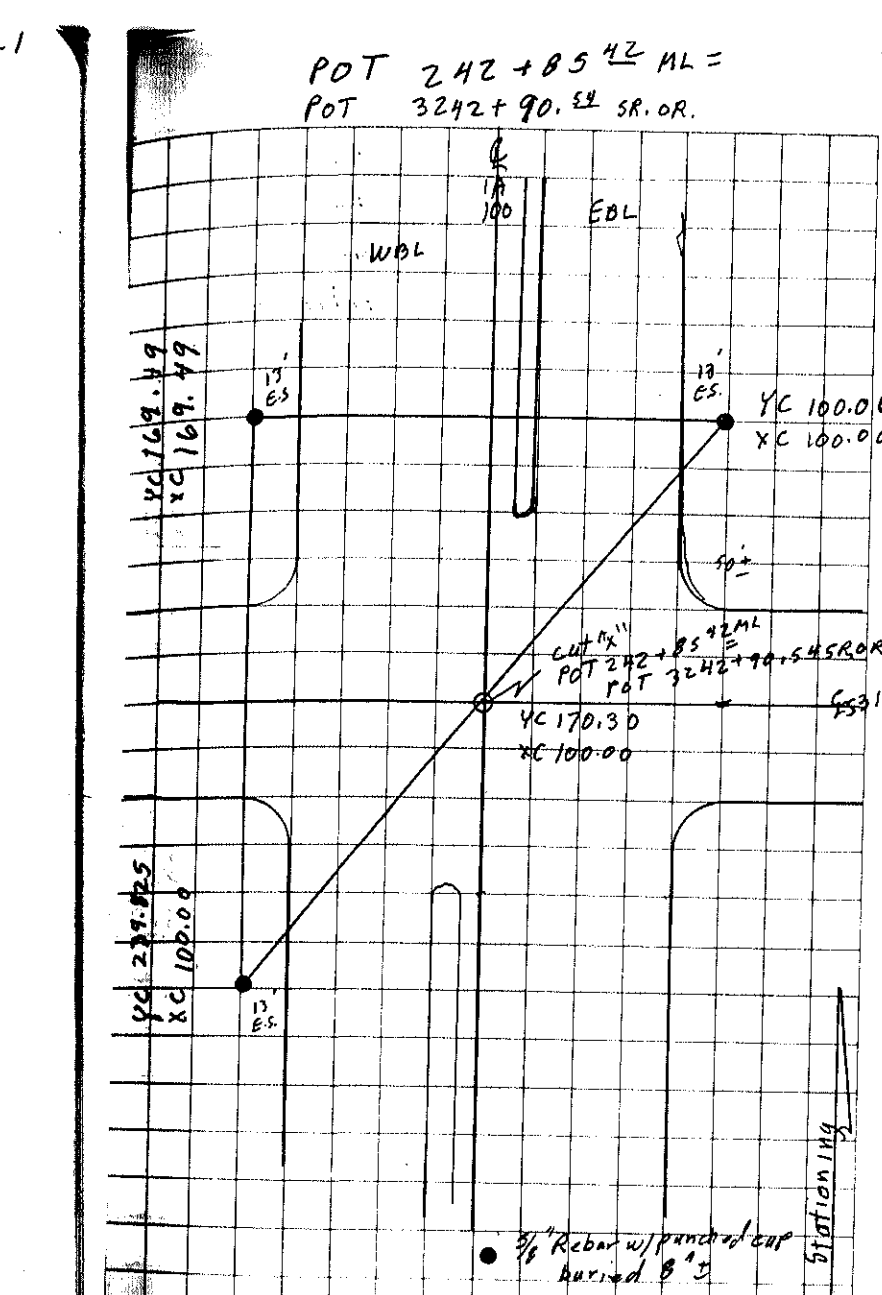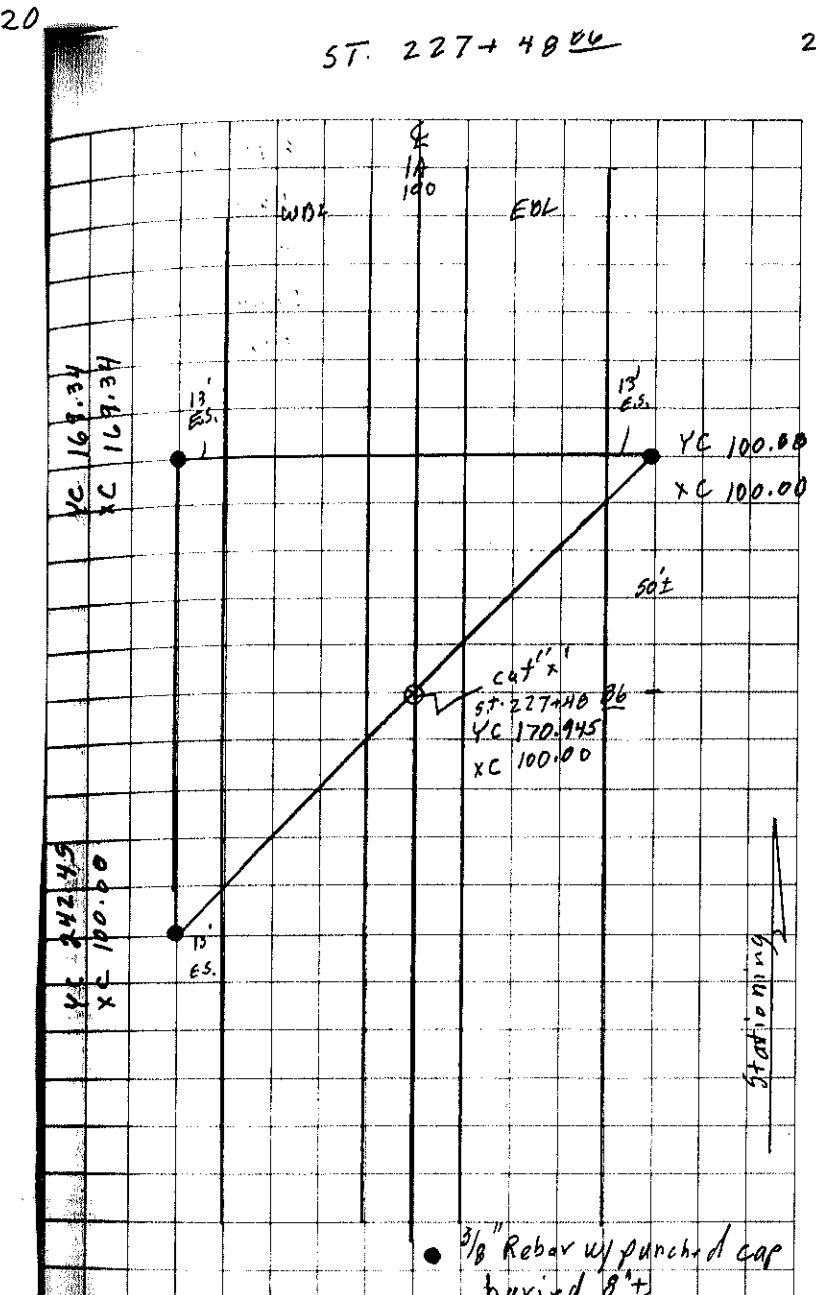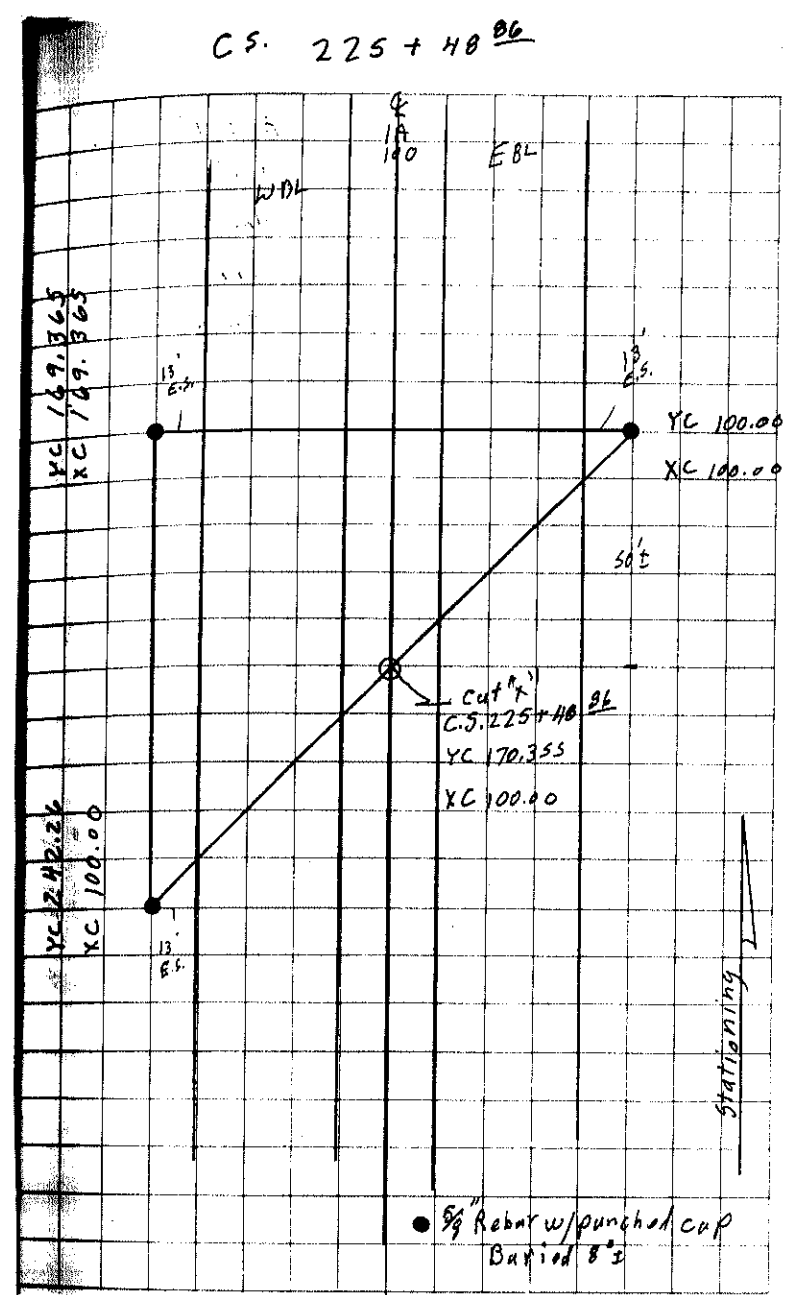

NHS-100-1(23)-1957 G.02
LINN COUNTY P.52

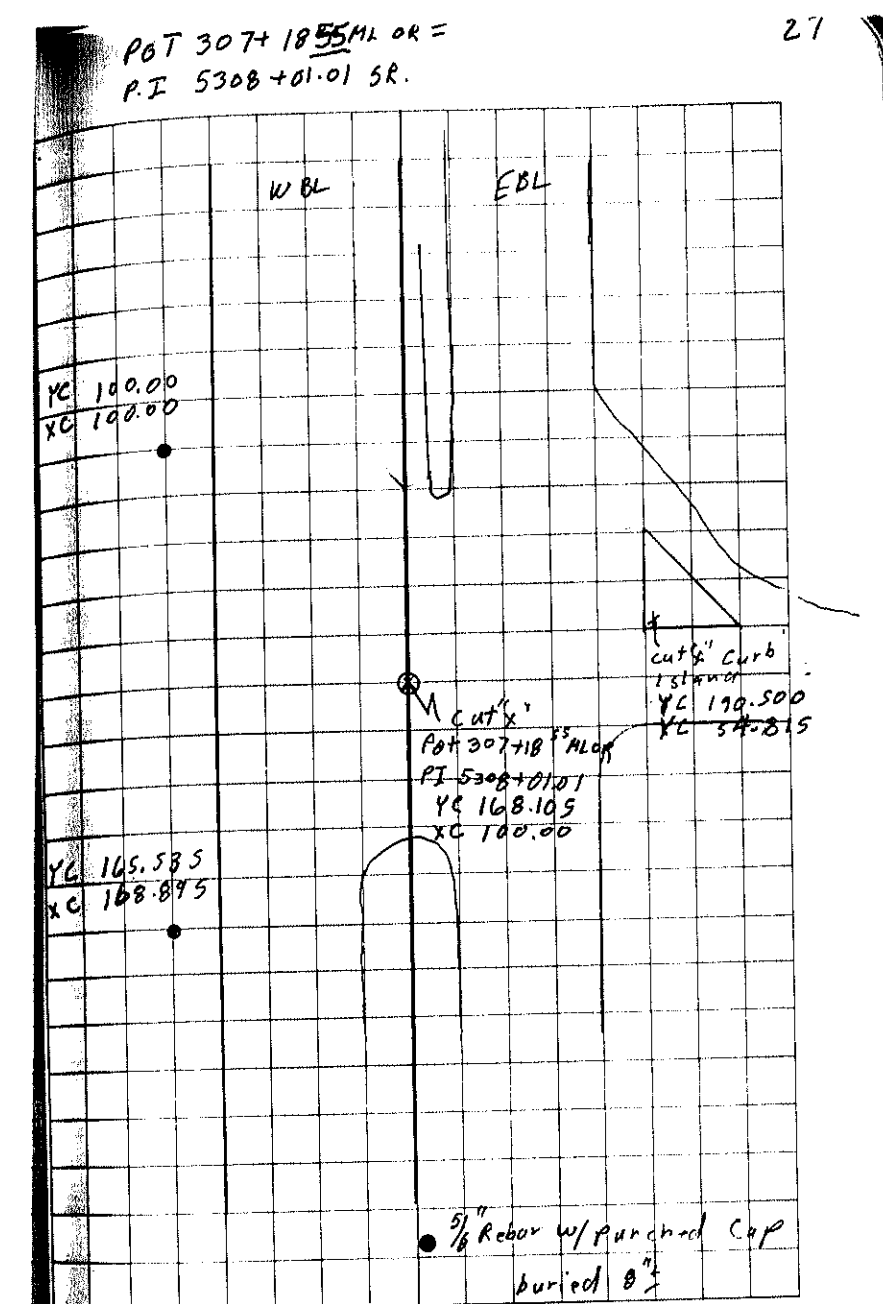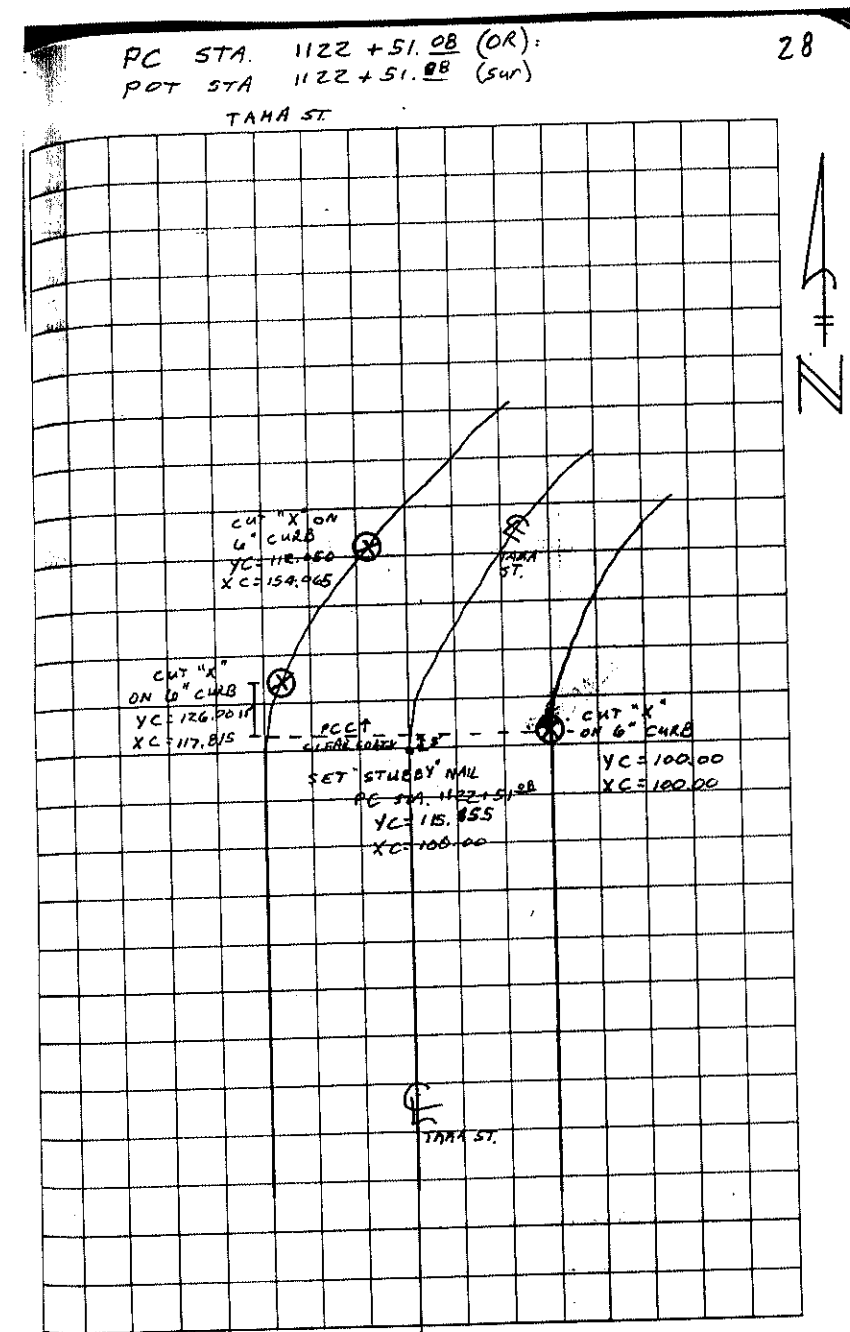

804.10	-362+98.9	Hwy 151 100' RT Iowa DOT Bress Plug Top Center Hdwl RCB
812.05	-370+75	Hwy 151 RT RR Spike Power Pole N.E. Quadrant Intersection
791.94	-310+00	90' LT RIZ SPIKE PP
783.59	-301+00	75' LT Iowa DOT brass plug Center N. Hdwl RCB
815.11	-384+15	104' RT 60' spike in No. side corner Post
811.61	-271+91.66	130' LT Top ROW Pin
775.66	-260+78.8	130' LT Top ROW pin
799.96	-245+25	75' LT Iowa DOT Brass plug Top Center Hdwl RCB
815.56	-232+60	125' LT 60' spike 12' b tree
830.61	-222+25	60' LT "D" Cut top 15" Conc. Apron
874.02	-213+00	150' RT Cut "X" Top Conc. Fty. Steel Power Pole
889.20	-207+25	150' RT Cut "X" Top Conc. Fty. Steel Power Pole
895.03	-201+50	135' RT Cut "X" Top Conc. Fty. Steel Power Pole
878.42	-195+42	133' RT Cut "X" Top Conc. Fty. Steel Power Pole
850.31	-1190+64	RM 198 RT. S.E. bolt Fire Hyd. East Side East Post Rd. Bottom Flange.
839.51	-186+05	66' LT Cut "D" N.W. Corner Hwy 100 + East. East Rd. on So. side Conc. Fty. for Signals

807.75	-182+33	147' RT Iron Pin w/ Fence Past on ROW line.
787.60	-155+63	45' RT Iowa DOT Brass Plug Top NE Wing Wall Bridge
789.57	-152+94	44' RT Iowa DOT Brass Plug Top SW Wing Wall Bridge
812.02	-143+85	106' LT RR Spike So. Side 12' Maple Tree.
826.78	-129+60	135' RT 60' spike Power Pole West side Farm St.
851.13	-113+47	56.5' RT "X" Cut Top Conc. Light Base S.E. Corner T&E's parking lot.

DATUM INFORMATION:

1989 Survey
The datum plane for this survey is the same as that of U.S.C.&G.S.
Datum and also the same as:
Project No.: F-151-3(900)--20-57 (1980-1981 Survey)
Project No.: F-151-3(118)--20-57 (1982 Survey)

1980 - 1981 Survey
The datum plane for this survey is identical with U.S.C.&G.S. Datum.

Equations were made to all other datum planes falling
within the bounds of this survey and as follows.

Datum:
U.S.C.&G.S. B.M. Marion, 1934 (This Survey) Elev. = 850.658=
U.S.C.&G.S. B.M. Marion, 1934 Elev. = 850.658=
City of Marion Datum Elev. = 850.66

B.M.#1 This Survey Elev. = 805.140=
T.B.M.#3 U-151-1(118)--40-57 Linn Co., Elev. = 805.140=
July, 1976 Photo Control
City of Cedar Rapids Datum Elev. = 177.720

B.M.#29 This Survey Elev. = 796.920=
B.M.#2 City of Marion Sanitary Sewer Datum Elev. = 797.04

B.M.#37 This Survey Elev. = 797.062=
B.M.#7 L-N-19 Linn Co. As-Built Plans Elev. = 796.95=
U.S.C.&G.S. B.M.#57-690 Elev. = 796.95

B.M.#38 This Survey Elev. = 813.217=
B.M.#31 F-13-1(23)--20-57 Linn Co., Aug.-Nov. Elev. = 813.217=
1973 Survey by J.E. Feller
U.S.C.&G.S. Datum Elev. = 813.217

JUNE - JULY, 1989 SURVEY


BENCH MARKS	LOCATION	DESCRIPTION	ELEVATIONS
No. 122	Sta. 109+87-147' Rt.	Found (X) on S. Bolt Top Hydrant	851.53
No. 120	Sta. 119+59-174' Lt.	Found R.R. Spike N. Side Power Pole	847.99
No. 302	Sta. 129+70-117' Rt.	Found R.R. Spike in S.E. Side Power Pole	827.21
No. 303	Sta. 137+66-53' Lt.	Set R.R. Spike in S. Side Power Pole	818.36
No. 304	Sta. 146+91-29' Rt.	Set R.R. Spike in E. Side 24" Basswood	795.50
No. 305	Sta. 152+50-112' Lt.	Set R.R. Spike in W. Side 24" Locust	766.16
No. 306	Sta. 164+40-26' Lt.	Set R.R. Spike in S. Side 15" Elm Lt.	800.42
No. 307	Sta. 174+03-184' Lt.	Found R.R. Spike in Fence Brace Post Lt.	801.49
No. 19	Sta. 182+72-47' Lt.	Found R.R. Spike N. Side Power Pole	838.66
No. 400	Sta. 1125+10-29' Rt.	Cut (X) on S.W. Corner Concrete Electric Base	851.21
No. 402	Sta. 1140+89-24' Lt.	Cut (X) on E. Corner End 4.0' Concrete Walk Lt.	824.05
No. 403	Sta. 1147+83.5-174' Lt.	Cut (X) on Hydrant N.W. Corner Armor Drive and Kerry Lane	841.57

NOV., 1980 TO MARCH, 1981 SURVEY

BENCH MARKS	LOCATION	DESCRIPTION	ELEVATIONS
No. 1	Sta. 6+98.7-37.5' Lt.	Found 'X' on S.W. Bolt Fire Hyd. @ 28 Th. St. S.E. & 1 St. Ave. S.E.	805.140
No. 2	Sta. 10+11-50' Lt.	Cut 'X' on S.W. Bolt Fire Hyd. @ 29 Th. St. S.E. & 1 St. Ave. S.E.	803.495
No. 3	-----	Cut 'X' on S.W. Bolt Fire Hyd. @ 30 Th. St. S.E. & 1 St. Ave. S.E.	802.550
No. 4	-----	Cut 'X' on N.E. Cor. Abut. of R.R. Overpass Between 30 Th. & 31 St.	810.646
No. 5	-----	Cut 'X' on S.W. Bolt Fire Hyd. @ 32 Nd. St. S.E. & 1 St. Ave. S.E.	813.882
No. 6	-----	Cut 'X' on S.W. Bolt Fire Hyd. in Front of Julian Machinery Sales	793.866
No. 7	-----	Set R.R. Spike in 24" Oak	787.886
No. 8	-----	Set R.R. Spike in North Side Power Pole	777.199
No. 9	-----	Set R.R. Spike in North Side 30" Cottonwood	759.689
No. 10	Sta. 113+60-91' Lt.	Set R.R. Spike in S.W. Side 36" Oak	756.606
No. 11	Sta. 120+21-2' Lt.	Set R.R. Spike in South Side Power Pole	775.999
No. 12	Sta. 133+30-8' Rt.	Found R.R. Spike in North Side Power Pole	769.689
No. 13	Sta. 136+07-160' Lt.	Set R.R. Spike in S.W. Side 24" Oak	760.959
No. 14	Sta. 149+51-79' Rt.	Set R.R. Spike in North Side Power Pole	772.644
No. 15	Sta. 157+19-35' Rt.	Set R.R. Spike in North Side 18" Willow	764.055
No. 16	Sta. 158+92-33' Lt.	Set R.R. Spike in South Side 36" Locust	766.075
No. 17	Sta. 168+68-75' Rt.	Set R.R. Spike in N.E. Side 36" Triple Locust	778.632
No. 18	Sta. 174+12-193' Lt.	Set R.R. Spike in West Side Brace Post	801.532
No. 19	Sta. 182+72-47' Lt.	Set R.R. Spike in North Side Power Pole	838.659
No. 20	Sta. 187+77-90' Rt.	Set R.R. Spike in South Side Power Pole on East Post Road	847.526
No. 21	Sta. 195+21-129' Rt.	Set R.R. Spike in N.E. Side of North Power Pole	875.663
No. 22	Sta. 202+23-104' Rt.	Set R.R. Spike in North Side of North Power Pole	901.050
No. 23	Sta. 208+54-110' Rt.	Set R.R. Spike in South Side of North Power Pole	882.783
No. 24	Sta. 215+36-63' Lt.	Set R.R. Spike in South Side Power Pole	851.011
No. 25	Sta. 222+31.8-32.5' Lt.	Cut 'X' on N.W. Bolt of Fire Hydrant	841.744
No. 26	Sta. 220+74-77' Lt.	Set R.R. Spike N.W. Side Brace Post	834.568
No. 27	Sta. 231+56-22' Rt.	Set R.R. Spike in North Side 36" Triple Tree	820.903
No. 28	Sta. 238+38-32' Lt.	Set R.R. Spike in South Side 8" Cottonwood	817.003
No. 29	Sta. 243+44-59' Rt.	Found 40d Spike in West Side Power Pole	796.920
No. 30	Sta. 248+32-423' Rt.	Set R.R. Spike North Side Brace Post	792.001
No. 31	Sta. 271+25-180' Lt.	Set R.R. Spike in West Side Corner Post(B.M. Gone)	813.471
No. 32	Sta. 278+02-168' Lt.	Set R.R. Spike in West Side Fence Post(B.M. Gone)	843.129
No. 33	Sta. 285+18-66' Lt.	Found R.R. Spike in S.E. Side Power Pole	825.390
No. 34	Sta. 291+83-28' Rt.	Set R.R. Spike in South Side Power Pole	806.170
No. 35	Sta. 302+15-100' Rt.	Found Linn County Brass Plug #1001 in S.W. Cor. Wheel Guard of Bridge	785.613
No. 36	Sta. 311+77-43' Rt.	Set R.R. Spike in North Side Power Pole	792.233
No. 37	Sta. 319+89.5-55.5' Rt.	Found U.S.C.&G.S. 57-690	797.062
No. 38	Sta. 369+55-66' Rt.	Found R.R. Spike in East Side Power Pole	813.217
Iowa #13 Stationing			


P.O.T. STA. 109+51.91

June - July, 1989 Survey
Set Hinge Nail

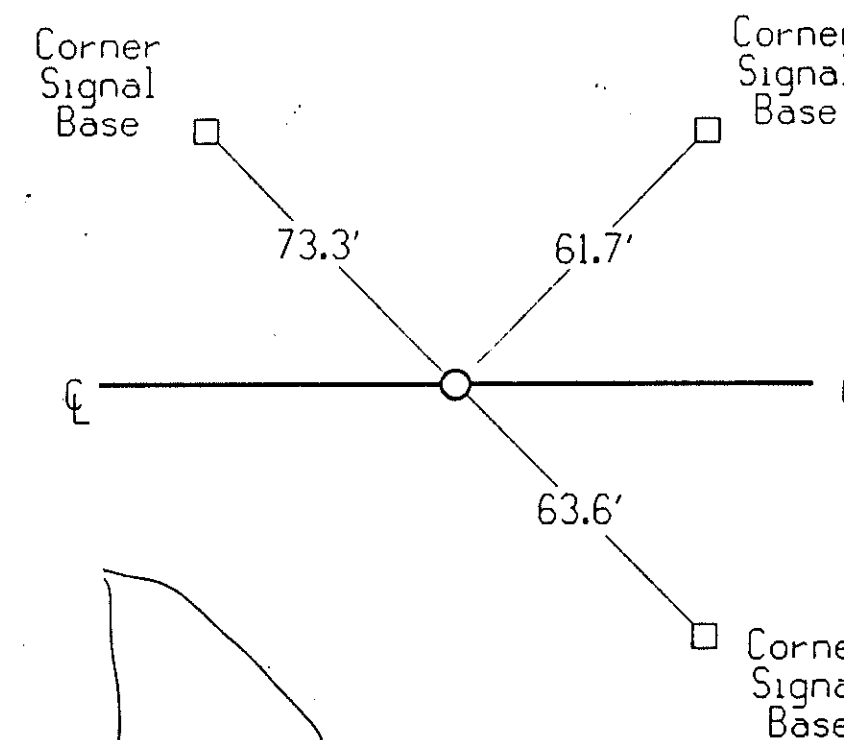


T.S. STA. 111+87.18

June - July, 1989 Survey
Set Iron Pin

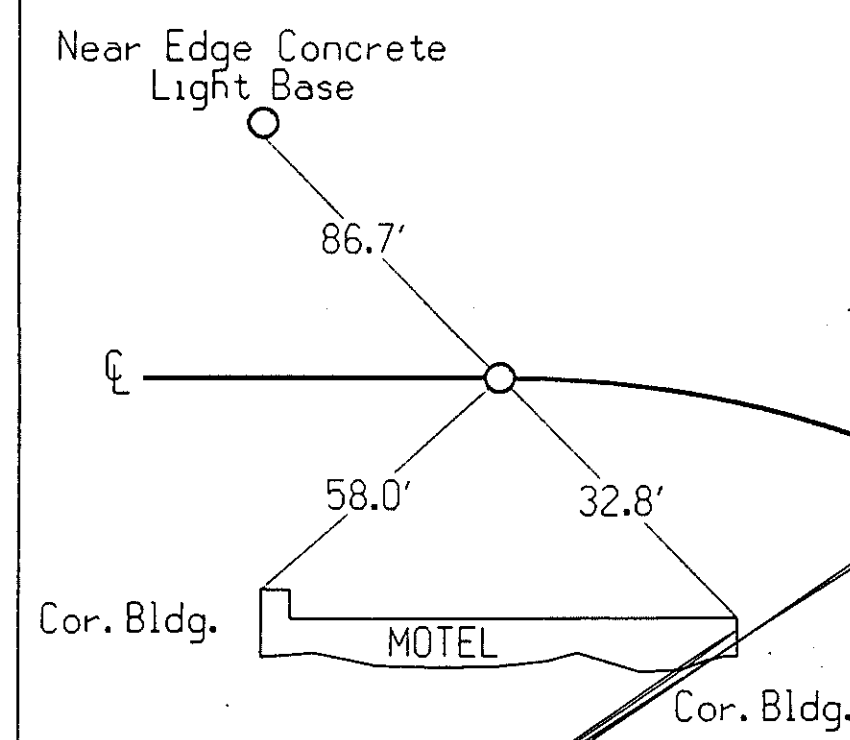


S.C. STA. 114+12.18

June - July, 1989 Survey
Set Iron Pin

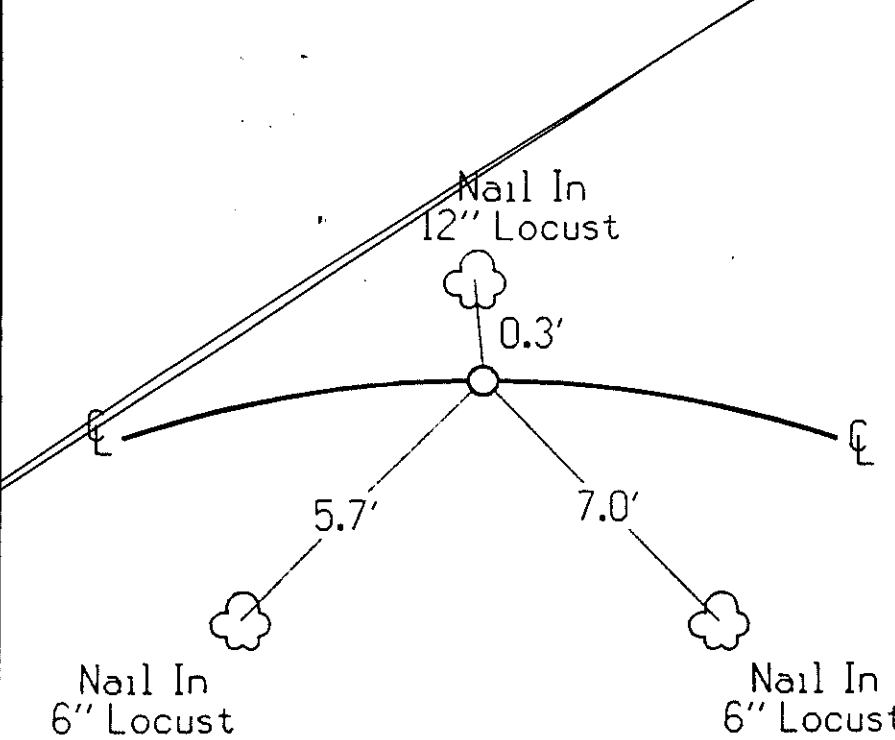


P.I. STA. 116+56.02

June - July, 1989 Survey
Set Iron Pin

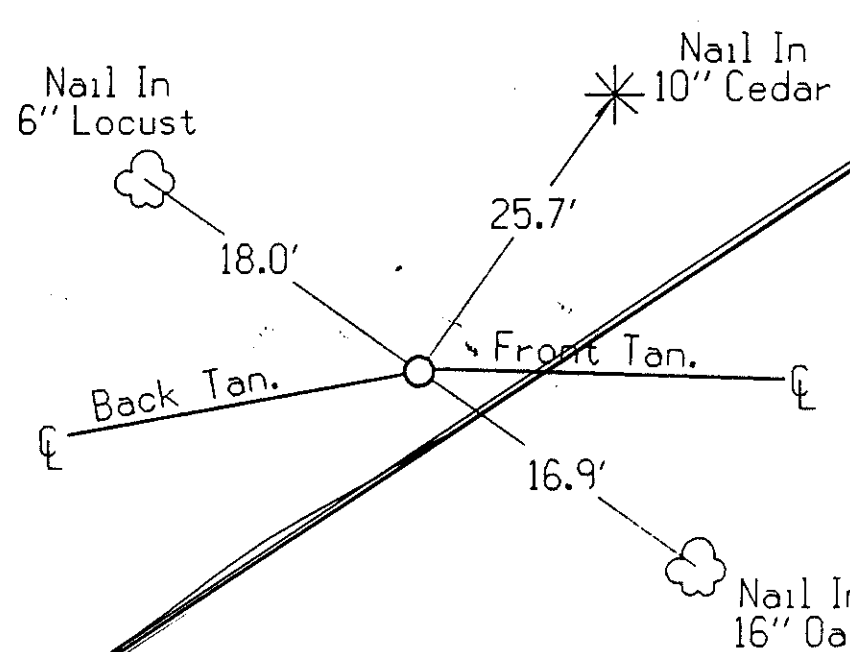


C.S. STA. 118+85.04

June - July, 1989 Survey
Set Iron Pin

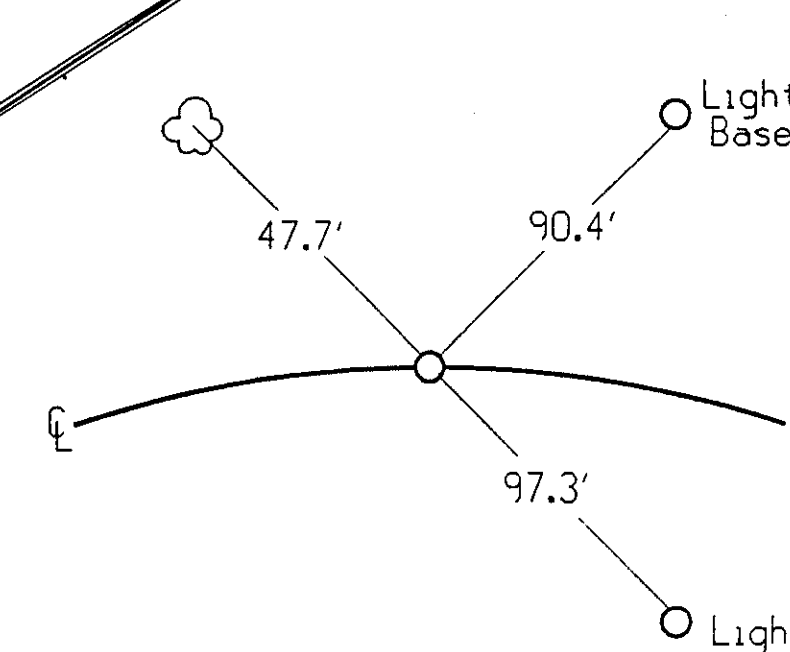


S.T. STA. 121+10.04

June - July, 1989 Survey
Set Iron Pin

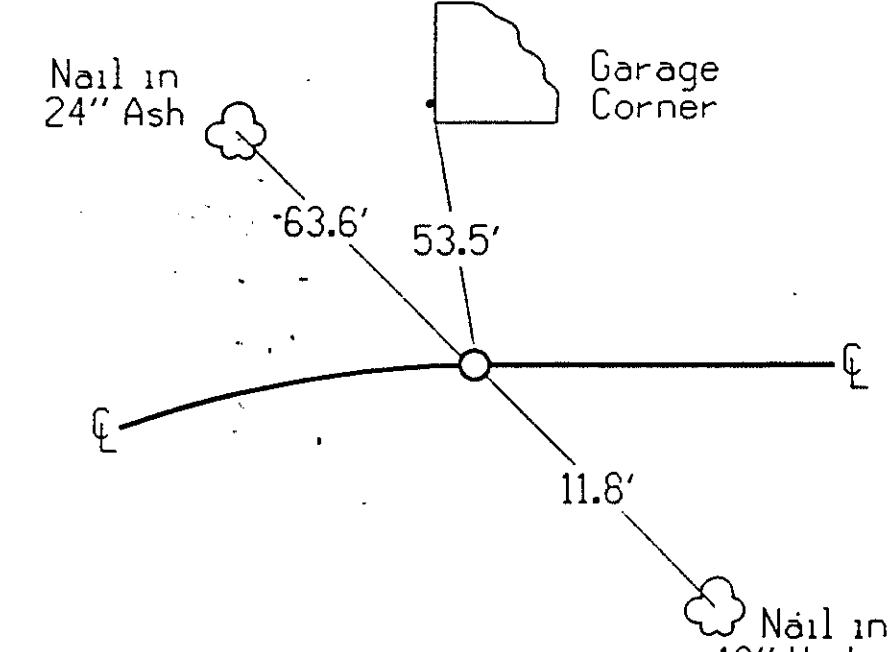


T.S. STA. 122+26.50

June - July, 1989 Survey
Set Iron Pin

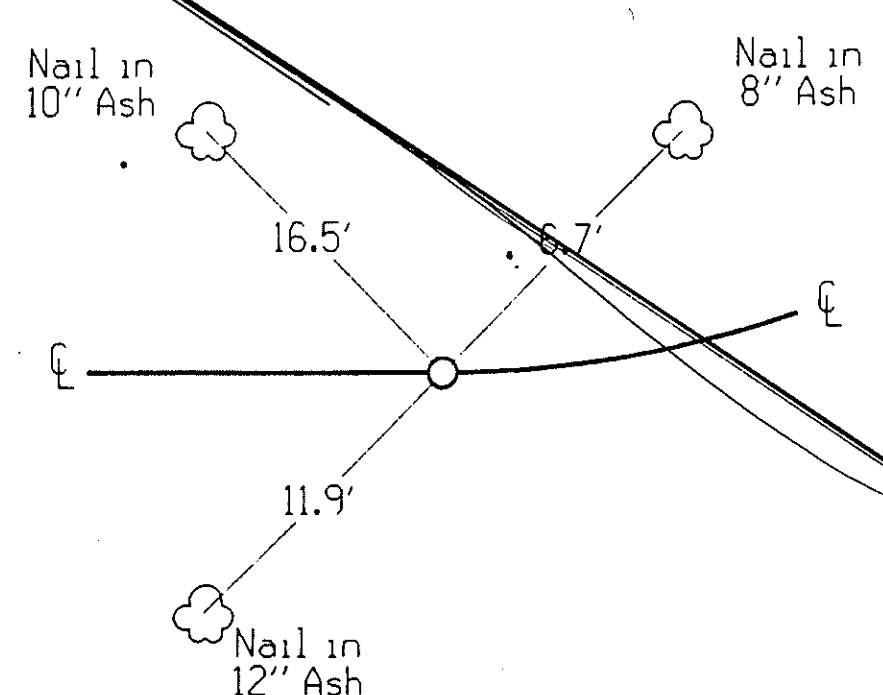


S.C. STA. 124+51.50

June - July, 1989 Survey
Set Iron Pin

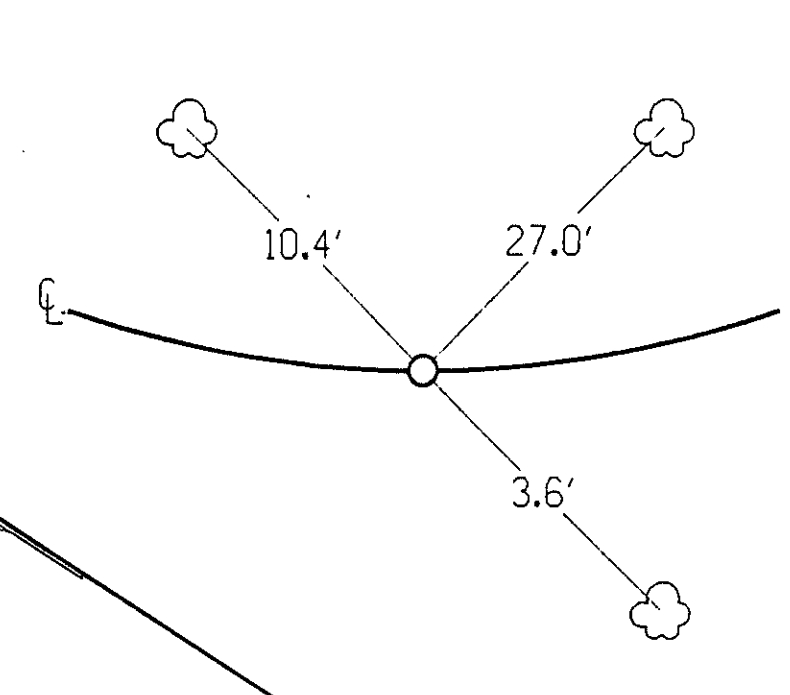


P.O.C. STA. 130+37.31

June - July, 1989 Survey
Set Iron Pin

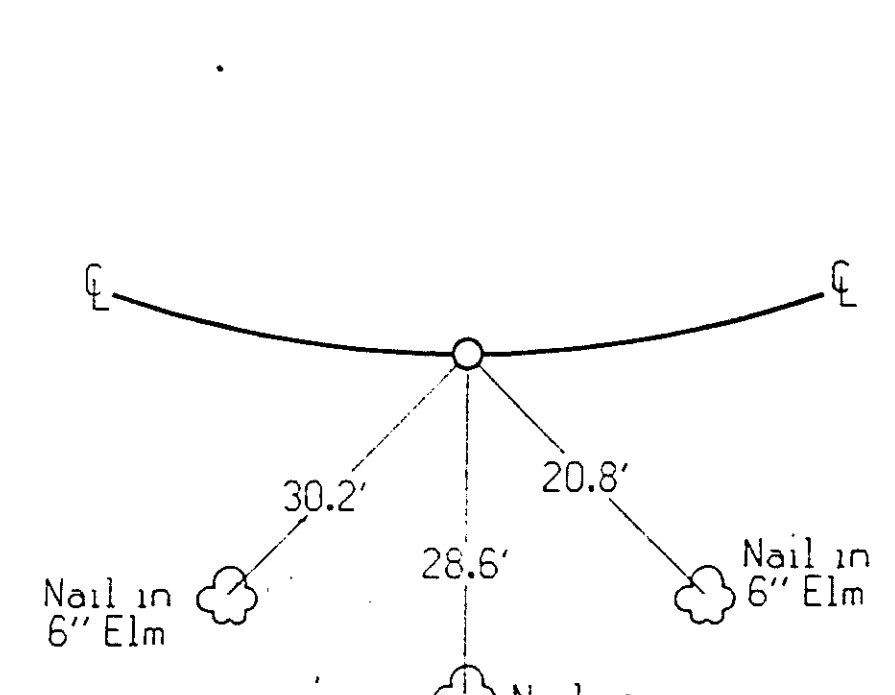


P.I. STA. 130+99.20

June - July, 1989 Survey
Set Iron Pin

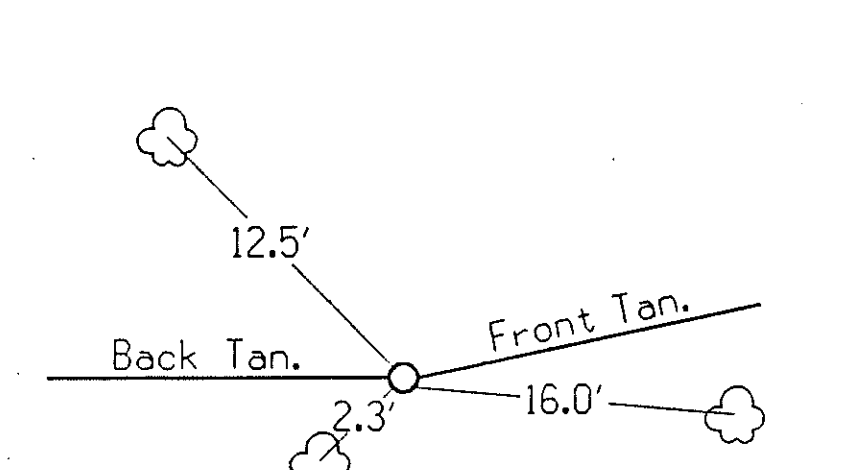



DETAILS OF REFERENCE INFORMATION


All References Plumb Distances
(unless otherwise noted)

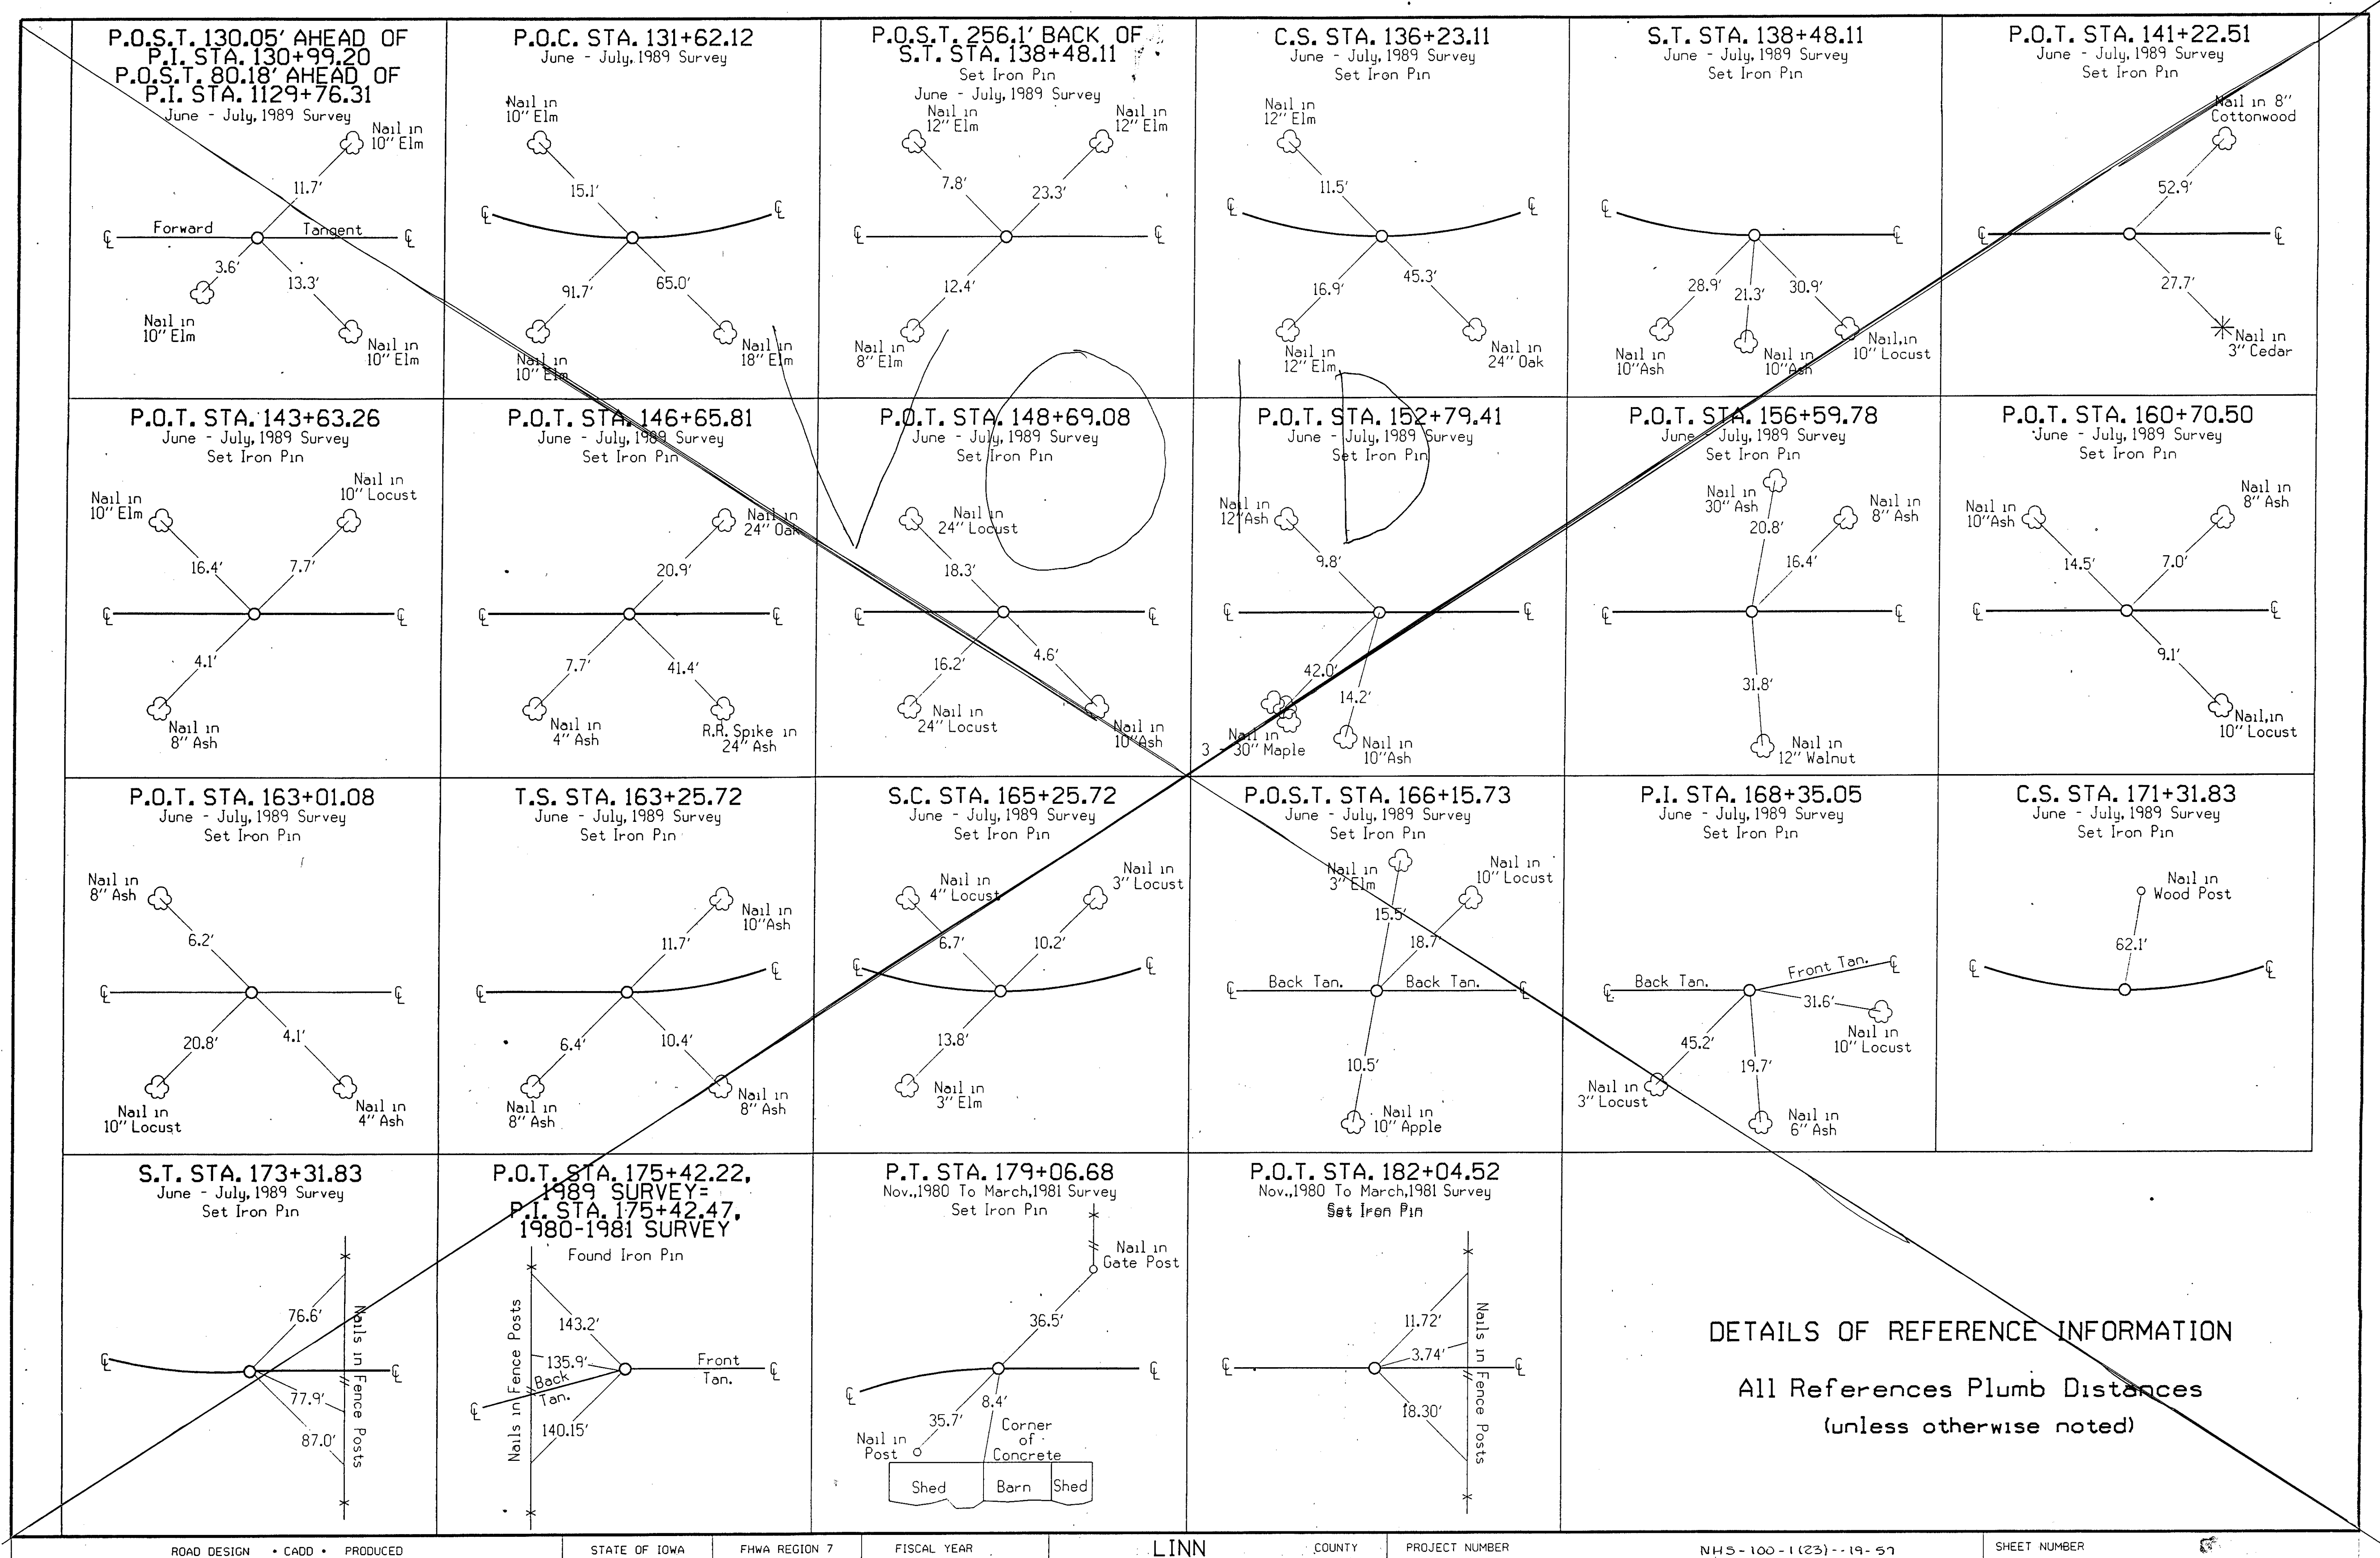



DETAILS OF REFERENCE INFORMATION
All References Plumb Distances
(unless otherwise noted)

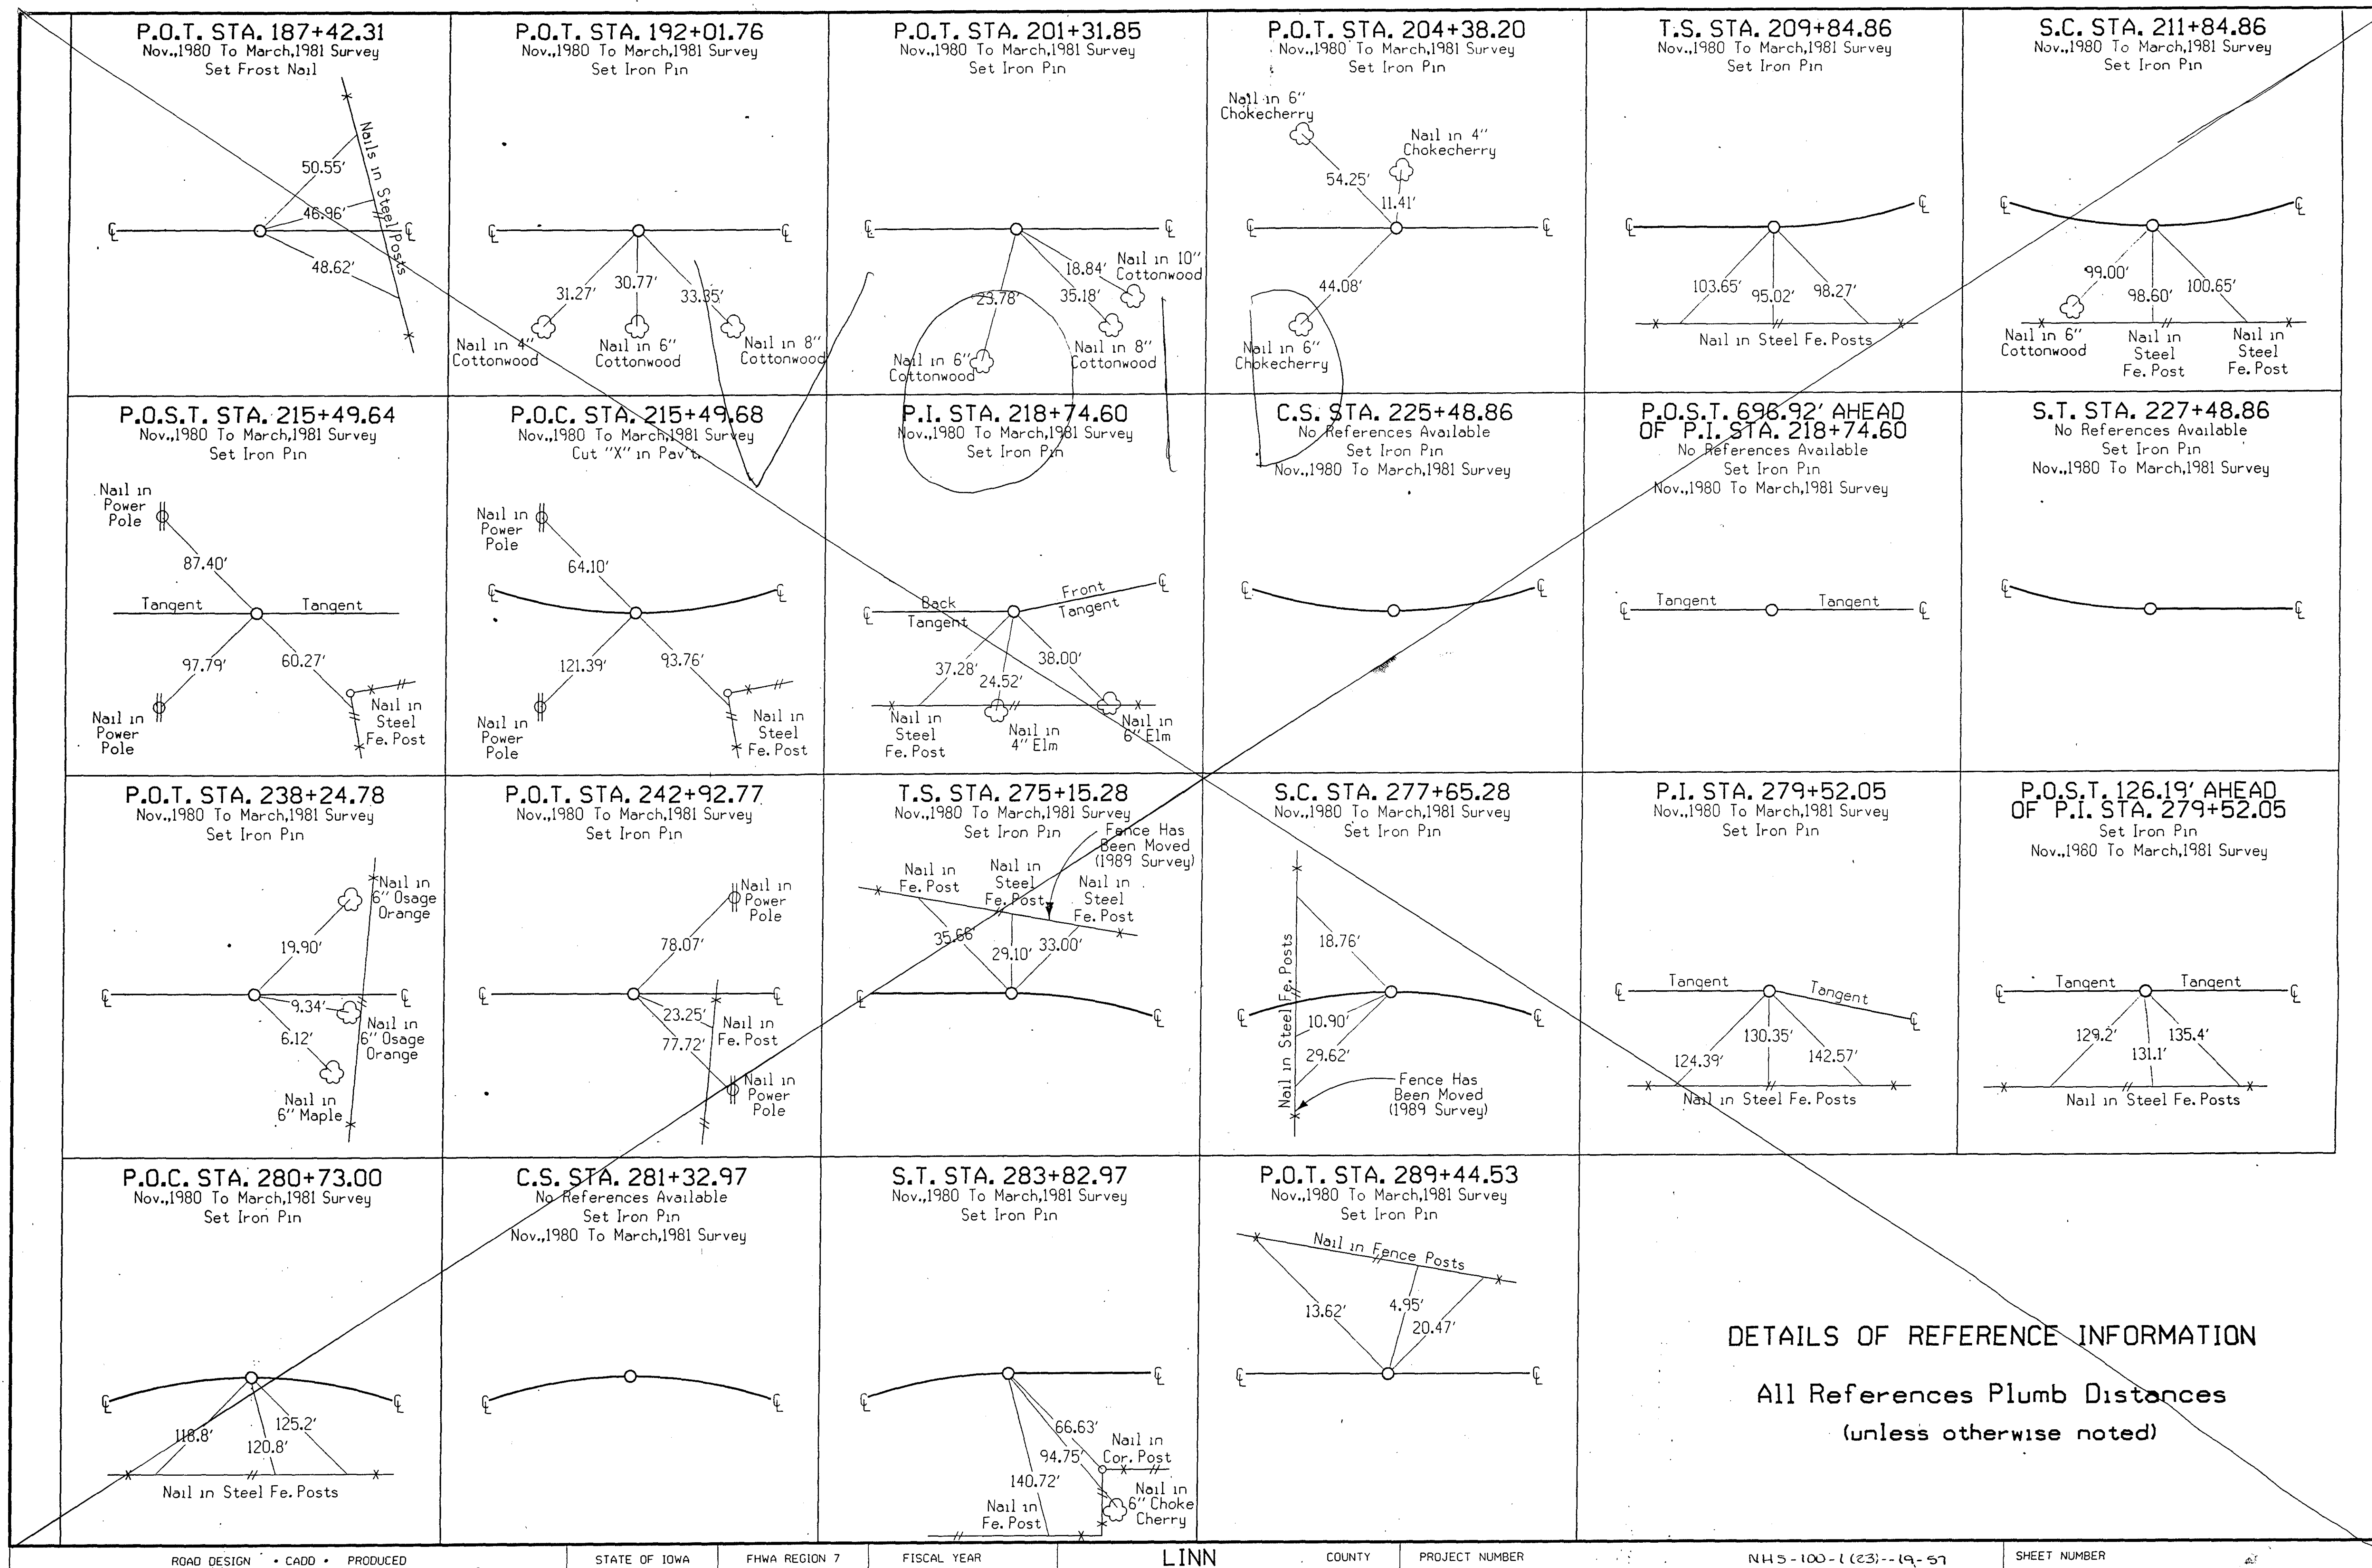


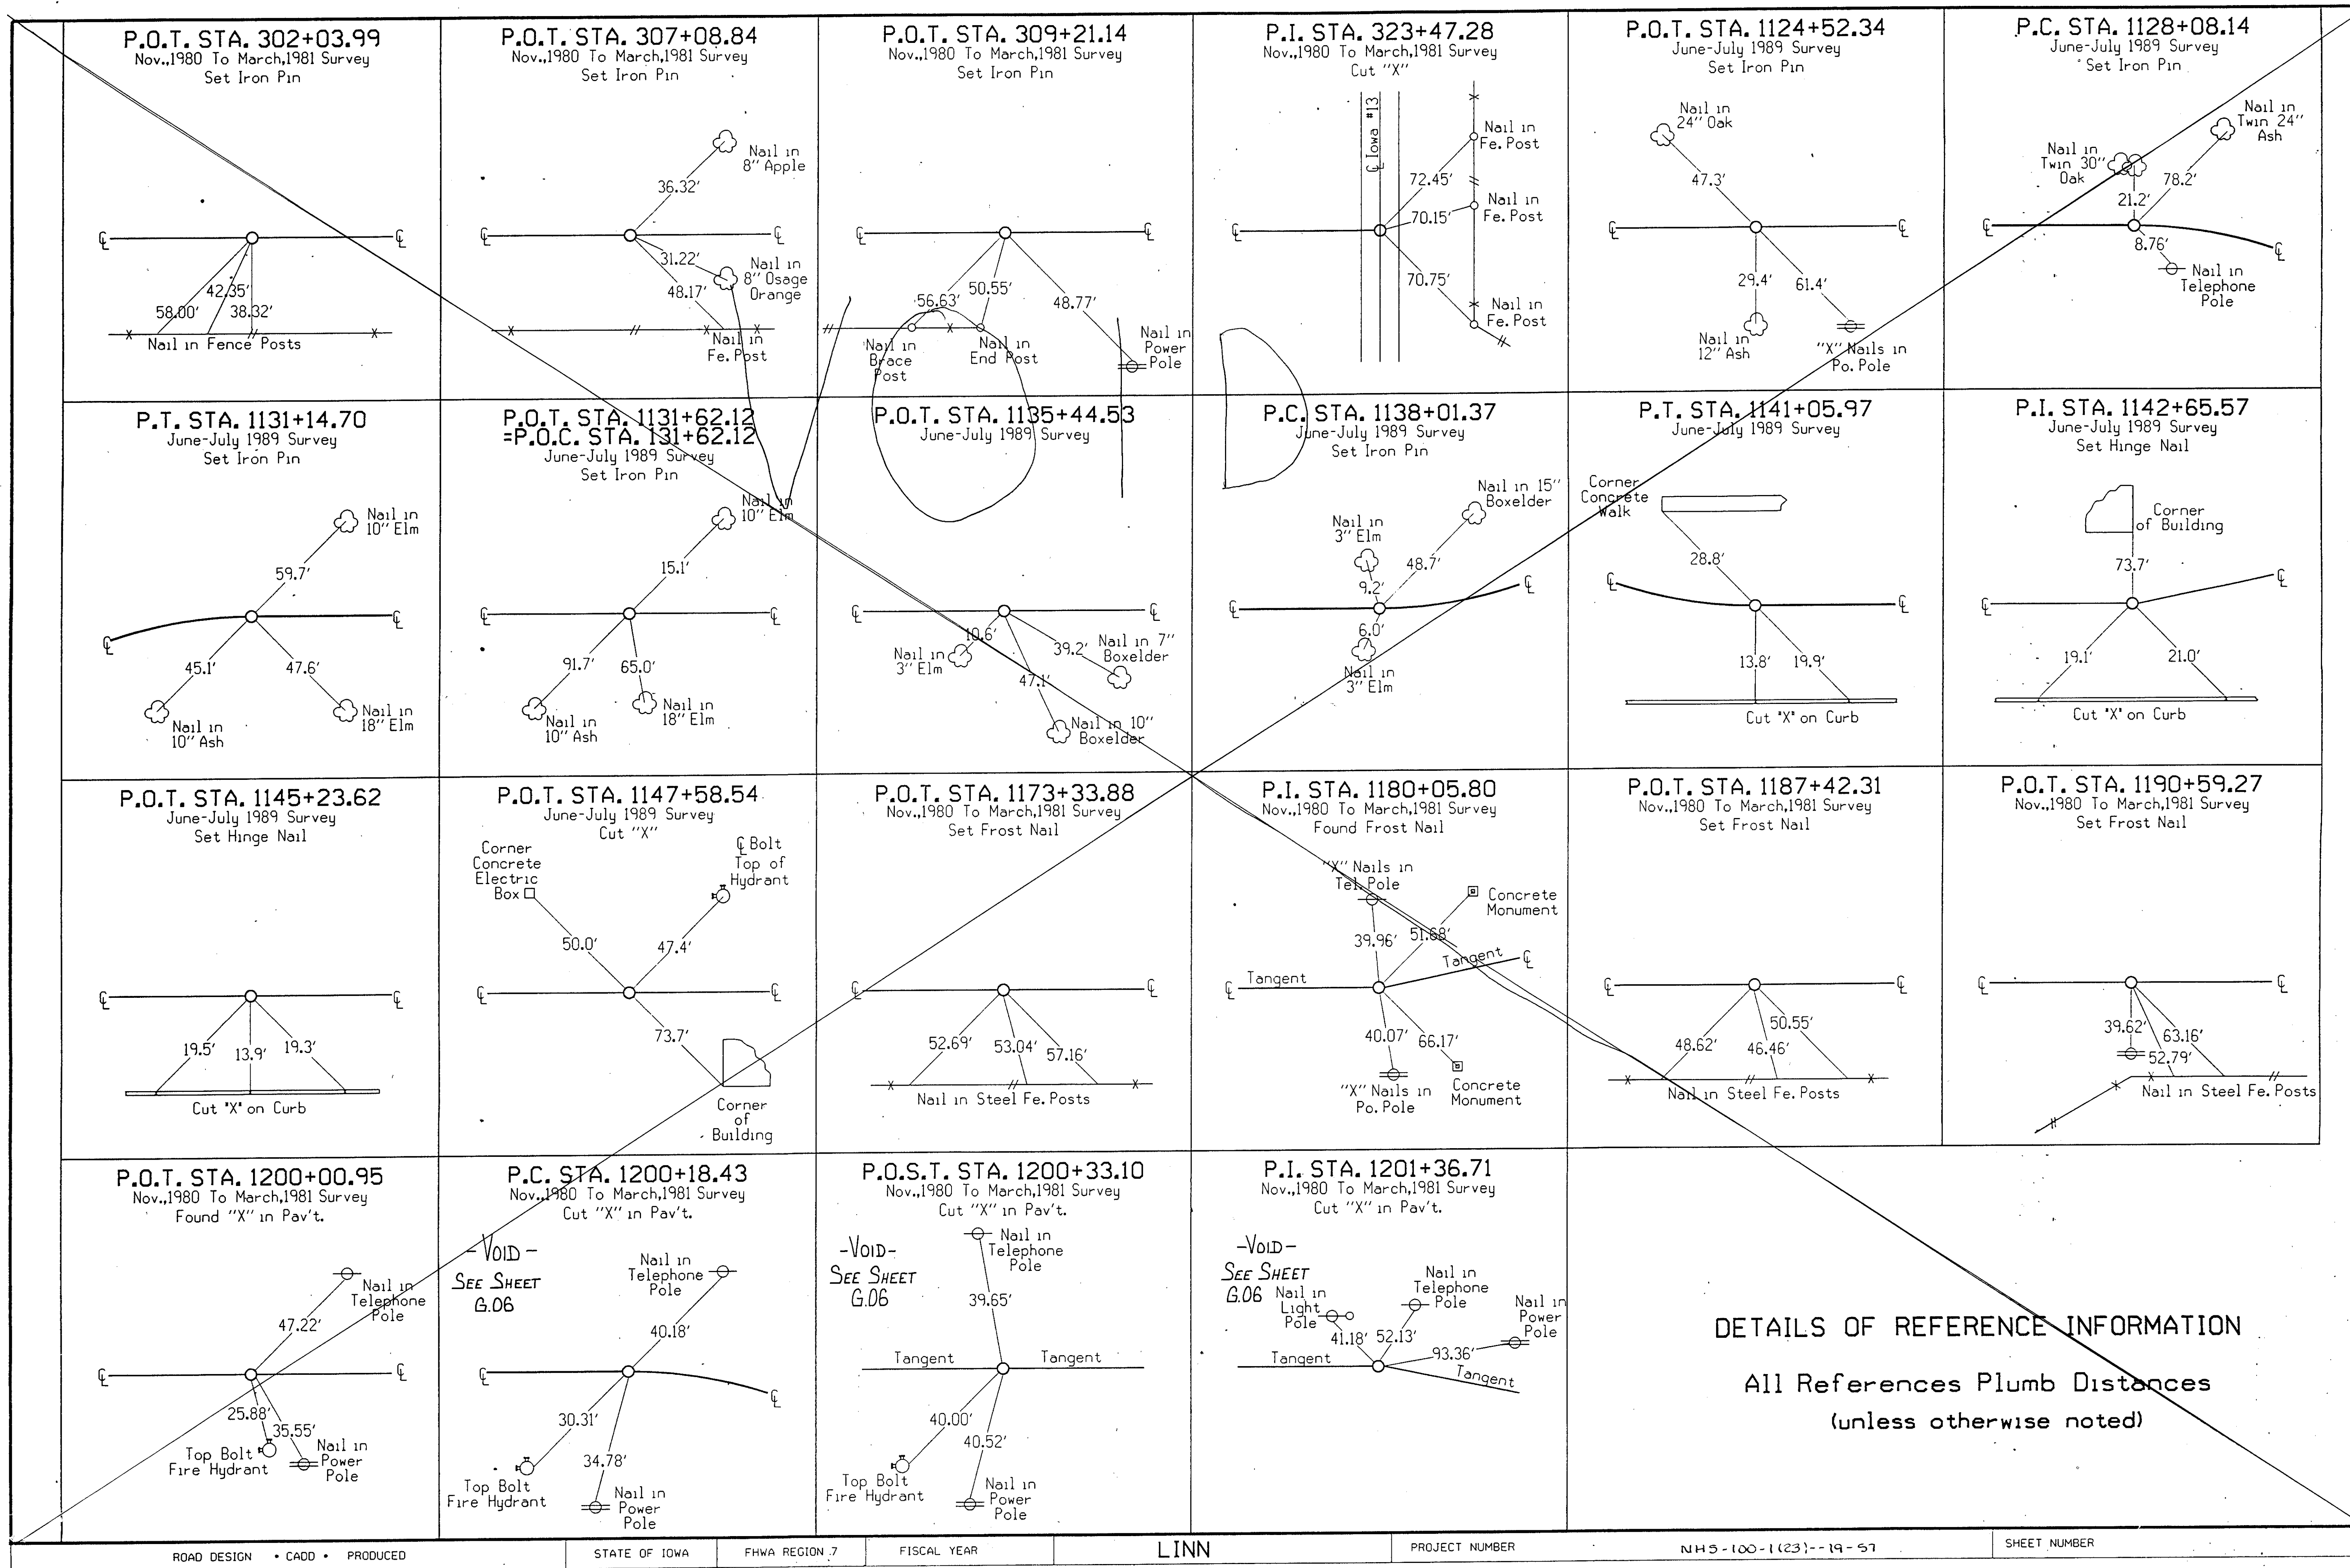


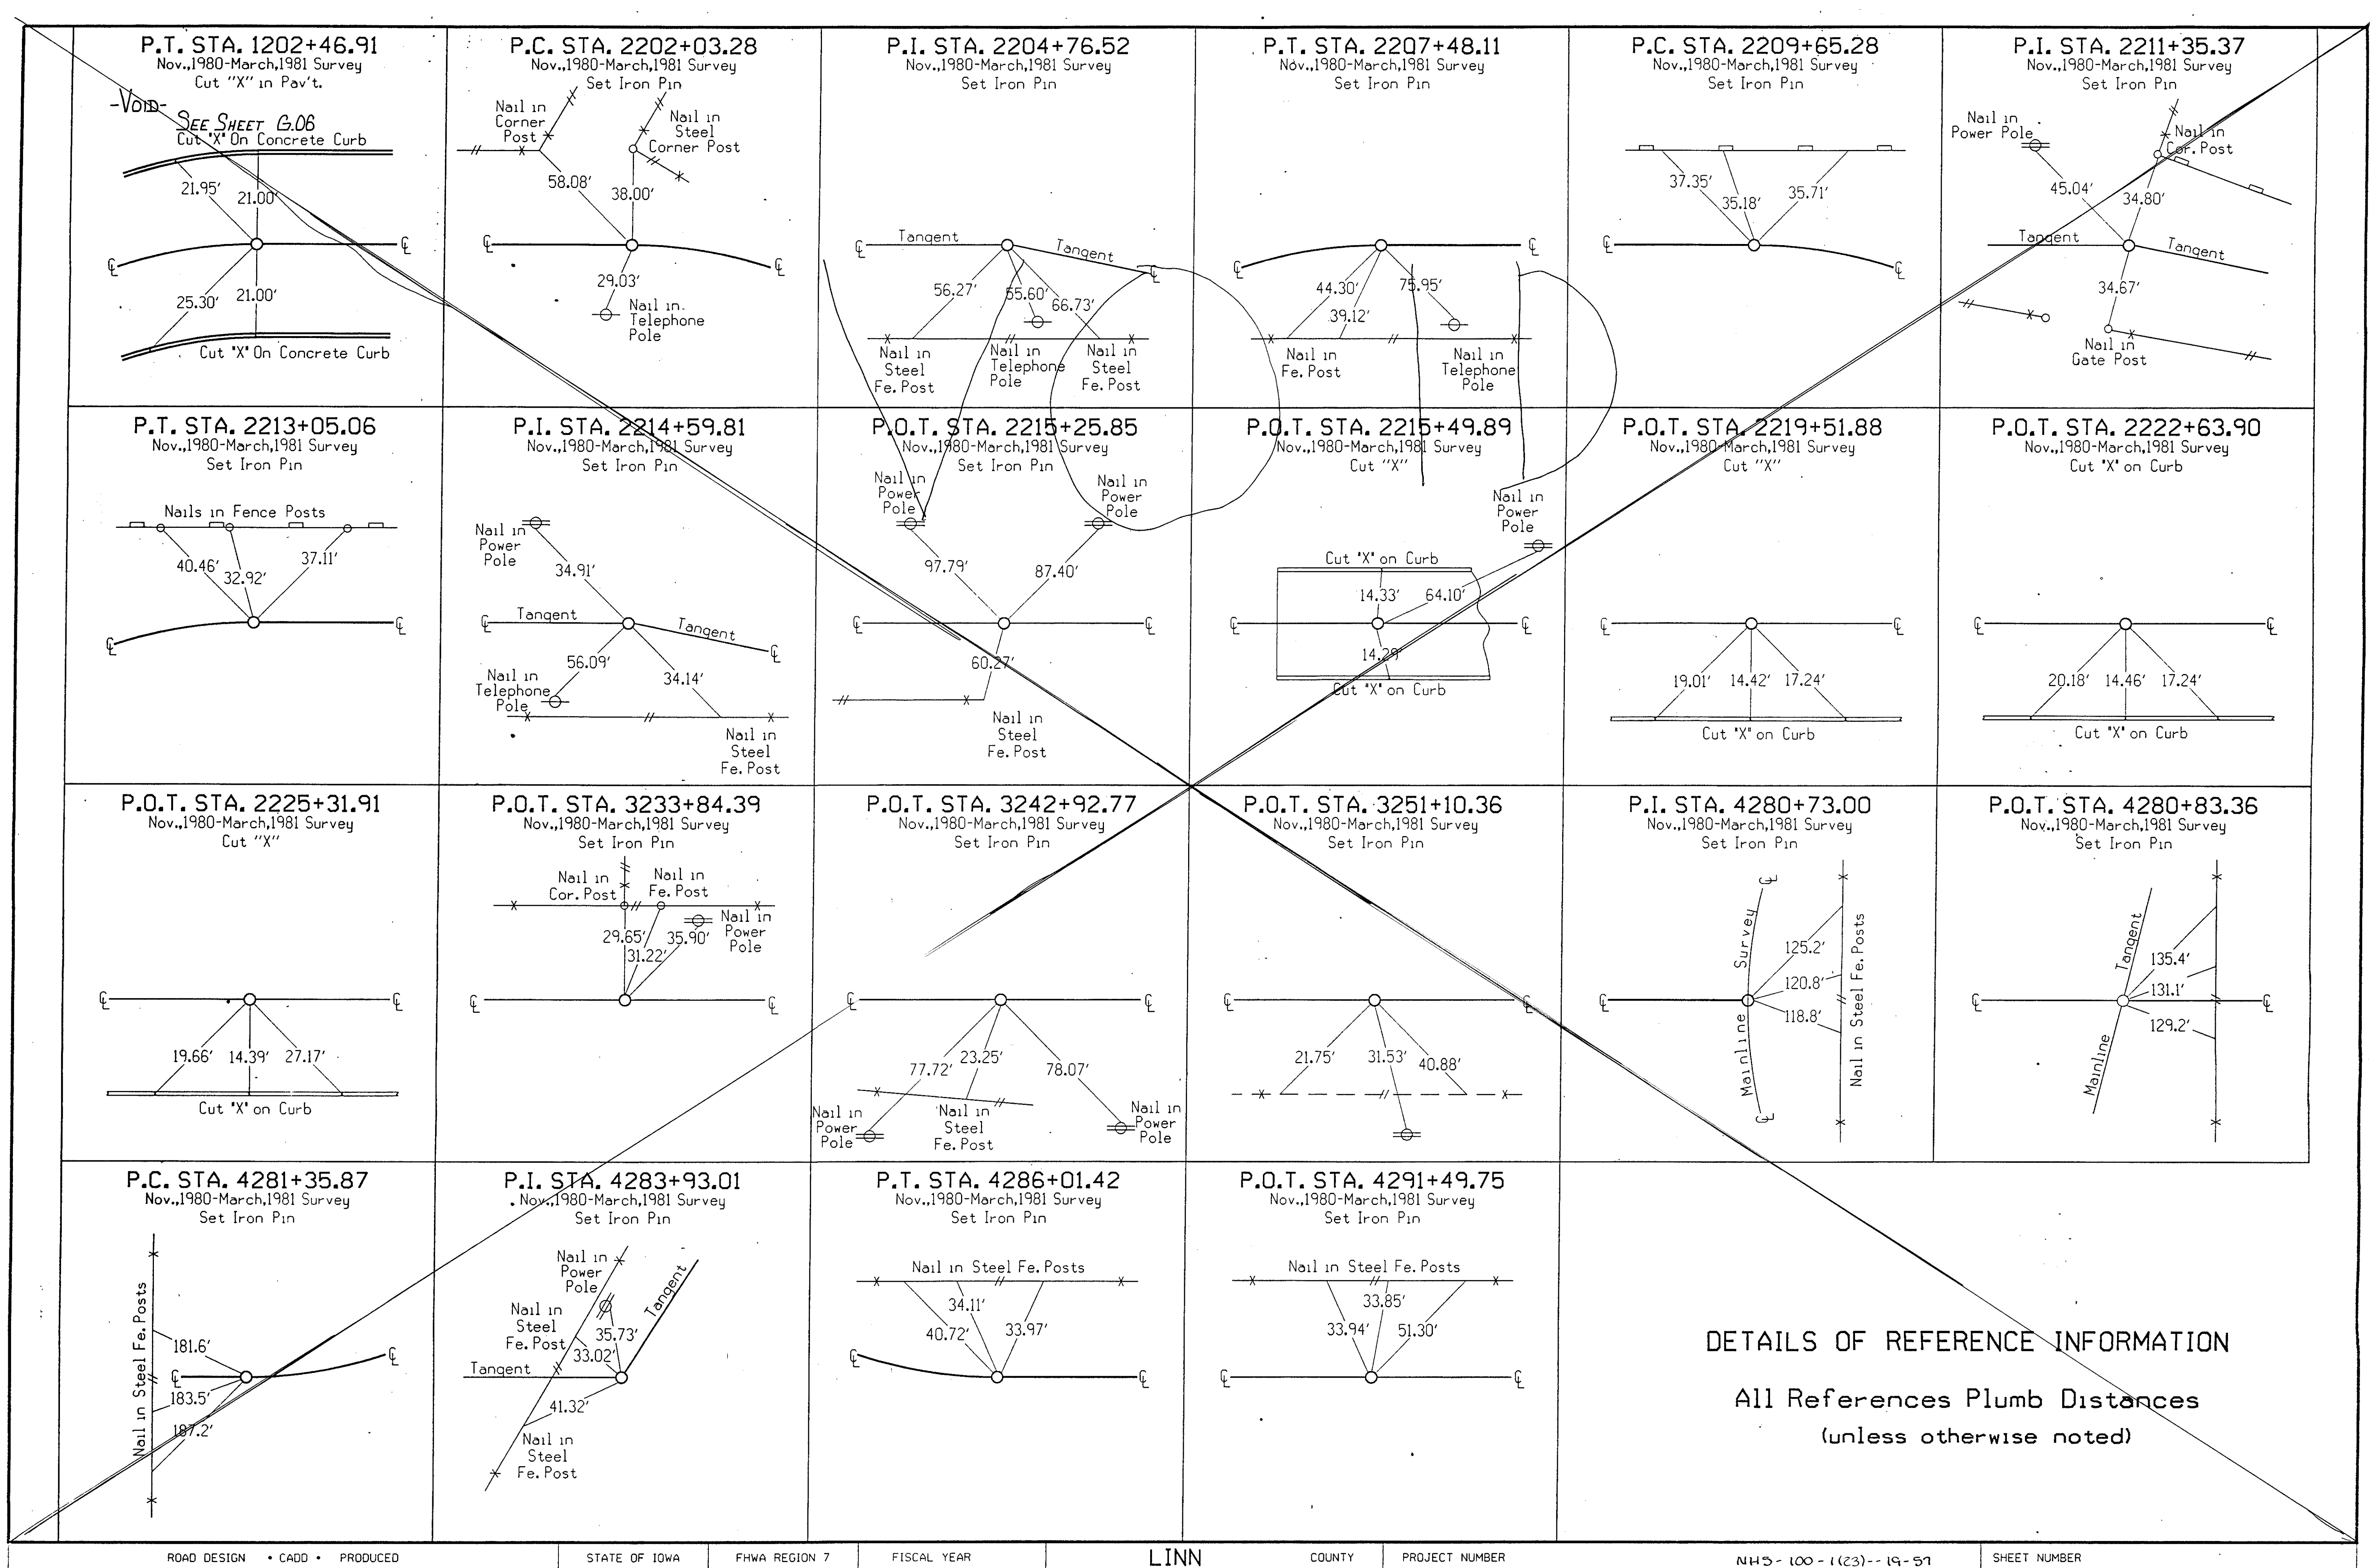


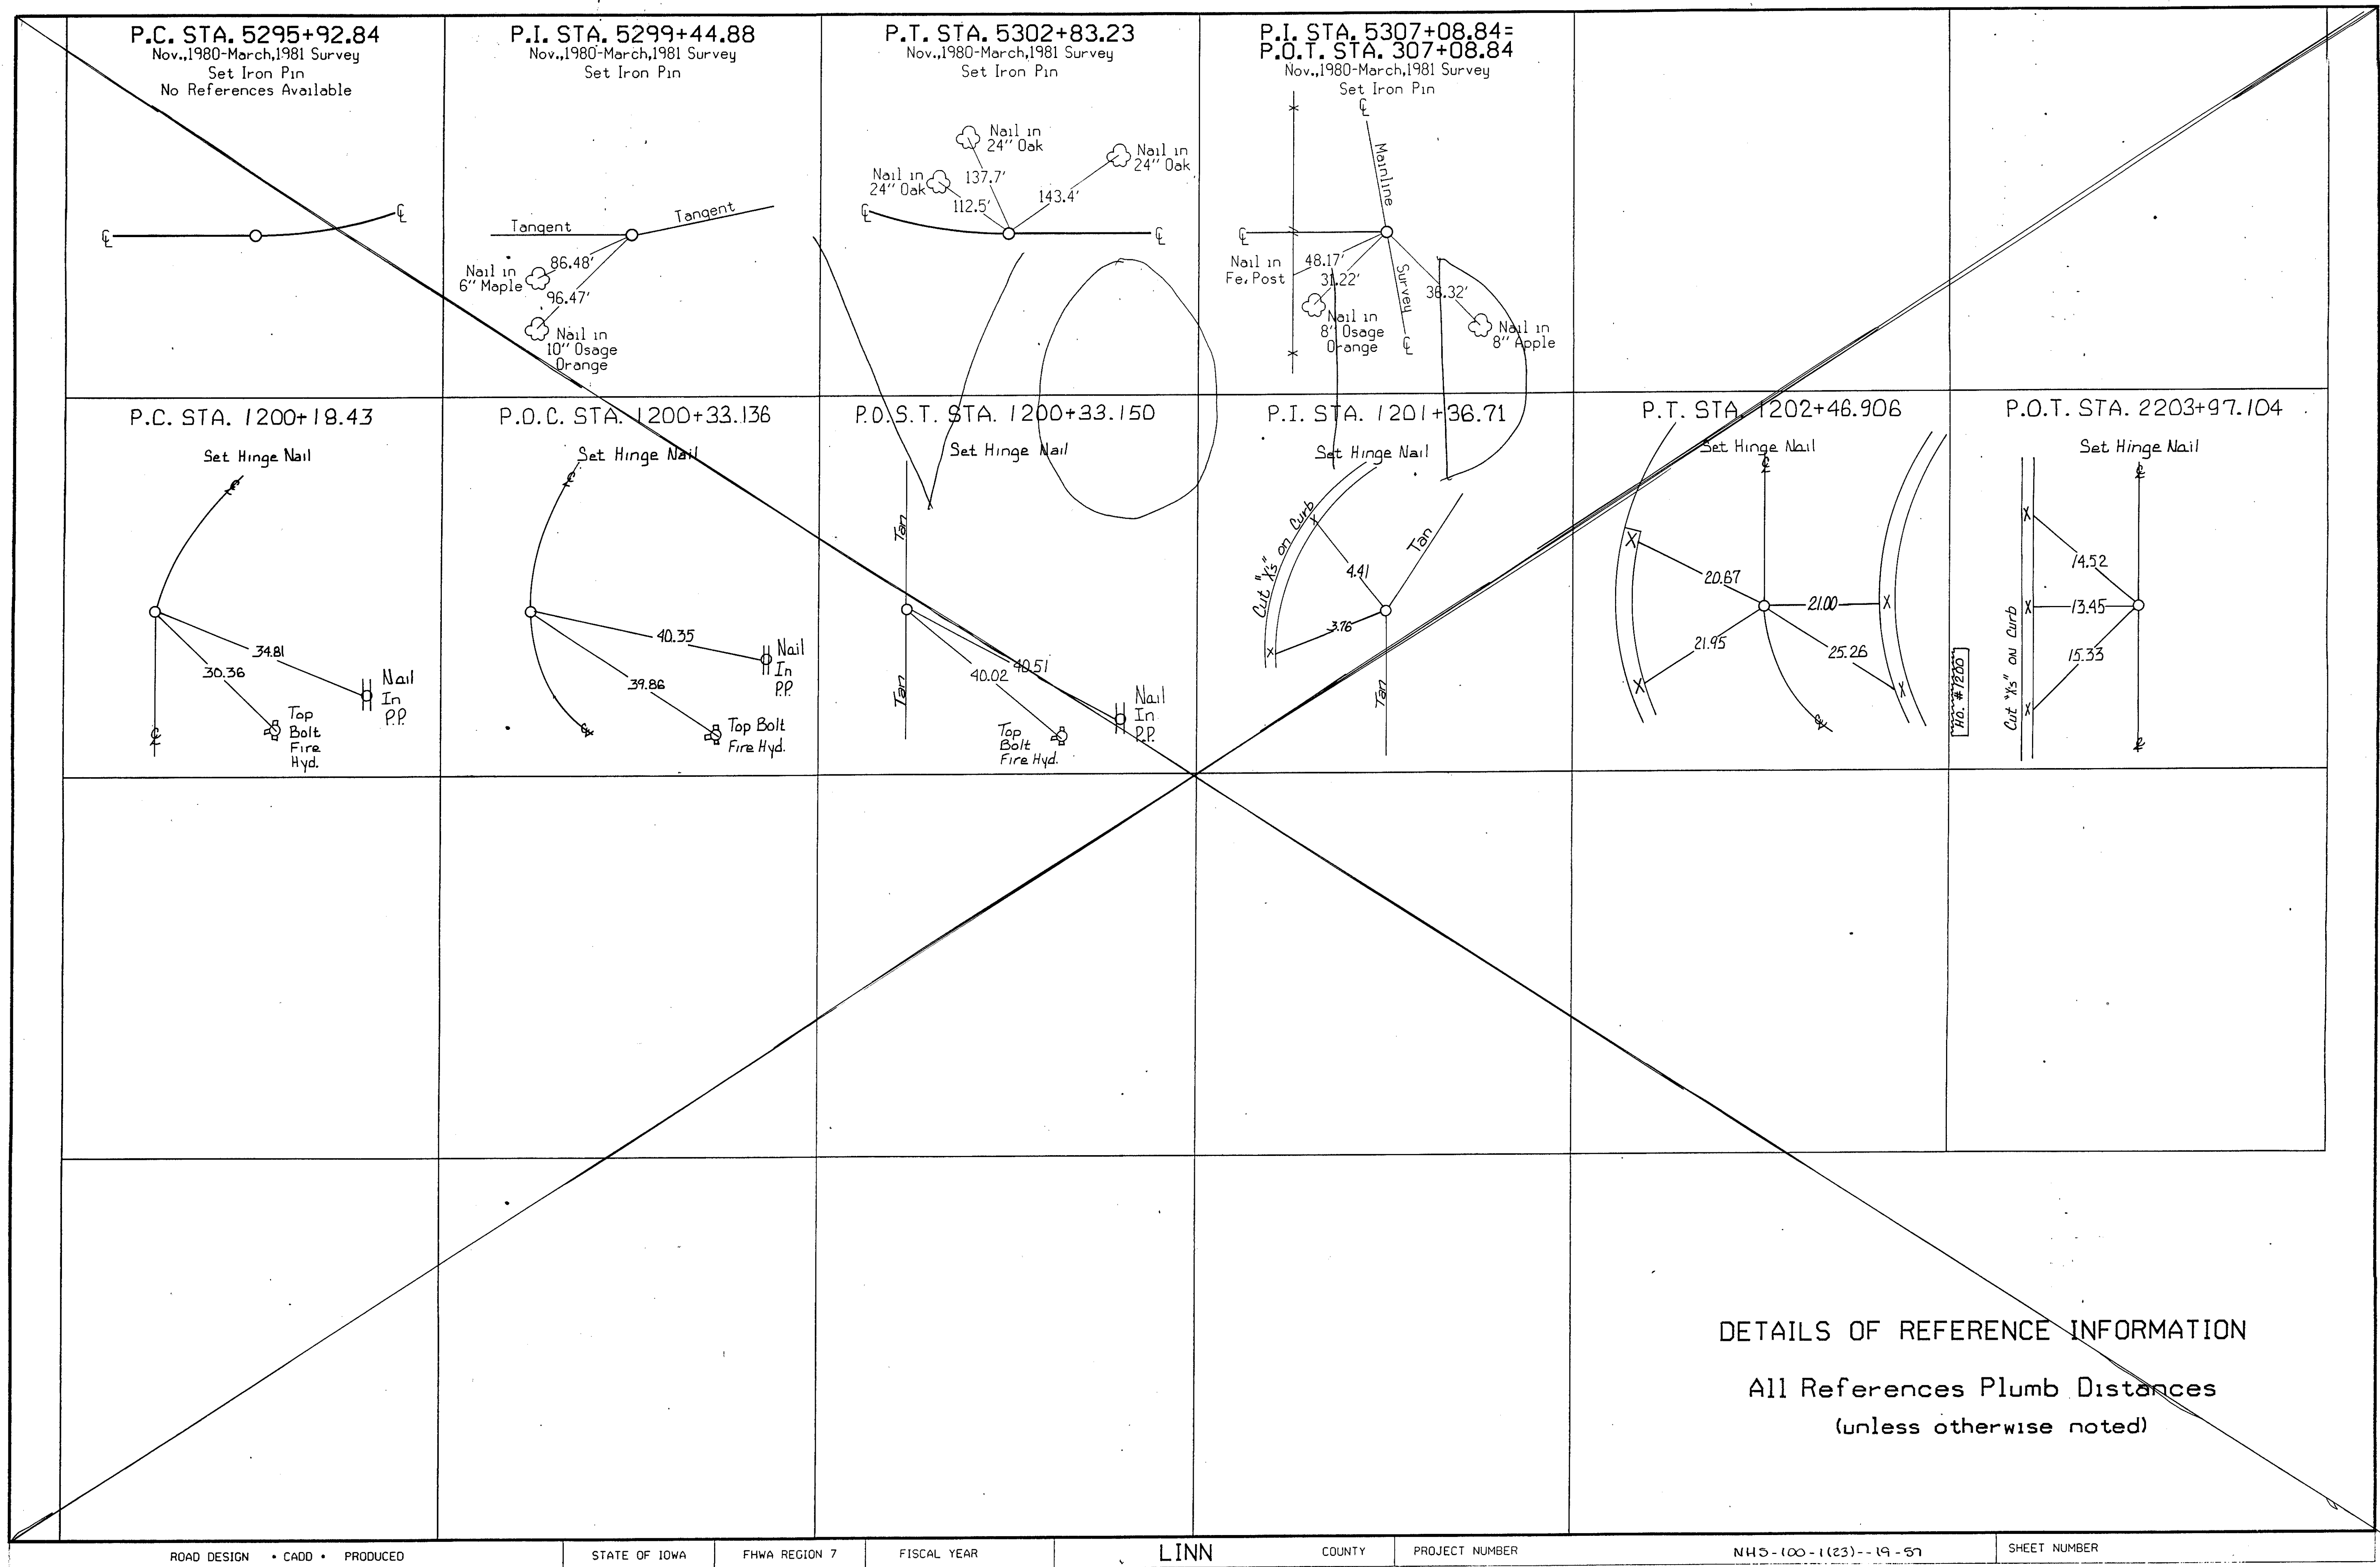


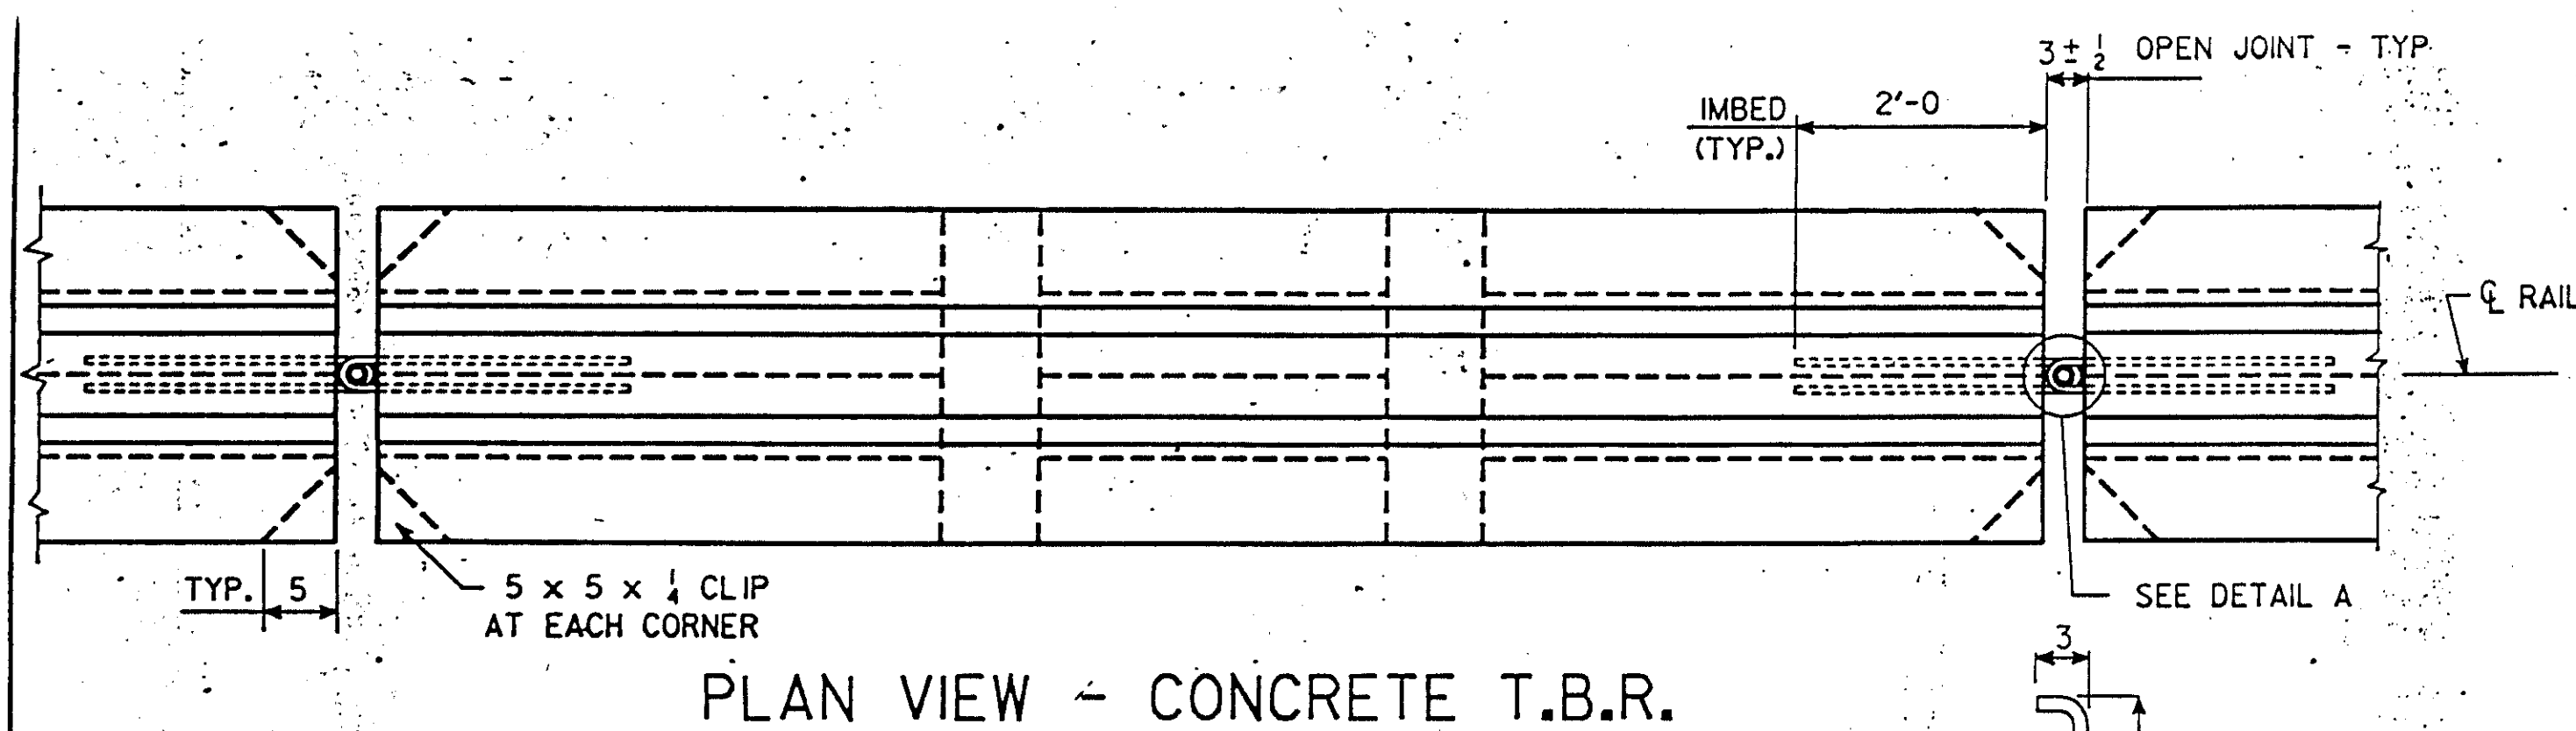




NOTE:
FOR CONCRETE TEMPORARY BARRIER RAIL, SECTION 2403
SHALL NOT APPLY. MINIMUM CONCRETE STRENGTH SHALL BE
F'C = 3000 P.S.I.

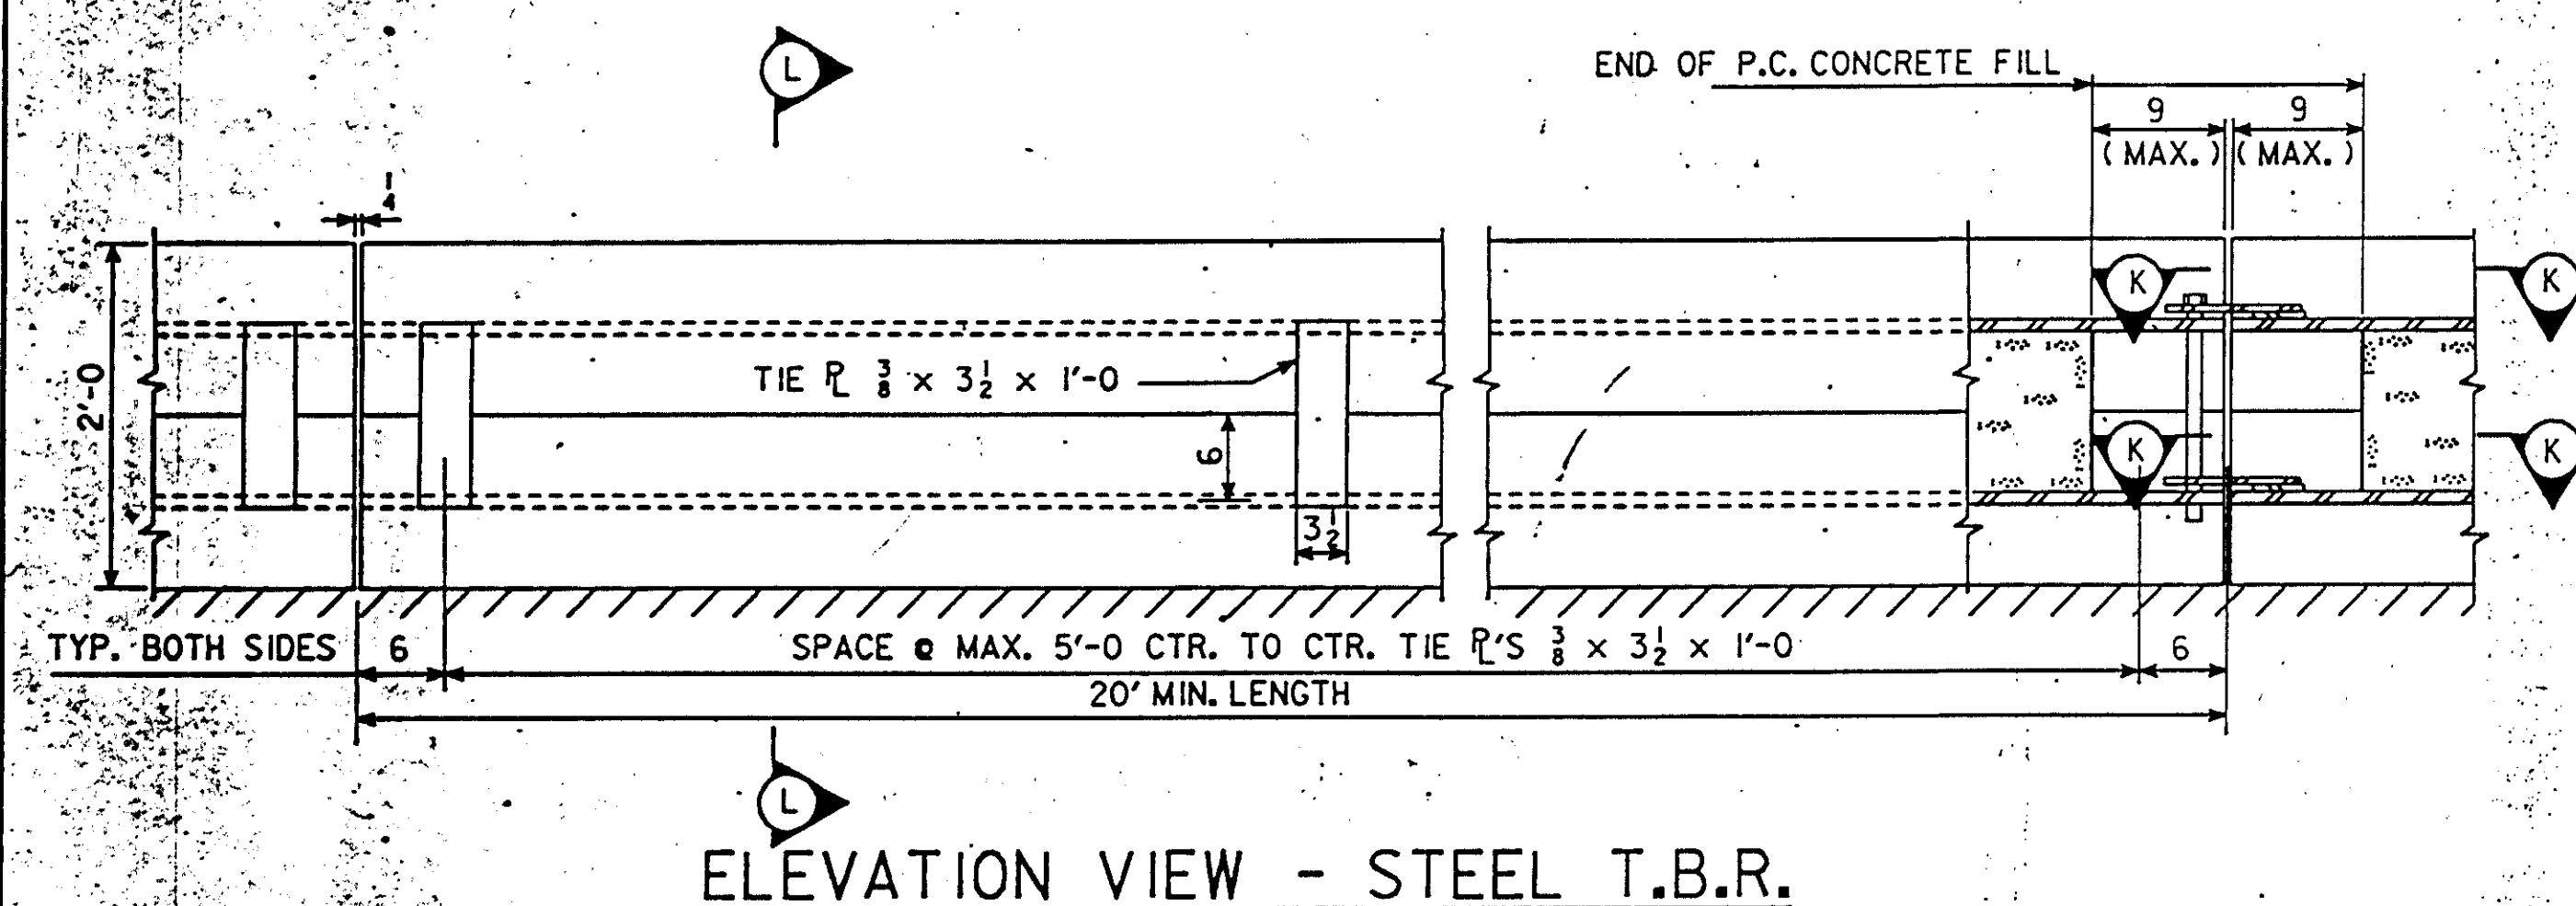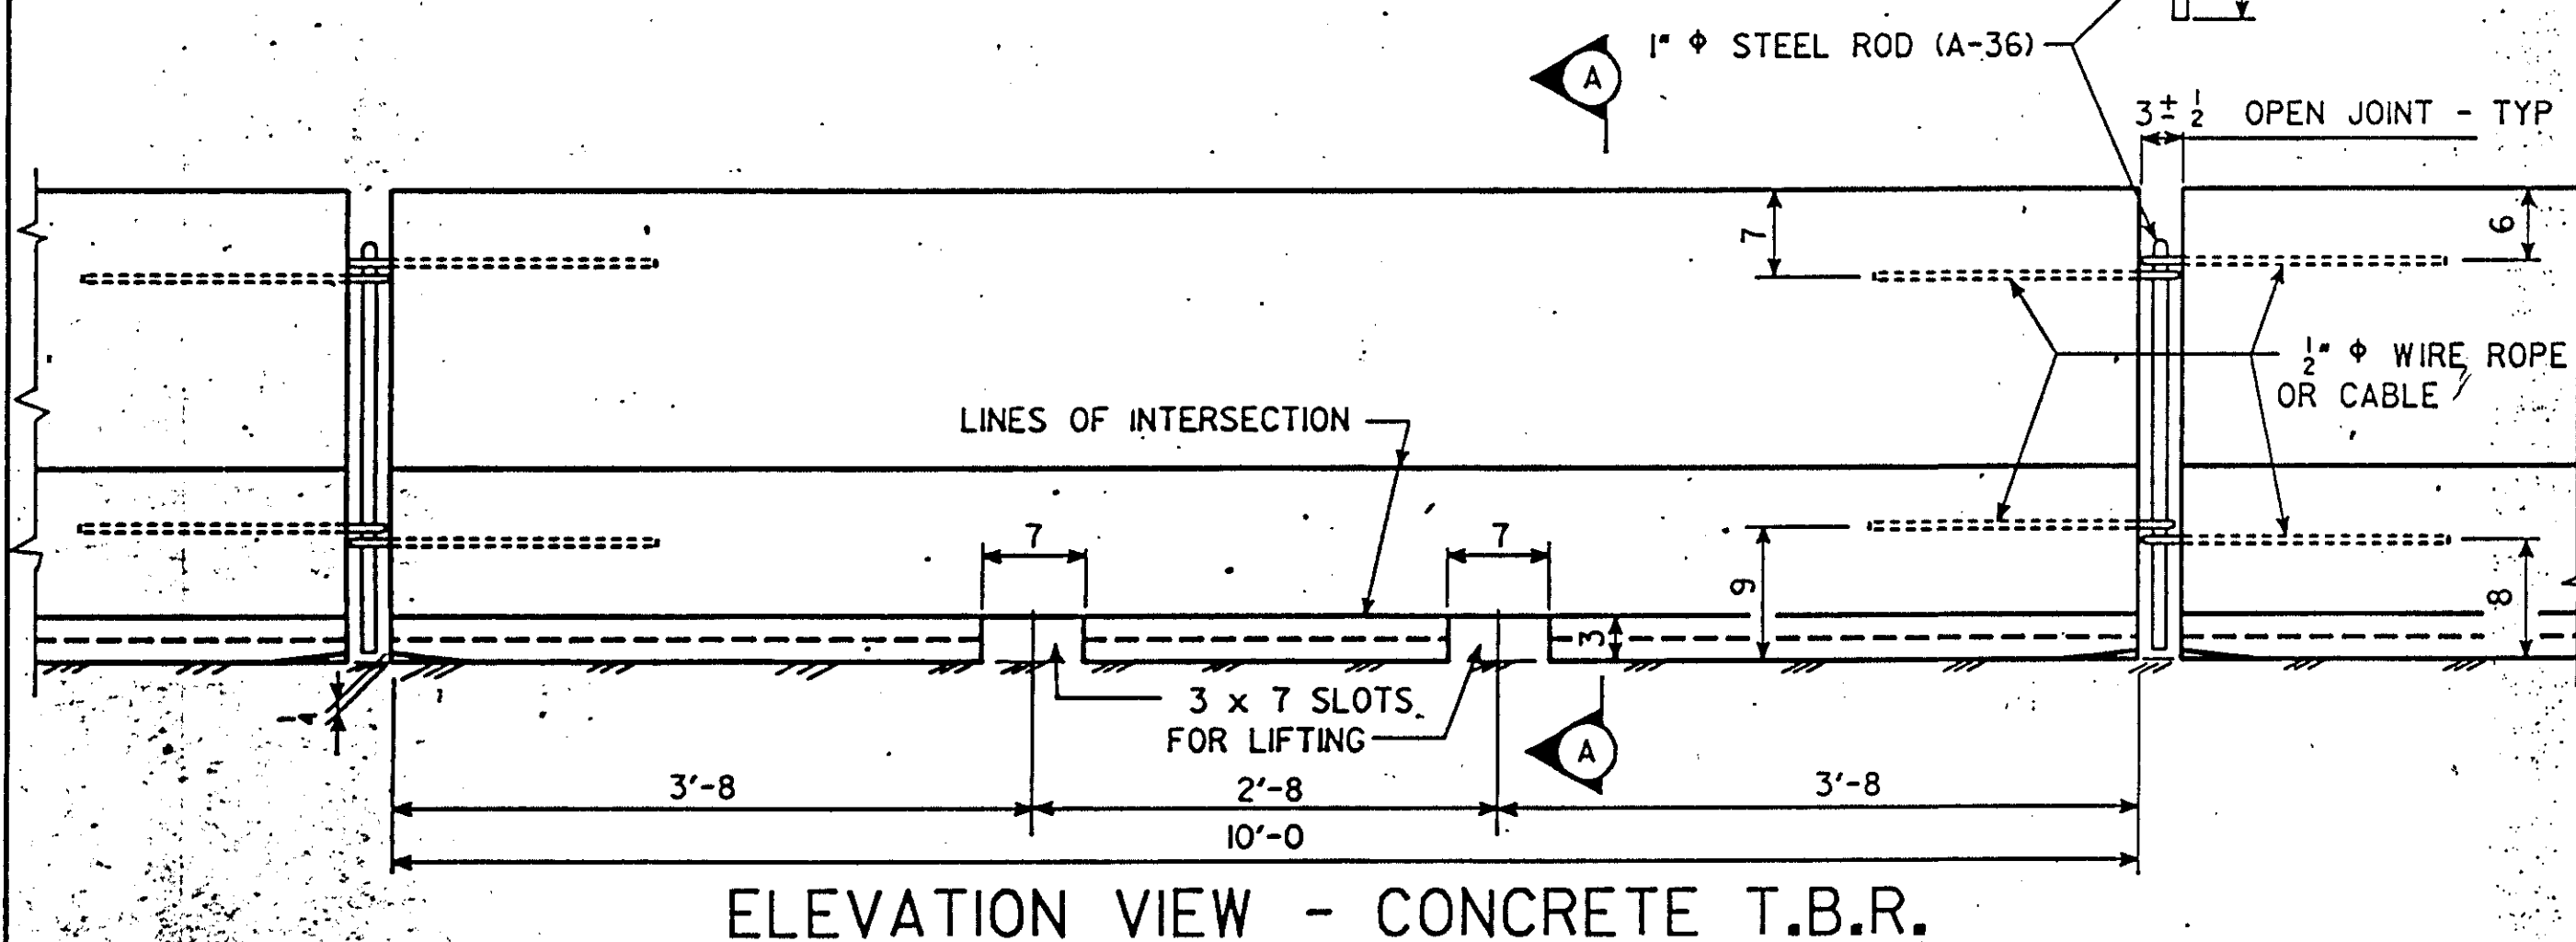

NOTE FOR STEEL TEMPORARY BARRIER RAIL:
HP12x53 SECTIONS ARE TO BE JOINED BEFORE P.C. CONCRETE FILL IS PLACED. HP SECTIONS MAY BE JOINED BY TIE PLATES AS DETAILED OR BY OTHER MEANS APPROVED BY THE ENGINEER. HP SECTIONS SHALL BE FREE FROM EXCESSIVE SWEEP AND CAMBER; STRAIGHTENING MAY BE REQUIRED BY THE ENGINEER IN ORDER TO PRODUCE A STABLE BARRIER.
CONCRETE MIX FOR THE P.C. FILL MAY BE ANY HIGHWAY DIVISION SPECIFICATION MIX OR MAY BE A COMMERCIAL READY - MIX WITH A MINIMUM F'C = 2500 P.S.I. THE FILL MAY BE DEPOSITED BY A METHOD ACCEPTABLE TO THE ENGINEER. JOINTS ARE TO BE REASONABLY MORTAR TIGHT, AND MORTAR EXTRUSIONS SHALL BE CLEANED FLUSH WITH THE OUTSIDE OF THE BARRIER. LIMITS OF FILL SHOWN ARE APPROXIMATE AND MAY BE ROUGH OR SLUMPED DEPENDING ON THE METHOD OF BULK HEADING.
CARE SHALL BE TAKEN IN MOVING THE BARRIER FOR STAGE 2 CONSTRUCTION SO THAT THE NEW CONCRETE OF STAGE 1 WILL NOT BE DAMAGED. ANY DAMAGE SHALL BE REPAIRED AT THE CONTRACTOR'S EXPENSE.
SEE STANDARD SHEET 1 OF 2 FOR ADDITIONAL NOTES.

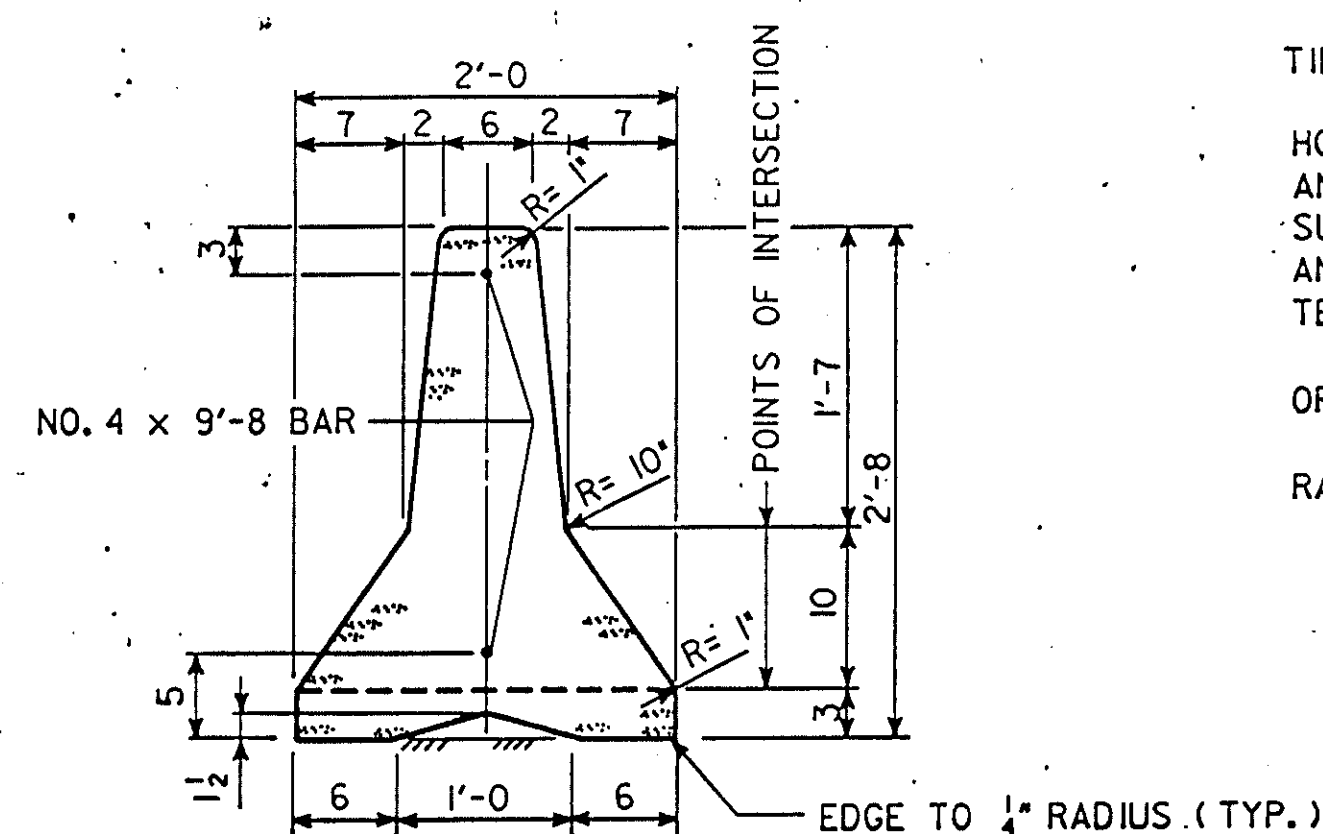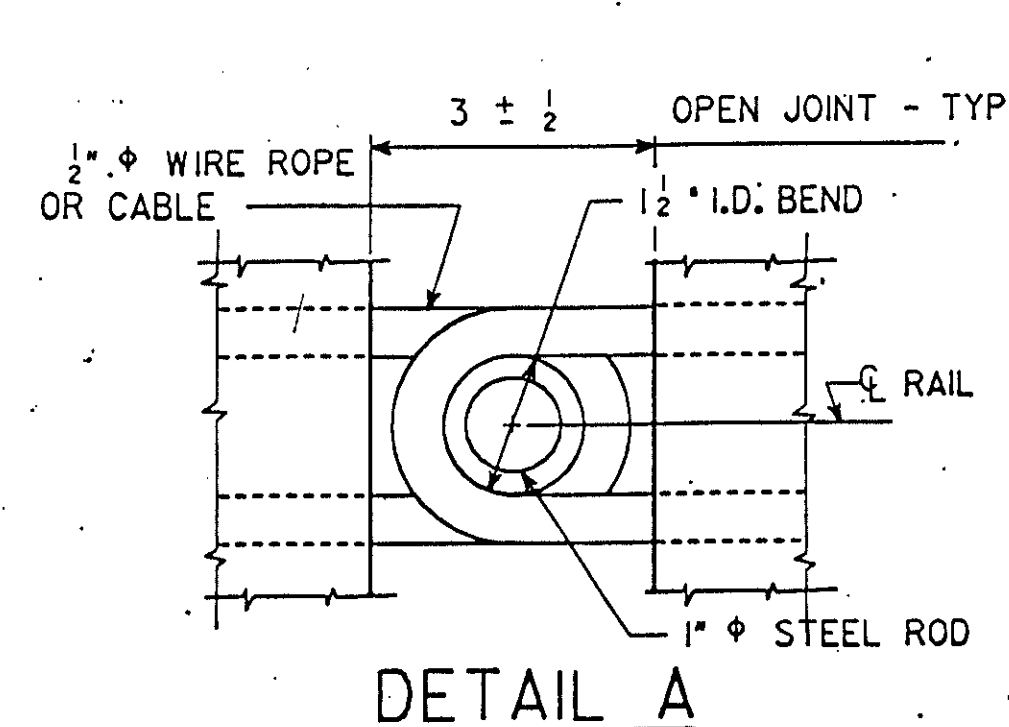

CONTRACTOR MAY ADD EXTRA REINFORCING BARS TO INCREASE THE SERVICE LIFE OF THE CONCRETE RAIL SECTIONS.

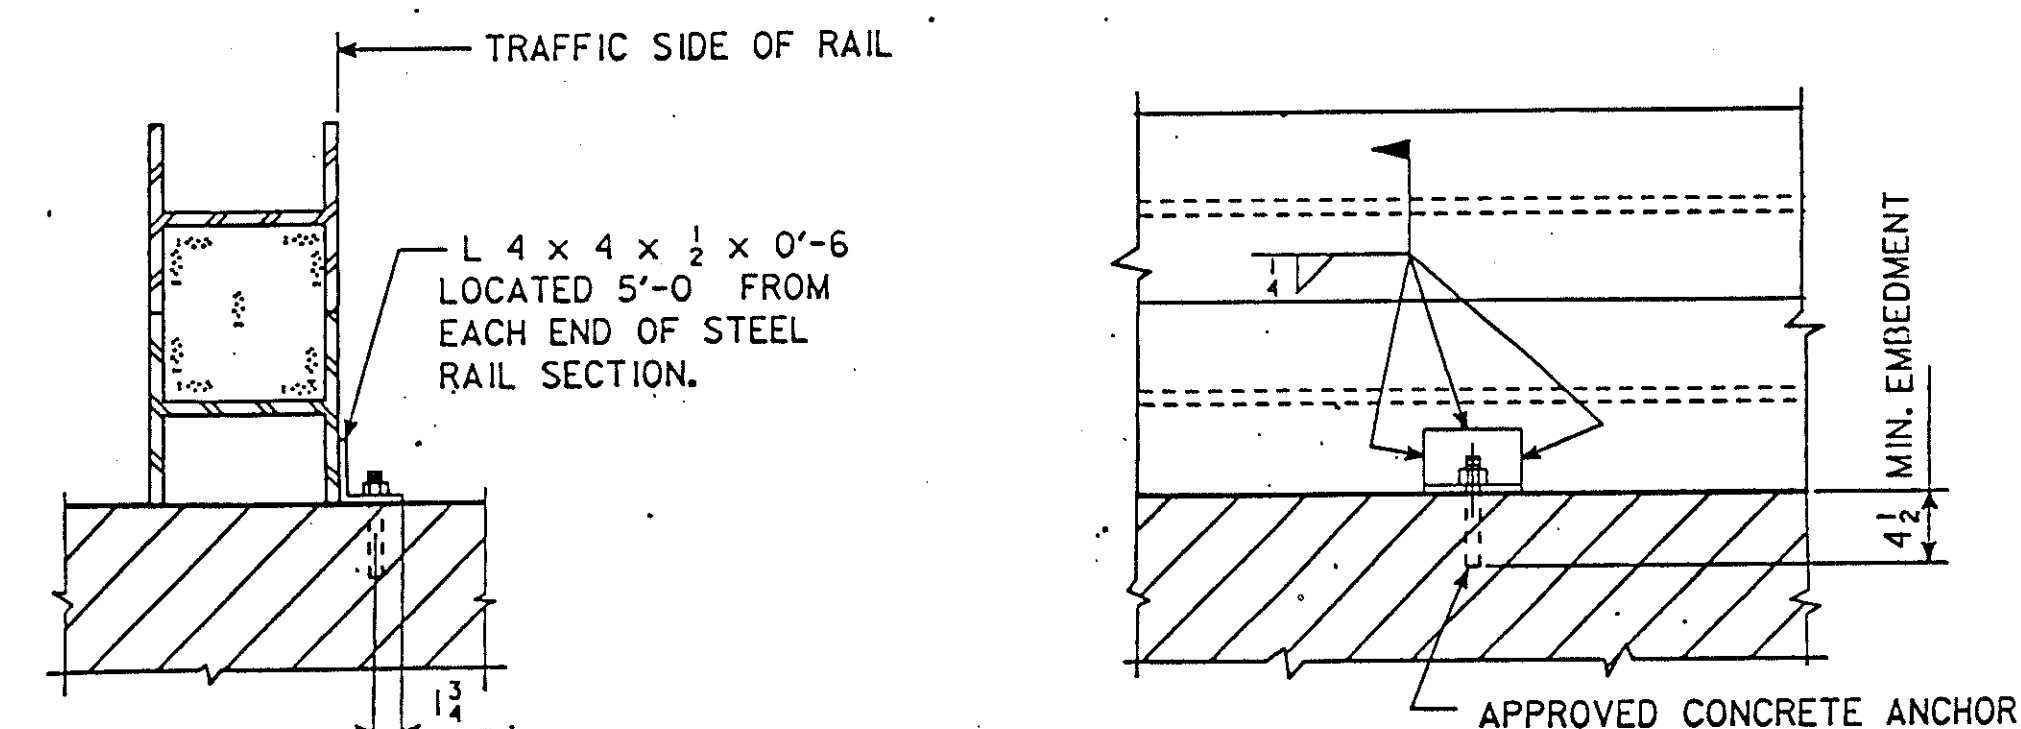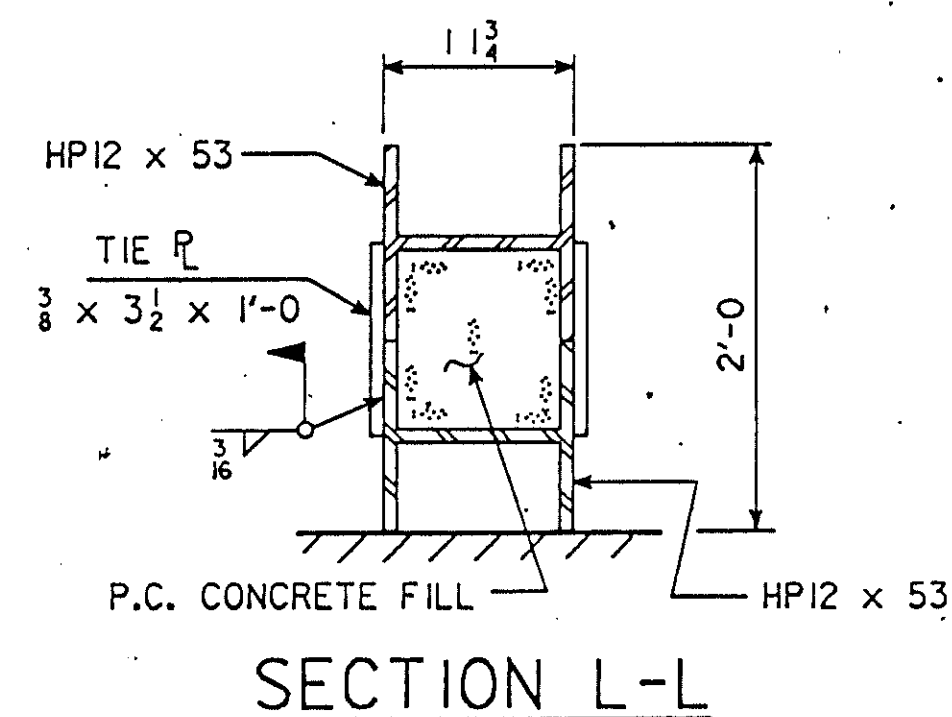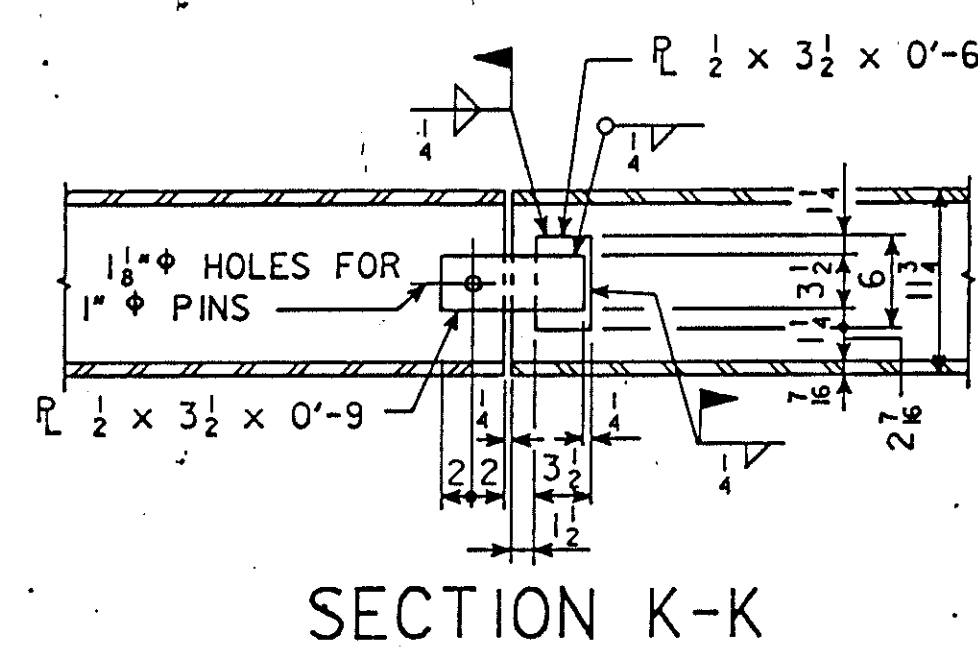

TIE DOWN NOTES:
TIE-DOWNS ARE REQUIRED ONLY WHERE THE TEMPORARY BARRIER RAIL IS ADJACENT TO A DROP-OFF. HOLES FOR CONCRETE ANCHORS MAY BE DRILLED AFTER POSITIONING TEMPORARY BARRIER RAIL. CONCRETE ANCHORS ARE TO BE SET SO THAT THE ANCHORS CAN BE REMOVED AT LEAST 12" BELOW THE CONCRETE SURFACE AND THE REMAINING HOLE FILLED WITH A NEAT MIXTURE OF SAND-CEMENT GROUT. CONCRETE ANCHORS ARE TO BE REMOVED, WITHOUT DAMAGING THE SURROUNDING CONCRETE, ONLY AFTER THE TEMPORARY BARRIER RAIL IS NO LONGER NEEDED AT THE PARTICULAR LOCATION.
CONCRETE ANCHORS ARE TO BE A MINIMUM OF 3" ϕ AND AS OTHERWISE SPECIFIED IN CURRENT OFFICE OF MATERIALS I.M. 453.09 WITH A PULL-OUT STRENGTH OF 6,000 LBS. BASED ON 4,000 P.S.I. CONCRETE.
ALL COSTS FOR TIE DOWNS SHALL BE INCLUDED IN THE PRICE BID FOR "TEMPORARY BARRIER RAIL, PLACE ONLY".


QUANTITIES	
ITEM	AMOUNT
TEMPORARY BARRIER RAIL, FURNISH ONLY	430 L.F.
TEMPORARY BARRIER RAIL, PLACE ONLY	690 L.F.

ITEM REFERENCE:
TEMPORARY BARRIER RAIL SHALL BE A COMBINATION
OF NOMINAL 20 ' LONG STEEL UNITS AND NOMINAL 10' LONG
CONCRETE UNITS. REFER TO LAYOUT FOR NUMBER OF EACH.

TEMPORARY BARRIER RAIL - COMBINATION

IOWA DEPARTMENT OF TRANSPORTATION - HIGHWAY DIVISION
DESIGN SHEET NO. ____ OF ____ FILE NO. _____ DESIGN NO. ____

DESIGNED BY _____	TRACED BY _____	TEMPORARY BARRIER RAIL - COMBINATION WITH TIE DOWNS (2 OF 2)	STANDARD 1034A	LINN COUNTY	PROJECT NUMBER	STATE	FHWA REGION	FISCAL YEAR	SHEET NO.	TOTAL SHEETS
DETAILS BY _____	CHECKED BY _____				1115-100-1(23)--(9-57)	IOWA	7			

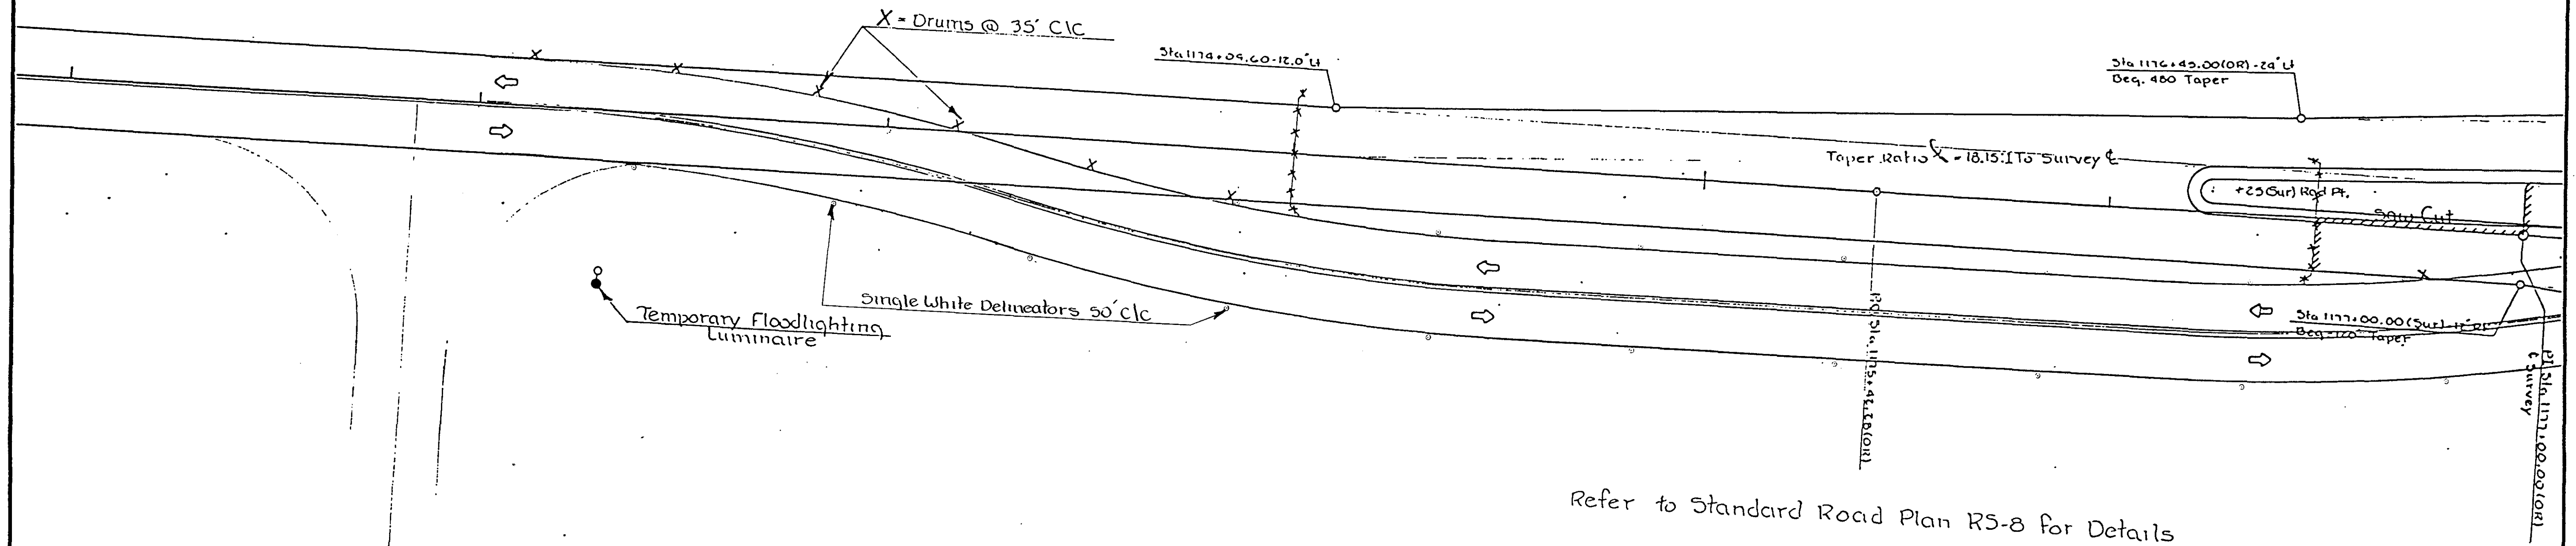

Traffic Control Layout
East Post Road
Sheet 1
1" = 20'

OFFICE OF DESIGN • CADD • PRODUCED

STATE OF IOWA

FHWA REGION 7

FISCAL YEAR

LINN

COUNTY

PROJECT NUMBER

NHS-100-1(23)--19-57


SHEET NUMBER

J.02

$$1'' = 20'$$


P. 62


S7070332.m(3121.road1a) 1b@road1a. Fri Nov 18 07:24:43 CST 1994

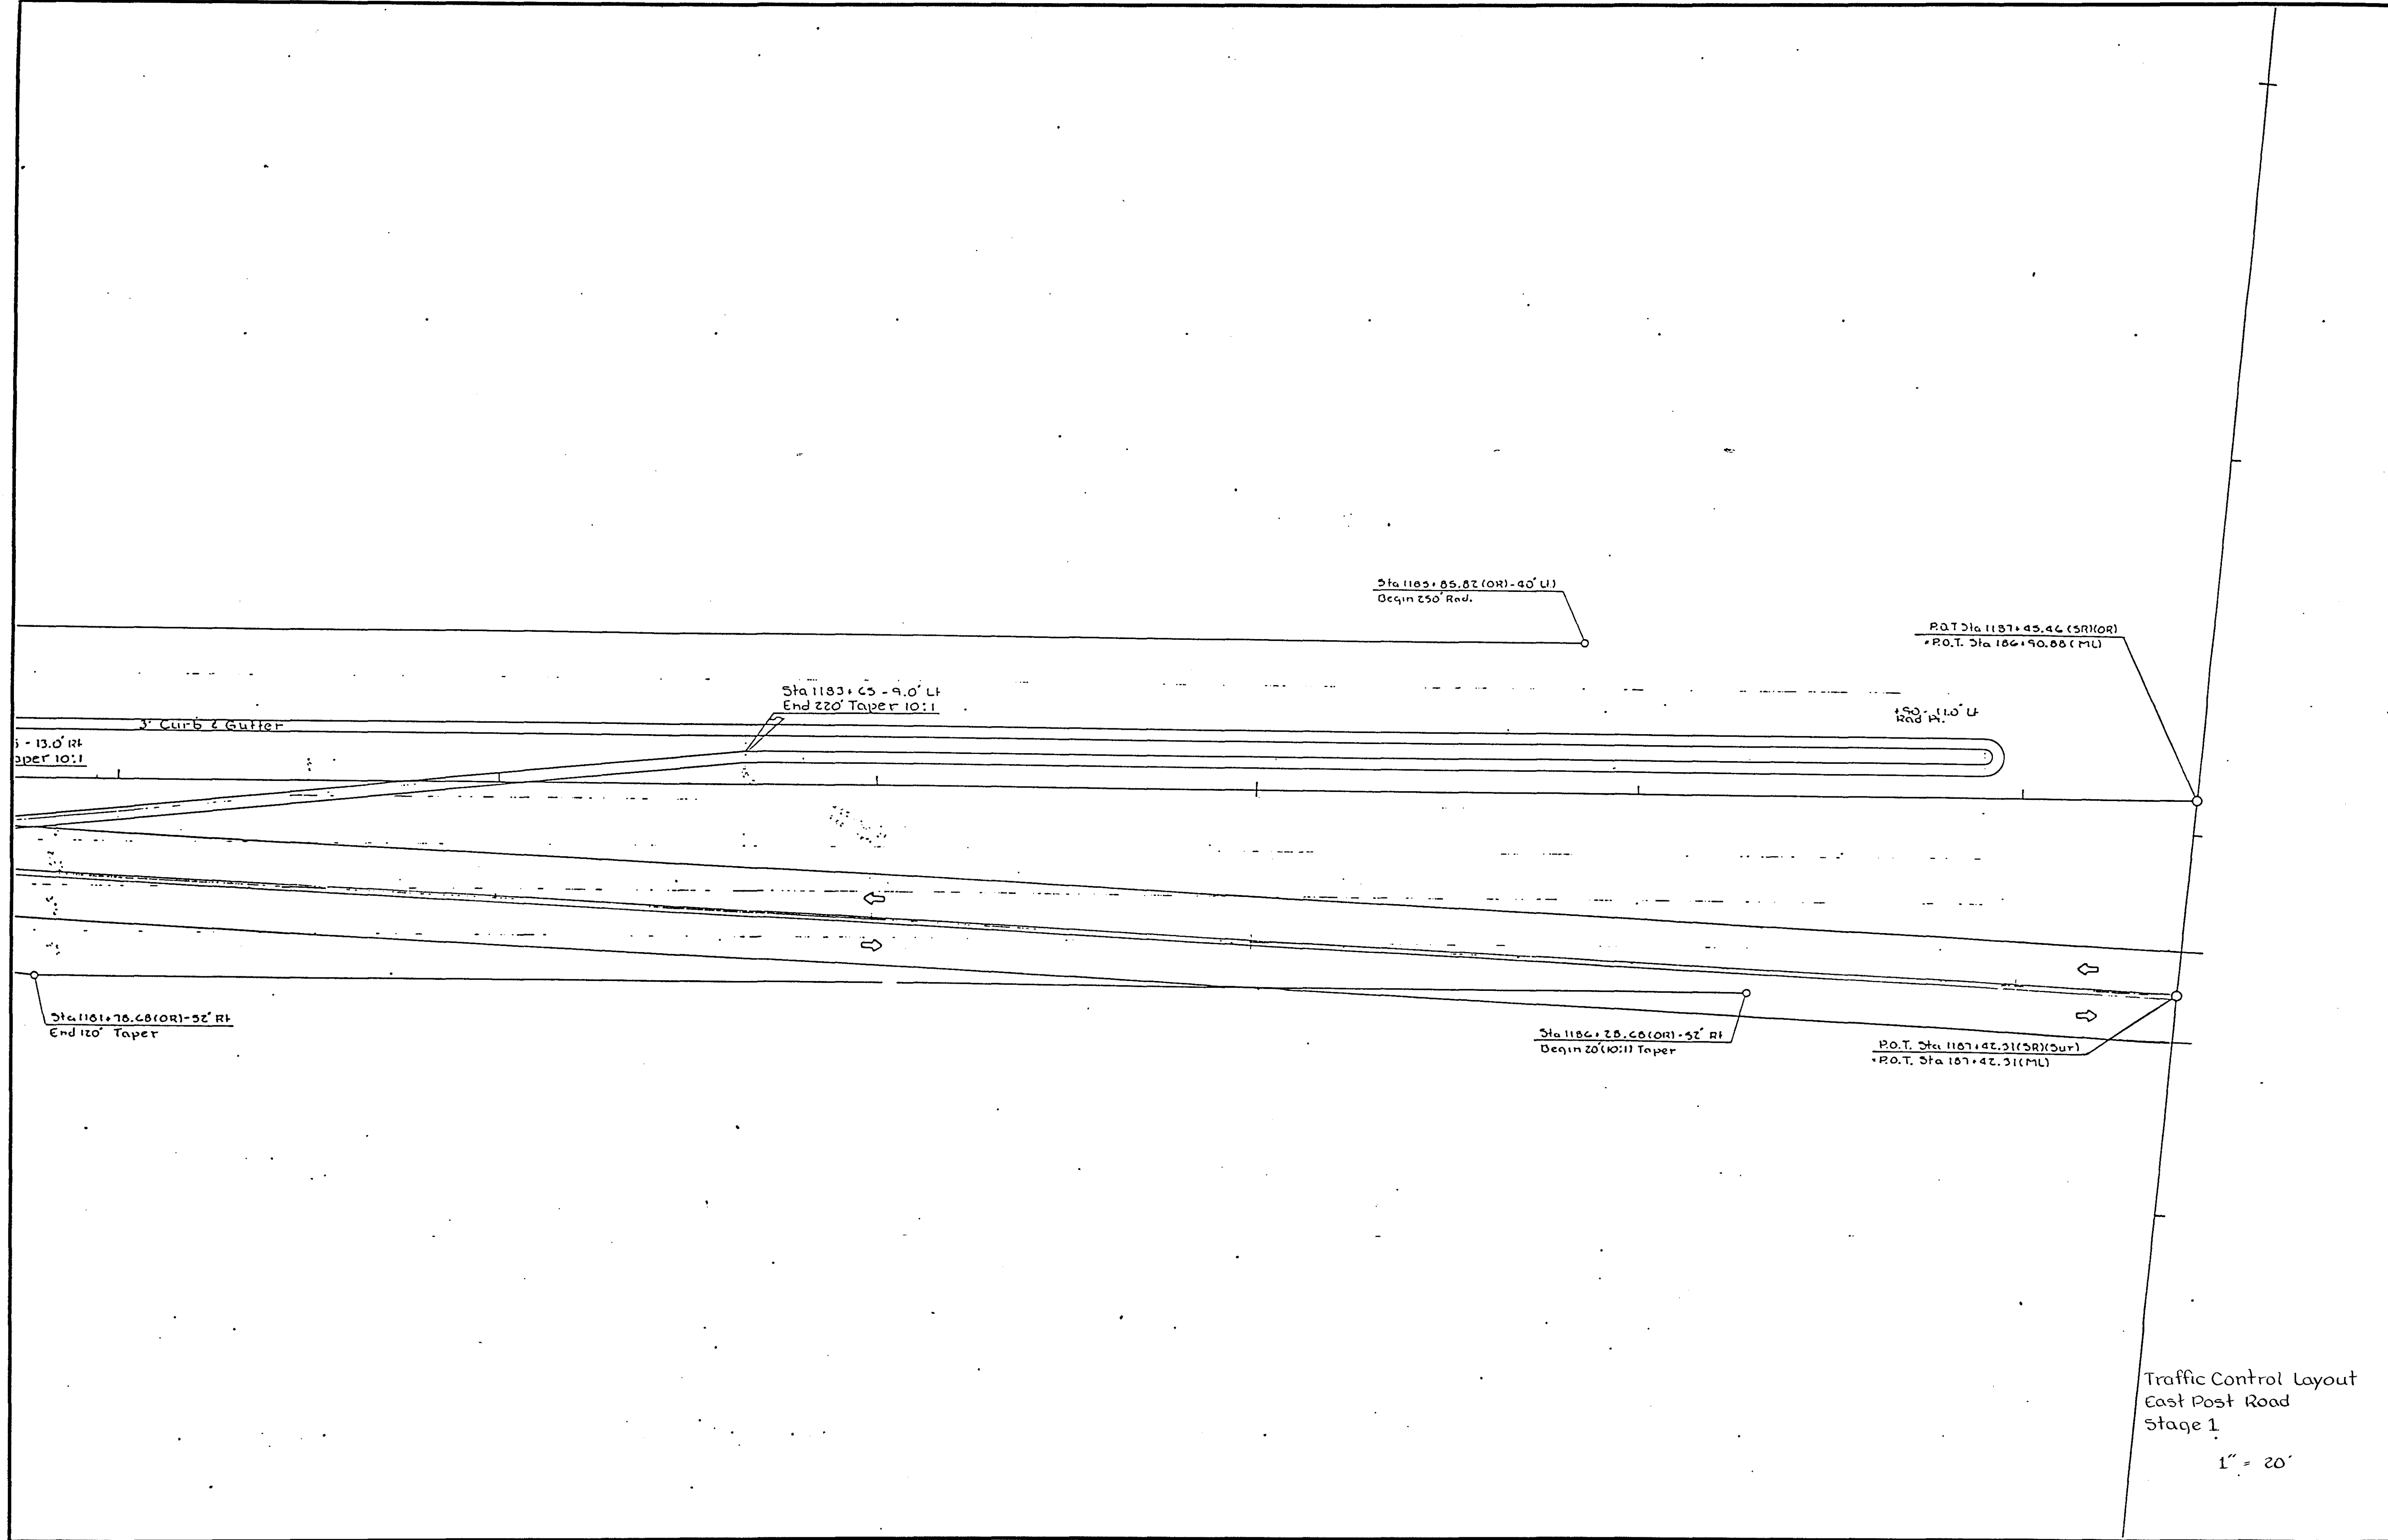

OFFICE OF DESIGN • CADD • PRODUCED	STATE OF IOWA	FHWA REGION 7	FISCAL YEAR	LINN	COUNTY	PROJECT NUMBER	NHS-100-1(23)--19-57	SHEET NUMBER	J.04
------------------------------------	---------------	---------------	-------------	------	--------	----------------	----------------------	--------------	------


P.63

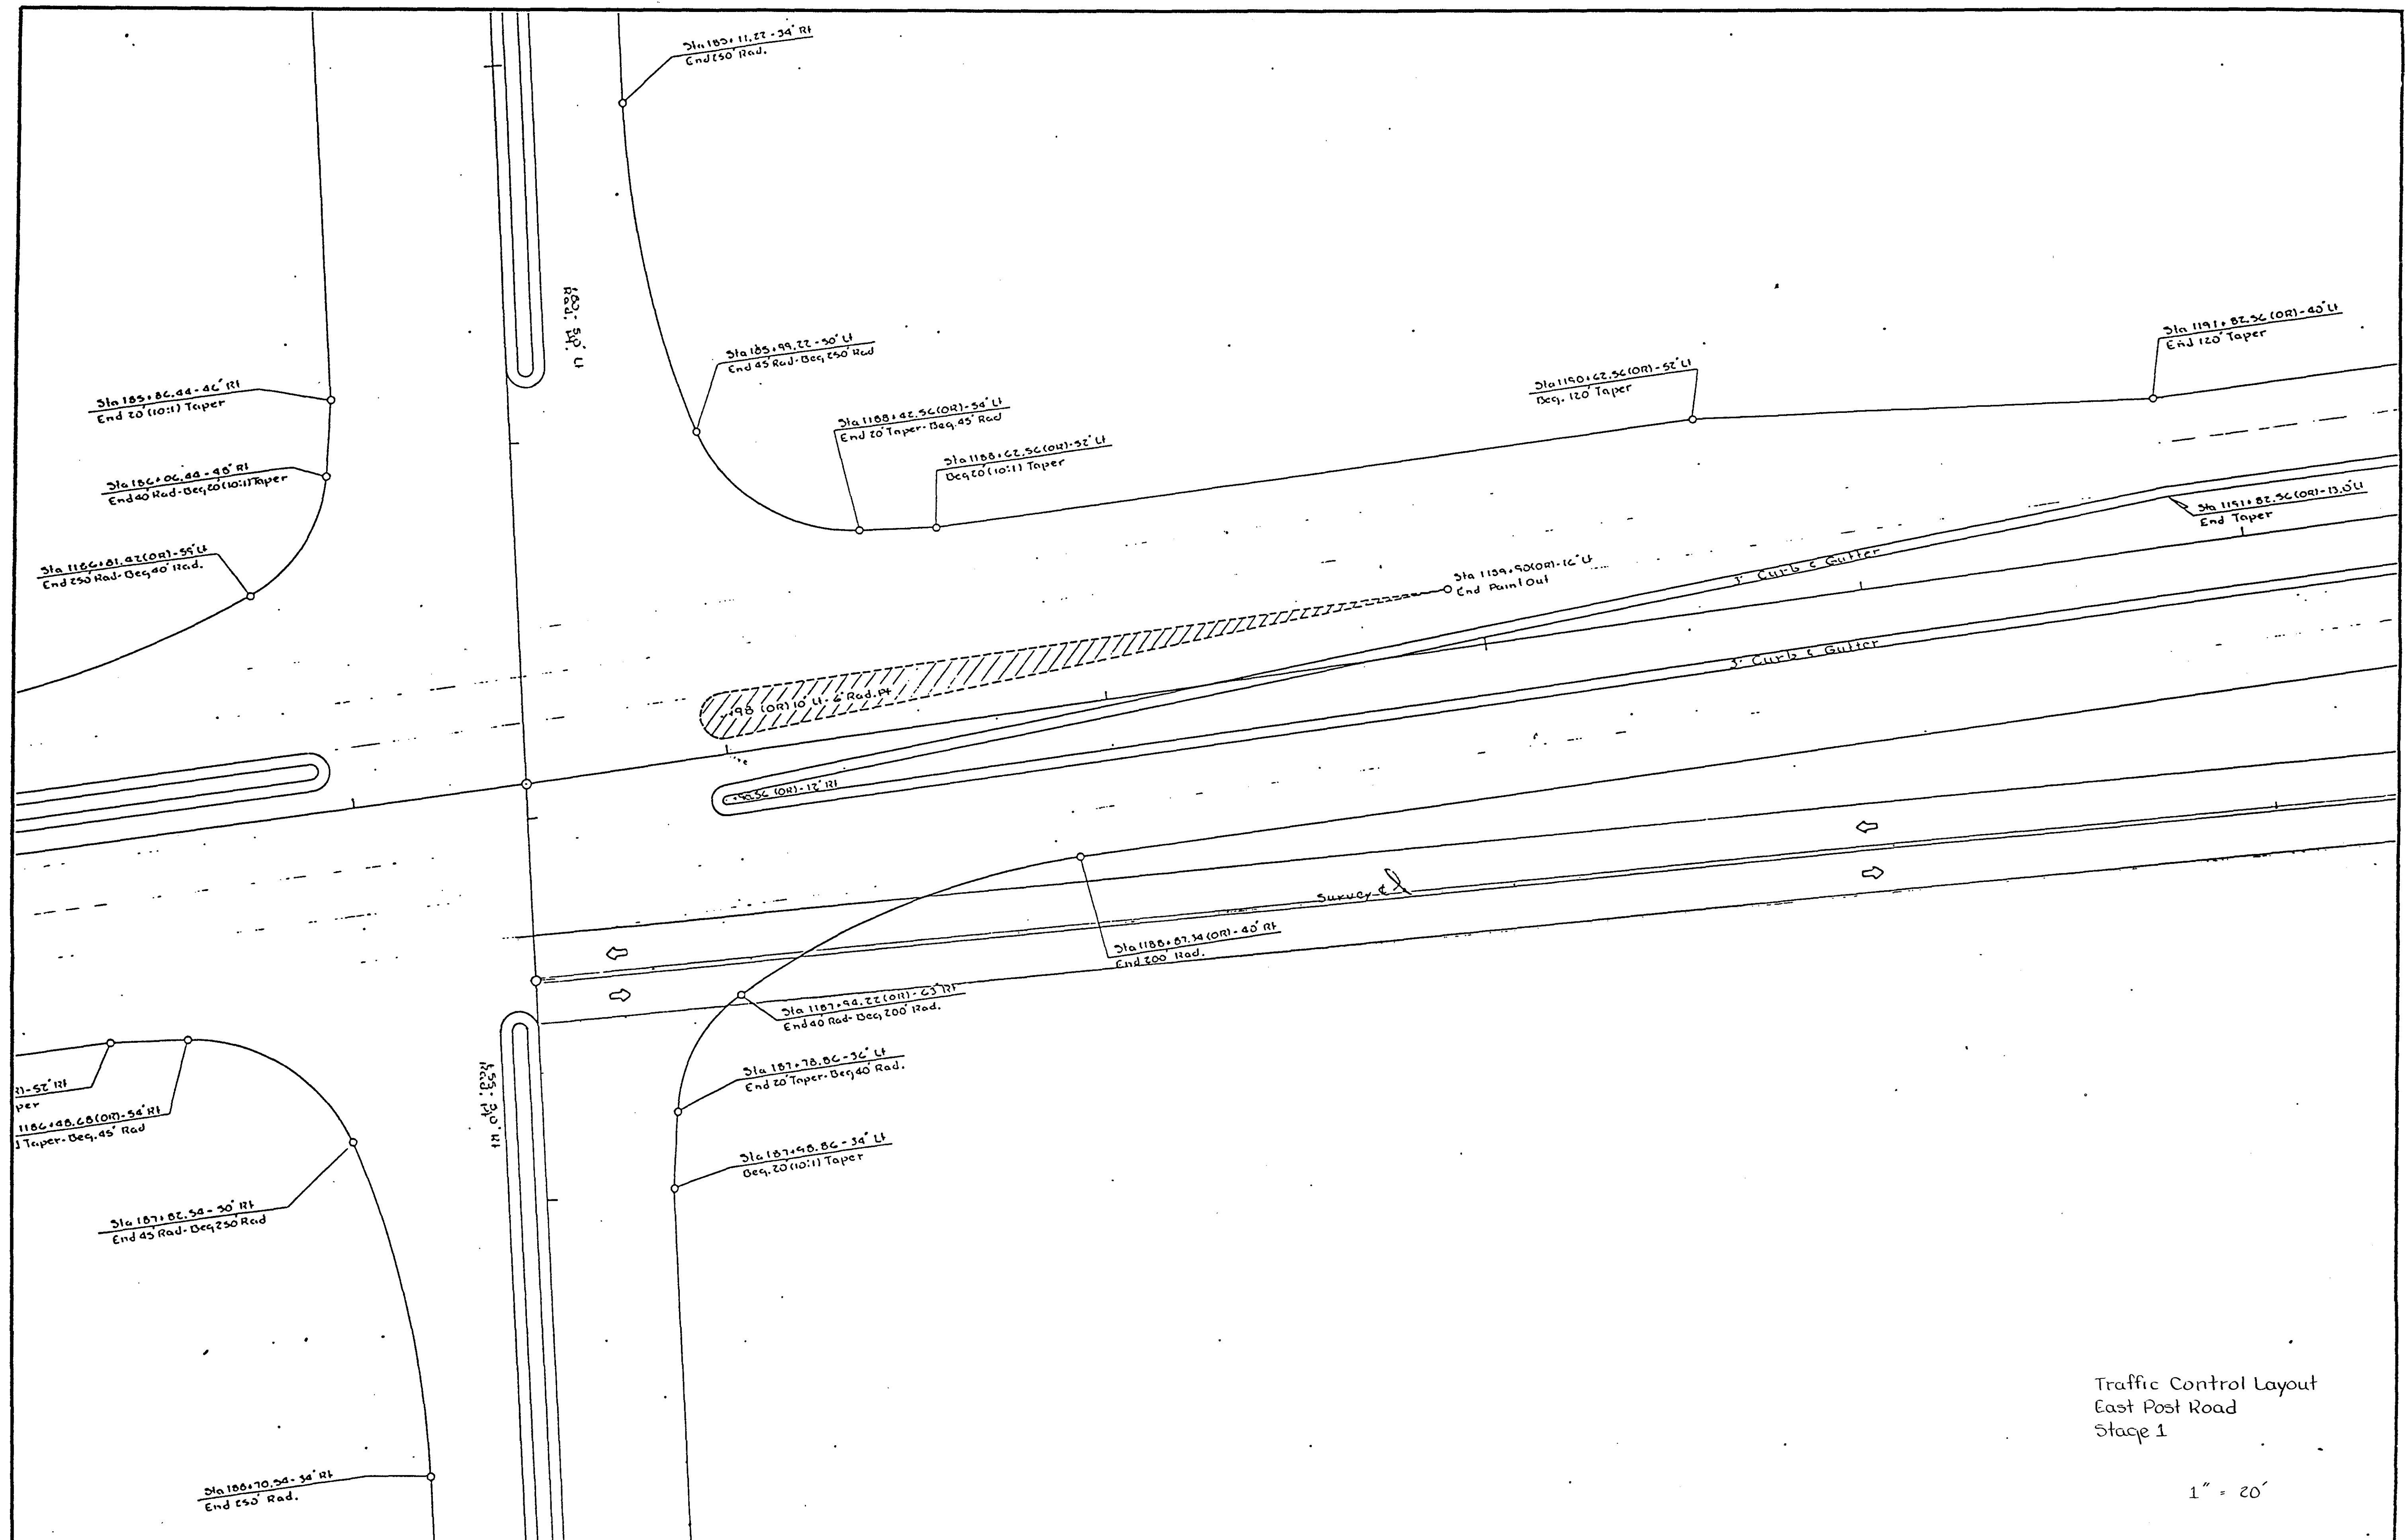

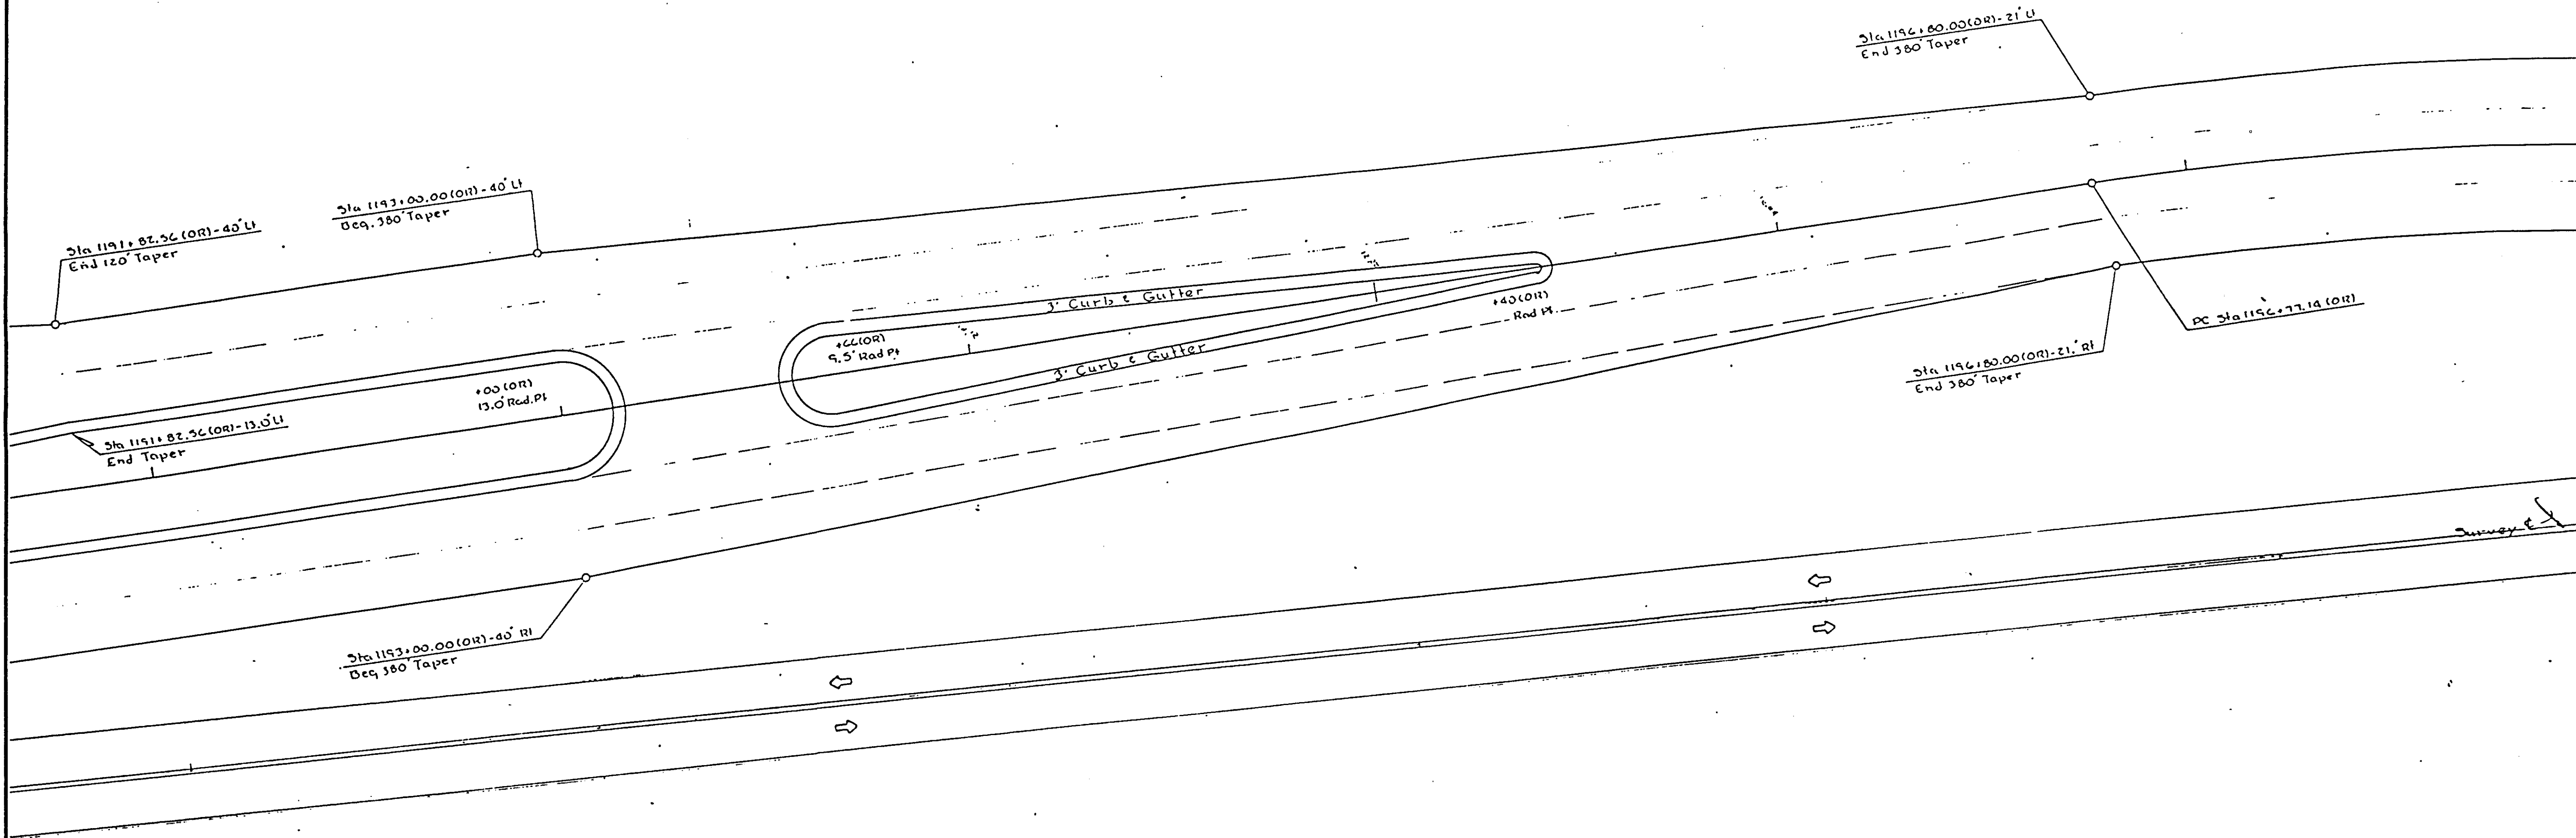

Traffic Control Layout
East Post Road
Stage 1
1" = 20'

OFFICE OF DESIGN	CADD	PRODUCED	STATE OF IOWA	FHWA REGION 7	FISCAL YEAR	LINN	COUNTY	PROJECT NUMBER	NHS-100-1(23)--19-57	SHEET NUMBER	U.06
------------------	------	----------	---------------	---------------	-------------	------	--------	----------------	----------------------	--------------	------

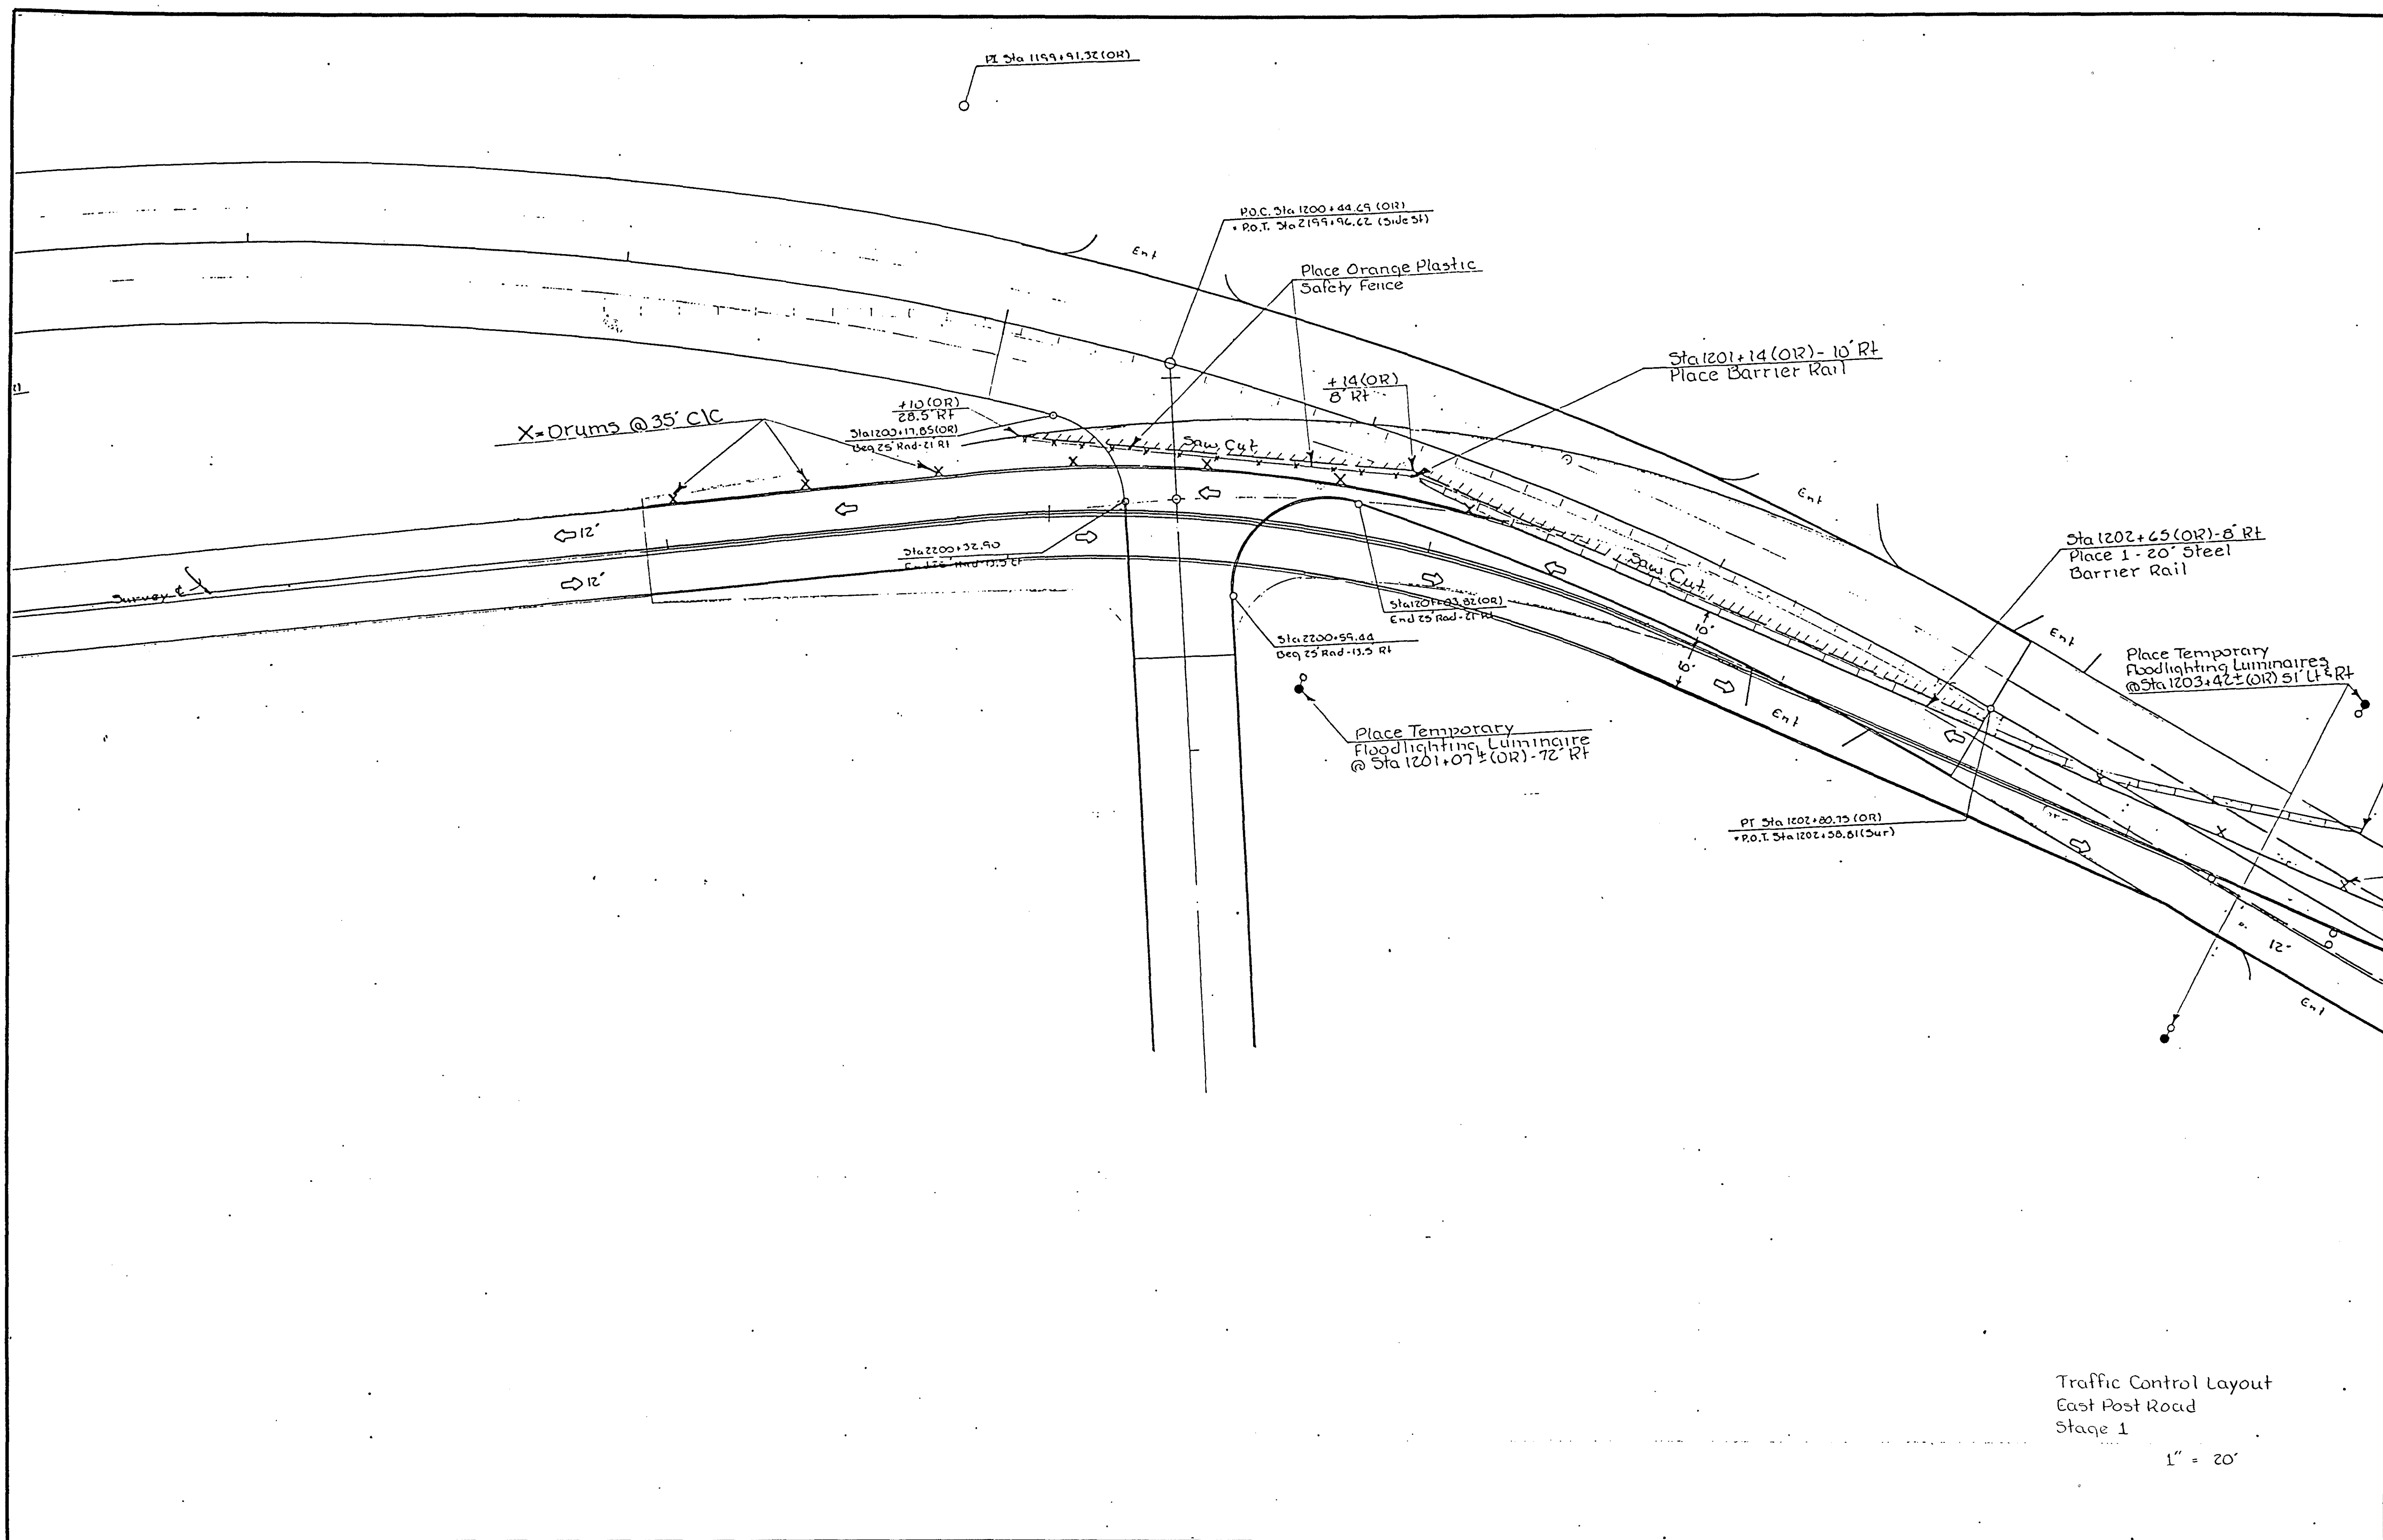

Traffic Control Layout
East Post Road
Stage 1
1" = 20'

OFFICE OF DESIGN • CADD • PRODUCED

STATE OF IOWA

FHWA REGION 7

FISCAL YEAR

LINN


COUNTY

PROJECT NUMBER

NHS-100-1(23)--19-57


SHEET NUMBER

J.07

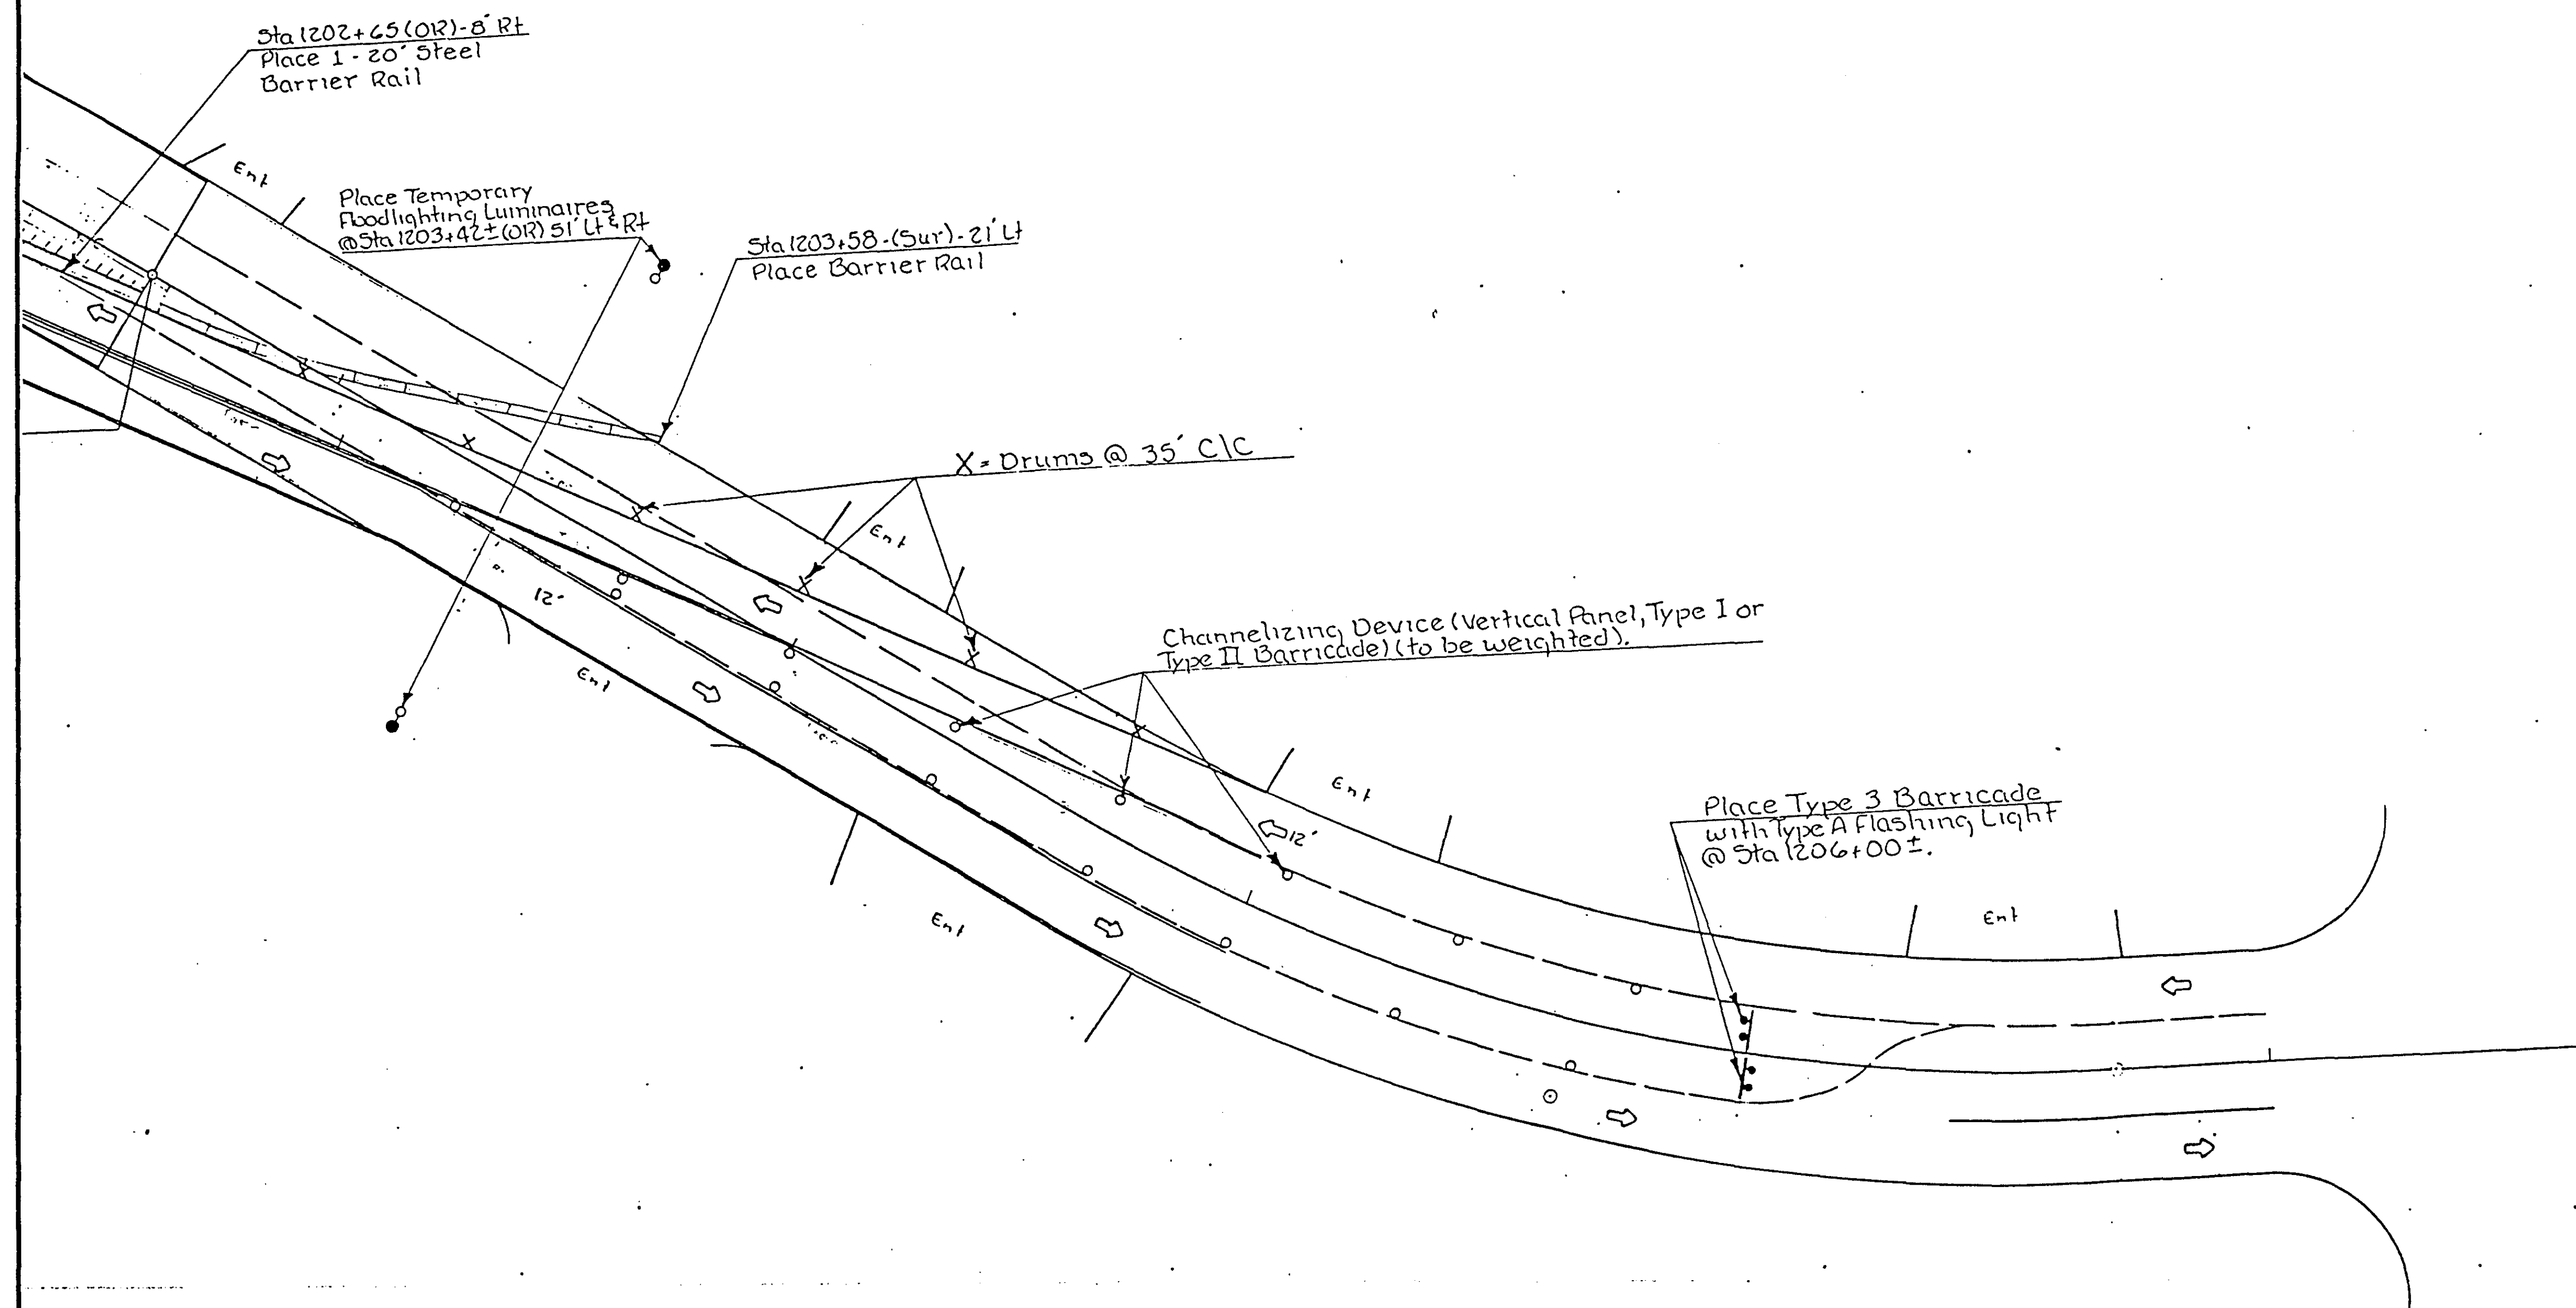


Traffic Control Layout
East Post Road
Stage 1
1" = 20'

OFFICE OF DESIGN • CAD • PRODUCED	STATE OF IOWA	FHWA REGION 7	FISCAL YEAR	LINN	COUNTY	PROJECT NUMBER	NHS-100-1(23)--19-57	SHEET NUMBER	J.08
-----------------------------------	---------------	---------------	-------------	------	--------	----------------	----------------------	--------------	------

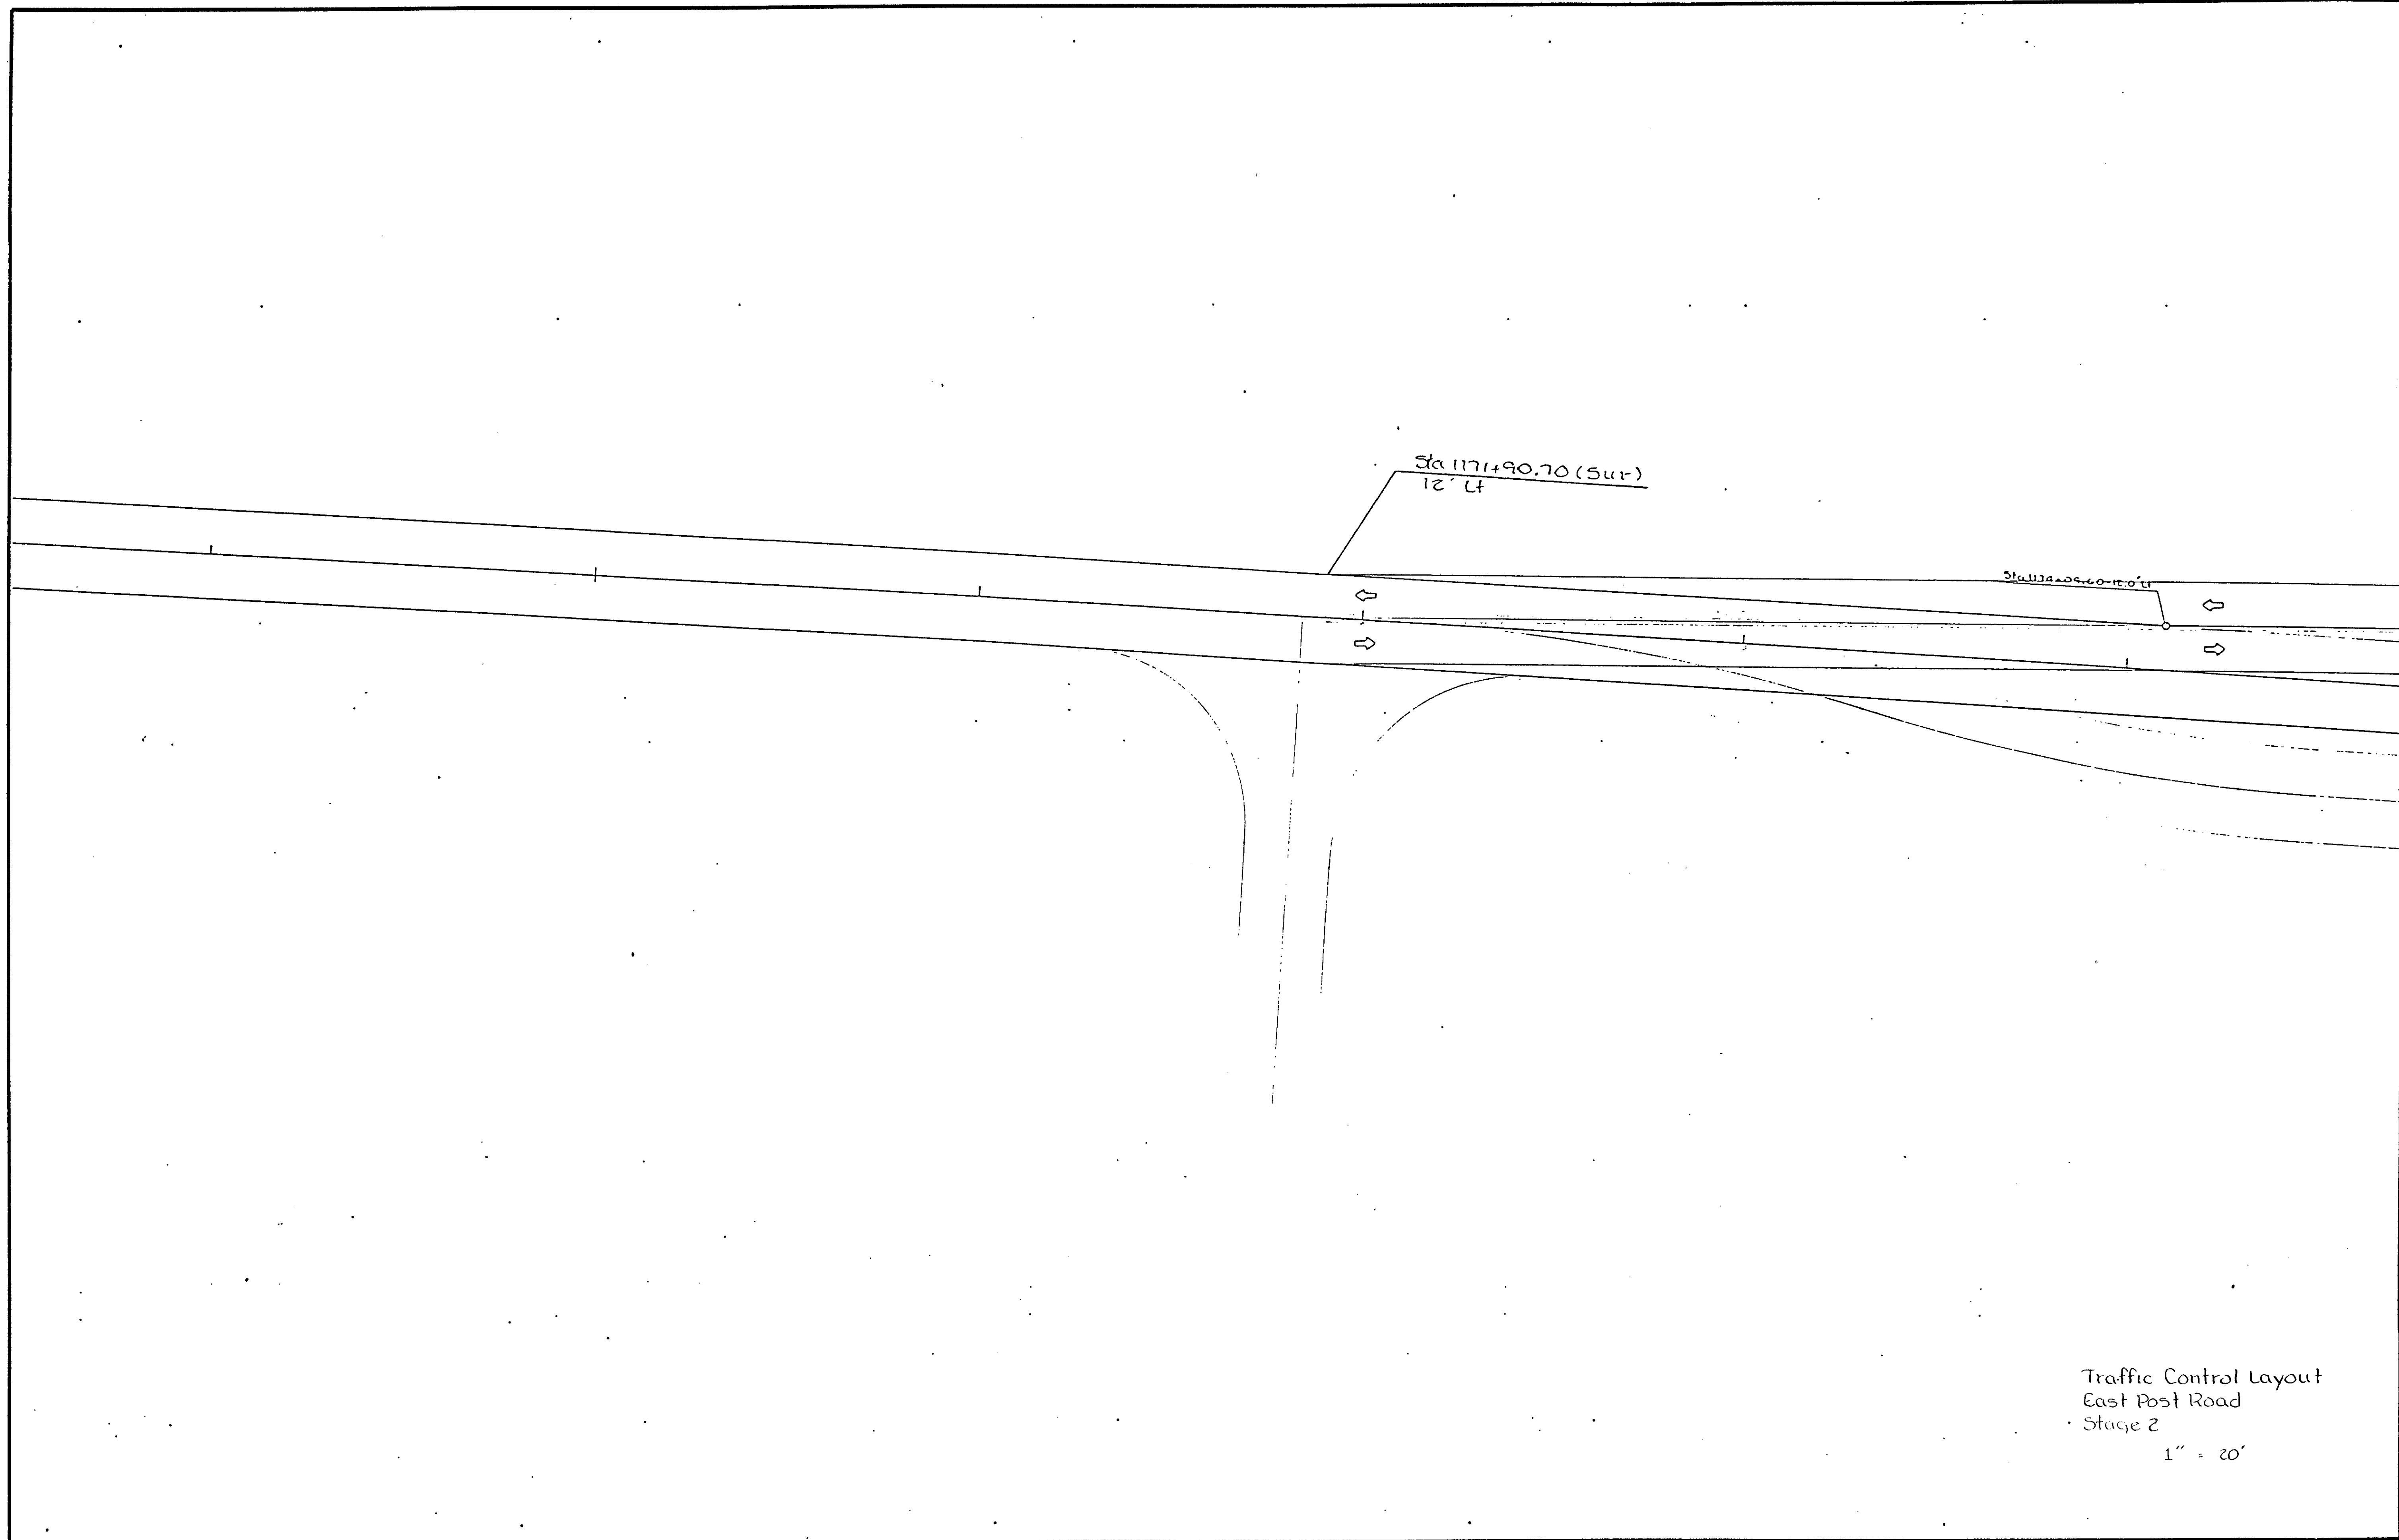

OFFICE OF DESIGN • CADD • PRODUCED	STATE OF IOWA	FHWA REGION 7	FISCAL YEAR	LINN	COUNTY	PROJECT NUMBER	NHS-100-1(23)--19-57	SHEET NUMBER	J.09
------------------------------------	---------------	---------------	-------------	------	--------	----------------	----------------------	--------------	------

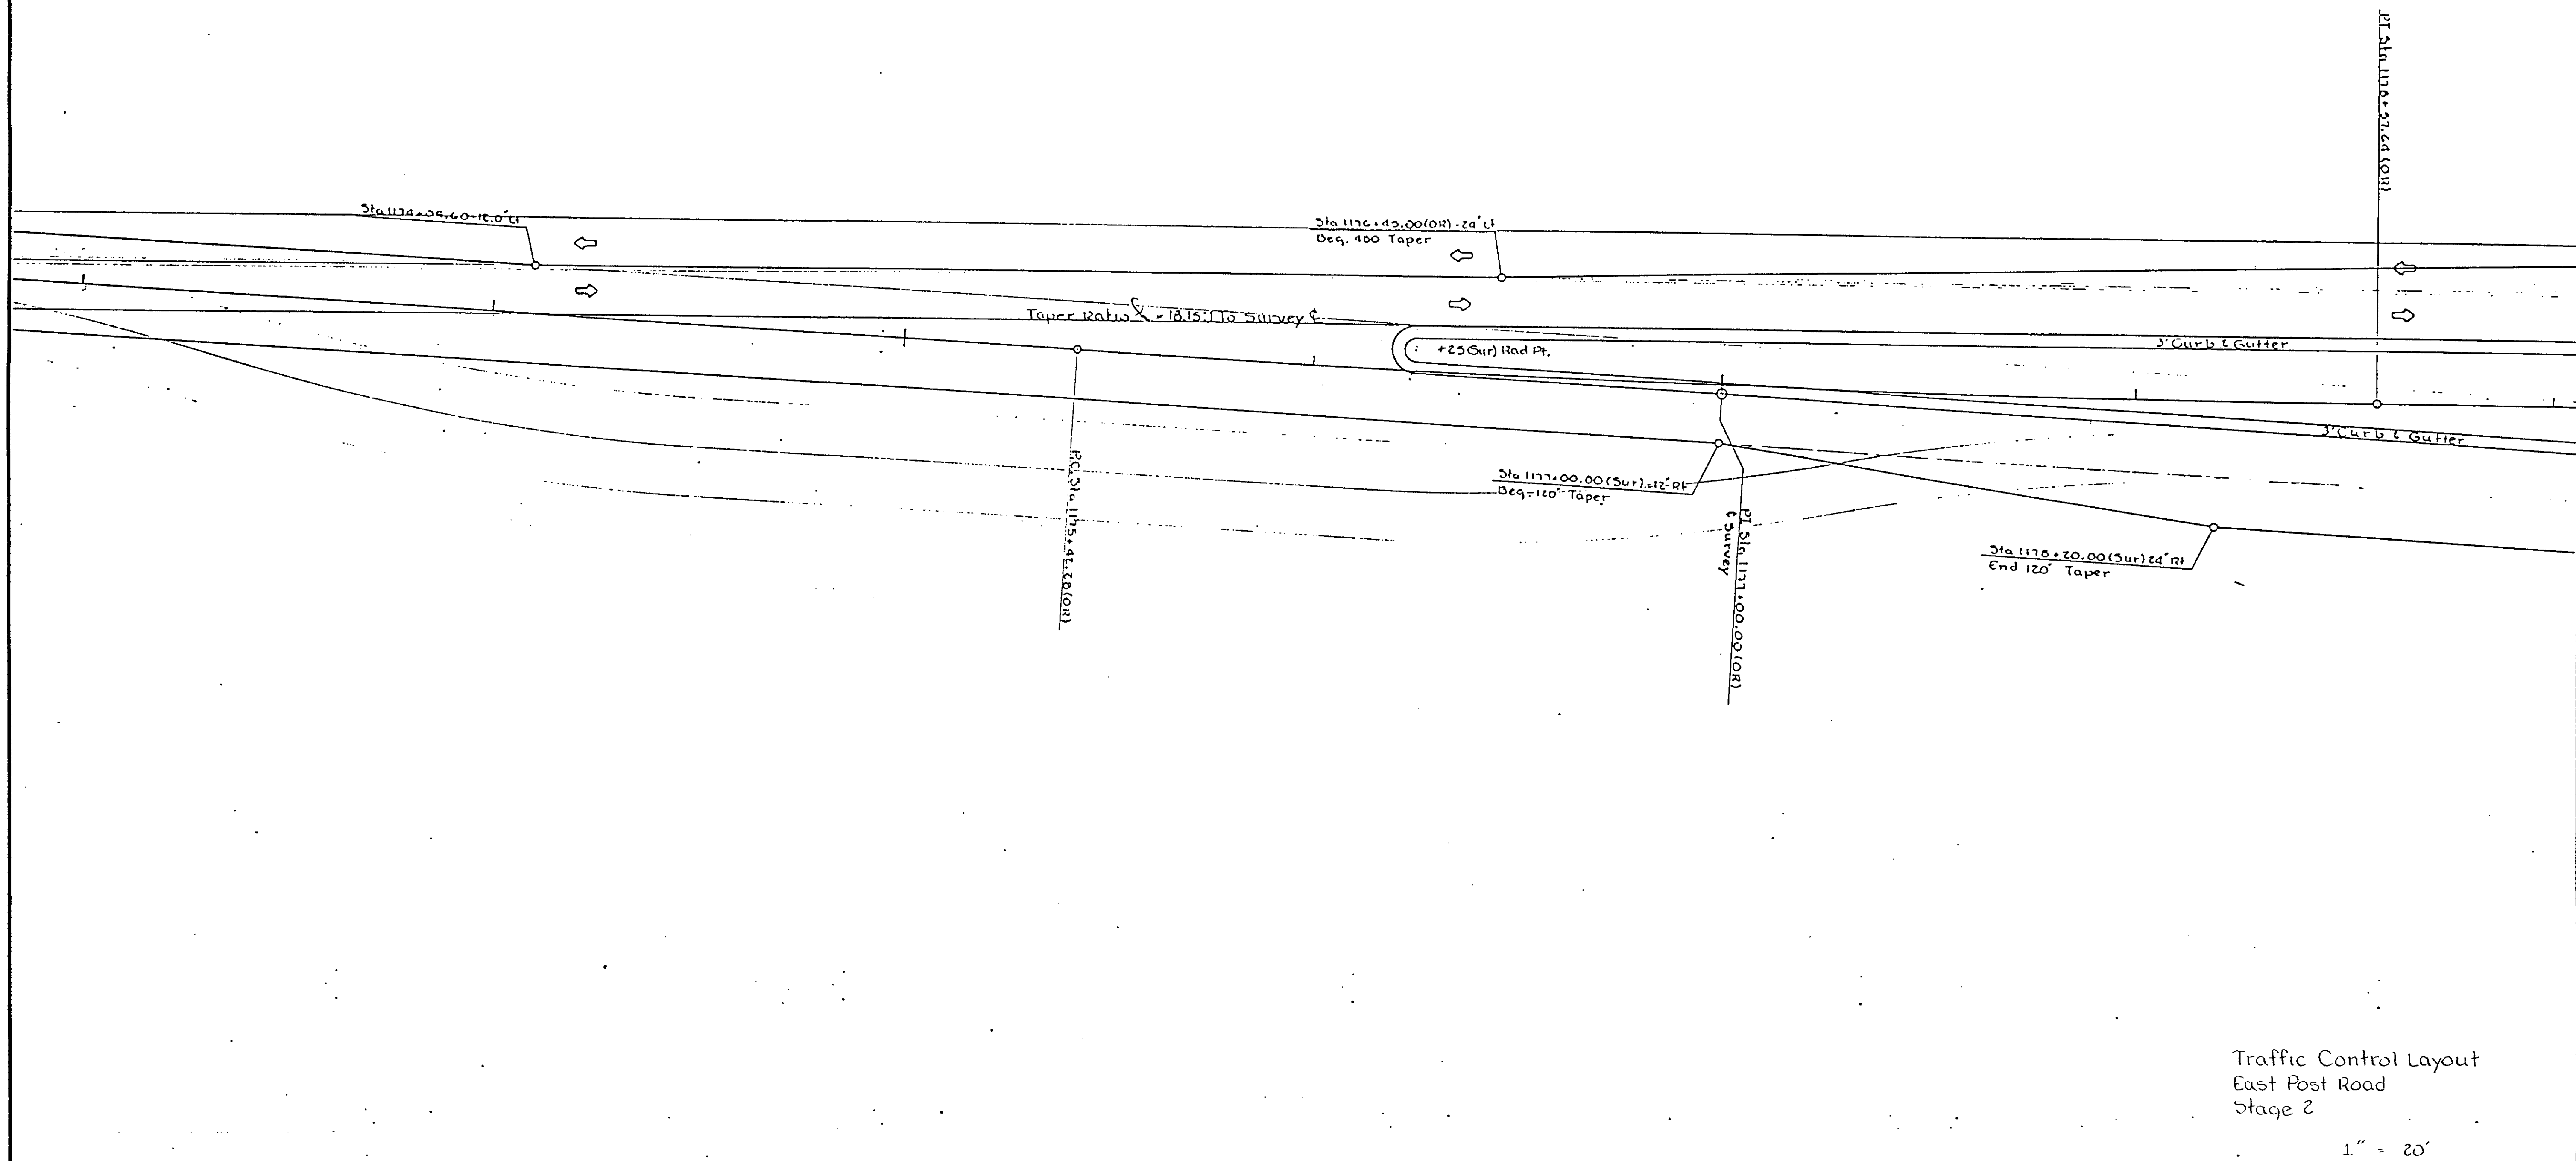

Traffic Control Layout
East Post Road
Stage 2
1" = 20'

OFFICE OF DESIGN • CADD • PRODUCED

STATE OF IOWA

FHWA REGION 7

FISCAL YEAR

LINN


COUNTY

PROJECT NUMBER

NHS-100-1(23)--19-57

SHEET NUMBER

J. 10

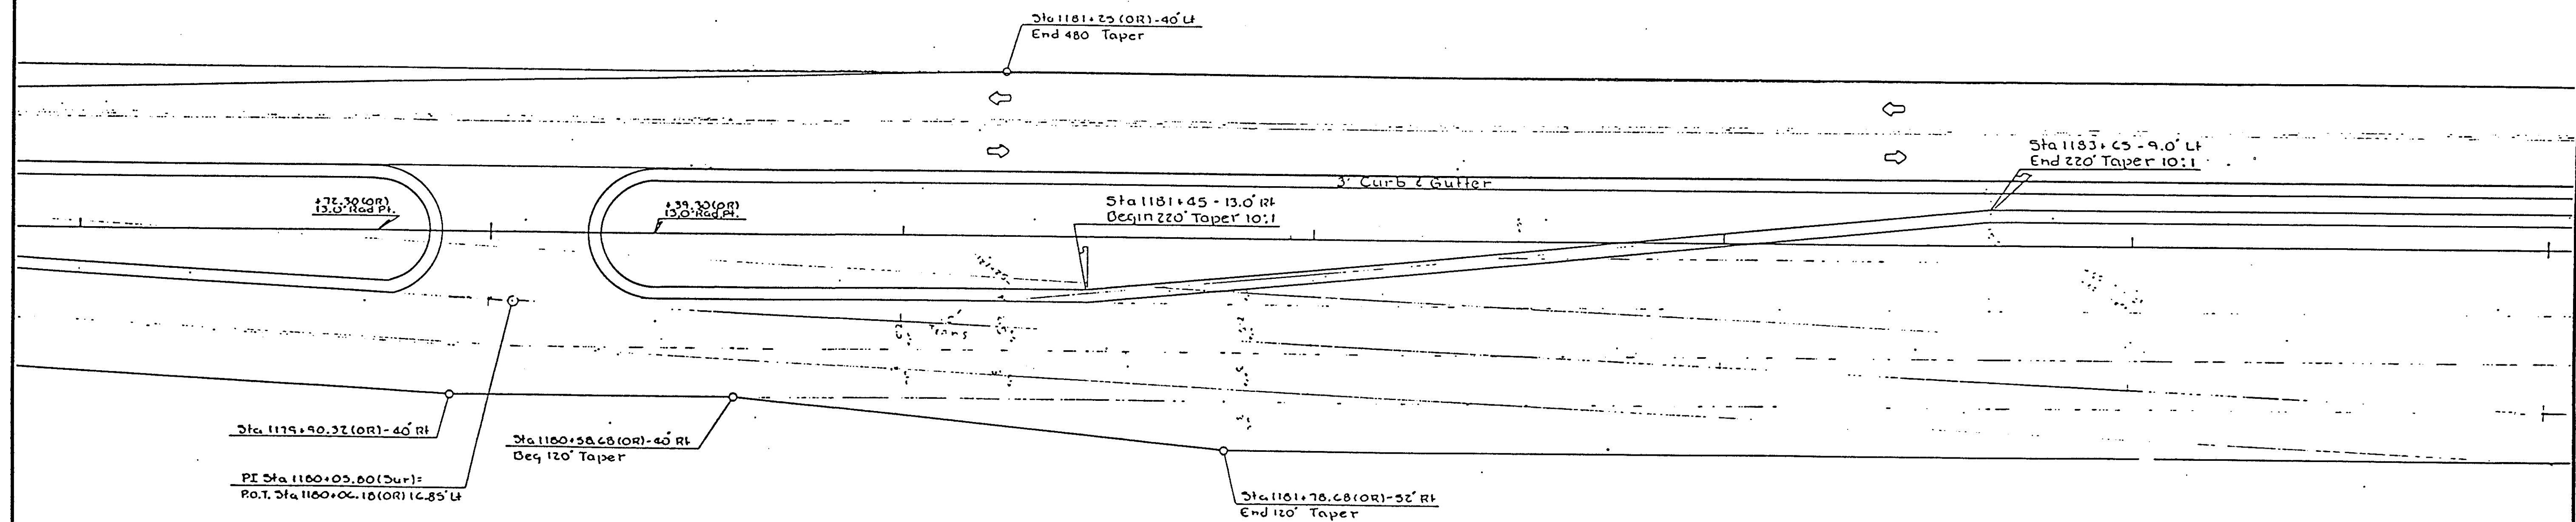

Traffic Control Layout
East Post Road
Stage 2

1" = 20'

OFFICE OF DESIGN • CADD • PRODUCED

STATE OF IOWA

FHWA REGION 7

FISCAL YEAR

LINN

COUNTY

PROJECT NUMBER

NHS-100-1(23)--19-57

SHEET NUMBER

J.11


$$1'' = 20'$$

P. 71

$$1'' = 20'$$

$$1'' = 20'$$

k57070332.m(3121.road1a) 1b@road1a. Fri Nov 18 07:24:43 CST 1994

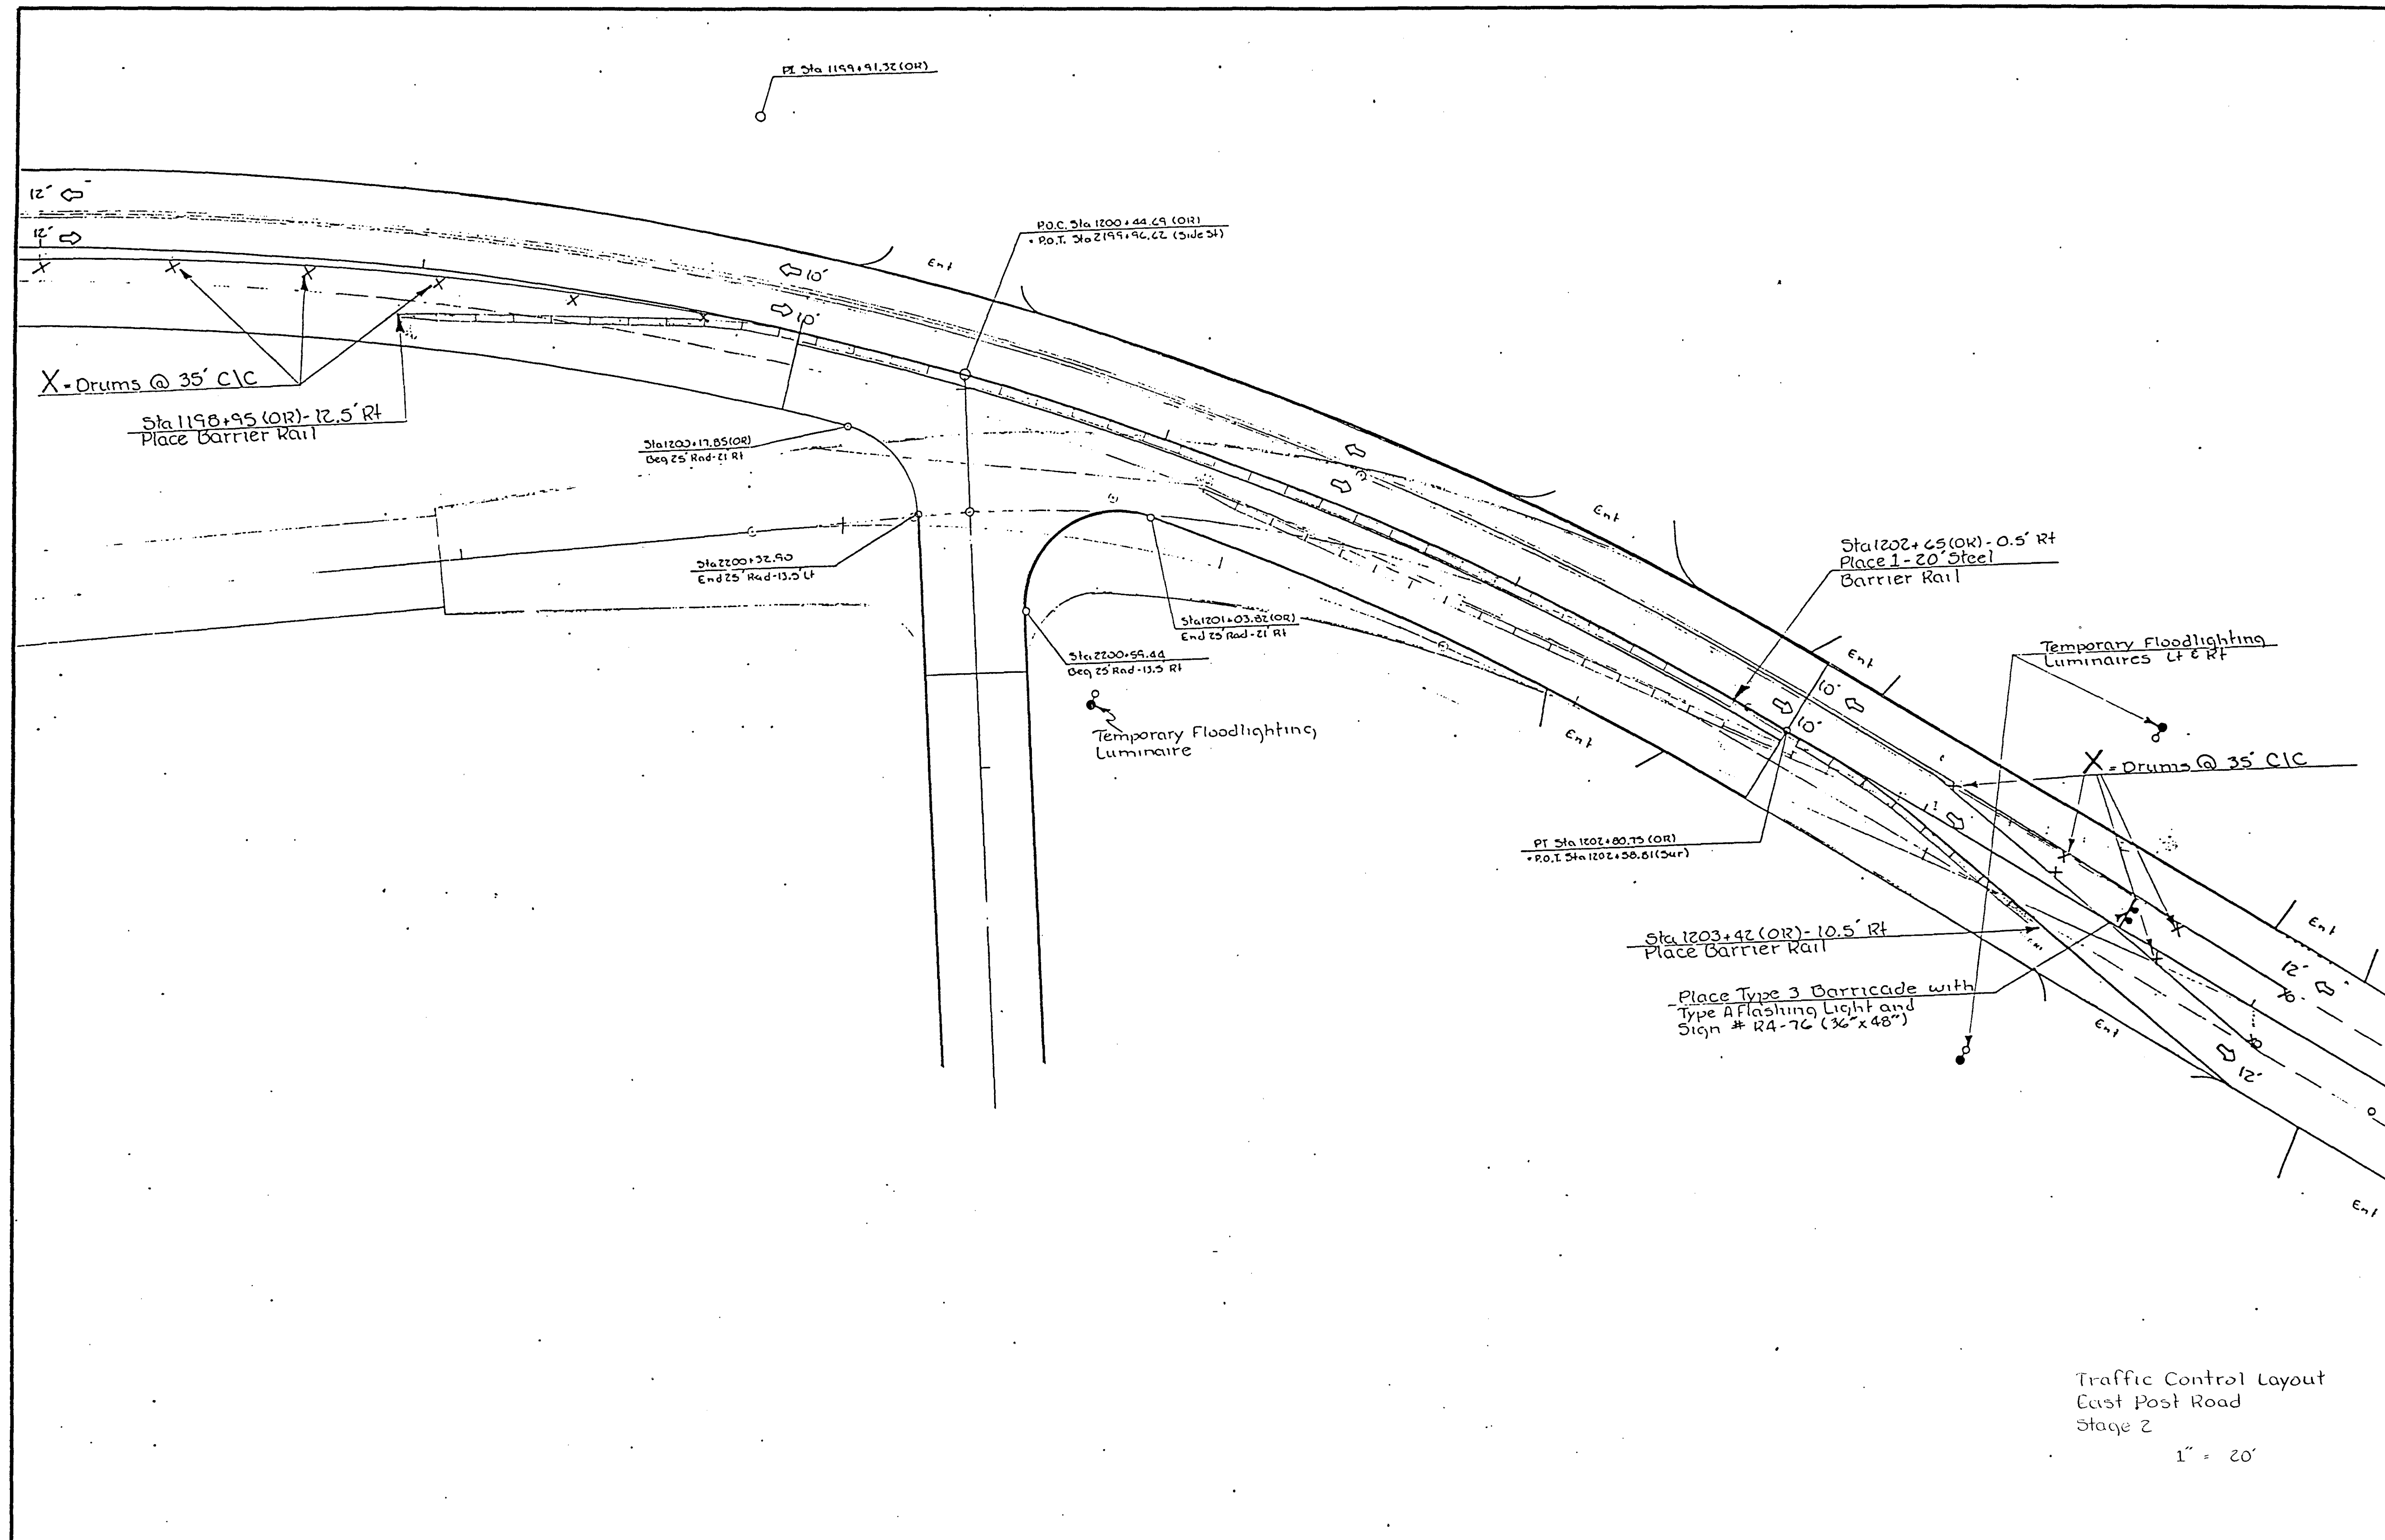

OFFICE OF DESIGN • CADD • PRODUCED

STATE OF IOWA

FHWA REGION 7

FISCAL YEAR

LINN

COUNTY


PROJECT NUMBER

NHS-100-1(23)--19-57

SHEET NUMBER



J.15

P 74

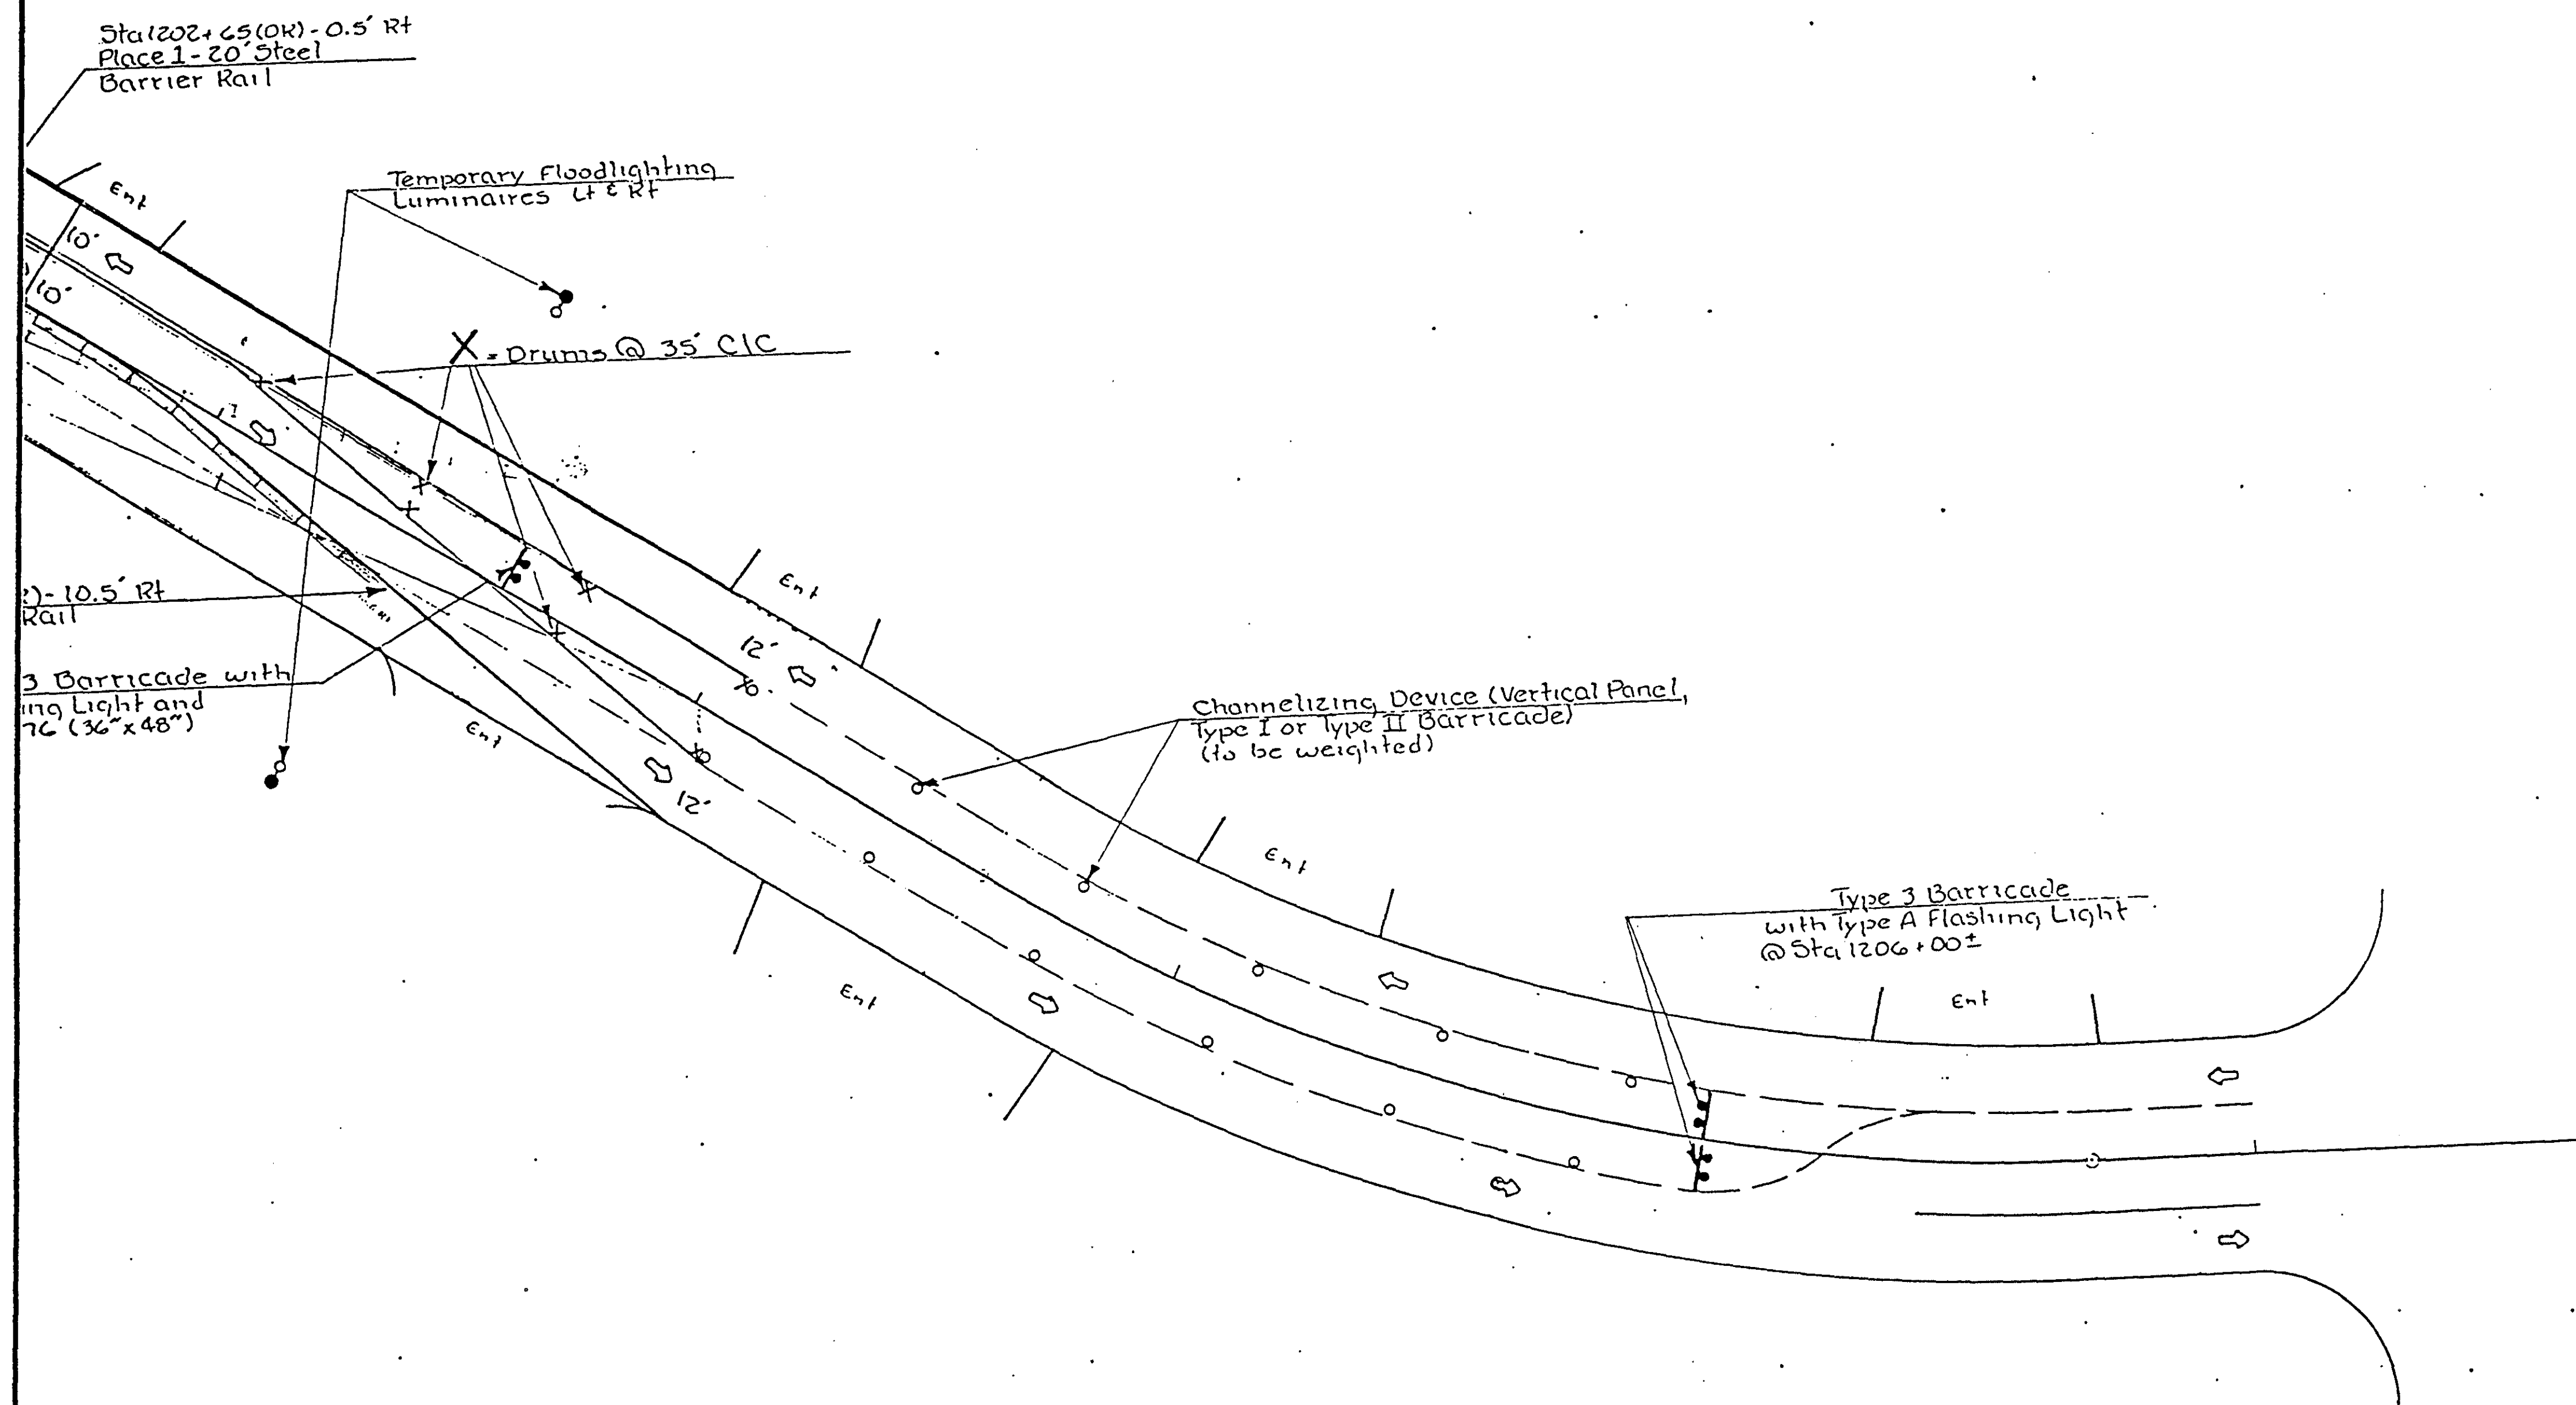

Traffic Control Layout
East Post Road
Stage 2
1" = 20'

OFFICE OF DESIGN • CADD • PRODUCED	STATE OF IOWA	FHWA REGION 7	FISCAL YEAR	LINN	COUNTY	PROJECT NUMBER	NHS-100-1(23)--19-57	SHEET NUMBER	J.16
------------------------------------	---------------	---------------	-------------	------	--------	----------------	----------------------	--------------	------

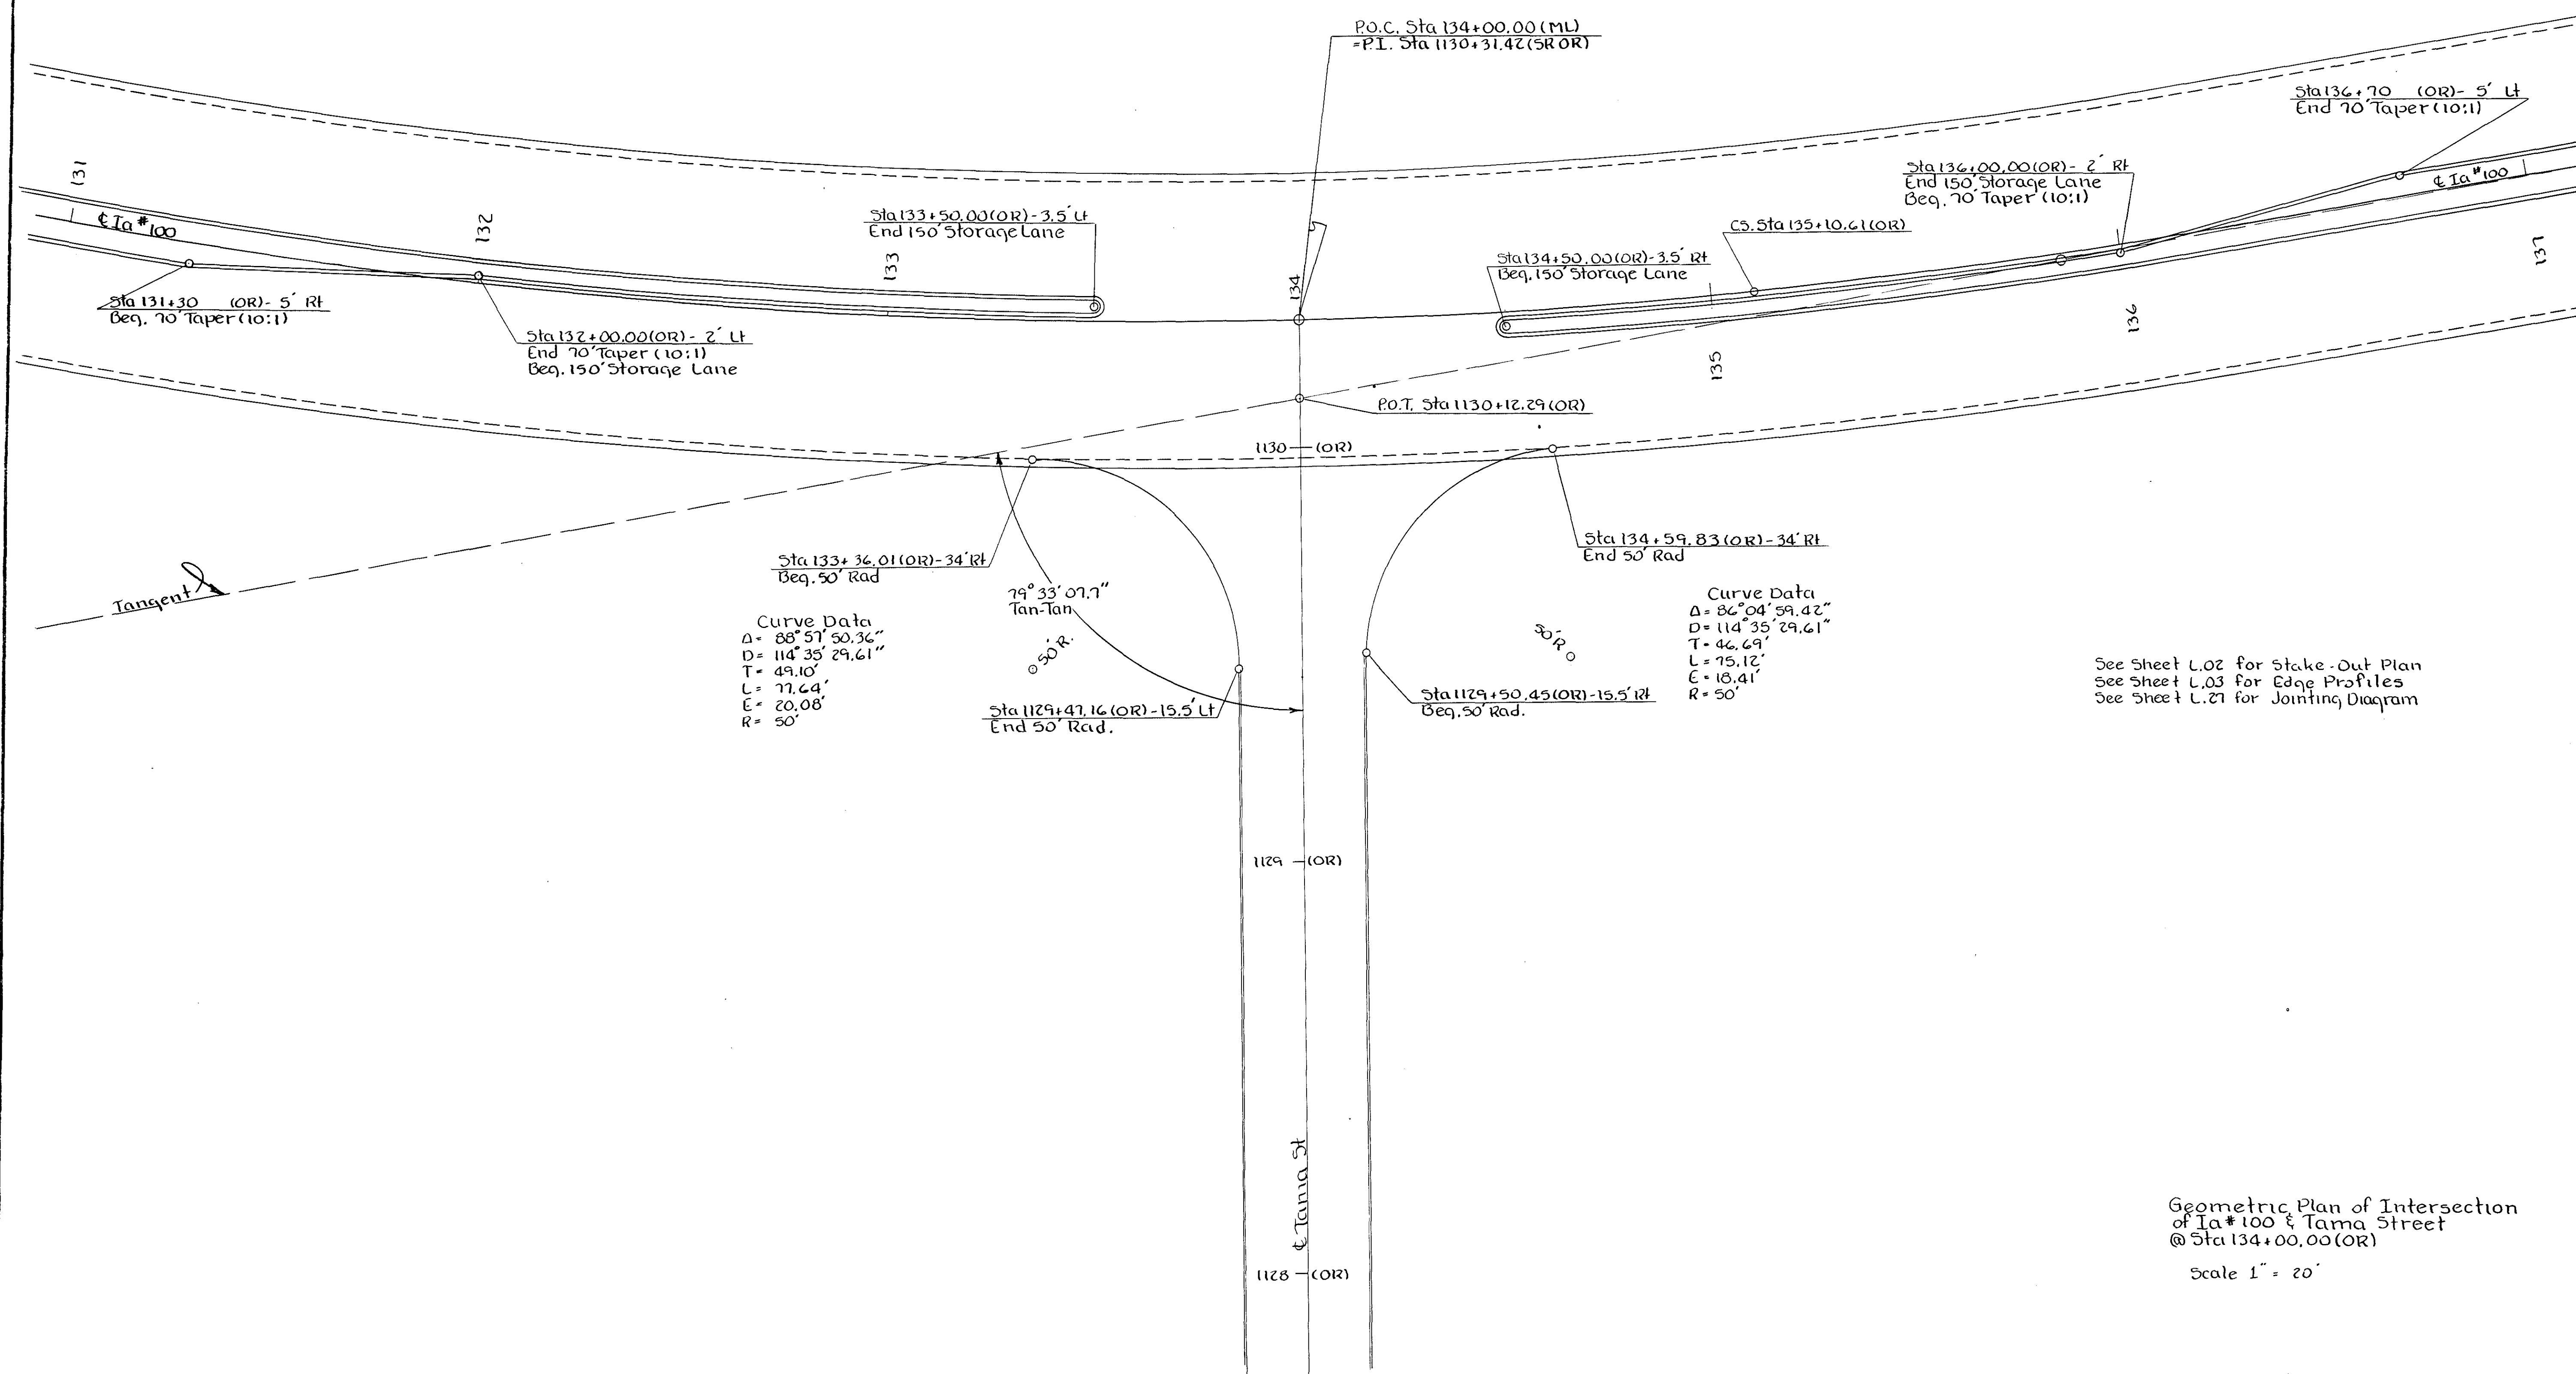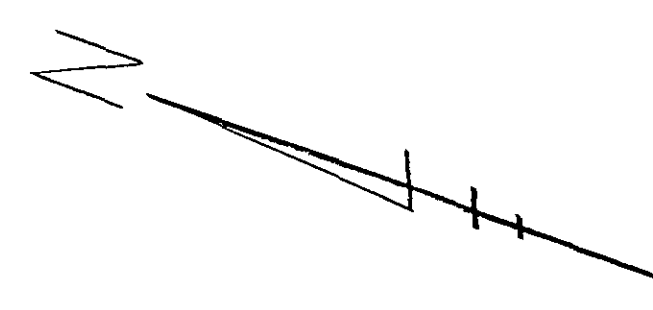

Curve Data
 $\Delta = 88^{\circ}51'50.36''$
 $D = 114^{\circ}35'29.61''$
 $T = 49.10'$
 $L = 77.64'$
 $E = 20.08'$
 $R = 50'$

$79^{\circ}33'07.7''$
Tan-Tan
 $50' R$
Sta 1129+47.16 (OR) - 15.5' Lt
End 50' Rad.


Curve Data
 $\Delta = 86^{\circ}04'59.42''$
 $D = 114^{\circ}35'29.61''$
 $T = 46.69'$
 $L = 75.12'$
 $E = 18.41'$
 $R = 50'$

See Sheet L.02 for Stake-Out Plan
See Sheet L.03 for Edge Profiles
See Sheet L.27 for Jointing Diagram

Geometric Plan of Intersection
of Ia#100 & Tama Street
@ Sta 134+00.00 (OR)
Scale 1" = 20'

P.76

D4

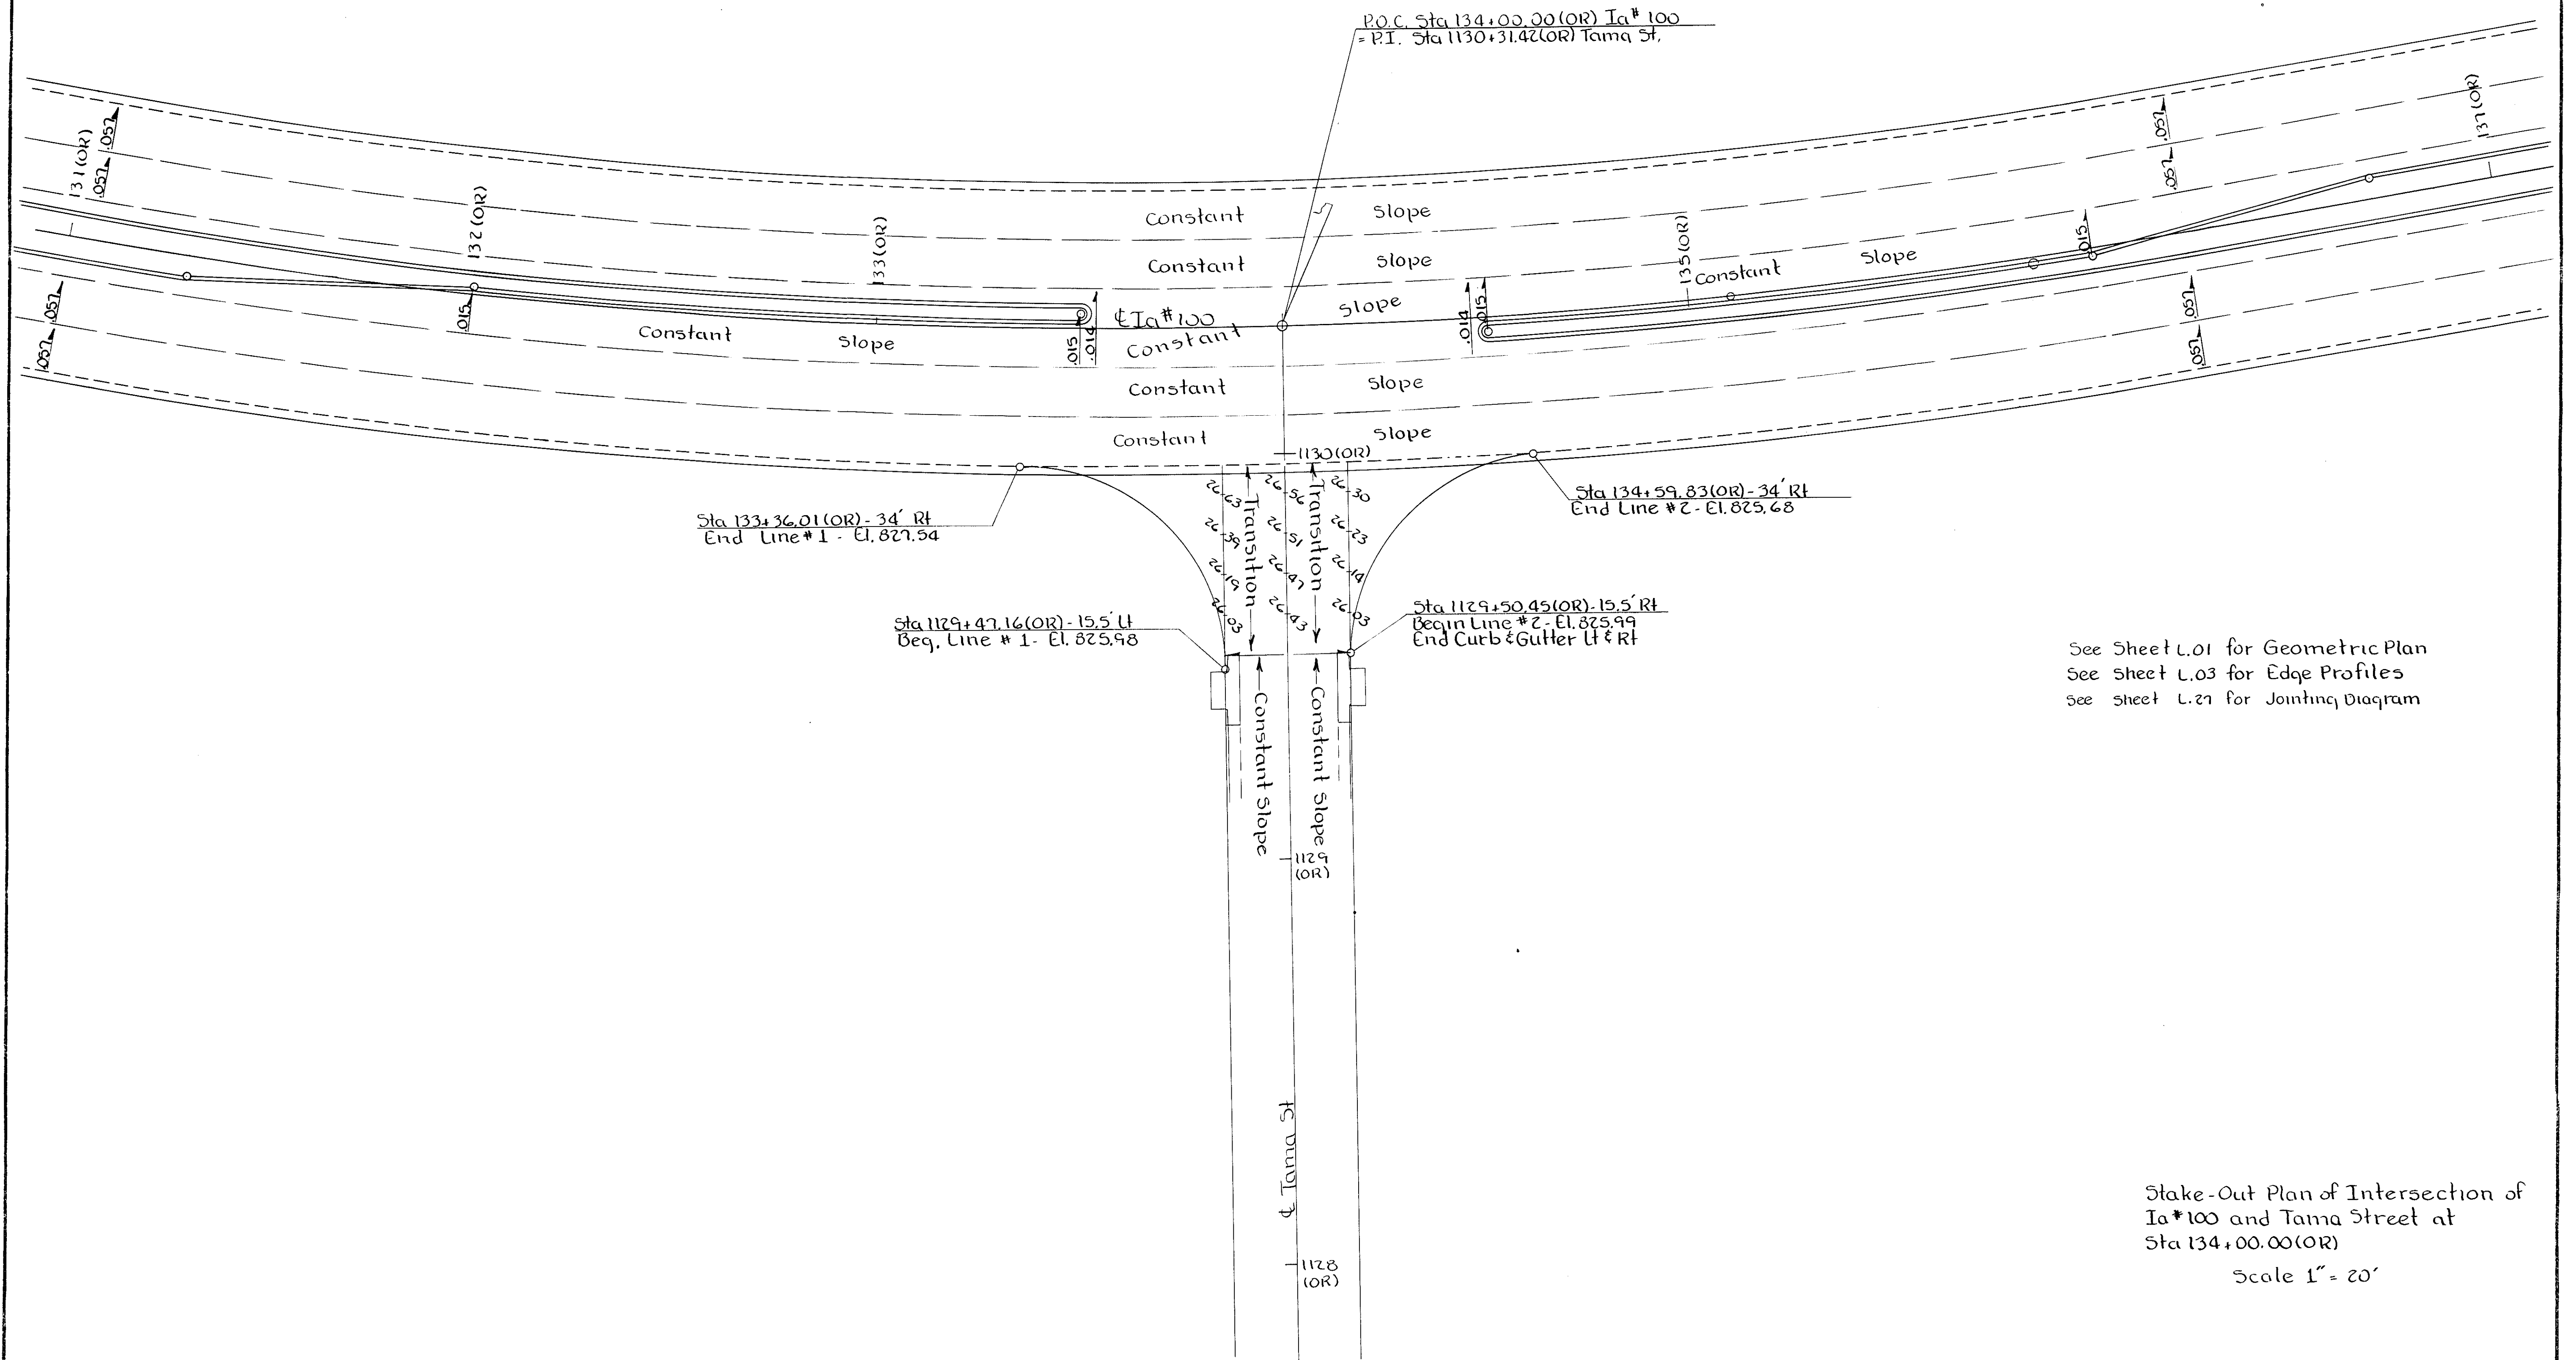

See Sheet L.01 for Geometric Plan
See Sheet L.03 for Edge Profiles
See Sheet L.27 for Jointing Diagram

Stake-Out Plan of Intersection of
Ia*100 and Tama Street at
Sta 134+00.00 (OR)
Scale 1" = 20'

PLAN	SURVEYED	DATE
	PLOTTED	BY
	NOTE BOOK NO.	RT OF WAY CHECKED

PROFILE	SURVEYED	DATE
	GRADES CHECKED	BY
	STRUCTURE NOTATIONS CHD	

See Sheet L.01 for Geometric Plan
See Sheet L.02 for Stake-Out Plan
See Sheet L.27 for Jointing Diagram





Edge Profiles of Intersection of
Ia #100 and Tama Street
at Sta 134+00.00 (OR)

Scale 1" = 1' Hor
1" = 10' Vert

P.78

Curve 4 Data
 $\Delta = 52^\circ 00' 47.73''$
 $D = 76^\circ 23' 39.74''$
 $T = 36.59'$
 $L = 68.08'$
 $E = 8.45'$
 $R = 75'$

Sta 1124+46.39 (OR) - 90.5' Lt
 75' Rad. Pt.

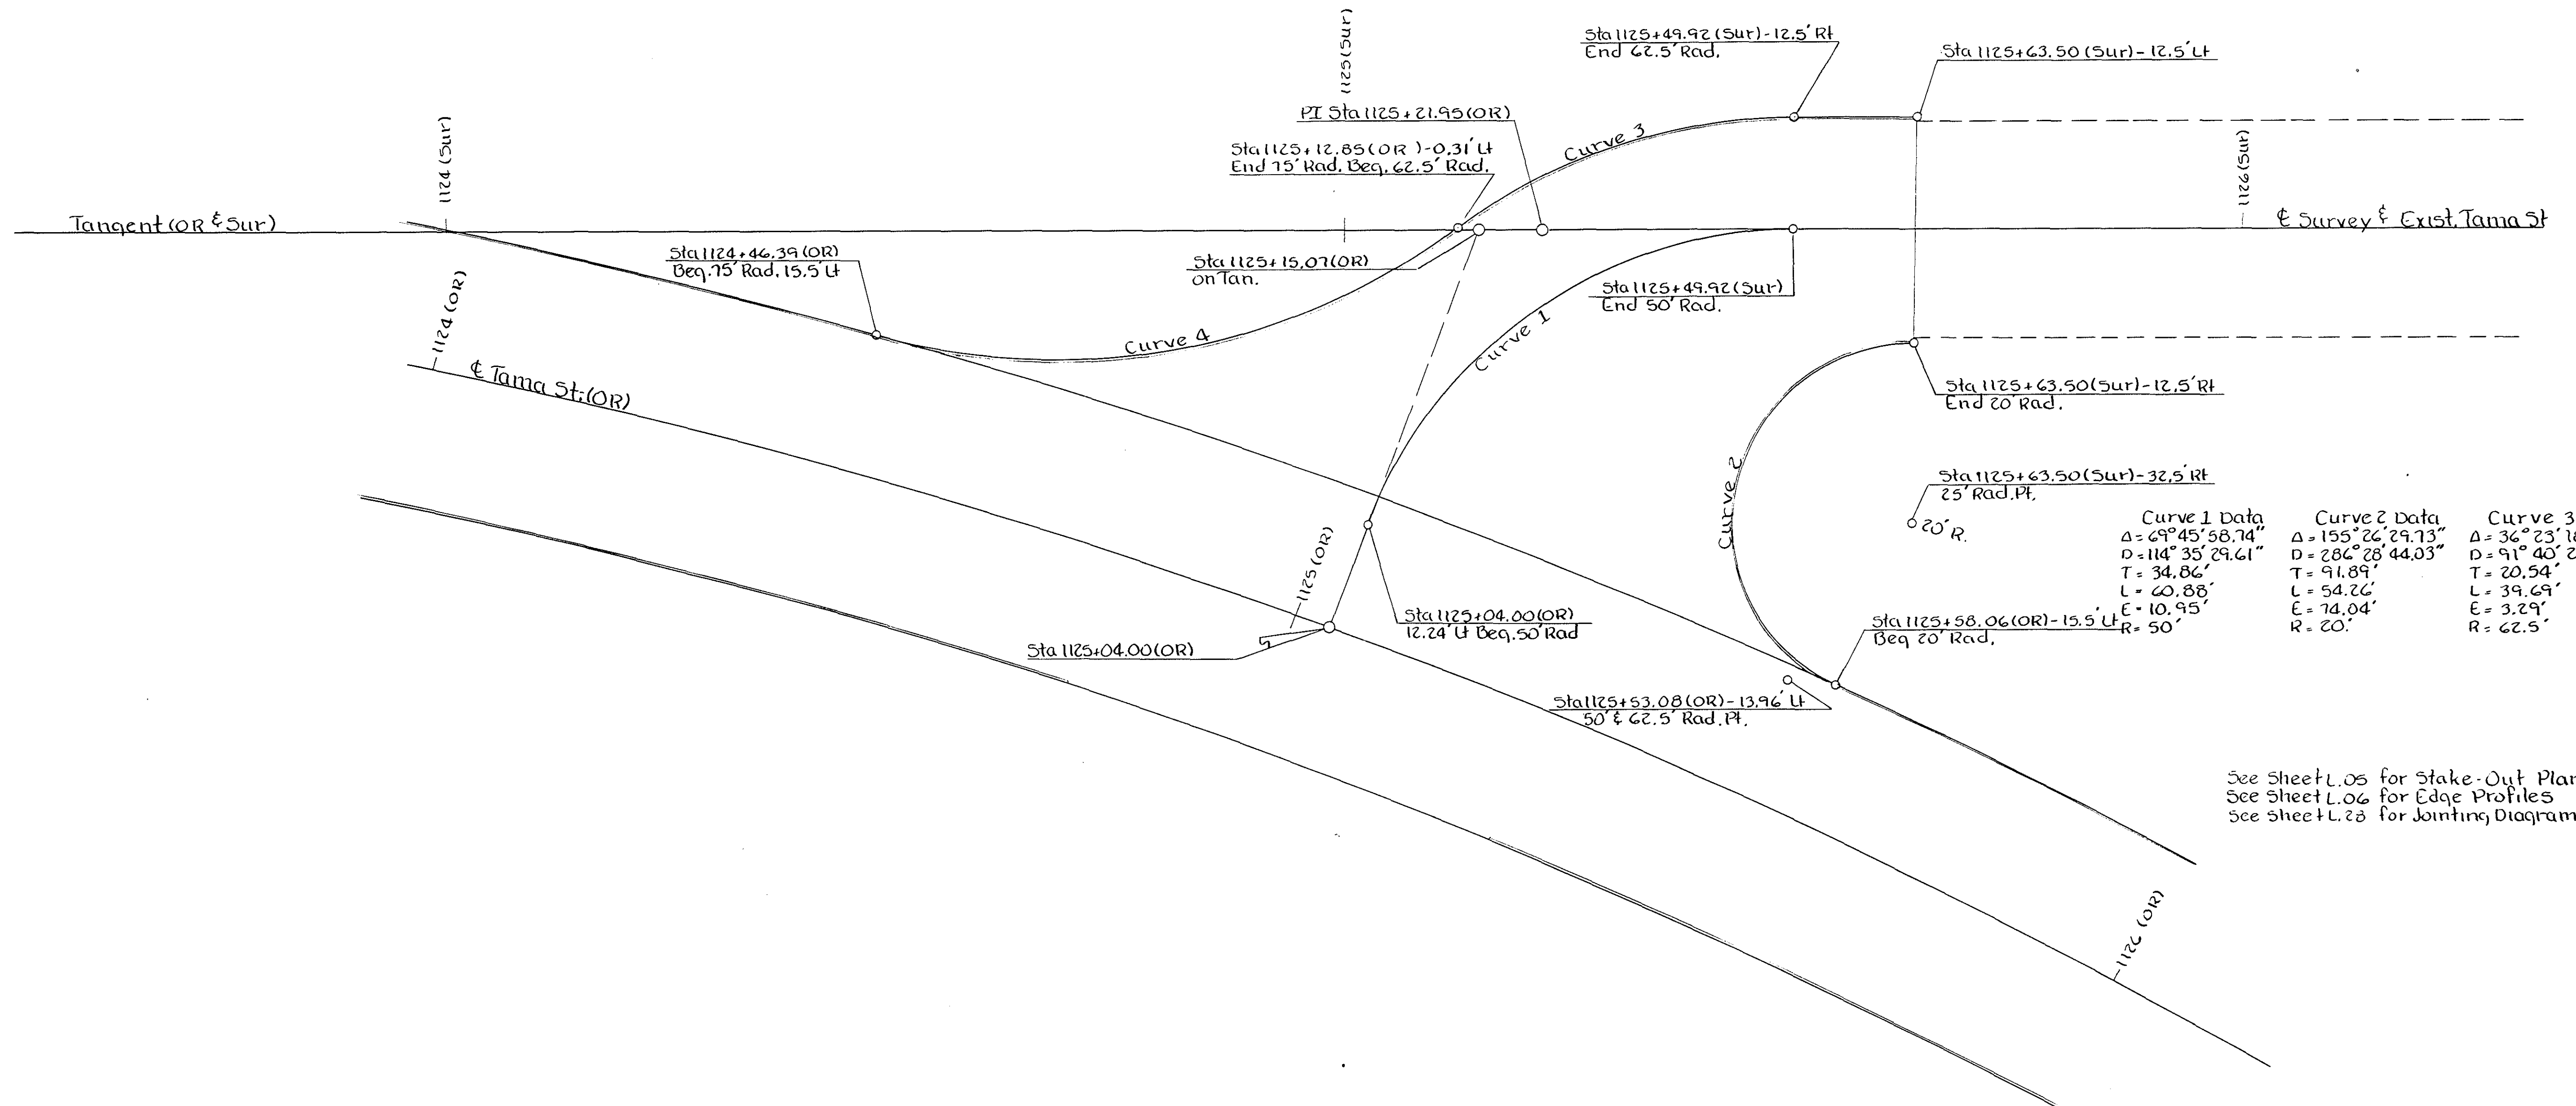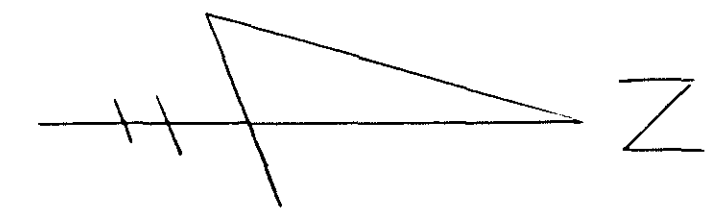



Curve 1 Data
 $\Delta = 69^\circ 45' 58.74''$
 $D = 114^\circ 35' 29.61''$
 $T = 34.86'$
 $L = 60.88'$
 $E = 10.95'$
 $R = 50'$

Curve 2 Data
 $\Delta = 155^\circ 26' 29.73''$
 $D = 286^\circ 28' 44.03''$
 $T = 91.89'$
 $L = 54.26'$
 $E = 74.04'$
 $R = 20'$

Curve 3 Data
 $\Delta = 36^\circ 23' 18.42''$
 $D = 91^\circ 40' 23.69''$
 $T = 20.54'$
 $L = 39.69'$
 $E = 3.29'$
 $R = 62.5'$

See Sheet L.05 for Stake-Out Plan
 See Sheet L.06 for Edge Profiles
 See Sheet L.28 for Jointing Diagram

Geometric Plan of Intersection
 of Prop. Tama St. & Exist. Tama St.
 @ Sta 1125+04.00 (OR) Tama St.
 Scale 1" = 10'

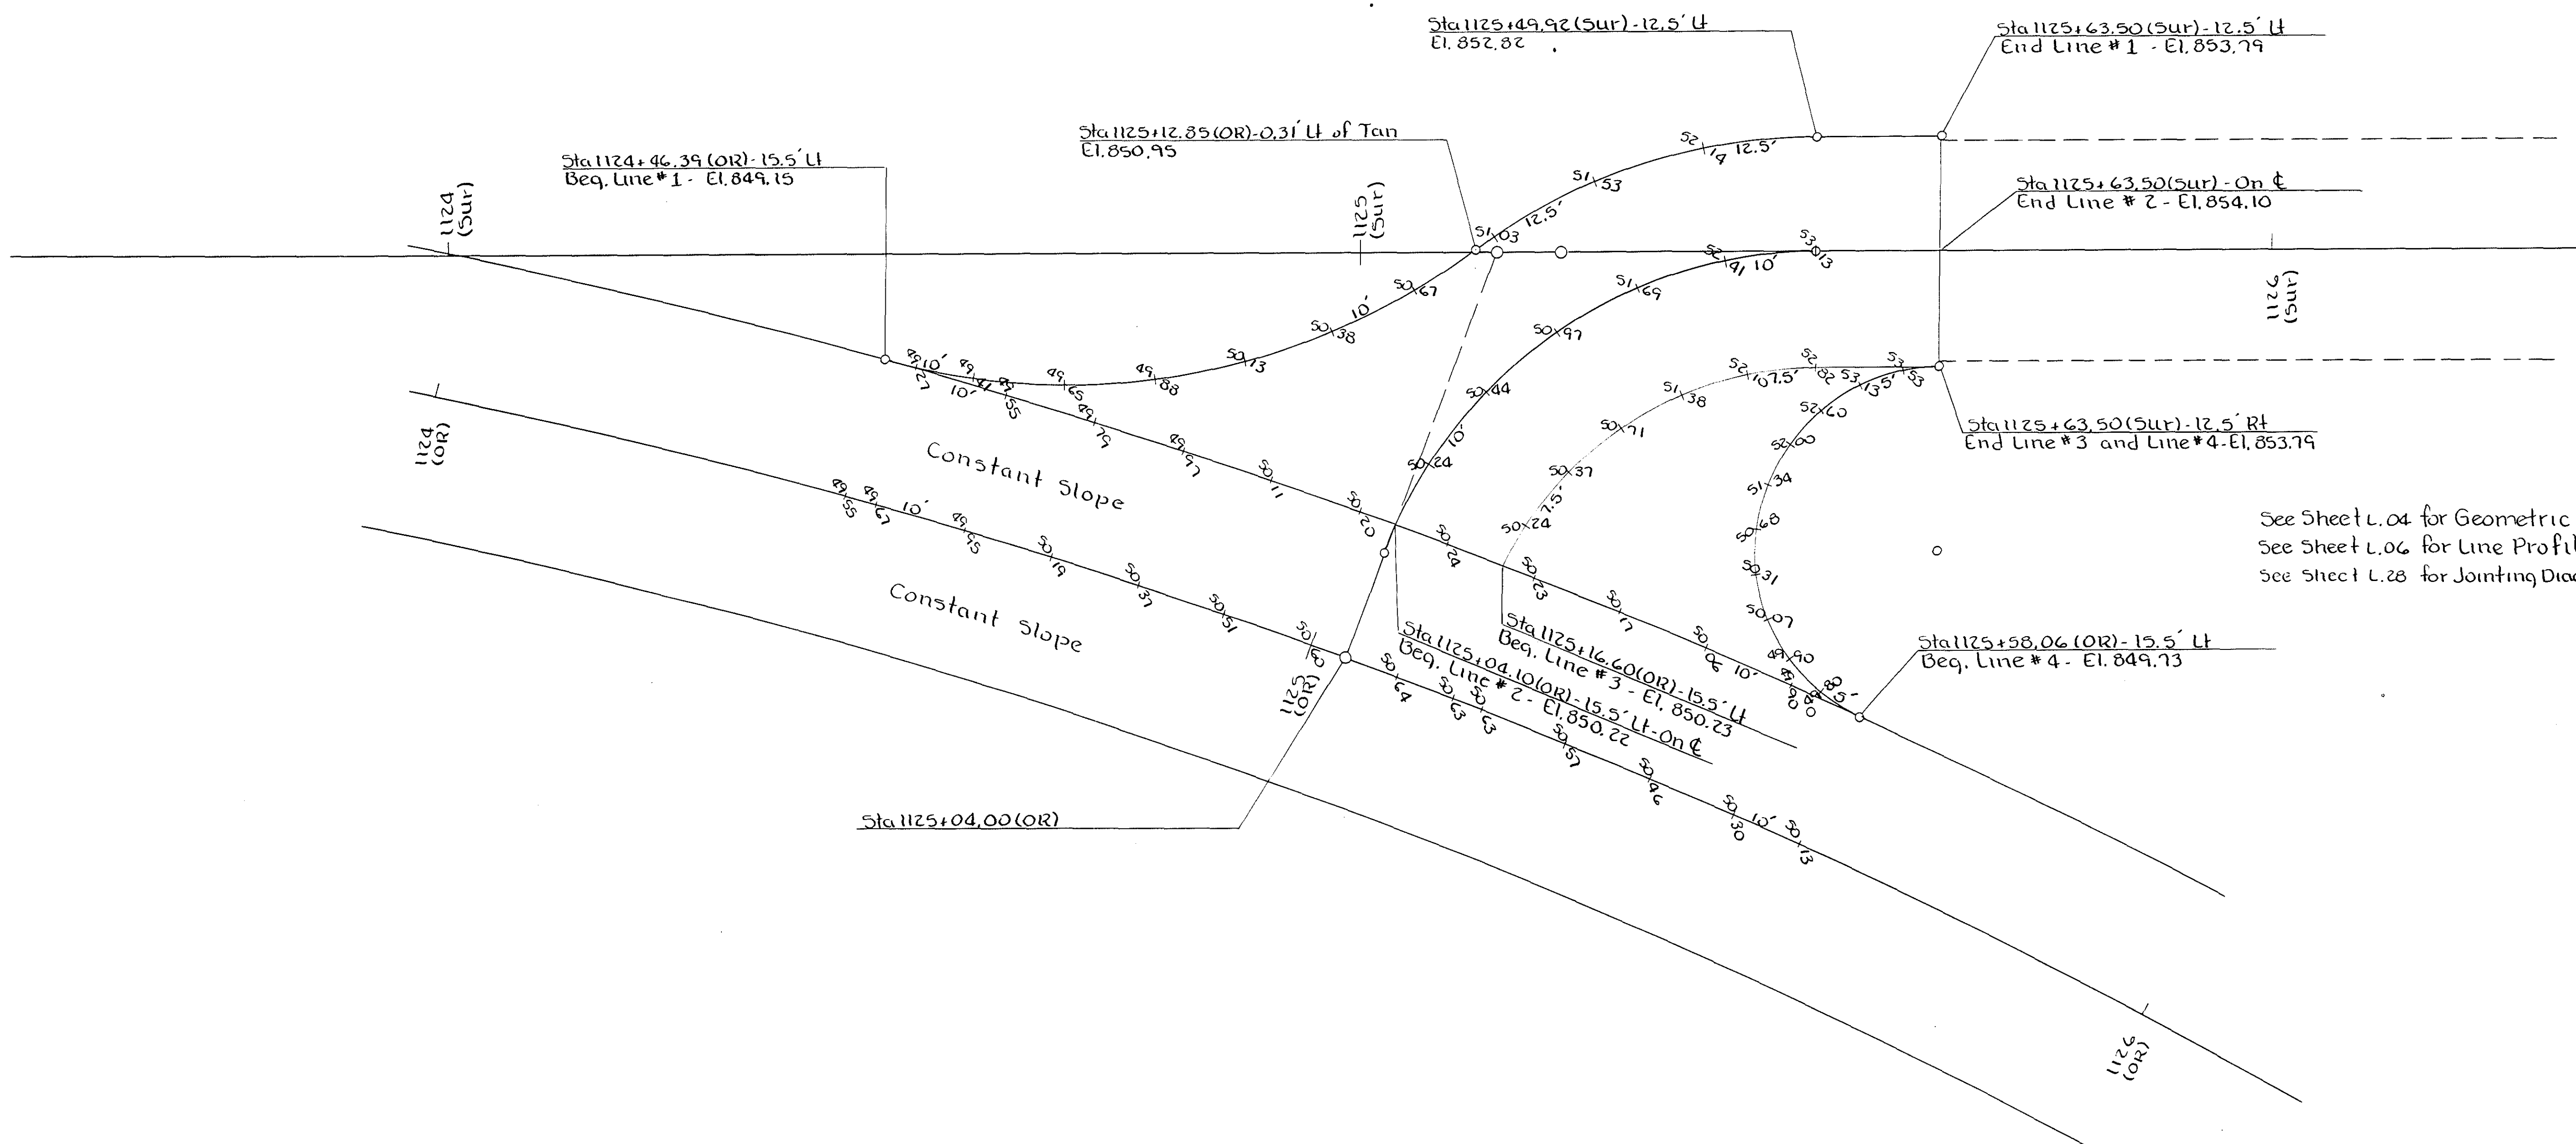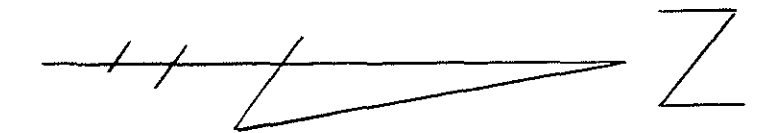


See Sheet L.04 for Geometric Plan
See Sheet L.06 for Line Profiles
See Sheet L.28 for Jointing Diagram

Stake-Out Plan of Intersection of
Proposed Tama St. & Existing Tama St.
at Sta 1125+04.00 (OR)
Scale = 1" = 10'


PLAN	NO.	BOOK	SURVEYED	BY	DATE

PROFILE	NO.	BOOK	SURVEYED	BY	DATE

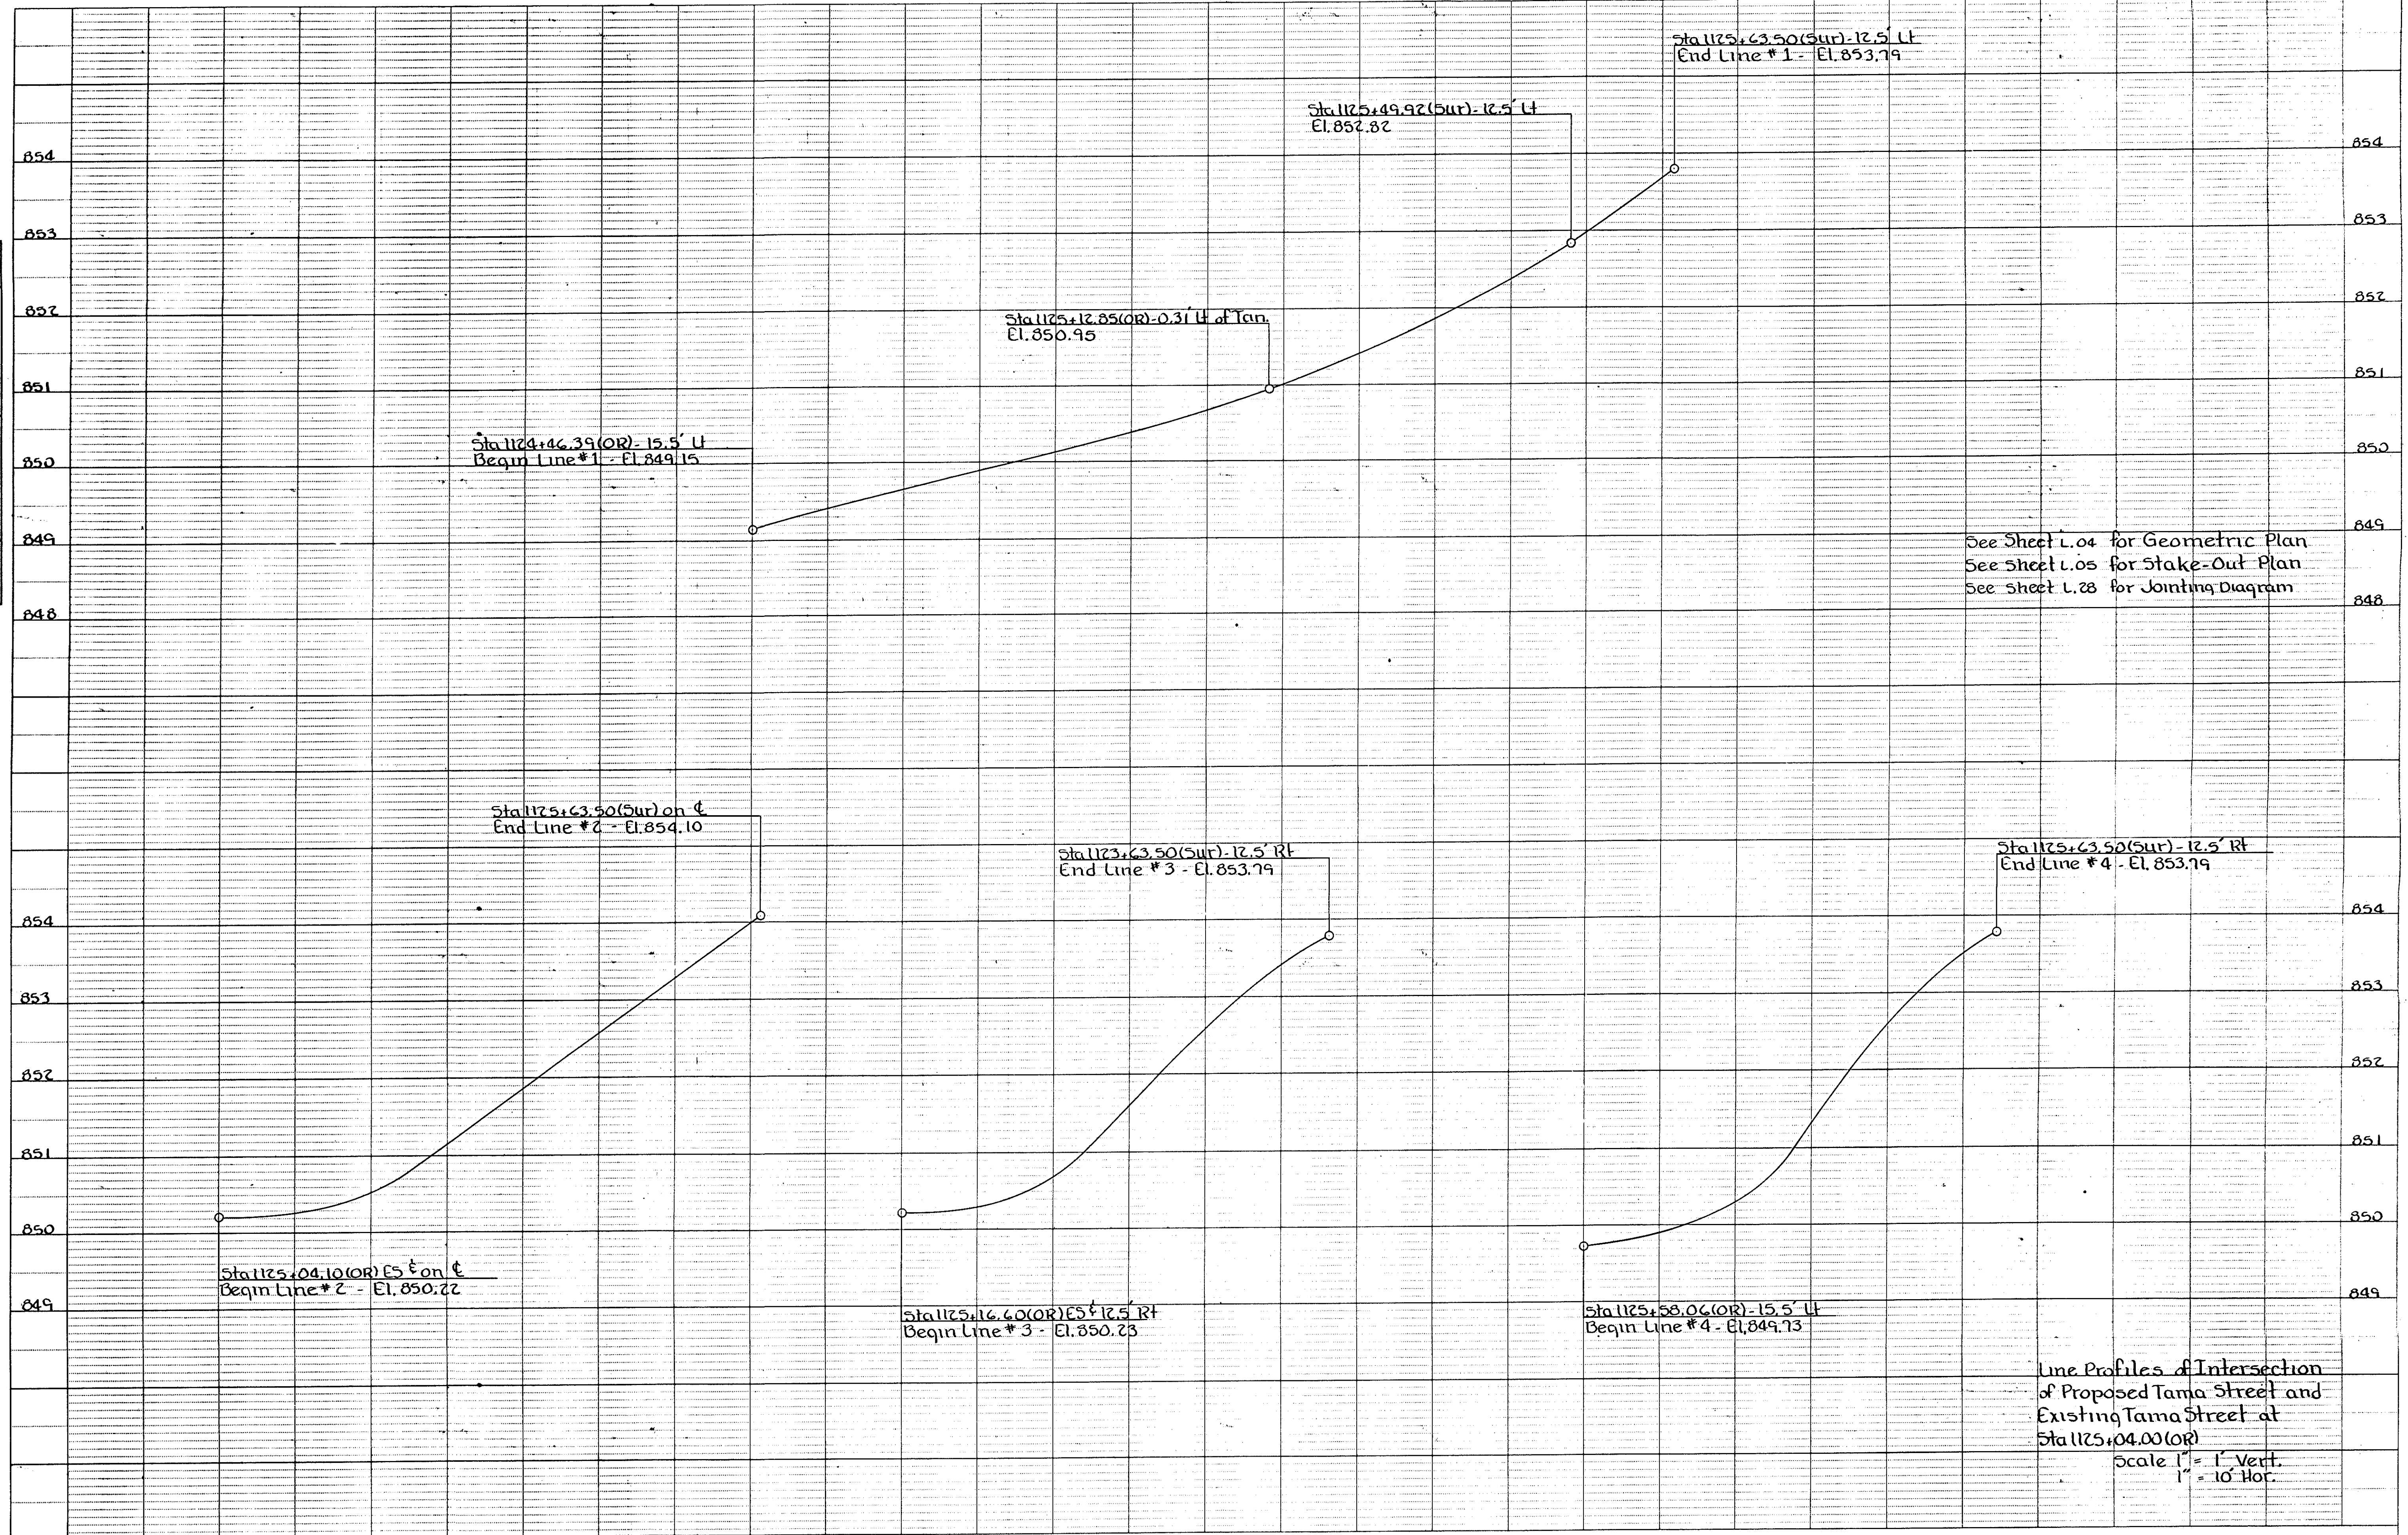

See Sheet L.04 for Geometric Plan
See Sheet L.05 for Stake-Out Plan
See Sheet L.28 for Jointing Diagram

Line Profiles of Intersection
of Proposed Tama Street and
Existing Tama Street at
Sta 1125+04.00 (OR)
Scale 1" = 1' Vert.
1" = 10' Hor.

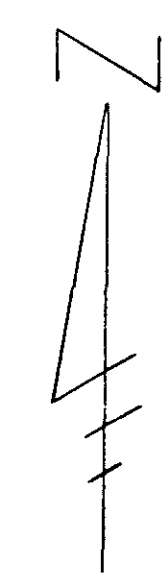


Curve 1 Data
 $\Delta = 20^\circ 36' 34.89''$
 $D = 22^\circ 55' 05.92''$
 $T = 45.45'$
 $L = 89.93'$
 $E = 4.10'$
 $R = 250'$

Curve 2 Data
 $\Delta = 68^\circ 50' 22.97''$
 $D = 127^\circ 19' 26.24''$
 $T = 30.84'$
 $L = 54.07'$
 $E = 9.55'$
 $R = 45'$

Curve 3 Data
 $\Delta = 27^\circ 44' 54.52''$
 $D = 28^\circ 38' 52.40''$
 $T = 49.40'$
 $L = 96.86'$
 $E = 2.01'$
 $R = 200'$


Curve 4 Data
 $\Delta = 51^\circ 22' 51.34''$
 $D = 143^\circ 14' 22.02''$
 $T = 19.24'$
 $L = 35.87'$
 $E = 4.39'$
 $R = 40'$

See Sheet L.08 for Stake-Out Plan
See Sheet L.09 for Stake-Out Plan
See Sheet L.14 for Edge Profiles
See Sheet L.15 for Edge Profiles
See Sheet L.12 for Stake-Out Plan South
See Sheet L.13 for Stake-Out Plan North
See Sheet L.10 for Geometric Plan South
See Sheet L.11 for Geometric Plan North
See Sheet L.29 for Joining Diagram

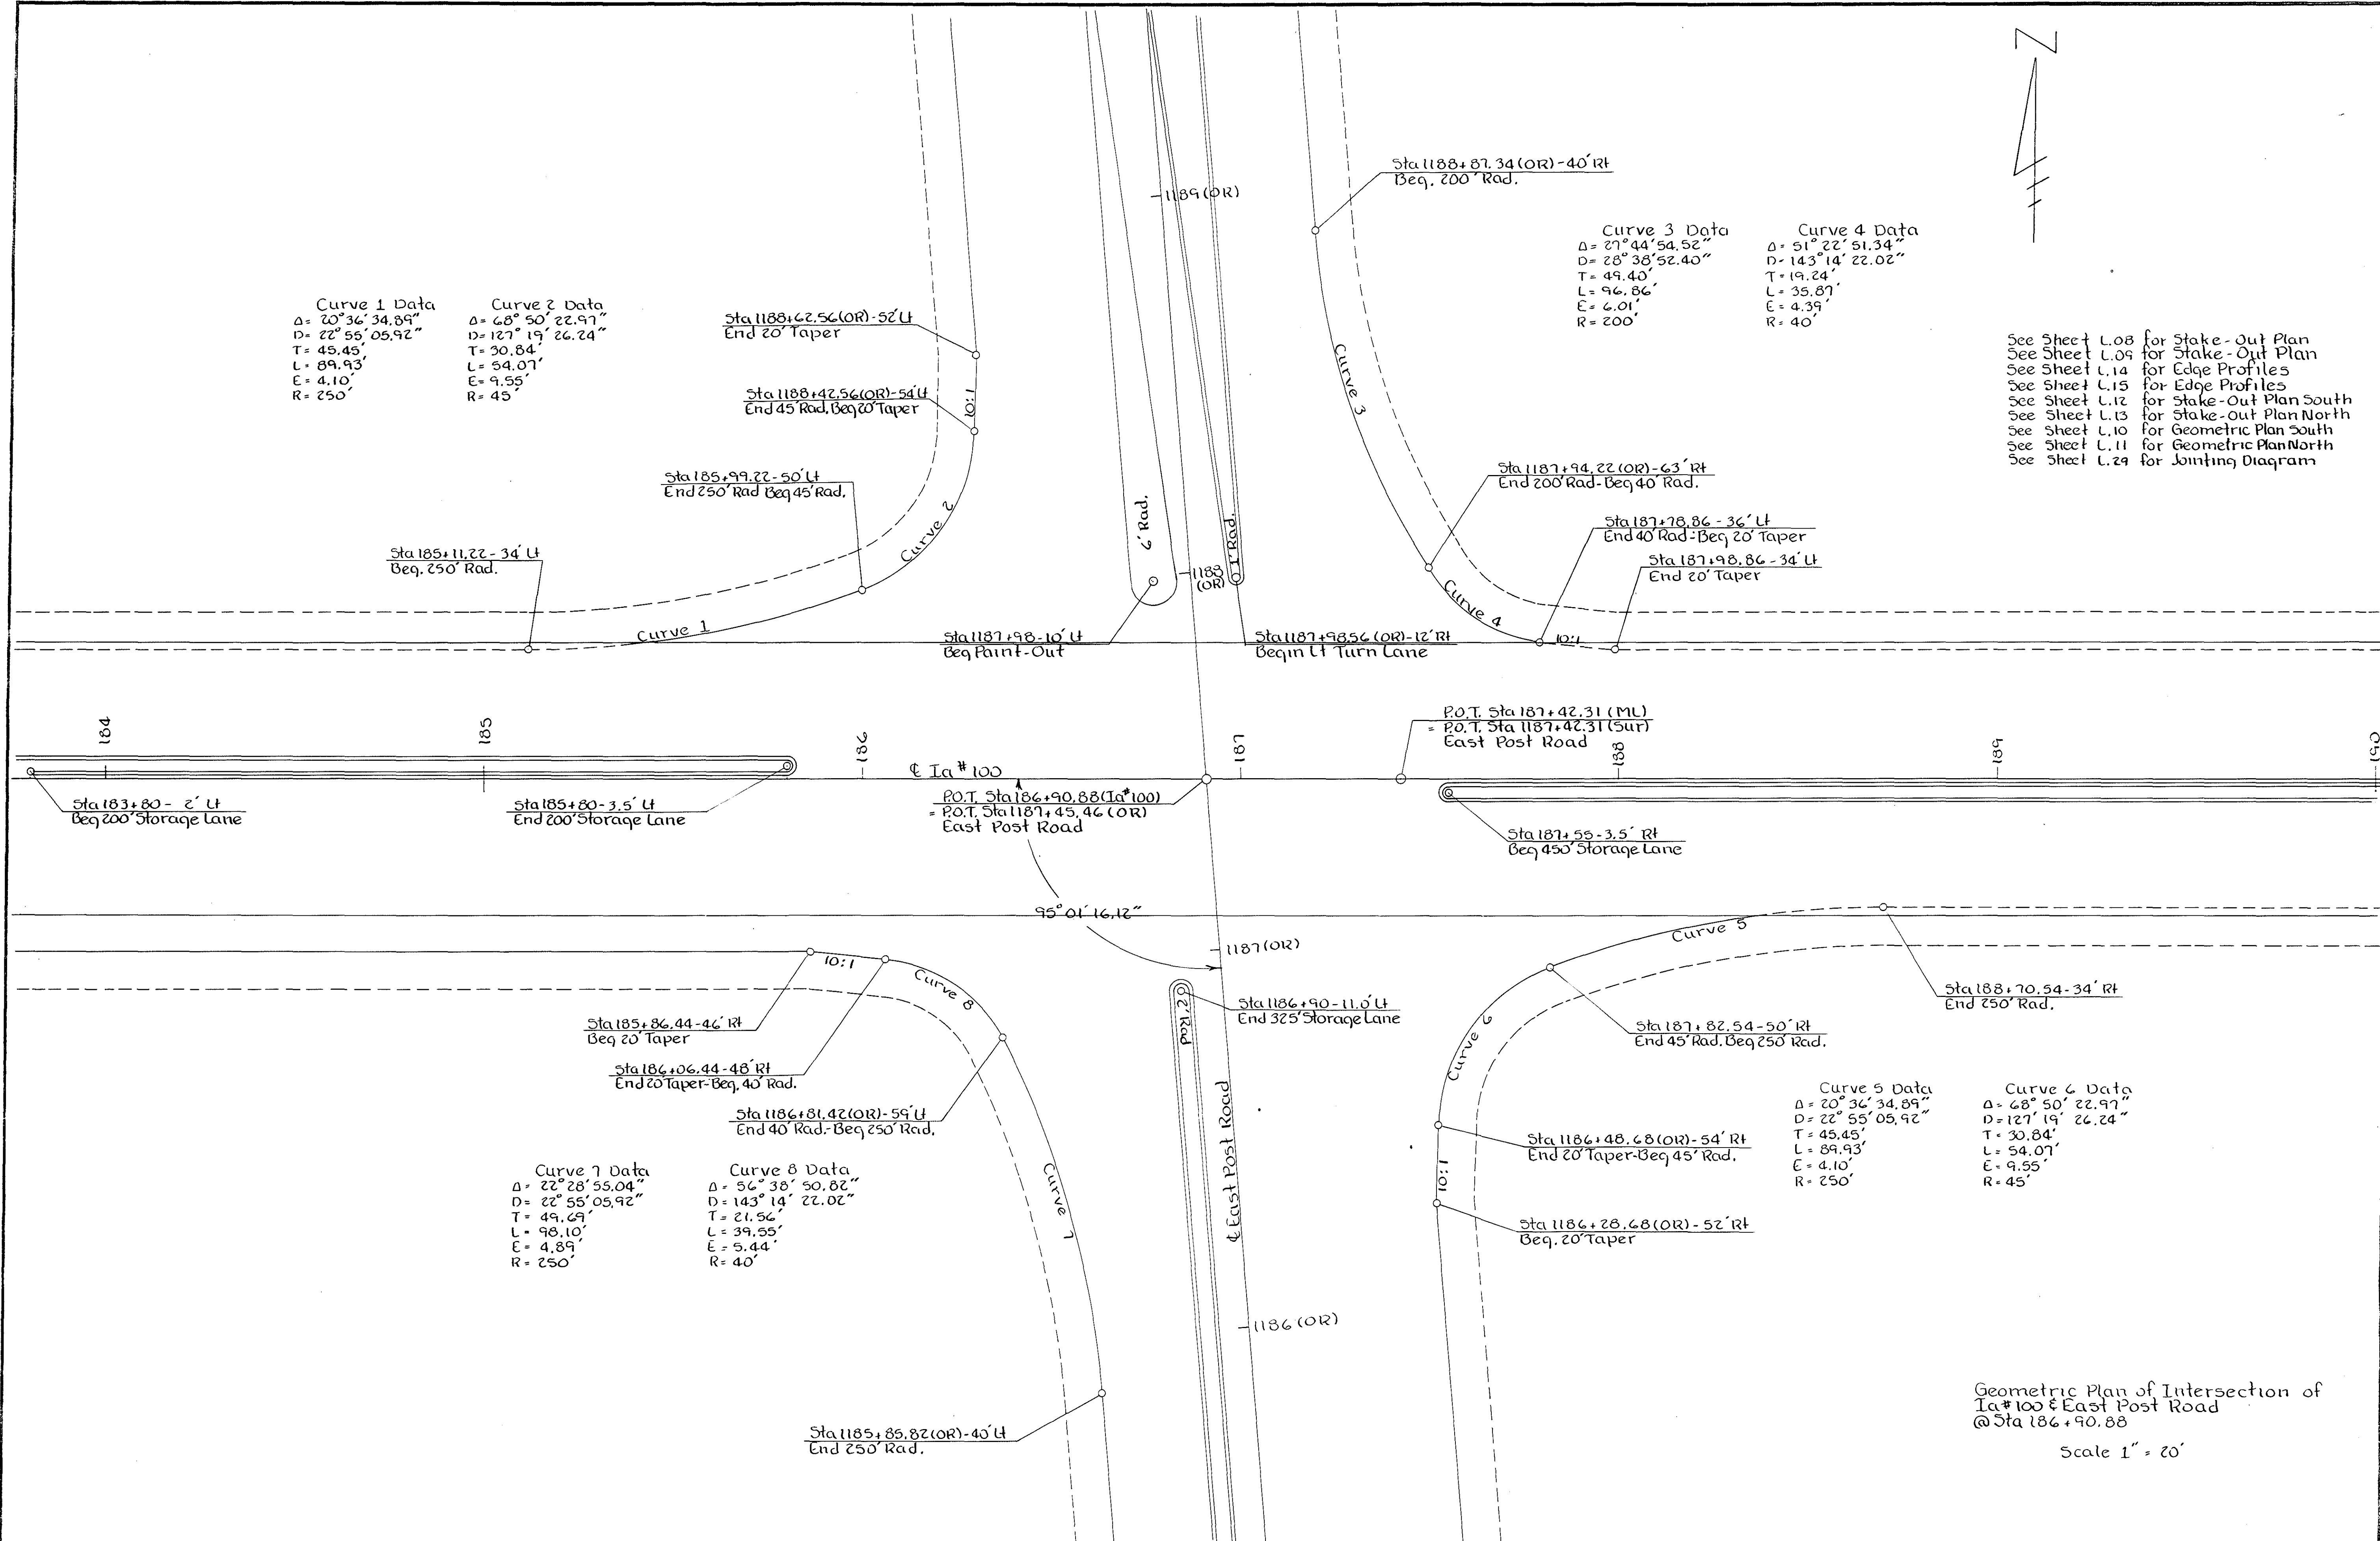

Geometric Plan of Intersection of
Ia#100 & East Post Road
@ Sta 186+90.88
Scale 1" = 20'


P. 82

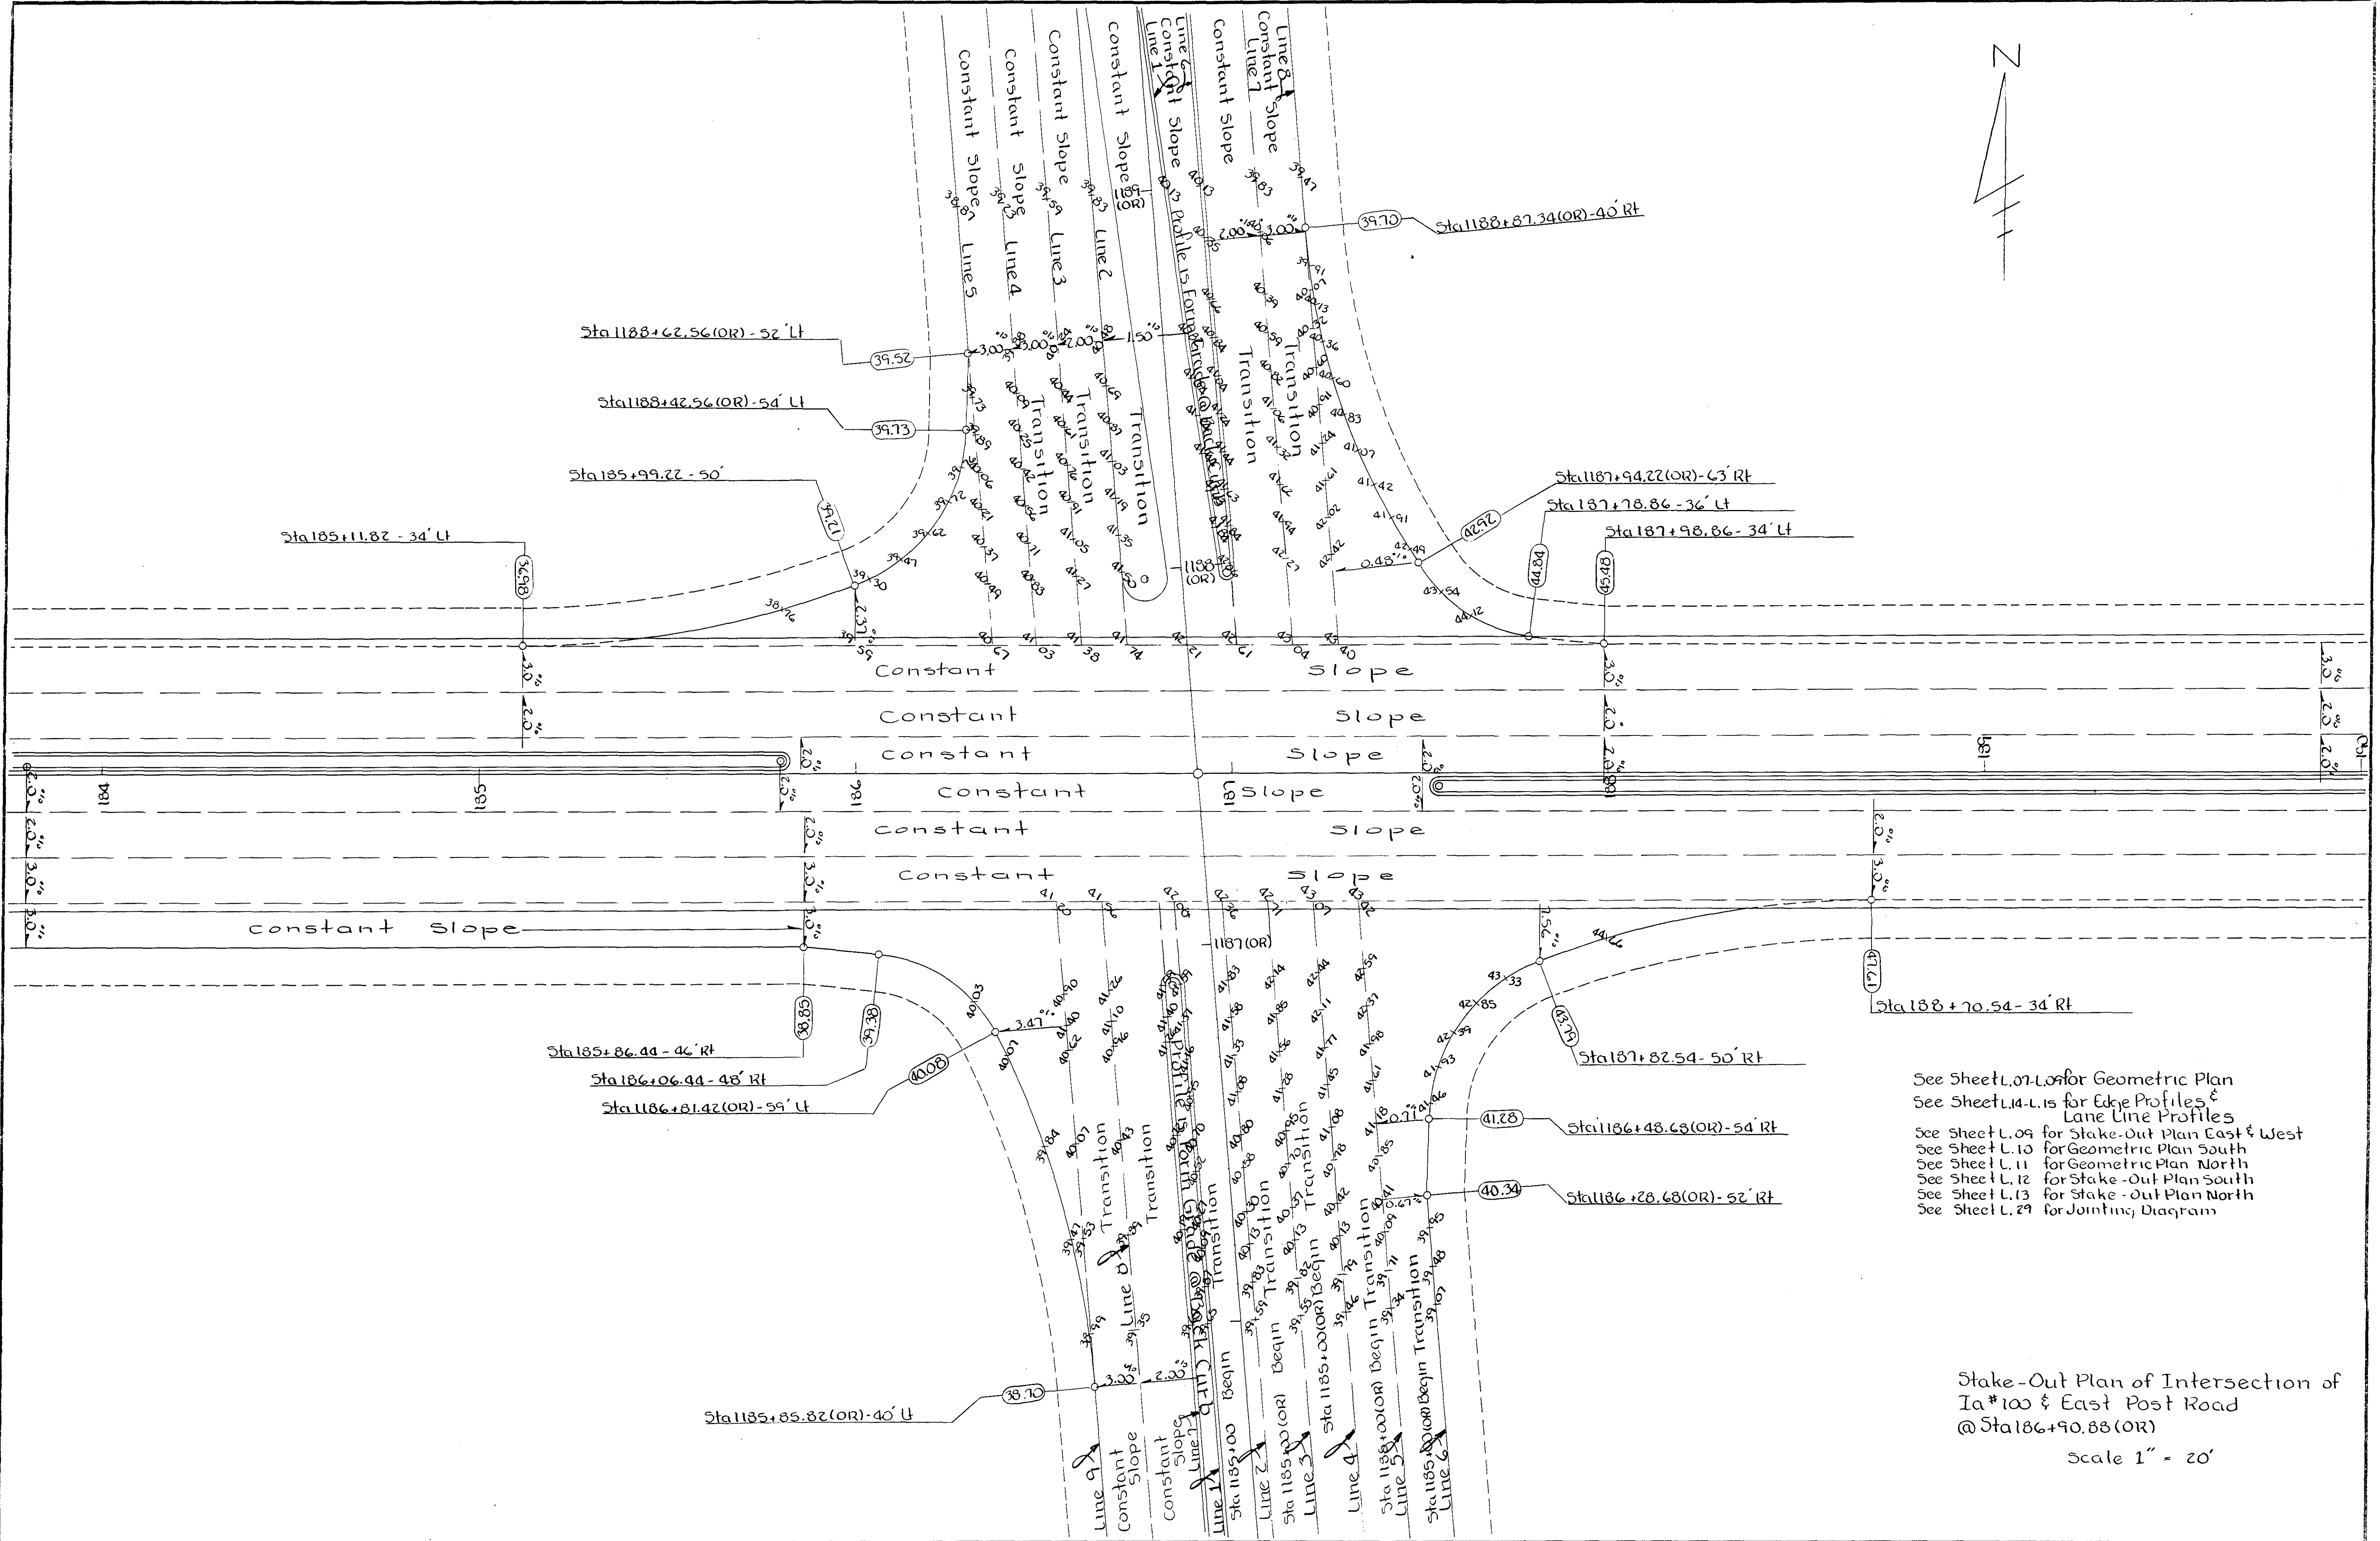


See Sheet L.07 for Geometric Plan
See Sheet L.14-L.15 for Edge Profiles &
Lane Line Profiles
See Sheet L.09 for Stake-Out Plan East & West
See Sheet L.10 for Geometric Plan South
See Sheet L.11 for Geometric Plan North
See Sheet L.12 for Stake-Out Plan North
See Sheet L.13 for Stake-Out Plan South
See Sheet L.29 for Jointing Diagram

Stake-Out Plan of Intersection of
Ia #100 & East Post Road
@ Sta 1186+90.88(OR)
Scale 1" = 20'


P.03

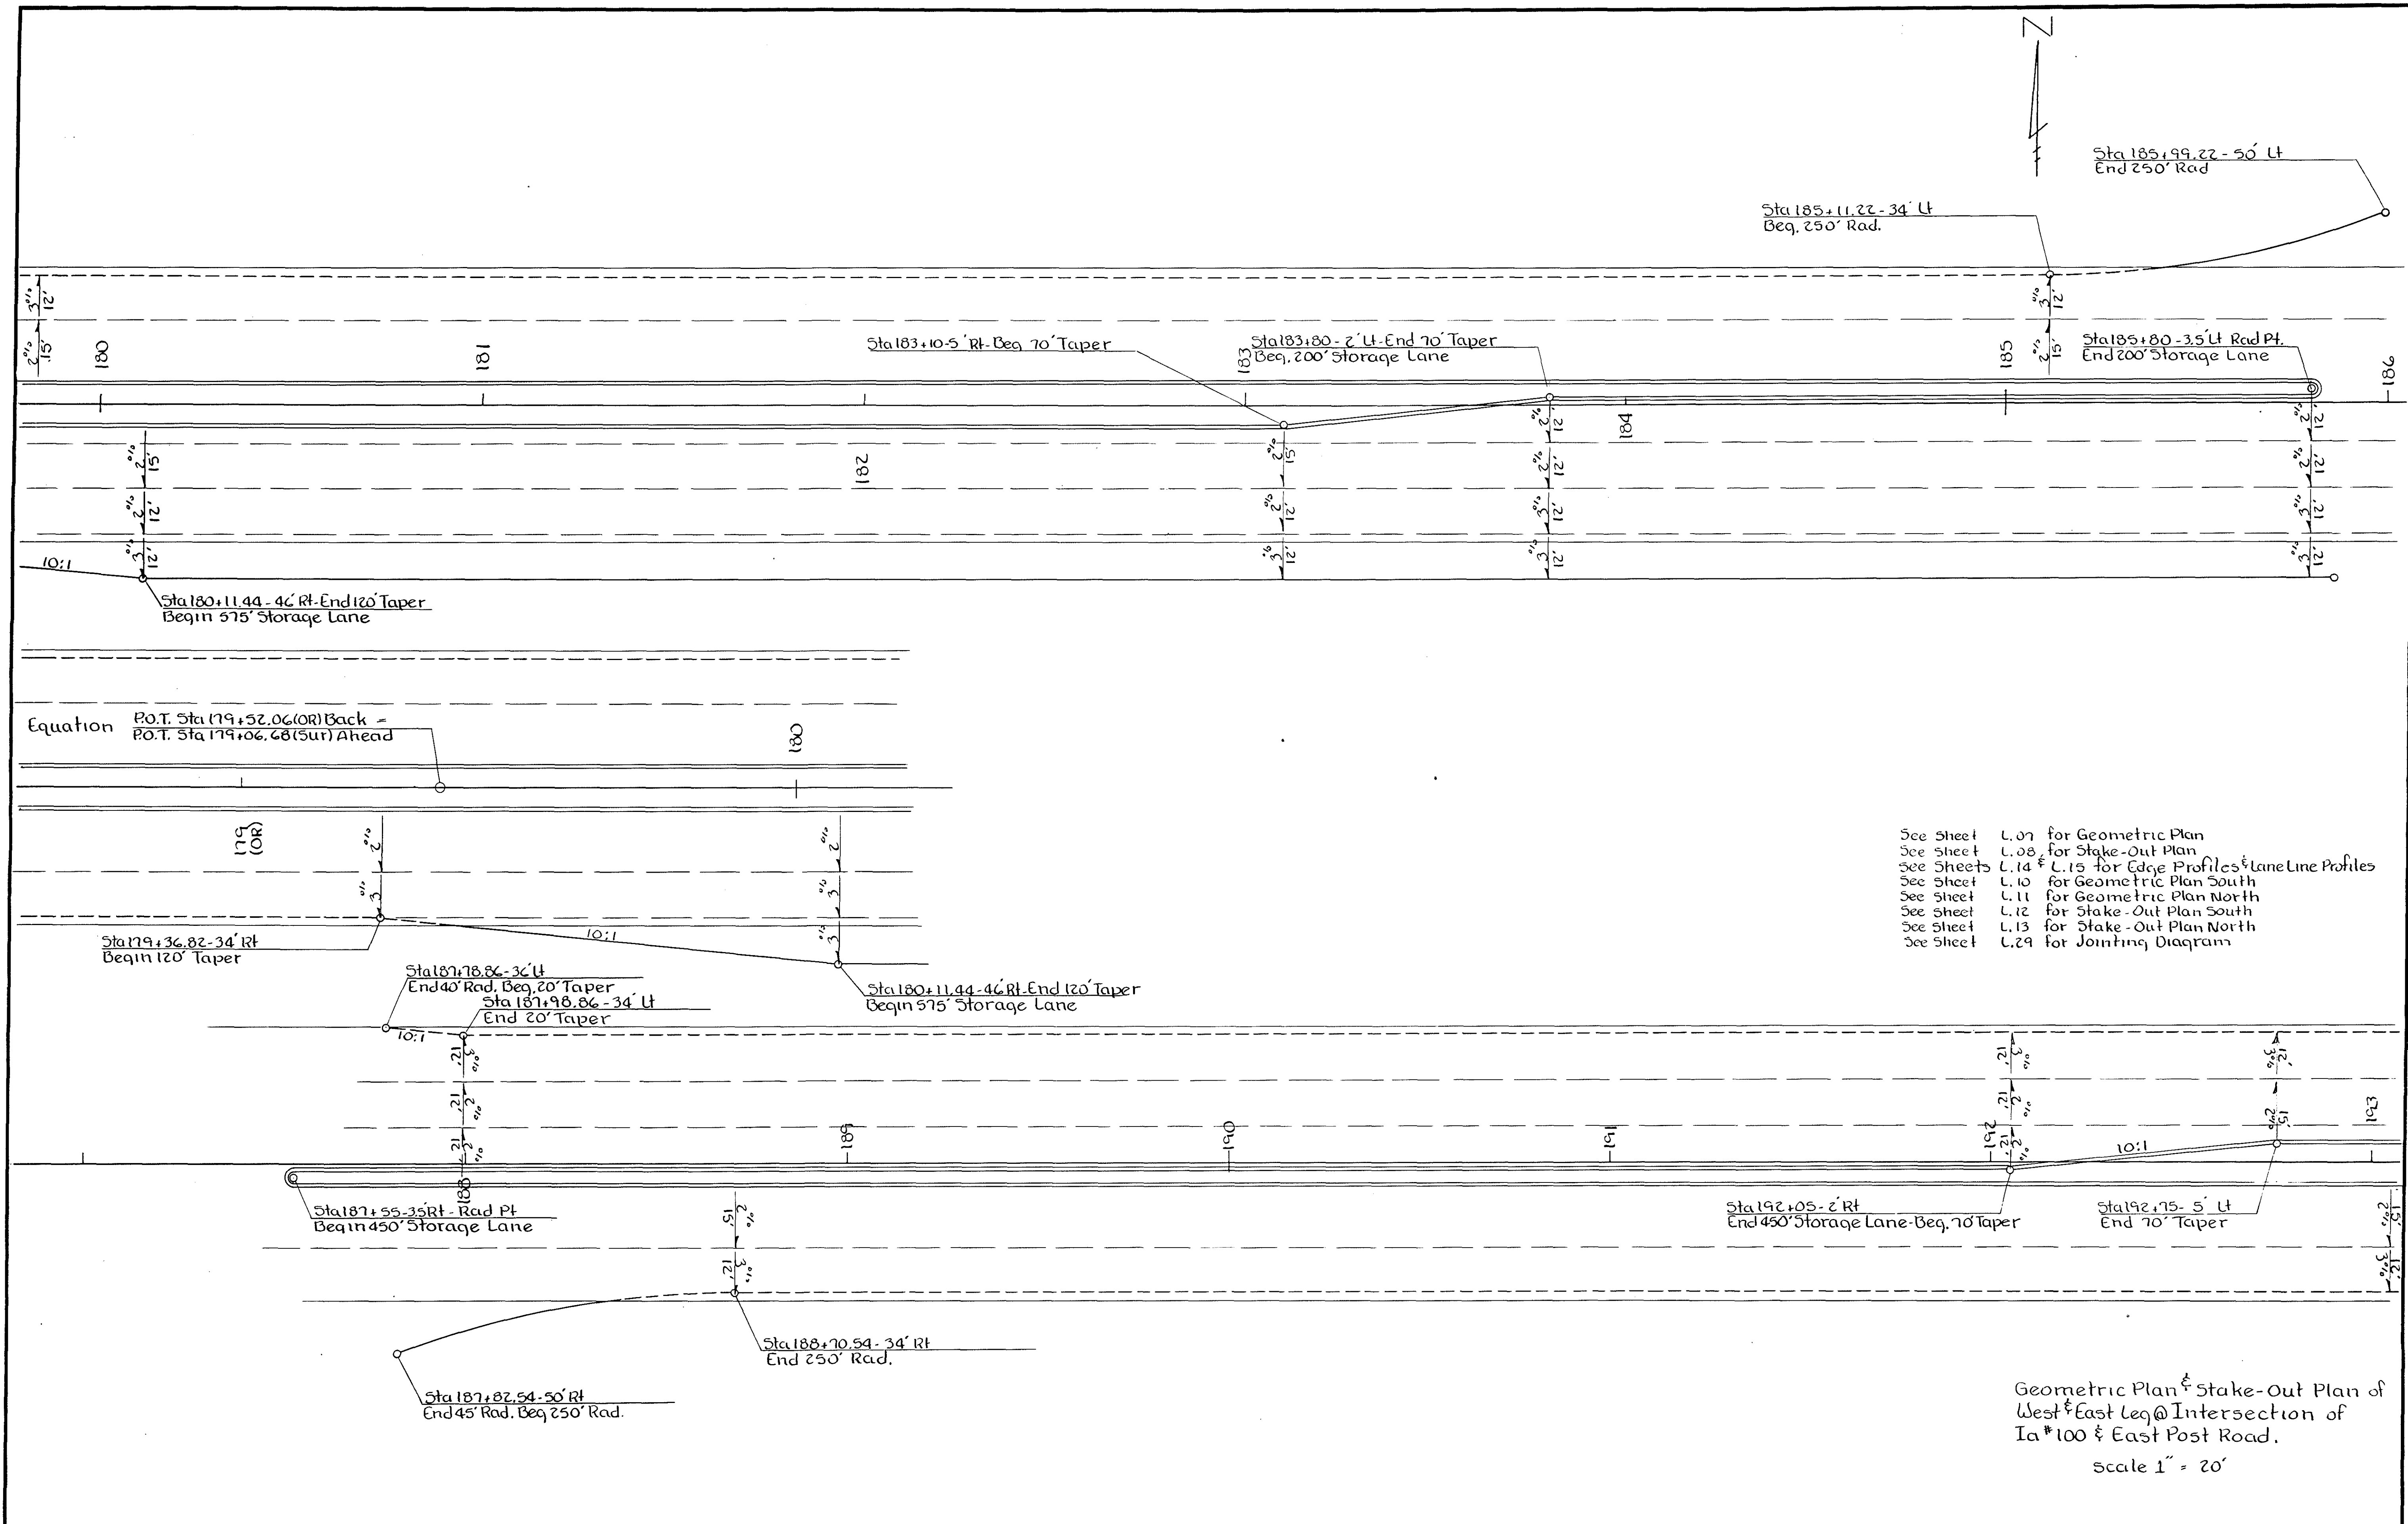

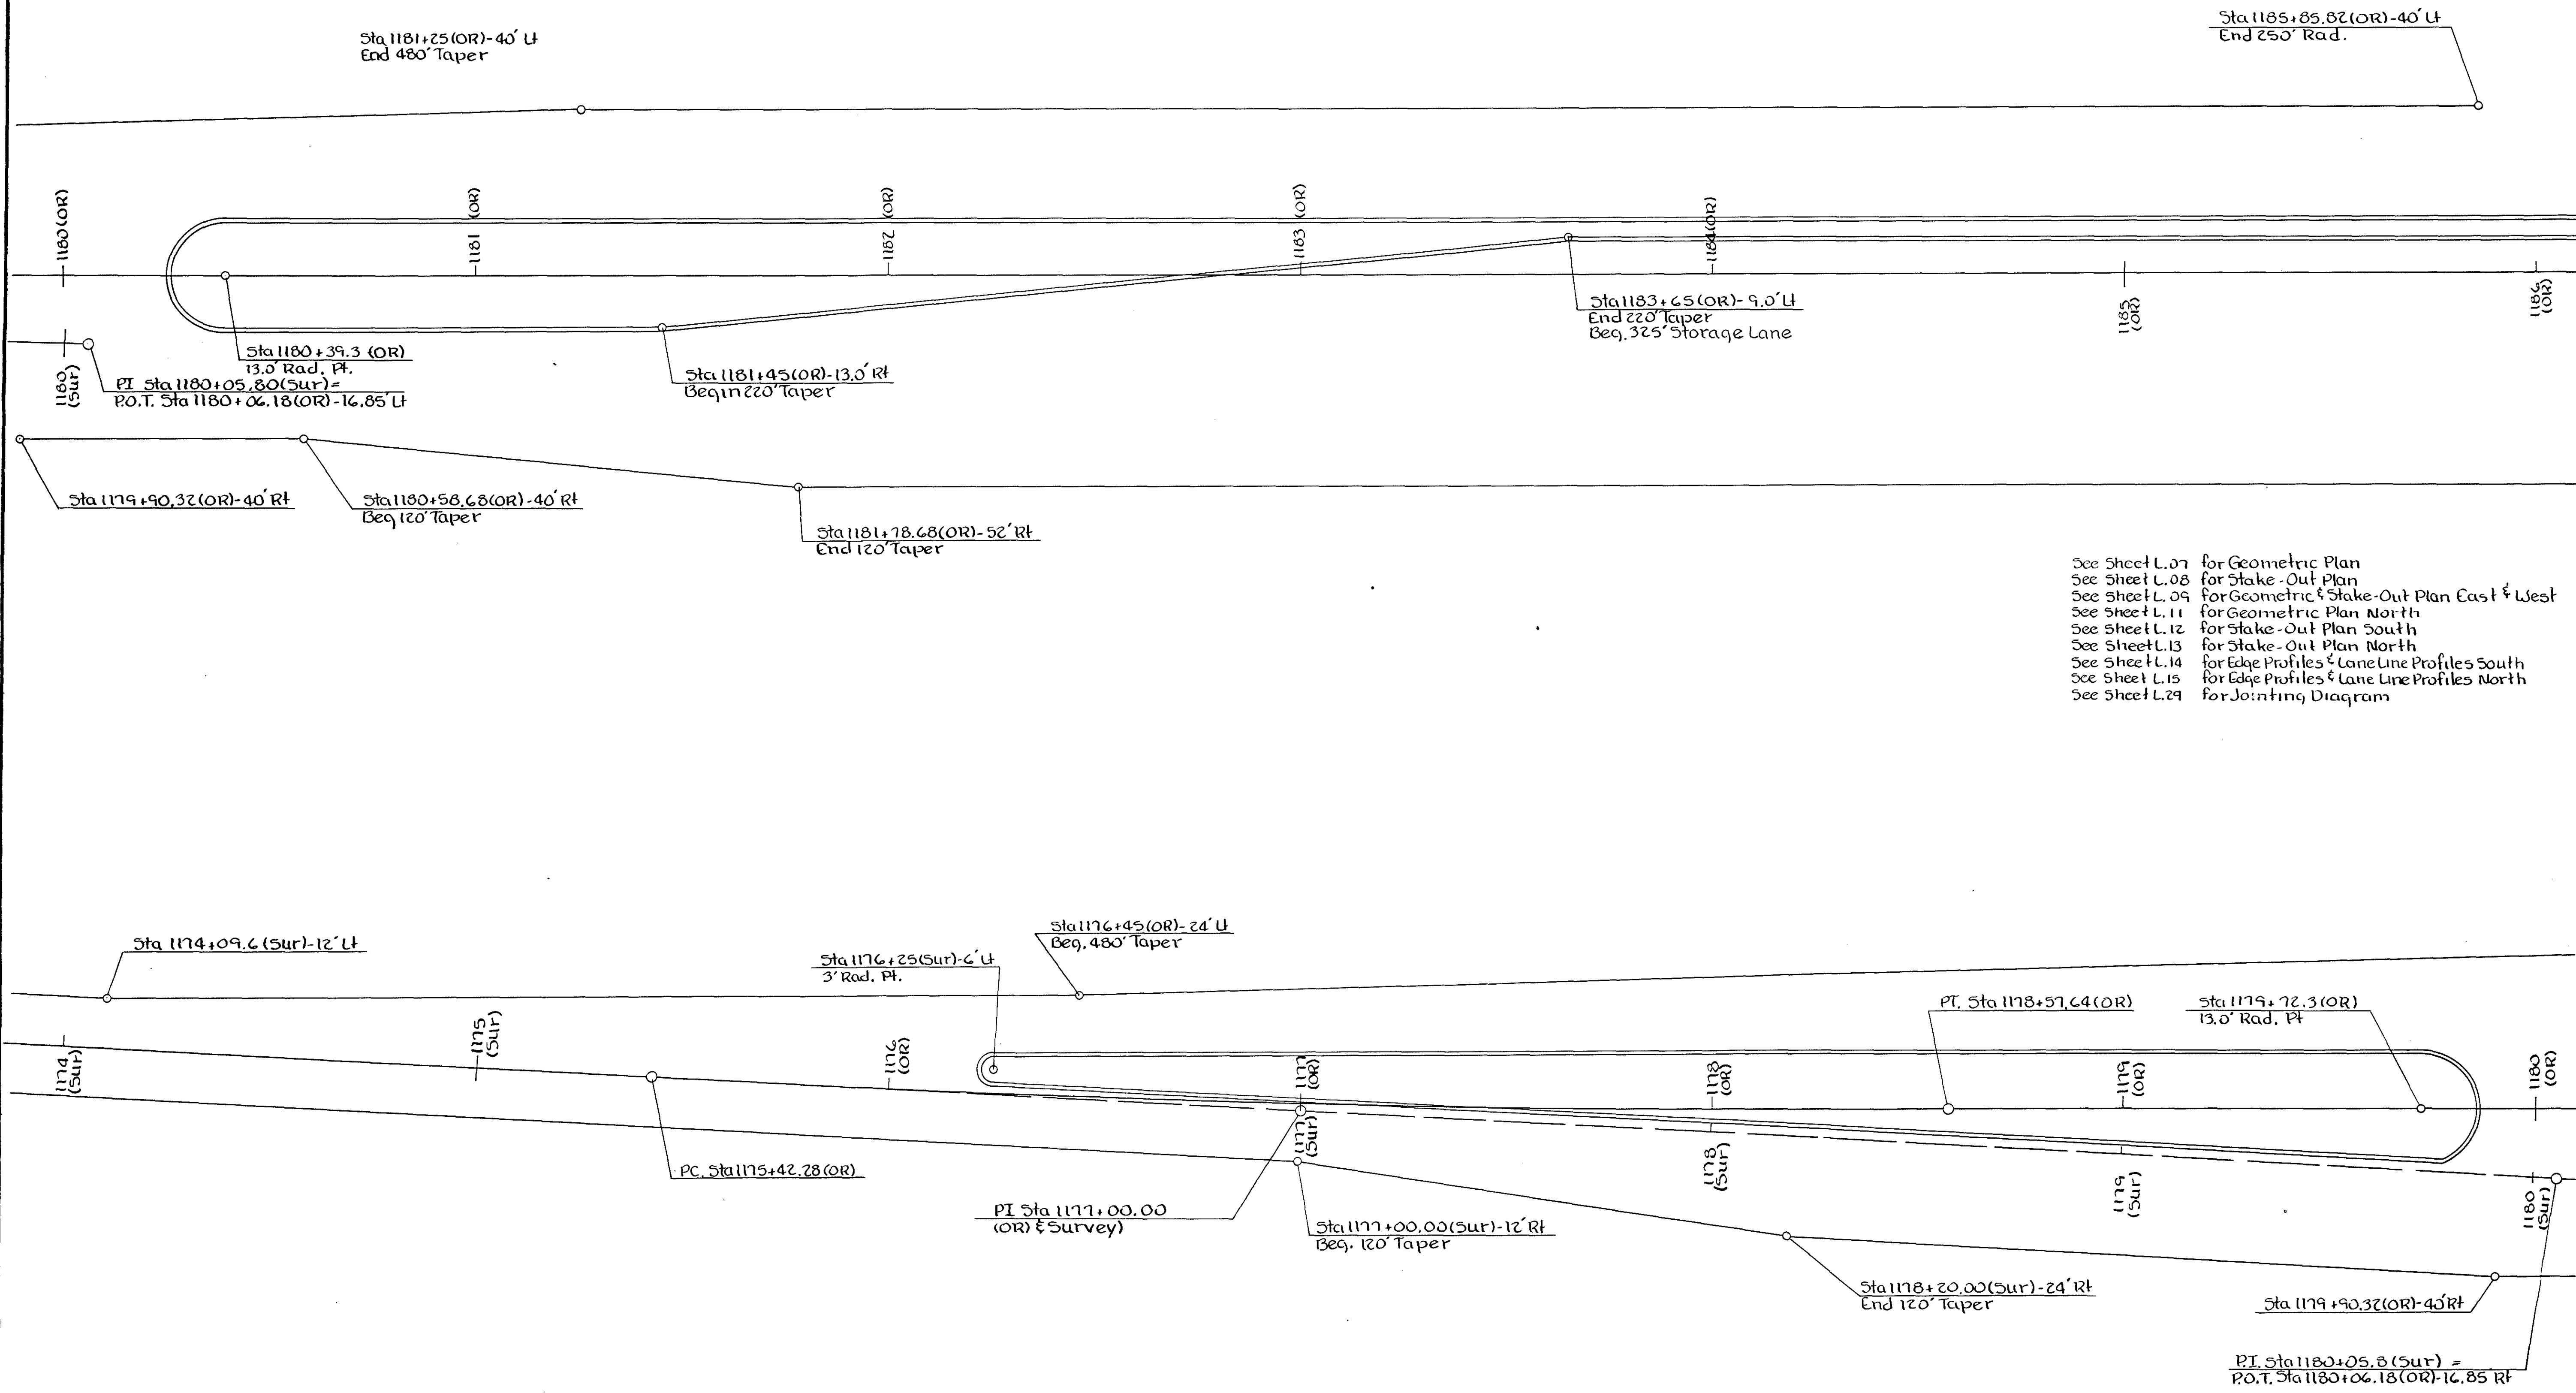


See Sheet L.07 for Geometric Plan
See Sheet L.08 for Stake-Out Plan
See Sheet L.09 for Geometric & Stake-Out Plan East & West
See Sheet L.11 for Geometric Plan North
See Sheet L.12 for Stake-Out Plan South
See Sheet L.13 for Stake-Out Plan North
See Sheet L.14 for Edge Profiles & Lane Line Profiles South
See Sheet L.15 for Edge Profiles & Lane Line Profiles North
See Sheet L.29 for Joining Diagram



Geometric Plan of East Post Road
South of Ia # 100 ML,
Scale 1" = 20'

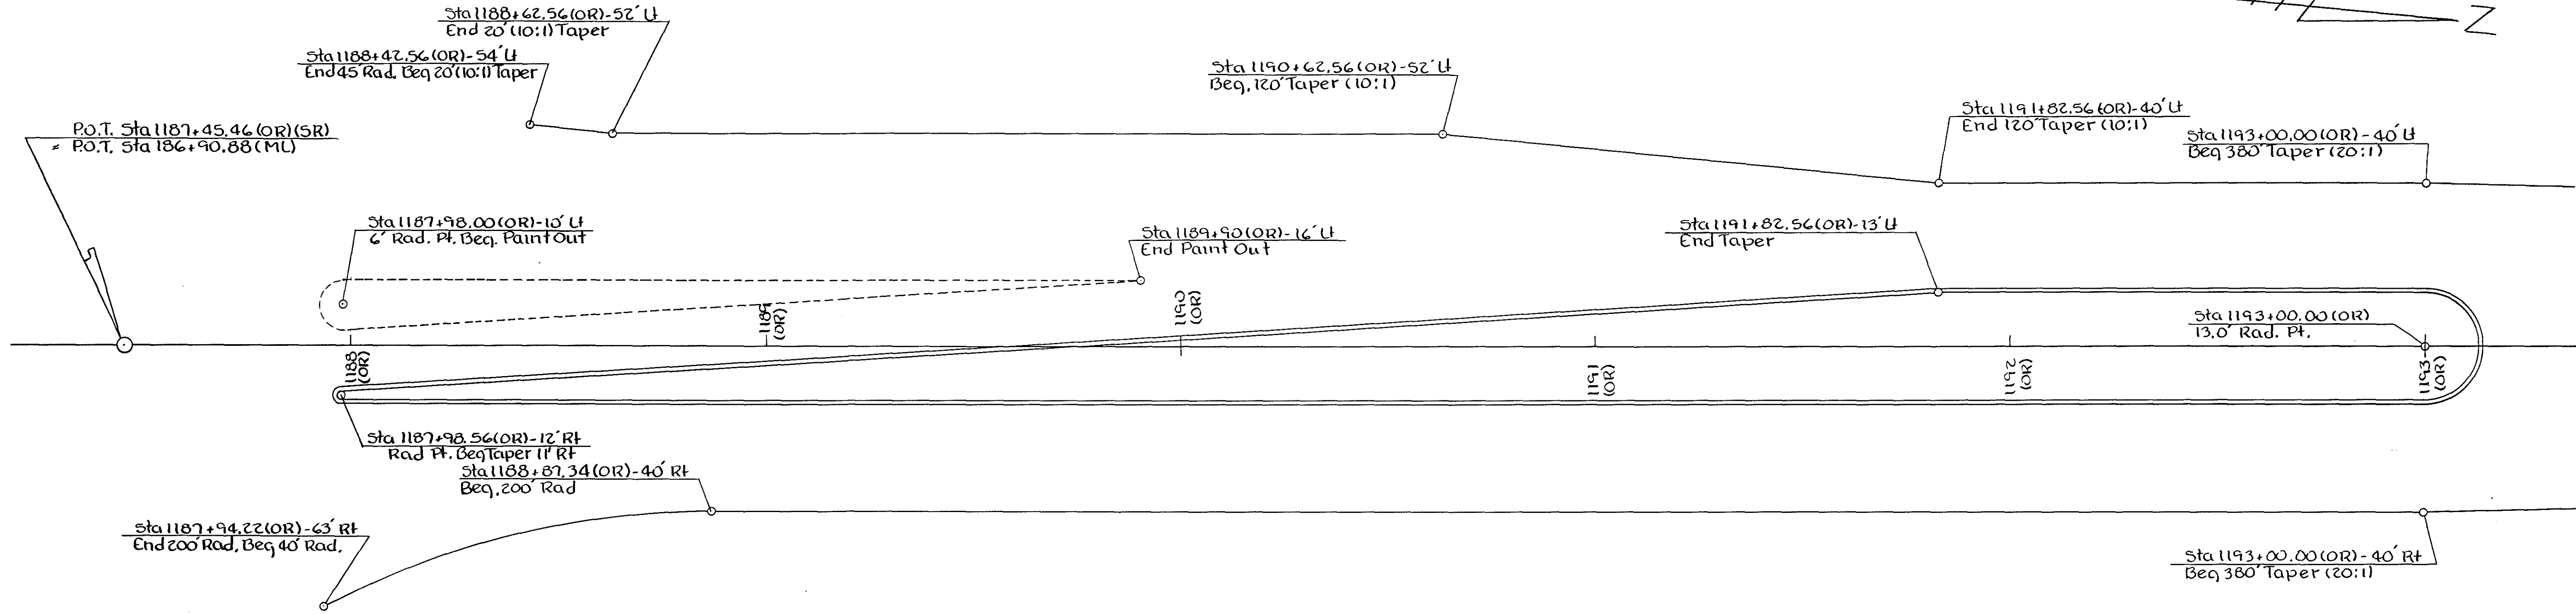

See Sheet L.07 for Geometric Plan
 See Sheet L.08 for Stake-Out Plan
 See Sheet L.09 for Geometric & Stake-Out Plan East & West
 See Sheet L.10 for Geometric Plan South
 See Sheet L.12 for Stake-Out Plan South
 See Sheet L.13 for Stake-Out Plan North
 See Sheet L.14 for Edge Profiles & Lane Line Profiles South
 See Sheet L.15 for Edge Profiles & Lane Line Profiles North
 See Sheet L.29 for Jointing Diagram

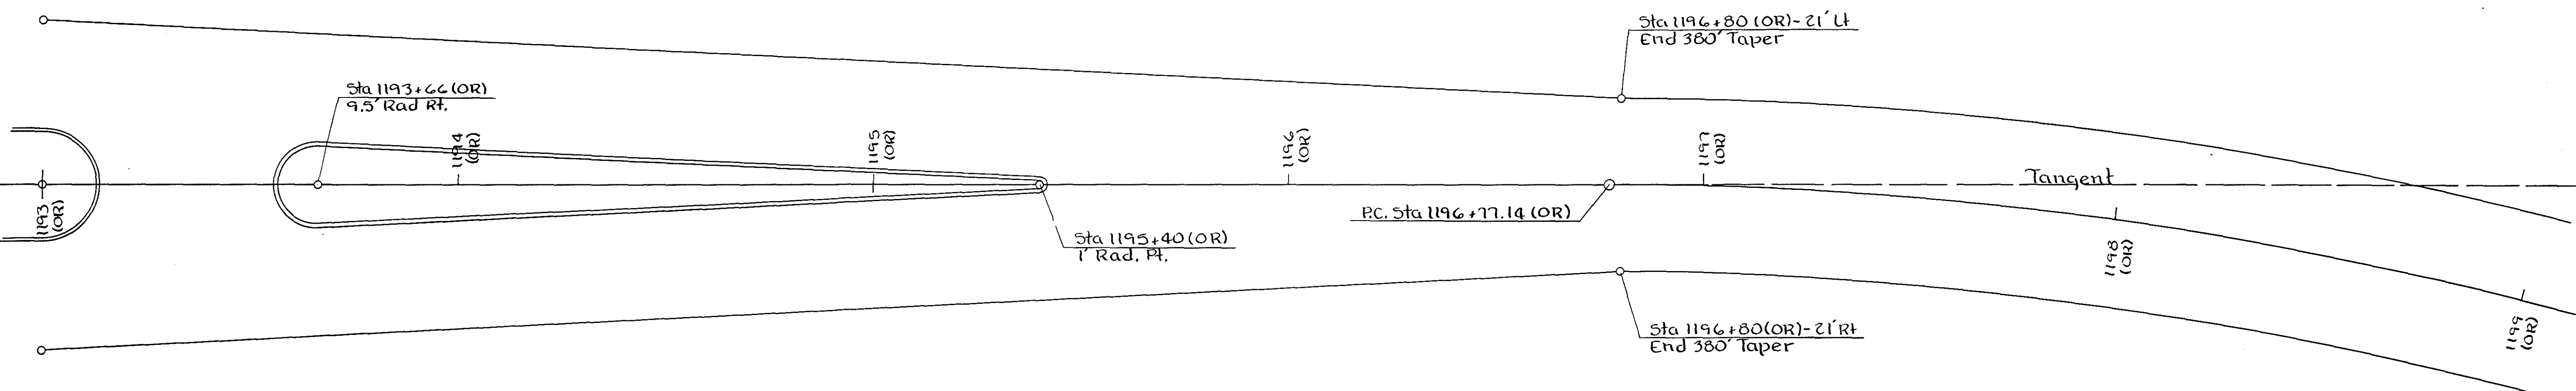


Geometric Plan of East Post Road
 North of Ia#100 ML
 Scale 1" = 20'

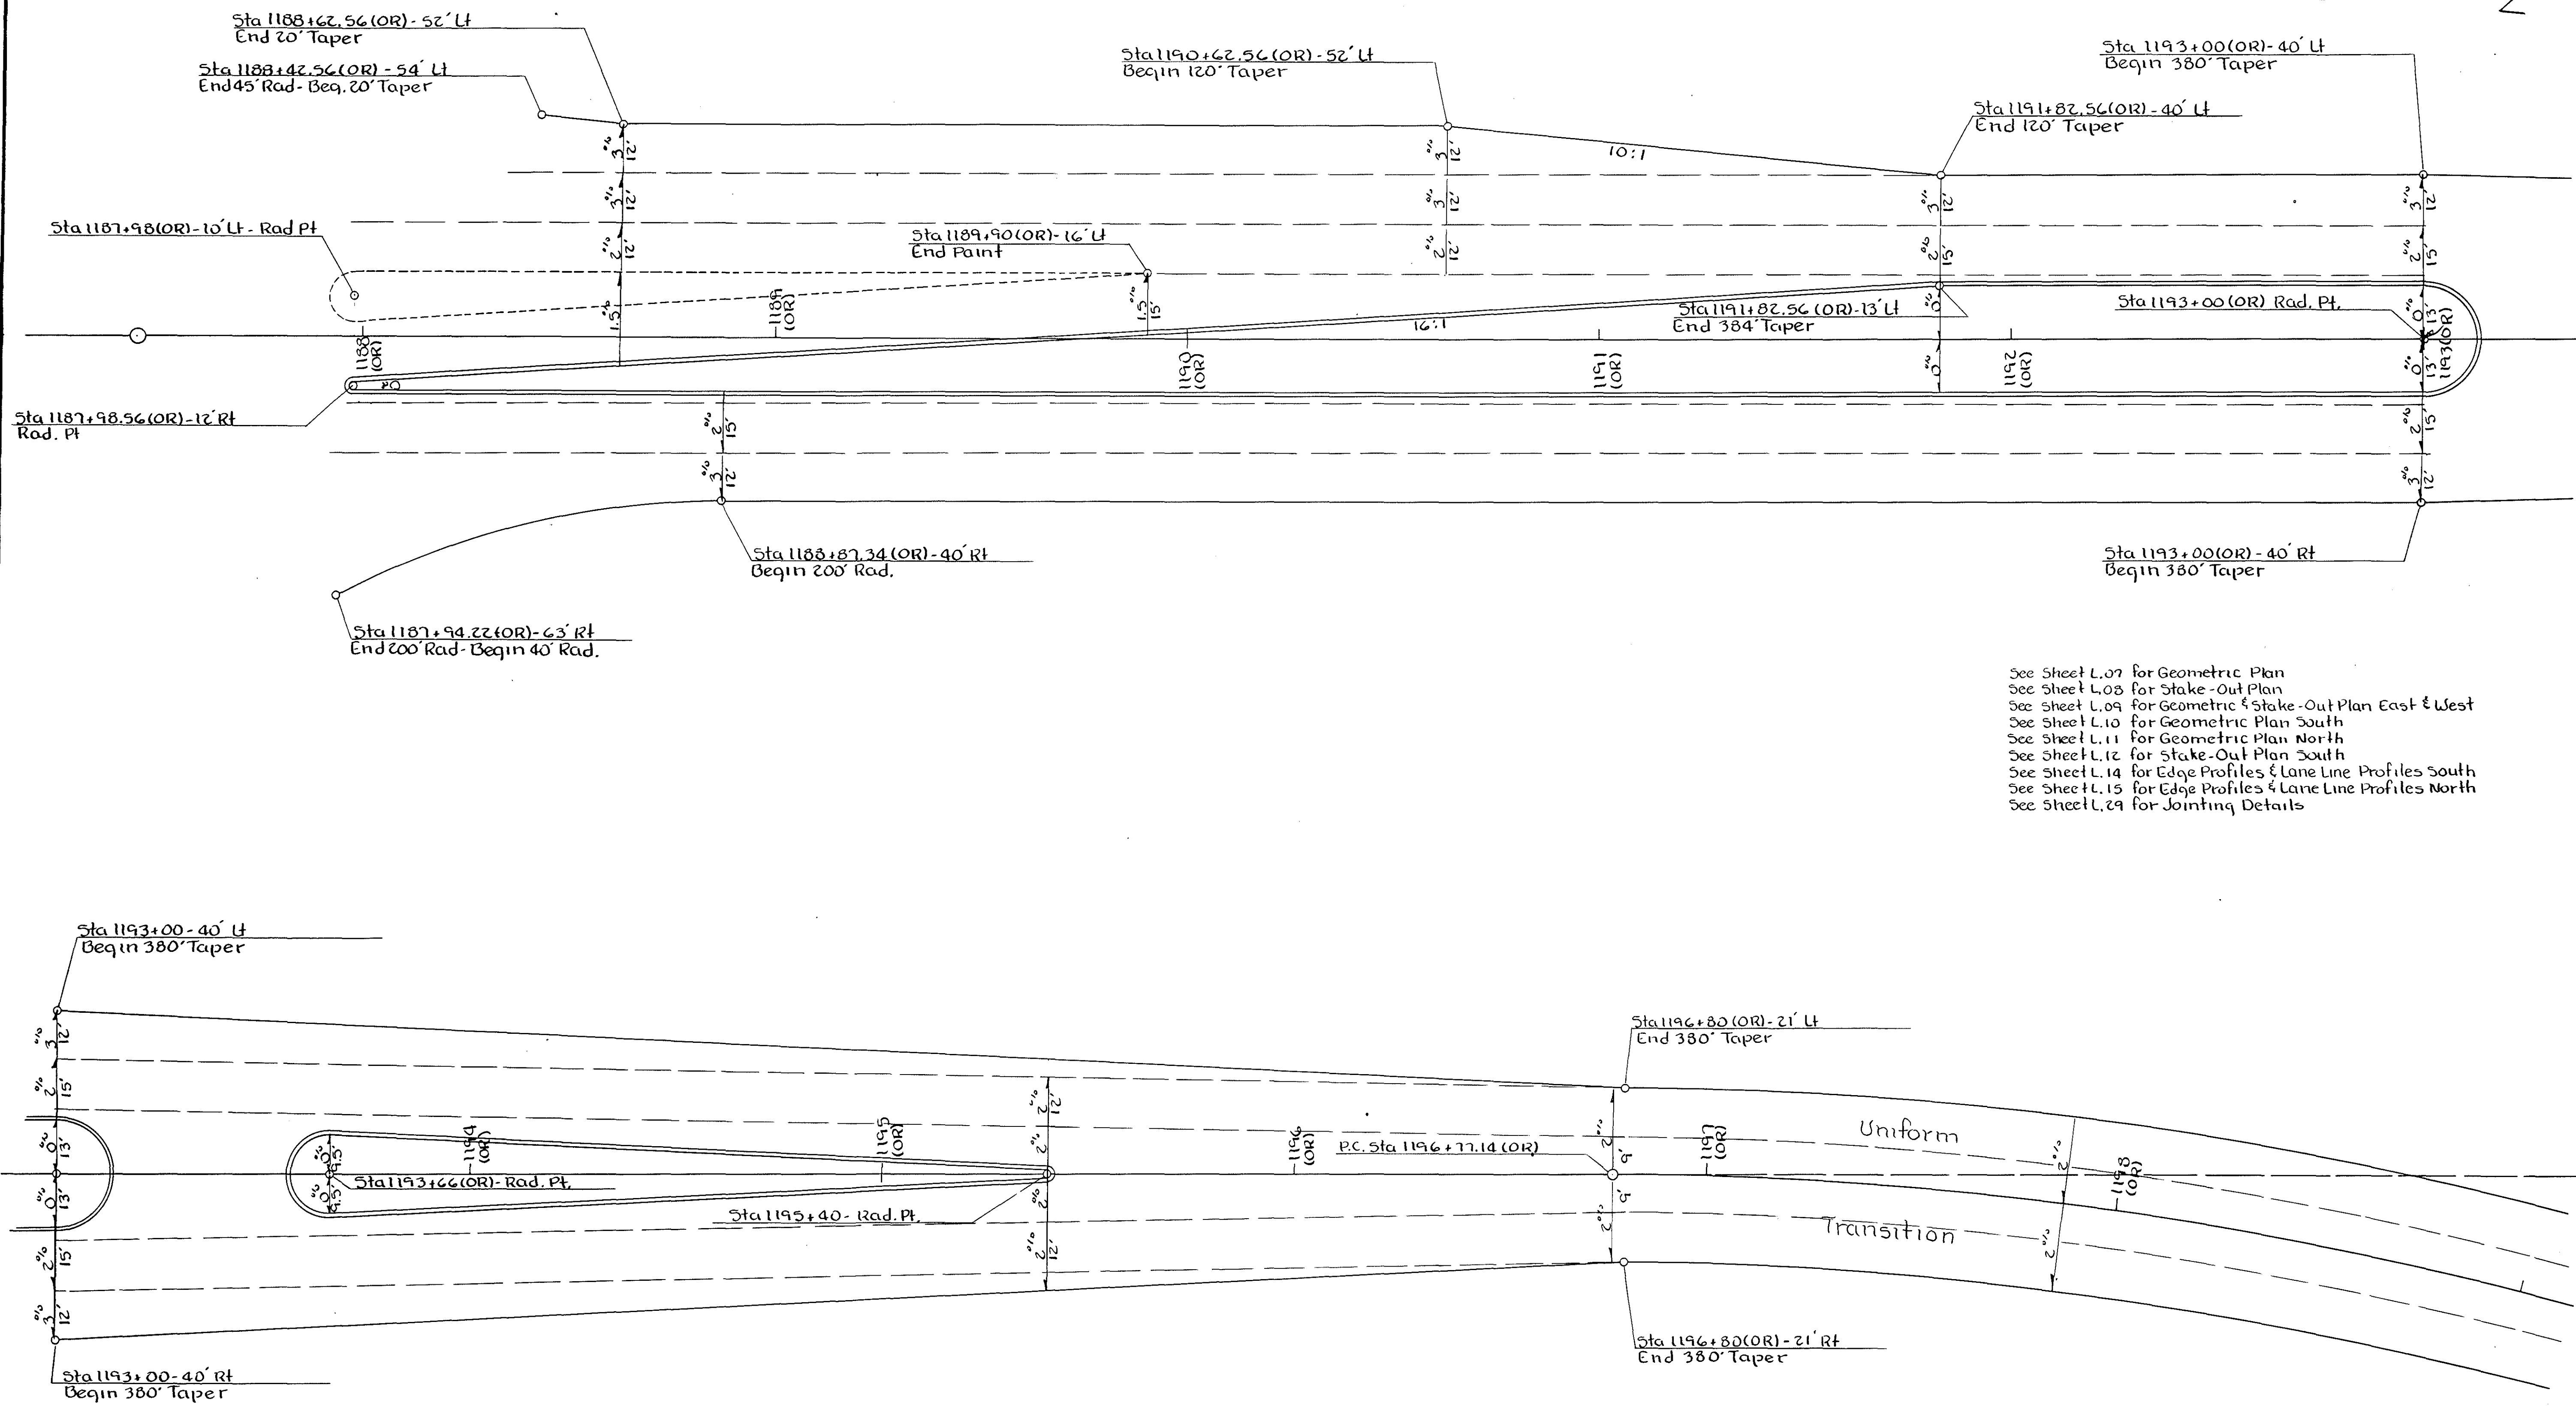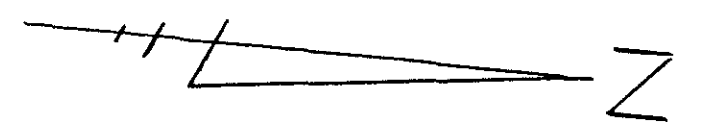

See Sheet L.07 for Geometric Plan
See Sheet L.08 for Stake-Out Plan
See Sheet L.09 for Geometric & Stake-Out Plan East & West
See Sheet L.10 for Geometric Plan South
See Sheet L.11 for Geometric Plan North
See Sheet L.12 for Stake-Out Plan South
See Sheet L.14 for Edge Profiles & Lane Line Profiles South
See Sheet L.15 for Edge Profiles & Lane Line Profiles North
See Sheet L.29 for Jointing Details


Stake-Out Plan of Intersection of
North Leg of East Post Road
Scale 1" = 20'

PROFILE	SURVEYED _____	BY _____	DATE _____
NOTE BOOK	PLOTTED _____		
	GRADES CHECKED _____		
	B.M.'S NOTED _____		
NO. _____	STRUCTURE NOTATIONS CH'KD _____		

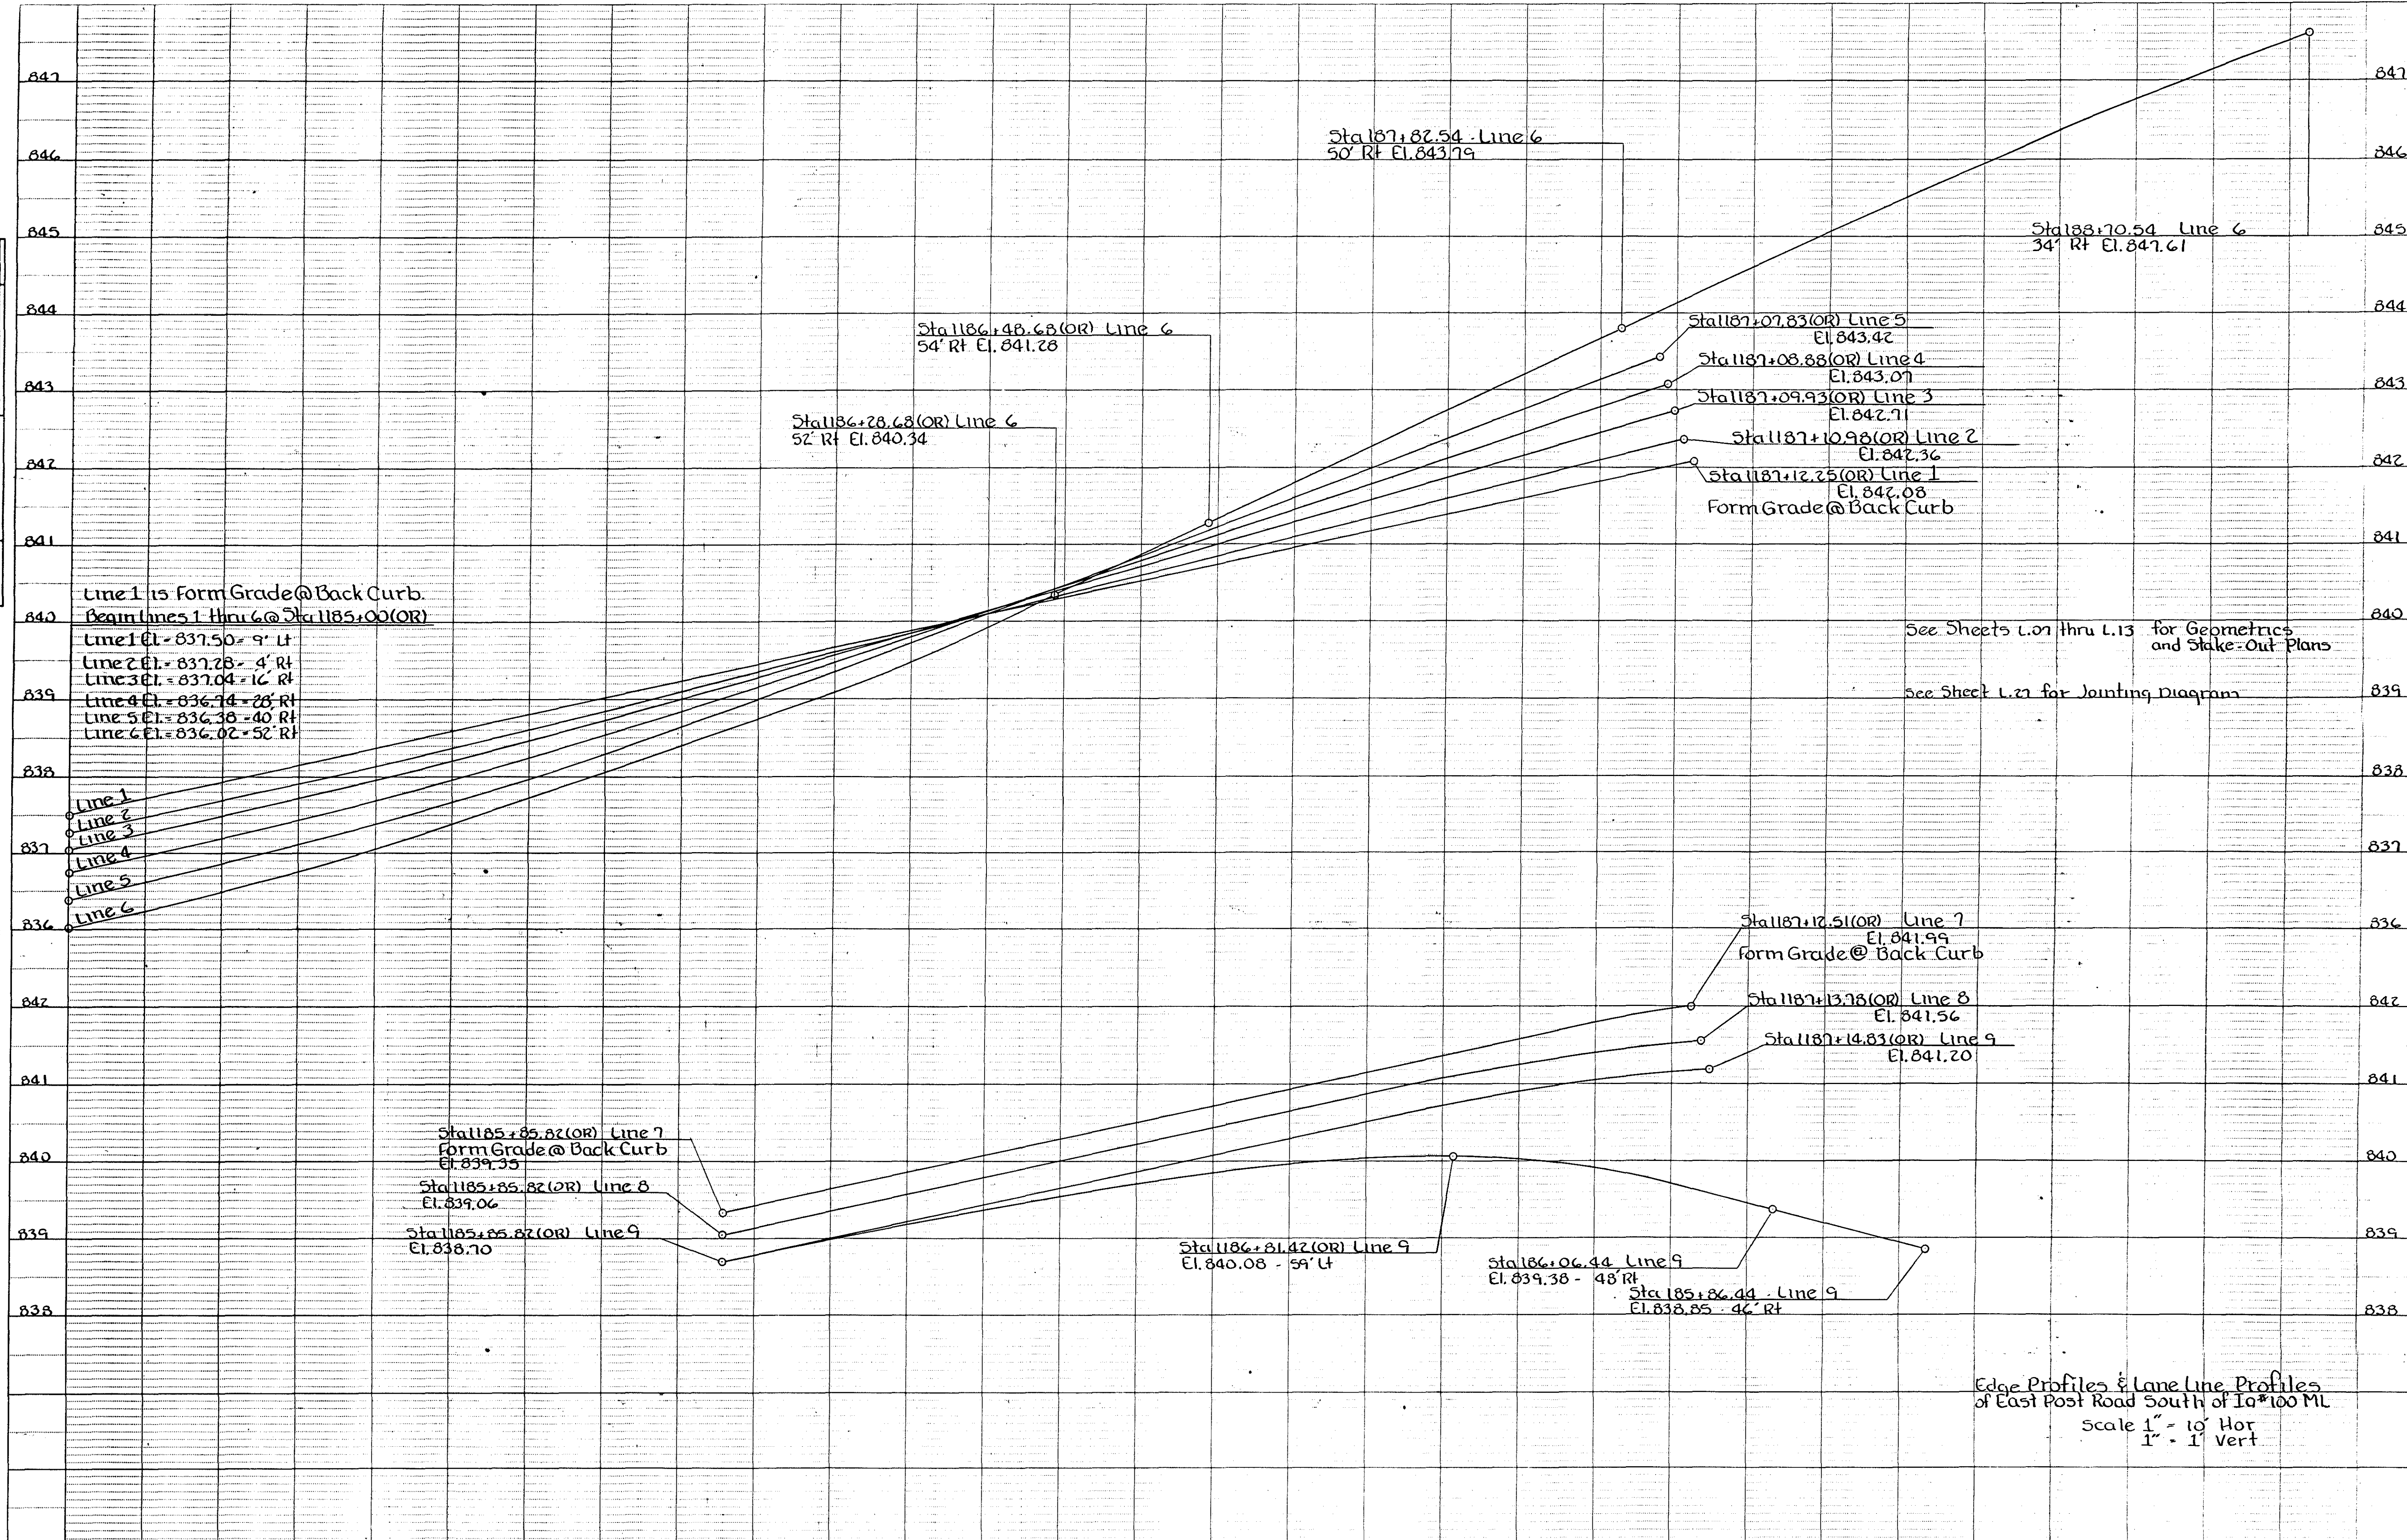


PLAN	DATE	BY	SURVEYED	PLOTTED	CHECKED	NOTE BOOK NO.

PROFILE	DATE	BY	SURVEYED	PLOTTED	CHECKED	NOTE BOOK NO.

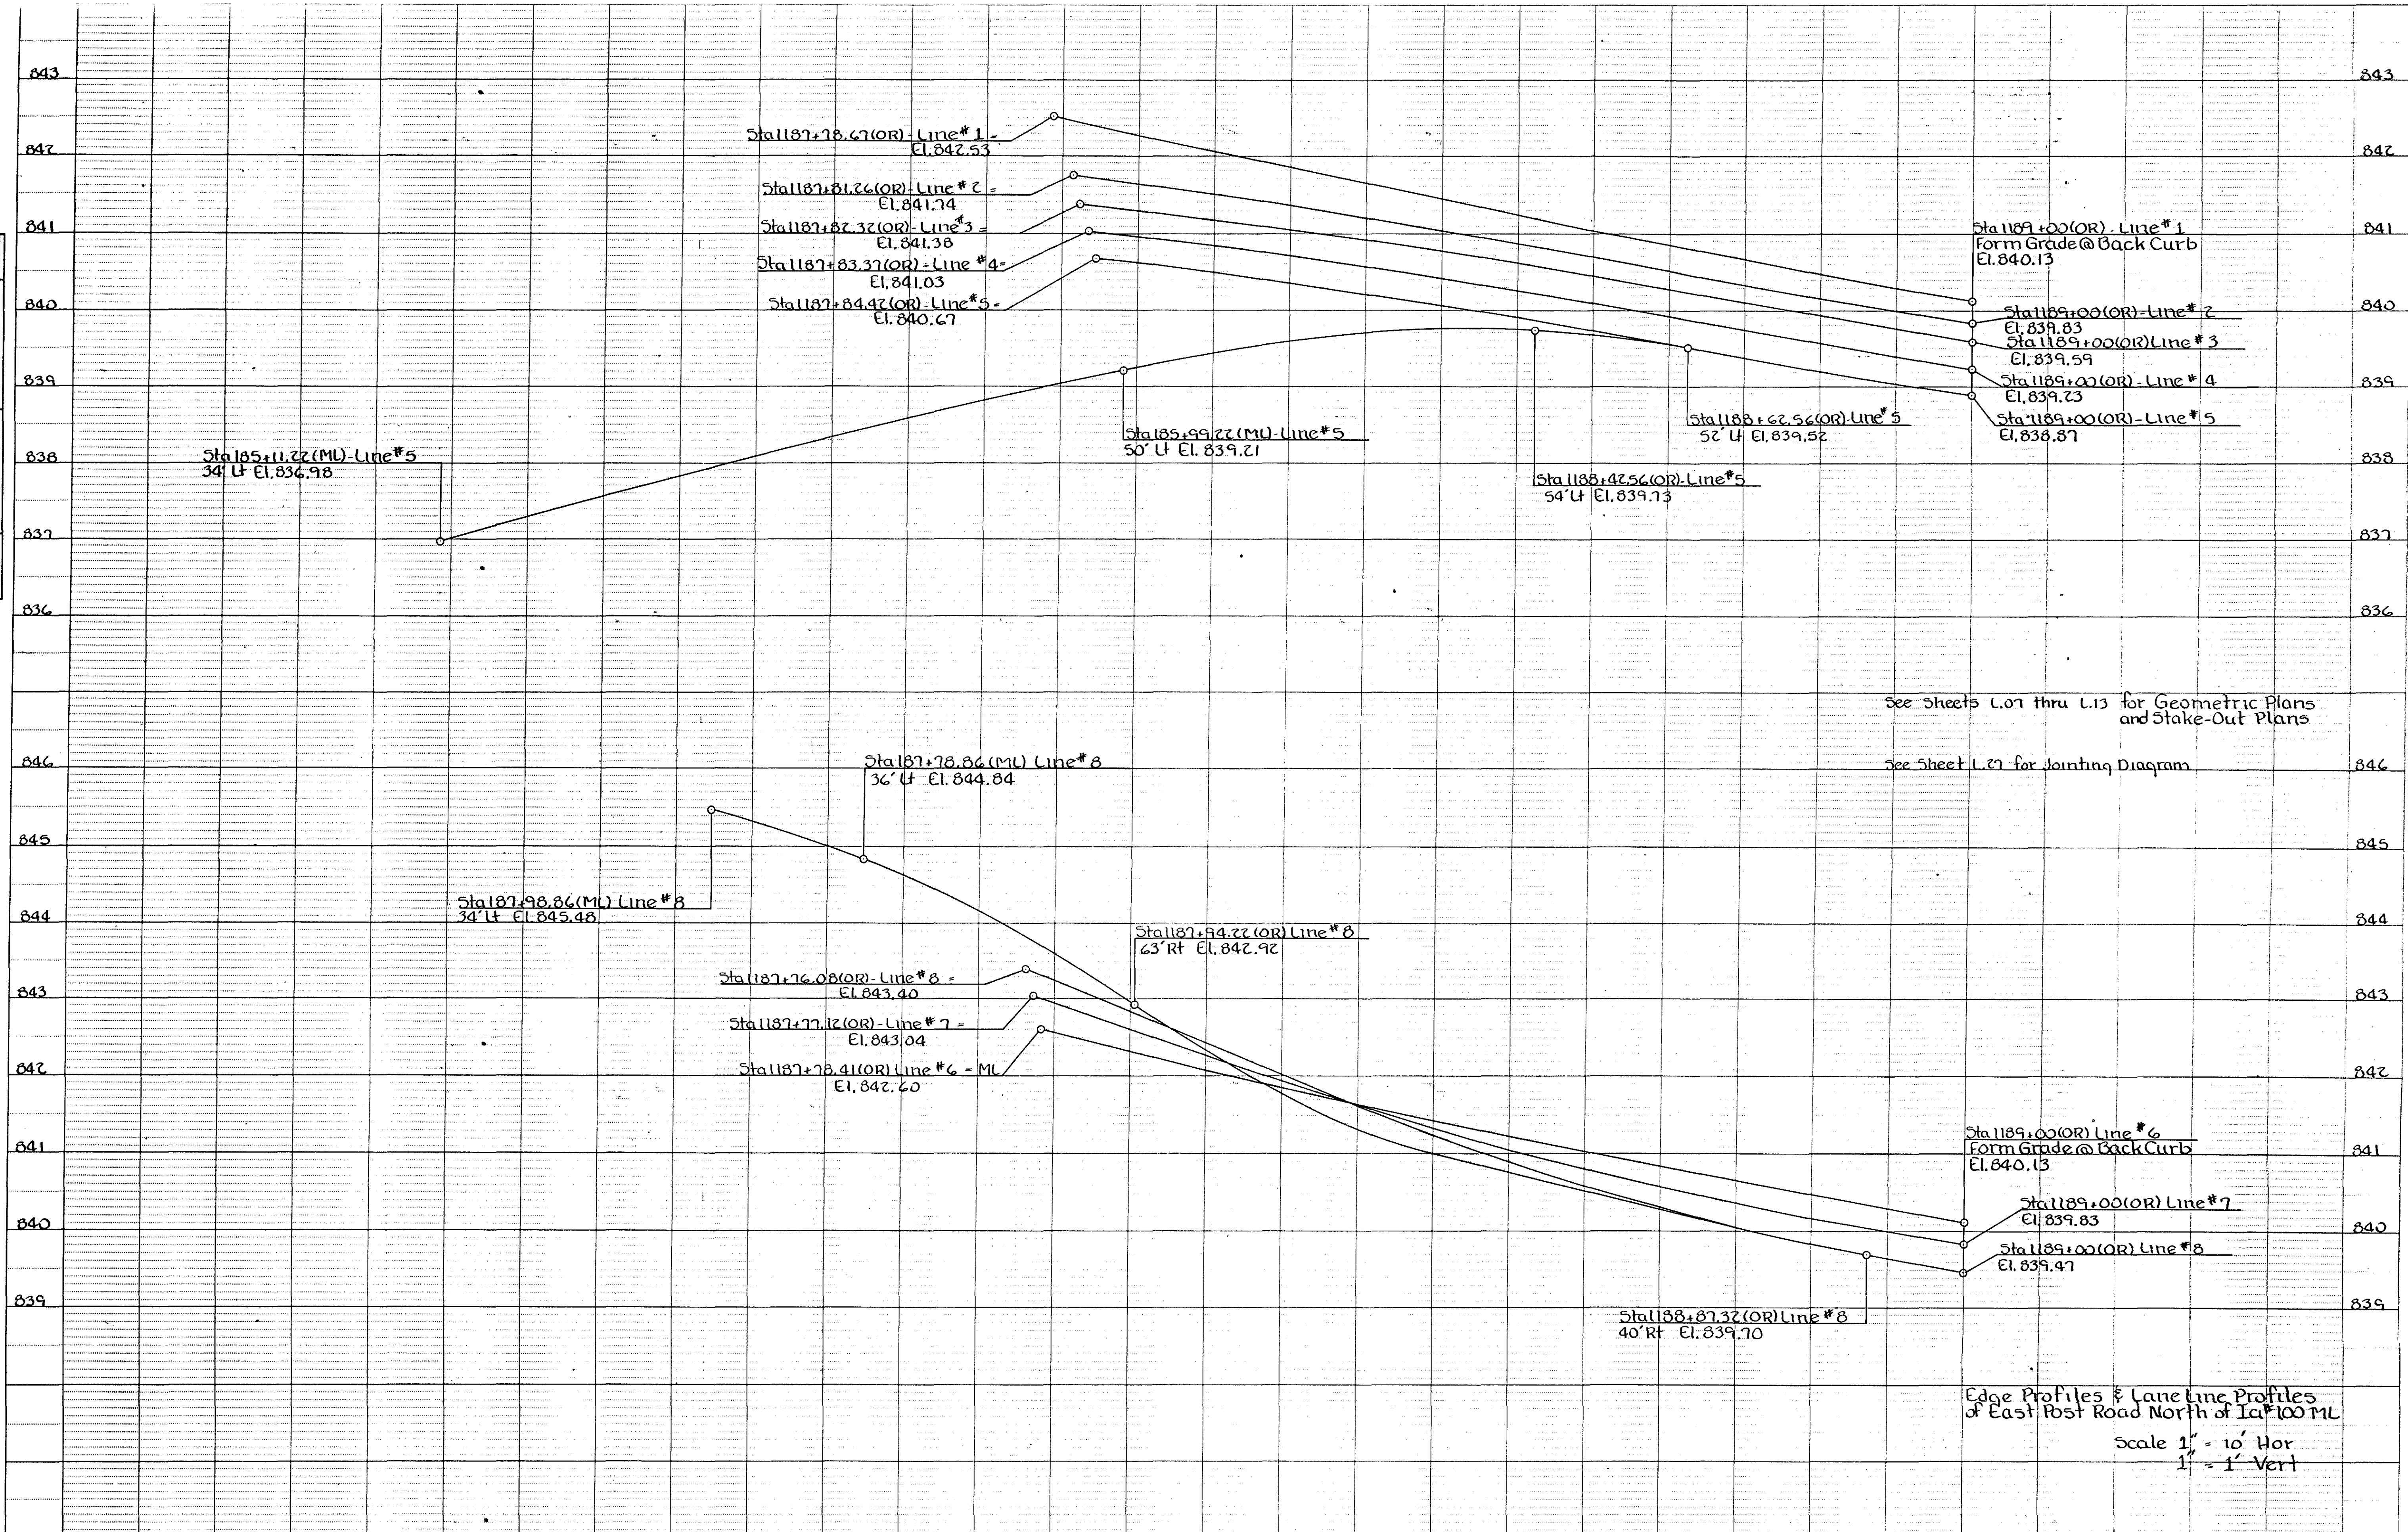


P.90 04

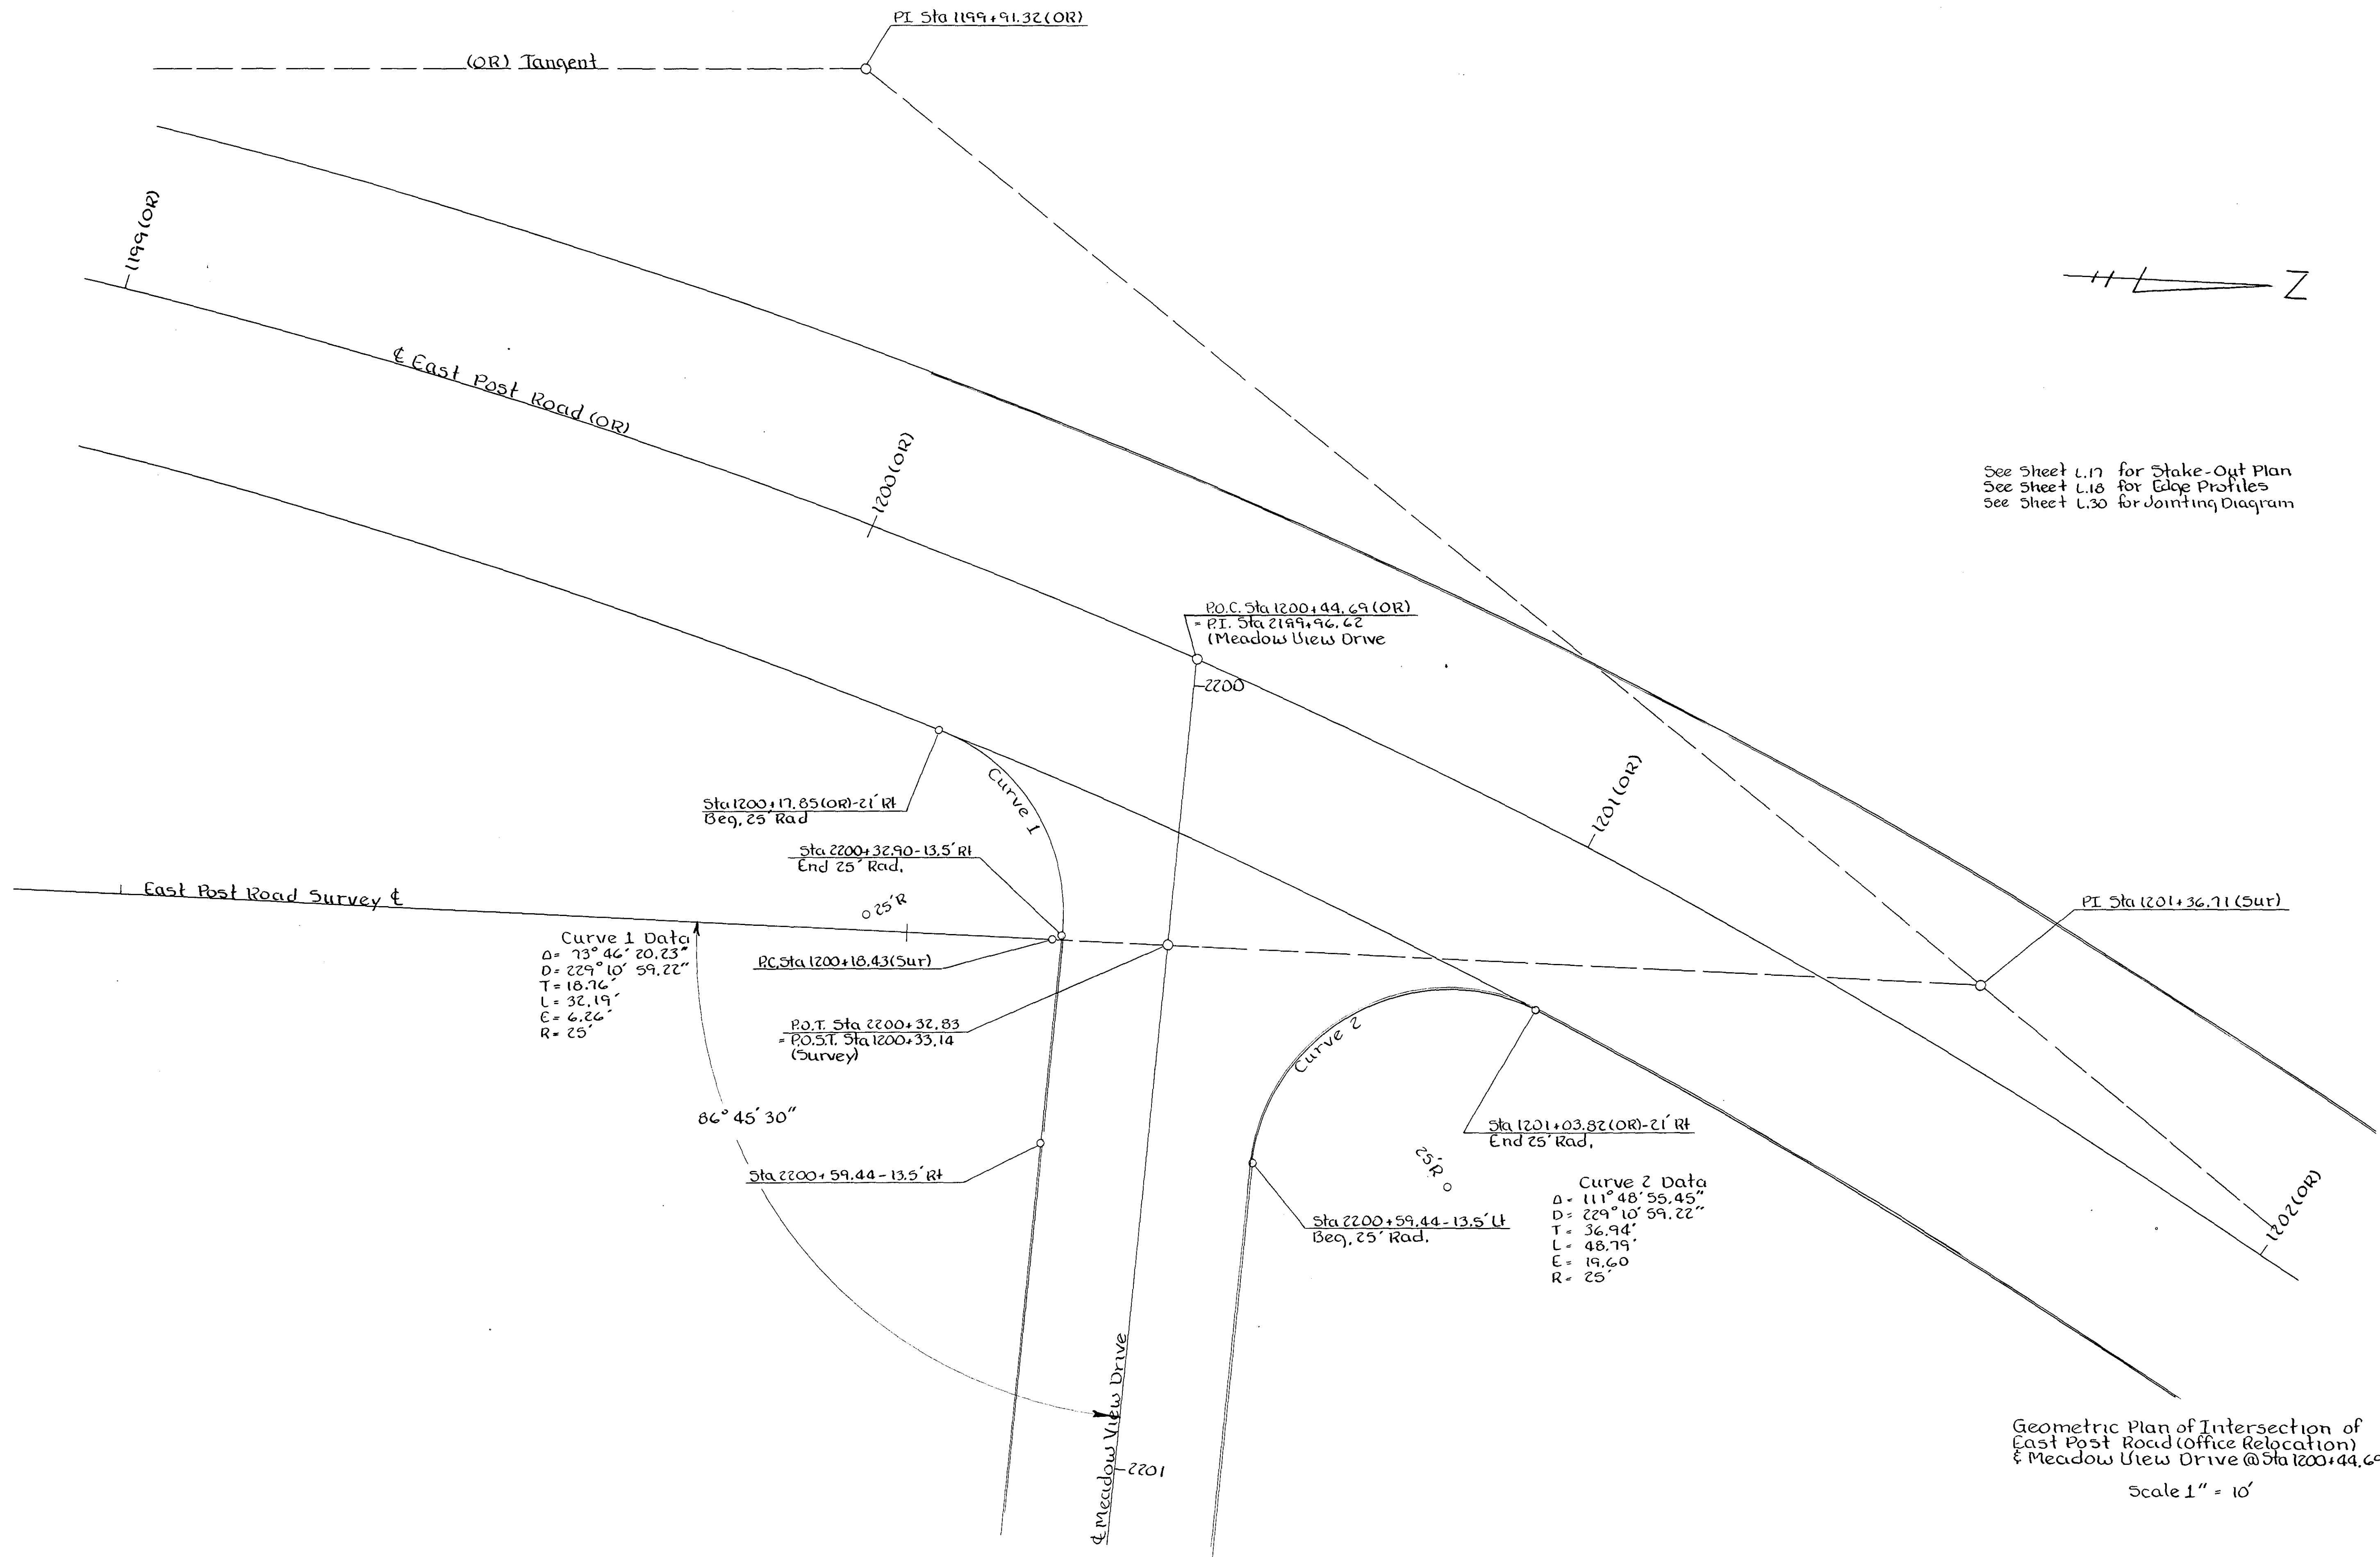


See Sheet L.17 for Stake-Out Plan
 See Sheet L.18 for Edge Profiles
 See Sheet L.30 for Jointing Diagram

Geometric Plan of Intersection of
 East Post Road (Office Relocation)
 & Meadow View Drive @ Sta 1200+44.69 (OR)
 Scale 1" = 10'

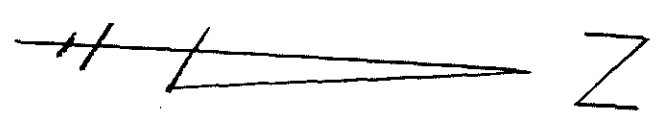


See Sheet L.16 for Geometric Plan
See Sheet L.18 for Edge Profiles
See Sheet L.30 for Jointing Diagram

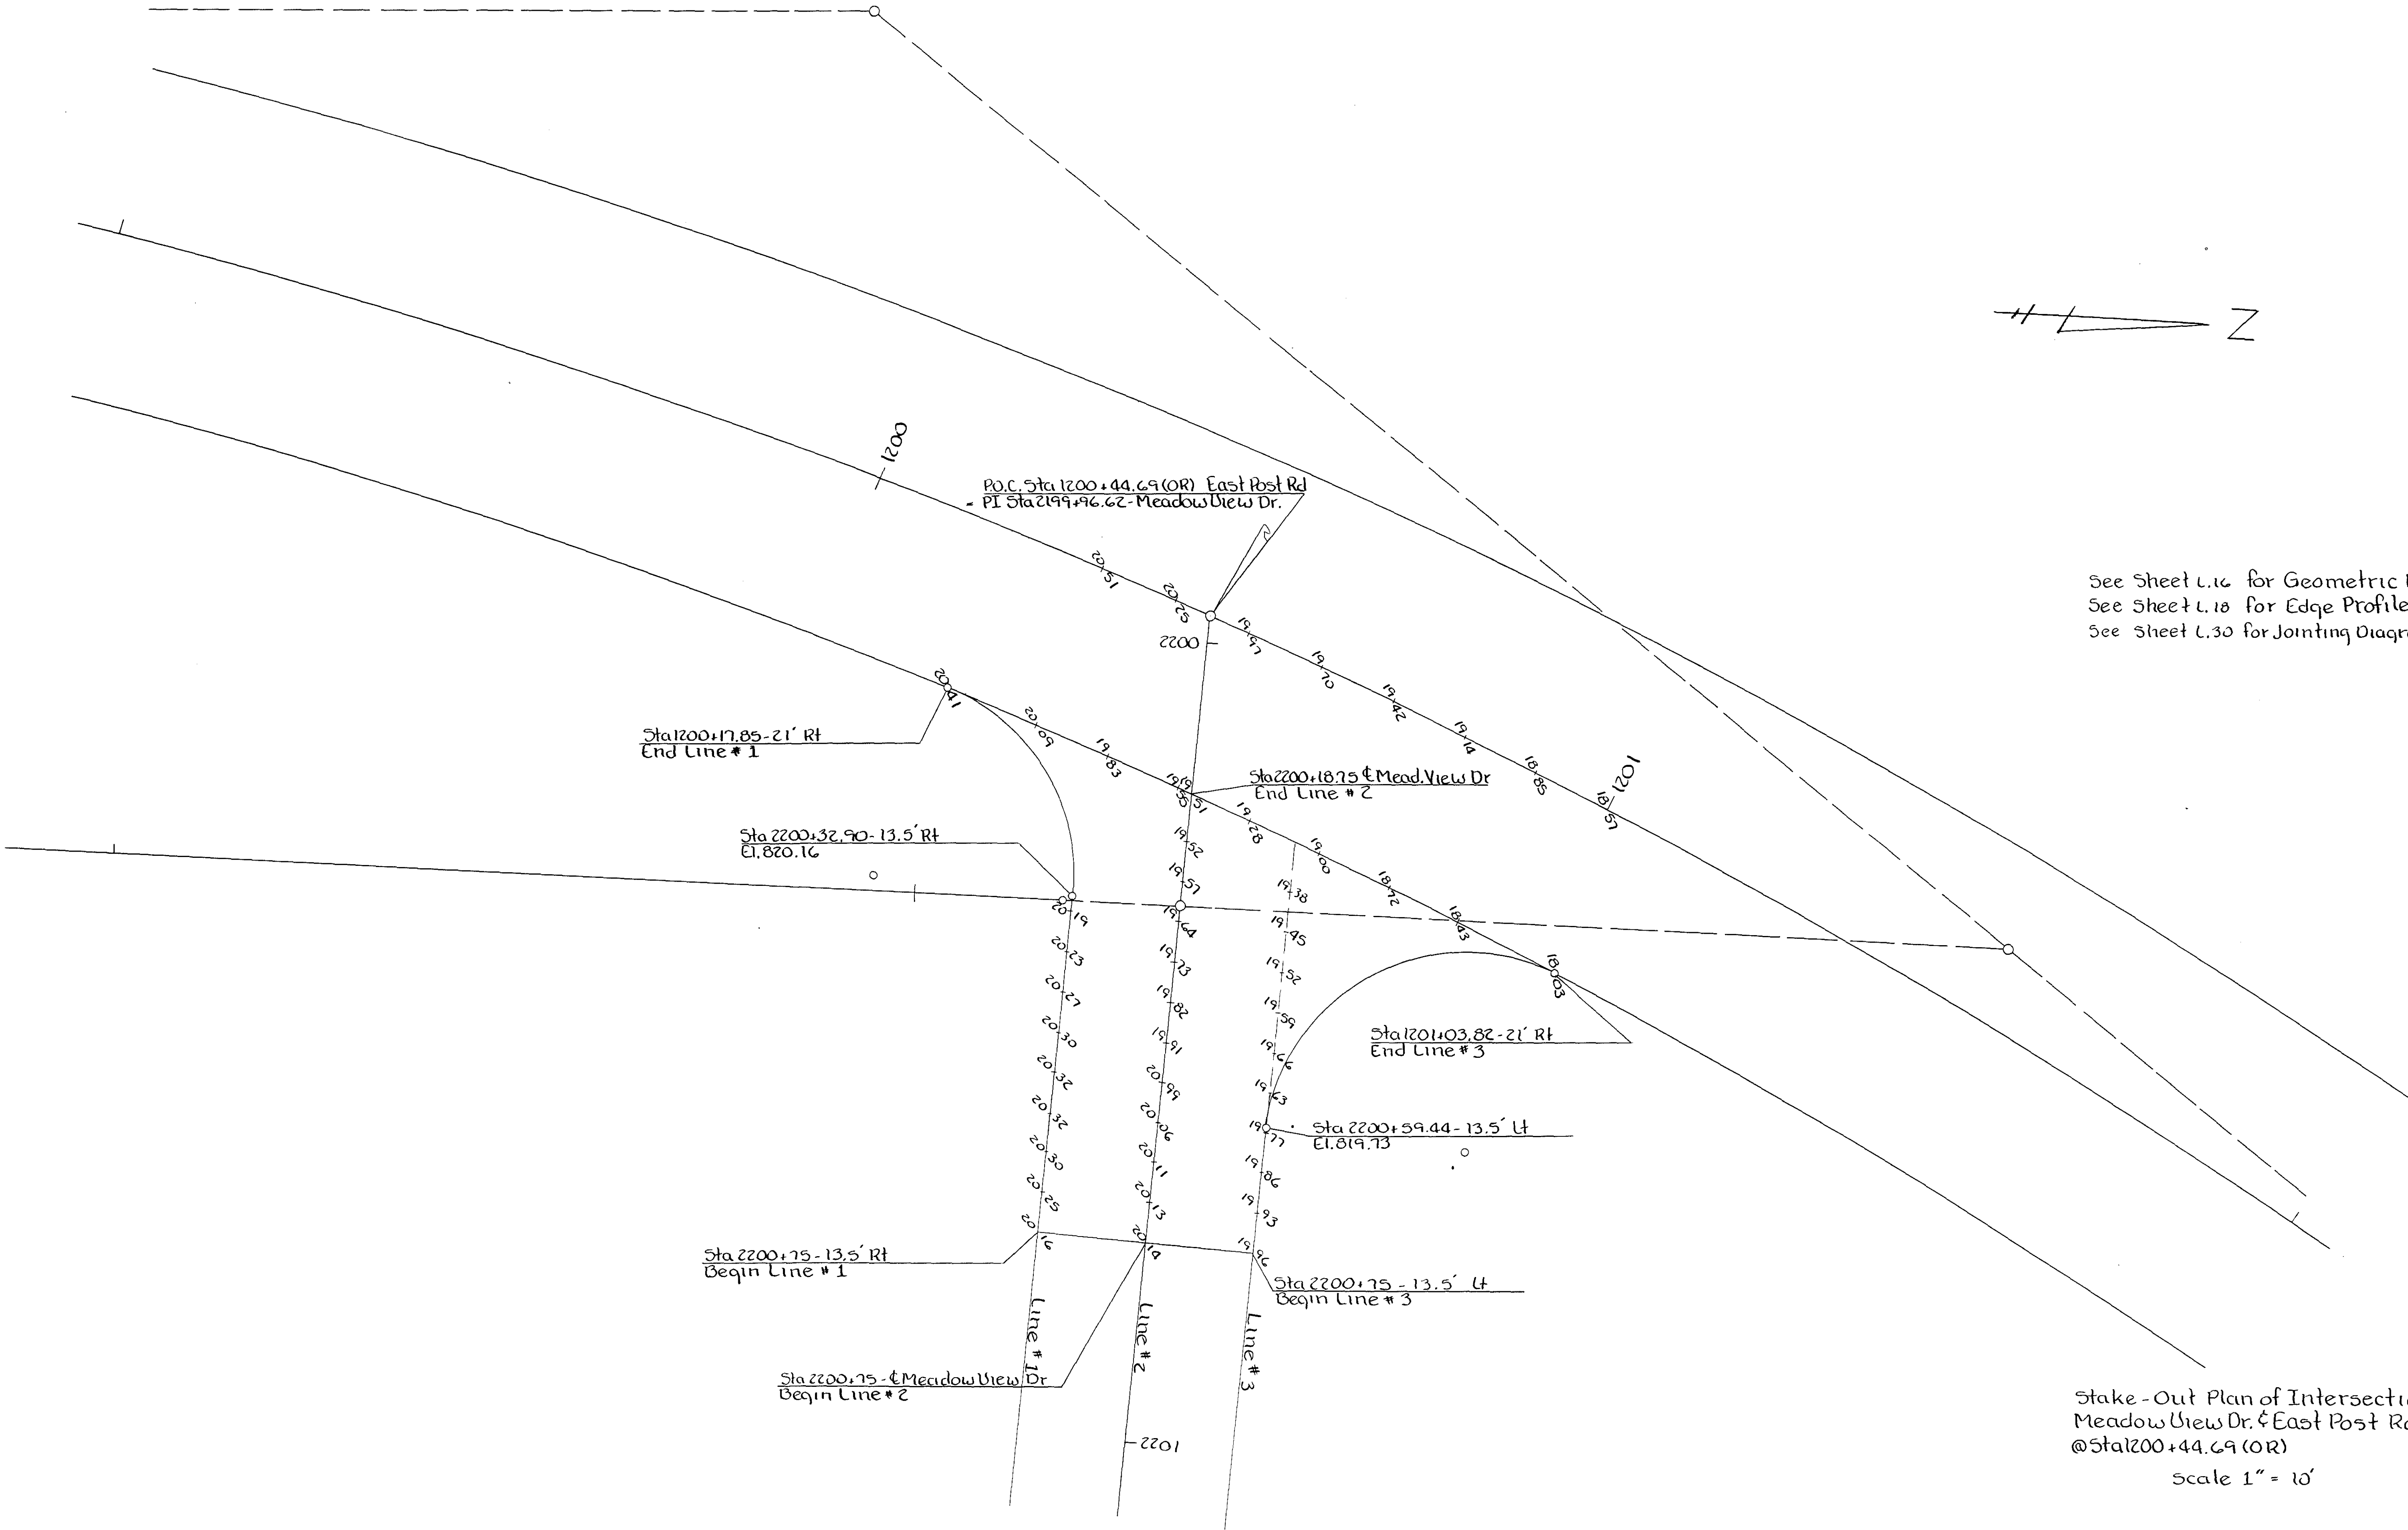

Stake-Out Plan of Intersection of
Meadow View Dr. & East Post Road
@Sta 1200+44.69 (OR)
Scale 1" = 10'


PLAN	DATE	BY
	NO.	NO.
	NO.	NO.
	NO.	NO.

PROFILE	DATE	BY
	NO.	NO.
	NO.	NO.
	NO.	NO.

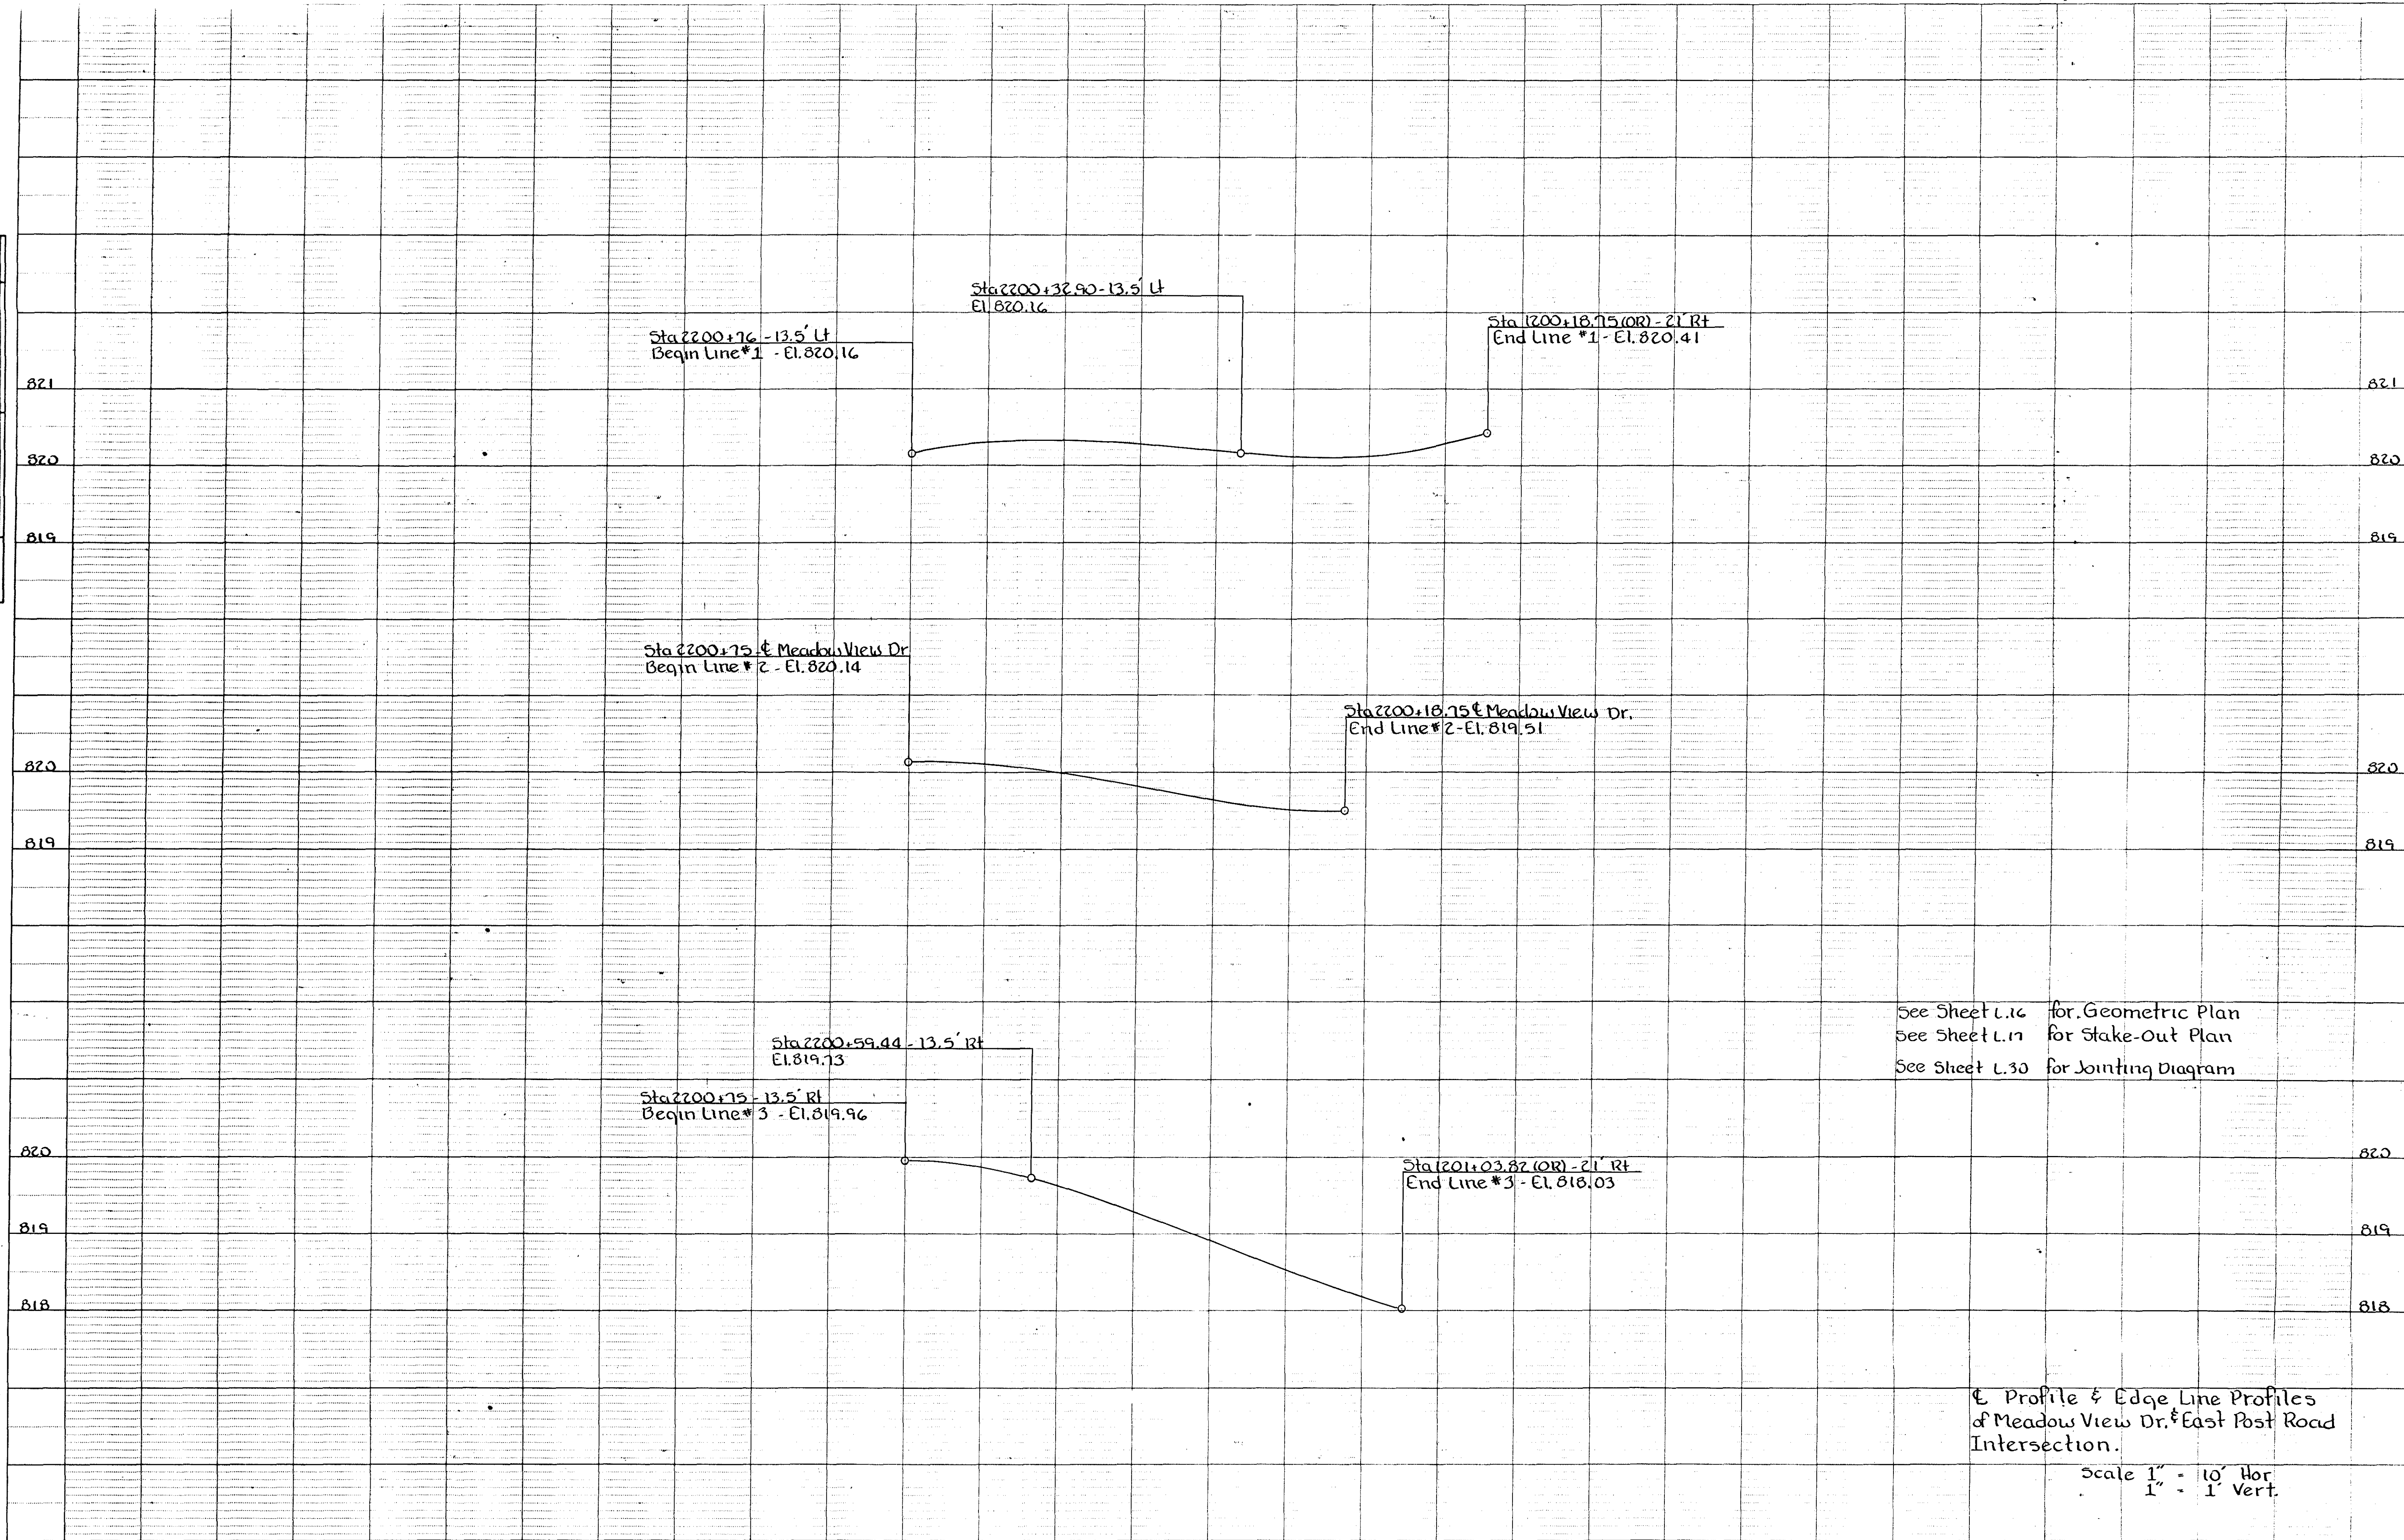

See Sheet L.16 for Geometric Plan
 See Sheet L.17 for Stake-Out Plan
 See Sheet L.30 for Jointing Diagram

E Profile & Edge Line Profiles
 of Meadow View Dr. & East Post Road
 Intersection.
 Scale 1" = 10' Hor.
 1" = 1' Vert.

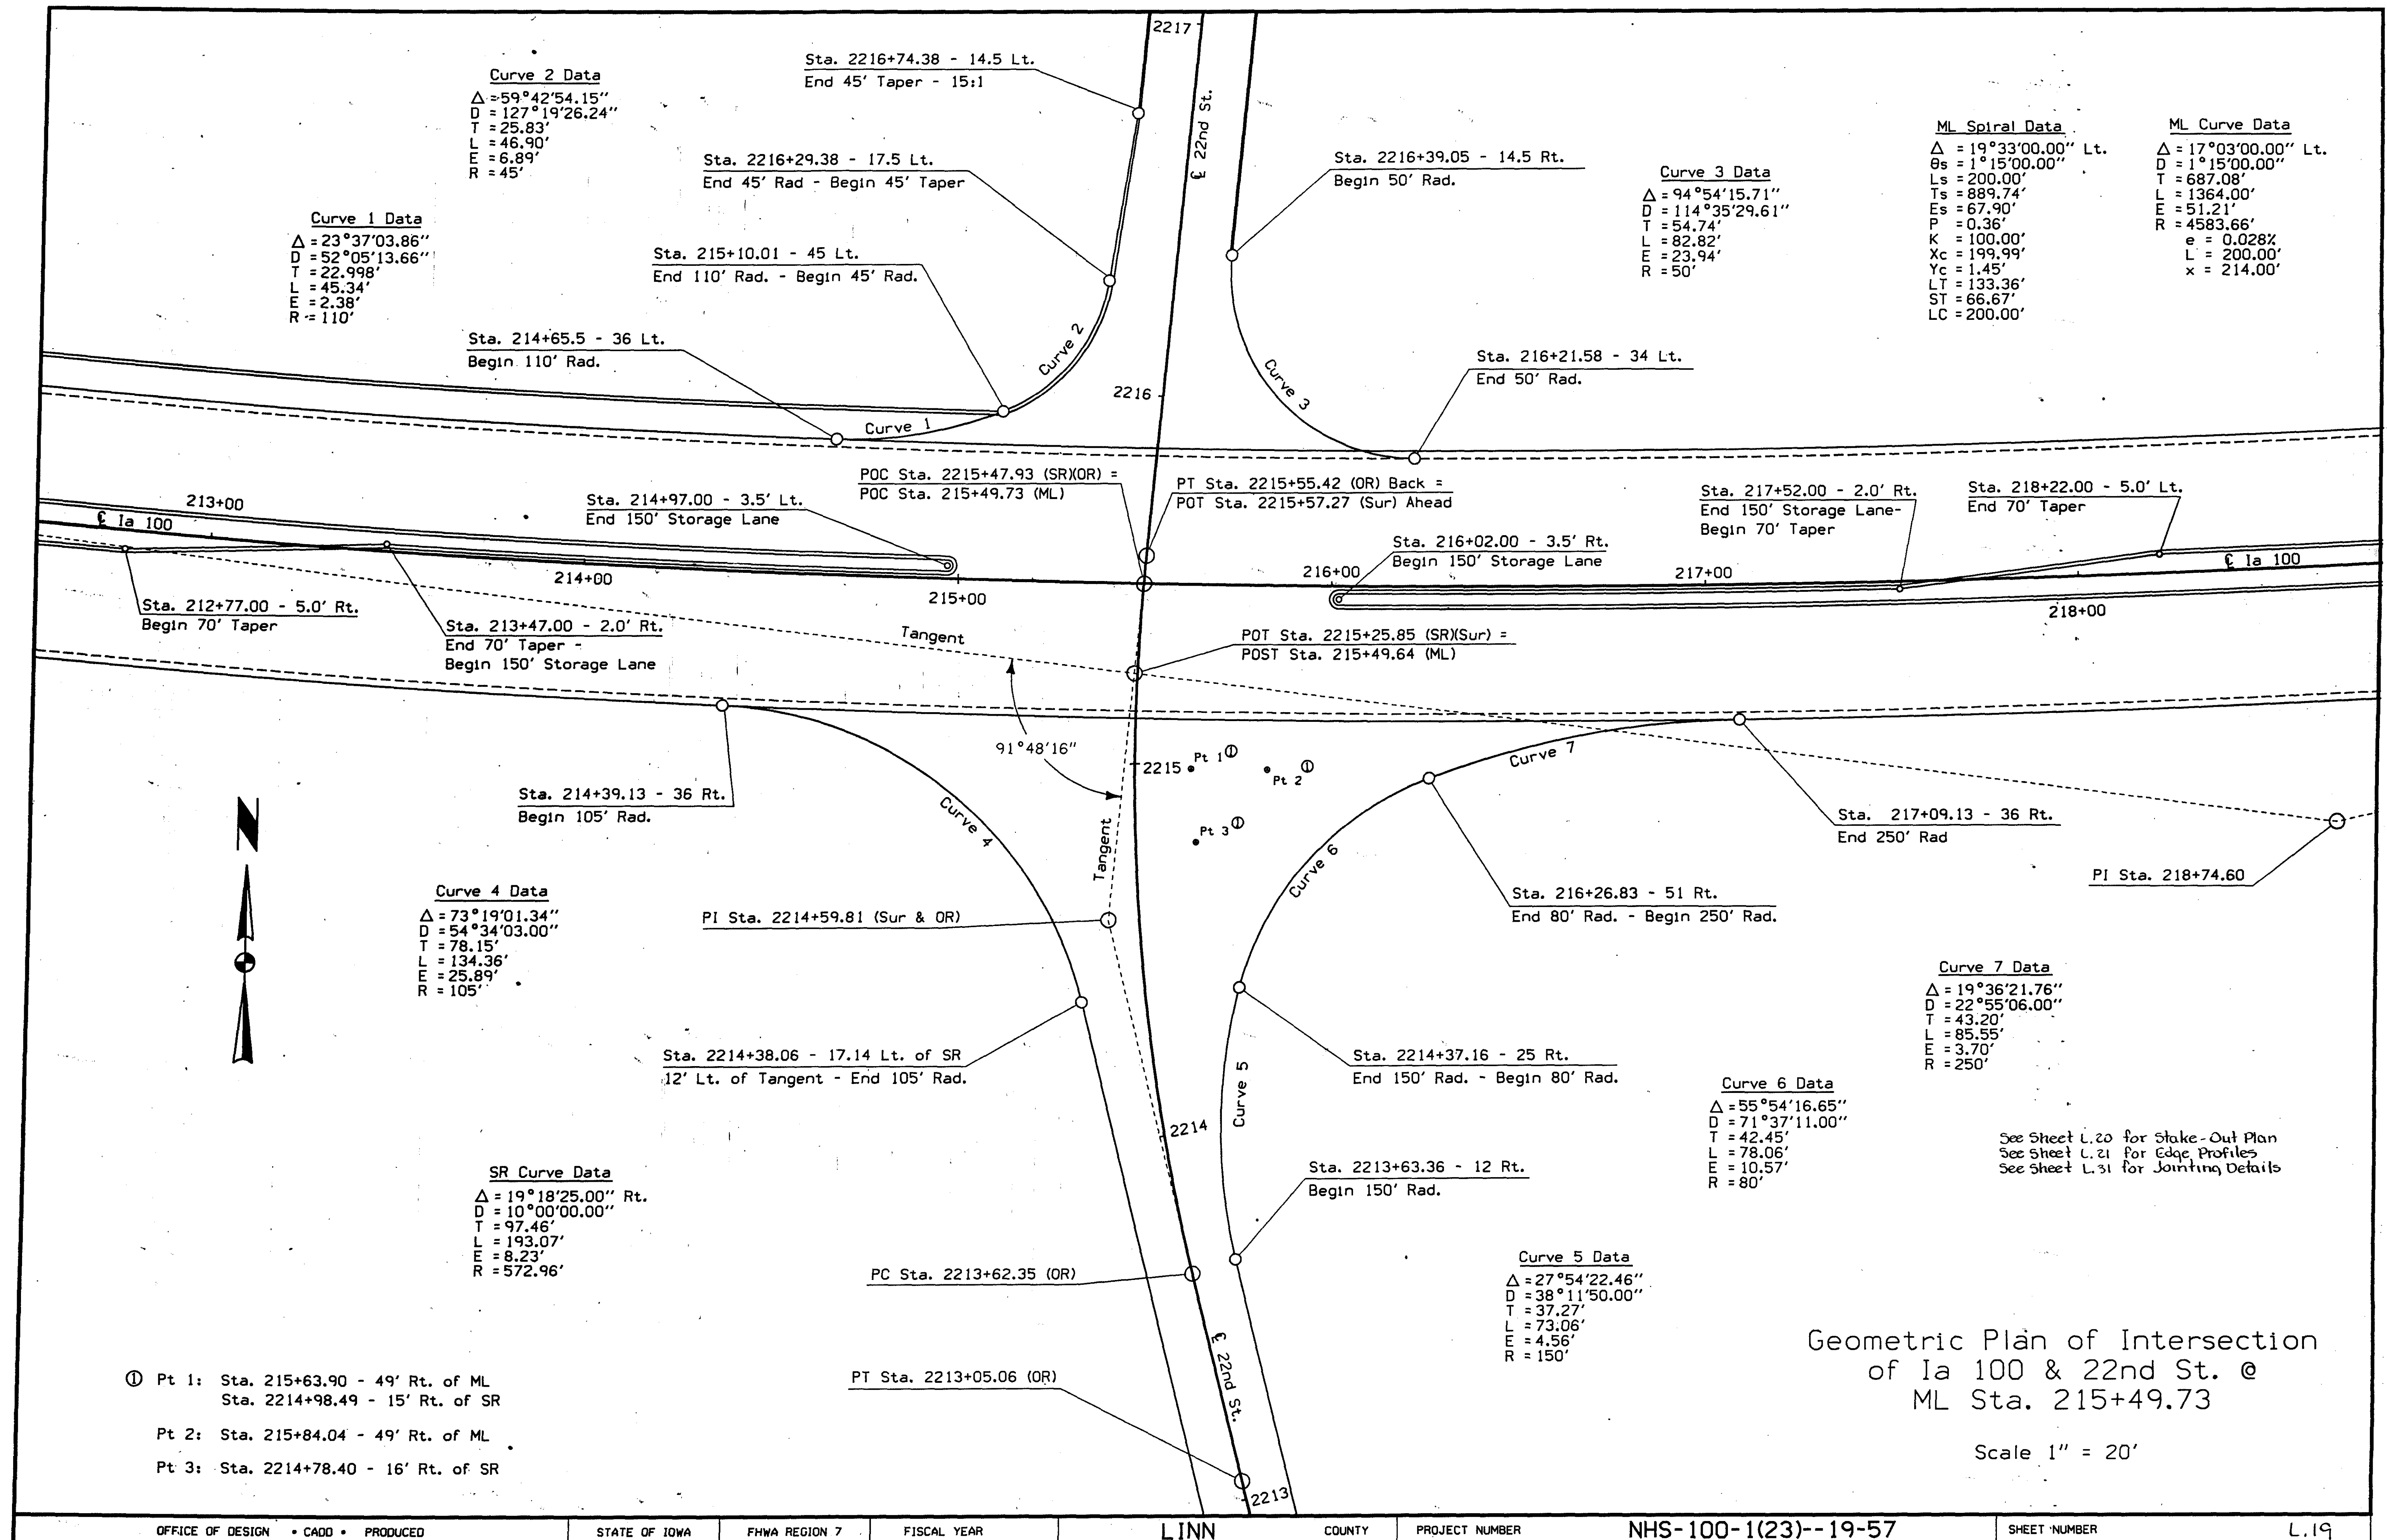

Geometric Plan of Intersection
 of Ia 100 & 22nd St. @
 ML Sta. 215+49.73


Scale 1" = 20'


- ① Pt 1: Sta. 215+63.90 - 49' Rt. of ML
Sta. 2214+98.49 - 15' Rt. of SR
- Pt 2: Sta. 215+84.04 - 49' Rt. of ML
- Pt 3: Sta. 2214+78.40 - 16' Rt. of SR

See Sheet L.20 for Stake-Out Plan
 See Sheet L.21 for Edge Profiles
 See Sheet L.31 for Jointing Details

PLAN	SURVEYED	DATE
	ALIGNED	BY
	CHECKED	
	RT OF WAY CHECKED	
NOTE BOOK NO.		

PROFILE	SURVEYED	DATE
	PLOTTED	BY
	CHECKED	
	STRUCTURE NOTATIONS CHKO	
NOTE BOOK NO.		

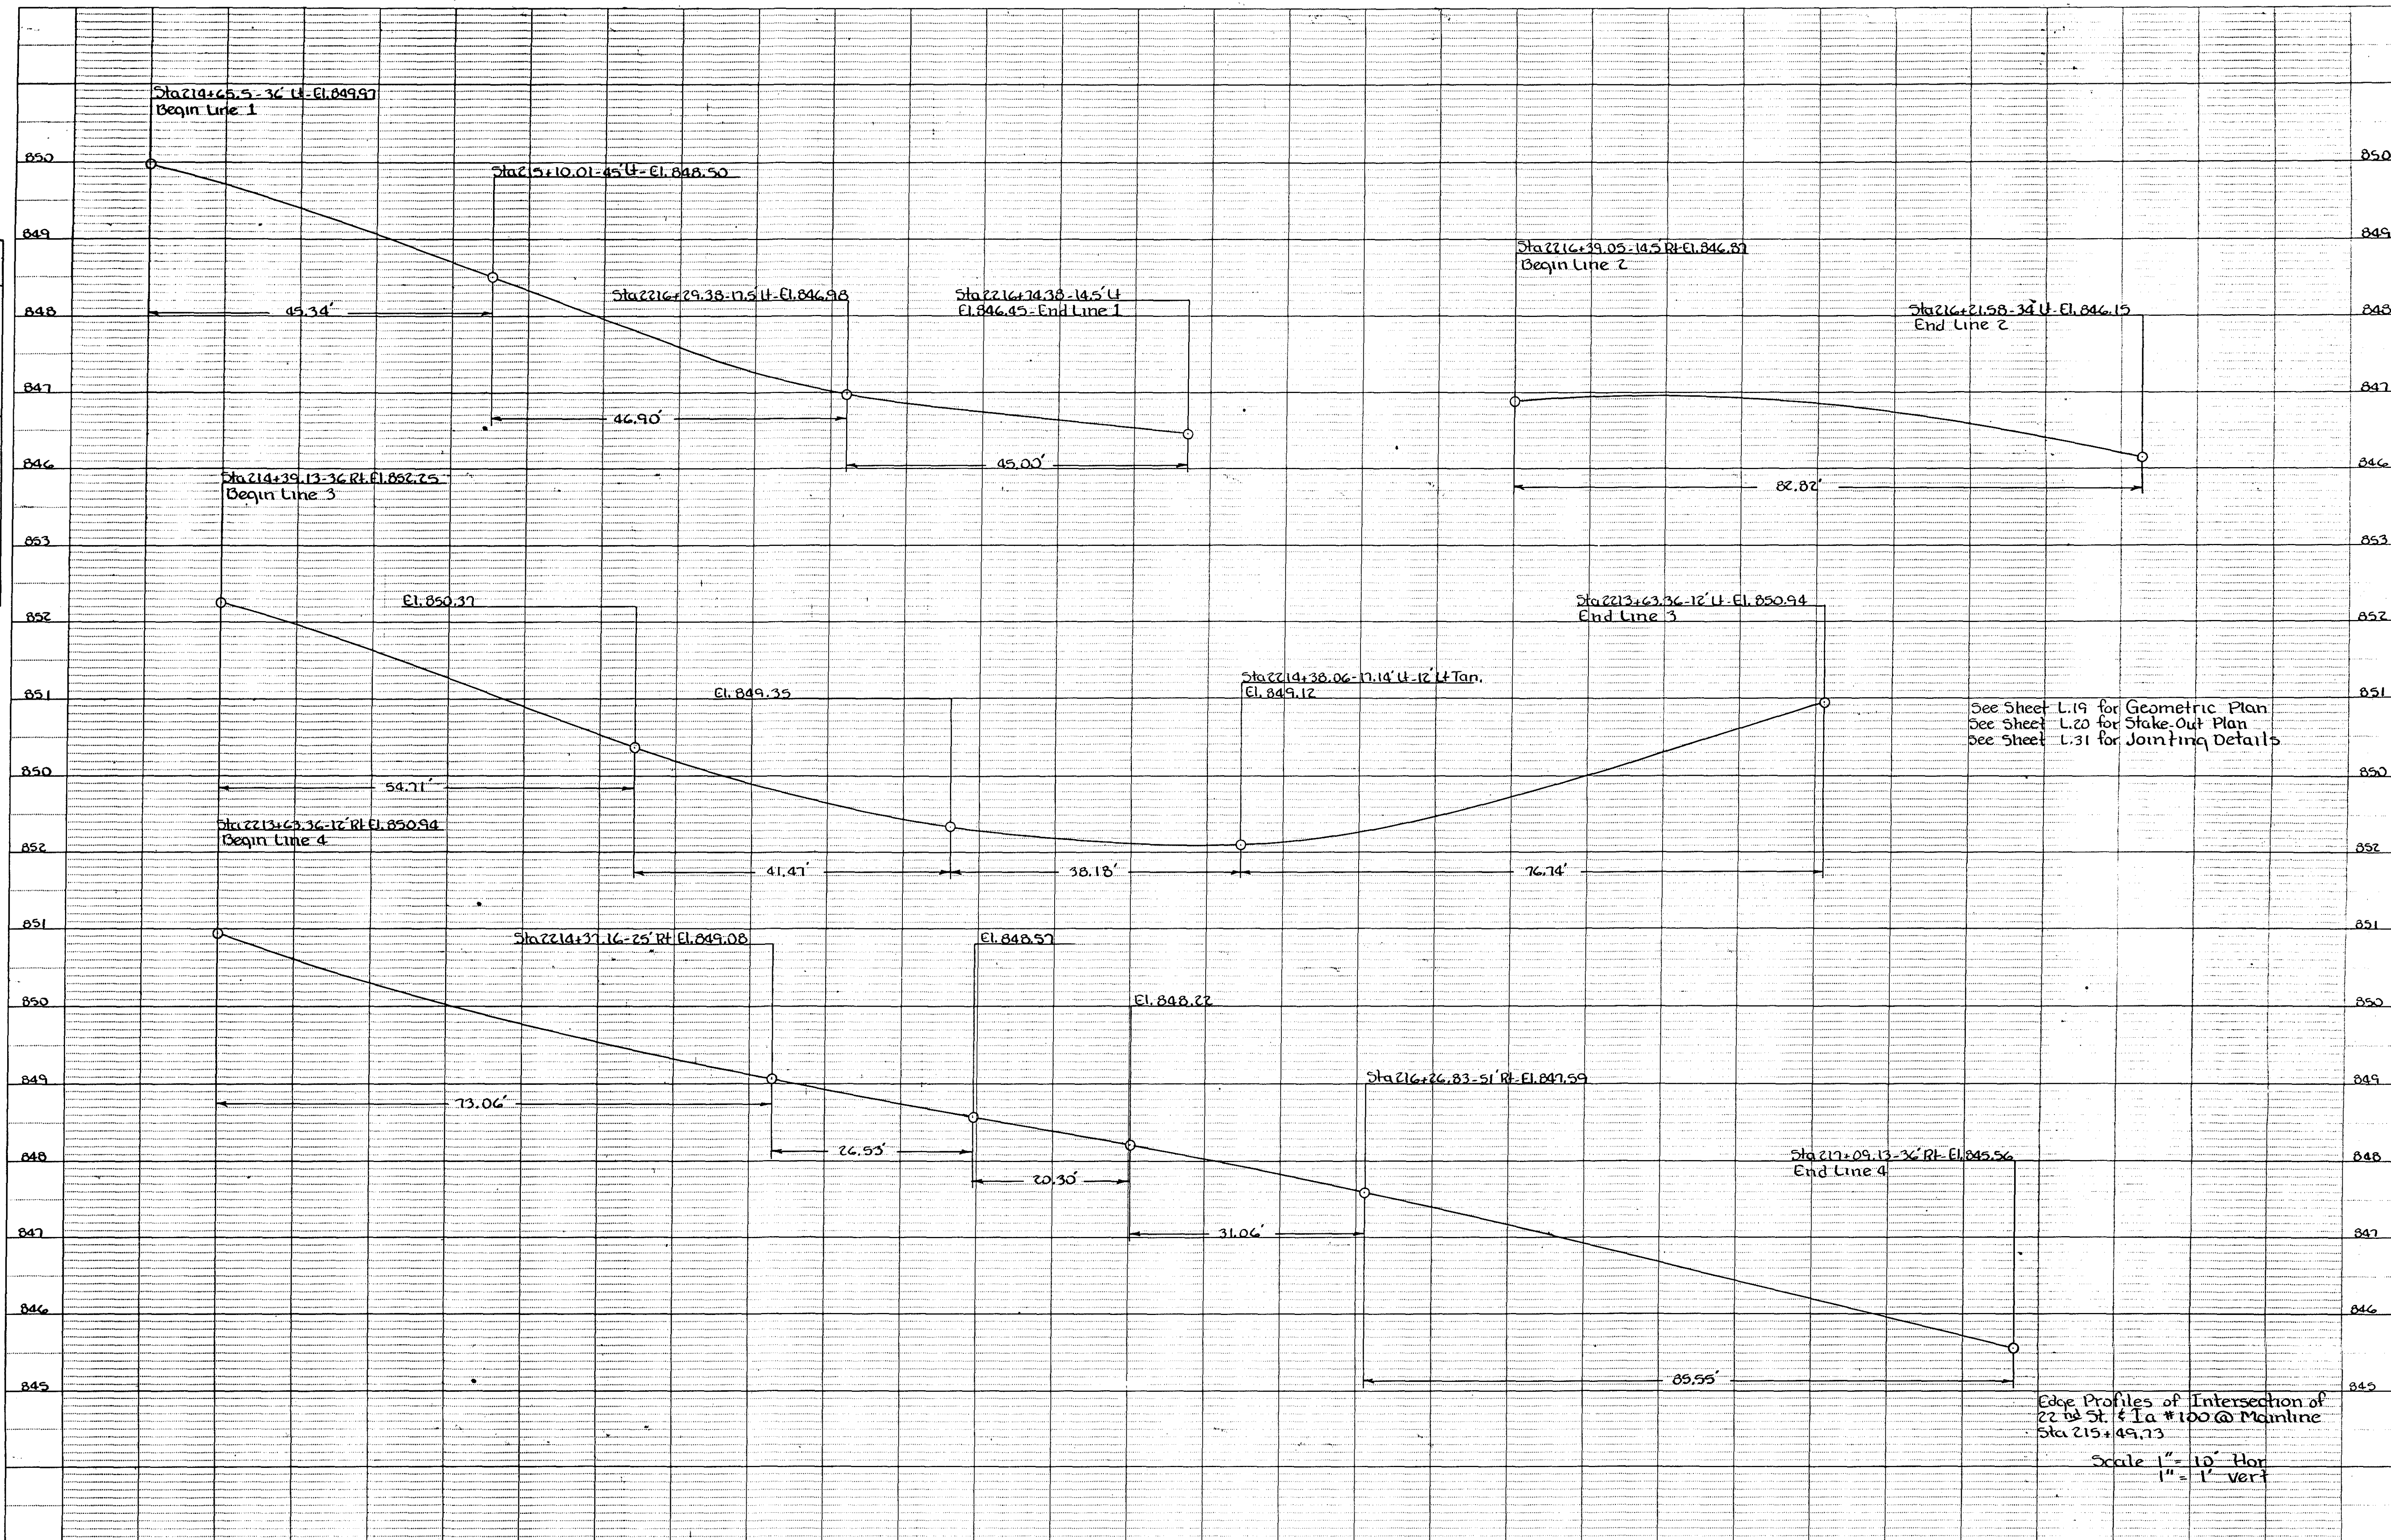

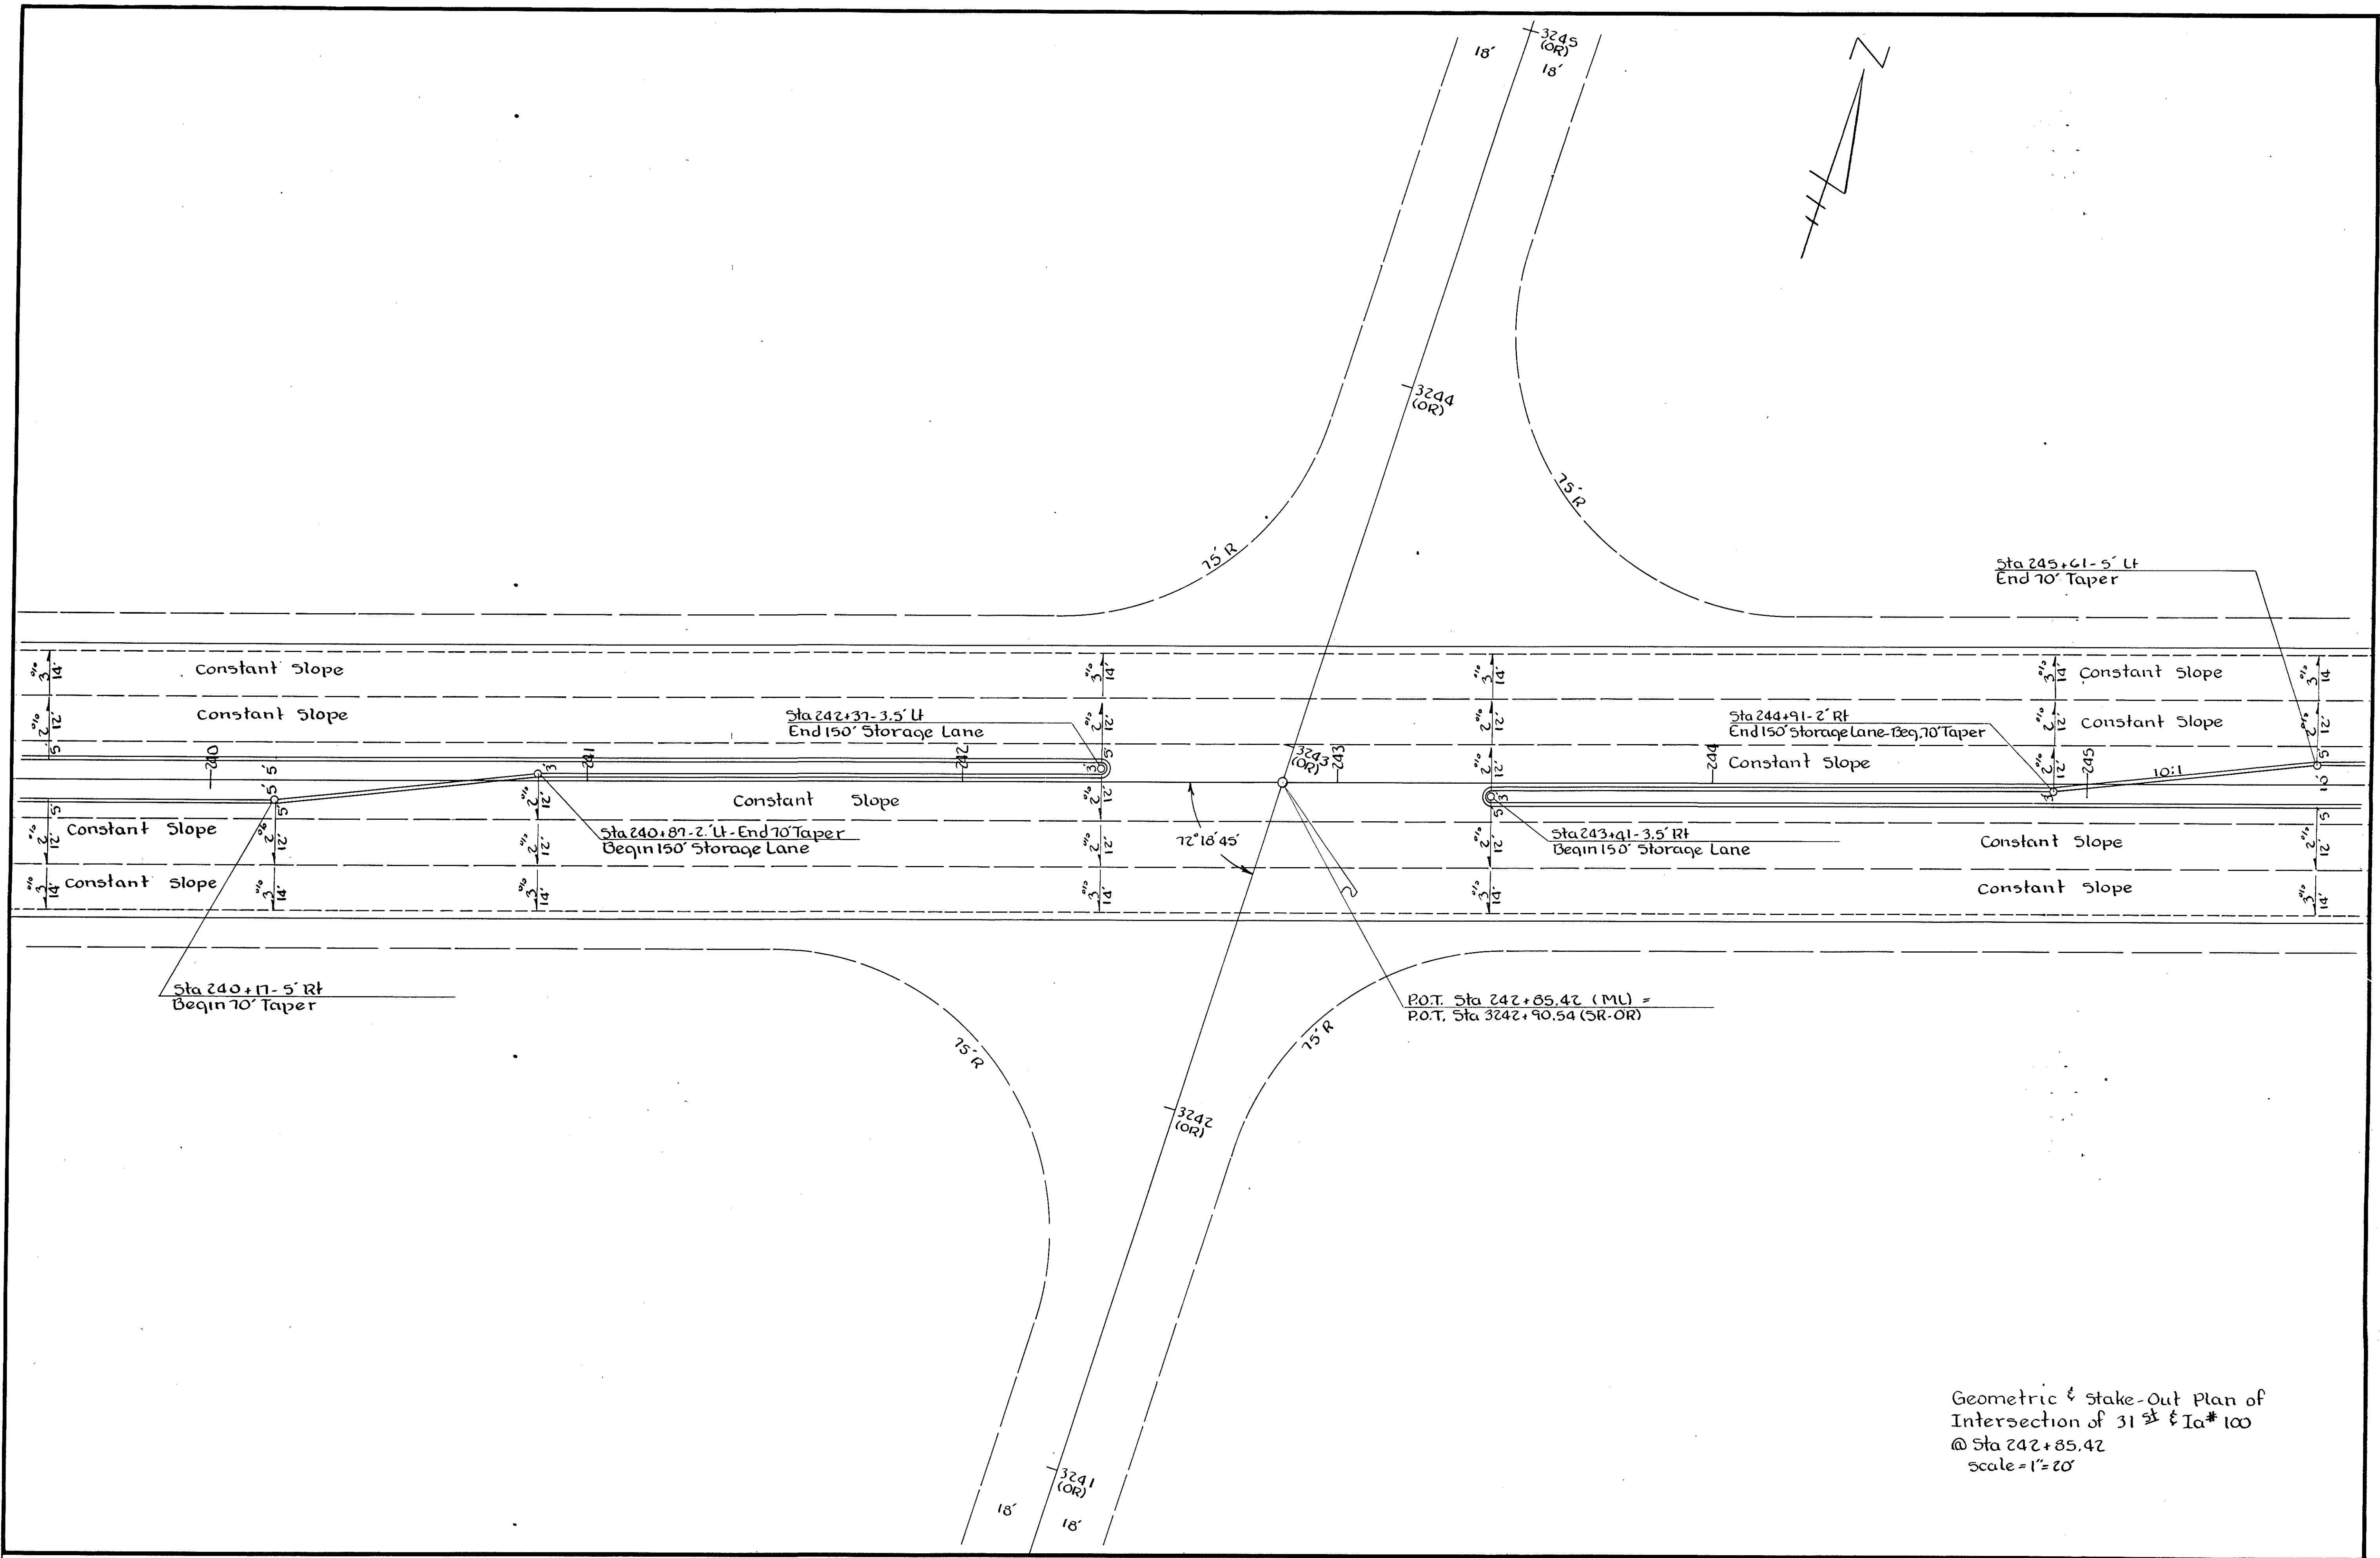

Geometric & stake-out Plan of
Intersection of 31st & Ia#100
@ Sta 242+85.42
Scale = 1"=20'

P-97
D4

ML Curve Data
 $\Delta = 21^\circ 45' 09.00''$
 $D = 0^\circ 45' 00.00''$
 $T = 1467.84'$
 $L = 2900.33'$
 $E = 139.74'$
 $R = 7639.44'$
 Normal Crown

SR Curve Data
 $\Delta = 60^\circ 31' 18.00''$ Lt.
 $D = 13^\circ 00' 00.00''$
 $T = 257.14'$
 $L = 465.55'$
 $E = 69.53'$
 $R = 440.74'$

Curve 3 Data
 $\Delta = 29^\circ 06' 34.91''$
 $D = 38^\circ 11' 49.87''$
 $T = 38.95'$
 $L = 76.21'$
 $E = 4.97'$
 $R = 150'$

Curve 2 Data
 $\Delta = 53^\circ 32' 06.90''$
 $D = 60^\circ 18' 40.85''$
 $T = 47.92'$
 $L = 88.76'$
 $E = 11.40'$
 $R = 95'$

Curve 1 Data
 $\Delta = 14^\circ 43' 07.82''$
 $D = 16^\circ 22' 12.80''$
 $T = 45.20'$
 $L = 89.91'$
 $E = 2.91'$
 $R = 350'$

Sta. 4282+30.66 - 12' Rt.
 Begin 400' Rad.

Curve 4 Data
 $\Delta = 12^\circ 40' 27.31''$
 $D = 14^\circ 19' 26.20''$
 $T = 44.42'$
 $L = 88.48'$
 $E = 2.46'$
 $R = 400'$

Curve 5 Data
 $\Delta = 70^\circ 22' 21.09''$
 $D = 88^\circ 08' 50.47''$
 $T = 45.83'$
 $L = 79.84'$
 $E = 14.53'$
 $R = 65'$

Curve 6 Data
 $\Delta = 12^\circ 25' 57.86''$
 $D = 19^\circ 05' 54.94''$
 $T = 32.68'$
 $L = 65.10'$
 $E = 1.77'$
 $R = 300'$

Sta. 4281+71.39 - 24.5' Lt.
 End 95' Rad. - Begin 150' Rad.

Sta. 279+93.13 (OR) - 46' Lt.
 End 350' Rad. - Begin 95' Rad.

Sta. 279+04.74 (OR) - 34' Lt.
 Begin 350' Rad.

Sta. 4281+48.01 - 30' Rt.
 End 400' Rad. - Begin 65' Rad.

Sta. 281+68.92 (OR) - 34' Lt.
 End 65' Rad.

Sta. 280+30 (OR) - 3.5' Lt.
 End 150' Storage Lane

Sta. 278+80 (OR) - 2' Lt.
 End 70' Taper
 Begin 150' Storage Lane

Sta. 278+10 (OR) - 5.0' Rt.
 Begin 70' Taper

POT Sta. 4281+24.52 (SR)
 = POST 538.55' Back of
 PI Sta. 286+19.50 (OR)


Sta. 281+15 (OR) - 5.0' Lt.

Sta. 281+15 (OR) - 3.5' Lt.
 Radius Pt.
 Sta. 281+14.68 (OR) - 2.04' Lt.
 End 1.5' Rad. - Begin 300' Rad.

Sta. 281+79.26 (OR) - 5.0' Rt.
 End 300' Rad.

POC Sta. 280+70.43 (OR)
 = PI Sta. 4280+67.89 (SR)

Island Radius Points
 Pt 1 = Sta. 280+46.09 (OR) - 49' Lt.
 Pt 2 = Sta. 280+60.44 (OR) - 49' Lt.
 Pt 3 = Sta. 4281+24.37 (SR) - 16' Lt.

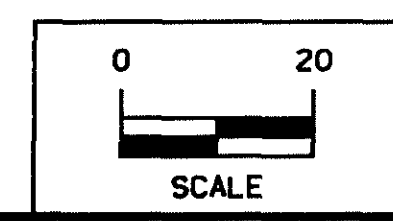

Geometric Plan of Intersection of
 Ia 100 & Munier Road @ Sta. 280+70.43 (OR)

See Sheet L.24 for Stake-Out Plan
 See Sheet L.25 for Edge Profile
 See Sheet L.32 for Jointing Details

OFFICE OF DESIGN • CADD • PRODUCED

STATE OF IOWA

FHWA REGION 7

FISCAL YEAR

LINN



COUNTY

PROJECT NUMBER

NHS-100-1(23)--19-57

SHEET NUMBER

L.23

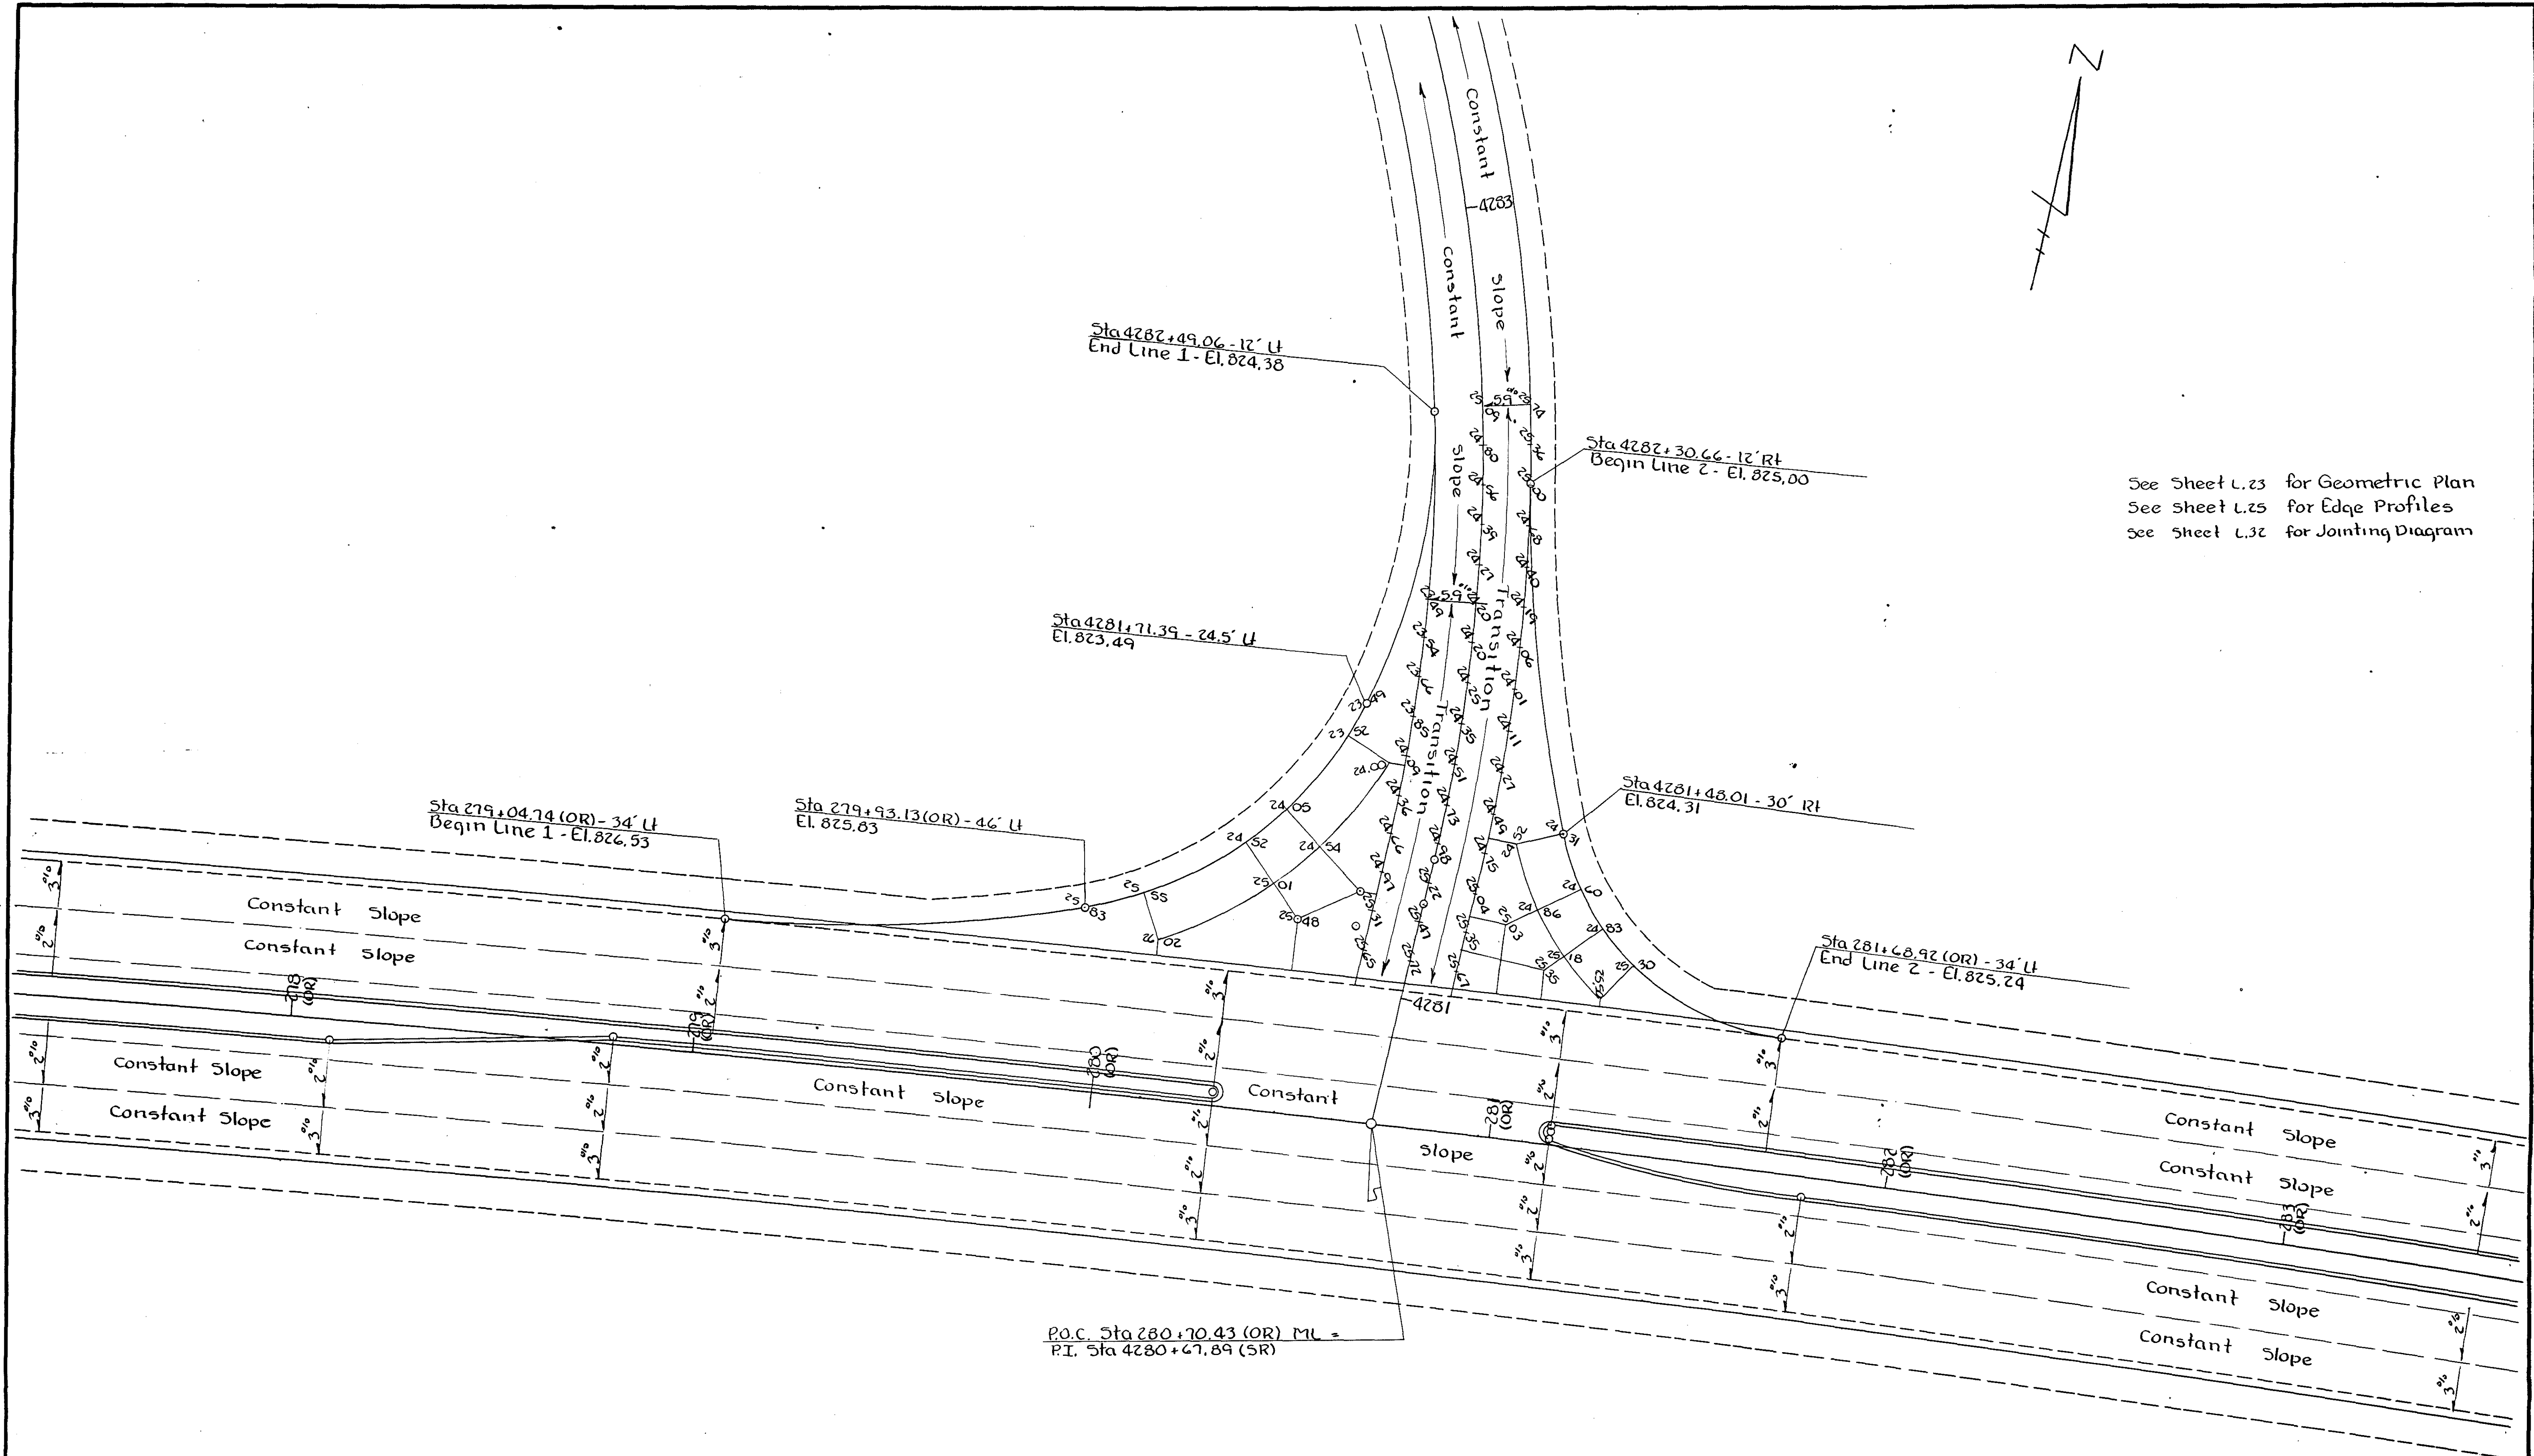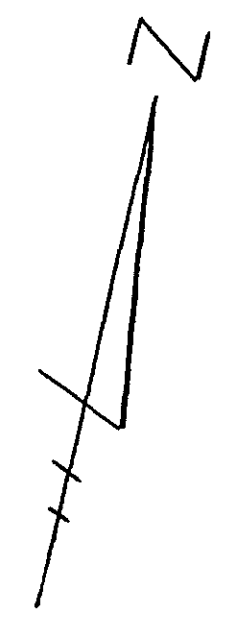


See Sheet L.23 for Geometric Plan
See Sheet L.25 for Edge Profiles
See Sheet L.32 for Jointing Diagram

Stake-Out Plan of Intersection of
Ia*100 & Munier Road @ Sta 280+70.43 (OR)
Scale 1" = 20'

PLAN	DATE	
	BY	
	NOTED	
NO.	NOTE BOOK	NO.
SURVEYED		
ALIGNED		
CHECKED		
BY		

PROFILE	DATE	
	BY	
	NOTED	
NO.	NOTE BOOK	NO.
SURVEYED		
ALIGNED		
CHECKED		
BY		

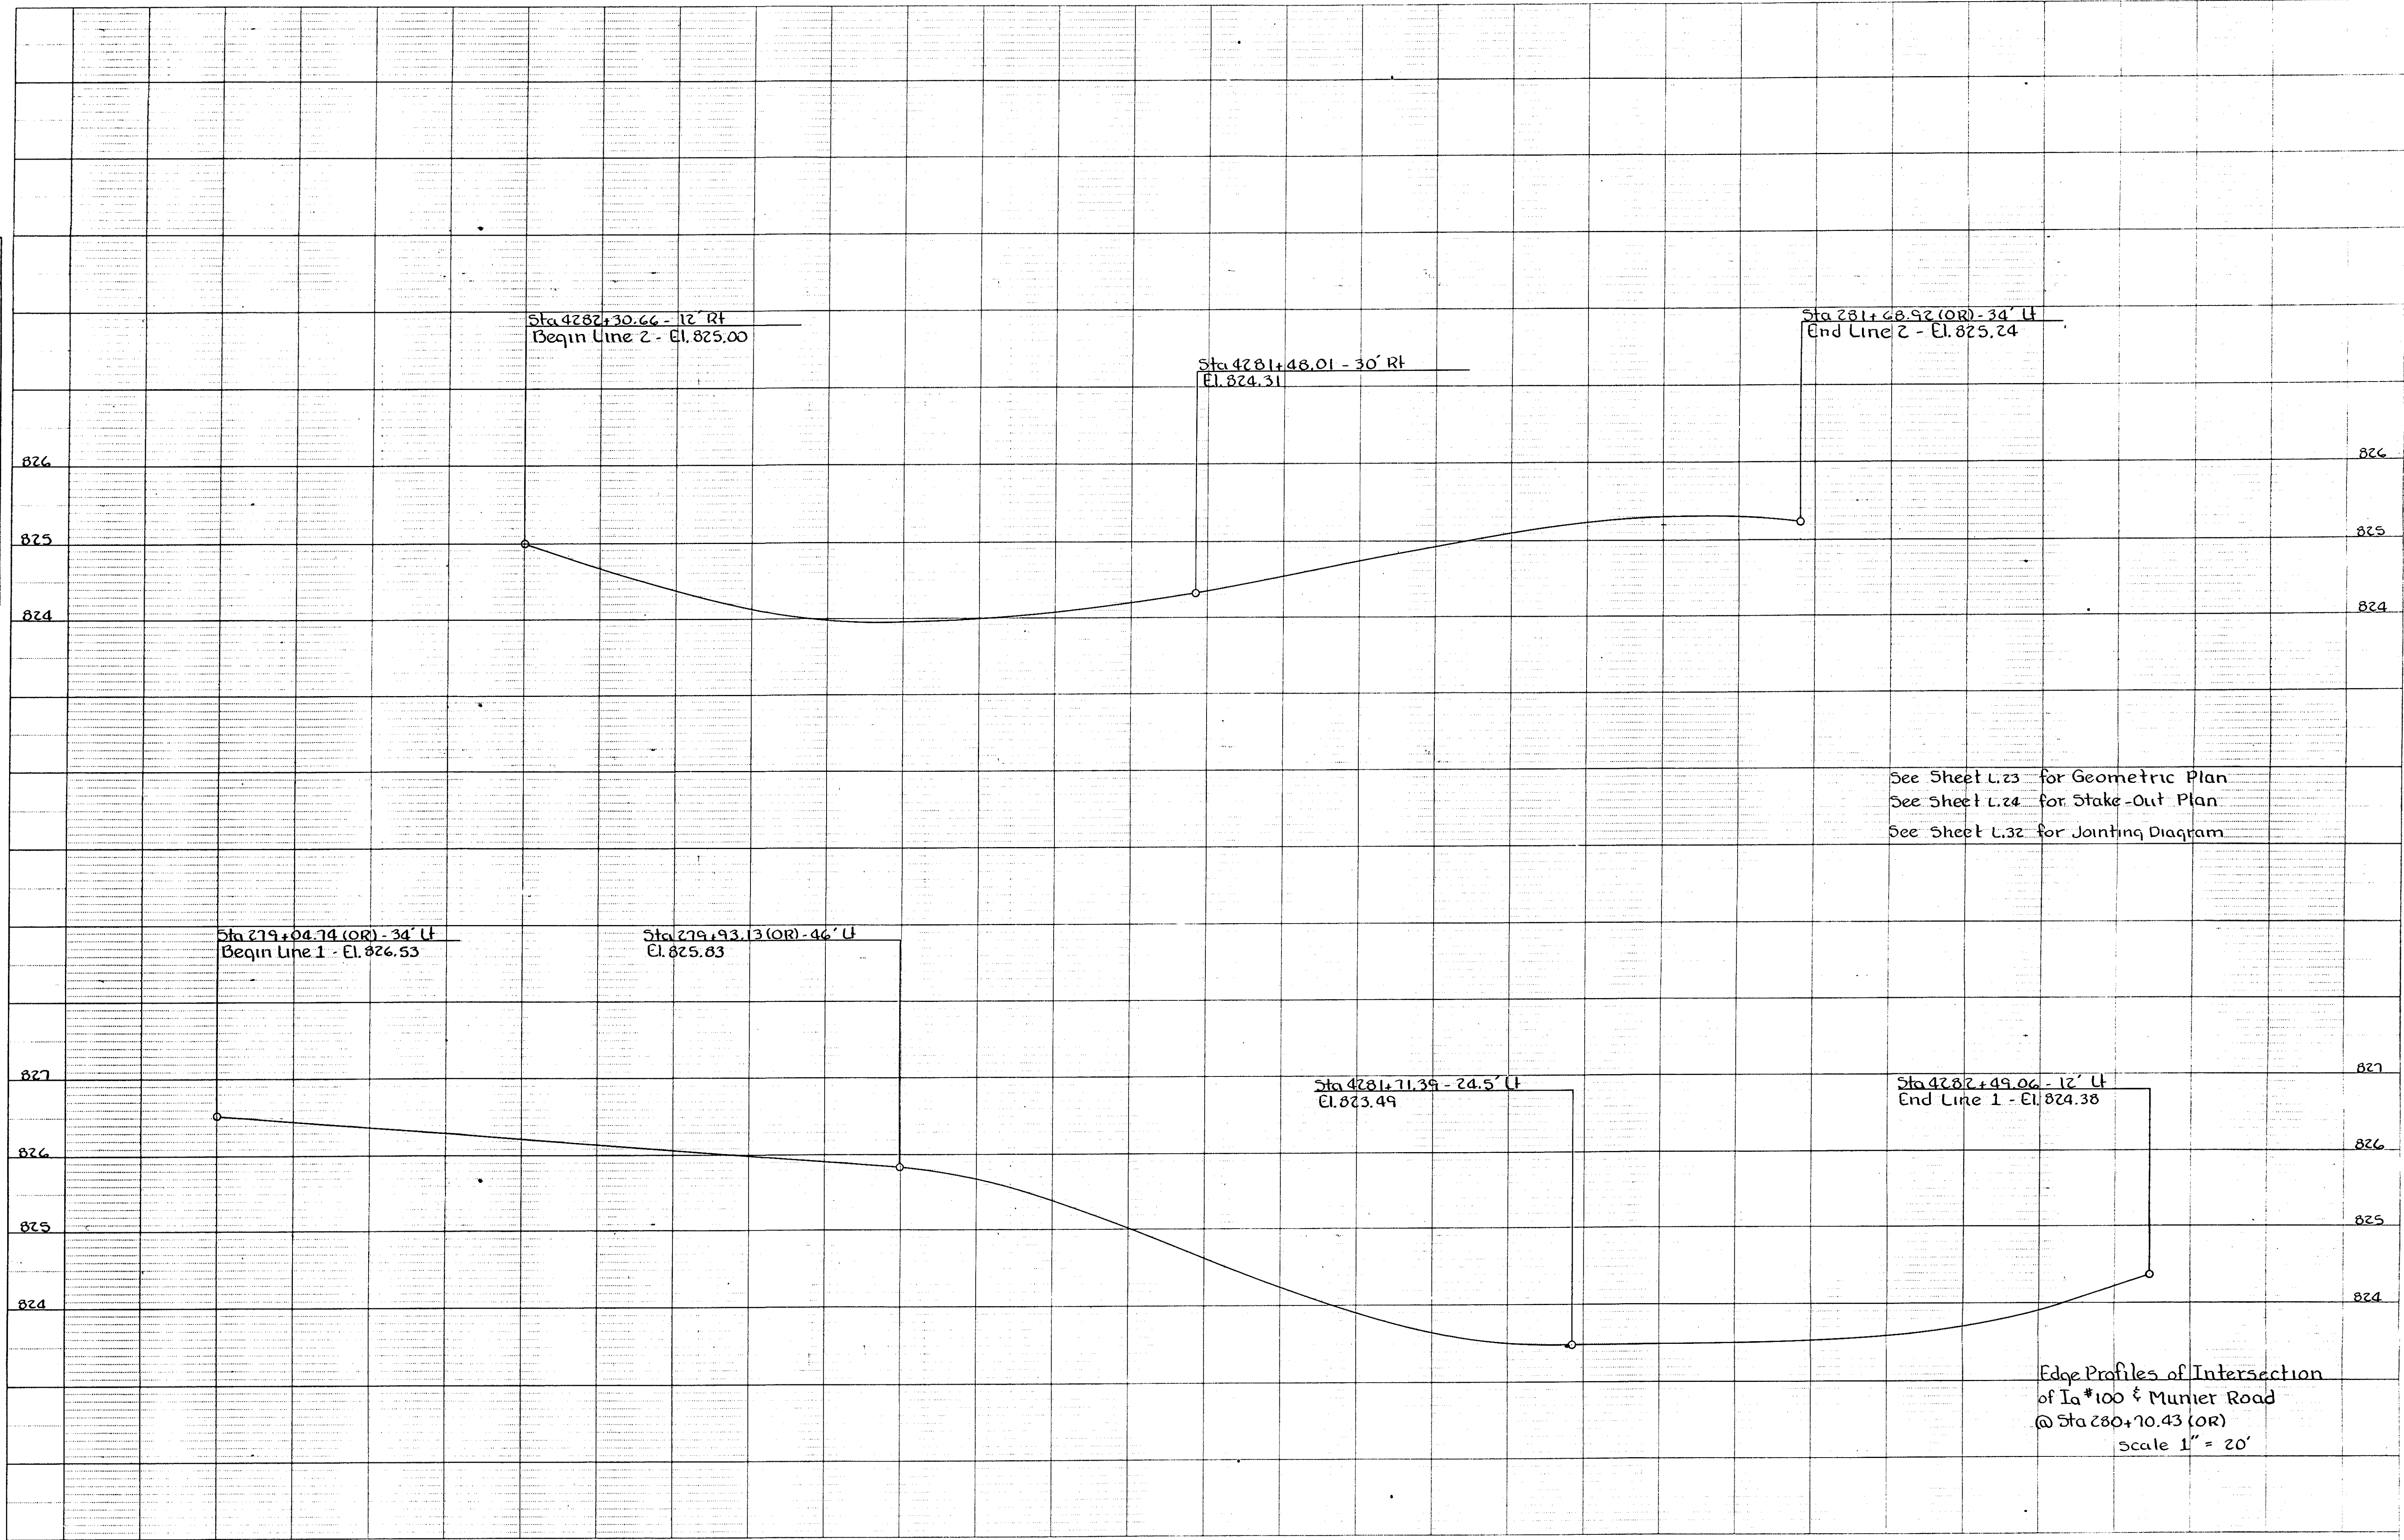

See Sheet L.23 for Geometric Plan
 See Sheet L.24 for Stake-Out Plan
 See Sheet L.32 for Jointing Diagram


Edge Profiles of Intersection
 of Ia #100 & Munier Road
 @ Sta 280+70.43 (OR)
 Scale 1" = 20'

P. 100
 04

CIRCULAR CURVE DATA

101-10C
10-02-90

NO.	Δ	D	T	L	E	R
1	92°31'48"	143°14'22"	41.81	64.60'	17.86	40'
2	92°31'48"	143°14'22"	41.81	64.60'	17.86	40'
3	36°24'36"	47°44'47"	39.47	76.26'	6.32	120'
4	92°40'12"	114°35'30"	52.39	80.87'	22.42	50'
5	76°51'36"	114°35'30"	39.67	67.07'	13.83	50'

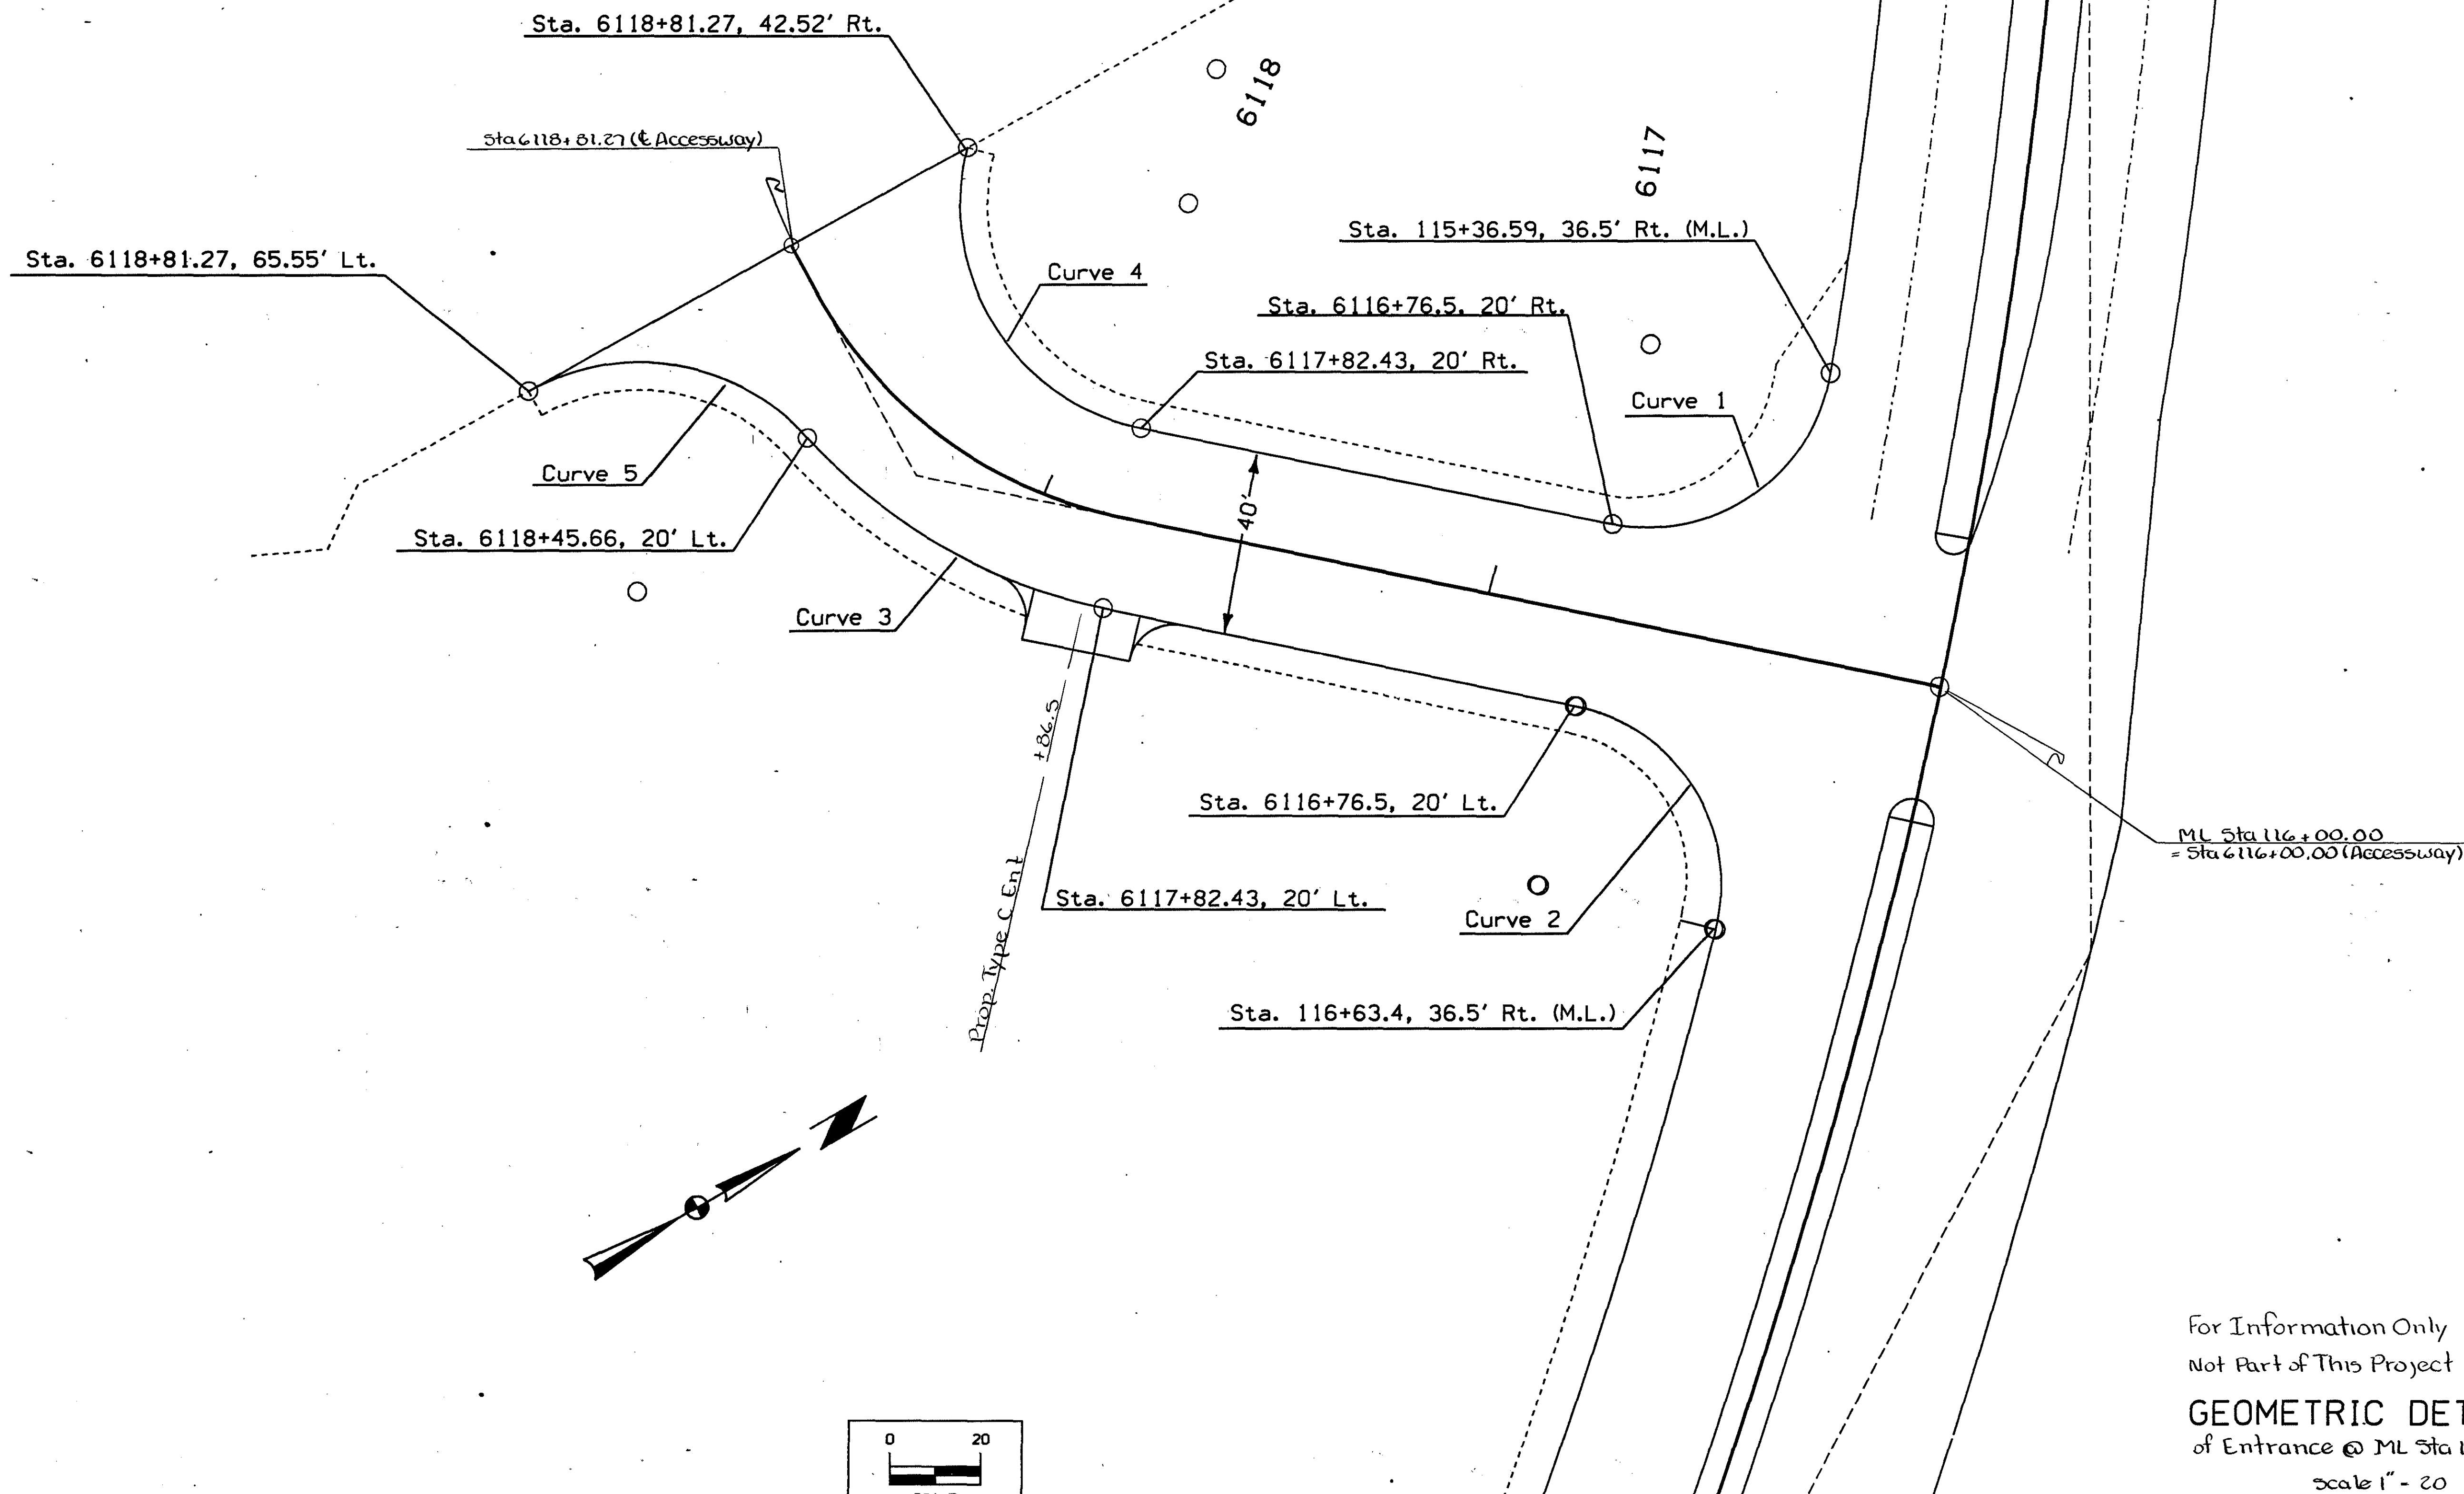

For Information Only
Not Part of This Project
GEOMETRIC DETAILS
of Entrance @ ML Sta 116+00
Scale 1" = 20'

OFFICE OF DESIGN • CADD • PRODUCED

STATE OF IOWA

FHWA REGION 7

FISCAL YEAR

LINN


COUNTY

PROJECT NUMBER

NHS-100-1(23)--19-57

SHEET NUMBER

L.26

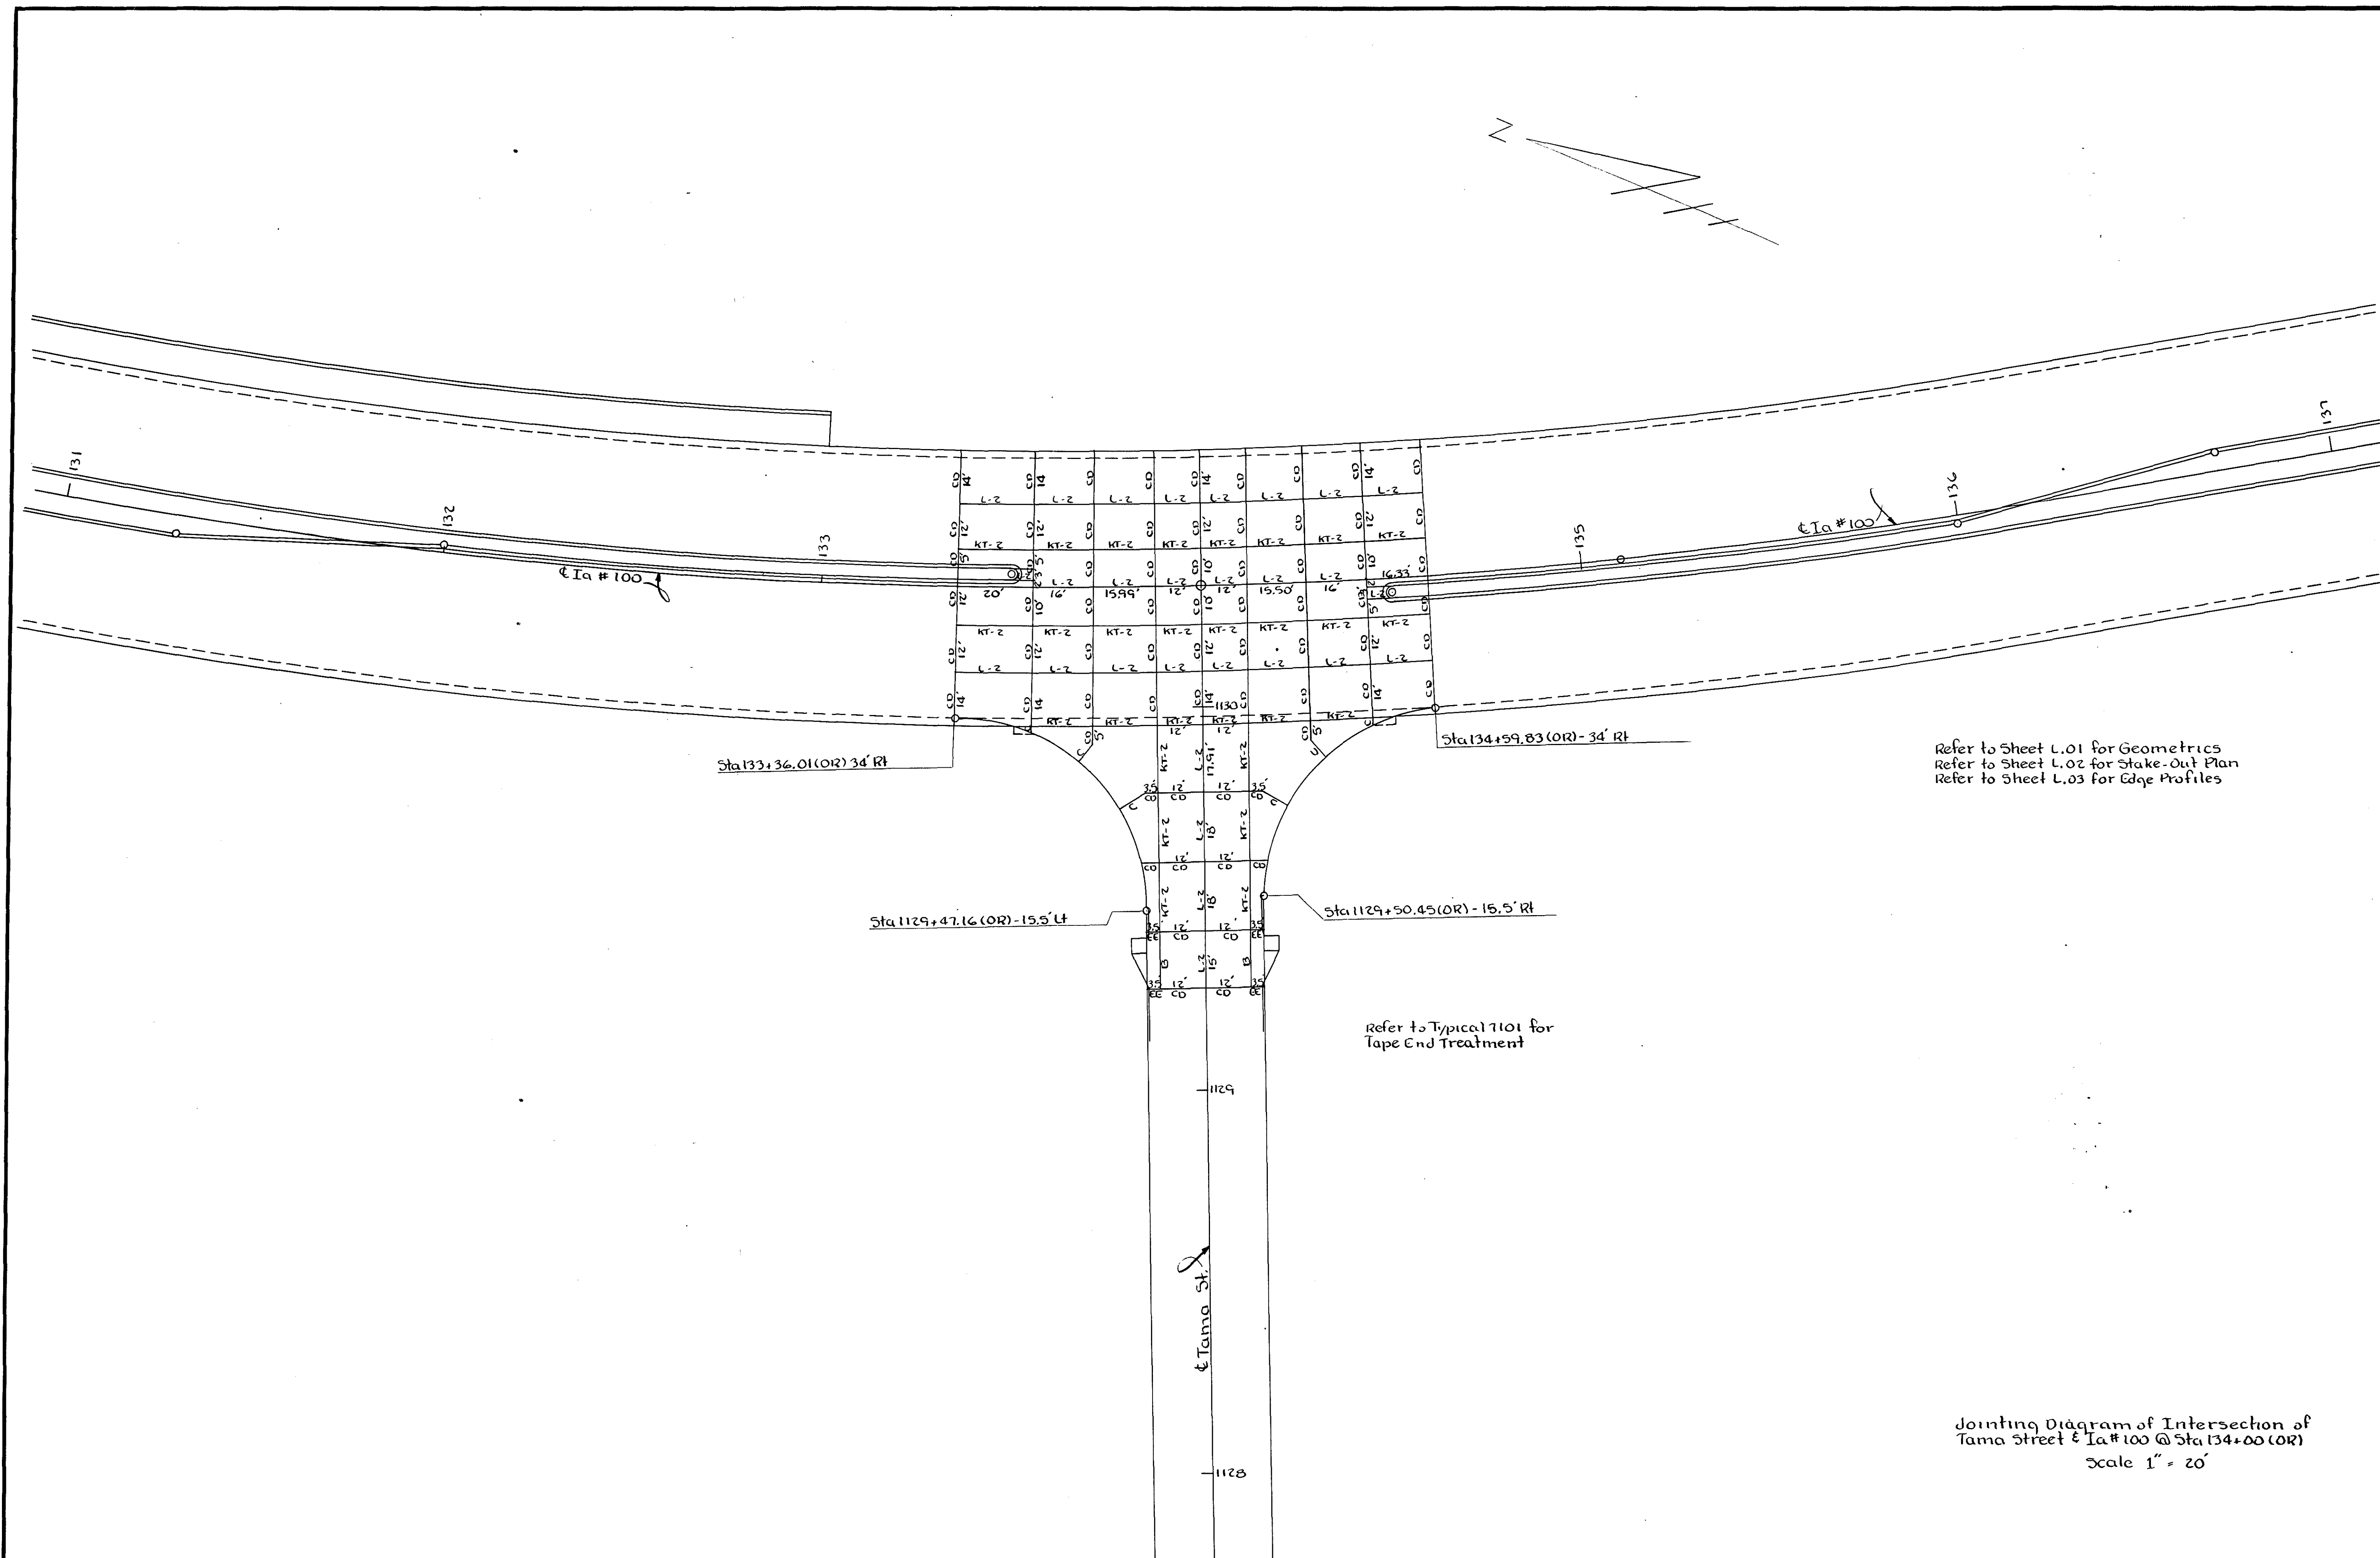

Refer to Sheet L.01 for Geometrics
 Refer to Sheet L.02 for Stake-Out Plan
 Refer to Sheet L.03 for Edge Profiles

Refer to Typical 17101 for
 Tape End Treatment


Jointing Diagram of Intersection of
 Tama Street & Ia #100 @ Sta 134+00 (OR)
 Scale 1" = 20'

2350 S.F.
 I.D.T. #000-316920

COUNTY Linn

PROJECT NUMBER	NHS-100-1(23)-19-57
----------------	---------------------

STATE	FHWA Region	FISCAL YEAR	SHEET NO.	TOTAL SHEETS
IOWA	7		L.27	L.27

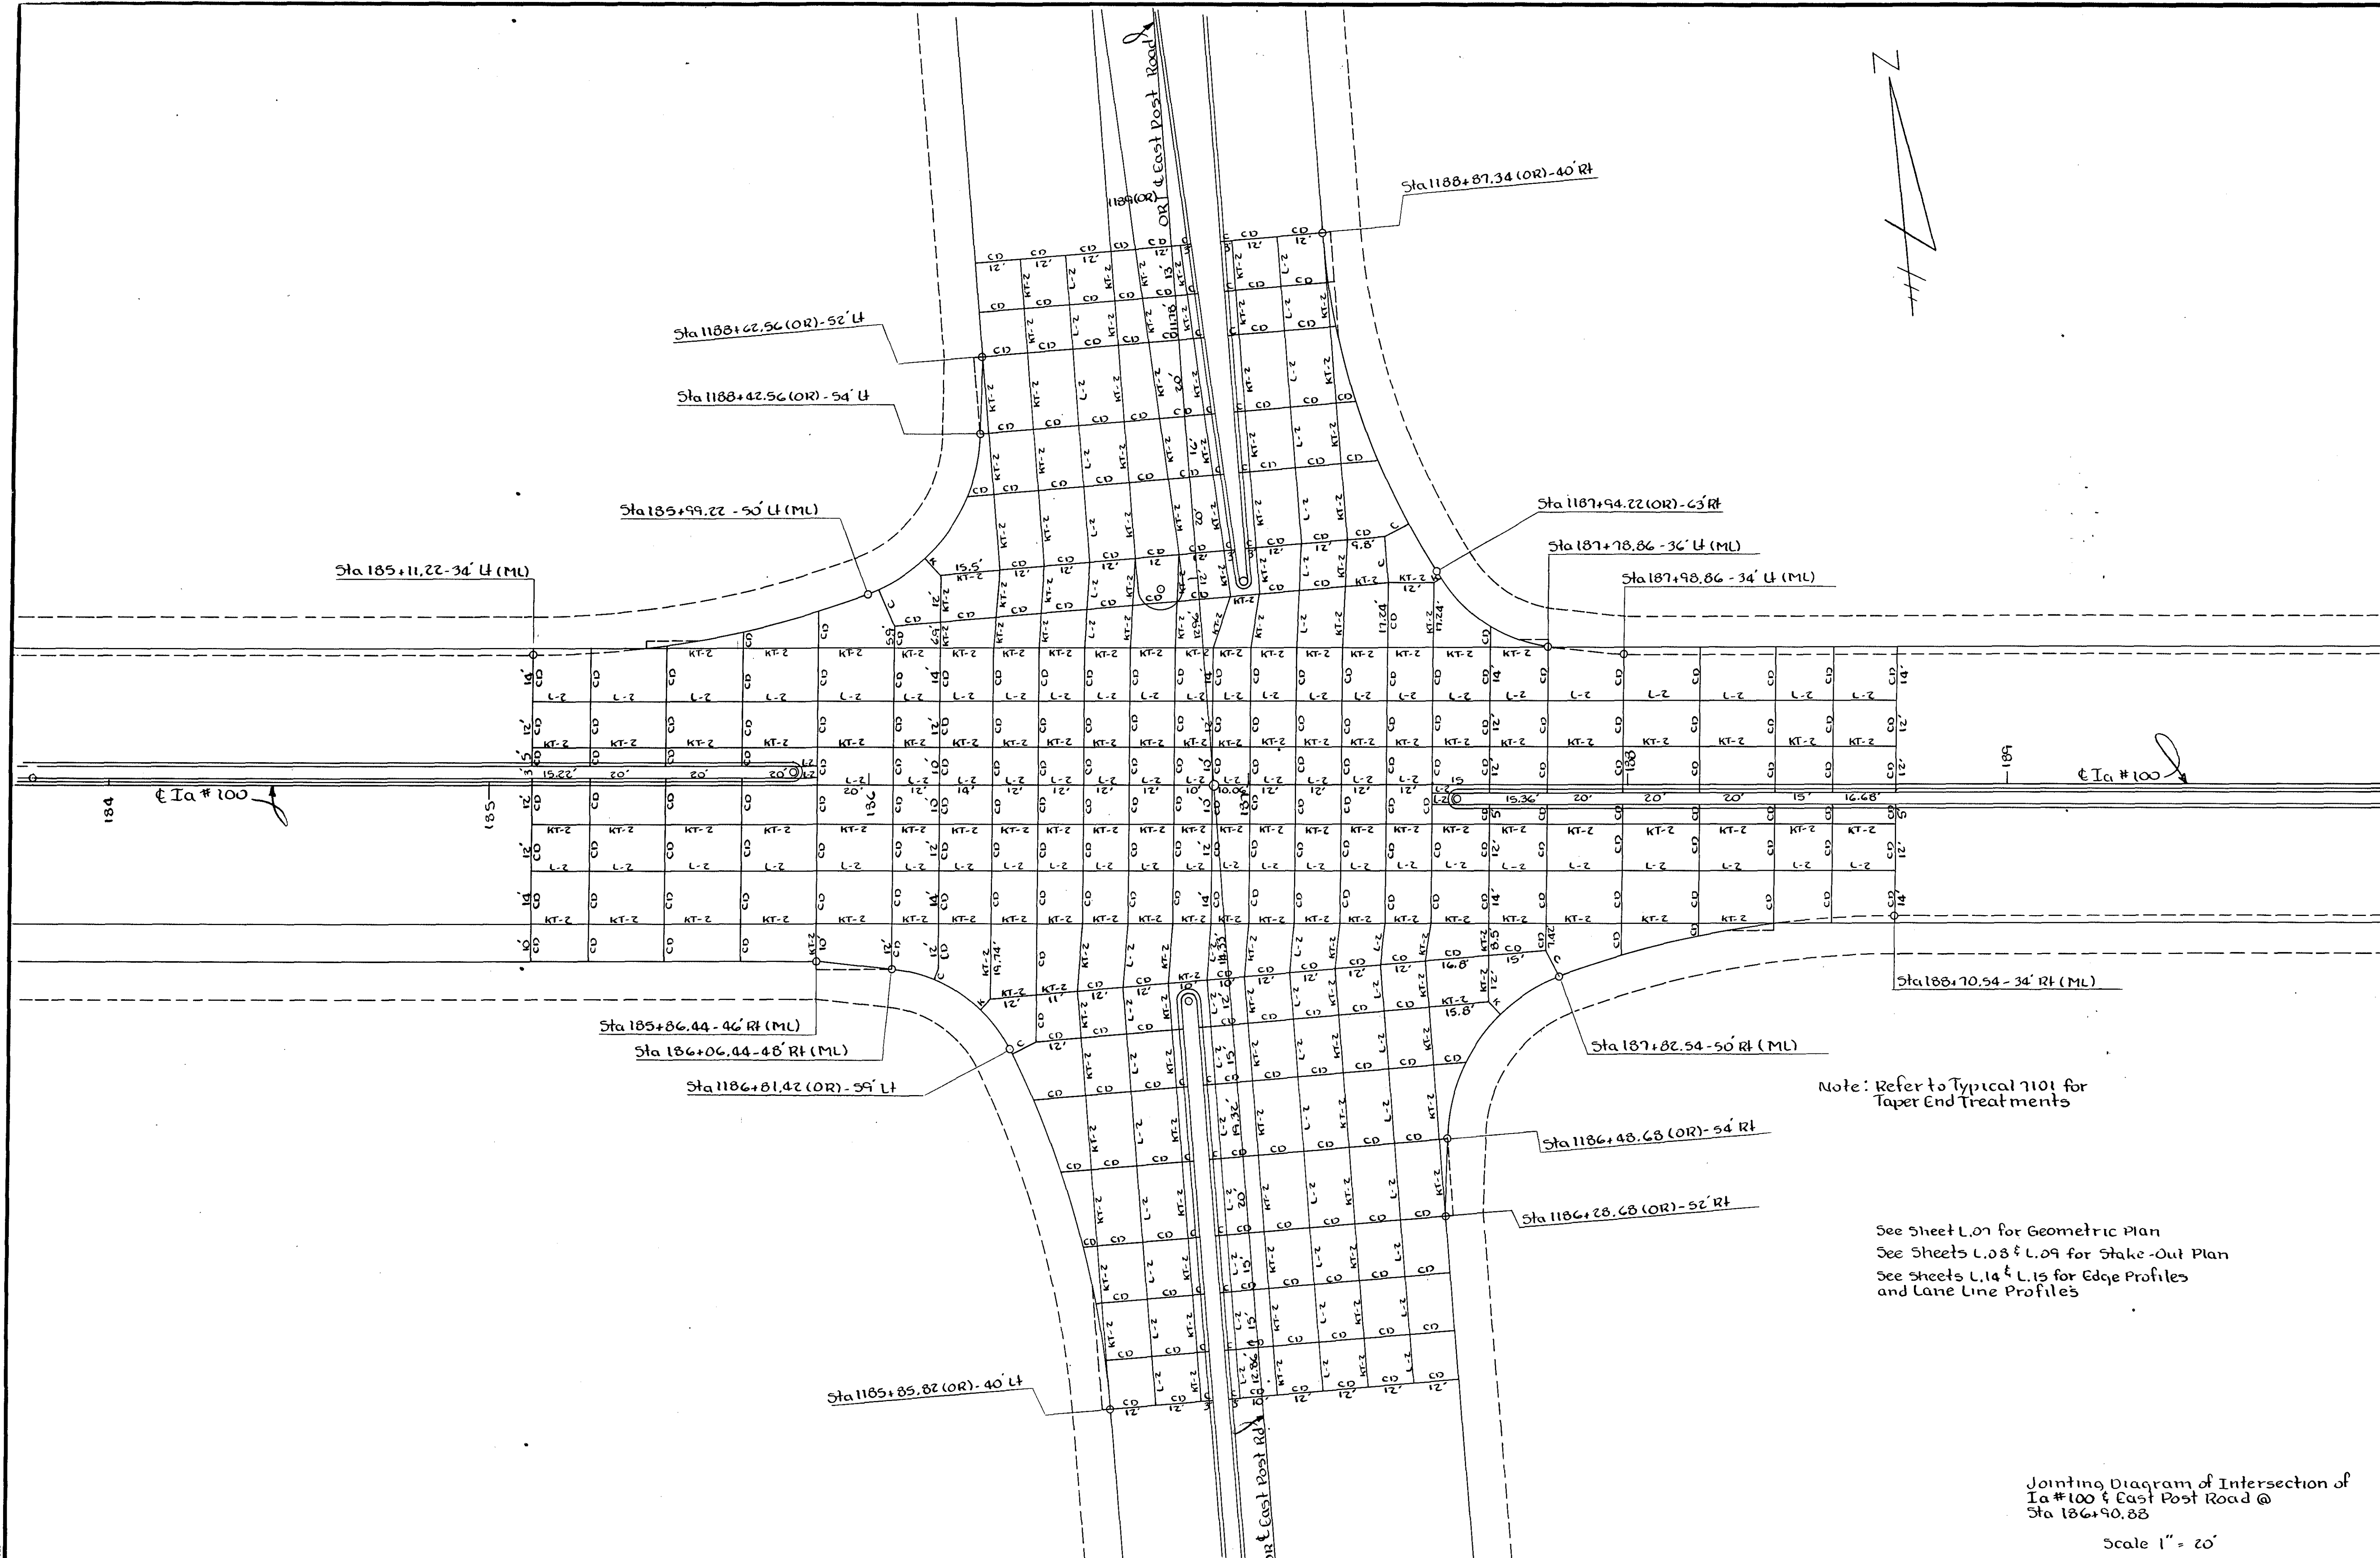

Jointing Diagram of Intersection of
Ia #100 & East Post Road @
Sta 186+90.88


Scale 1" = 20'

14,670 Sq Ft South - 12,350 Sq Ft North
I.D.T. #000316920


COUNTY Linn

PROJECT NUMBER
NH5-100-1(23)--19-57

STATE	FHWA Region	FISCAL YEAR	SHEET NO.	TOTAL SHEETS
IOWA	7		L.29	

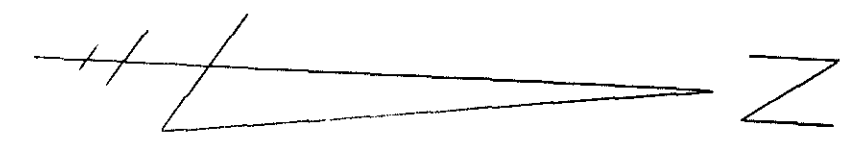

Refer to Sheet L.16 for Geometrics
Refer to Sheet L.17 for Stake-Out Plan
Refer to Sheet L.18 for Edge Profiles

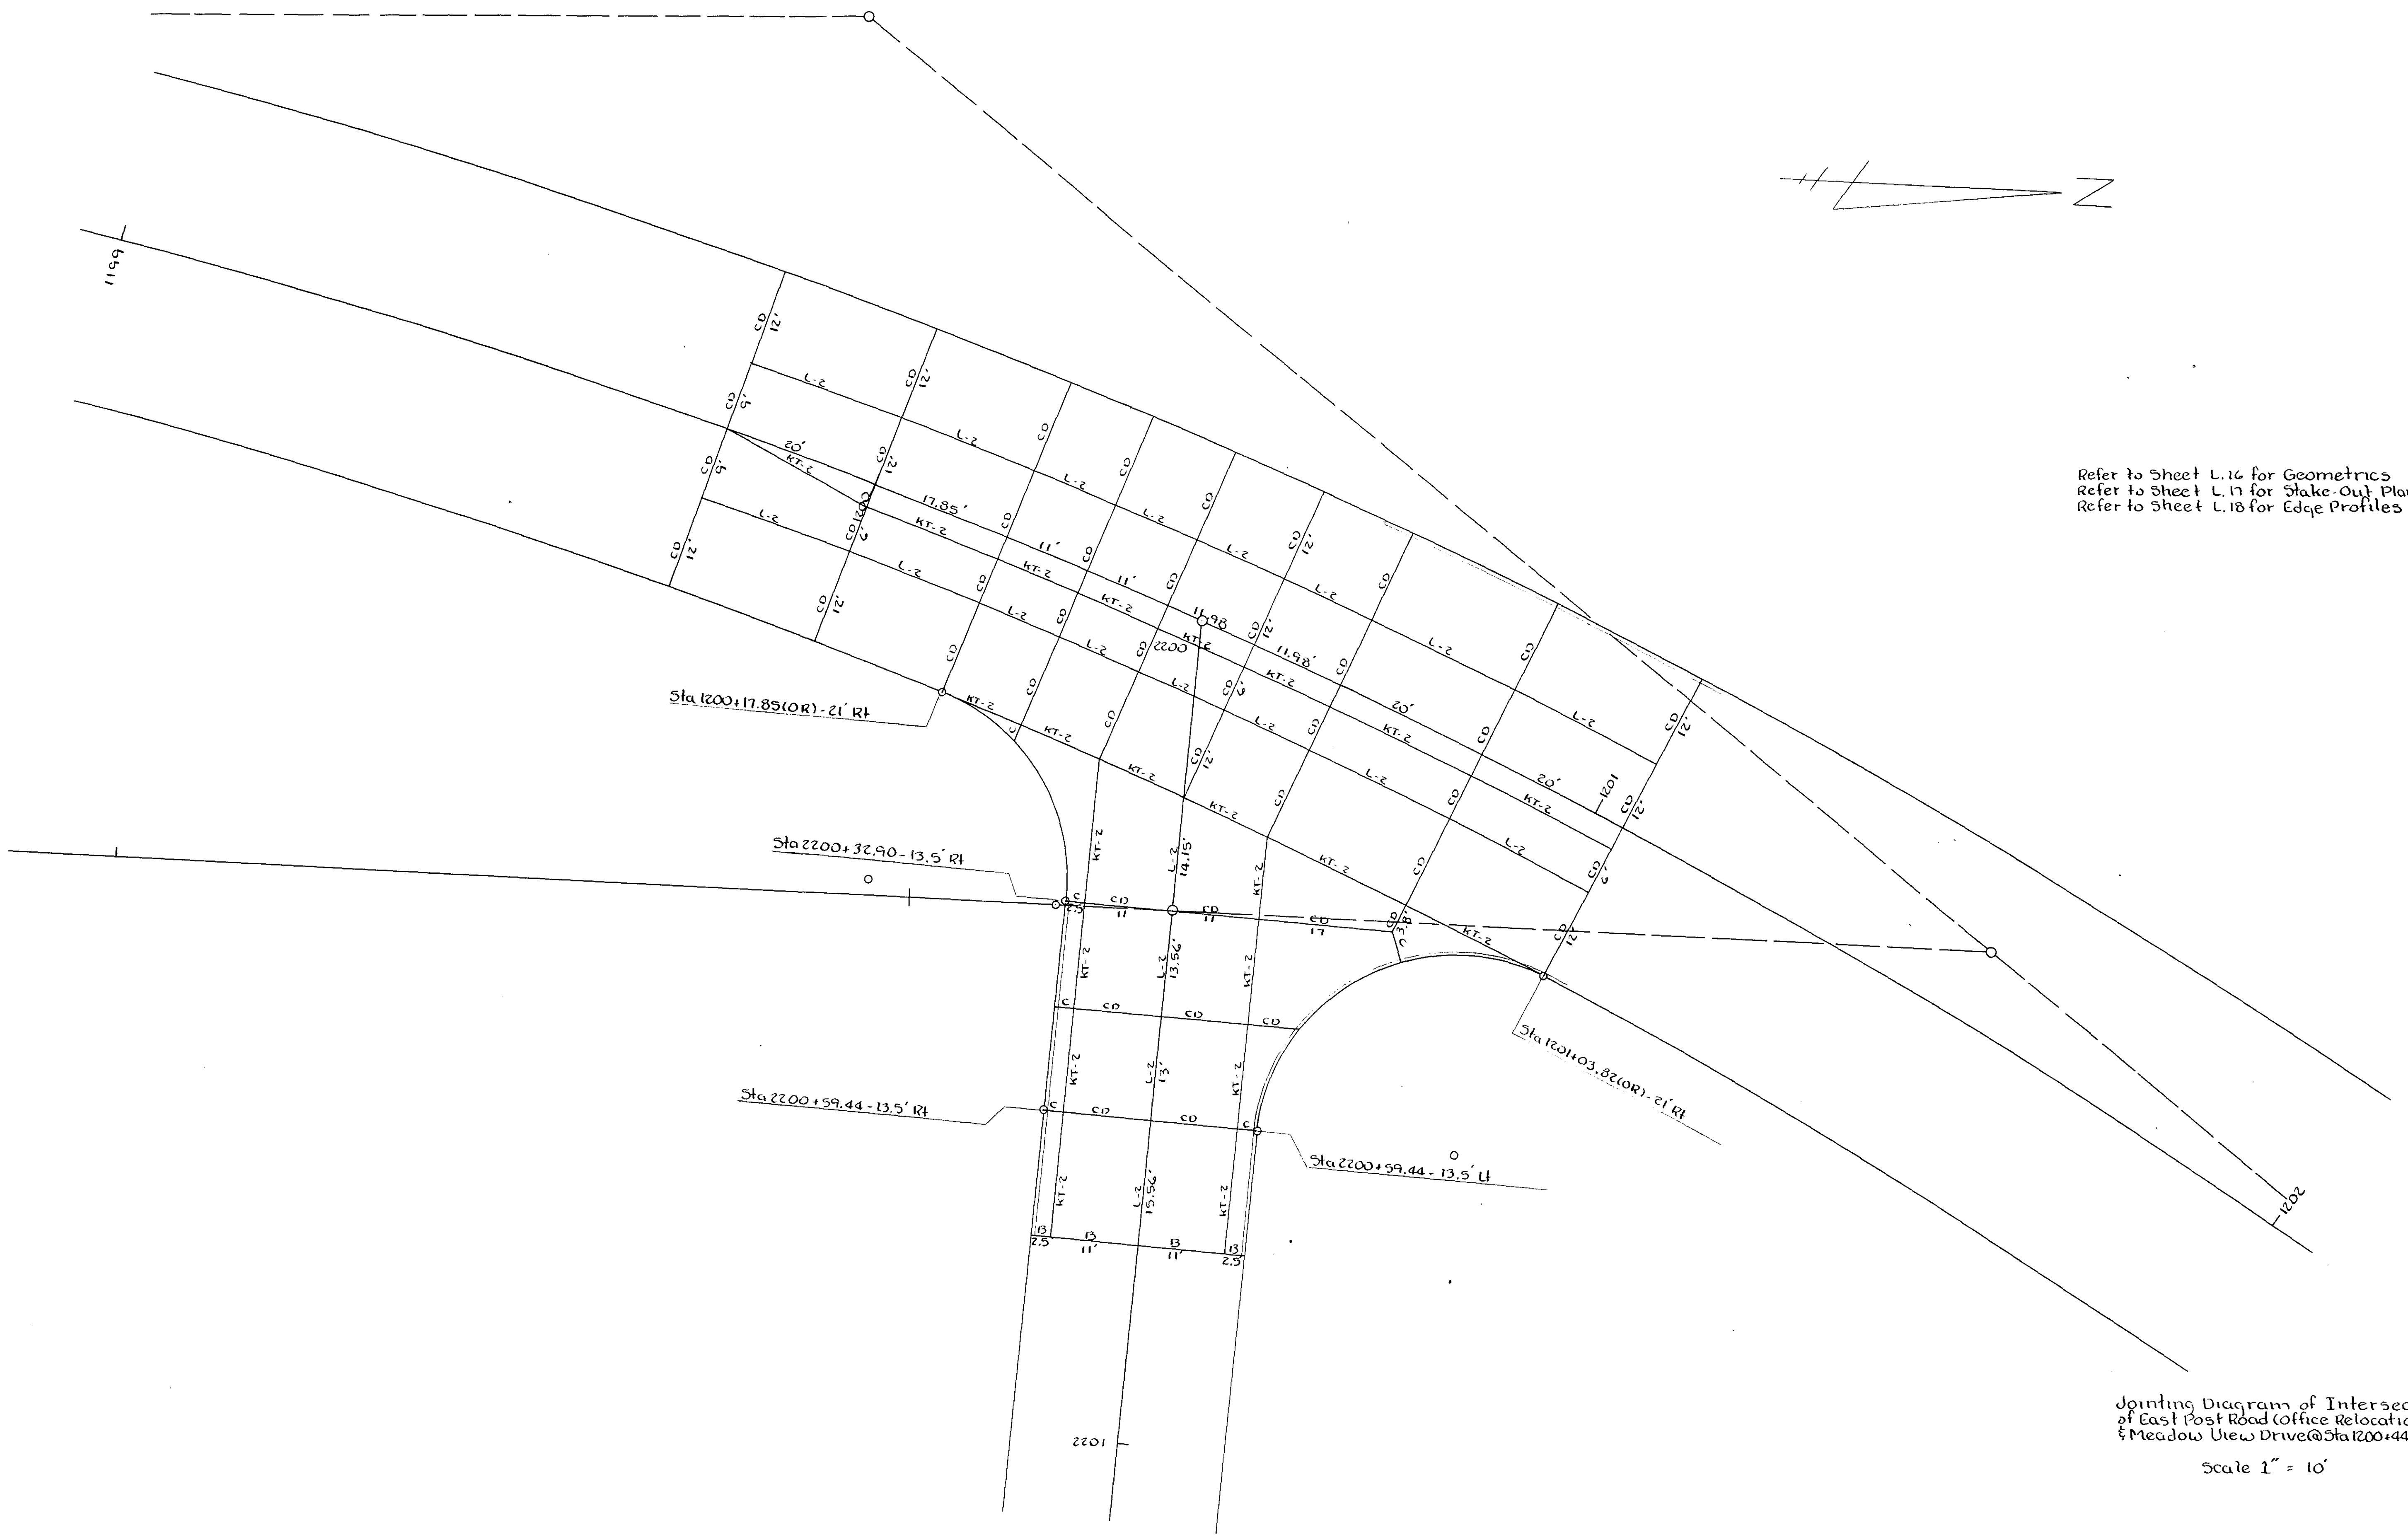

Jointing Diagram of Intersection
of East Post Road (Office Relocation)
& Meadow View Drive @ Sta 1200+44.69(OR)

Scale 1" = 10'

1394-5451
I.C.O.T. #000-316920

COUNTY Linn

PROJECT NUMBER
NH5-(00-1(23))-19-57

STATE	FHWA Region	FISCAL YEAR	SHEET NO.	TOTAL SHEETS
IOWA	7			L.30



Sta. 2216+74.38 - 14.5 Lt.
End 45' Taper - 15:1

Sta. 2216+29.38 - 17.5 Lt.
End 45' Rad - Begin 45' Taper

Sta. 2216+39.05 - 14.5 Rt.
Begin 50' Rad.

Sta. 215+10.01 - 45 Lt.
End 110' Rad. - Begin 45' Rad.

Sta. 214+65.5 - 36 Lt.
Begin 110' Rad.

Sta. 216+21.58 - 34 Lt.
End 50' Rad.

See Sheet L.19 for Geometric Plan
See Sheet L.20 for Stake-Out Plan
See Sheet L.21 for Edge Profiles

Sta. 214+39.13 - 36 Rt.
Begin 105' Rad.

Sta. 217+09.13 - 36 Rt.
End 250' Rad

Sta. 216+26.83 - 51 Rt.
End 80' Rad. - Begin 250' Rad.


Sta. 2214+38.06 - 17.14 Lt. of SR
12' Lt. of Tangent - End 105' Rad.

Sta. 2214+37.16 - 25 Rt.
End 150' Rad. - Begin 80' Rad.

Sta. 2213+63.36 - 12 Rt.
Begin 150' Rad.

Joining Layout of Intersection
of Ia 100 & 22nd St. @
ML Sta. 215+49.73


Scale 1" = 20'

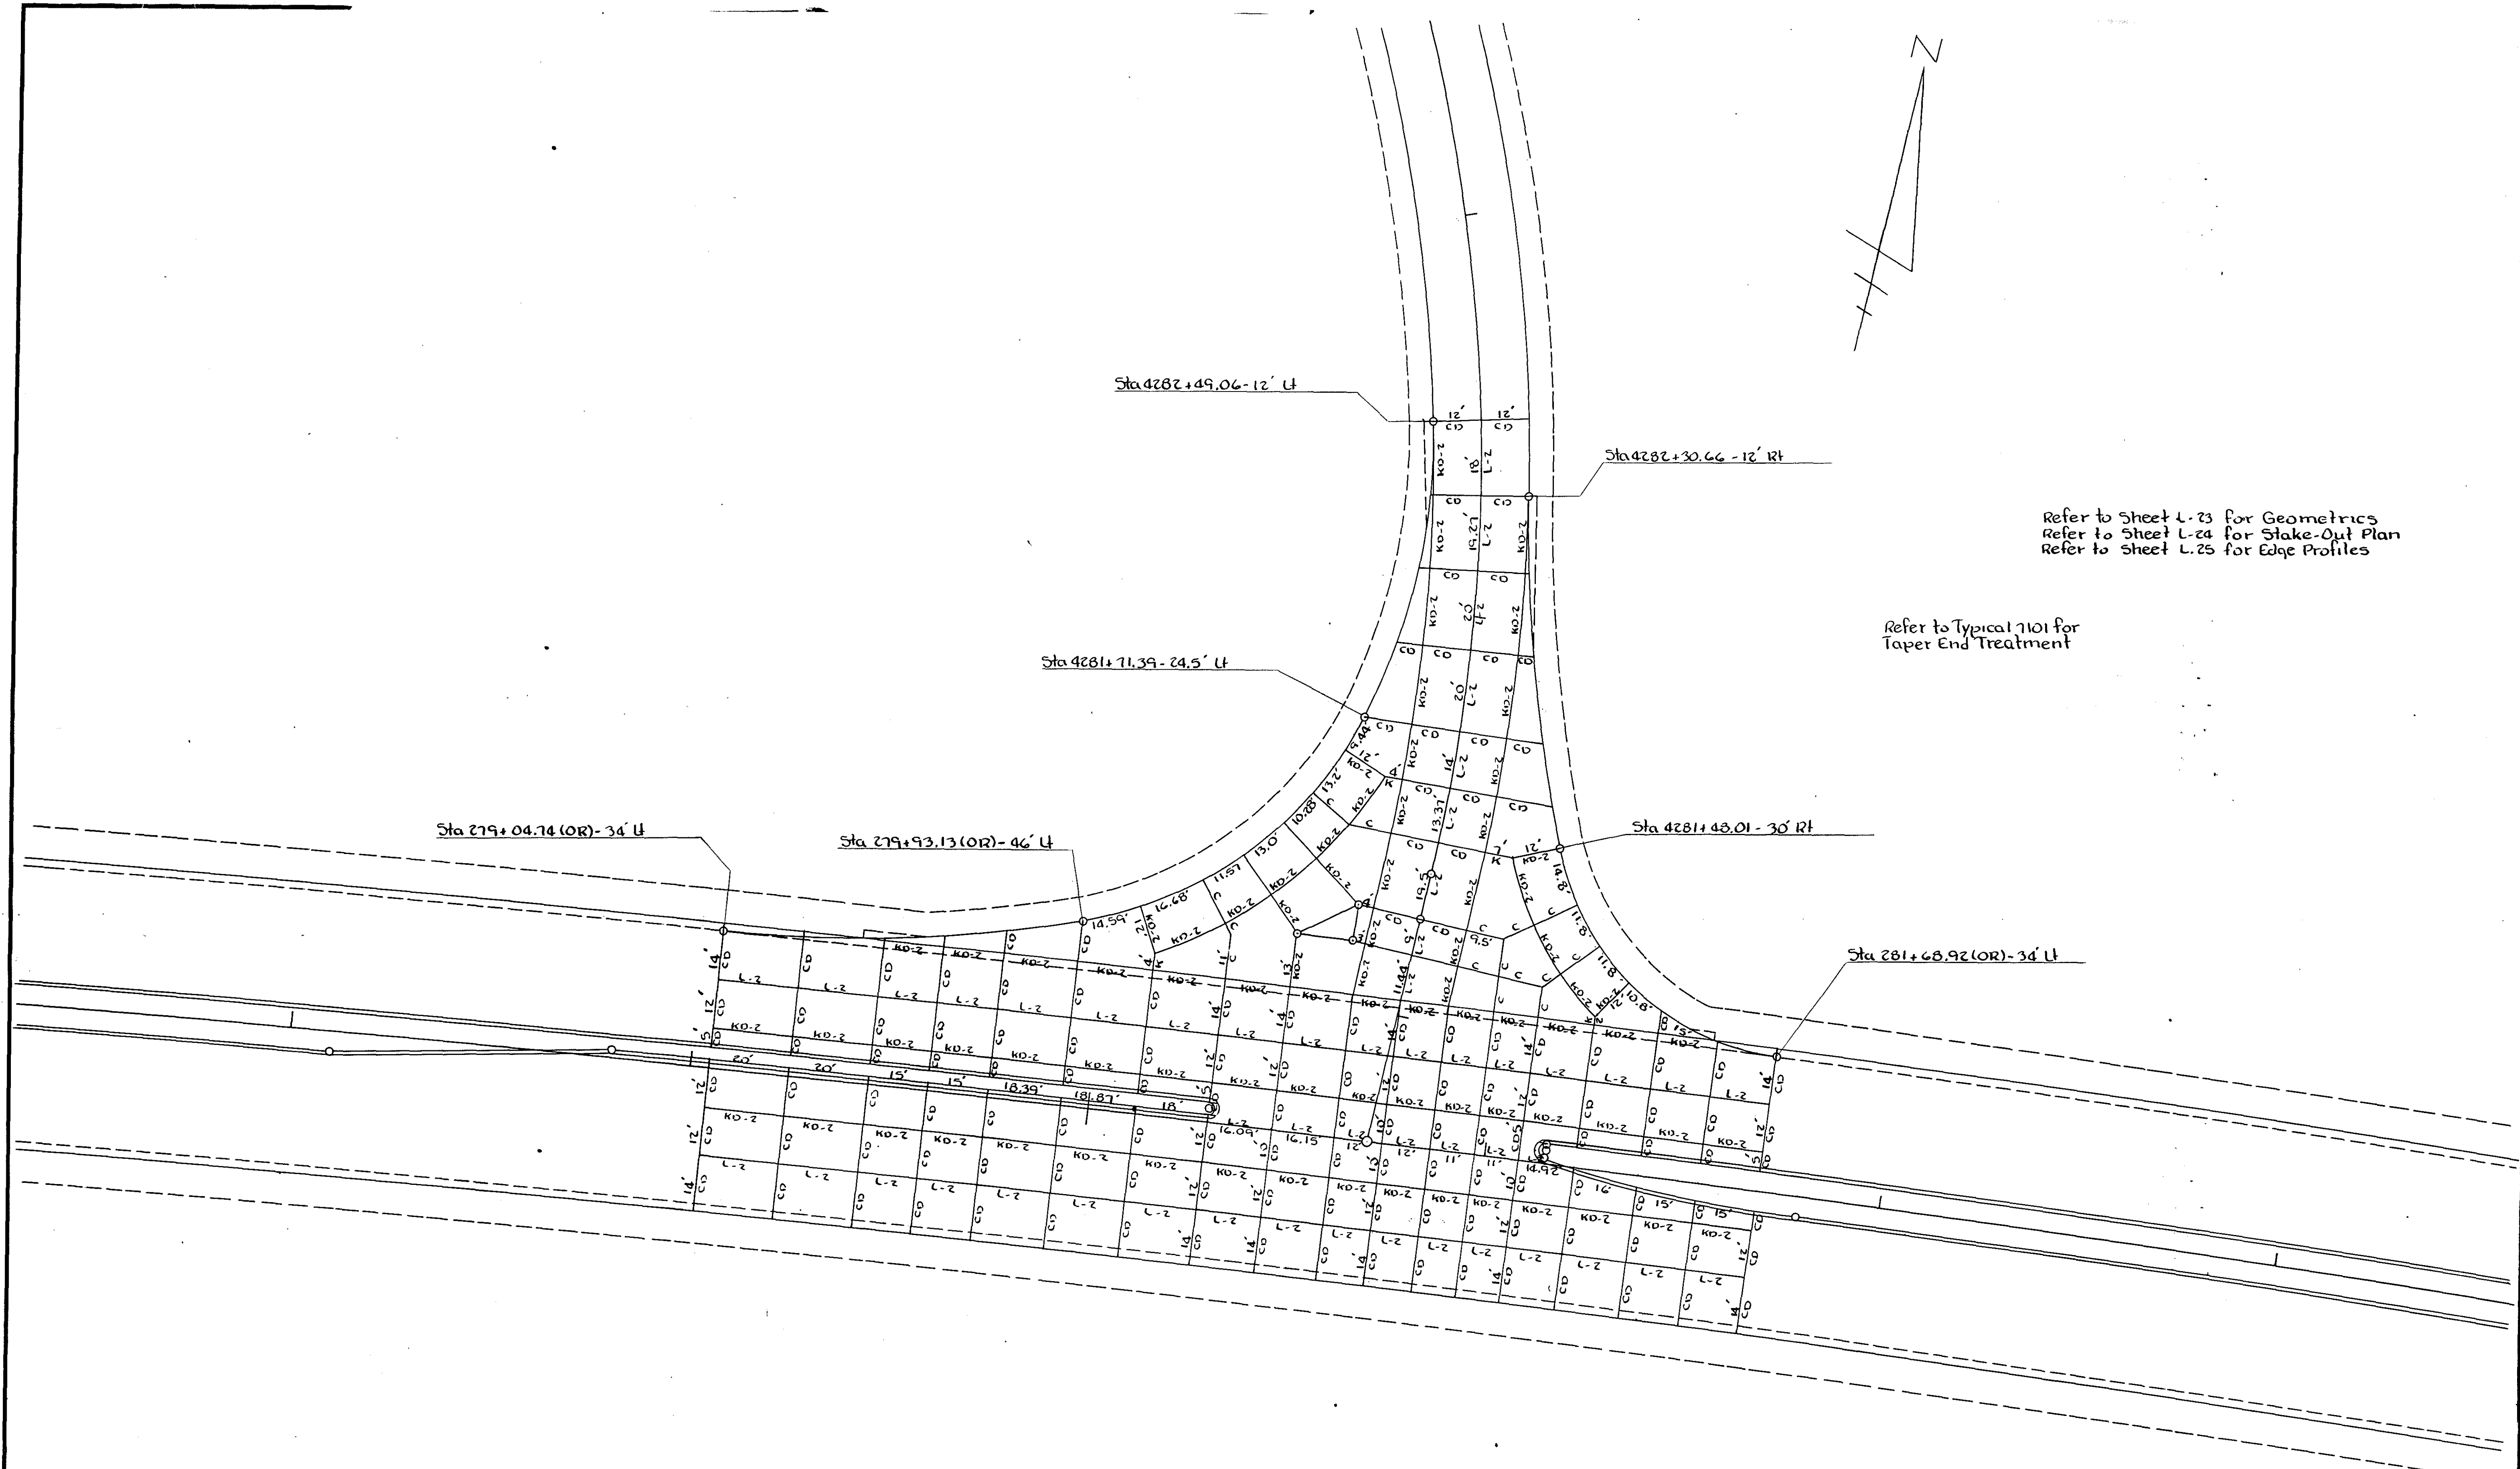

Refer to Sheet L-23 for Geometrics
Refer to Sheet L-24 for Stake-Out Plan
Refer to Sheet L-25 for Edge Profiles


Refer to Typical 7101 for
Taper End Treatment

Jointing Diagram of Intersection of
Ia #100 and Munier Road @ Sta 280+70.43 (OR)
Scale 1" = 20'

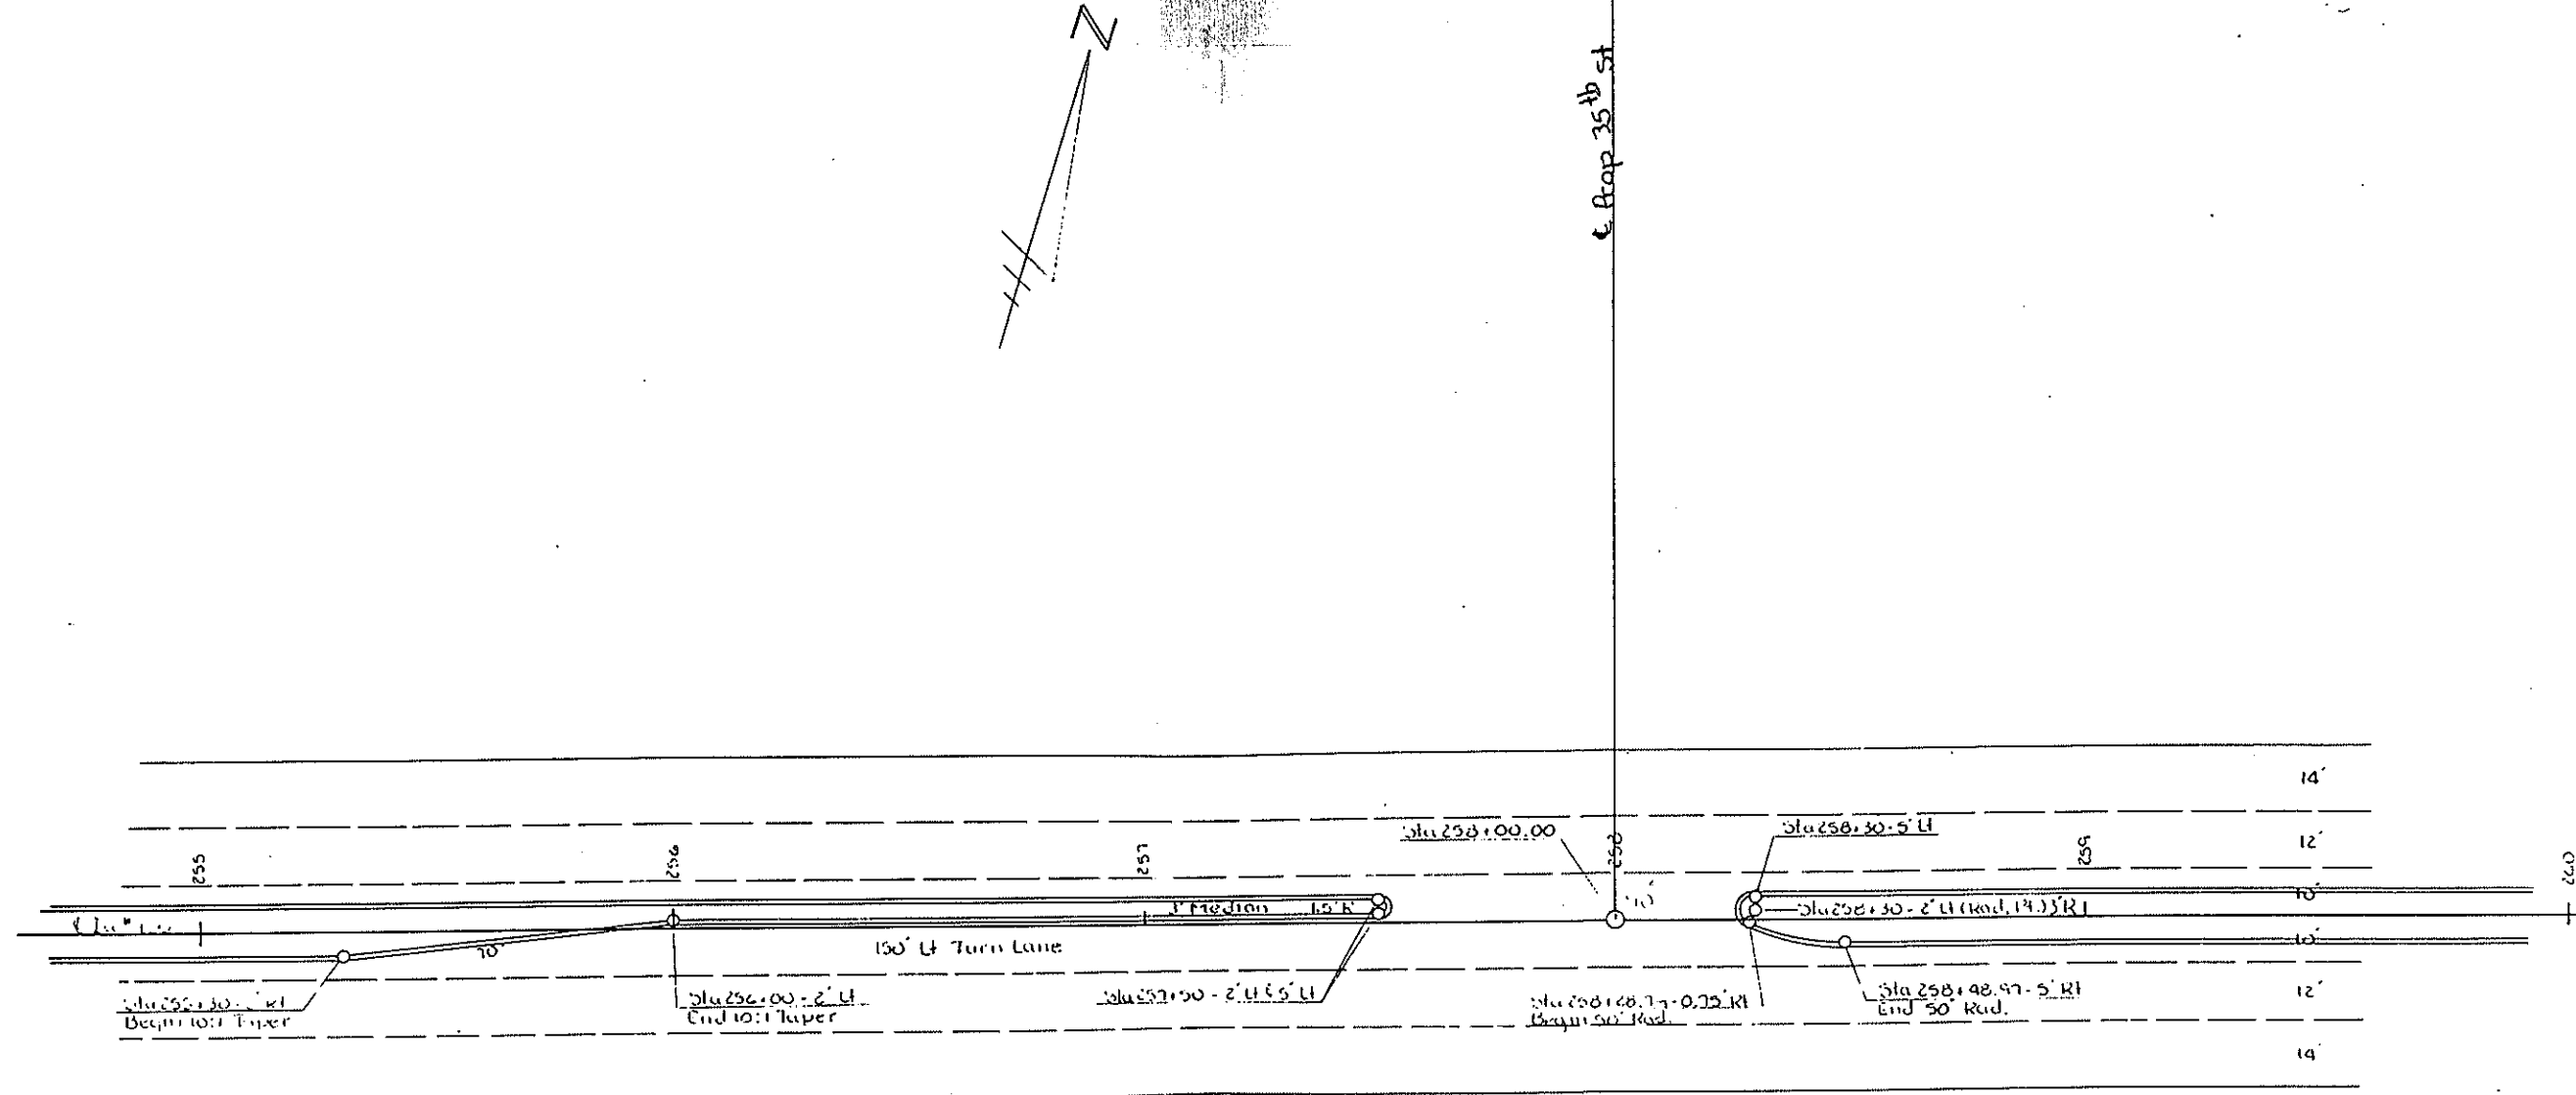

Geometric Plan for Proposed
Left Turn Lane @ Sta 250+00 (10'x100)
Scale 1" = 20'


LINN COUNTY		PROJECT NUMBER	NHS-100-1(23)-19-57	STATE	DESIGN	DATE	BY	CHECK	DATE	SHEET	TOTAL
				IA	1					L 34	34

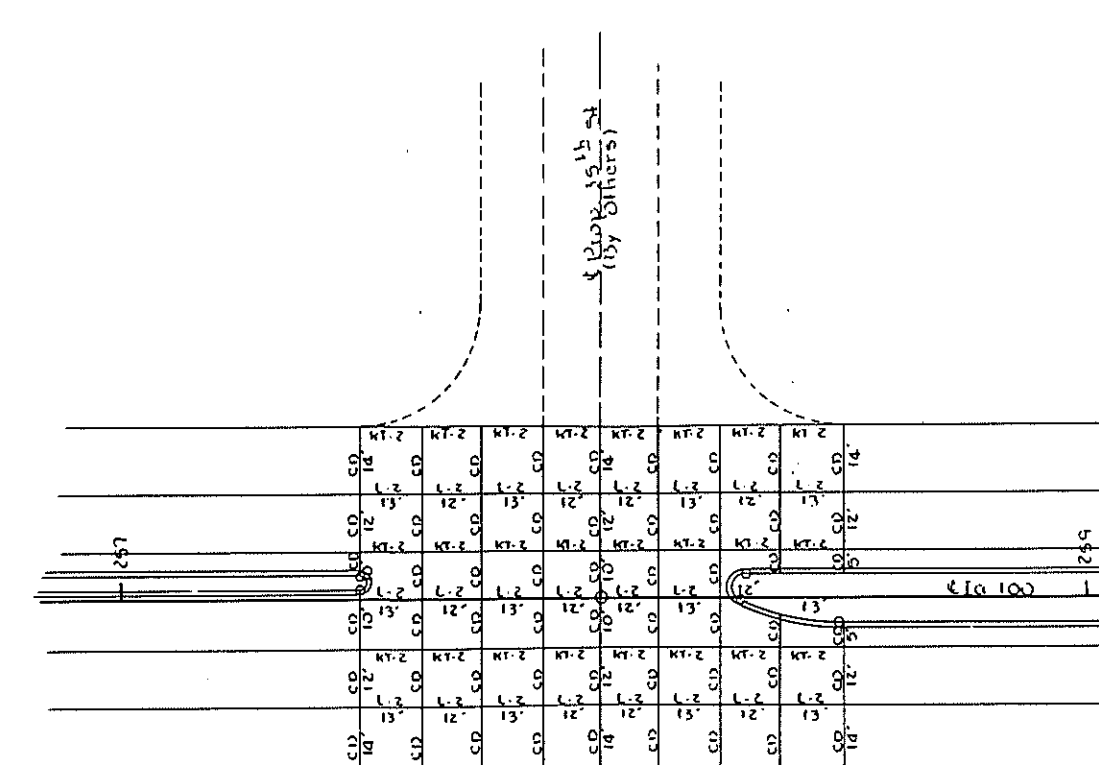

Refer to Sheet L.34 for Geometrics

Jointing Diagram of Intersection
of Future 35th St. @ Sta 250+00
Scale 1" = 20'

LINN COUNTY		PROJECT NUMBER	NHS-100-1(23)-19-57	STATE	DESIGN	DATE	BY	CHECK	DATE	SHEET	TOTAL
				IA	1					L 34	34

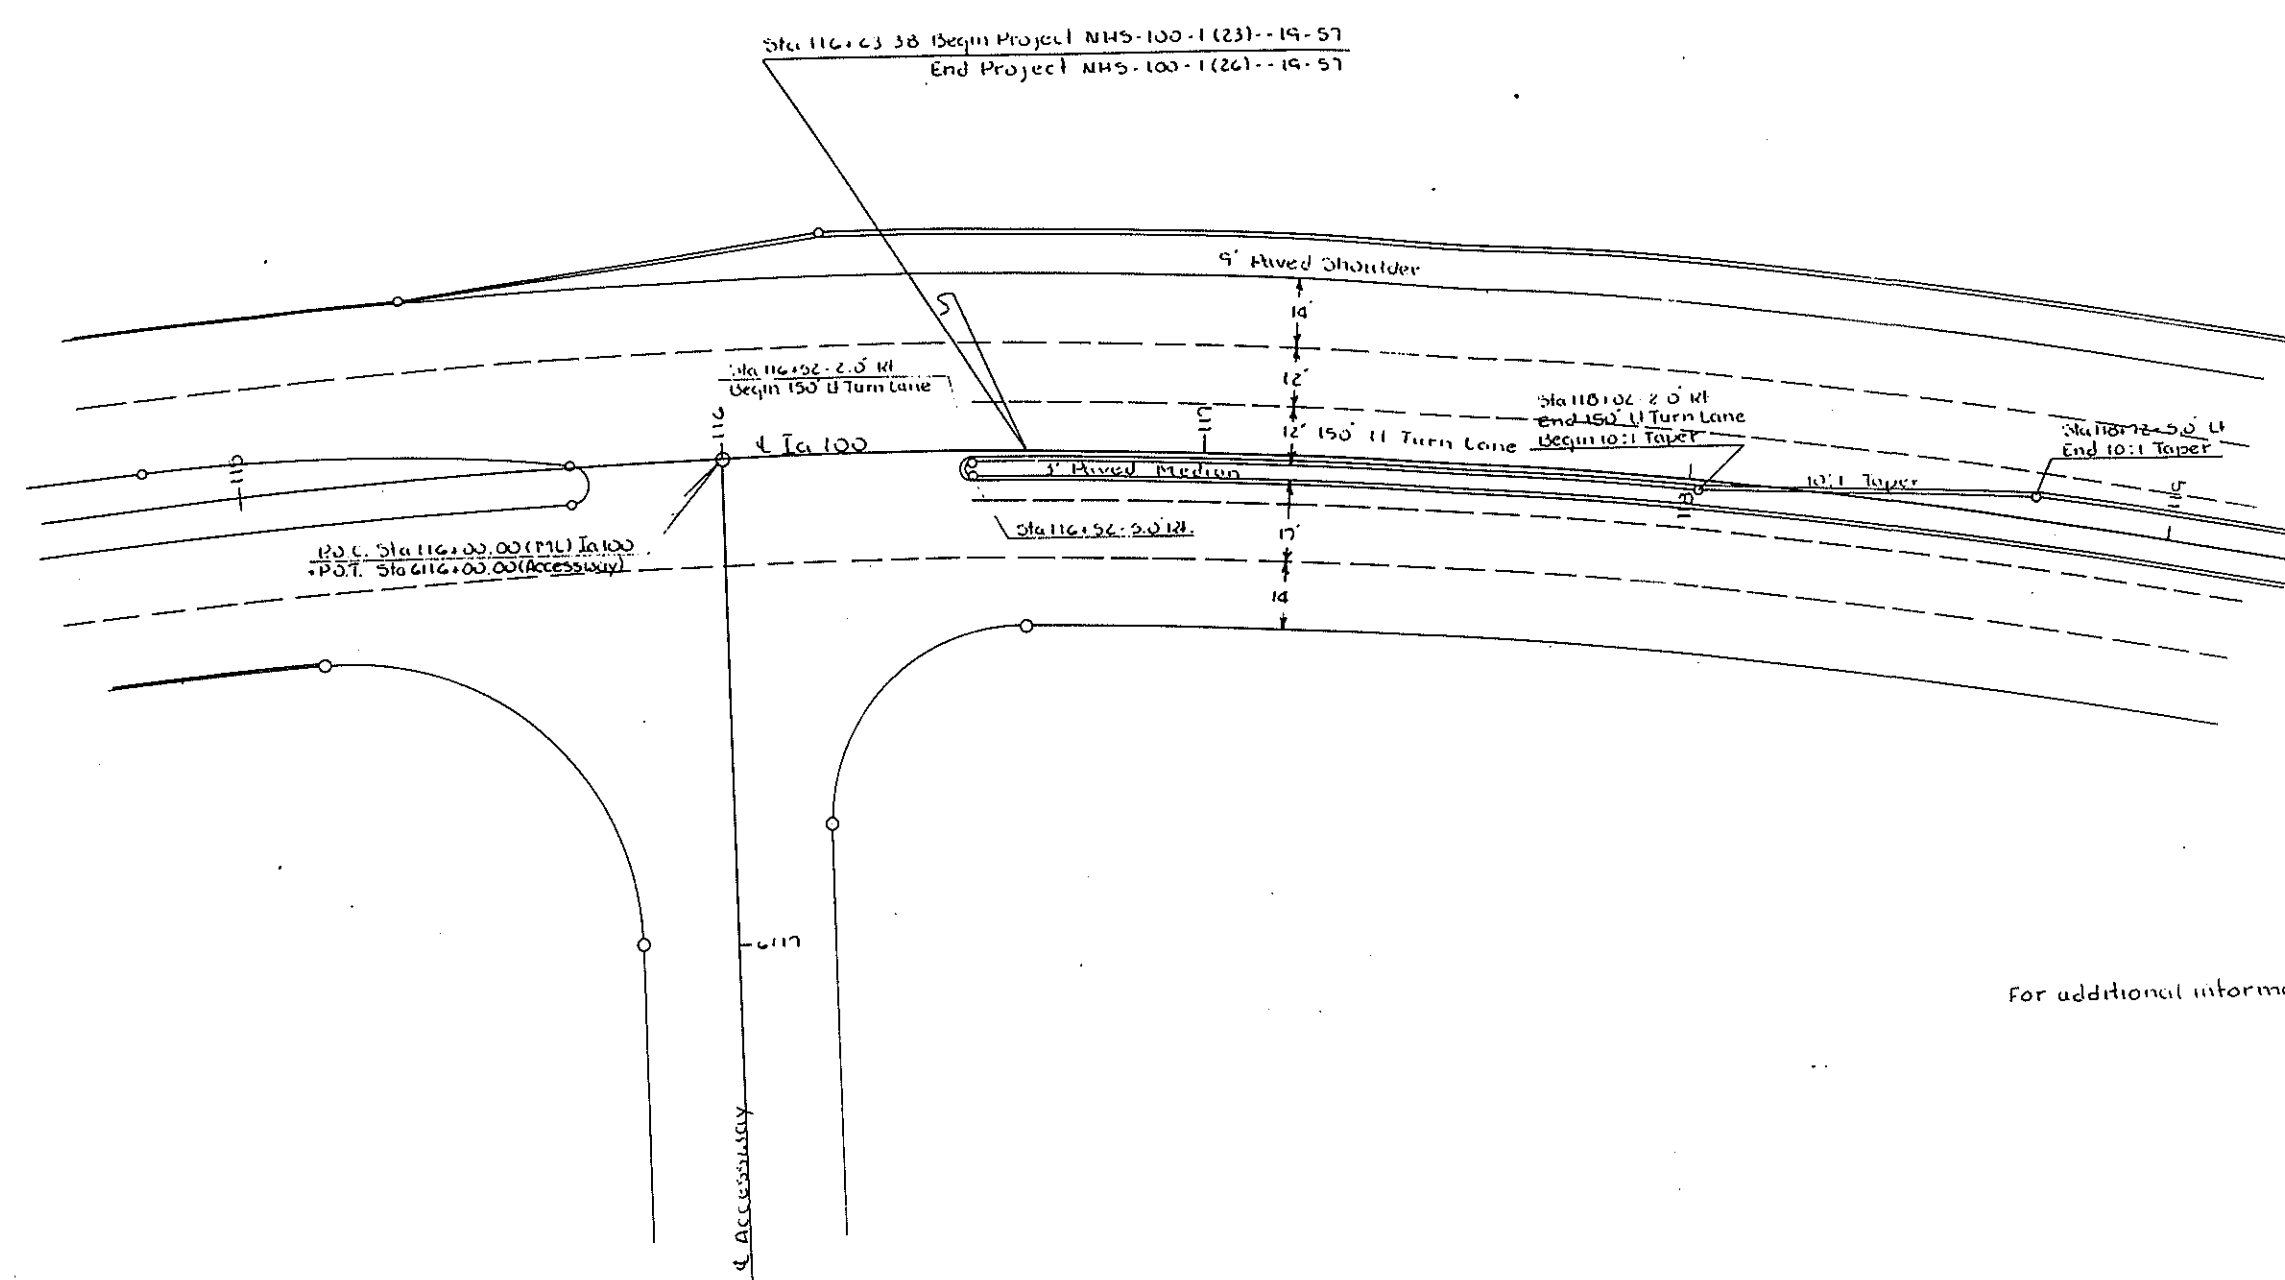

For additional information see Project NHS-100-1(23)-19-57


Geometric Plan for Proposed
Left Turn Lane @ Sta 116+50 (10'x100)
Scale 1" = 20'

LINN COUNTY		PROJECT NUMBER	NHS-100-1(23)-19-57	STATE	DESIGN	DATE	BY	CHECK	DATE	SHEET	TOTAL
				IA	1					L 33	33



LINN COUNTY NHS-100-1(23)-19-57

L.33
P. 108

PLAN	DATE
SURVEYED	BY
PLOTTED	BY
NOTED	BY
RT. OF WAY CHECKED	BY
NO.	

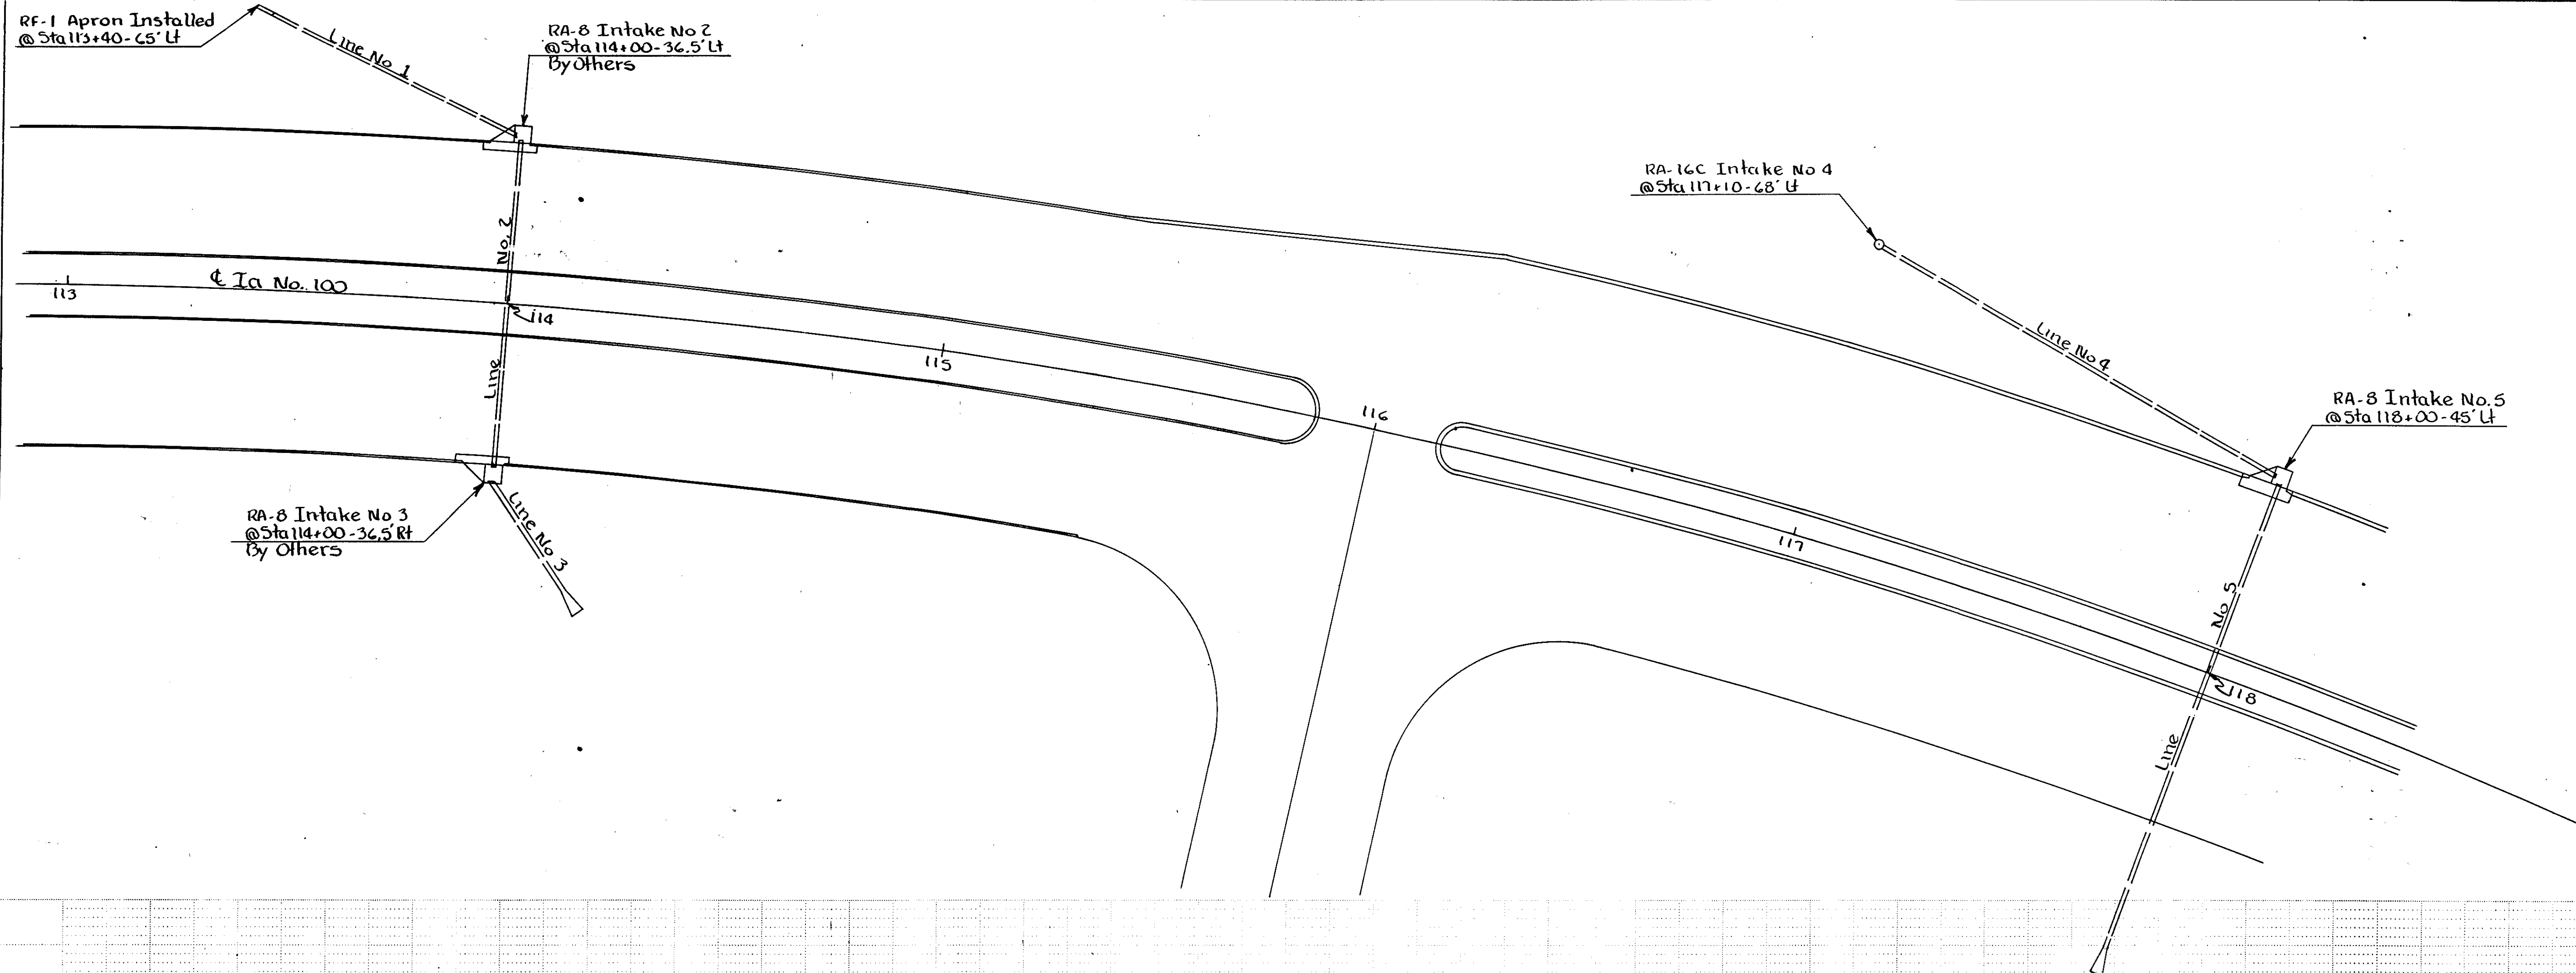



PROFILE	DATE
SURVEYED	BY
PLOTTED	BY
NOTED	BY
STRUCTURE NOTATIONS CHKD	BY
NO.	

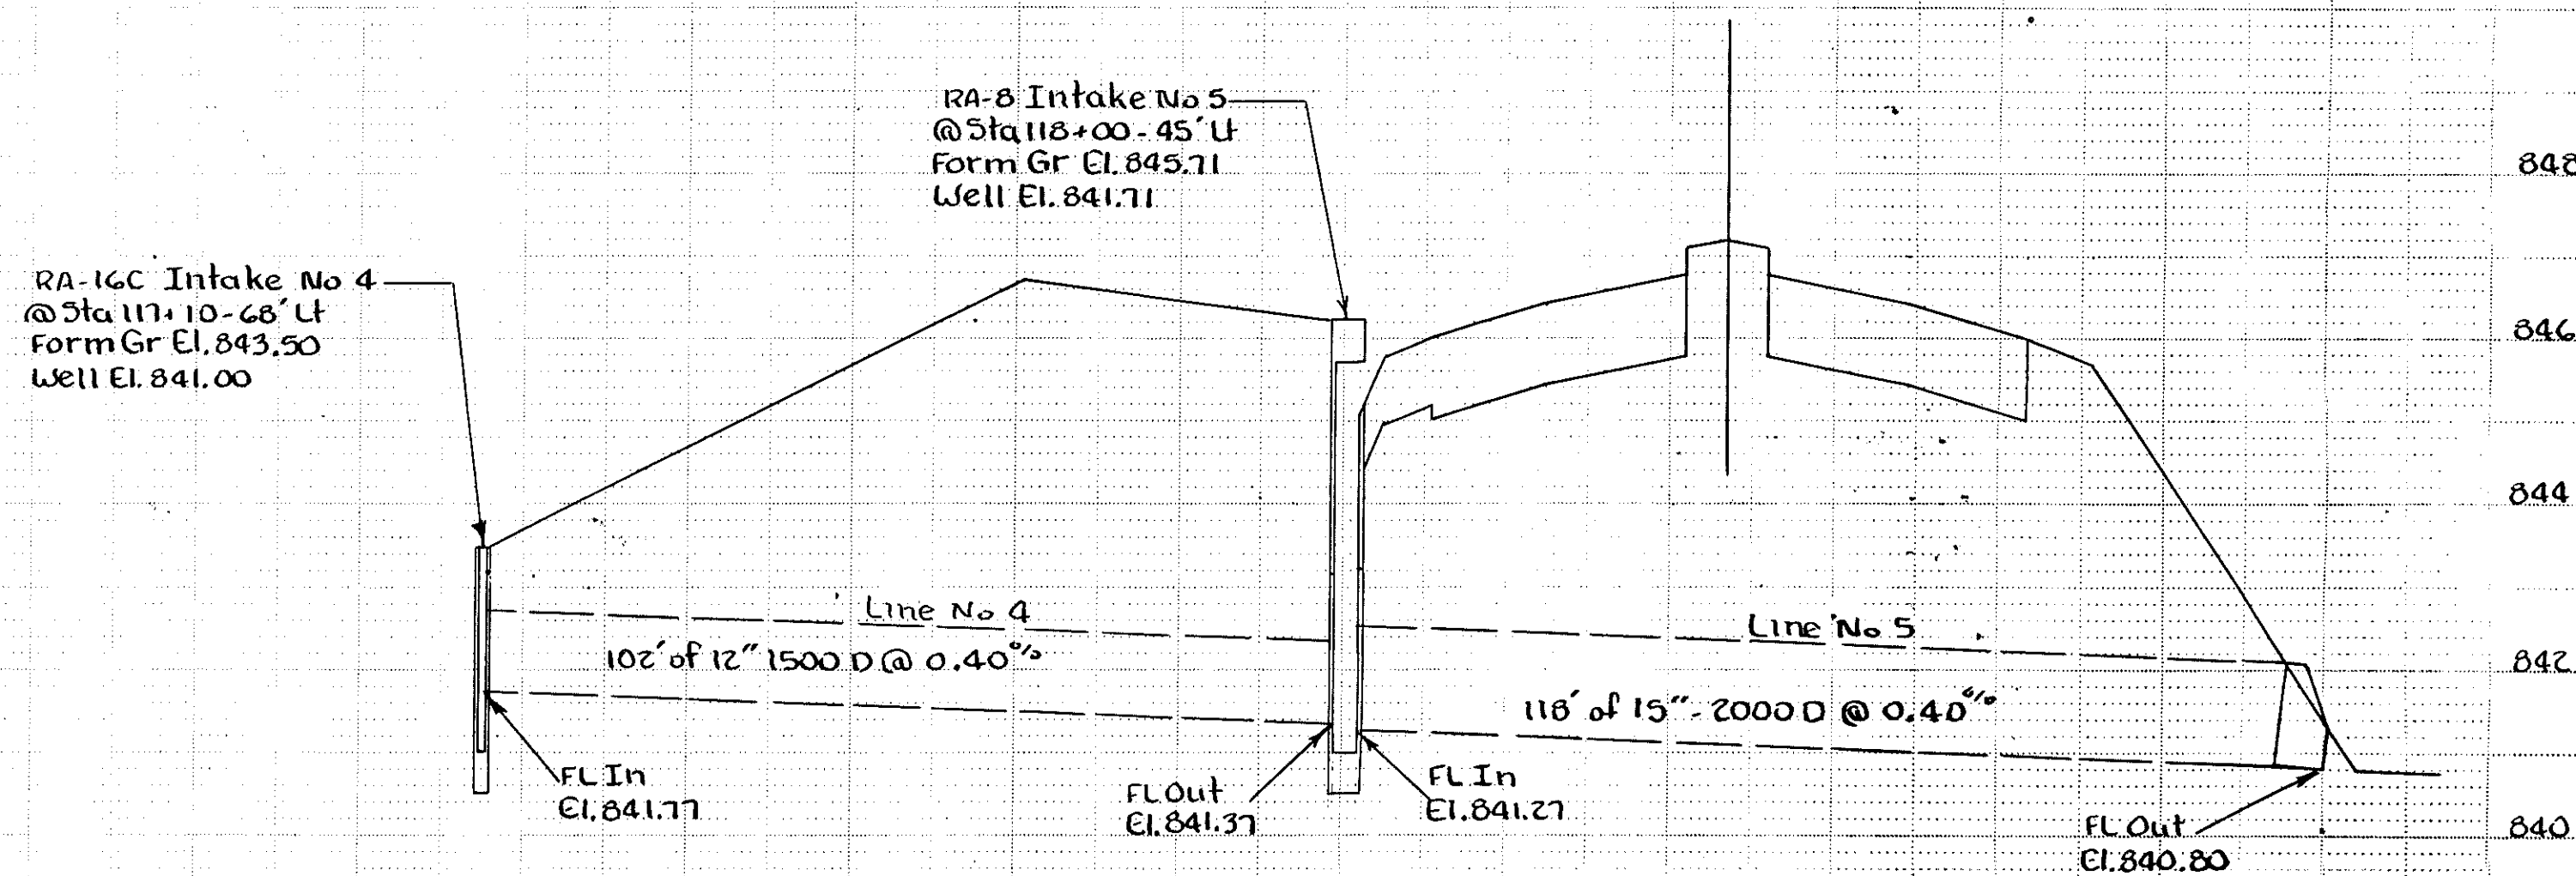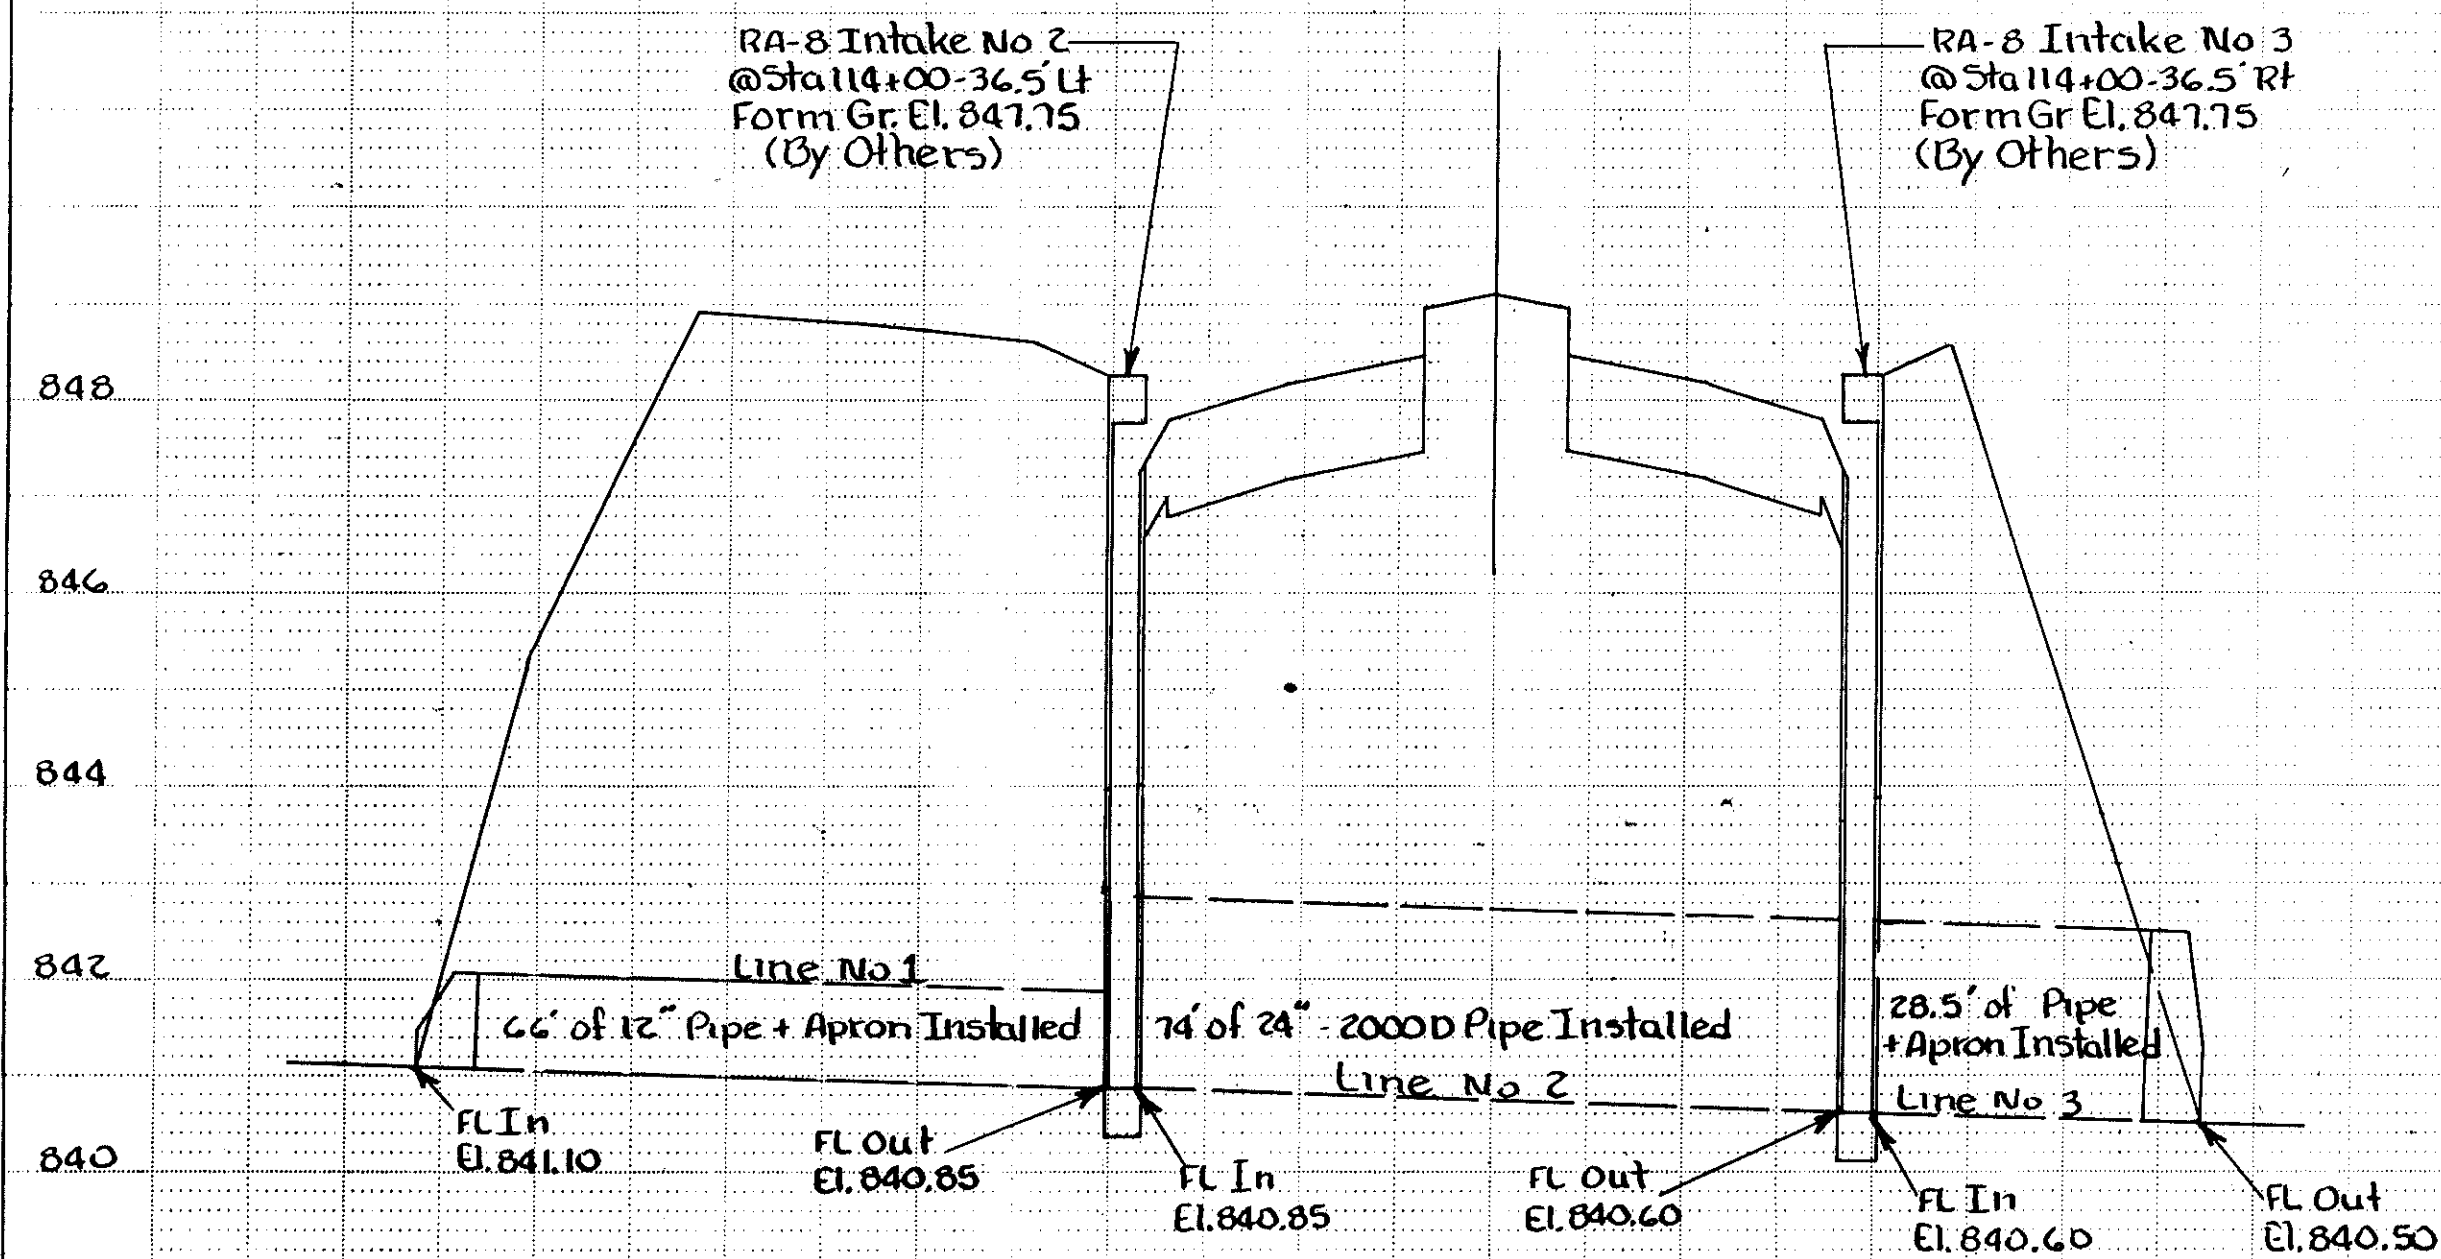

Storm Sewer Plan & Profile
Scale 1" = 2' Vert
1" = 20' Hor

RA-8 Intake No. 6
@ Sta 121+25.45' LT
Form Gr. El. 842.83
Well El. 838.83

RA-8 Intake No. 7
@ Sta 124+50.45' LT
Form Gr. El. 837.18
Well El. 833.18

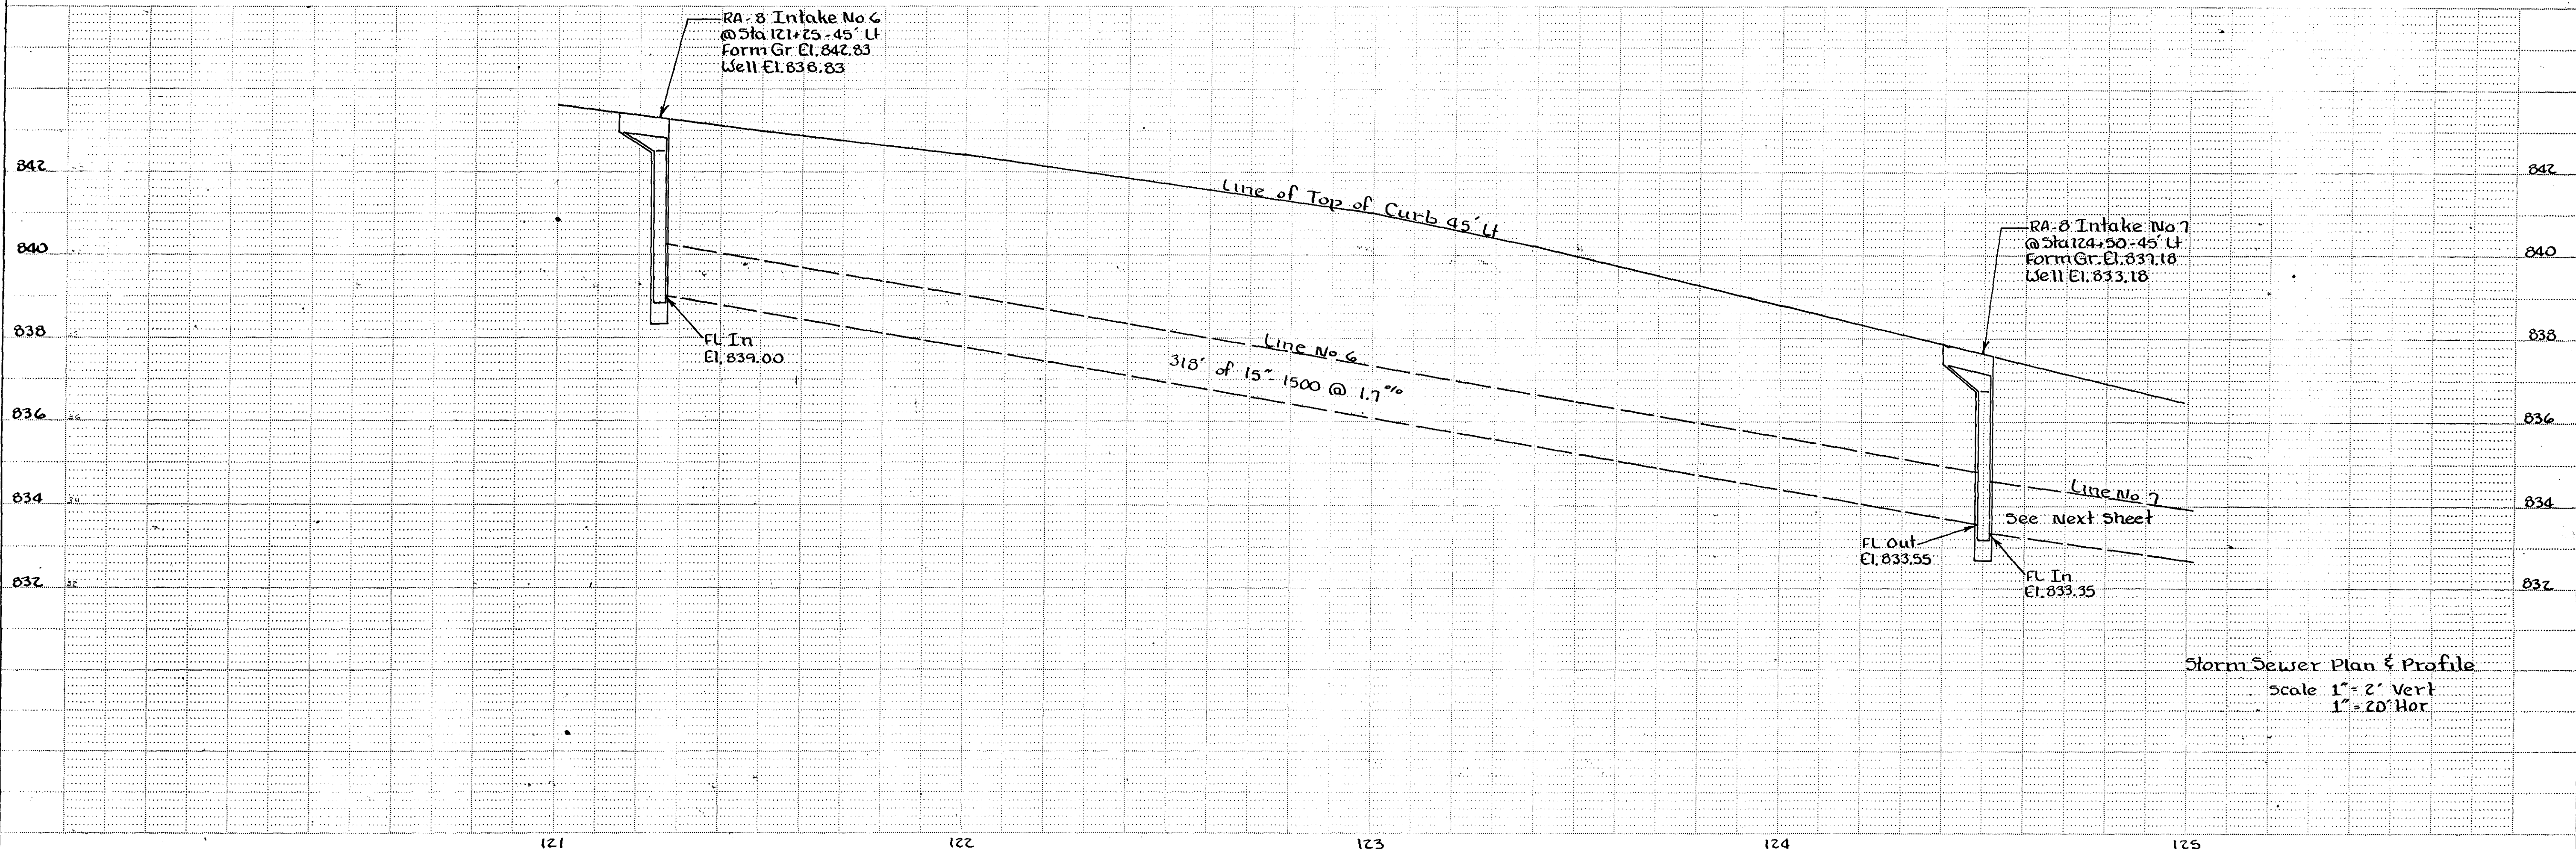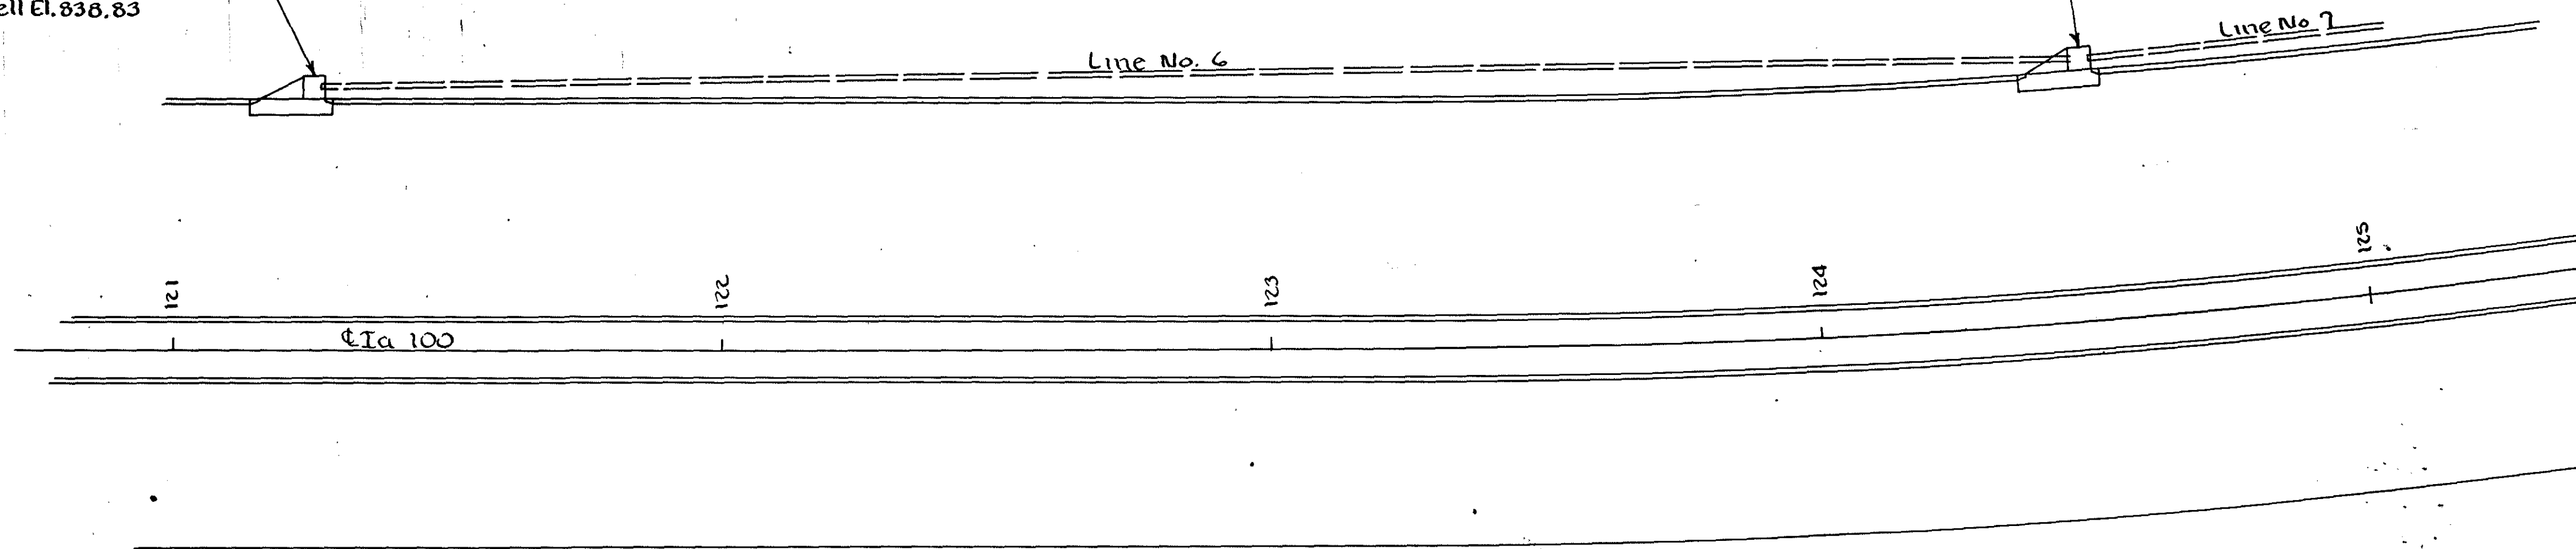

Storm Sewer Plan & Profile
Scale 1" = 2' Vert
1" = 20' Hor



PLAN	DATE
SURVEYED	BY
ALIGNED	DATE
NOTED	DATE
NO.	DATE

PROFILE	DATE
SURVEYED	BY
GRADES CHECKED	DATE
STRUCTURE NOTATIONS CHNG	DATE
NO.	DATE

P.110 D4


PLAN	DATE
SURVEYED	BY
PLOTTED	
NOTED	
CHECKED	
NO.	

PROFILE	DATE
SURVEYED	BY
PLOTTED	
NOTED	
CHECKED	
NO.	

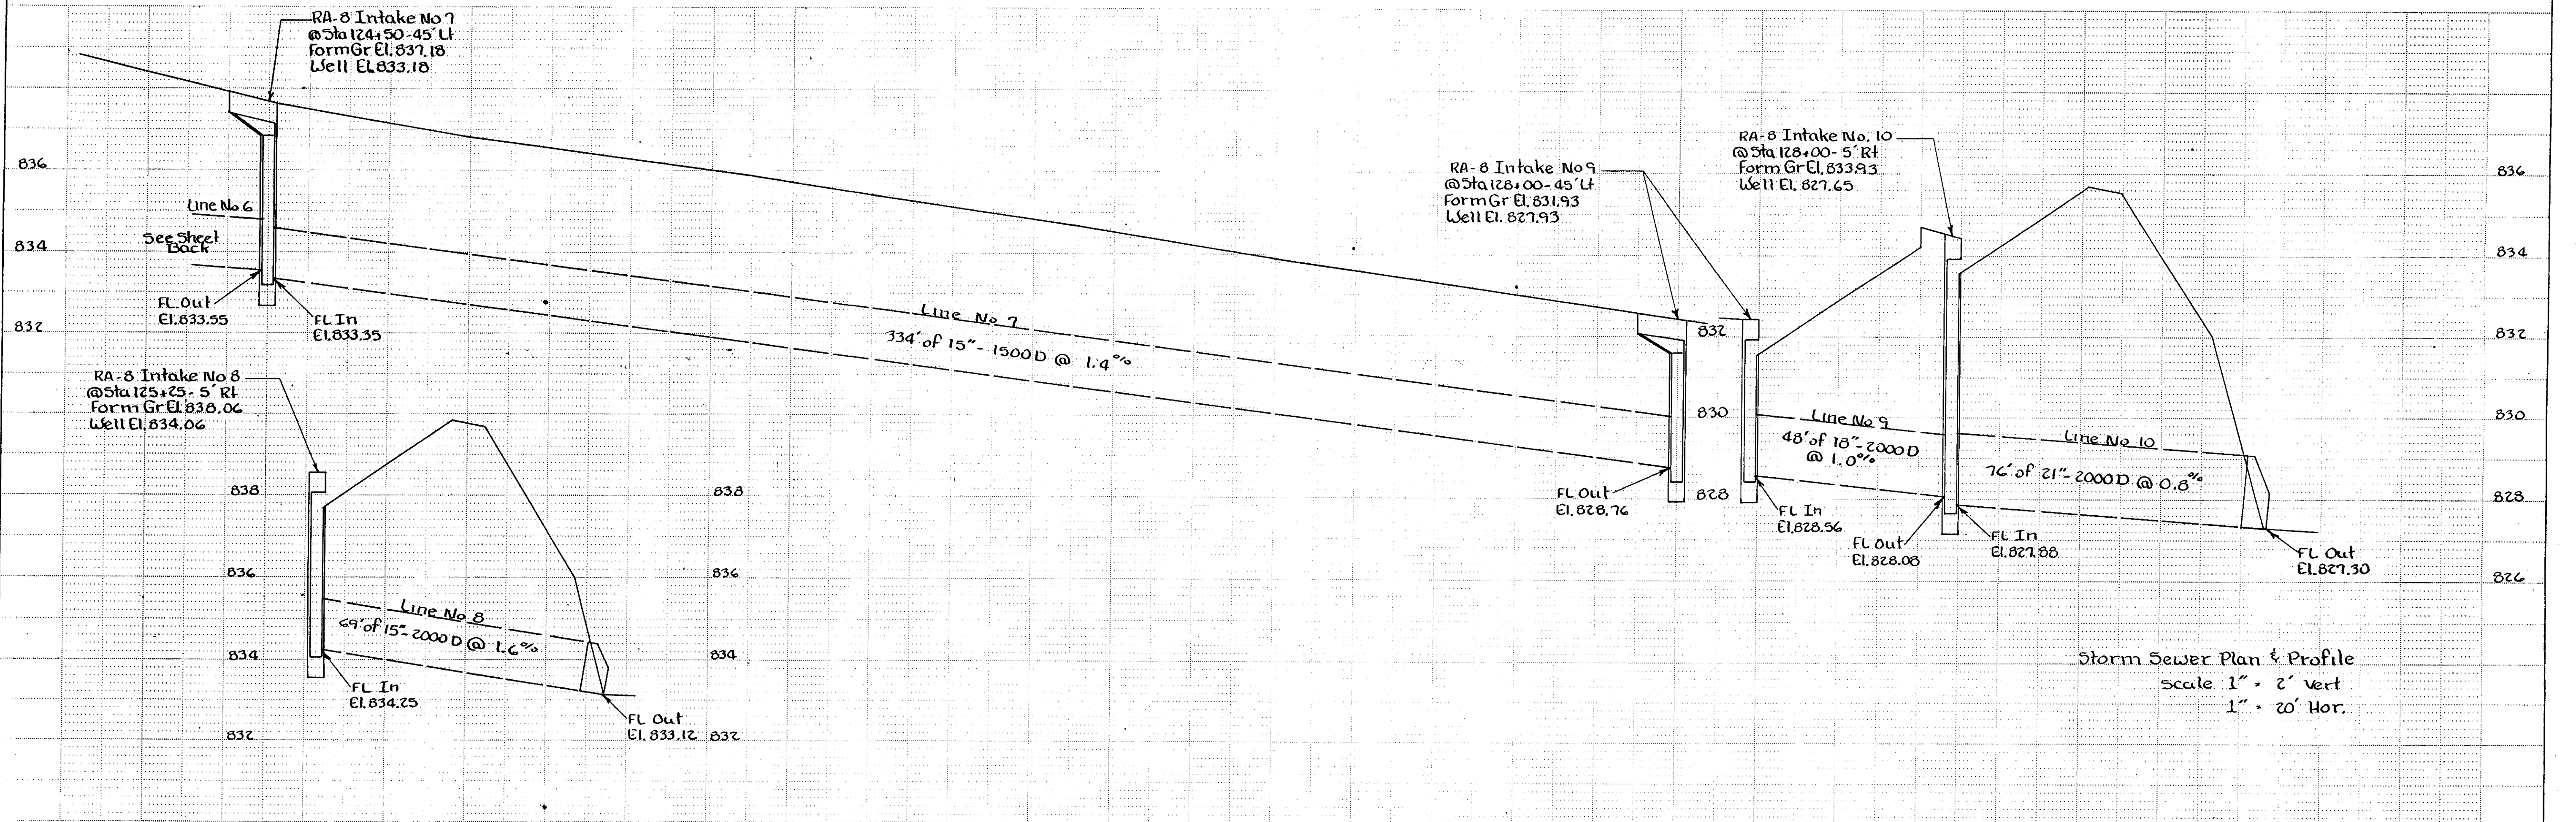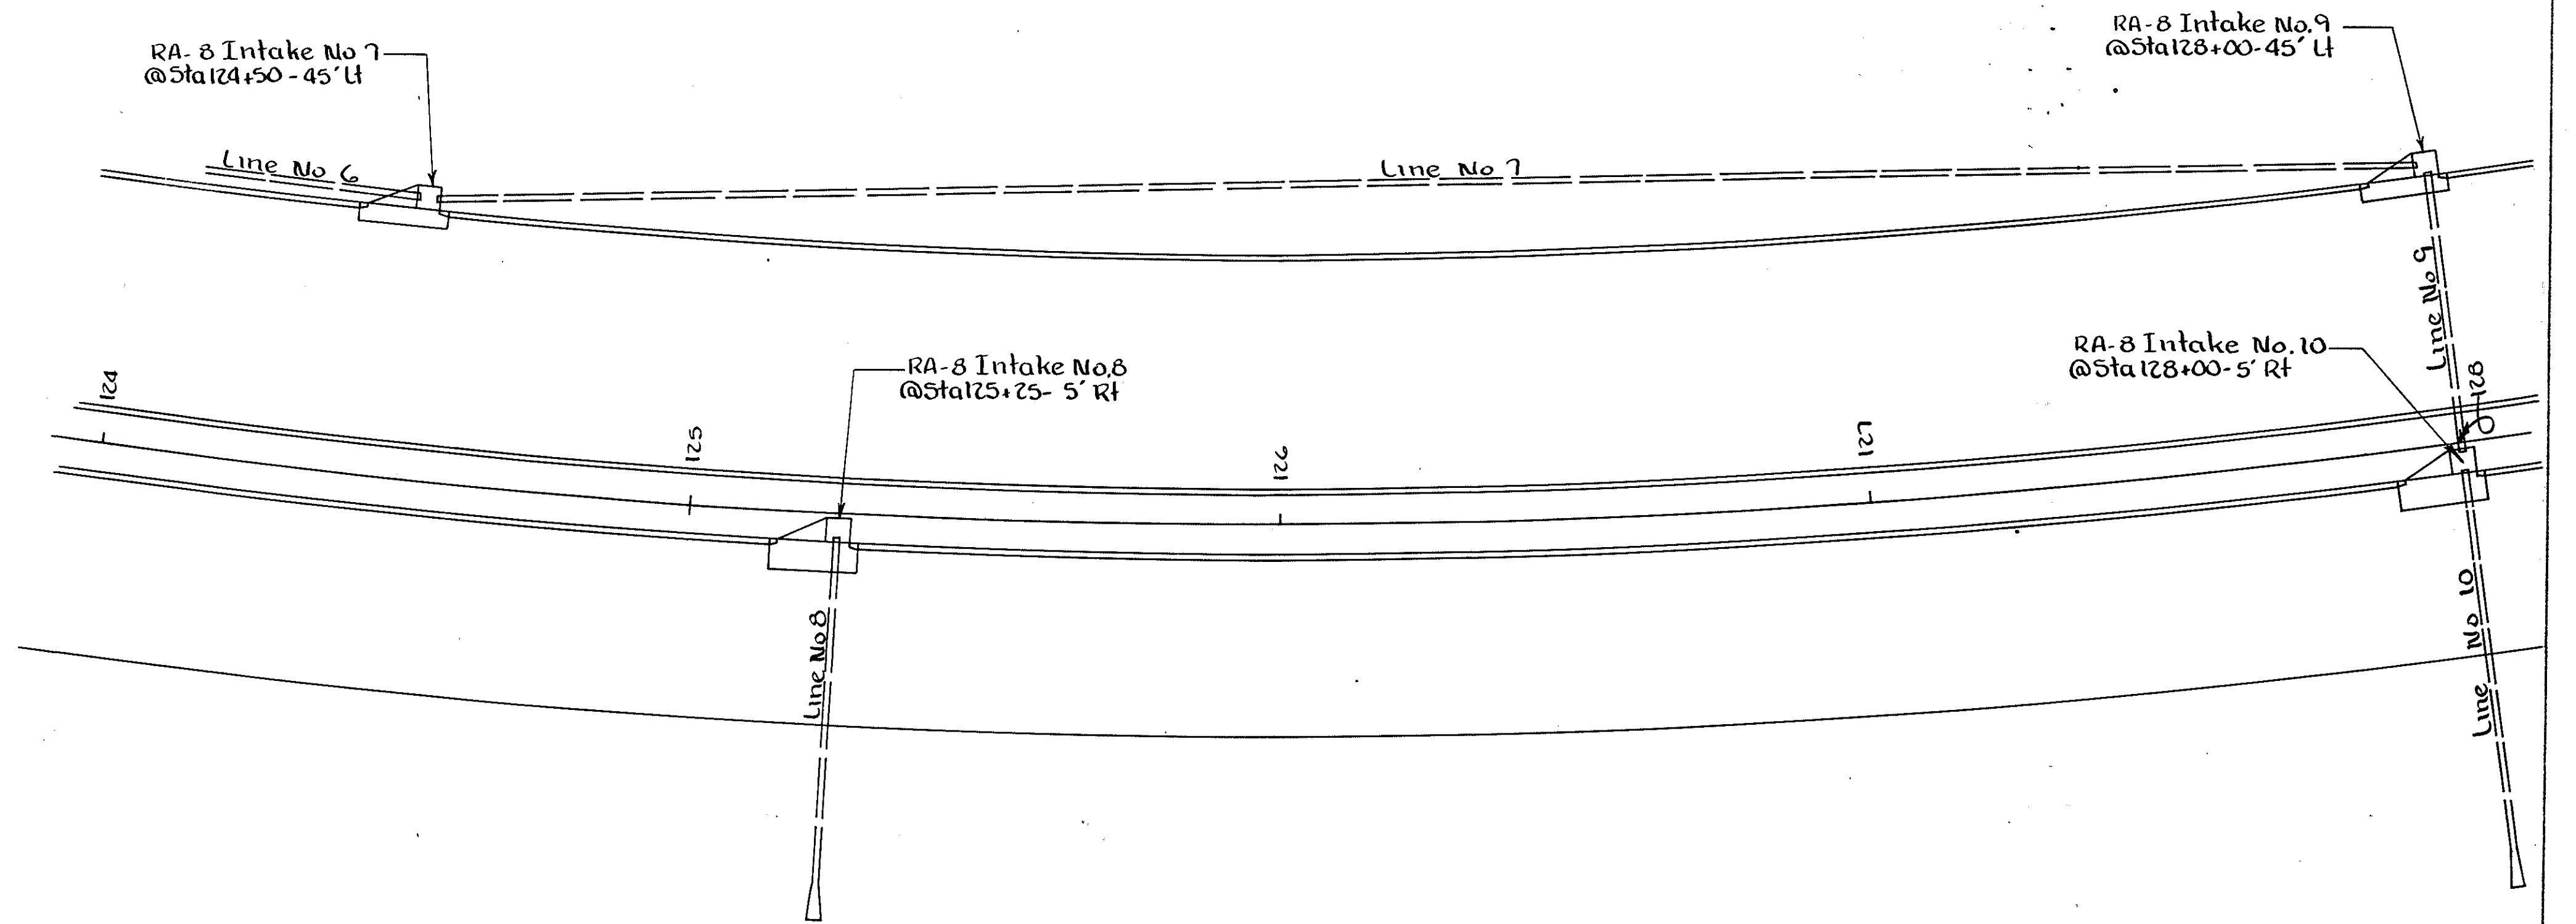


Storm Sewer Plan & Profile
Scale 1" = 2' Vert
1" = 20' Hor.

PLAN	DATE
SURVEYED	BY
PLOTTED	BY
NOTED	BY
CHECKED	BY
NO.	

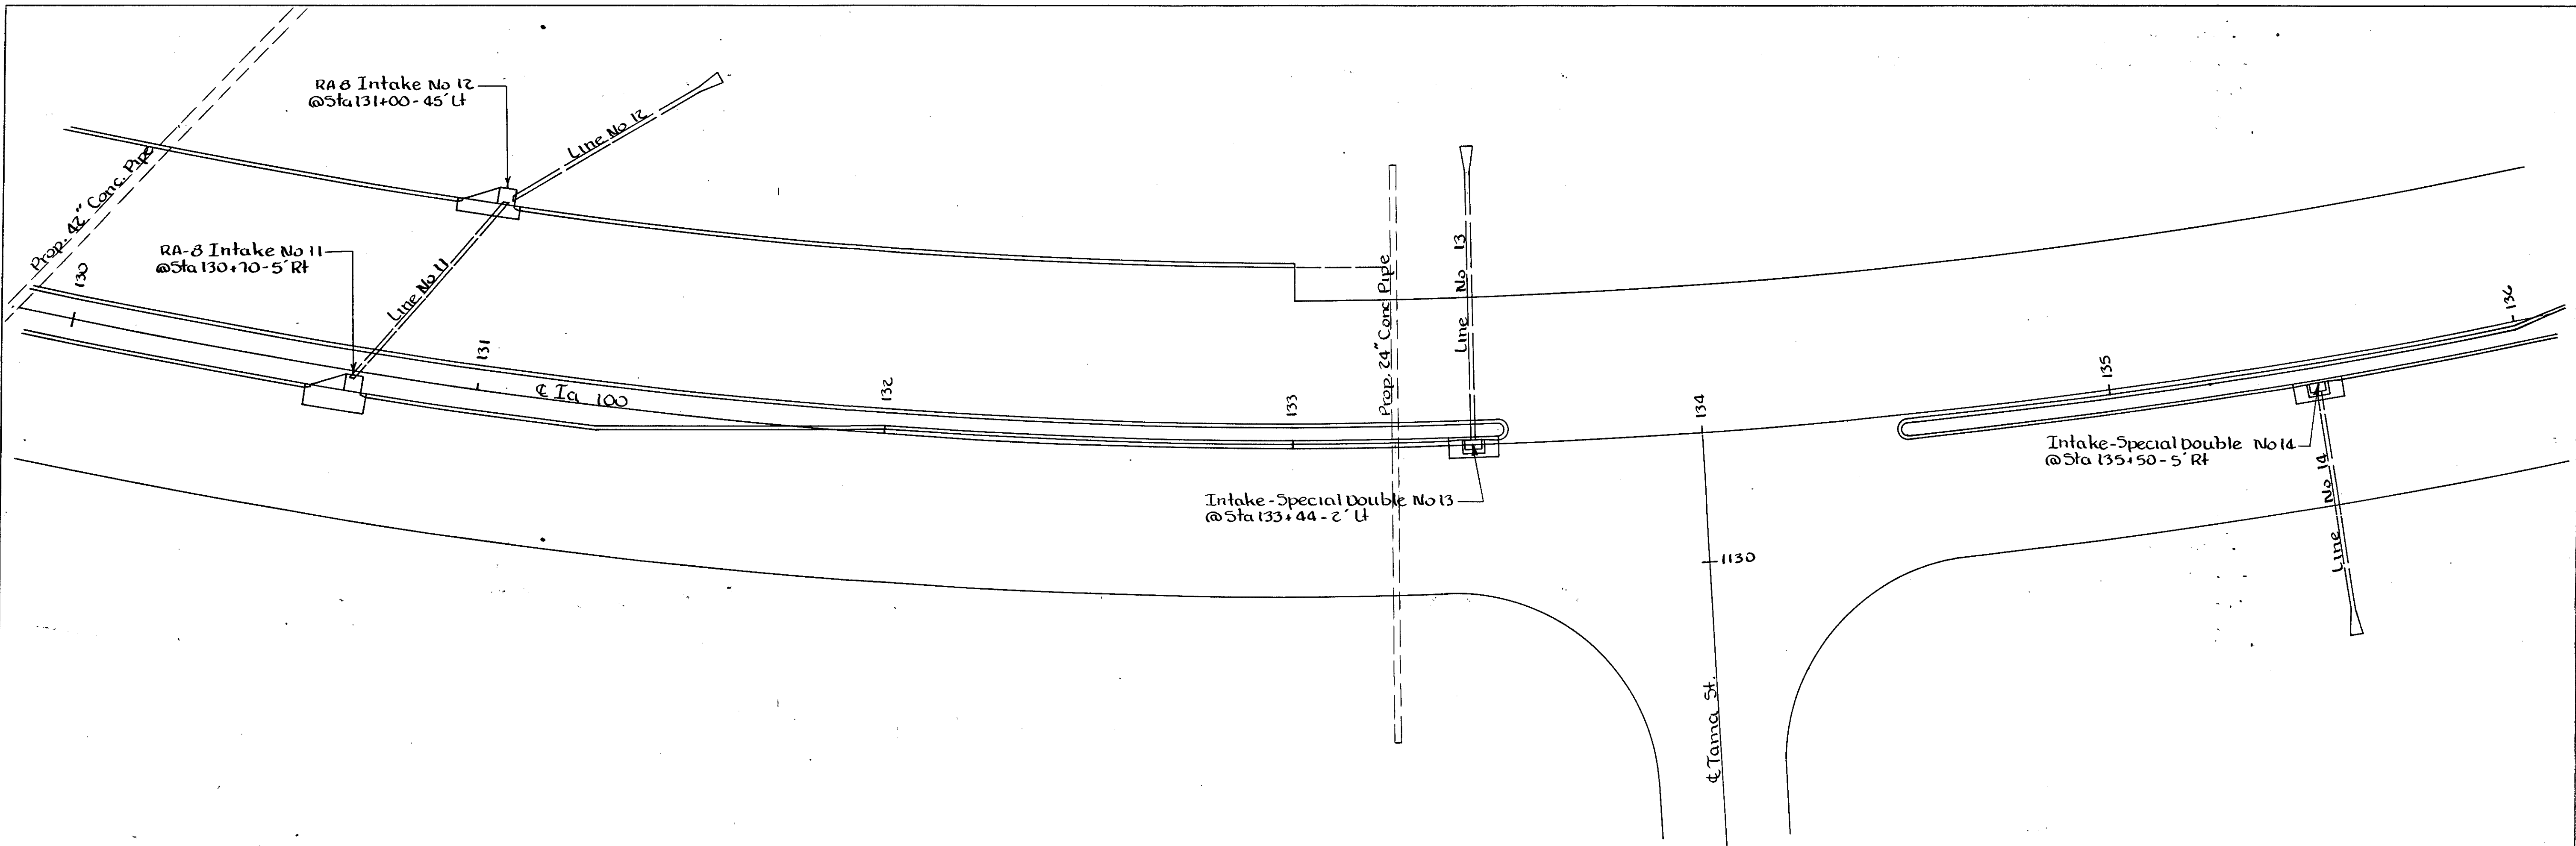


PROFILE	DATE
SURVEYED	BY
PLOTTED	BY
NOTED	BY
CHECKED	BY
NO.	


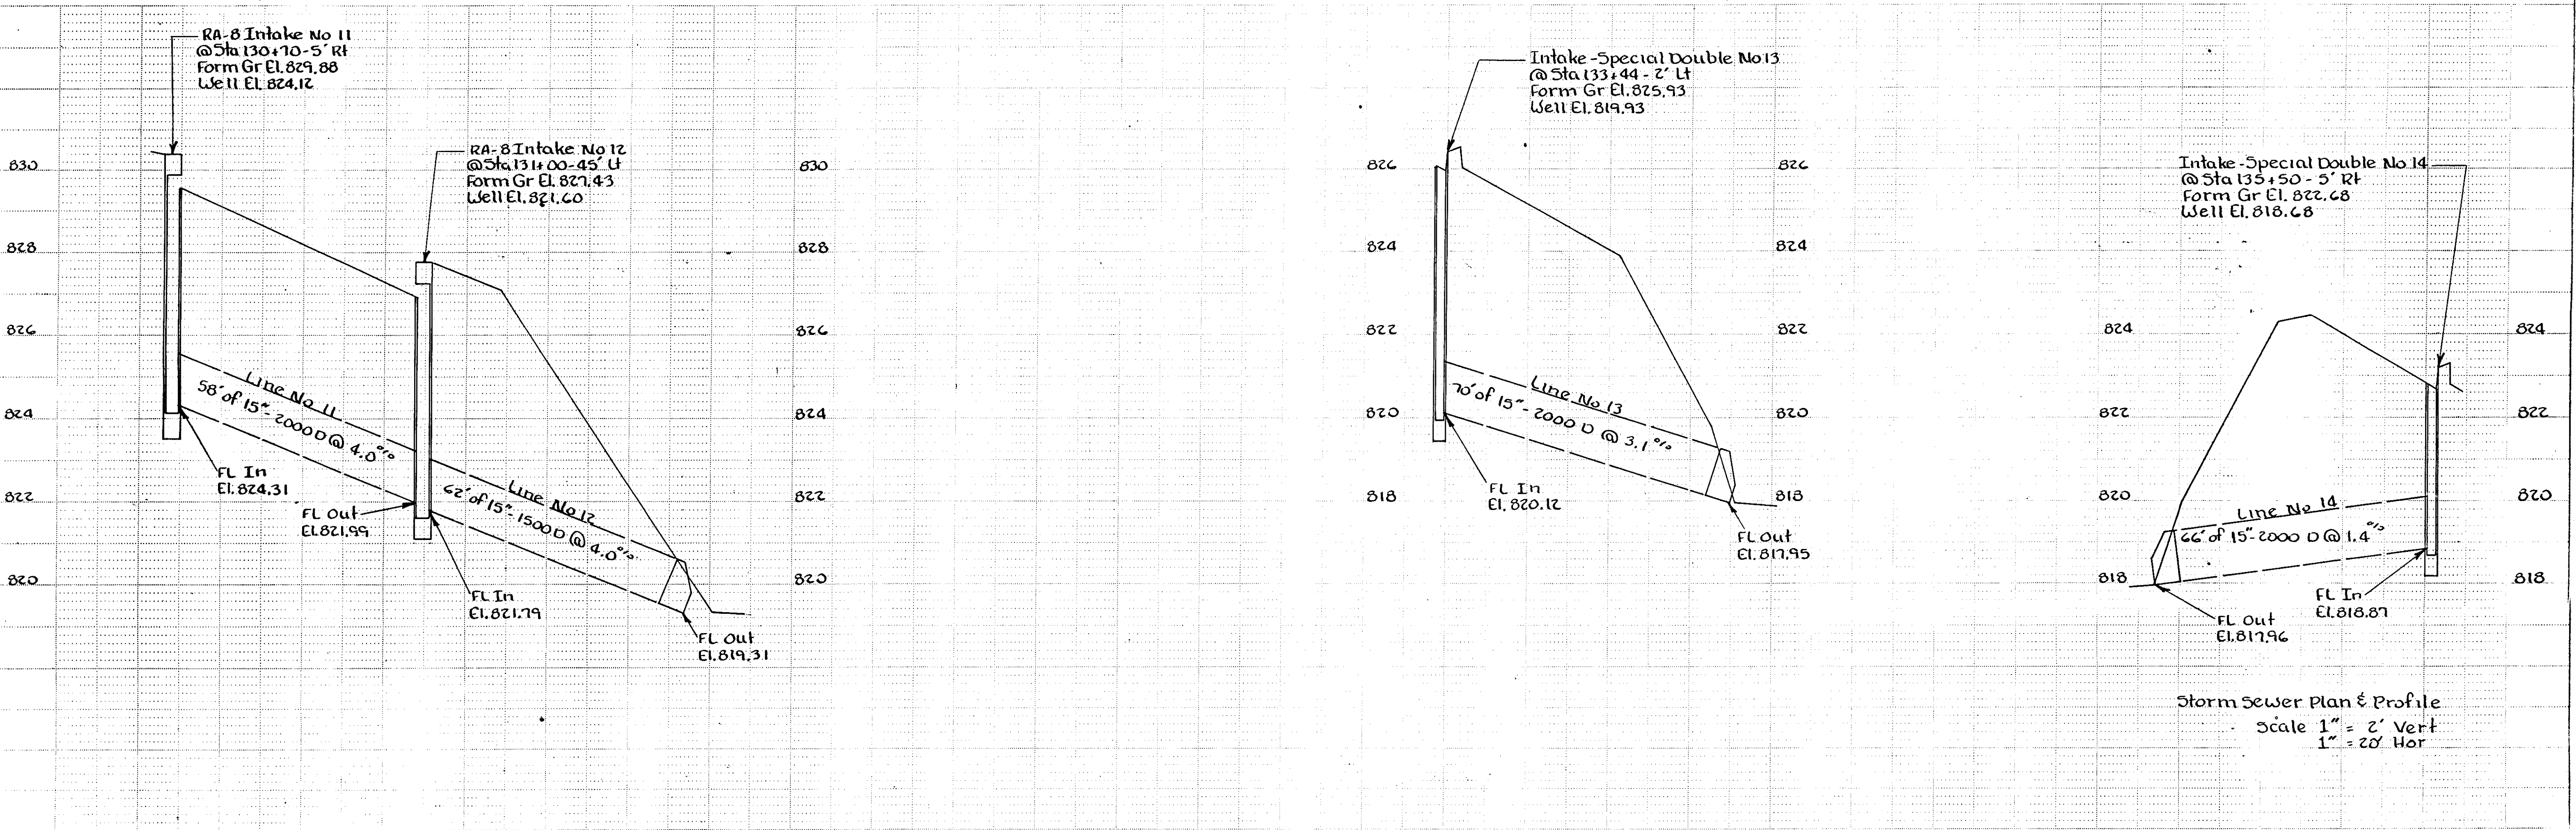


112

PLAN	DATE
SURVEYED	BY
PLOTTED	DATE
NOTE BOOK	NO.
NO.	

PROFILE	DATE
SURVEYED	BY
PLOTTED	DATE
NOTE BOOK	NO.
NO.	

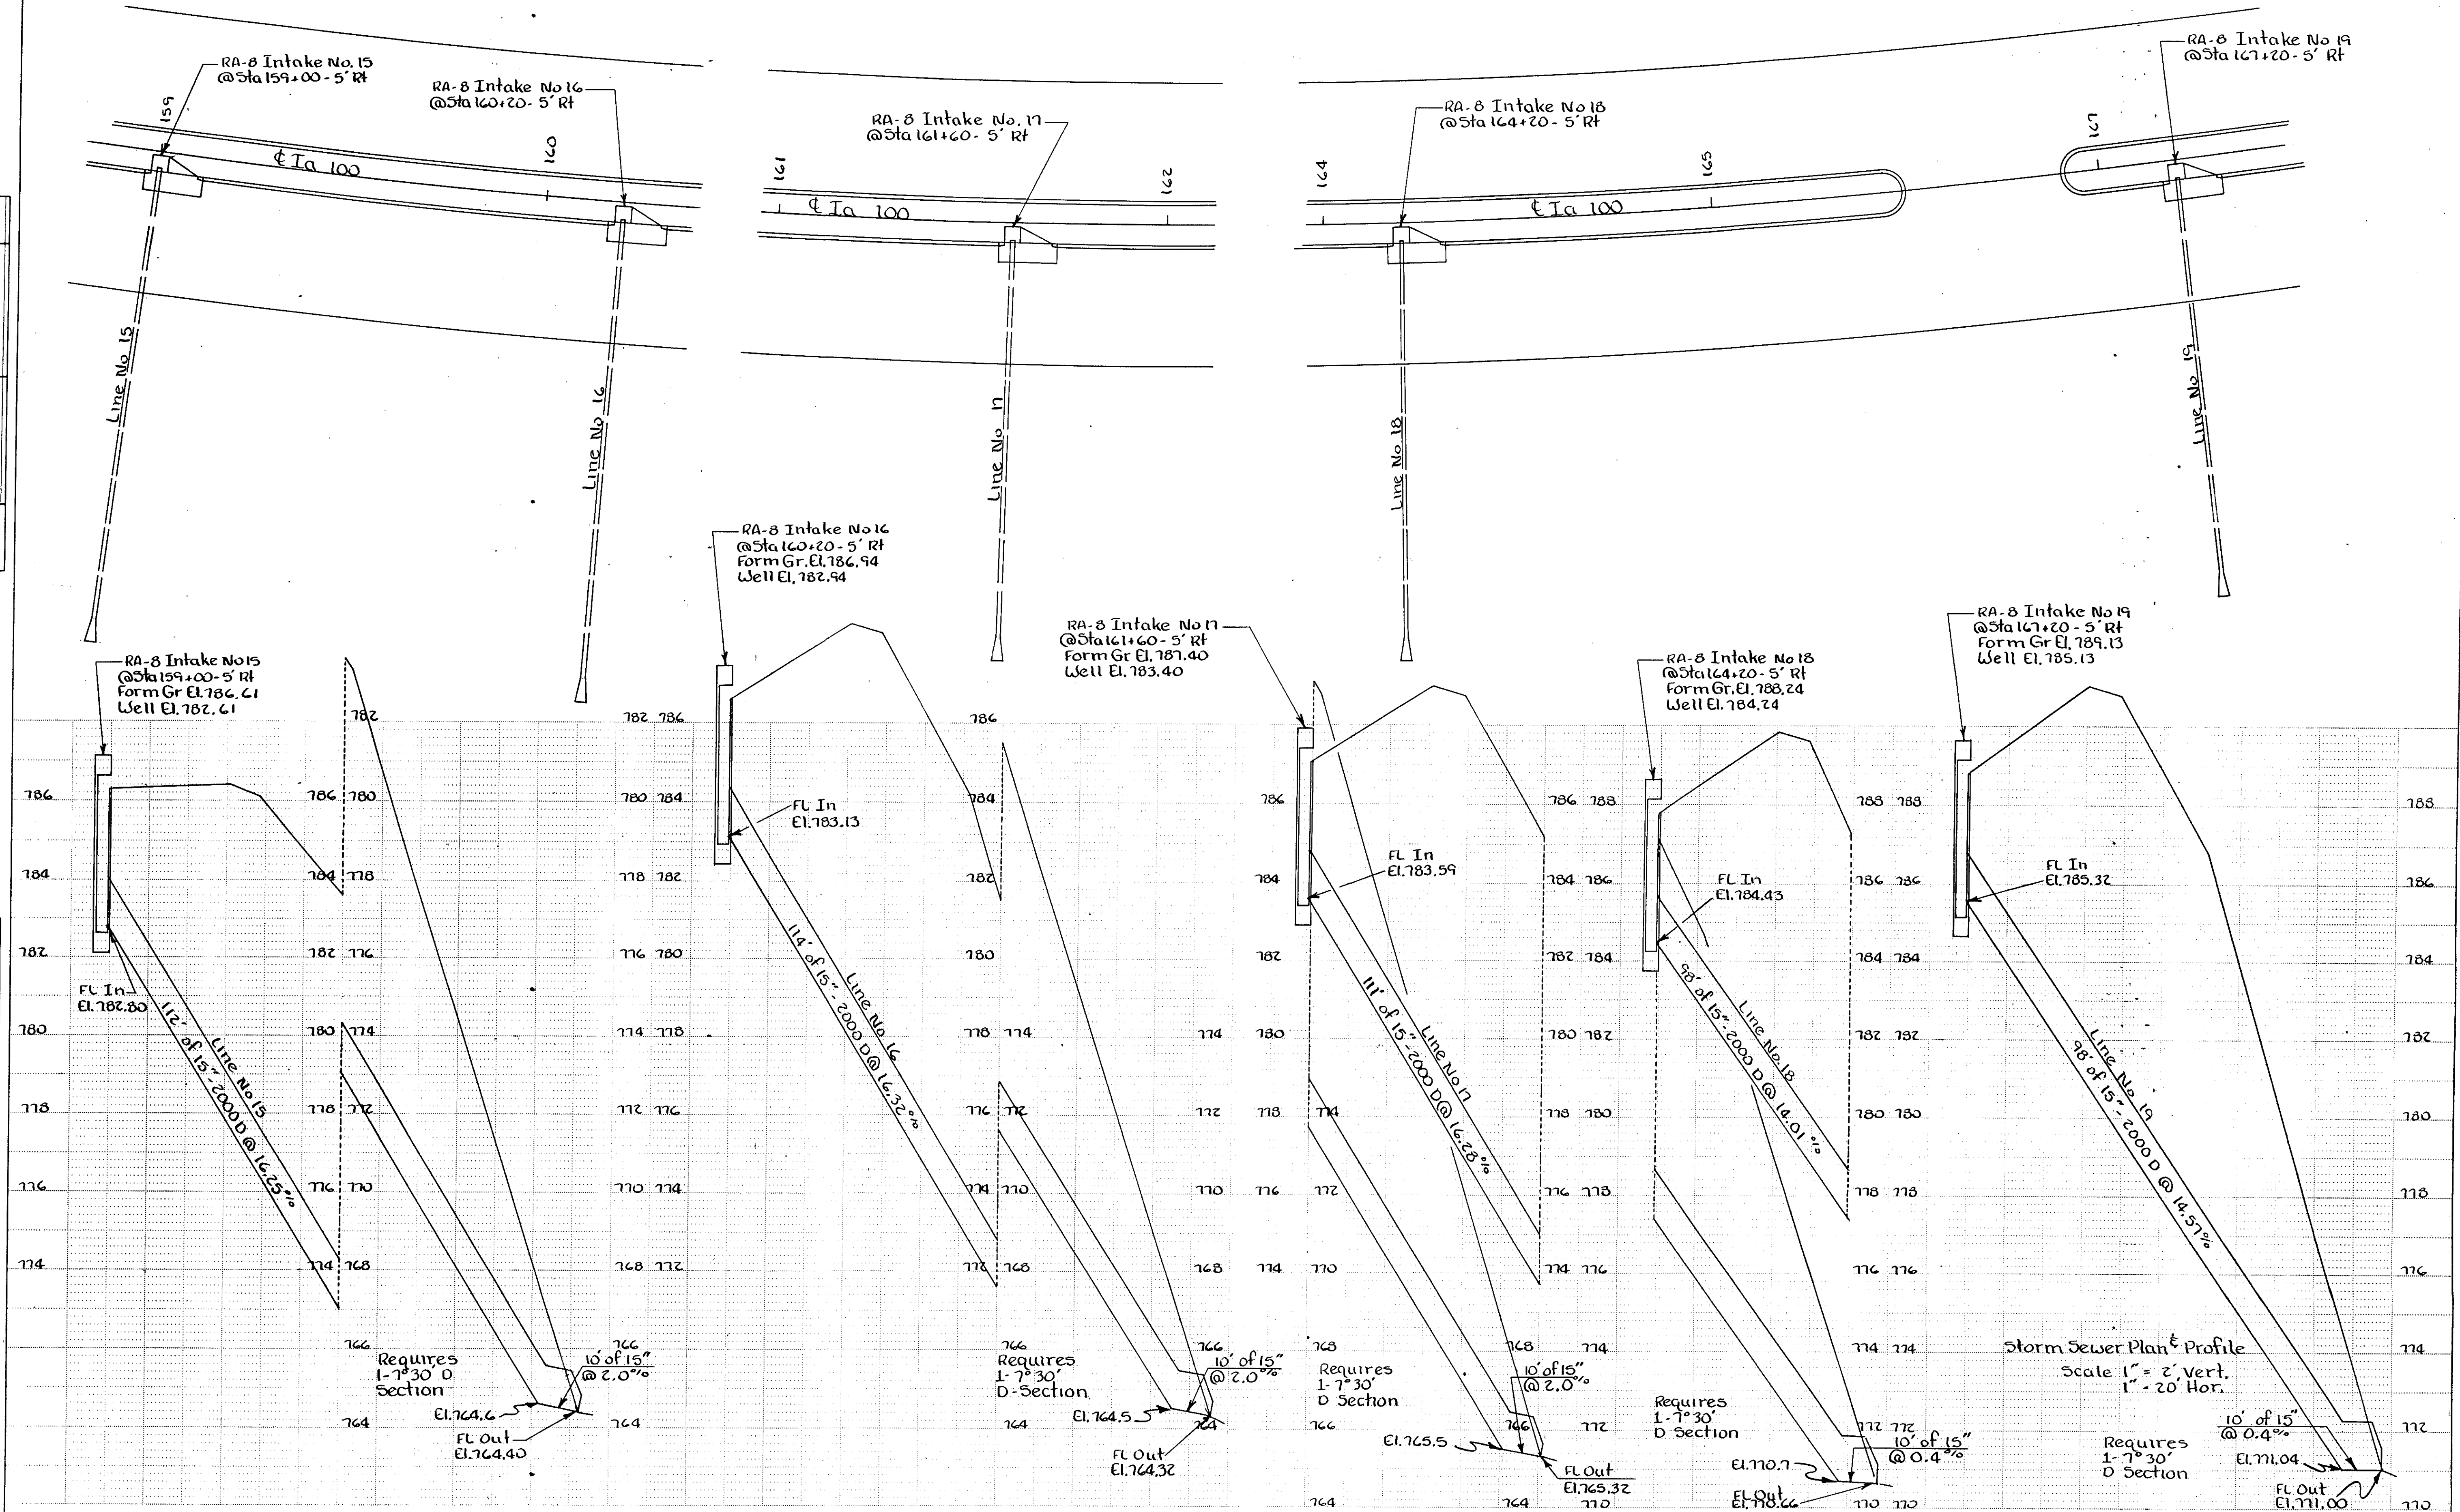

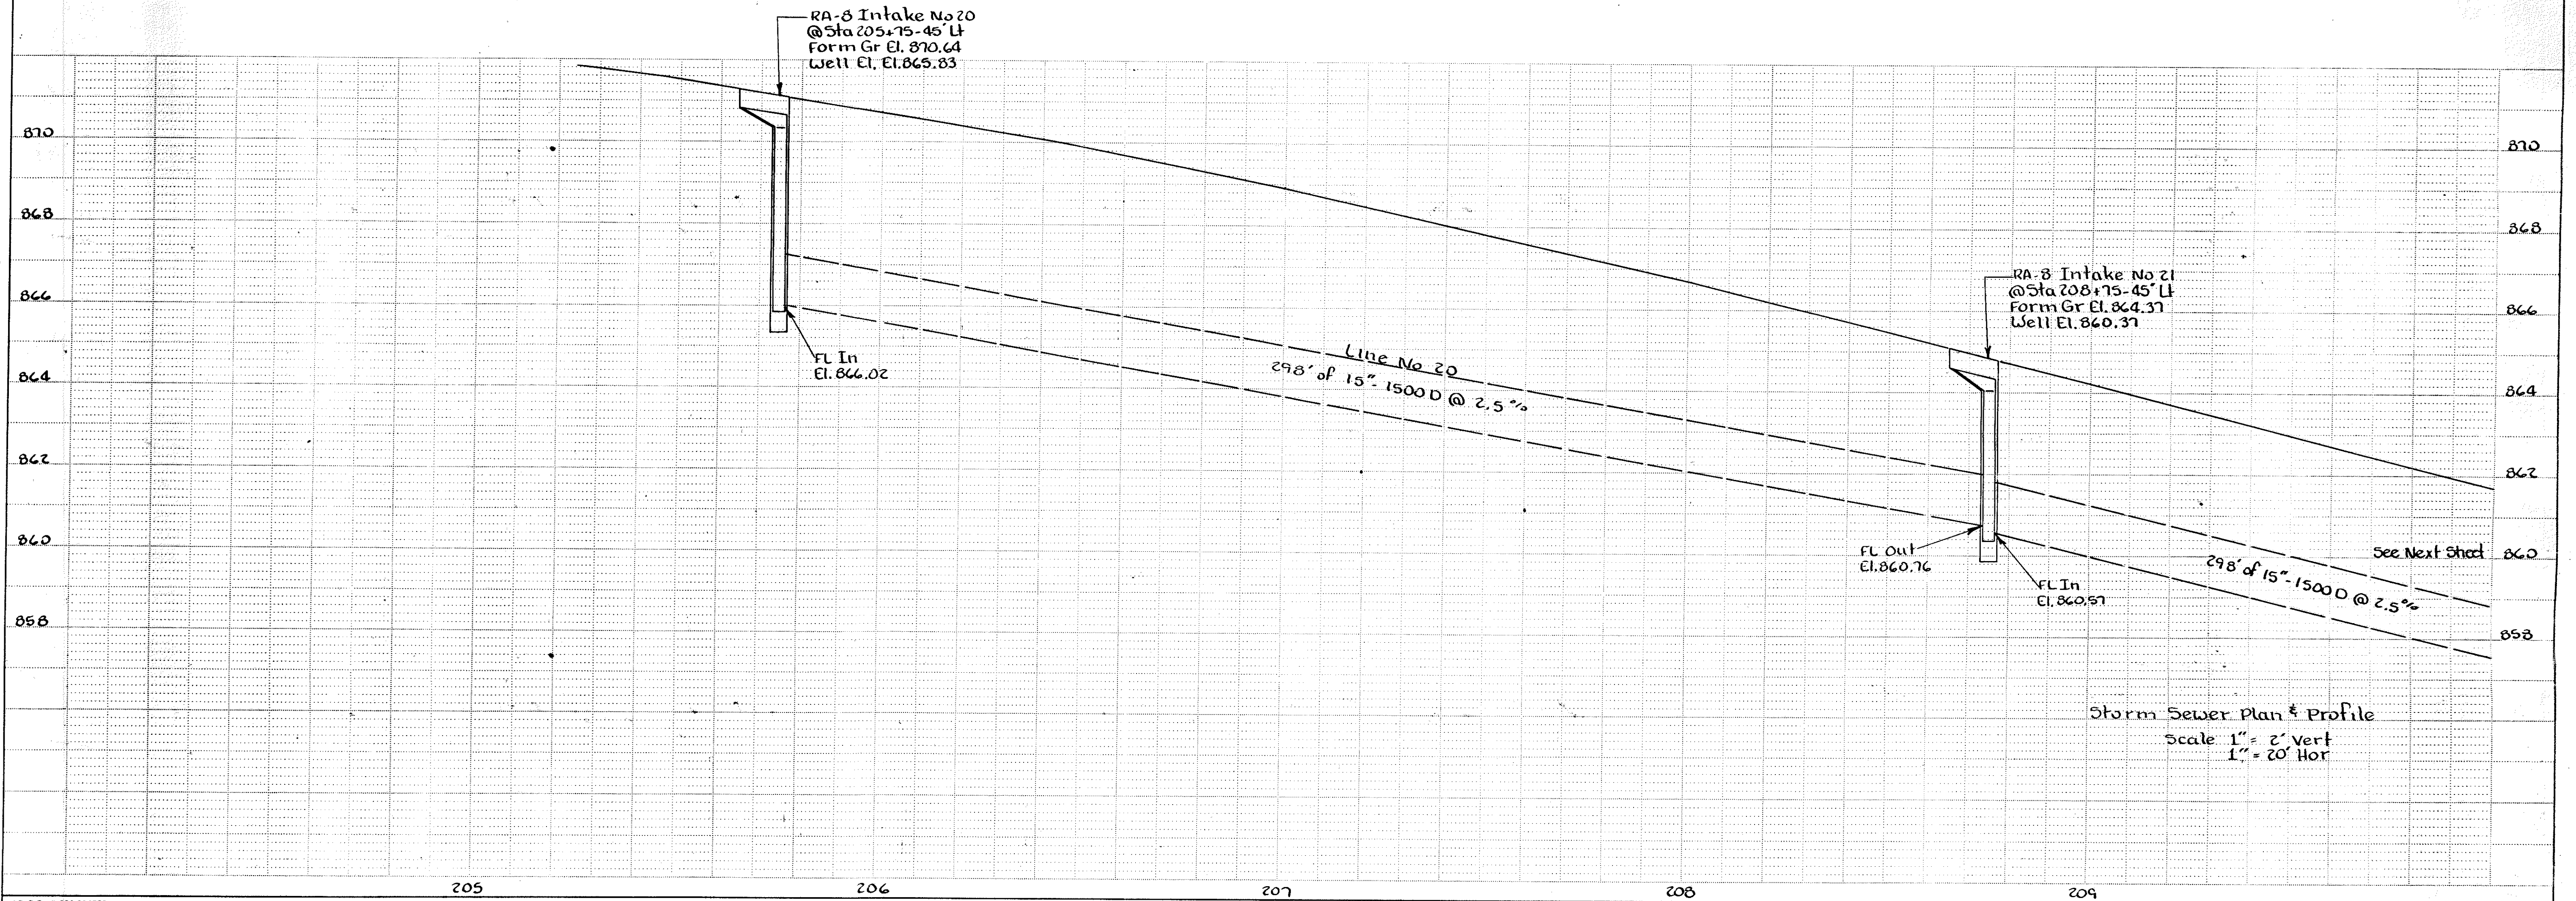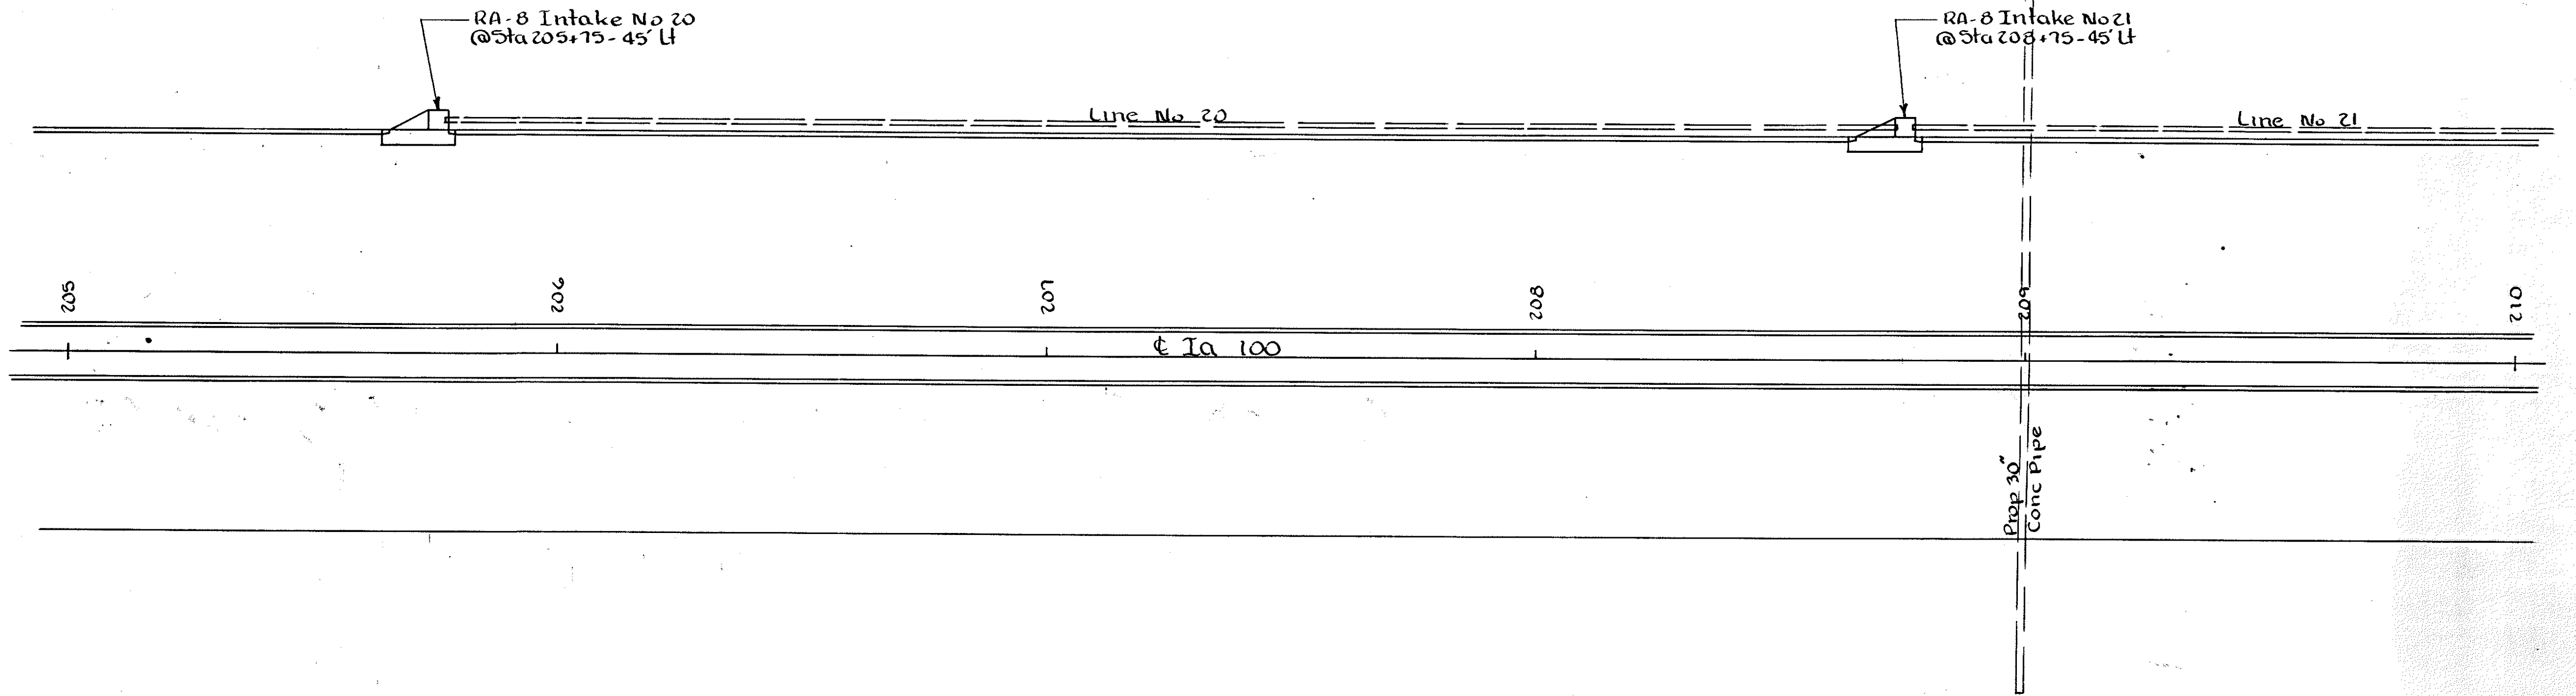

PLAN	DATE
SURVEYED	BY
PLOTTED	DATE
CHECKED	DATE
NOTED	DATE
NO.	DATE


PROFILE	DATE
SURVEYED	BY
PLOTTED	DATE
CHECKED	DATE
NOTED	DATE
NO.	DATE

LD.O.T. # 000-316980	PROJECT NUMBER	STATE	FWHA Region	FISCAL YEAR	SHEET NO.	TOTAL SHEETS
	NH3-100-1(23)--19-57	IOWA	7		M.06	

P. 114



PLAN	DATE	BY
SURVEYED		
NOTED		
ALIGNED		
CHECKED		
RT. OF WAY CHECKED		
NO.		

PROFILE	DATE	BY
SURVEYED		
NOTED		
ALIGNED		
CHECKED		
STRUCTURE NOTATIONS CHWD		
NO.		

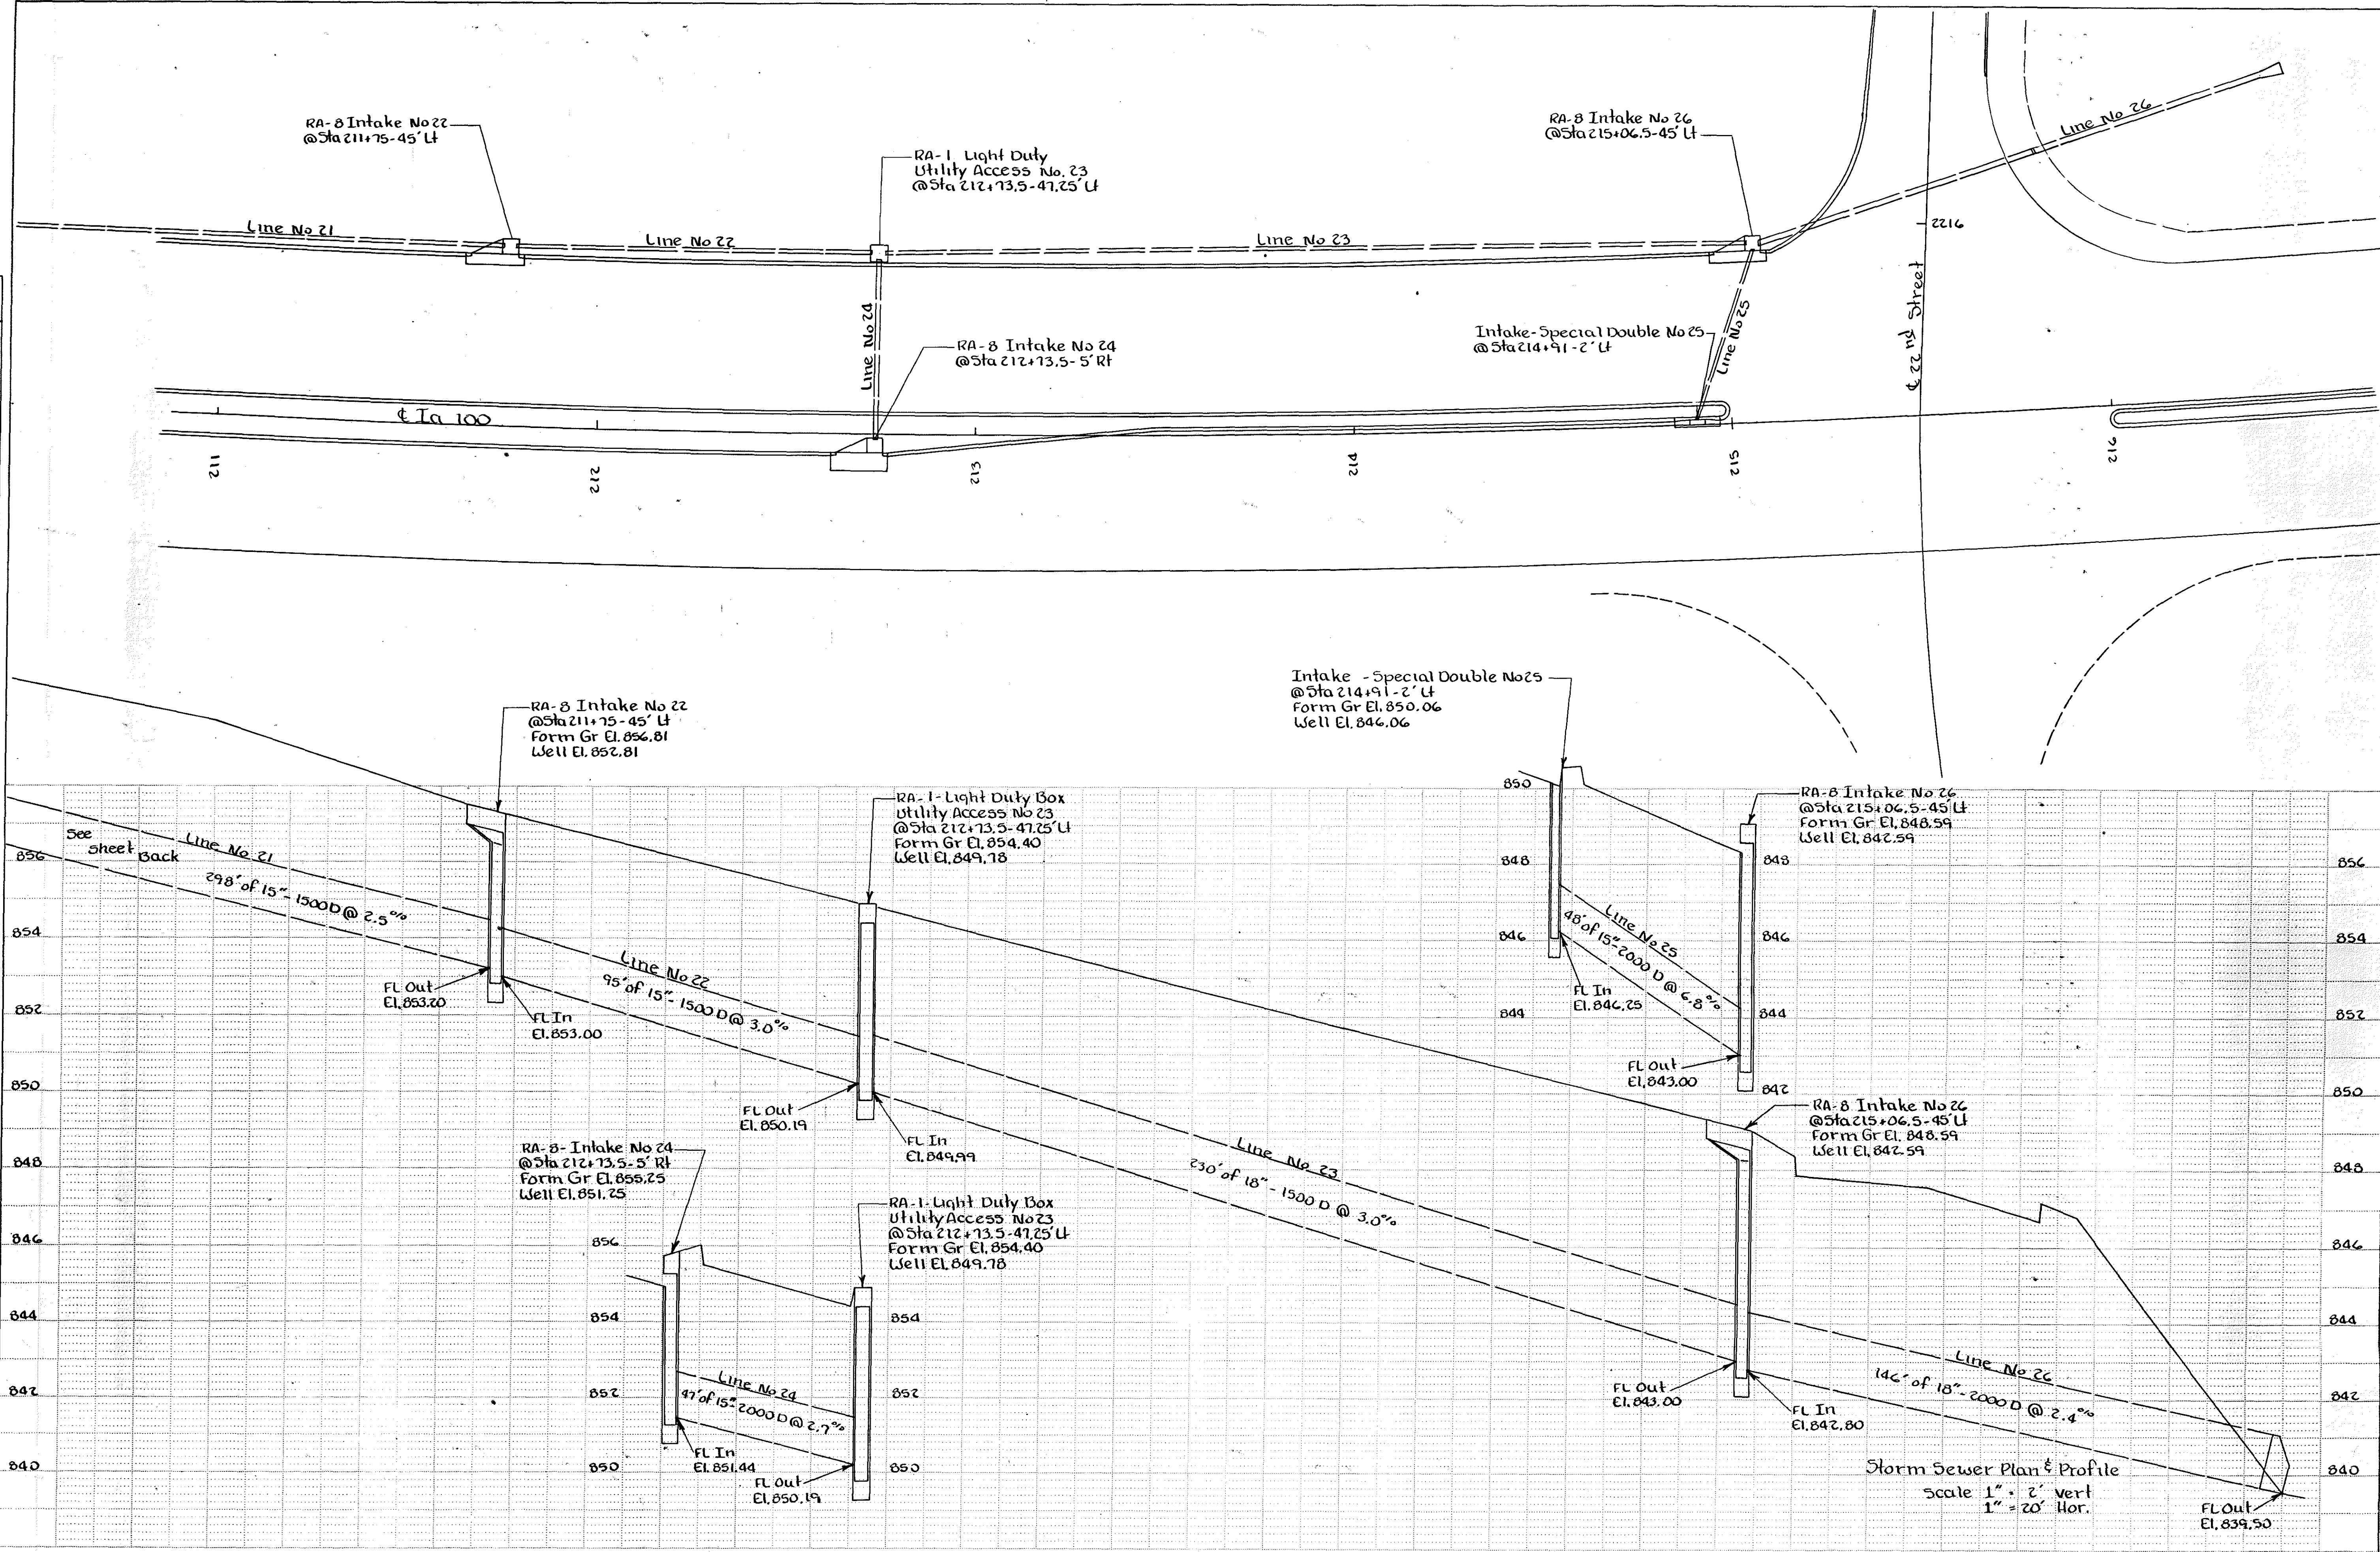

PLAN	NOTE BOOK NO.	SURVEYED	PLOTTED	CHECKED	BY	DATE


PROFILE	NOTE BOOK NO.	SURVEYED	PLOTTED	CHECKED	BY	DATE

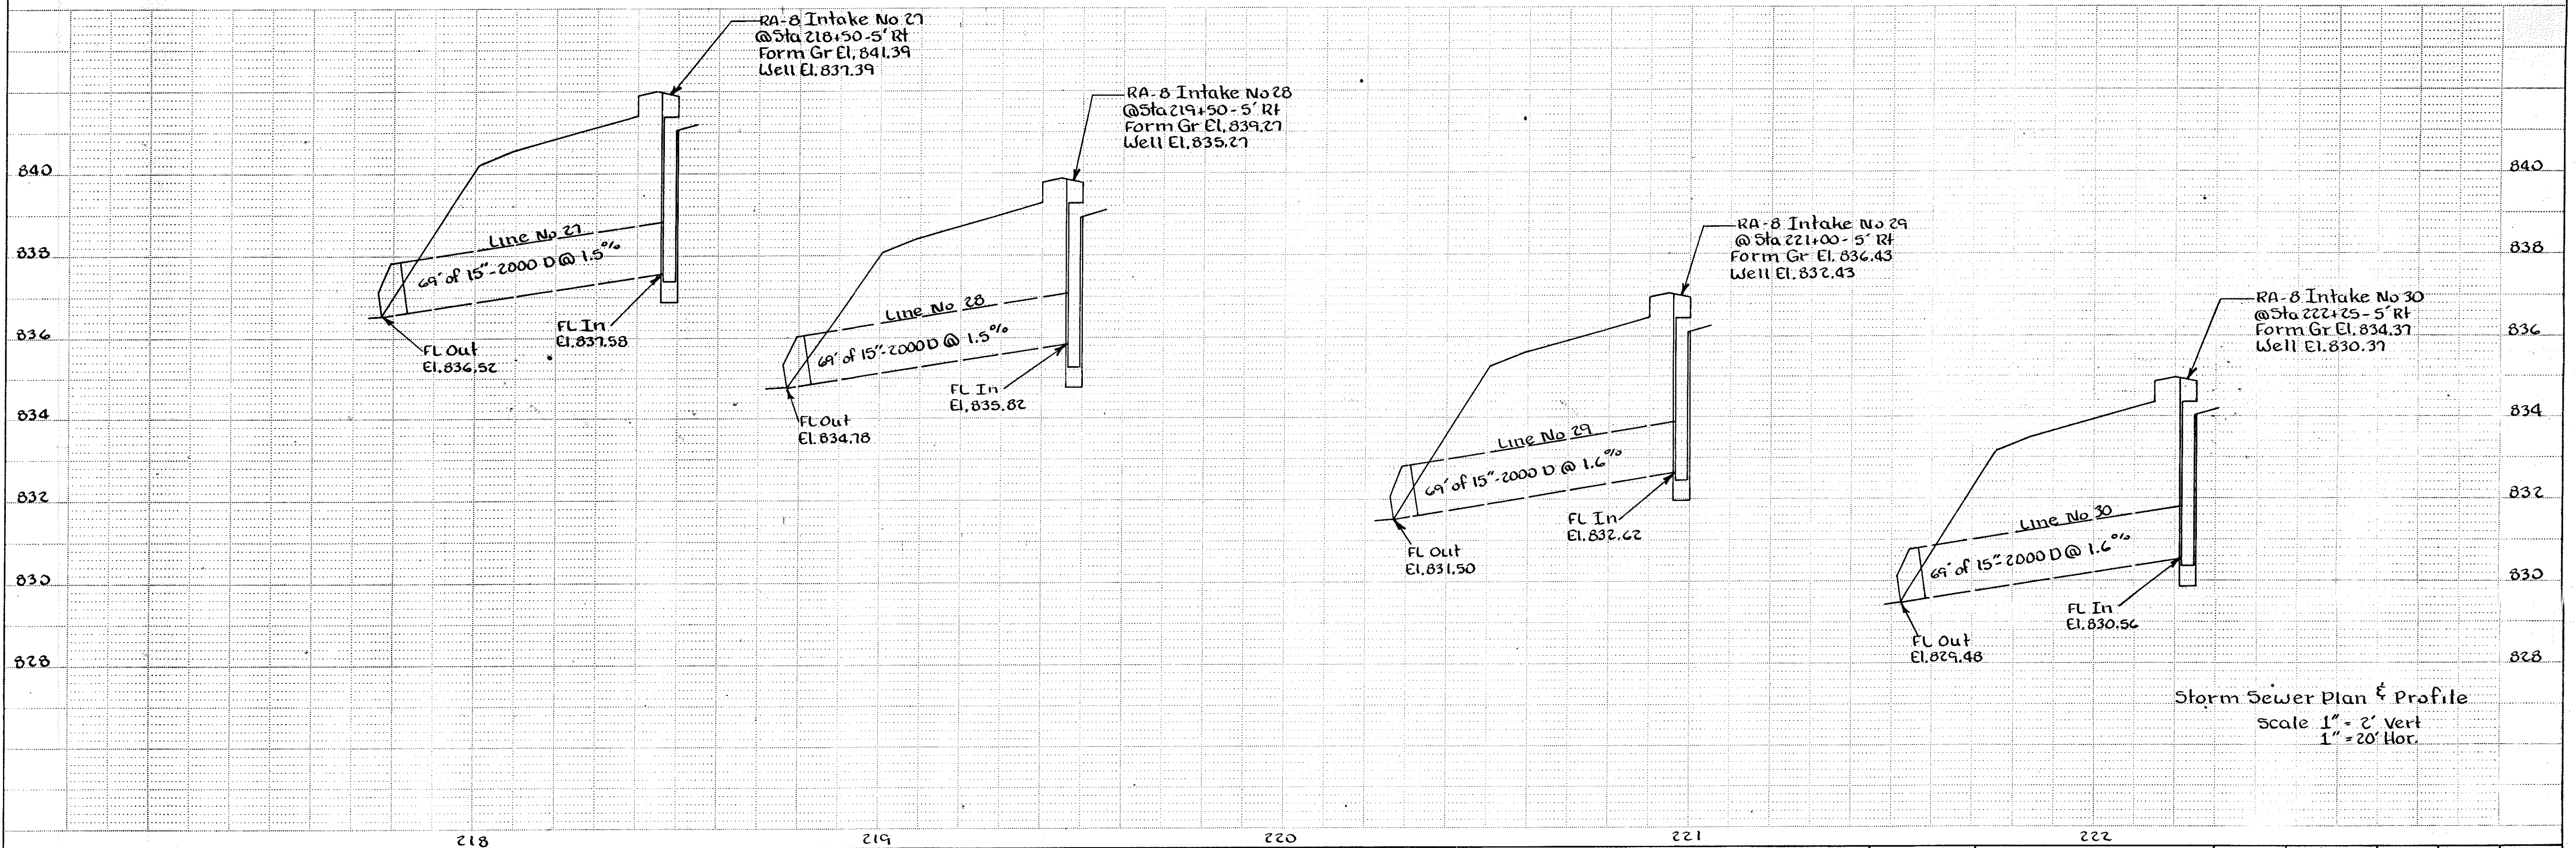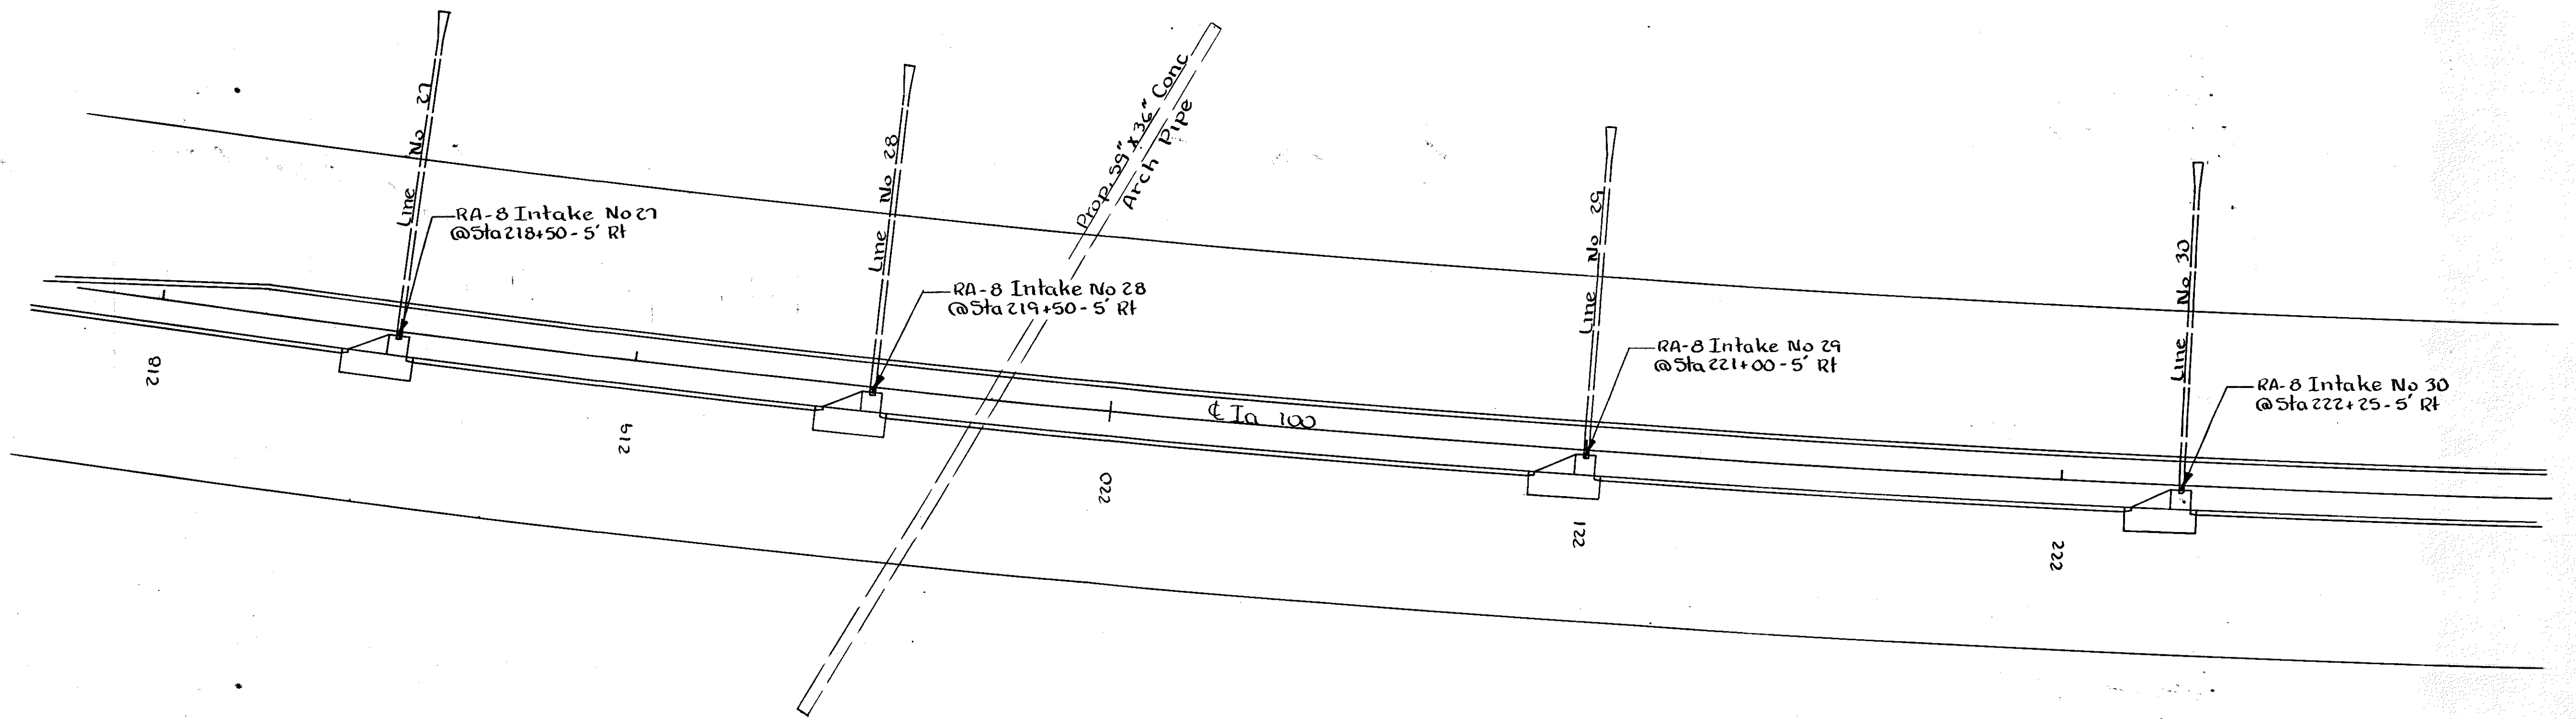


Storm Sewer Plan & Profile
Scale 1" = 2' Vert
1" = 20' Hor.

I.D.O.T. # 000-316980		Linn COUNTY		PROJECT NUMBER		STATE	FHWA Region	FISCAL YEAR	SHEET NO.	TOTAL SHEETS
				NH5-100-1(23)-19-97		IOWA	7		M08	

PLAN		DATE
SURVEYED	BY	
PLOTTED		
GRADES CHECKED		
NOTE BOOK NO.		

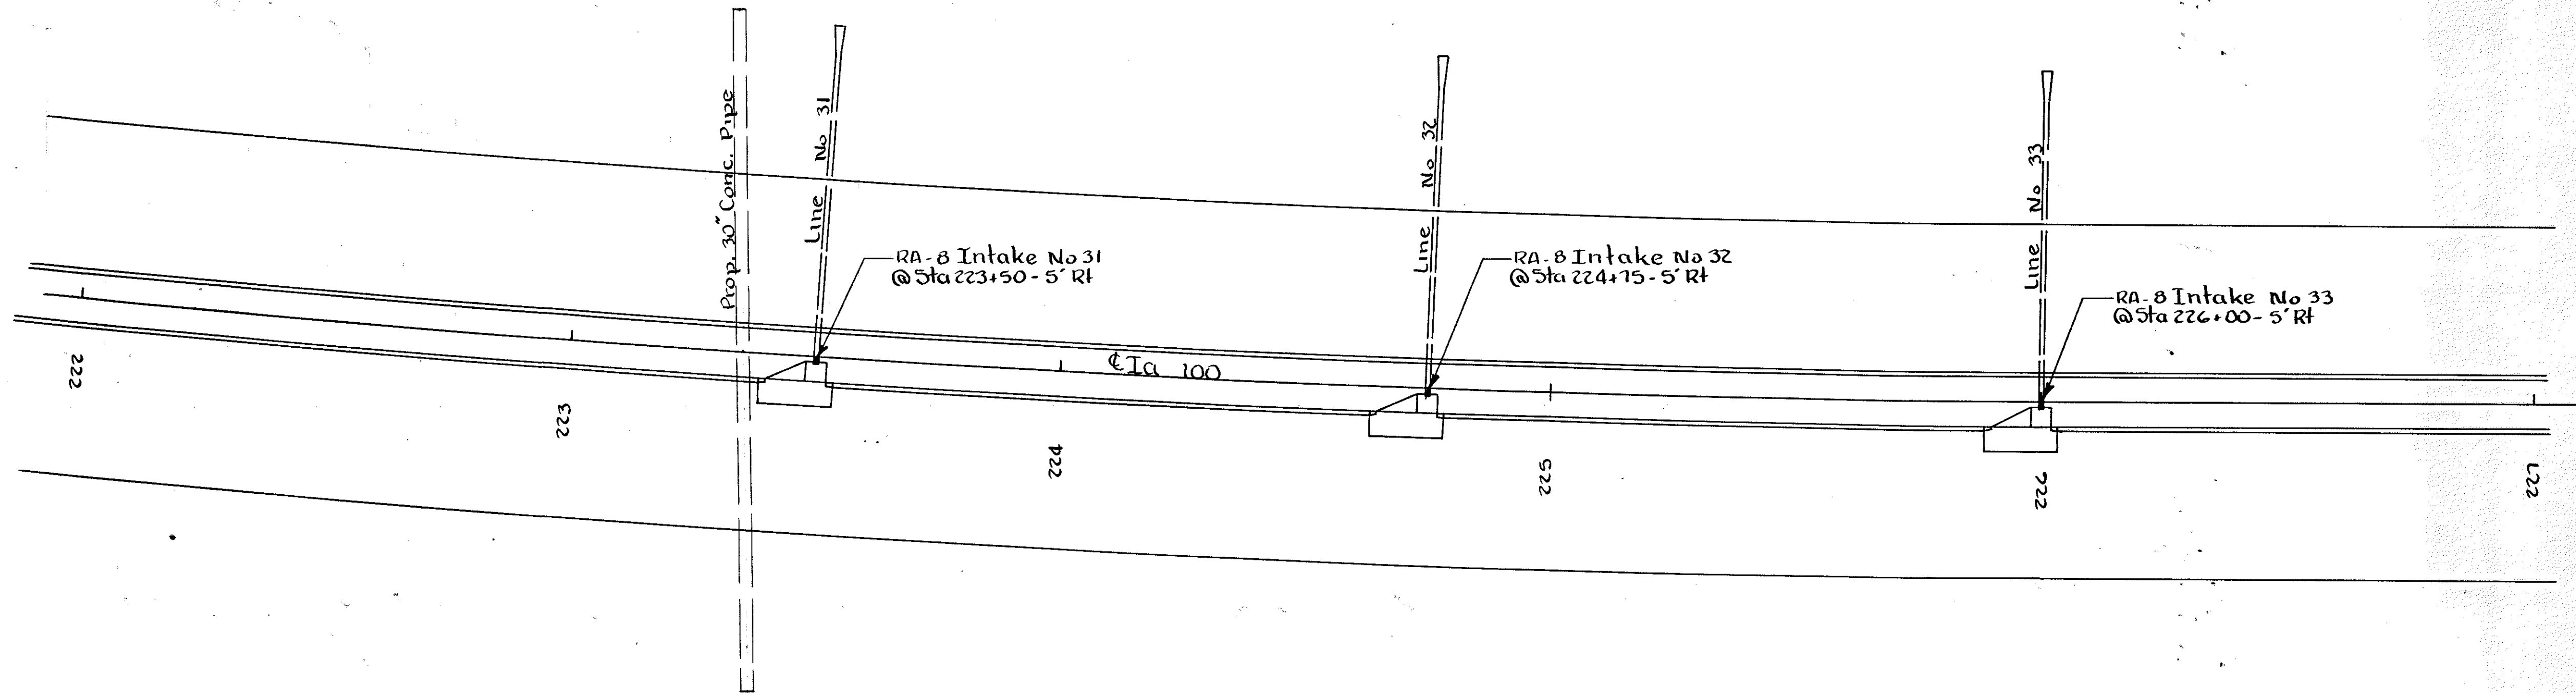


PROFILE		DATE
SURVEYED	BY	
PLOTTED		
GRADES CHECKED		
NOTE BOOK NO.		

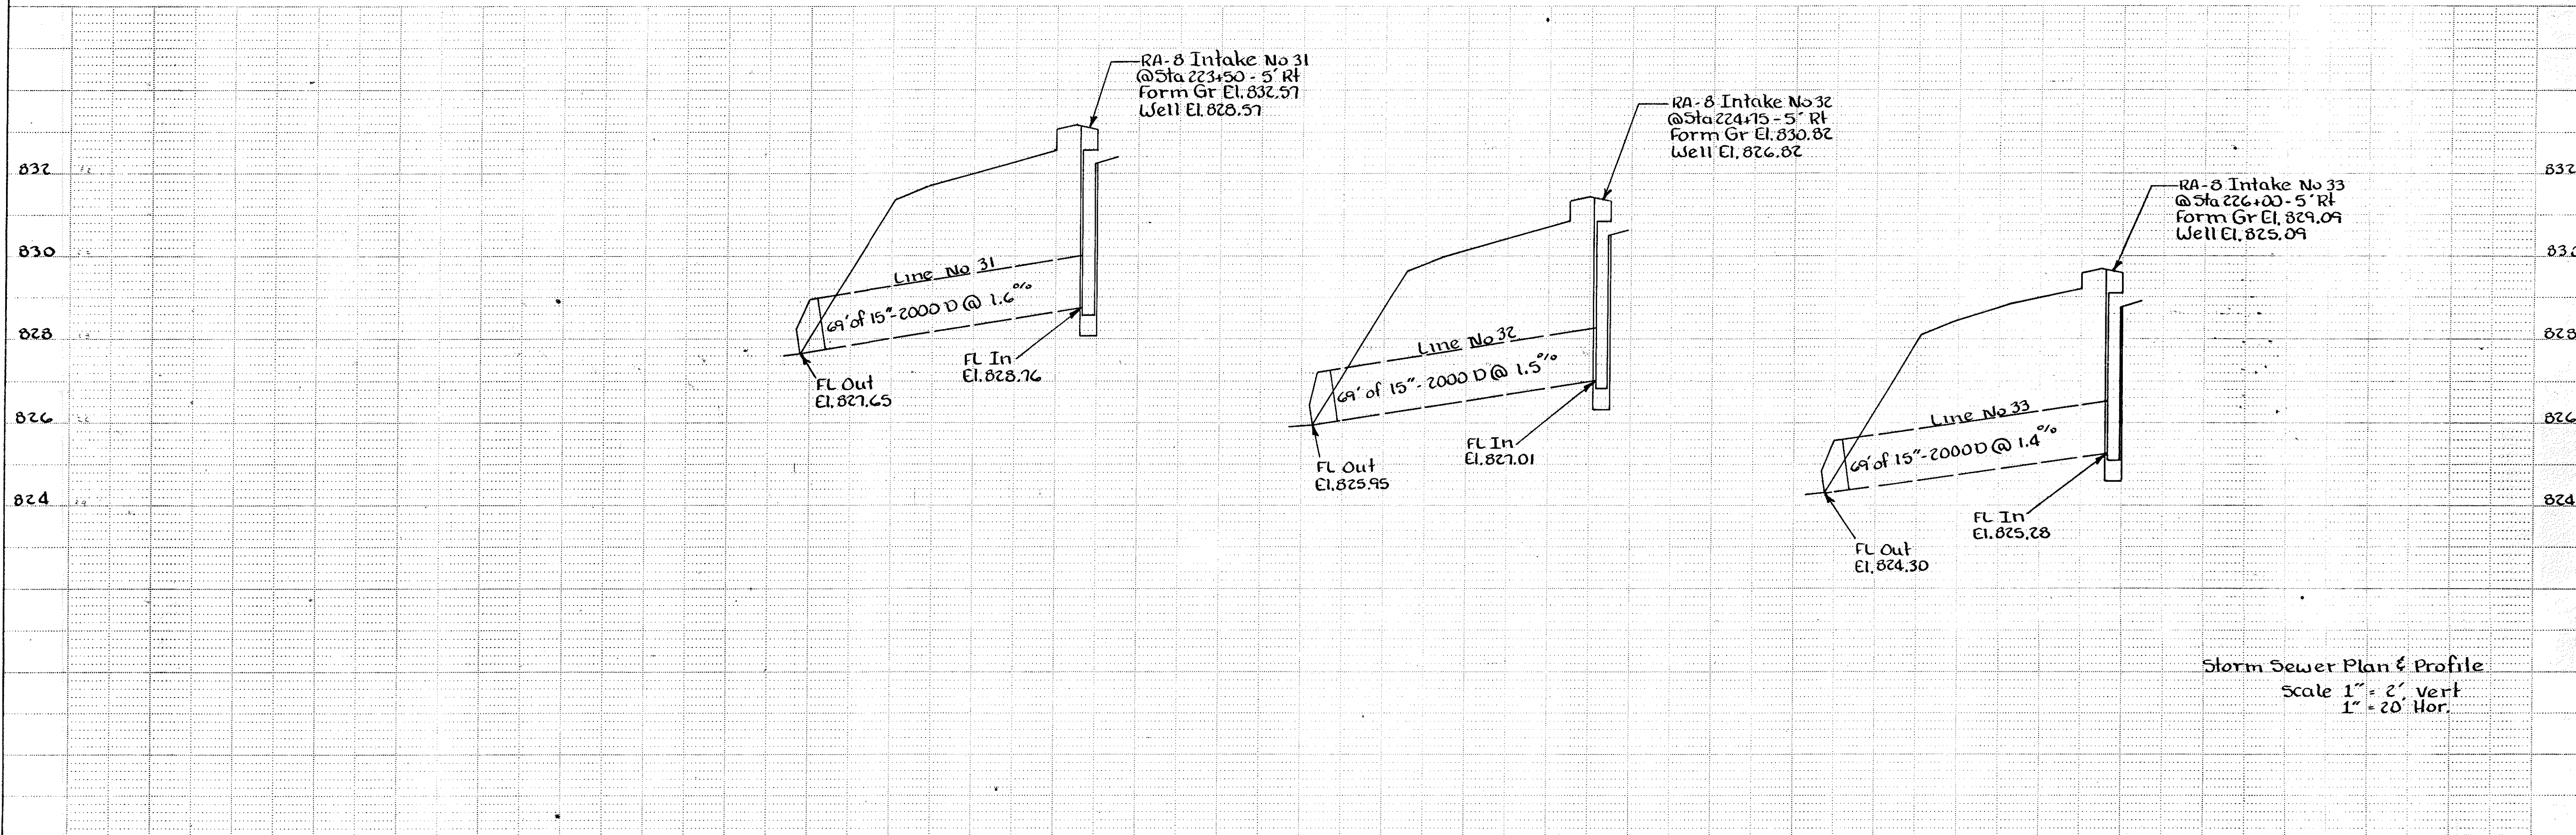


Storm Sewer Plan & Profile
Scale 1" = 2' Vert.
1" = 20' Hor.

PLAN	DATE
SURVEYED	BY
PLOTTED	DATE
ALIGNMENT CHECKED	
RT. OF WAY CHECKED	
NOTE BOOK	
NO.	

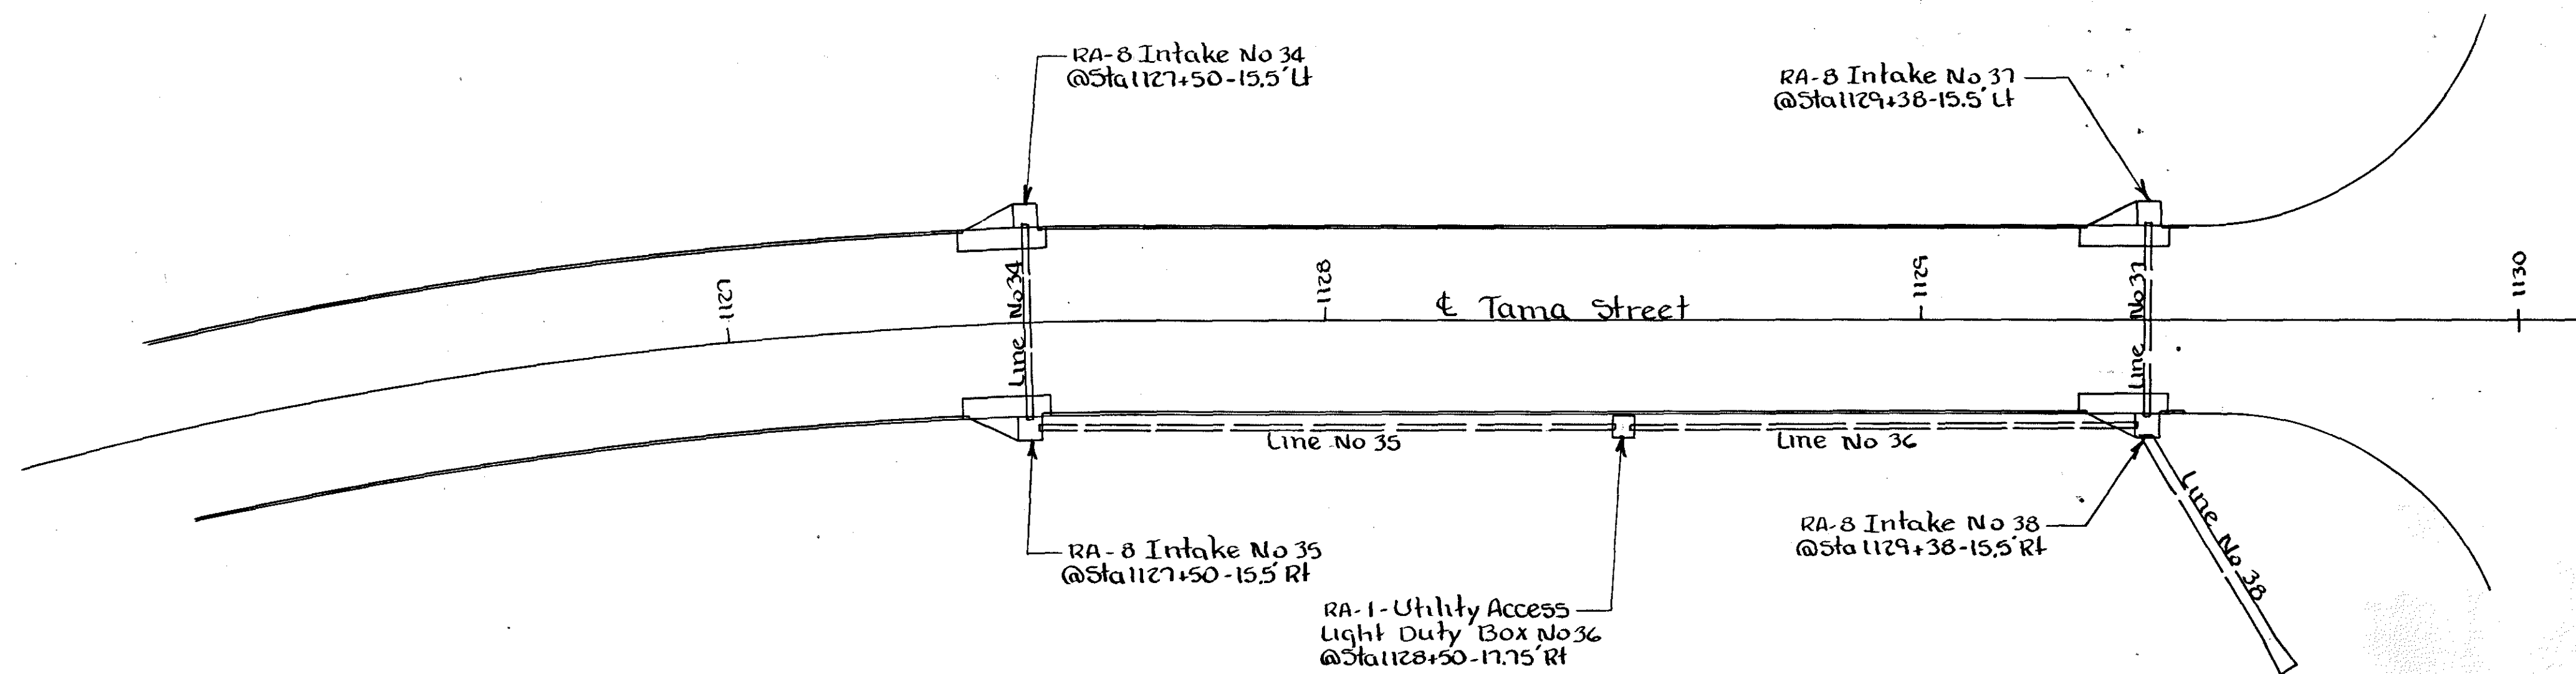

PROFILE	DATE
SURVEYED	BY
PLOTTED	DATE
STRUCTURE NOTATION CHKD	
NOTE BOOK	
NO.	

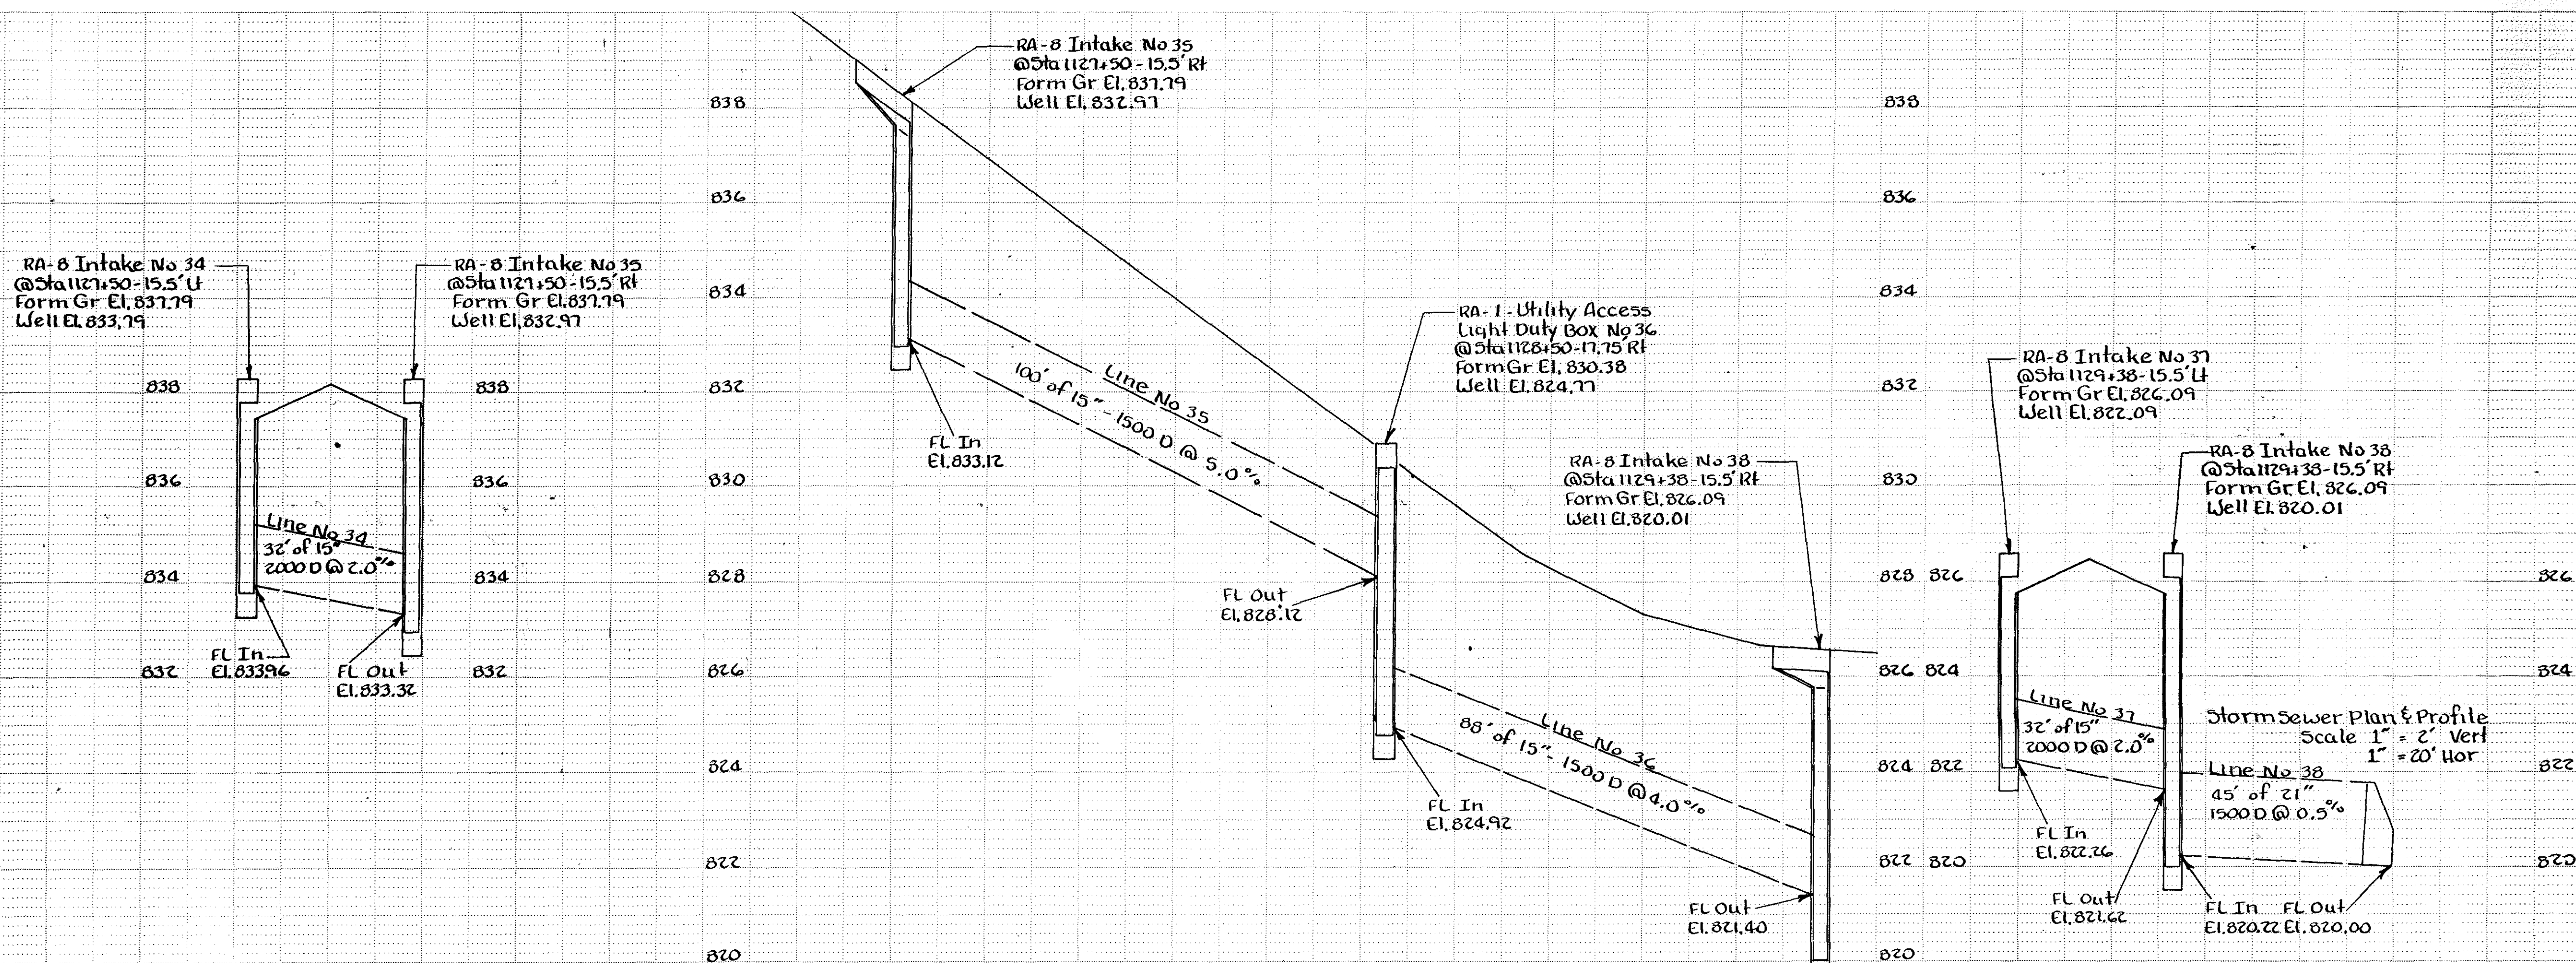



10.0.T. # 000-316980

Linn COUNTY





PROJECT NUMBER	STATE	FHWA Region	FISCAL YEAR	SHEET NO.	TOTAL SHEETS
NHS-100-1(23)-19-57	IOWA	7		M.10	

DATE	
BY	
REVIEWED	
NOTED	
NO.	
AREA	
DATE	

DATE	5-82
BY	A. J. J. & S. J. J.
REVIEWED	
NOTED	
NO.	
AREA	
DATE	

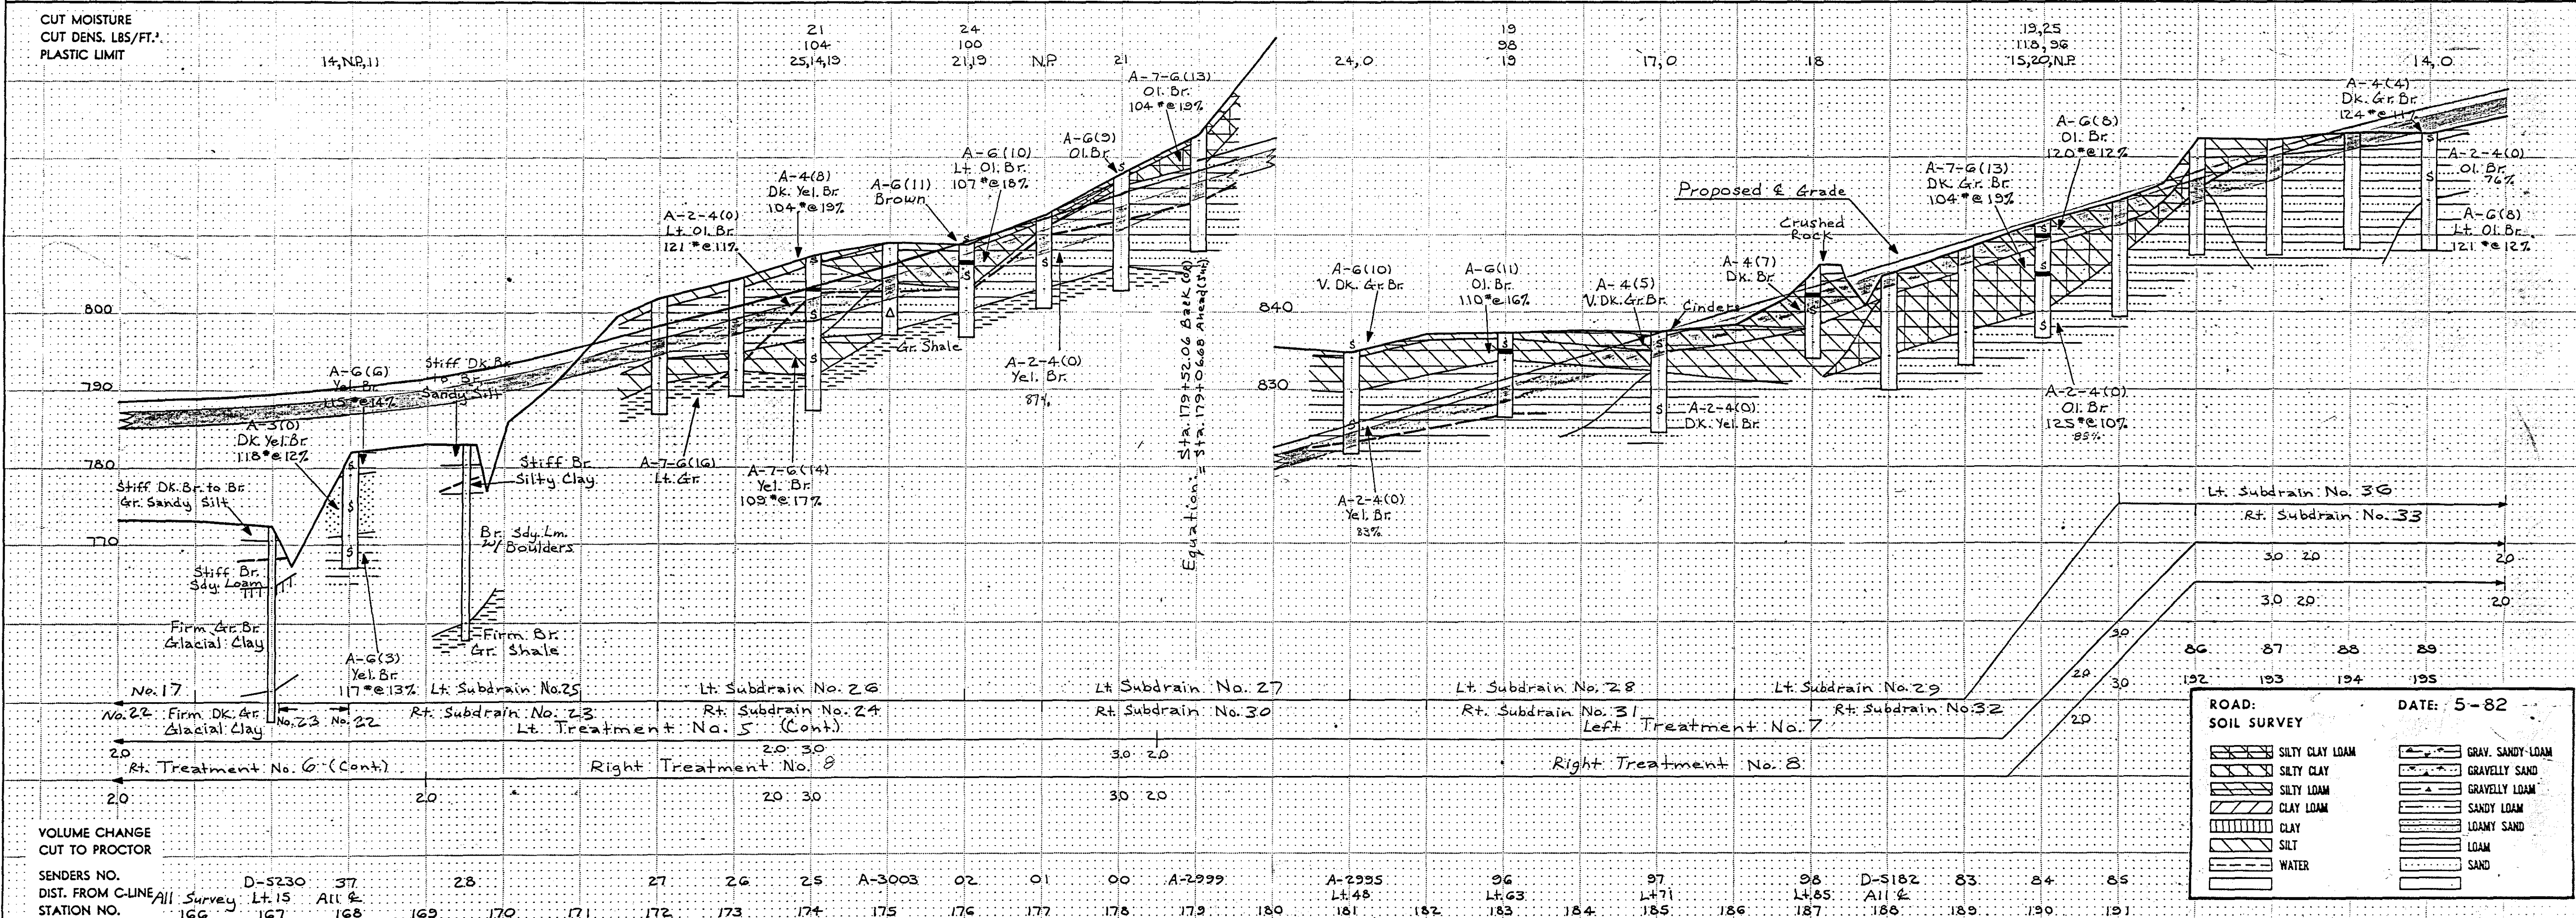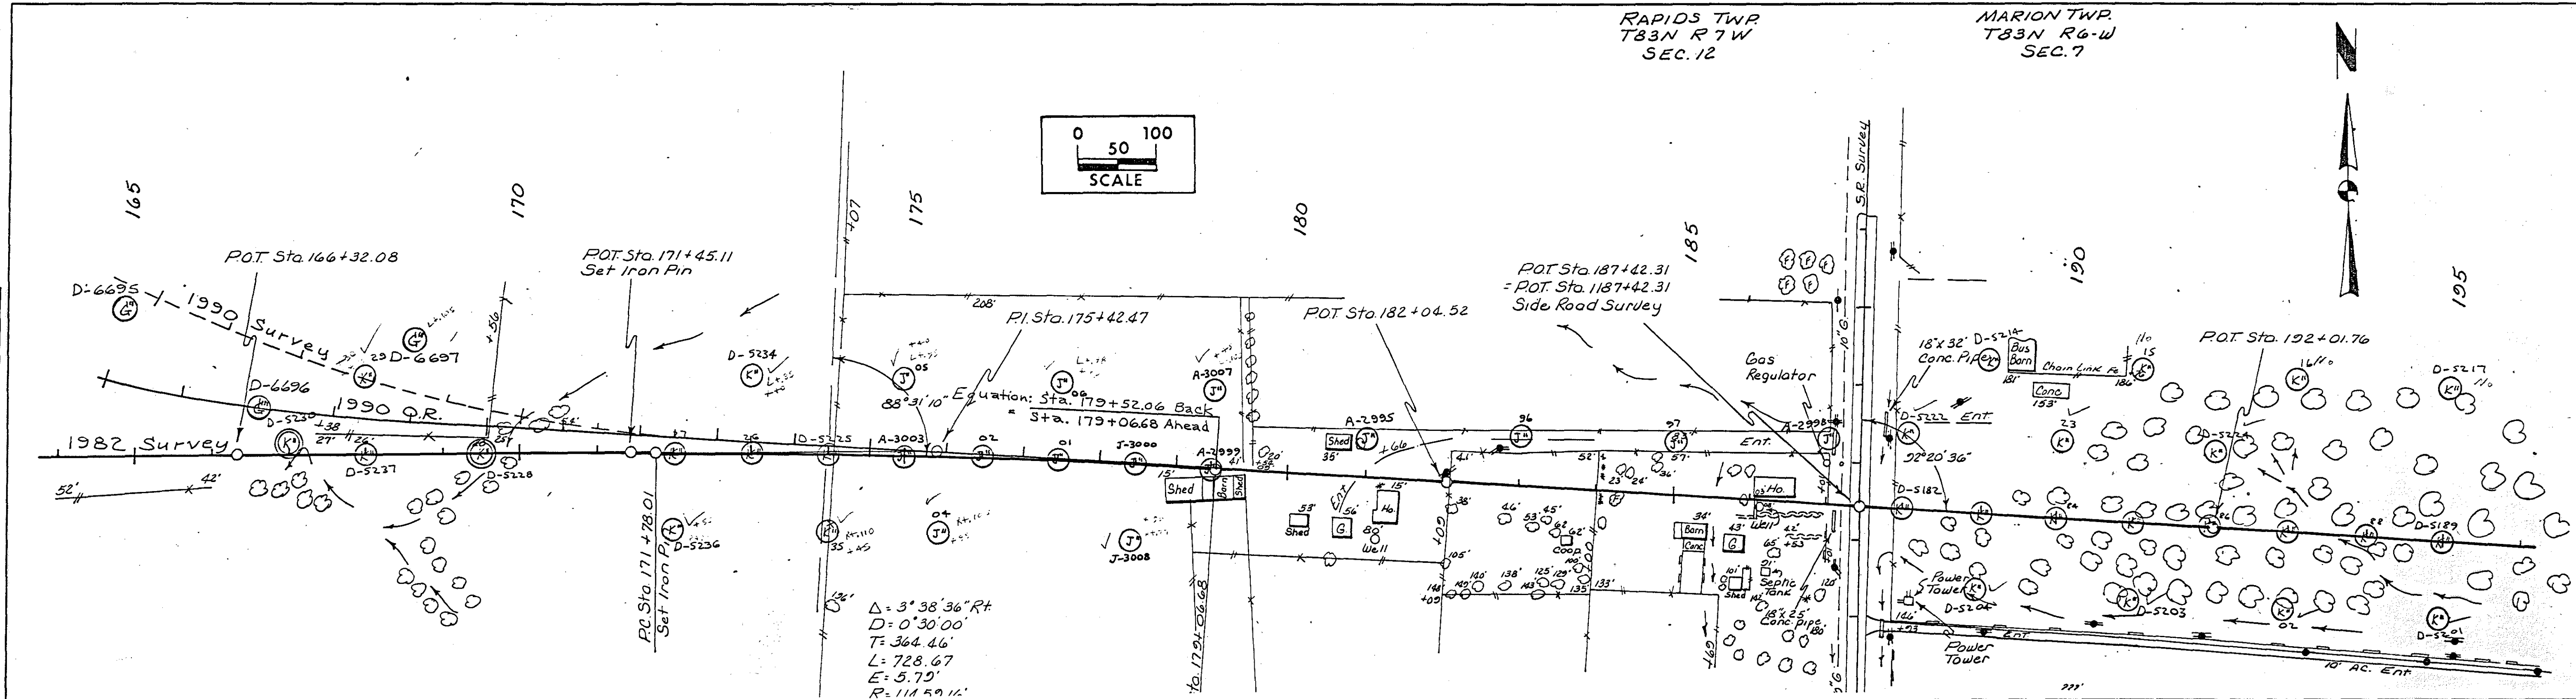

SENDERS NO.	D-5230	37	28	27	26	25	A-3003	02	01	00	A-2999	A-2995	96	97	98	D-5182	83	84	85
DIST. FROM C-LINE	All Survey	Lt. 15	All &									Lt. 48	Lt. 63	Lt. 71	Lt. 85	All &			
STATION NO.	166	167	168	169	170	171	172	173	174	175	176	177	178	179	180	181	182	183	184

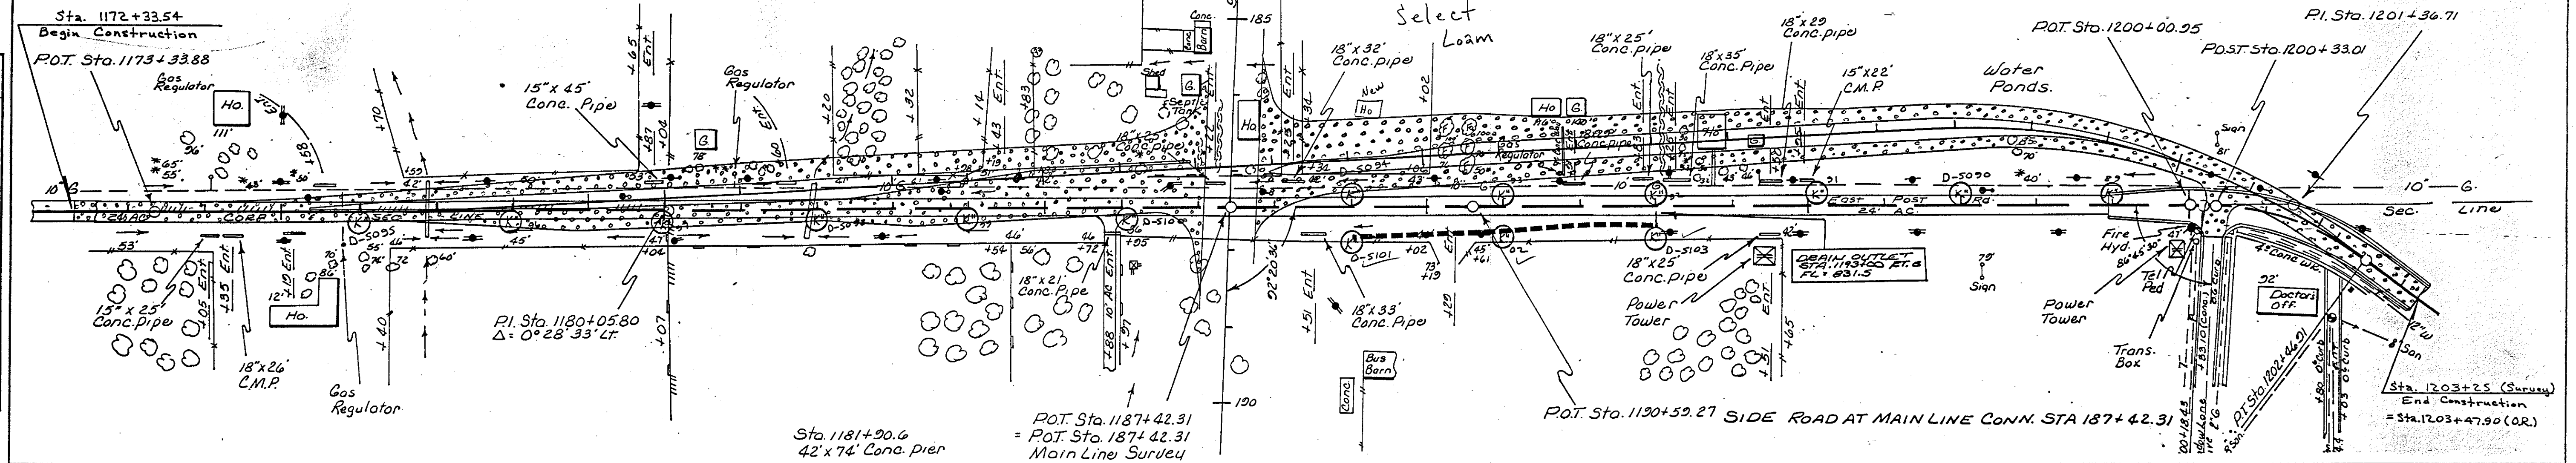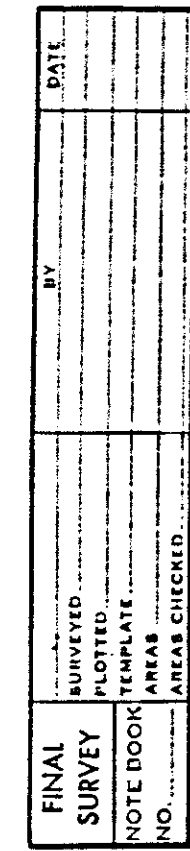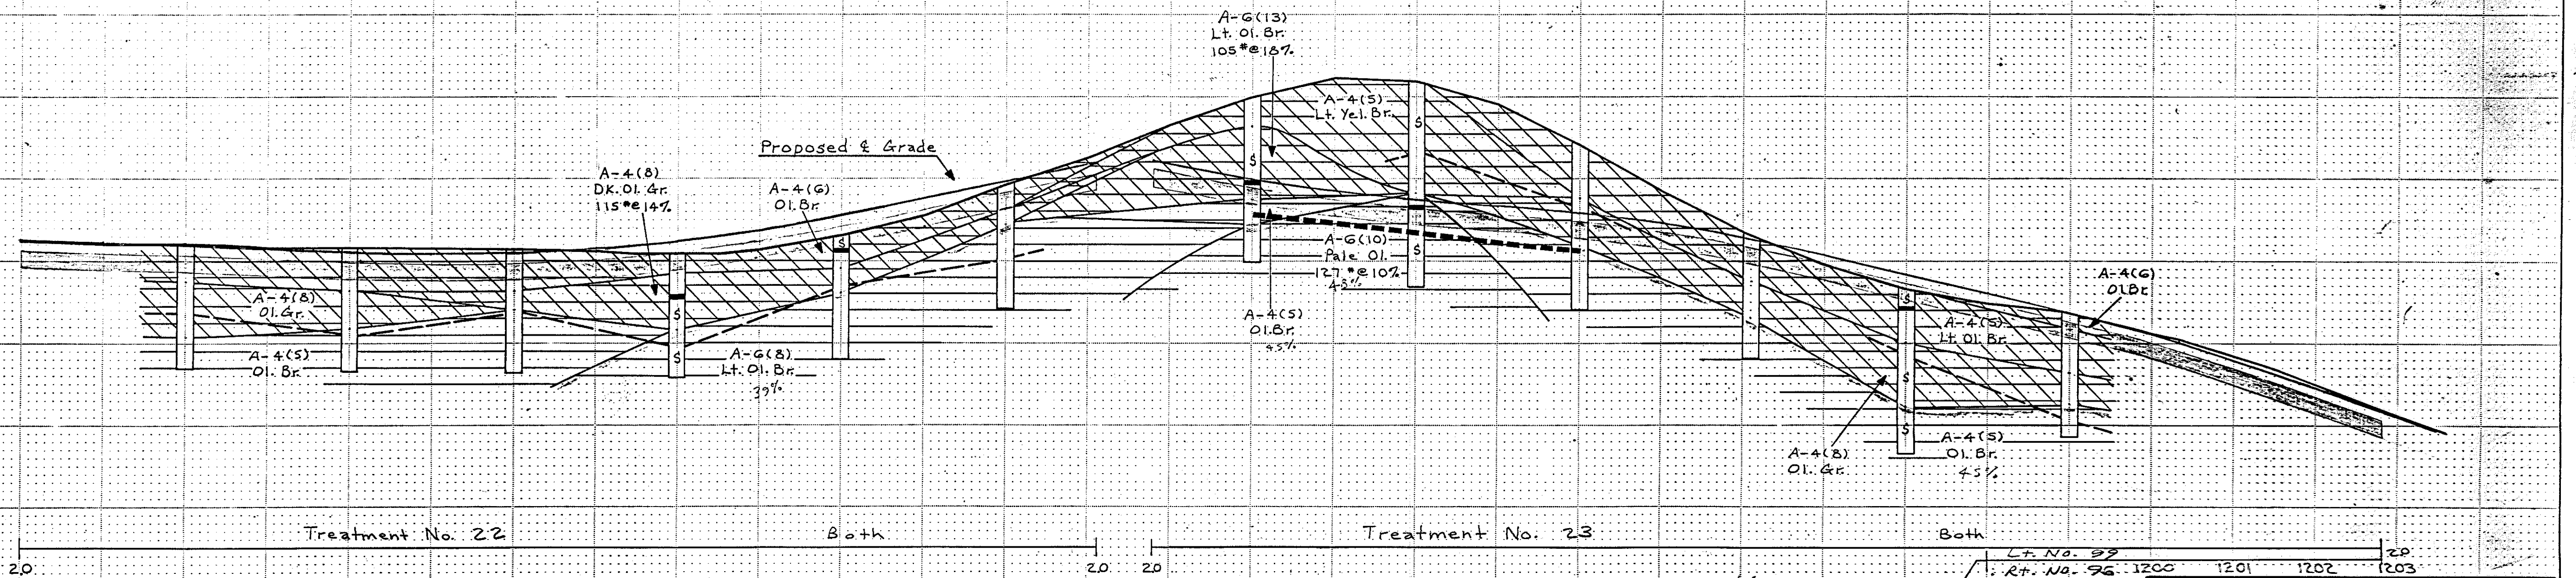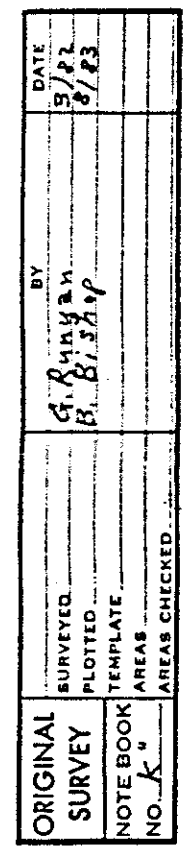[illegible]

																												ROAD: SOIL SURVEY										DATE: MAR. 82									
																												 SILTY CLAY LOAM										 GRAY. SANDY LOAM									
																												 SILTY CLAY										 GRAVELLY SAND									
																												 SILTY LOAM										 GRAVELLY LOAM									
																												 CLAY LOAM										 SANDY LOAM									
																												 CLAY										 LOAMY SAND									
																												 SILT										 LOAM									
																												 WATER										 SAND									
																																															

ROAD:

DATE: MAR. 82

SOIL SURVEY

SILTY CLAY LOAM

SILTY CLAY

SILTY LOAM

CLAY LOAM

CLAY

SILT

WATER

GRAV. SANDY LOAM

GRAVELLY SAND

GRAVELLY LOAM


SANDY LOAM


LOAMY SAND

LOAM


SAND

ORIGINAL SURVEY	BY A. Myers, G. Rayner B. Bishop	DATE 28-5-72 4-7-72
NOTE BOOK NO. J, K	SURVEYED PLOTTED TEMPLATE AREAS AREAS CHECKED	

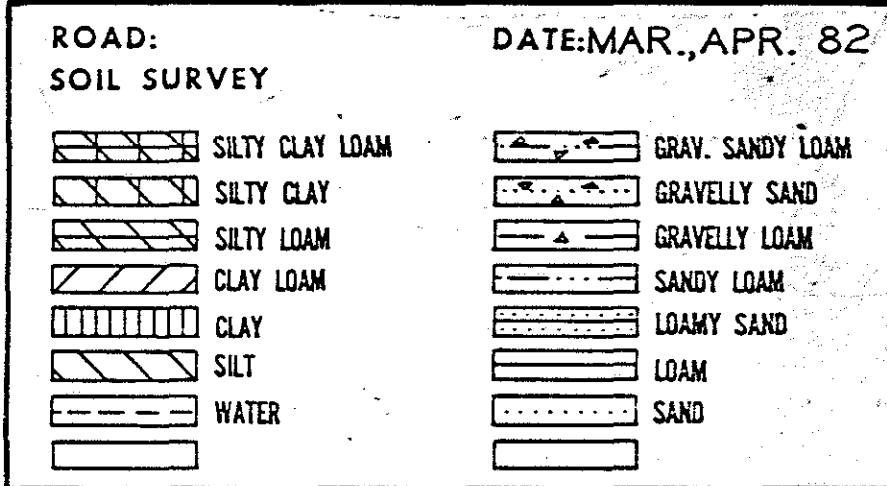

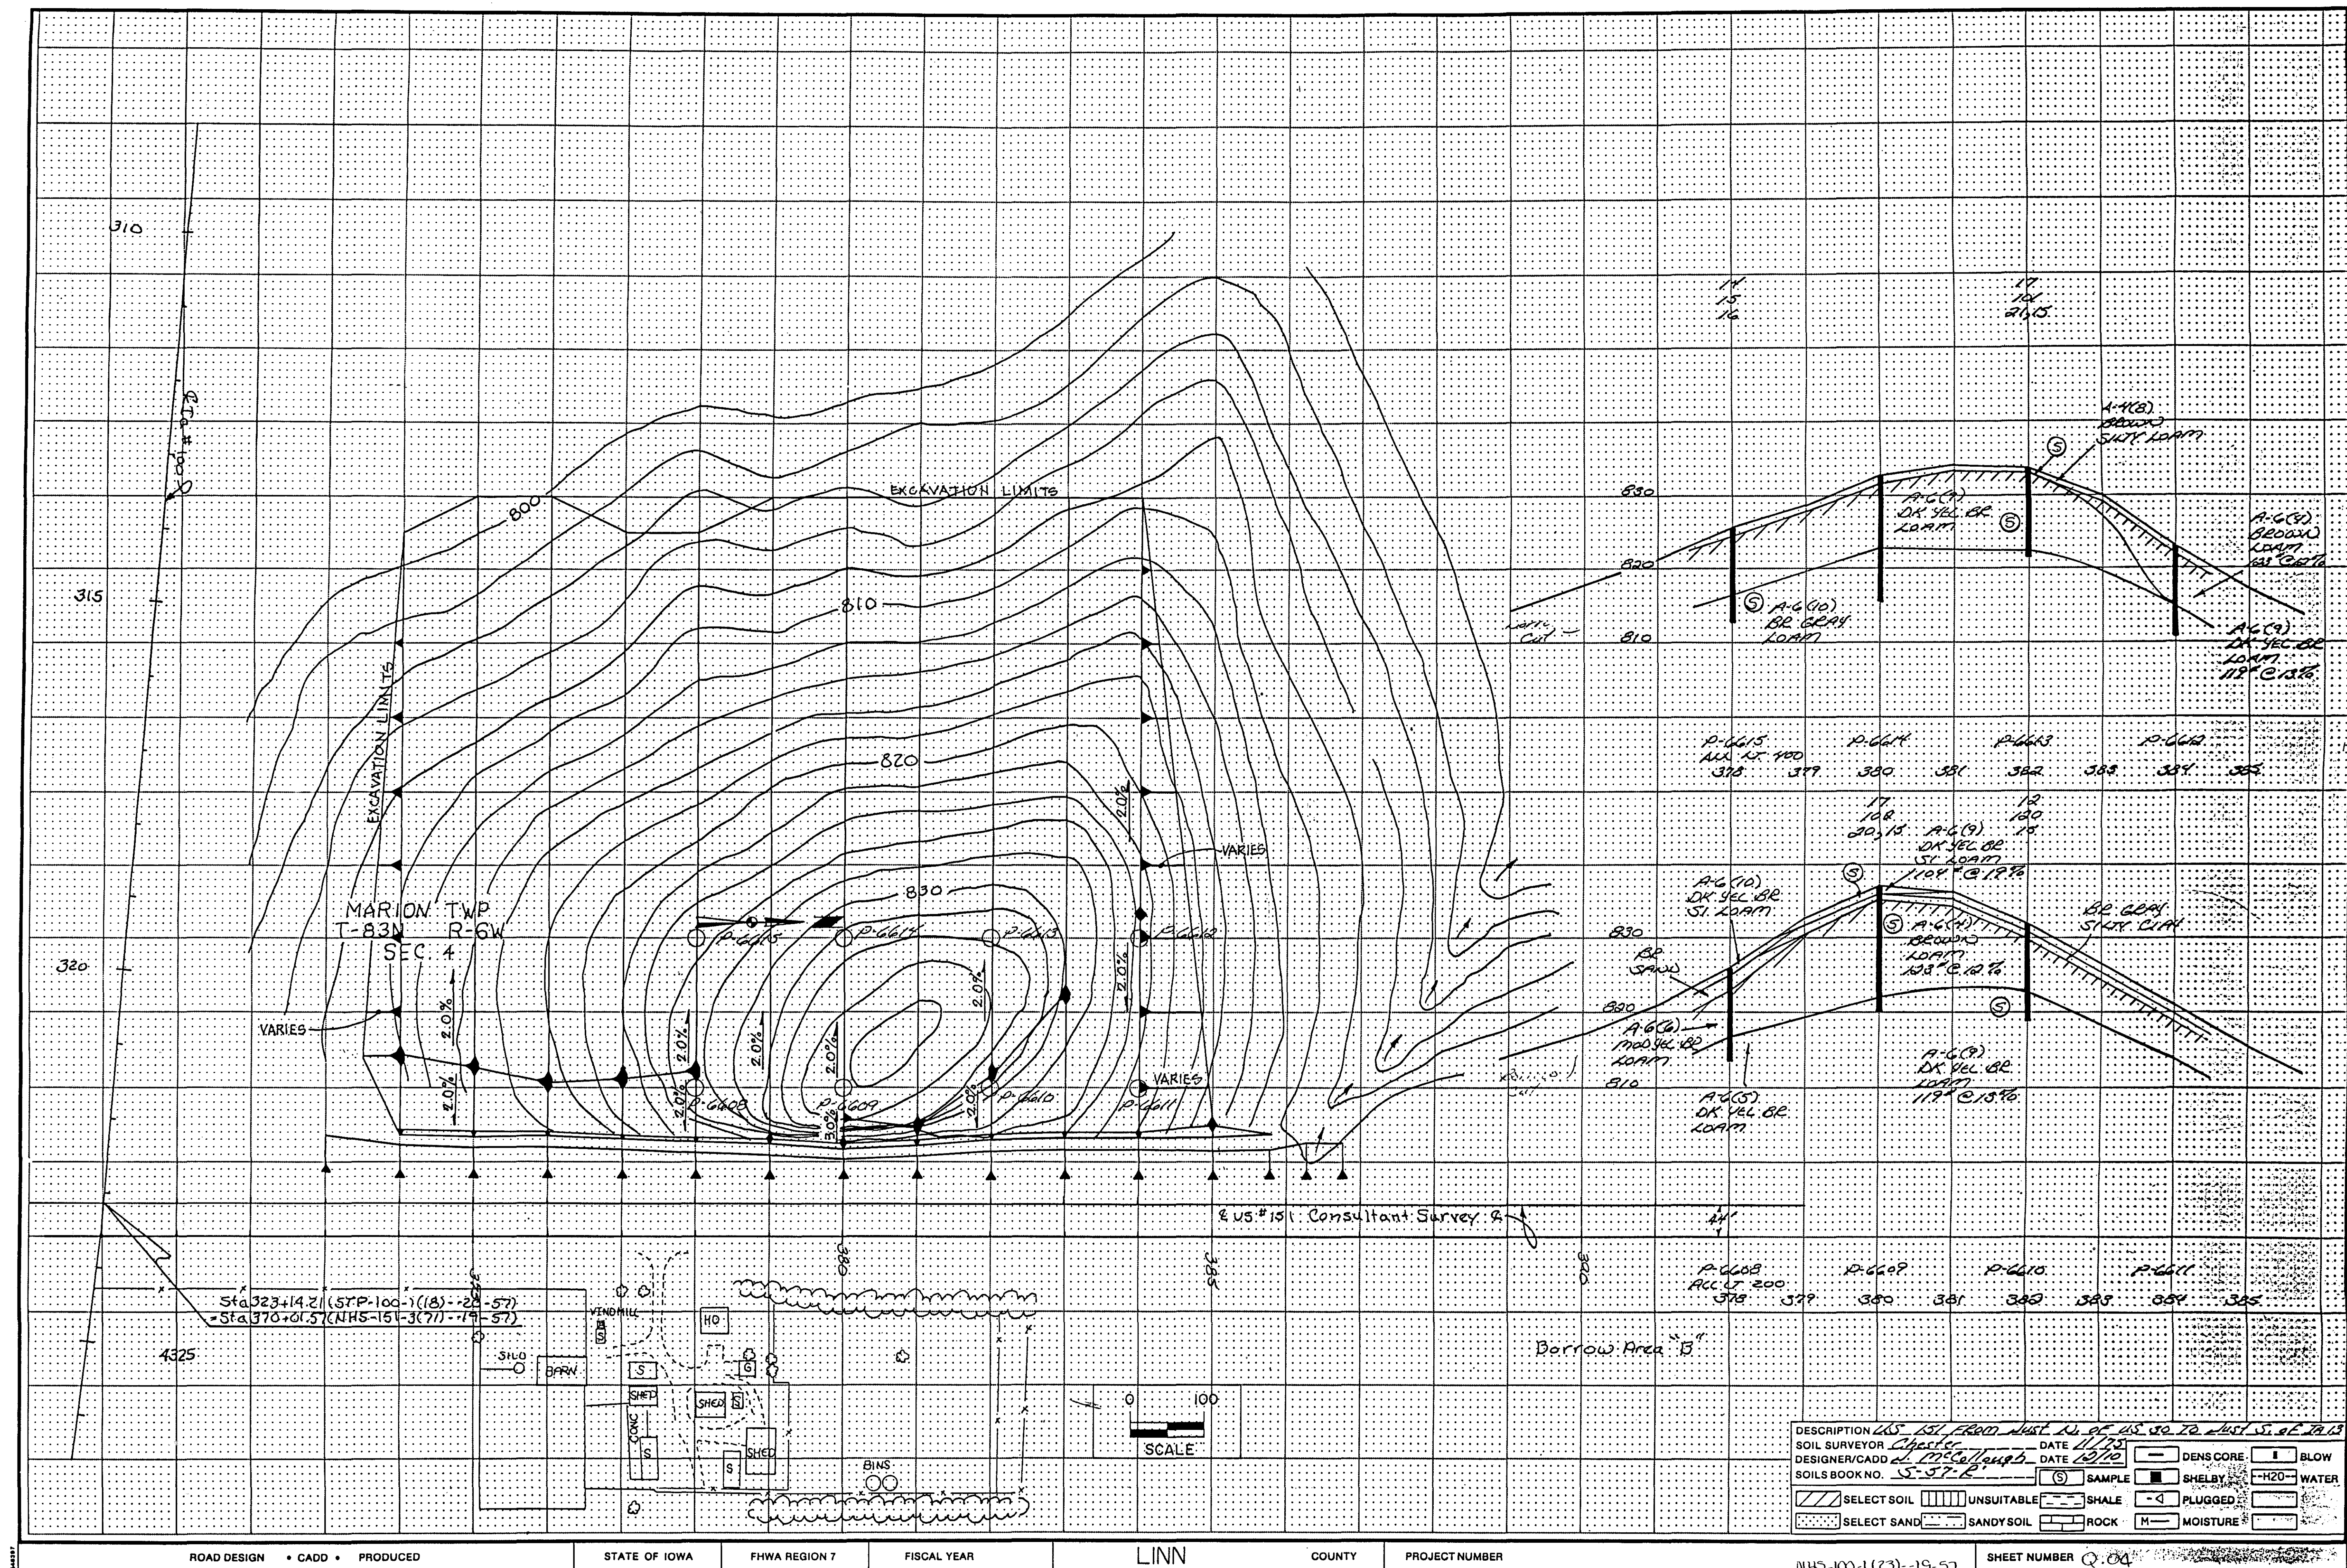

MARION TWP
T-83N R-6W
SEC. 8

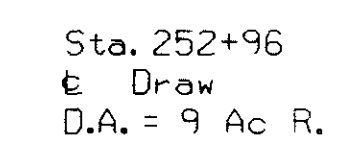


Sta. 244+46
 @ Draw
 D.A. = 439 Ac R.-H.

150,244 Cu Yds Avail.
68,144 Cu Yds Select Avail. & Required
11,484 Cu Yds Topsoil Avail. & Required
36,760 Cu Yds Class 10 Avail. & Required
33,856 Cu Yds Cushion

Note: The 11,484 cu yds of topsoil is for replacement within the borrow area upon completion of the project.

Included for Information Only
Scale 1" = 100'

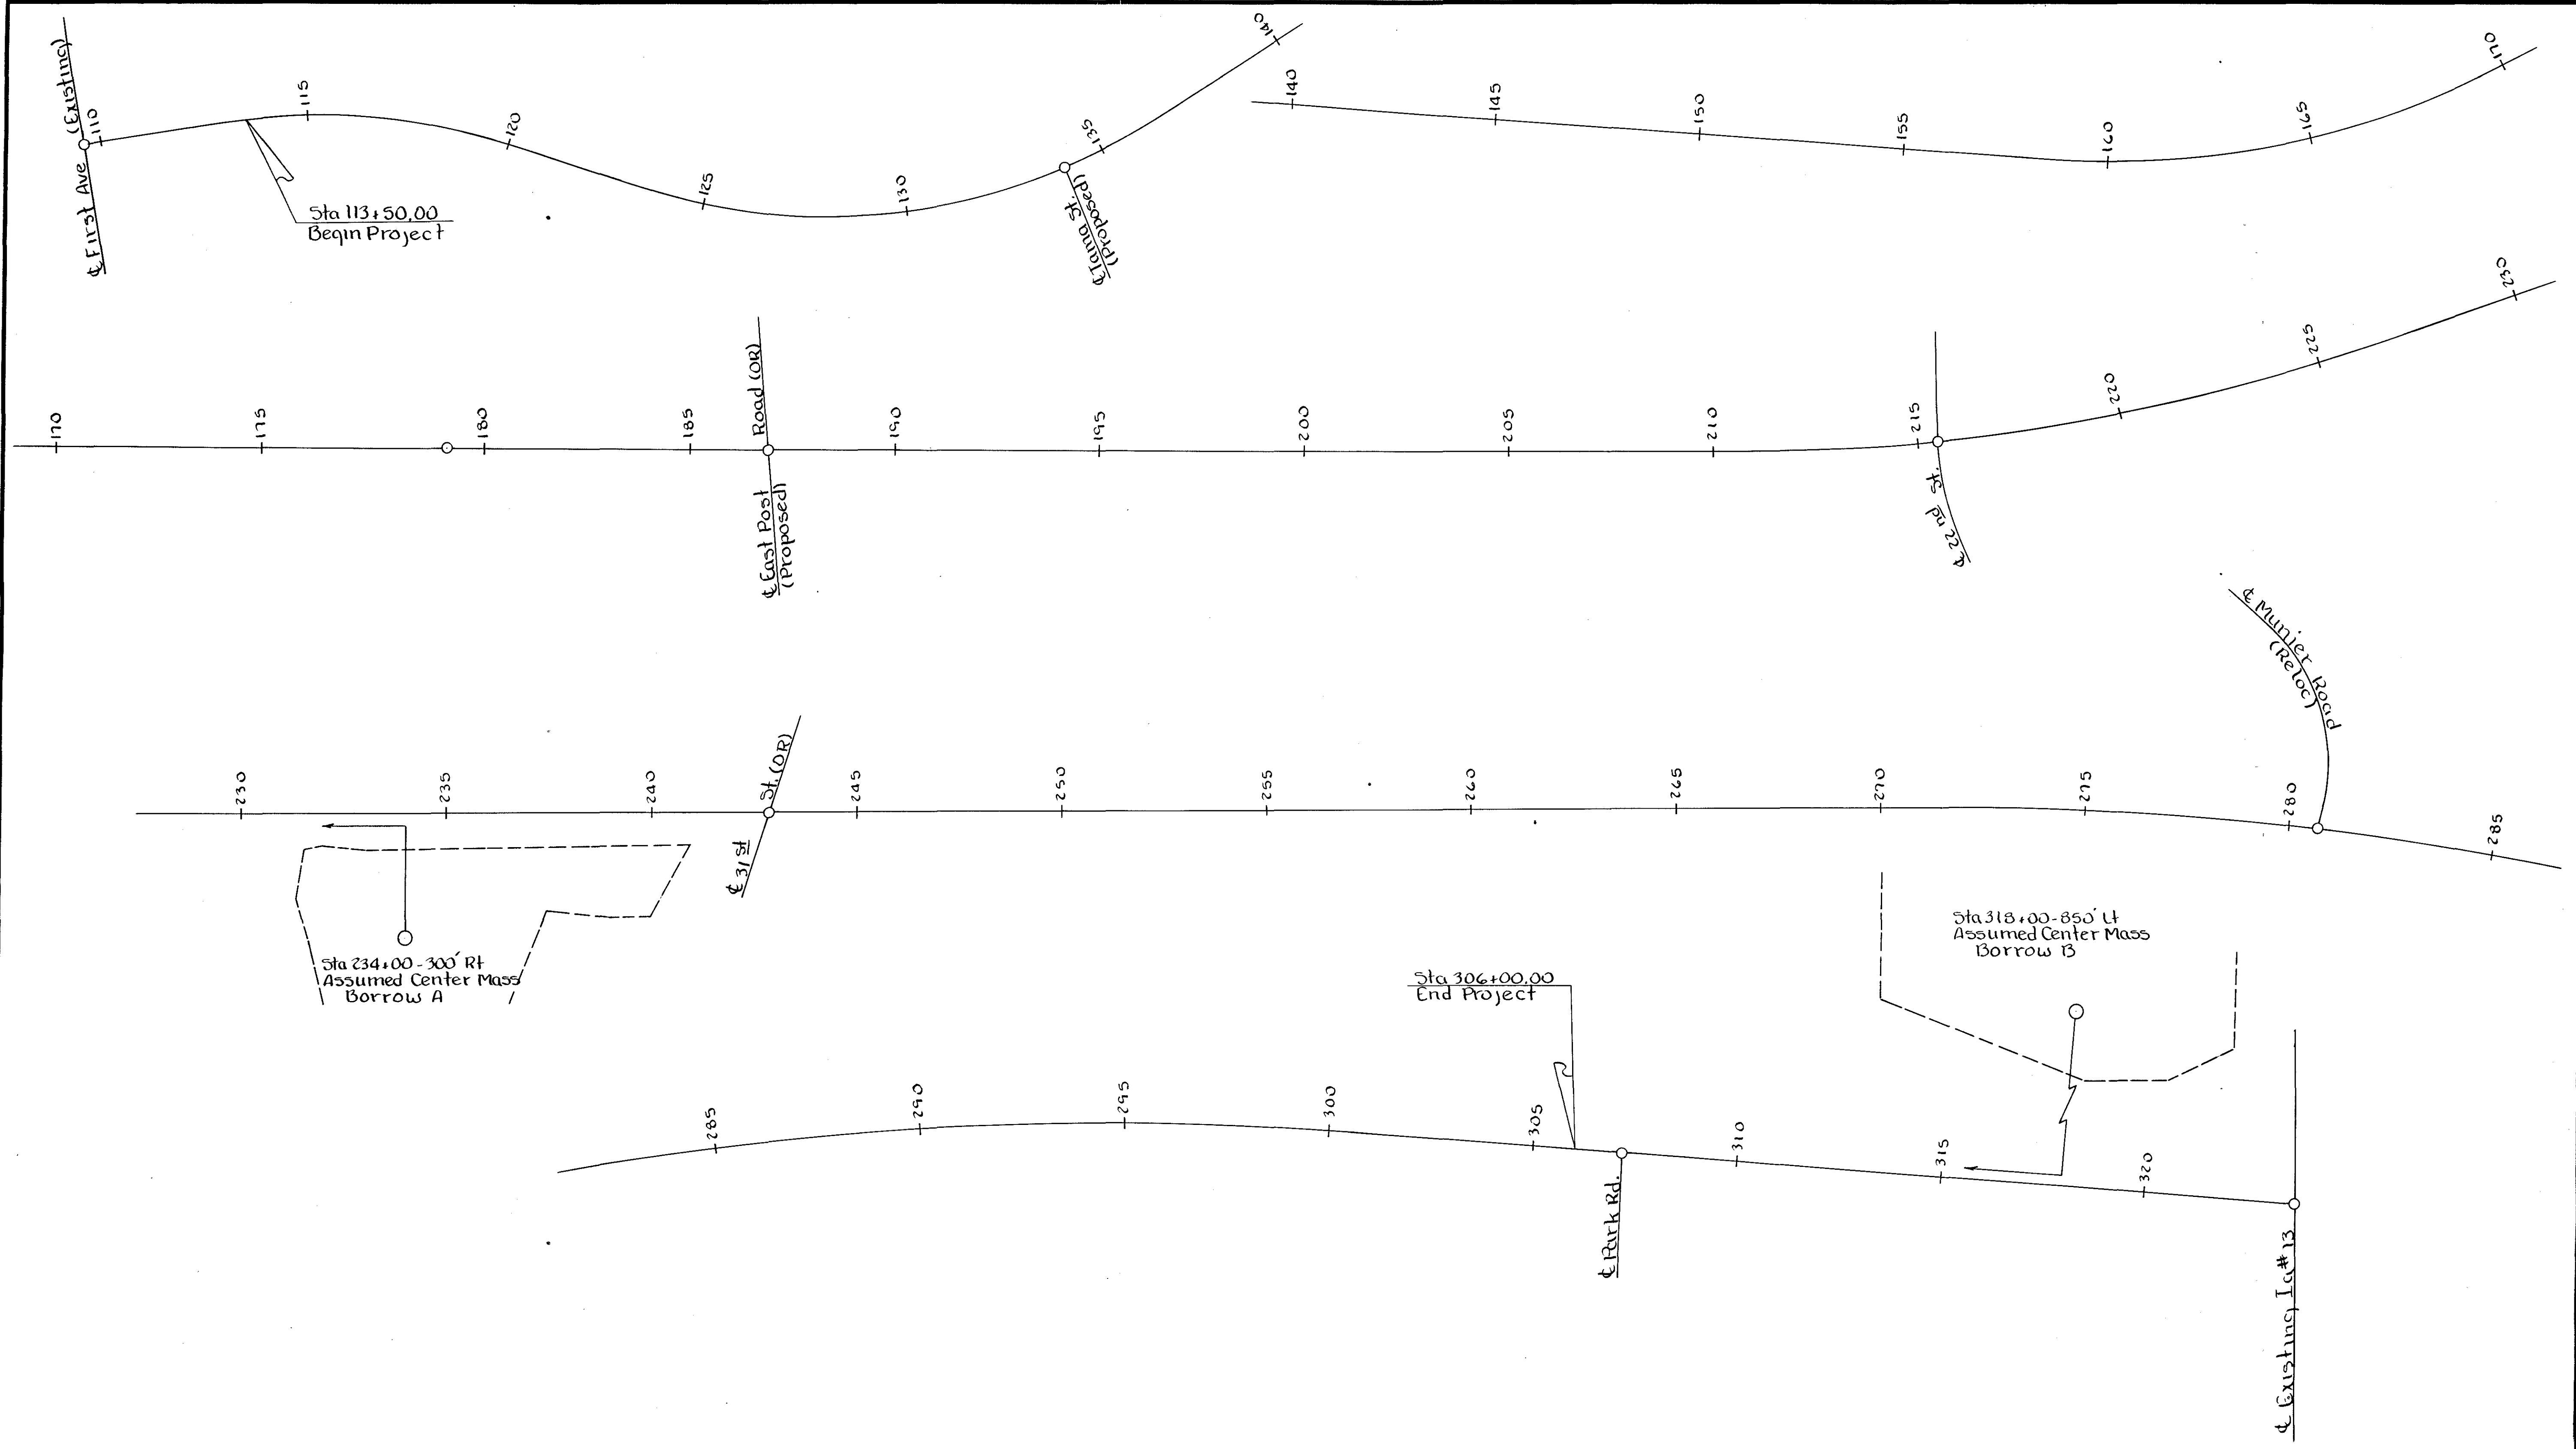

Schematic Haul Diagram
Scale 1" = 200'

P.124

07-28

01-09-90

NO OVERHAUL

NO OVERHAUL

NO OVERHAUL

107-28
01-09-90

Refer to Standard Road Plan RL-1

OVERHAUL =
27,546
Sta. Yds.

NO OVERHAUL

OVERHAUL =
855
Sta. Yds.

NO OVERHAUL


P. 124

107-28
01-09-90


Refer to Standard Road Plan RL-1

NO OVERHAUL

≥ 127

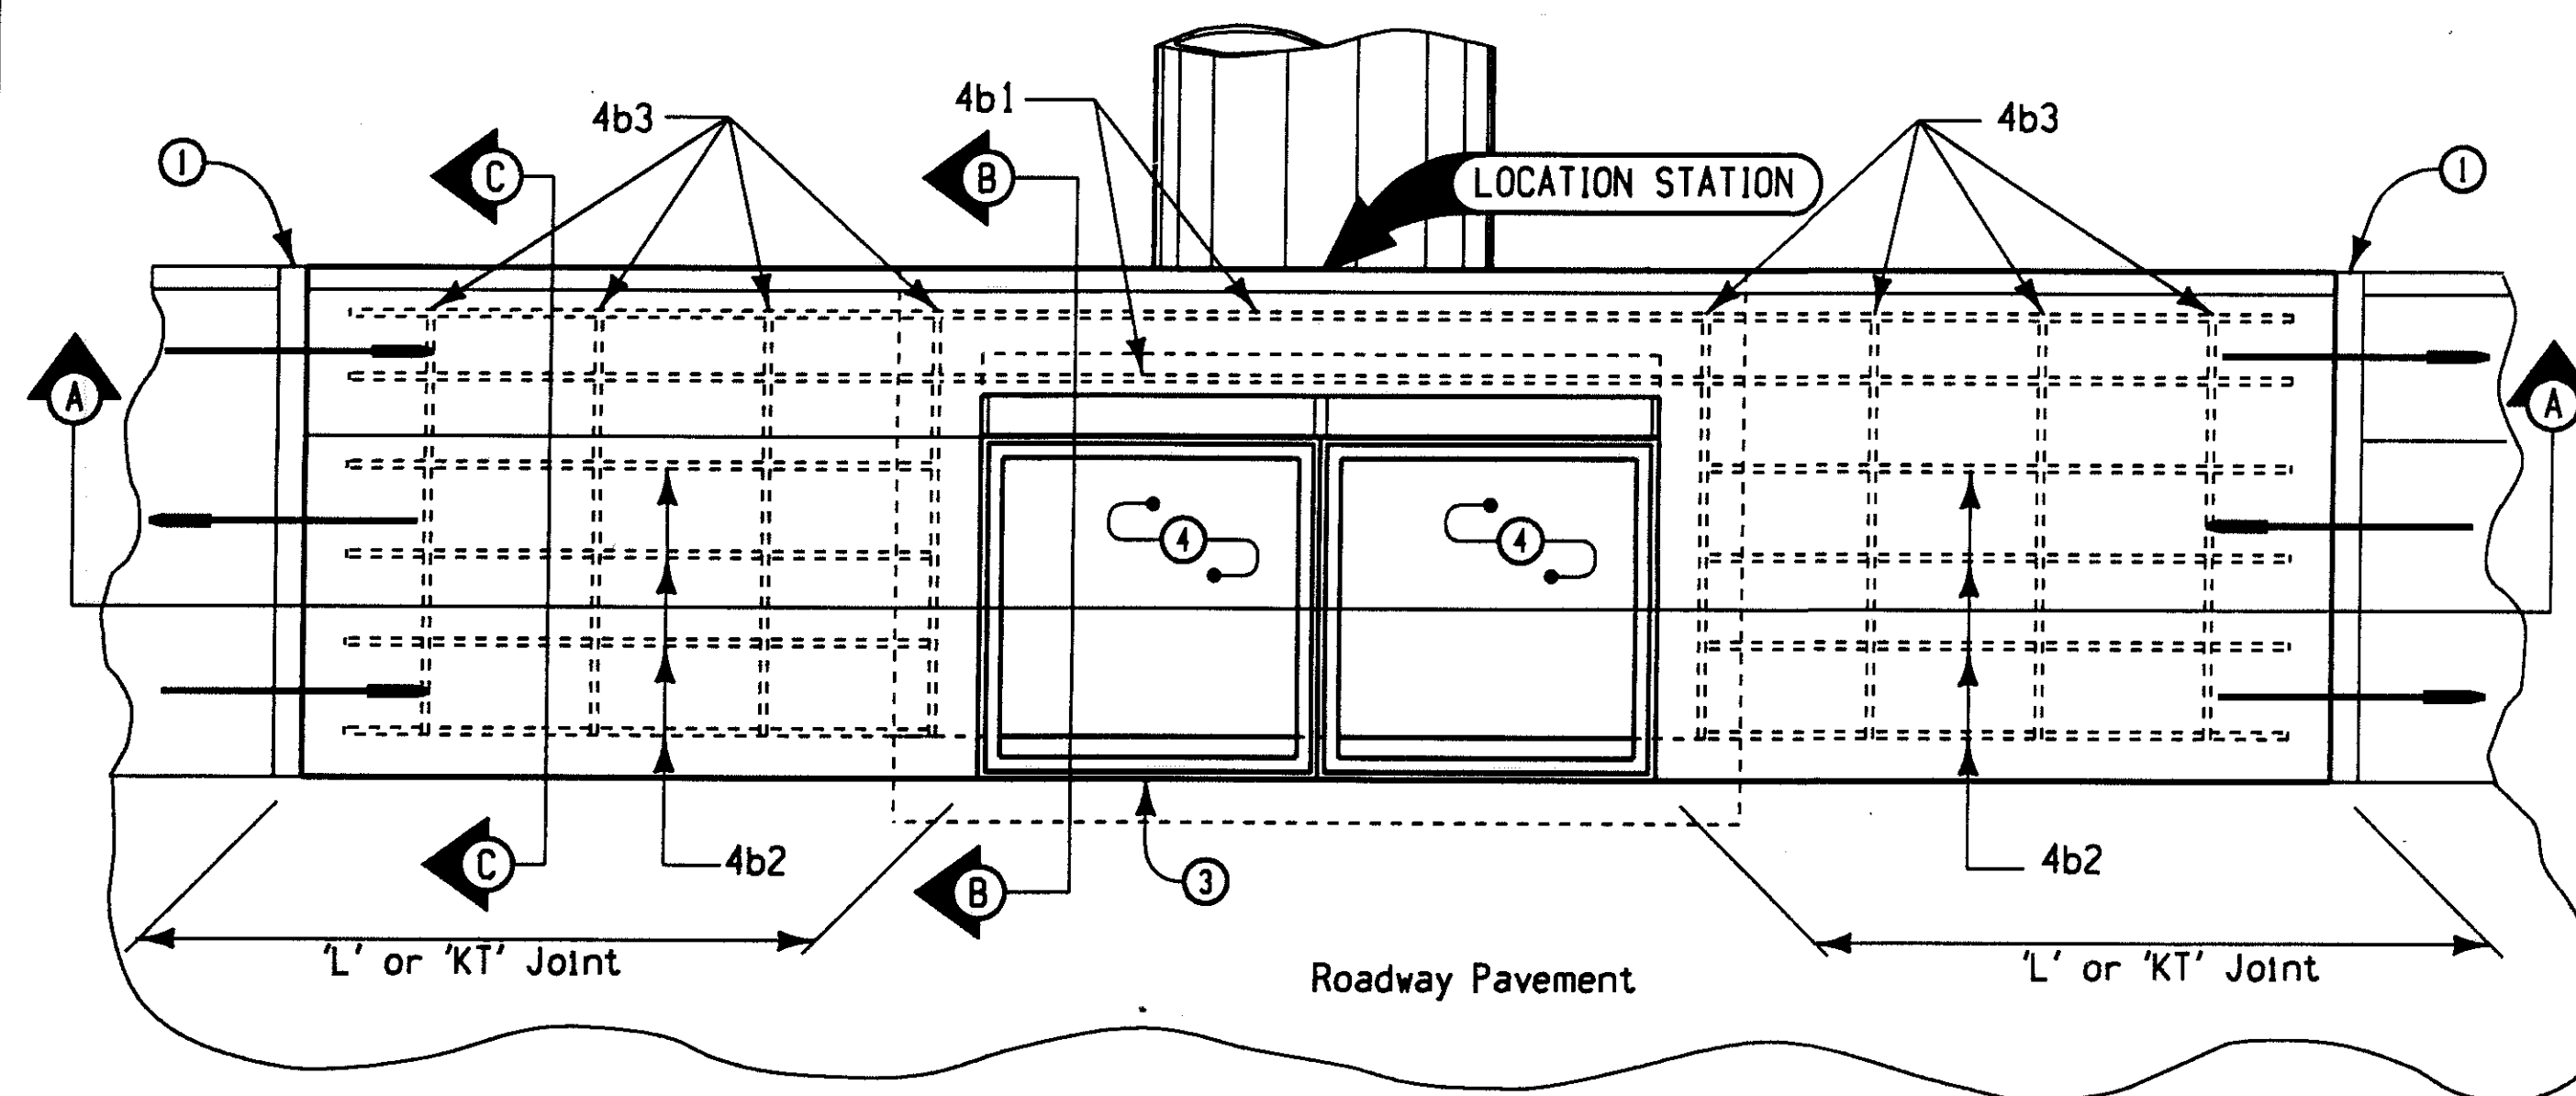


PLAN VIEW

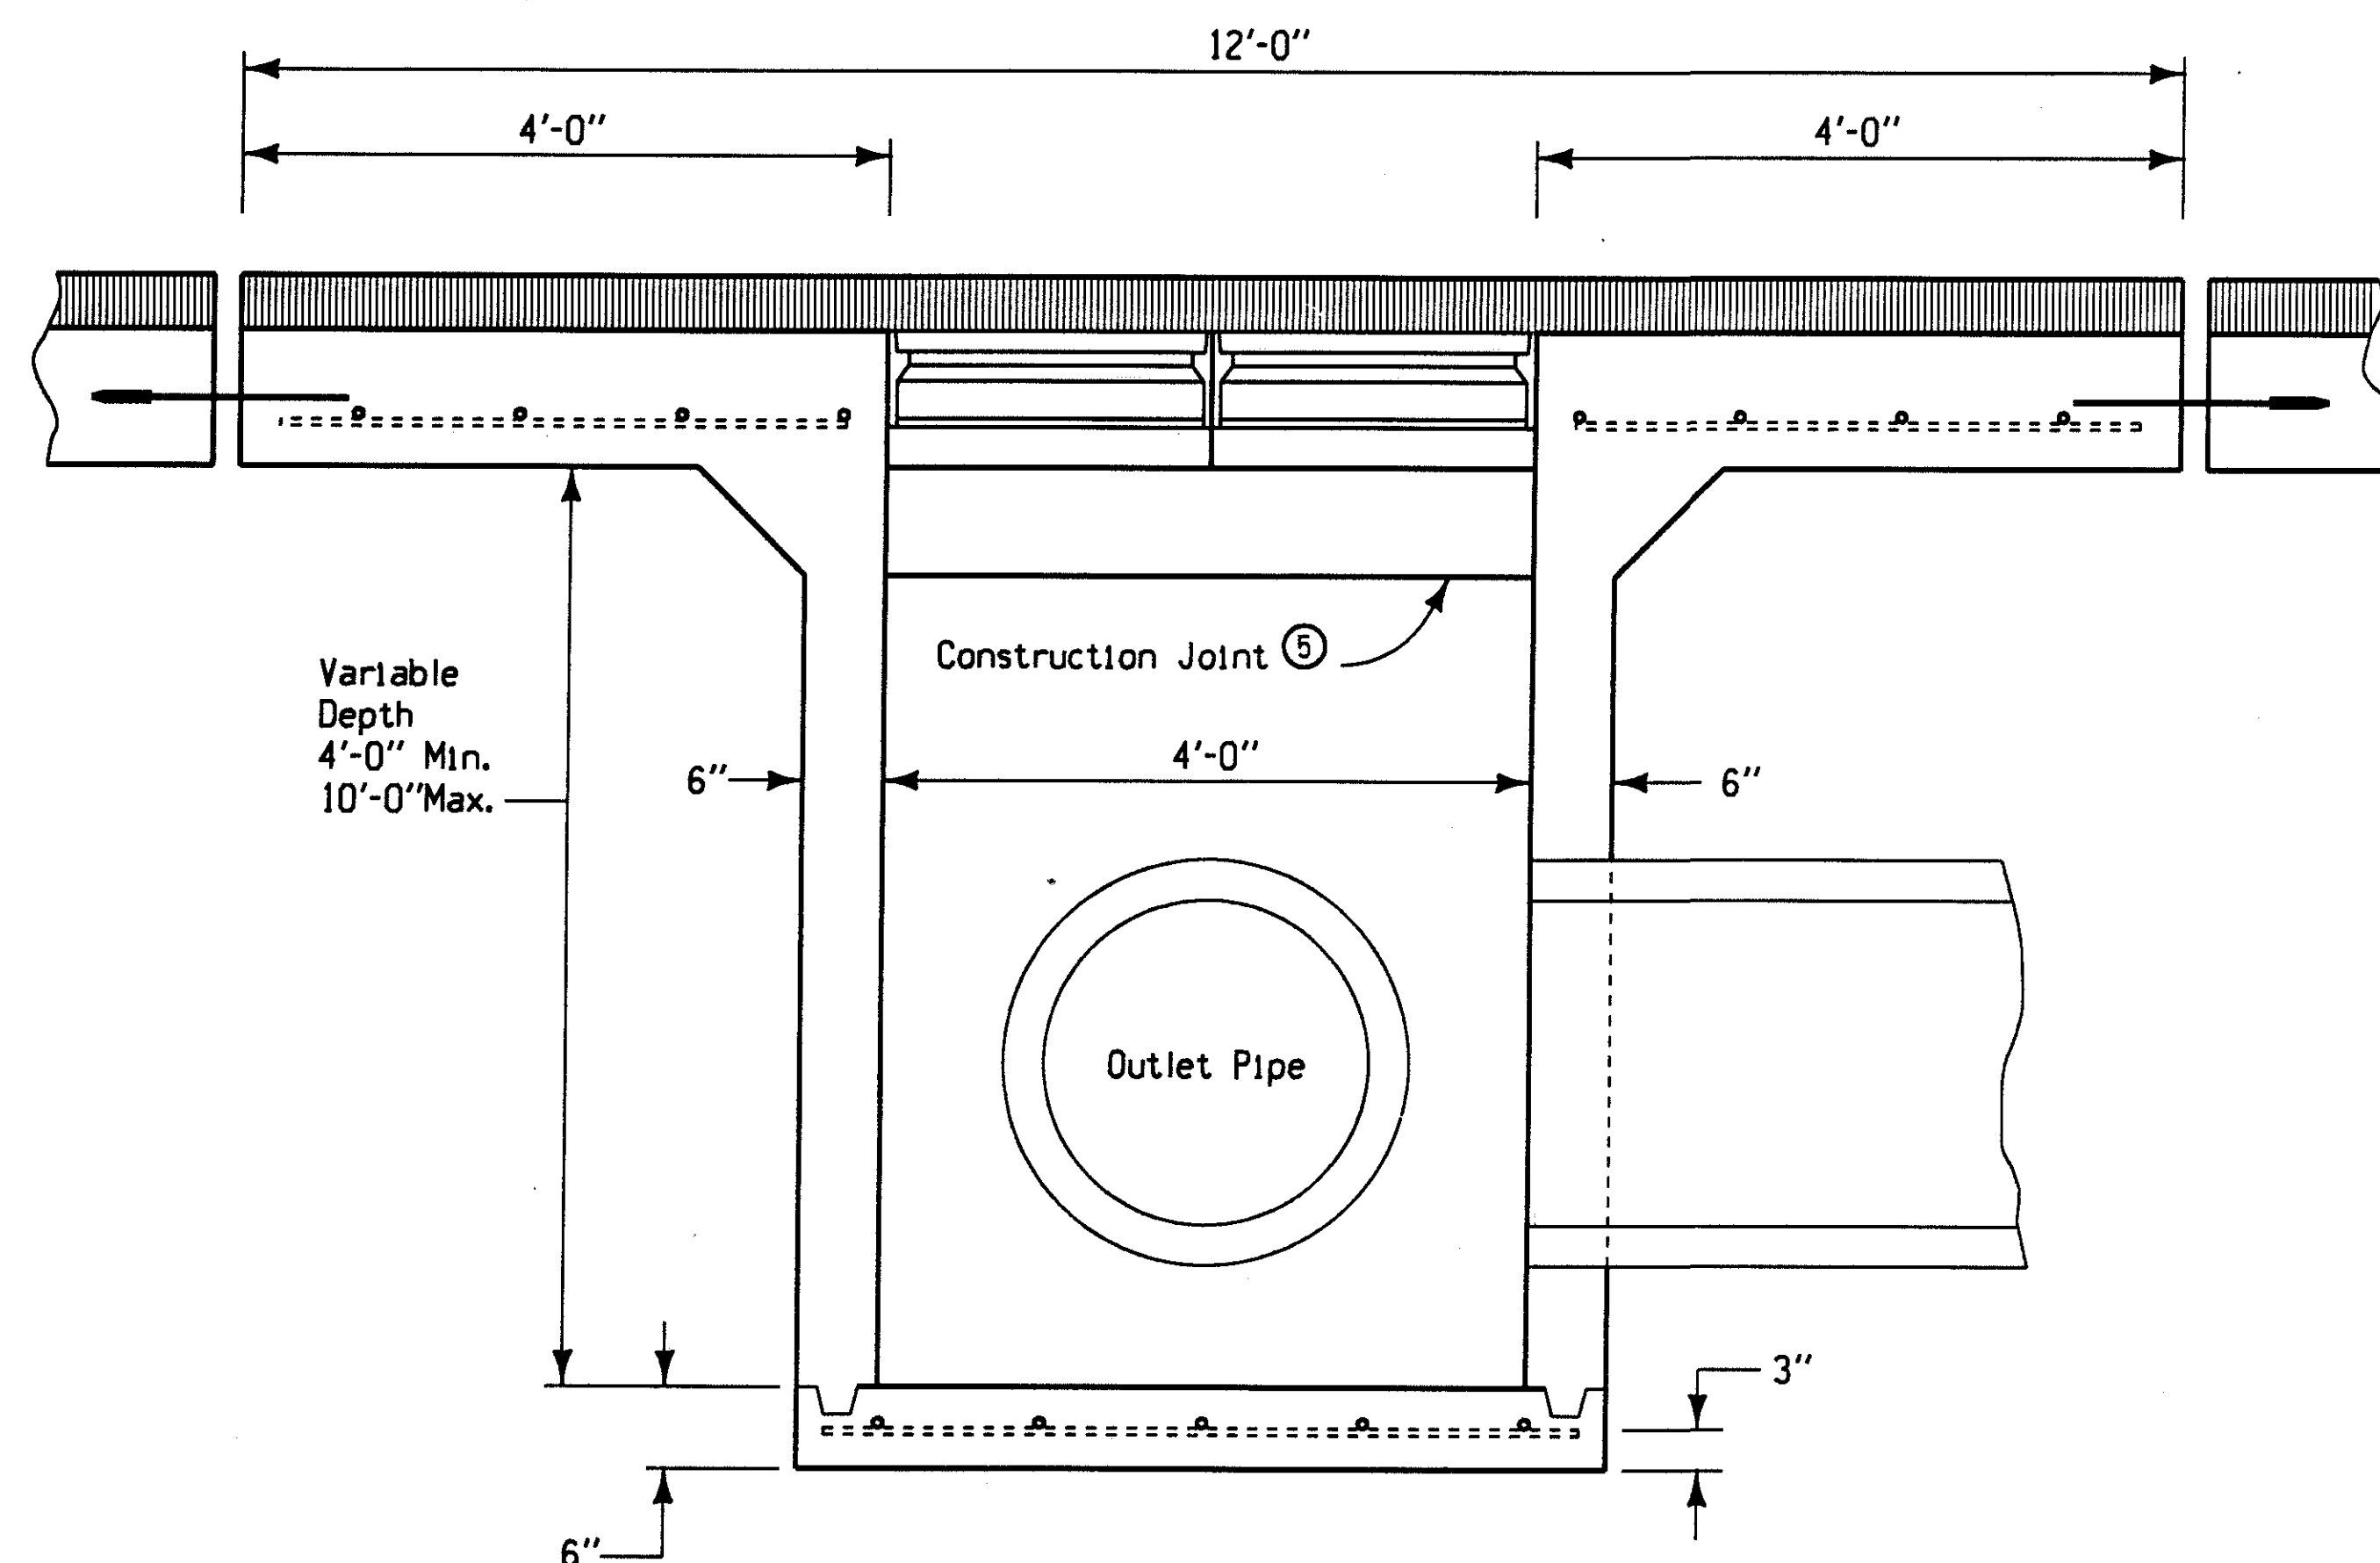


SECTION A-A

REINFORCING BAR LIST


BAR	LOCATION	SHAPE	NO.	LENGTH	LIN. FT.	WEIGHT	SPACING
4a1	Base	—	3	4'-8"	14	9.4	12"
4a2	Base	—	5	2'-11"	14.6	9.8	12"
4b1	Top	—	2	11'-6"	23	15.4	See Detail
4b2	Top	—	8	3'-6"	28	18.7	6.25"
4b3	Top	—	8	2'-6"	20	13.4	12"
Total					66.7		

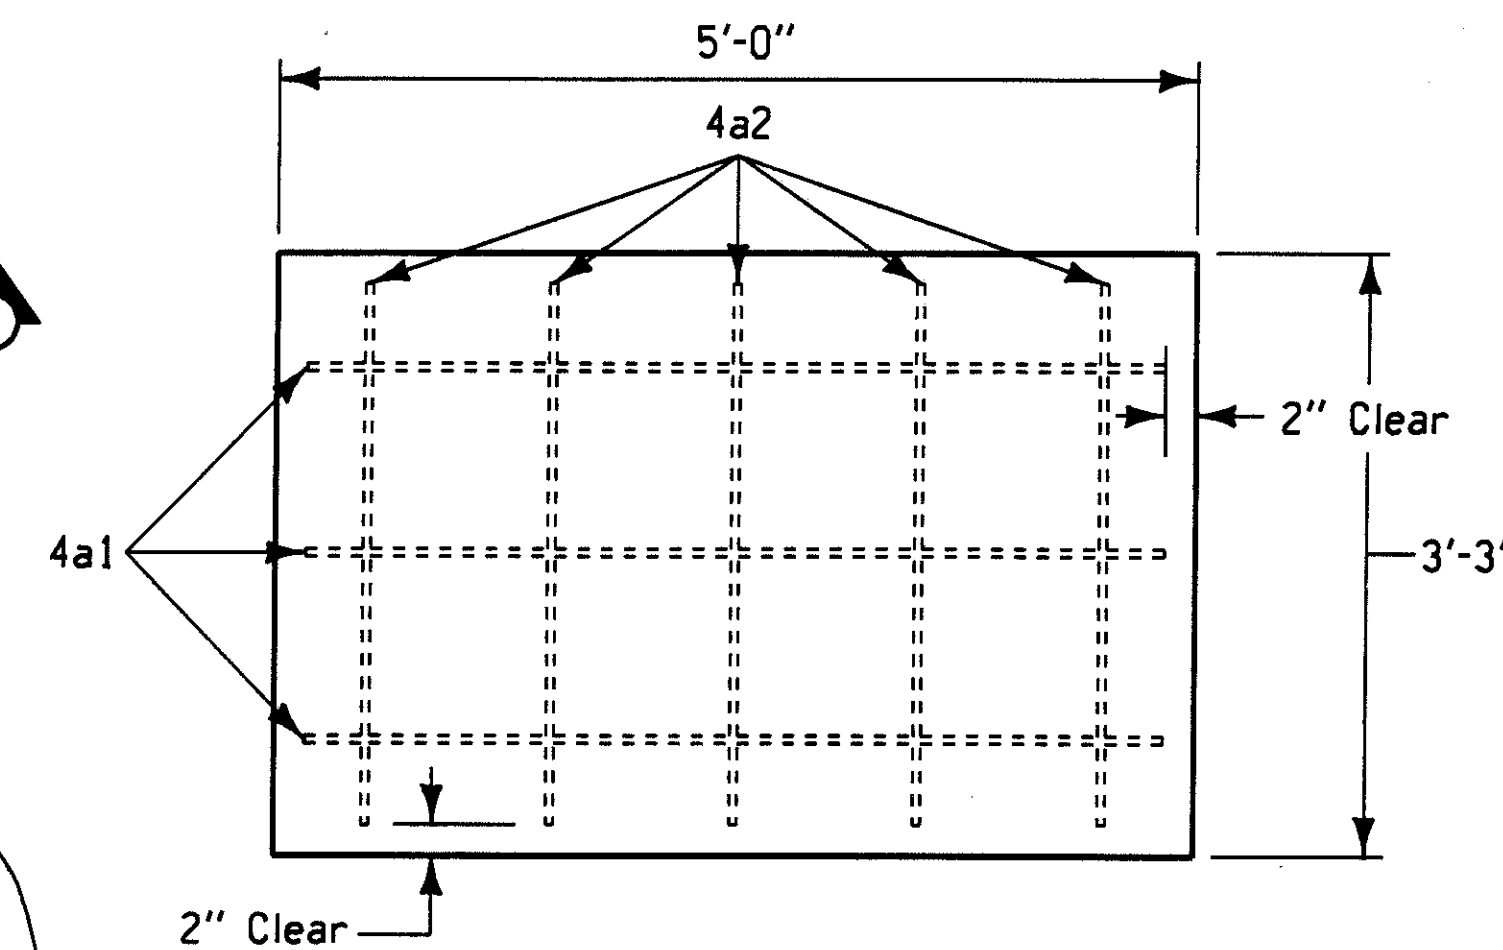

PLAN OF BASE

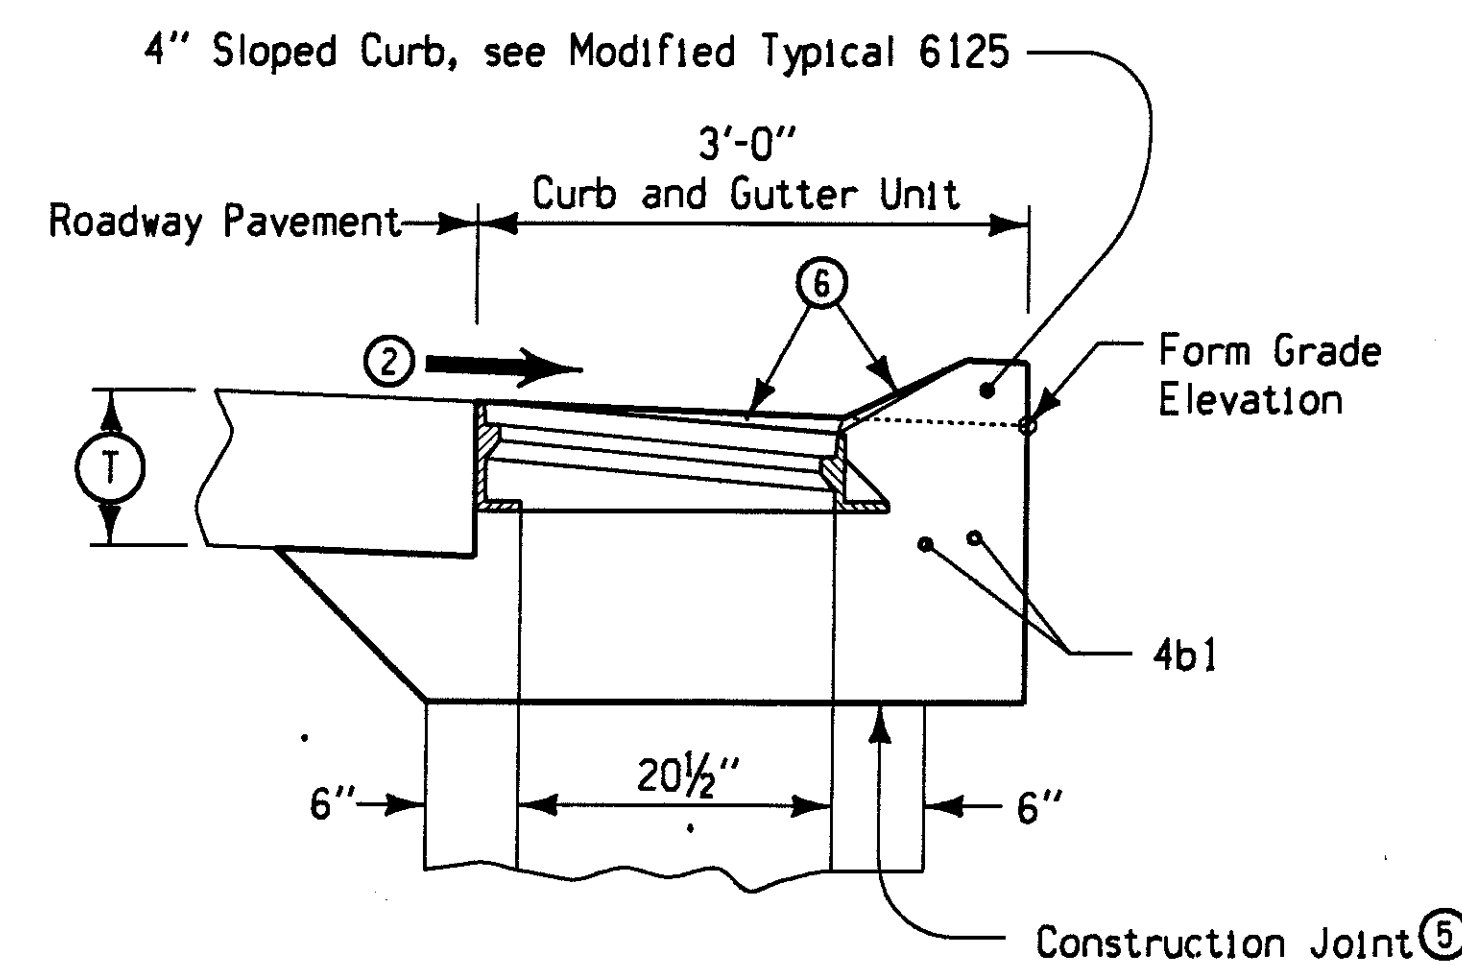

SECTION B-B

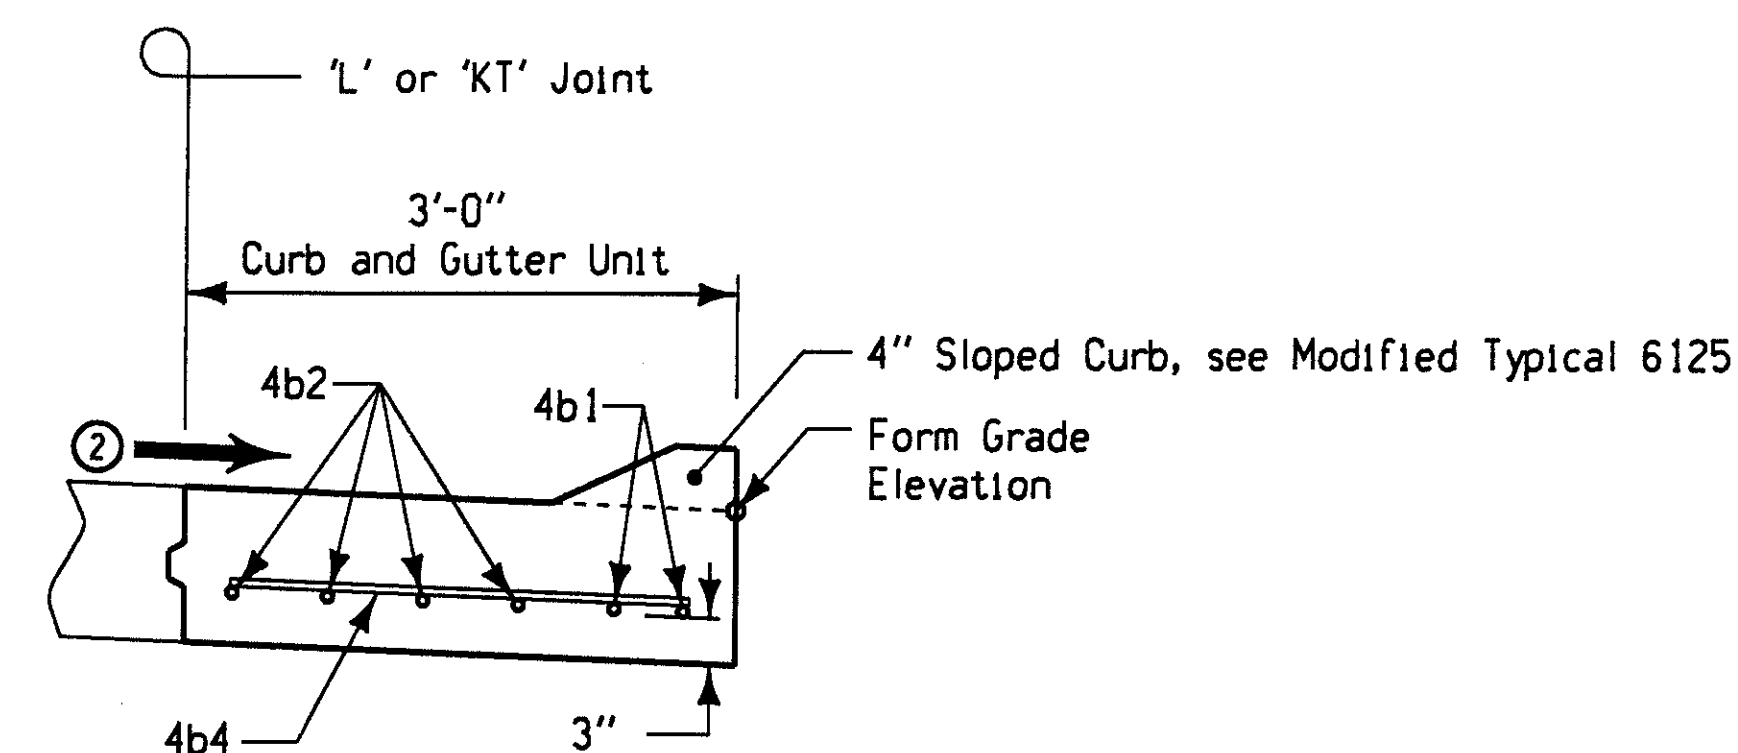

SECTION C-C

GENERAL NOTES:

This plan illustrates the details for the construction of a concrete intake for a high capacity grate to be used at the curb line of a superelevated roadway. Details shown on this sheet are typical. Alternate details may be submitted to the Engineer for his approval.

Materials and methods of construction shall be in accordance with current Standard and Supplemental Specifications.

Sidewalls shall be constructed as indicated with openings for storm sewer smoothly shaped and no pipe projecting unnecessarily beyond the inside face of the sidewall. Storm sewer pipe shall be installed before sidewall construction.

Storm sewer pipe location shown hereon is typical. Refer to detail project plans for additional data.

Joints in pavement, adjacent to intake, shall be as shown on Standard Road Plan RH-52. Any transverse pavement joints shall stop at the edge of the insert area. Joint locations shall be as indicated hereon, except where specifically modified by other drawings or by the Engineer.

Price bid for Intake Top Only, as Per Plan shall be considered full compensation for furnishing all work and materials necessary to construct the intake and insert area above the construction joint.

- ① 'EE' Joint, refer to Standard Road Plan RH-52 for details.
- ② Superelevation may vary from 3% to 8%.
- ③ See Detail Sheet of "Gutter Inlet Frame for Inlets on Superelevated Curves."
- ④ See Standard Road Plan RA-13B for details of grate.
- ⑤ Construction joint shall be a minimum of 16" below Form Grade Elevation. Install 'bond breaker.'
- ⑥ Special shaping of curb and gutter unit to ensure drainage.

MODIFIED DETAIL SHEET 500-11
INTAKE ON
SUPERELEVATED CURVE
(DOUBLE GRATE)




Unless specified otherwise as a part of project plans, the cast iron frame described hereon shall not be paid for separately but shall be included with and considered incidental to the intake where required.




MINIMUM WEIGHTS	
GRATE	90 lbs.
FRAME	130 lbs.

GUTTER INLET FRAME FOR INLETS ON SUPERELEVATED CURVES

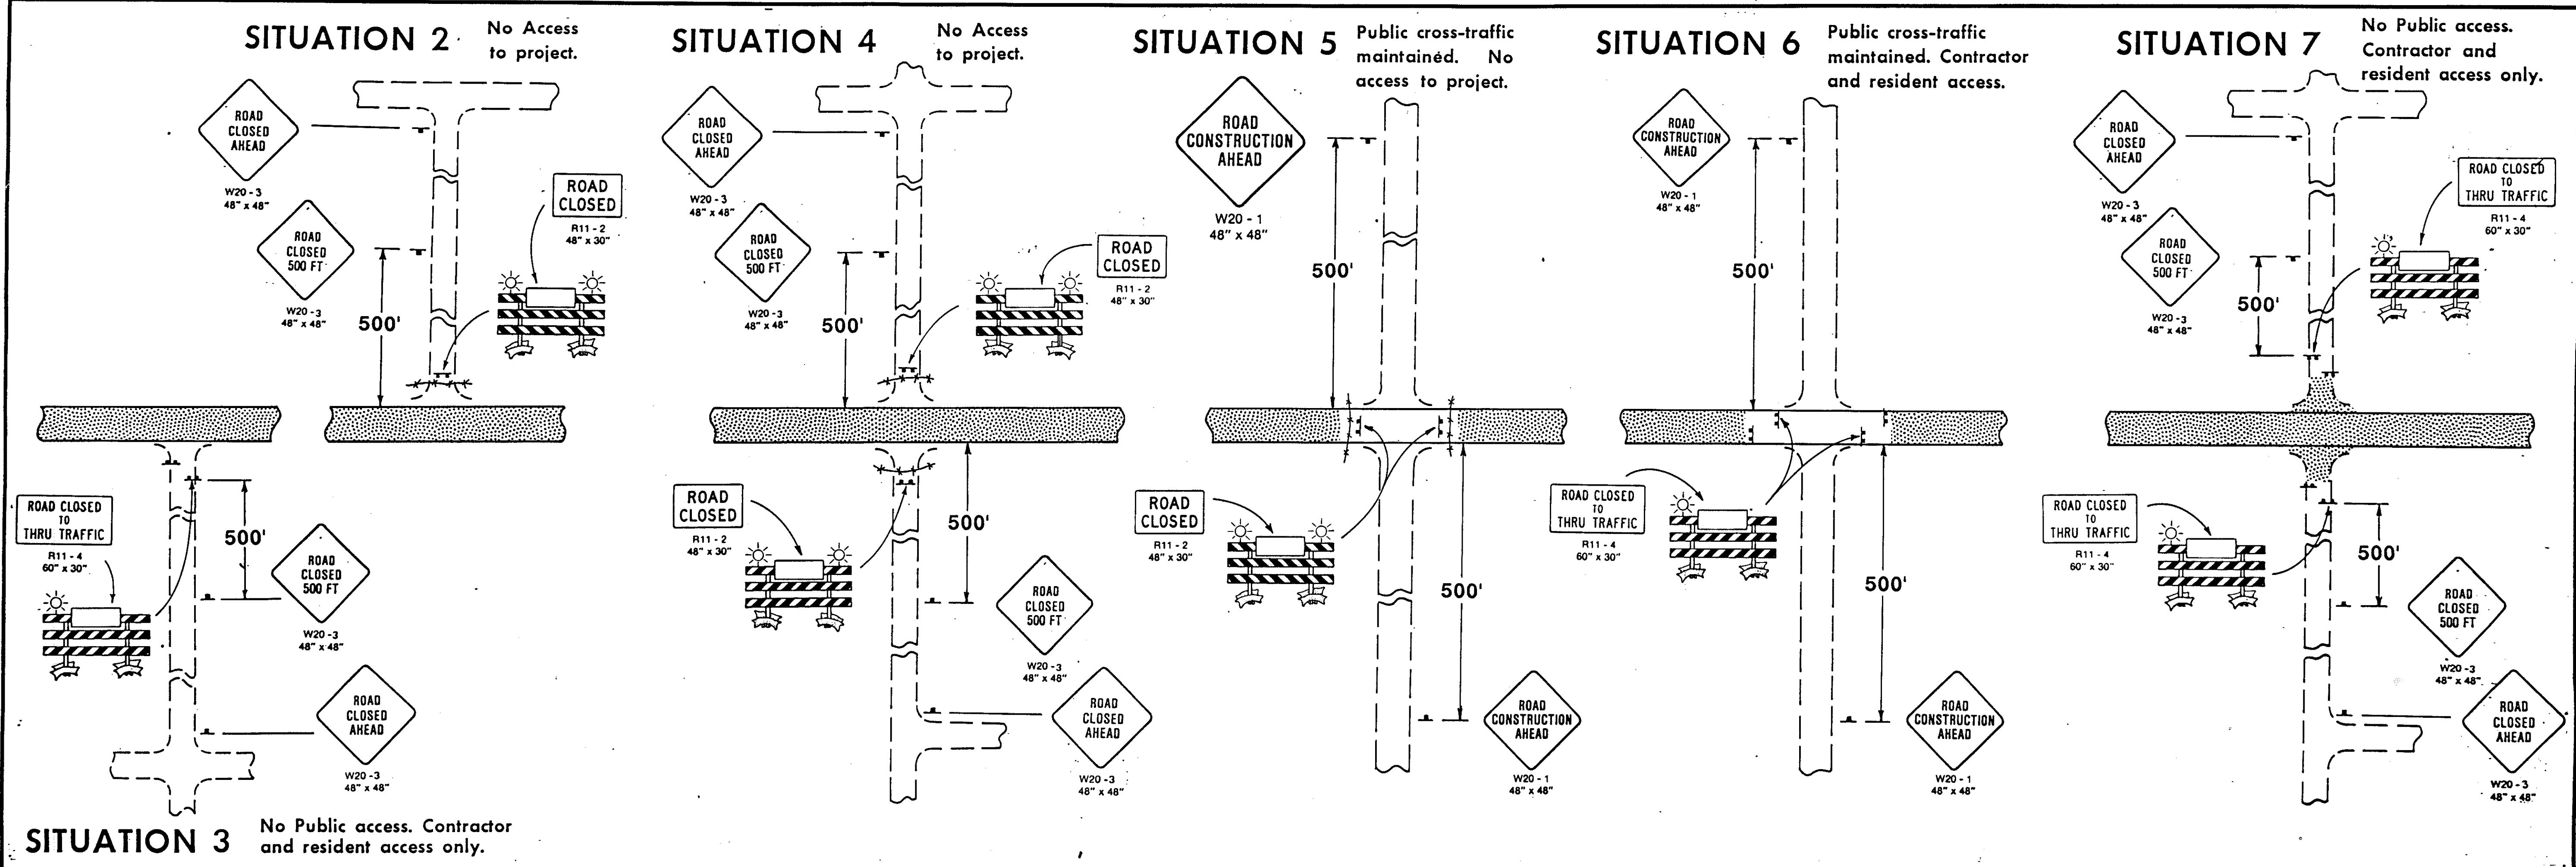

GENERAL NOTES:

- ① Situation 1 illustrates traffic control necessary to close the project route. SITUATION 2 through 7 are for signing of sideroads based on existing agreements and field conditions and will be selected by the engineer in charge of construction.
- ② Type 'A' Flashing Warning Lights shall be visible to both directions of traffic. The backside of the type III barricades shall be fully reflectorized unless there is no access permitted beyond the barricade. Strips shall be properly sloped down towards the traffic side.
- ③ All "Stop" and other regulatory signs on the sideroads are not to be disturbed. If a "Stop" or other regulatory sign must be removed, it will be relocated by the Contracting Authority.
- ④ This layout does not include safety closures as may be required by Section 2518 of the Standard Specifications.
- ⑤ In Situation 1, when distance "A" is less than 500 feet, the barricade should be placed in the middle of the traffic lane approaching the work area. In this case, Note 2 shall apply. The barricade may be omitted if the distance to the work area is less than 250 feet.
- ⑥ In Situation 1, if the intersection is the point of detour these two signs and barricade will become the responsibility of the contracting authority and may be modified by the contracting authority to fit detour signing.

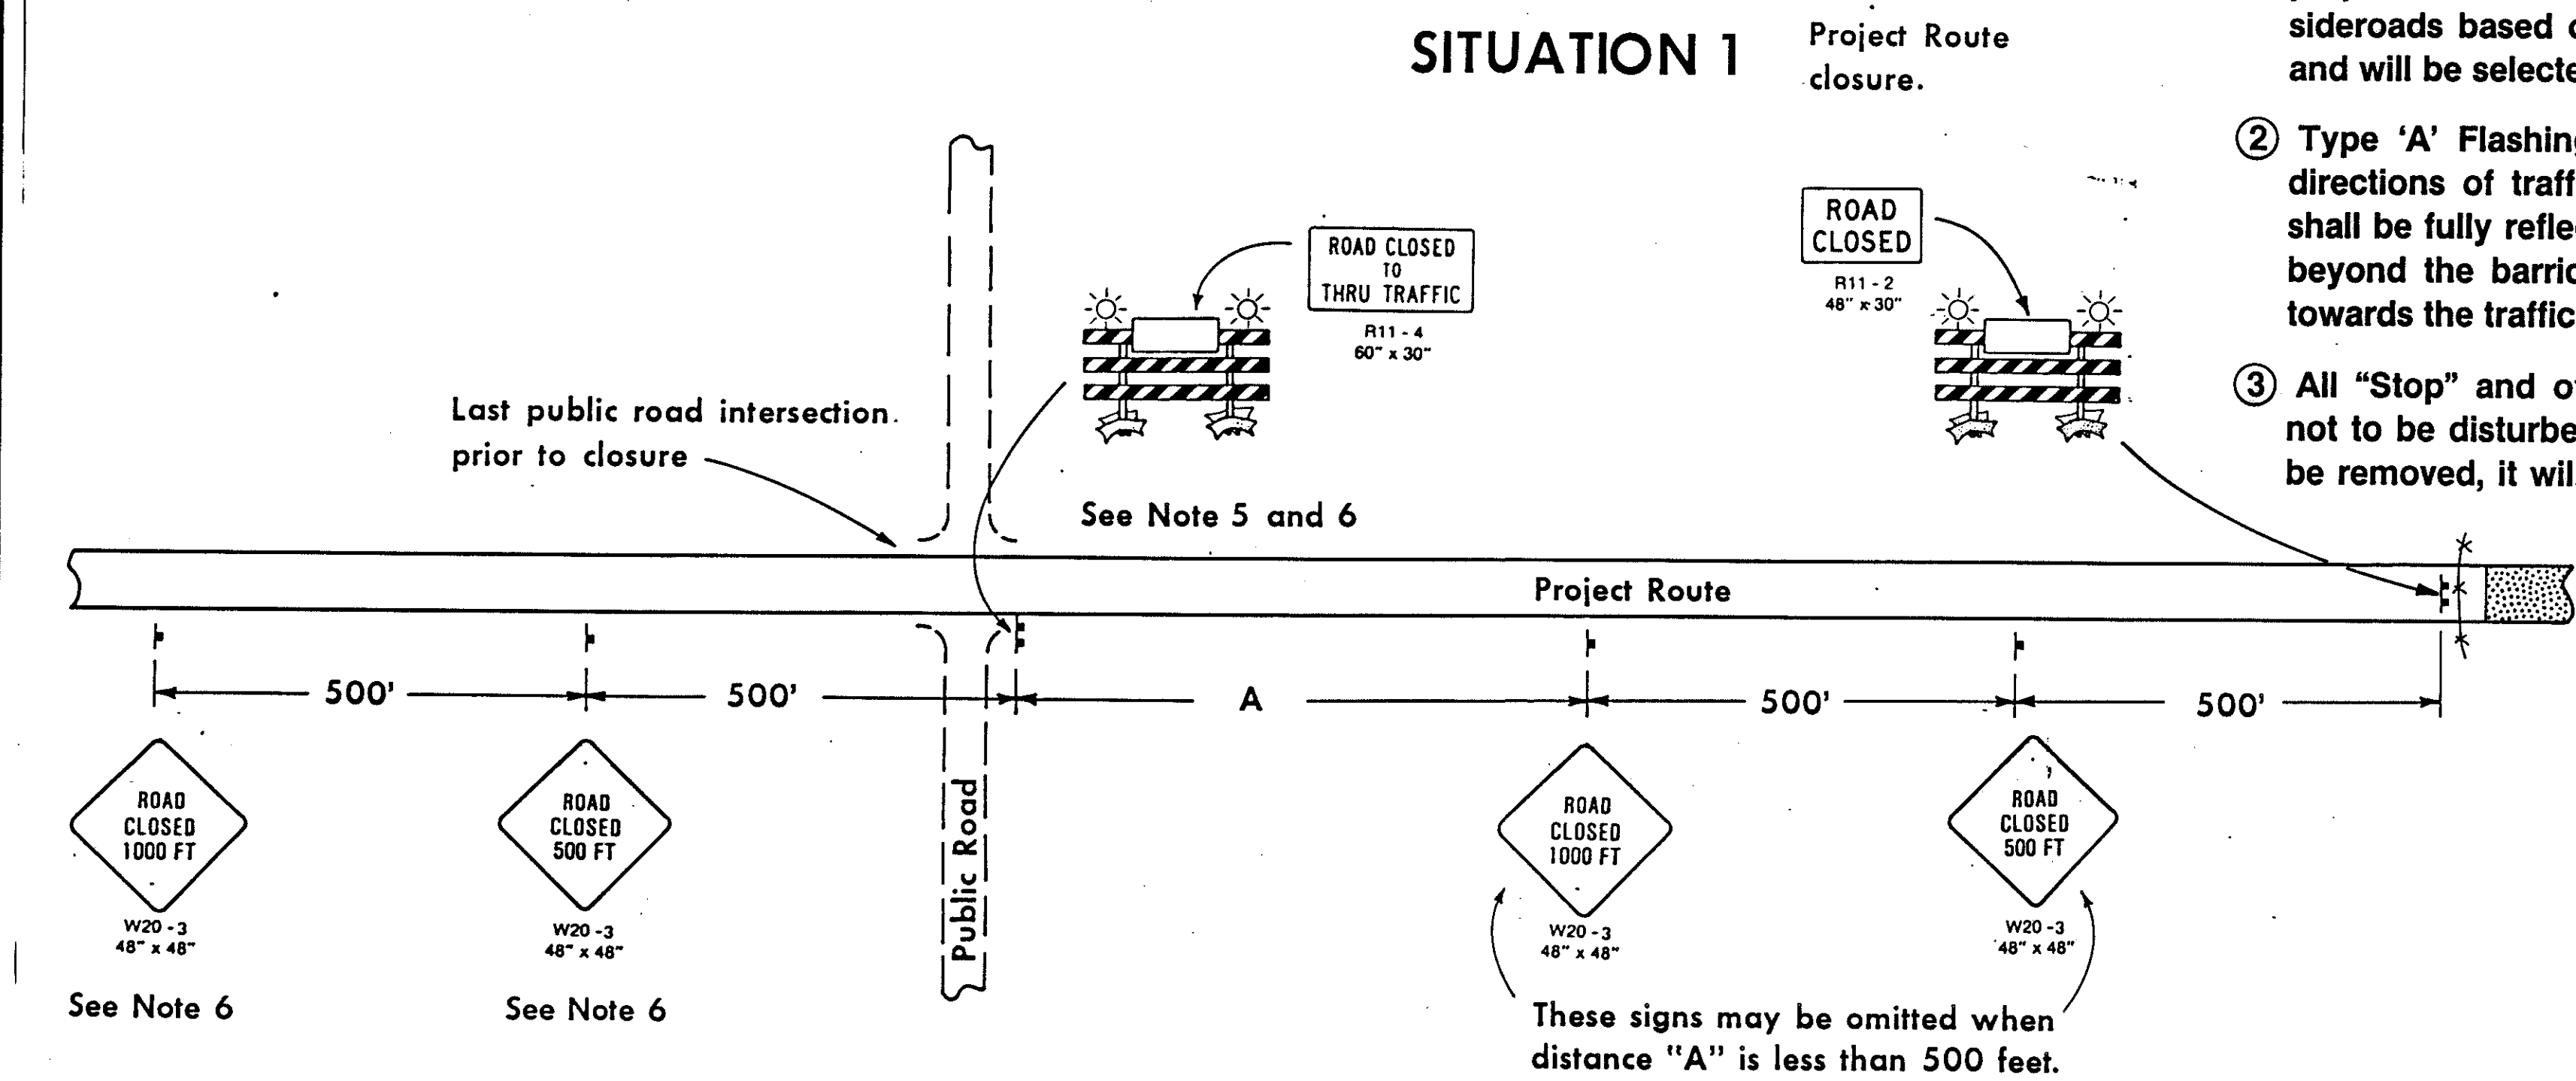

LEGEND

- Traffic Sign
- Type III Barricade (Type "A" Low Intensity Flashing Warning Light Required for Nighttime Use)
- Type "A" Low Intensity Flashing Warning Light
- Work Area
- Slat Fence Barricade or Orange Plastic Safety Fence


Iowa Department of Transportation
Highway Division

DETAIL SHEET 520-26

SIGNING FOR TEMPORARY ROAD CLOSURES IN RURAL AREAS (PROJECT ROUTE CLOSED TO TRAFFIC)

REVISION: Revise note 4, Change barricades to safety closure.

7/30
du

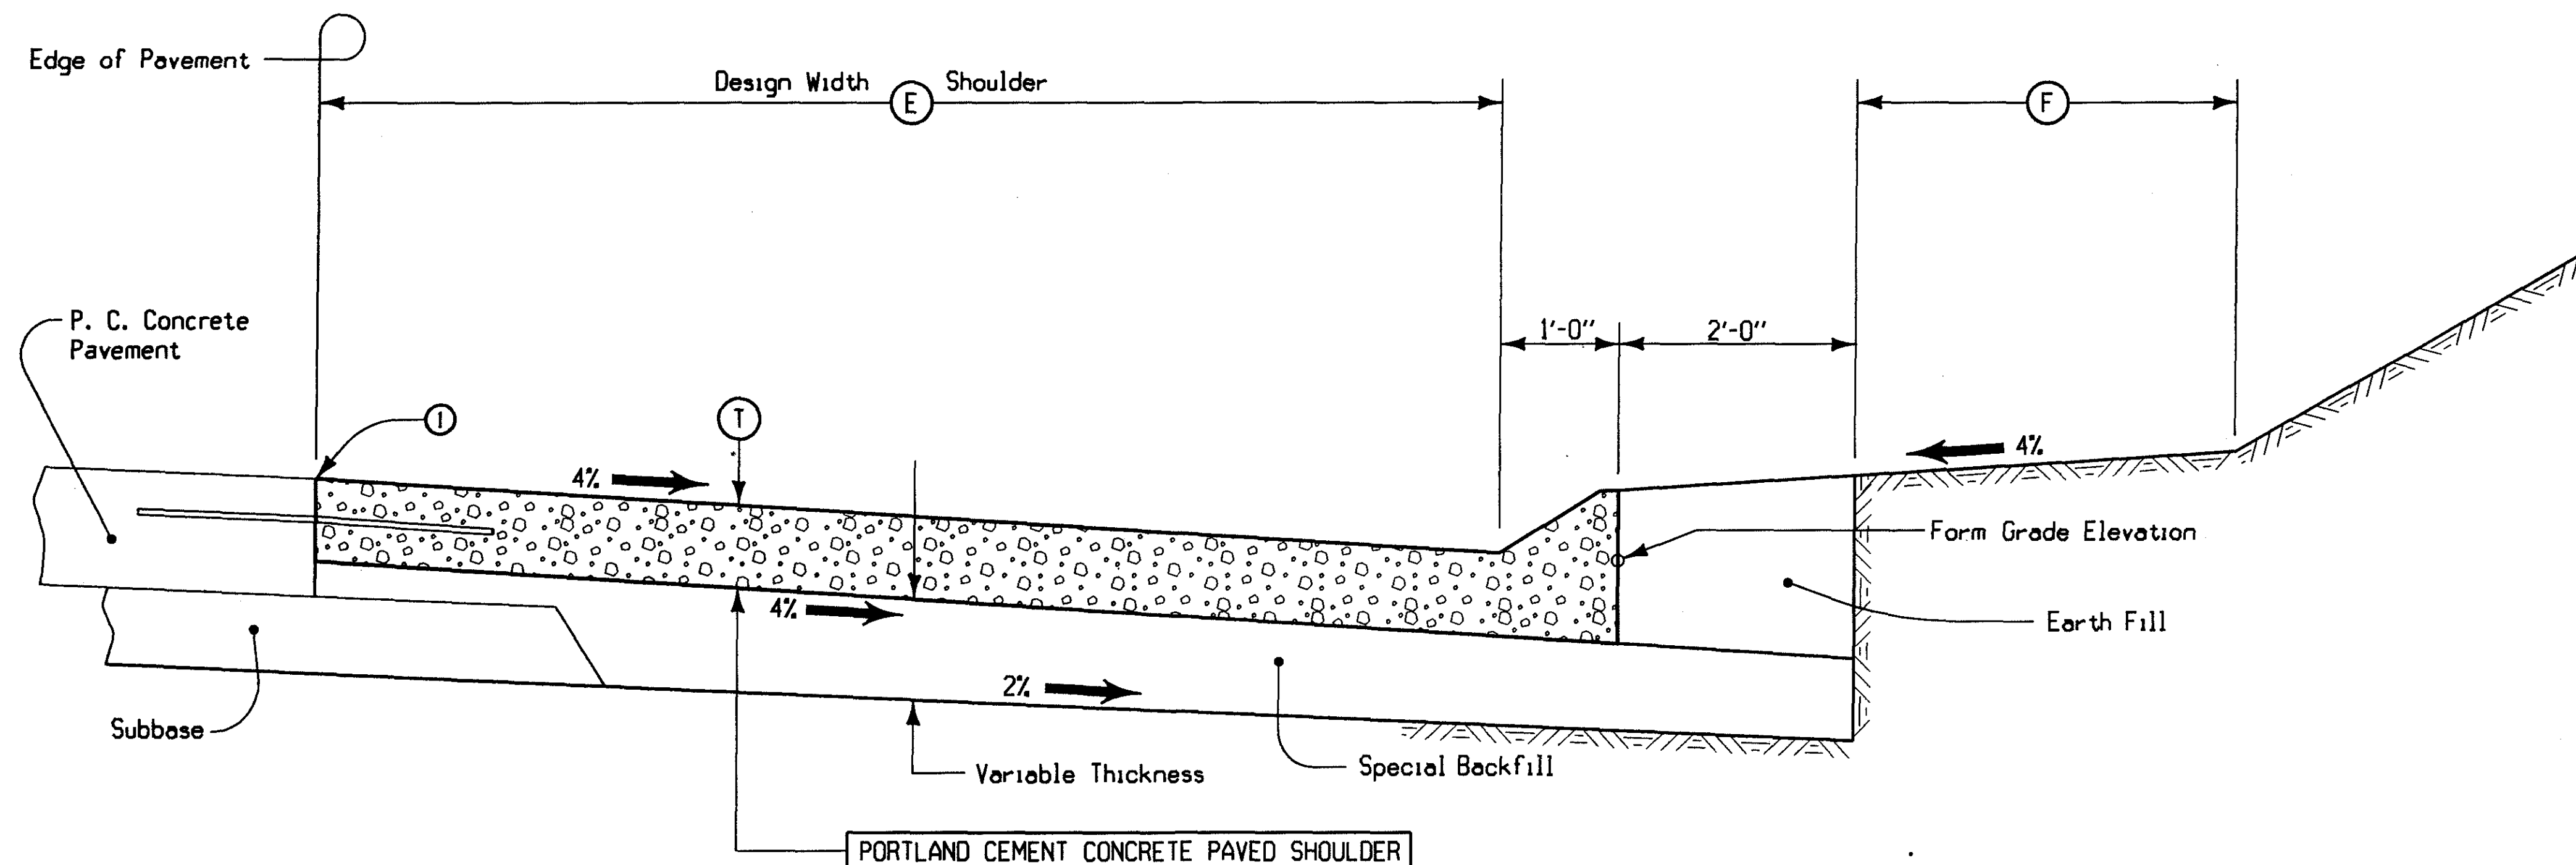

TYPICAL SECTION
P.C. CONCRETE PAVED SHOULDER

DESIGN QUANTITY TABLE ②										
	E = 4'		E = 6'		E = 8'		E = 8.5'		E = 10'	
①	Area Sq. Yds.	Volume Cu. Yds.	Area Sq. Yds.	Volume Cu. Yds.	Area Sq. Yds.	Volume Cu. Yds.	Area Sq. Yds.	Volume Cu. Yds.	Area Sq. Yds.	Volume Cu. Yds.
7.0"	55.56	11.853	77.78	16.174	100.00	20.495	105.56	21.575	122.22	24.816
7.5"	55.56	12.626	77.78	17.255	100.00	21.885	105.56	23.042	122.22	26.514
8.0"	55.56	13.398	77.78	18.336	100.00	23.275	105.56	24.509	122.22	28.213
8.5"	55.56	14.168	77.78	19.415	100.00	24.661	105.56	25.973	122.22	29.908
9.0"	55.56	14.940	77.78	20.496	100.00	26.051	105.56	27.440	122.22	31.607
9.5"	55.56	15.713	77.78	21.577	100.00	27.442	105.56	28.908	122.22	33.306
10.0"	55.56	16.483	77.78	22.656	100.00	28.828	105.56	30.371	122.22	35.001
10.5"	55.56	17.255	77.78	23.737	100.00	30.218	105.56	31.839	122.22	36.700
11.0"	55.56	18.027	77.78	24.818	100.00	31.608	105.56	33.306	122.22	38.398
11.5"	55.56	18.798	77.78	25.896	100.00	32.995	105.56	34.769	122.22	40.093
12.0"	55.56	19.570	77.78	26.977	100.00	34.385	105.56	36.237	122.22	41.792

GENERAL NOTES:

Details indicated hereon illustrate the general requirements for construction of a paved shoulder consisting of PCC Base except all joints shall be sealed as specified for "Portland Cement Concrete Pavement" in the current Standard Specifications. Unless otherwise specified, Class A Concrete shall be used.

Materials and methods of construction shall be in accordance with current Standard and Supplemental Specifications.

Slopes, dimensions, and quantities indicated hereon are for a normal section as shown and are for design purposes. Shoulder construction details may be modified through superelevated curves or other areas specifically designated by the Engineer. Refer to Typical Cross Sections and Standard Road Plans for superelevation.

Any special shaping of subgrade necessary, prior to construction of paved shoulders, shall be accomplished as directed by the Engineer. Any material removed due to this special shaping shall be disposed of at the direction of the Engineer.

The subgrade beneath Paved Shoulders shall be constructed in conformance with specifications for Natural Subgrade. "Special Backfill" material shall be paid for as specified in Article 2102.14, Paragraph D. Payment shall be based on a nominal 6 inch thickness. The thickness may be exceeded at the Contractor's option. However the contractor will not be compensated for any additional material.

For roughness pattern details see Standard Road Plan RH-41D.

The price bid for "Portland Cement Concrete Paved Shoulder" thickness as specified, in sq. yds. and "Special Backfill" in tons, shall be considered full compensation for the construction of shoulder as detailed hereon. Roughness pattern, joint construction, special shaping and earth fill shall be considered incidental to the price bid for "Portland Cement Concrete Paved Shoulder."

- ① "L-2", "KT-2" or modified "BT-3" Joint. Modified "BT-3" requires a keyway. Contractor option to pour either the tongue or groove of the keyway with the mainline pavement. Refer to Standard Road Plan RH-51.
- ② Quantities indicated are for design purposes and may be adjusted at time of construction if so directed by the engineer. Quantities listed are for one shoulder per station including the curb.

		Iowa Department of Transportation		
		Highway Division		
REVISION: Change Special Backfill "square yards" to "tons"	NO.	DATE	DETAIL SHEET	
	5	06-07-94		
				535-1
PAVED SHOULDER WITH 6 INCH SLOPED CURB (PORTLAND CEMENT CONCRETE)				

OFFICE OF DESIGN • CADD • PRODUCED

STATE OF IOWA

FHWA REGION 7

FISCAL YEAR

Linn COUNTY



PROJECT NUMBER

NHS-100-1(23)-19-57




SHEET NUMBER

U.04

TYPICAL
CONCRETE BARRIER RAIL
TAPER SECTION

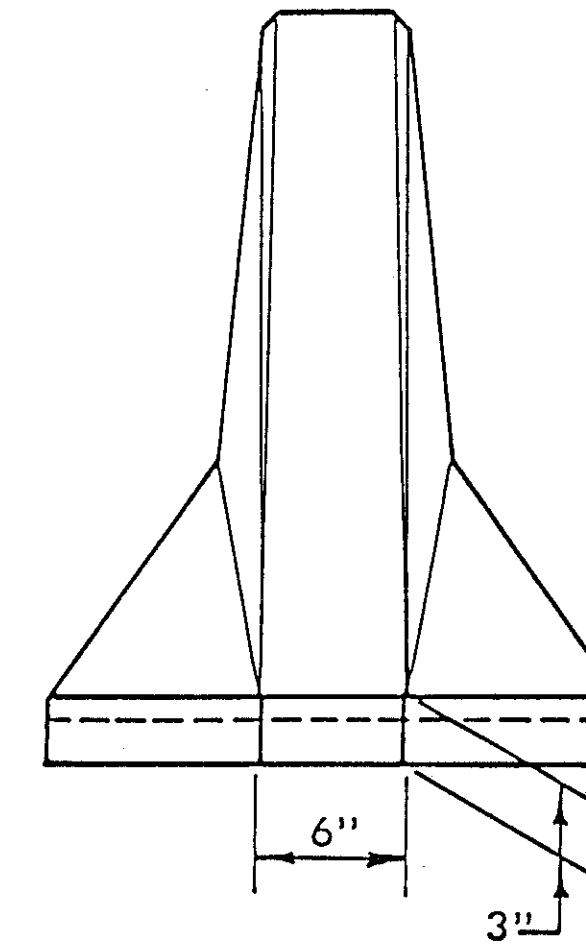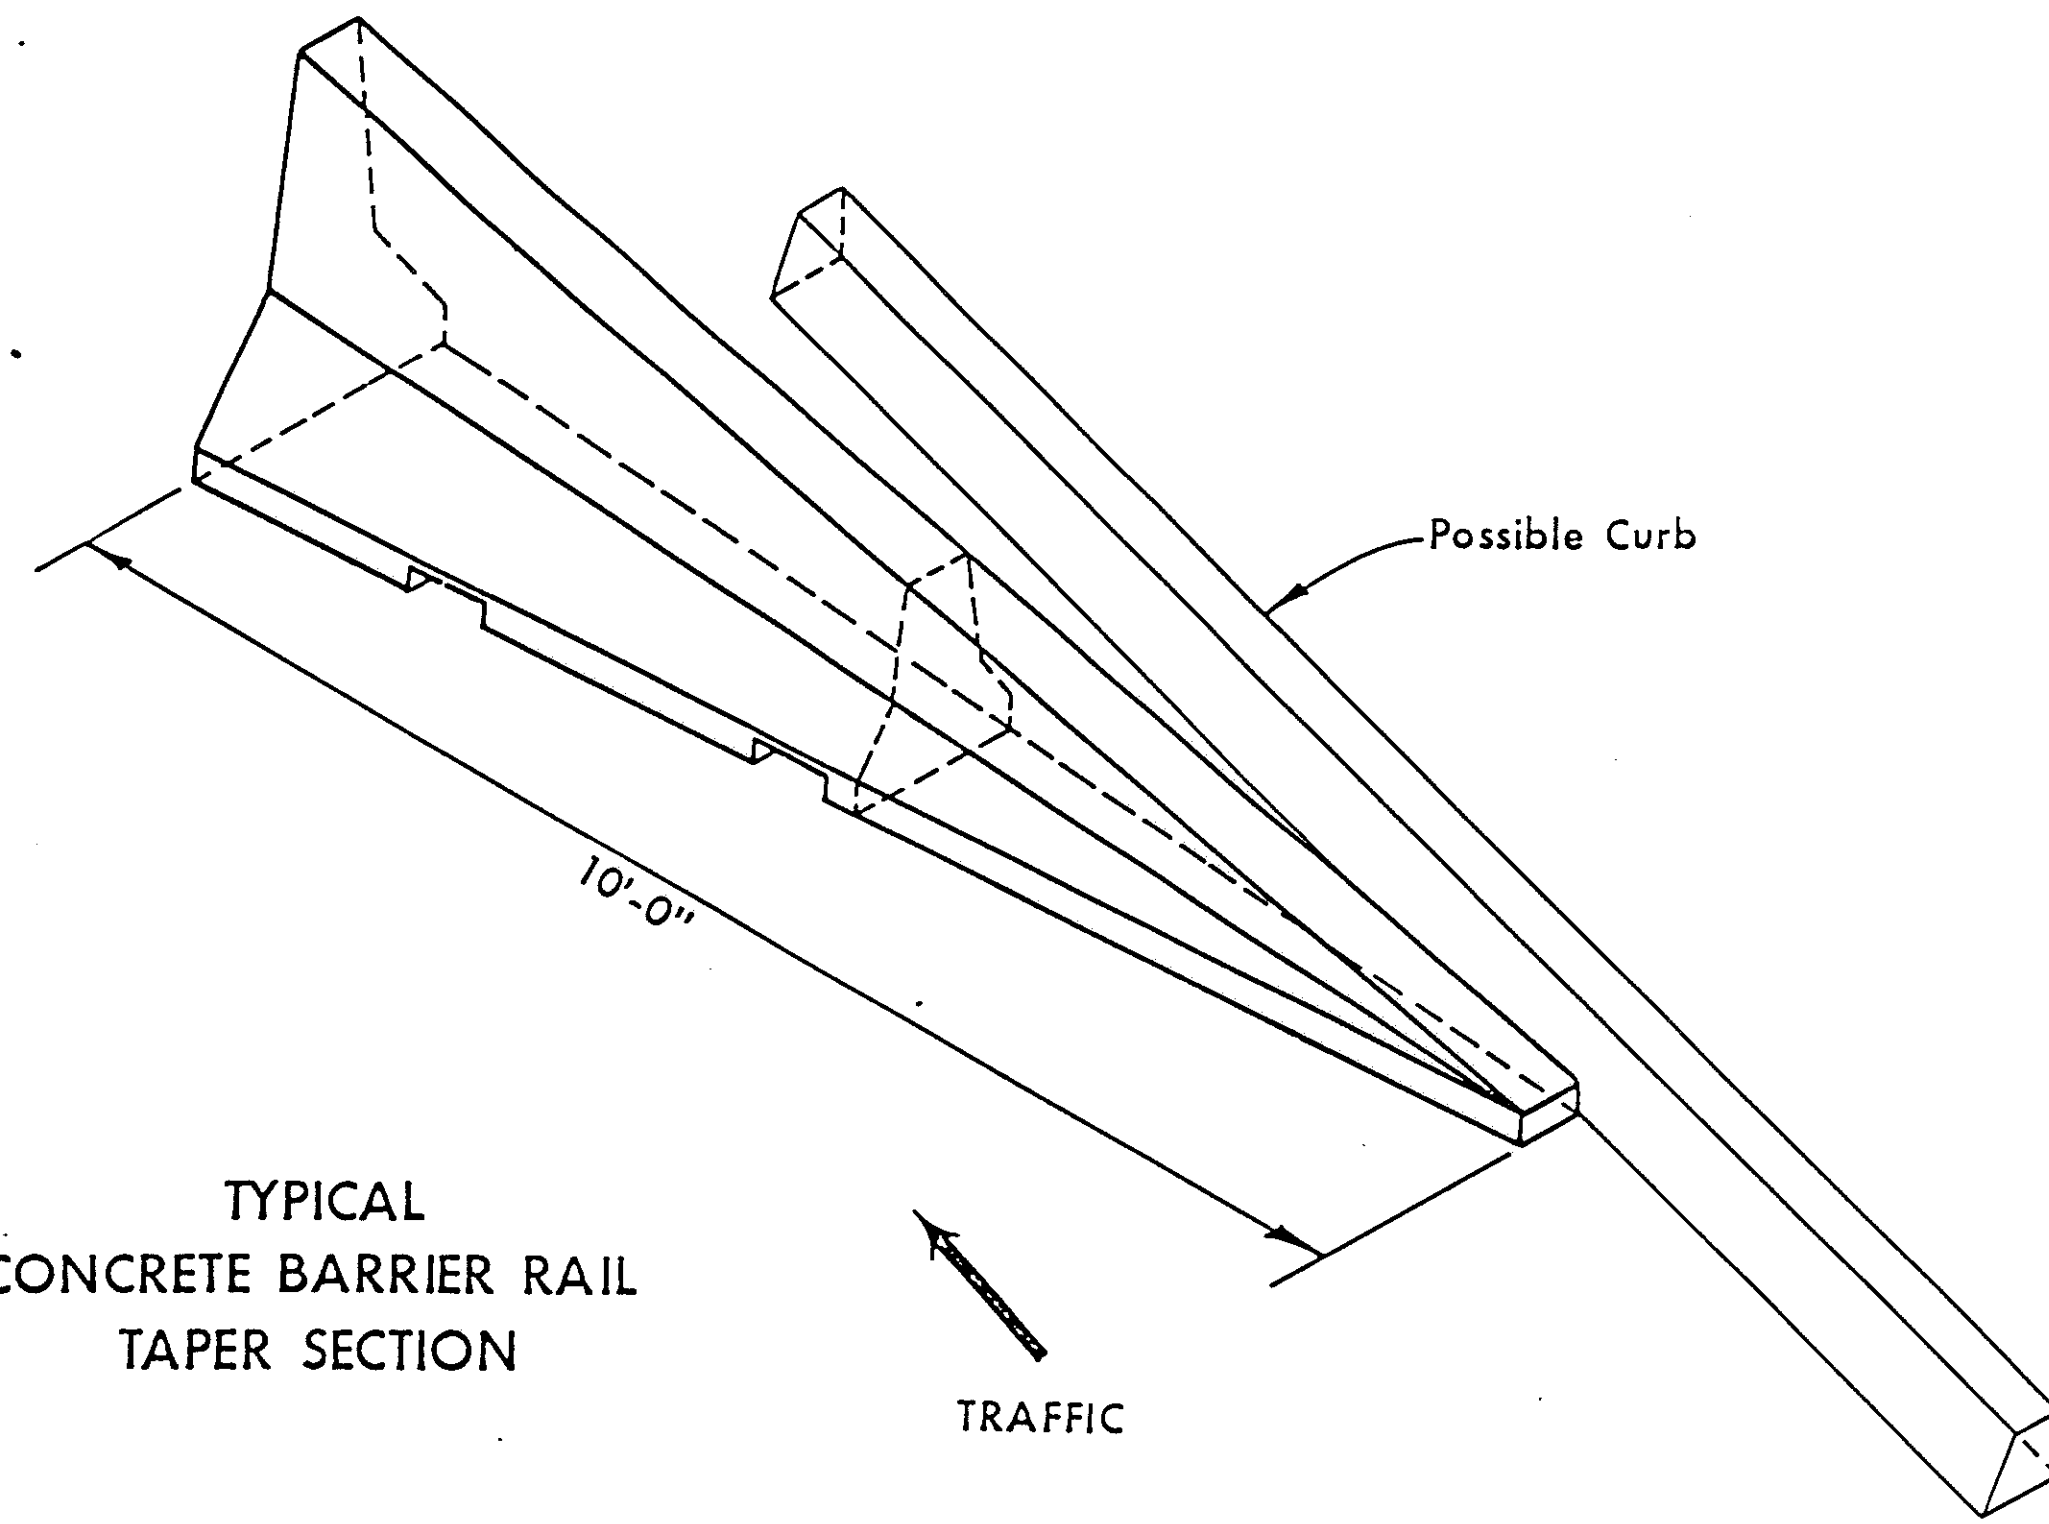

FRONT ELEVATION

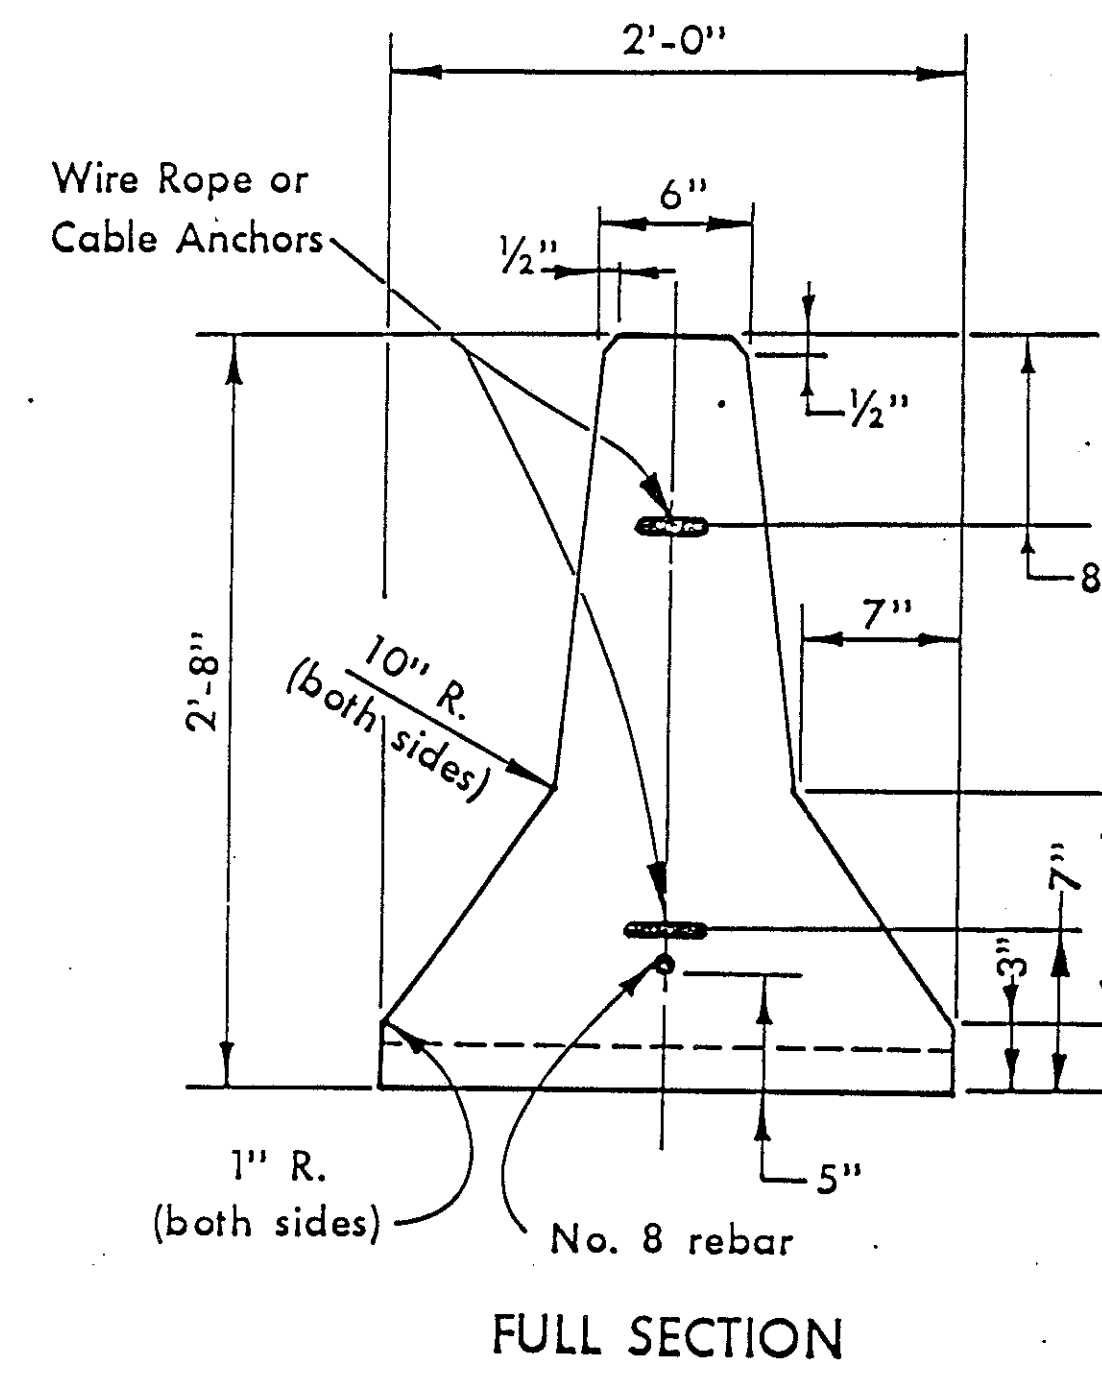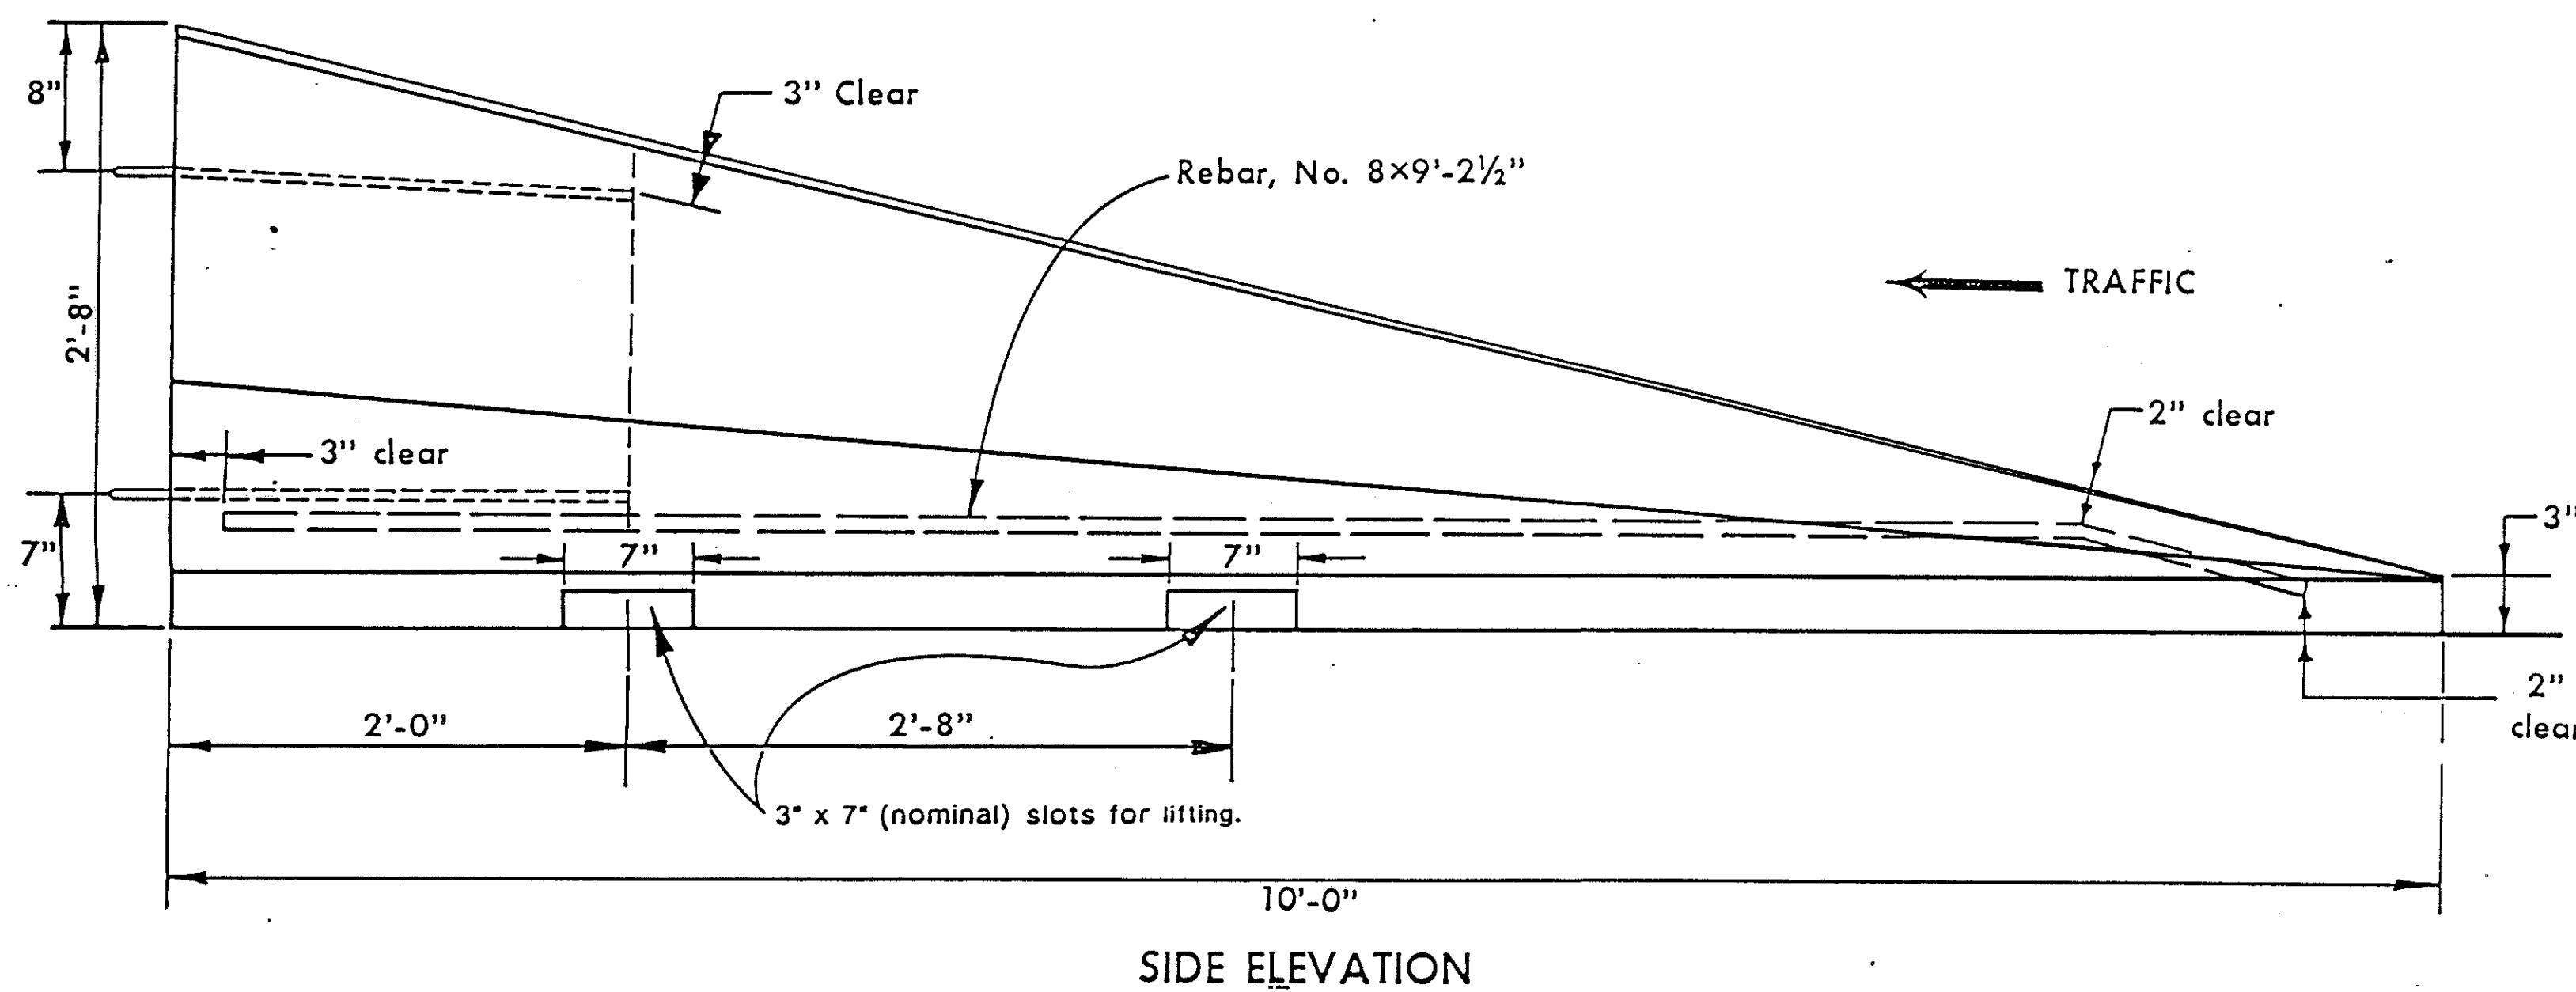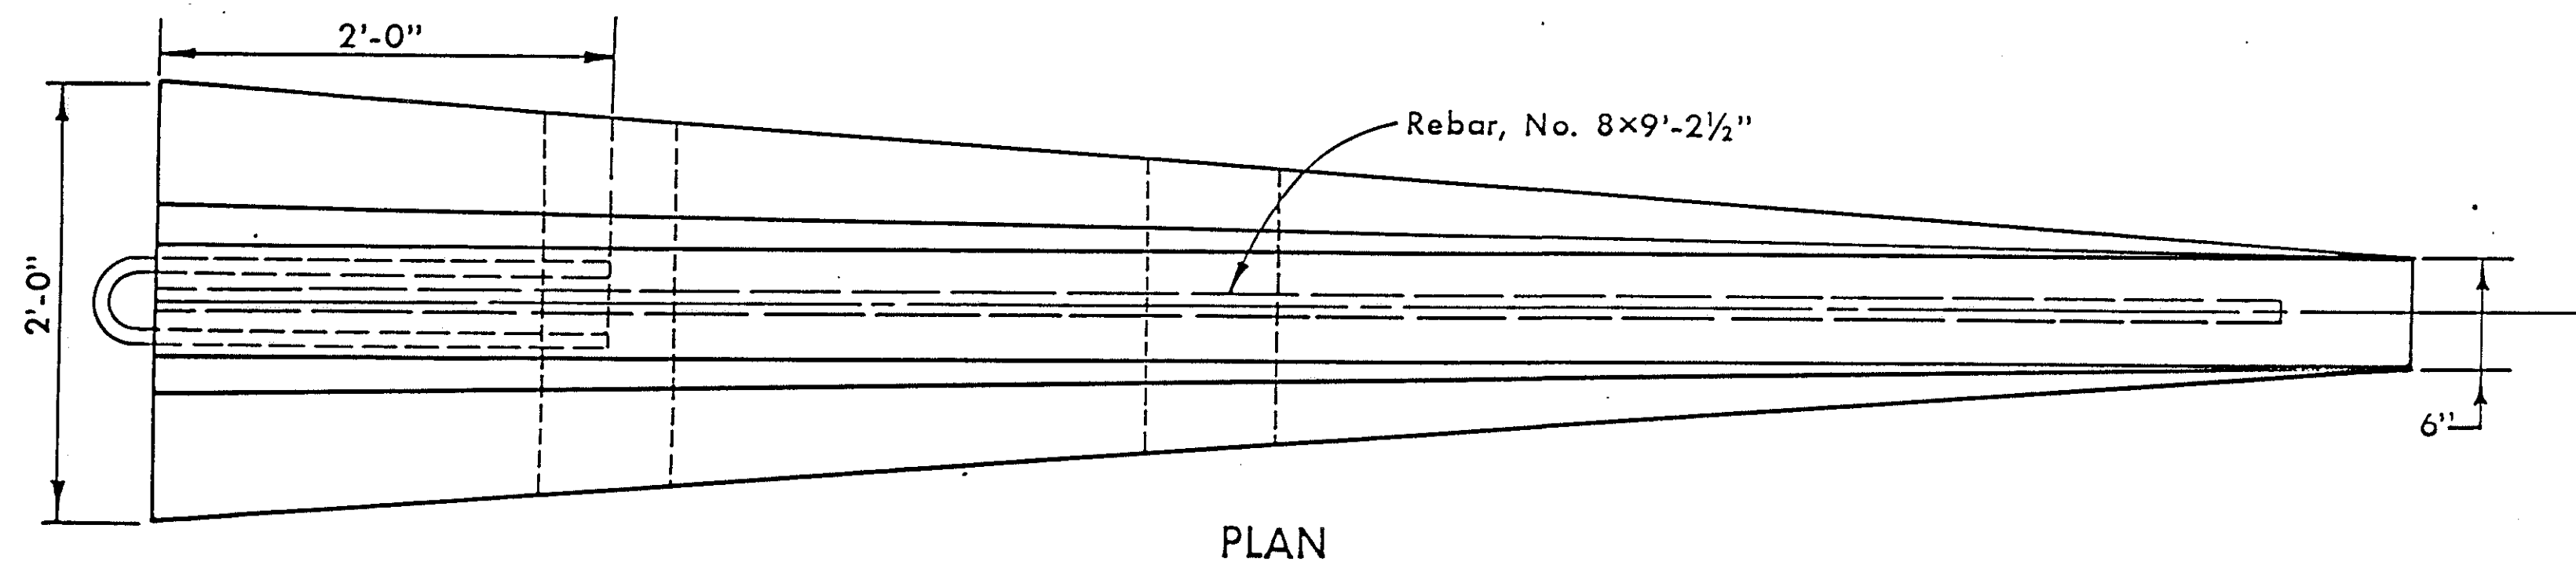

GENERAL NOTES:

Details shown hereon are for the construction of a precast concrete barrier rail taper section. Alternate design details may be submitted to the engineer for approval prior to construction.


Barrier shall be constructed as specified in Section 2513 of the current specifications. Estimated quantity for one taper section is 0.486 cu. yds. of concrete.




Iowa Department of Transportation
Highway Division

DETAIL SHEET 540-1


TEMPORARY CONCRETE
BARRIER RAIL TAPER SECTION
(PRE-CAST)

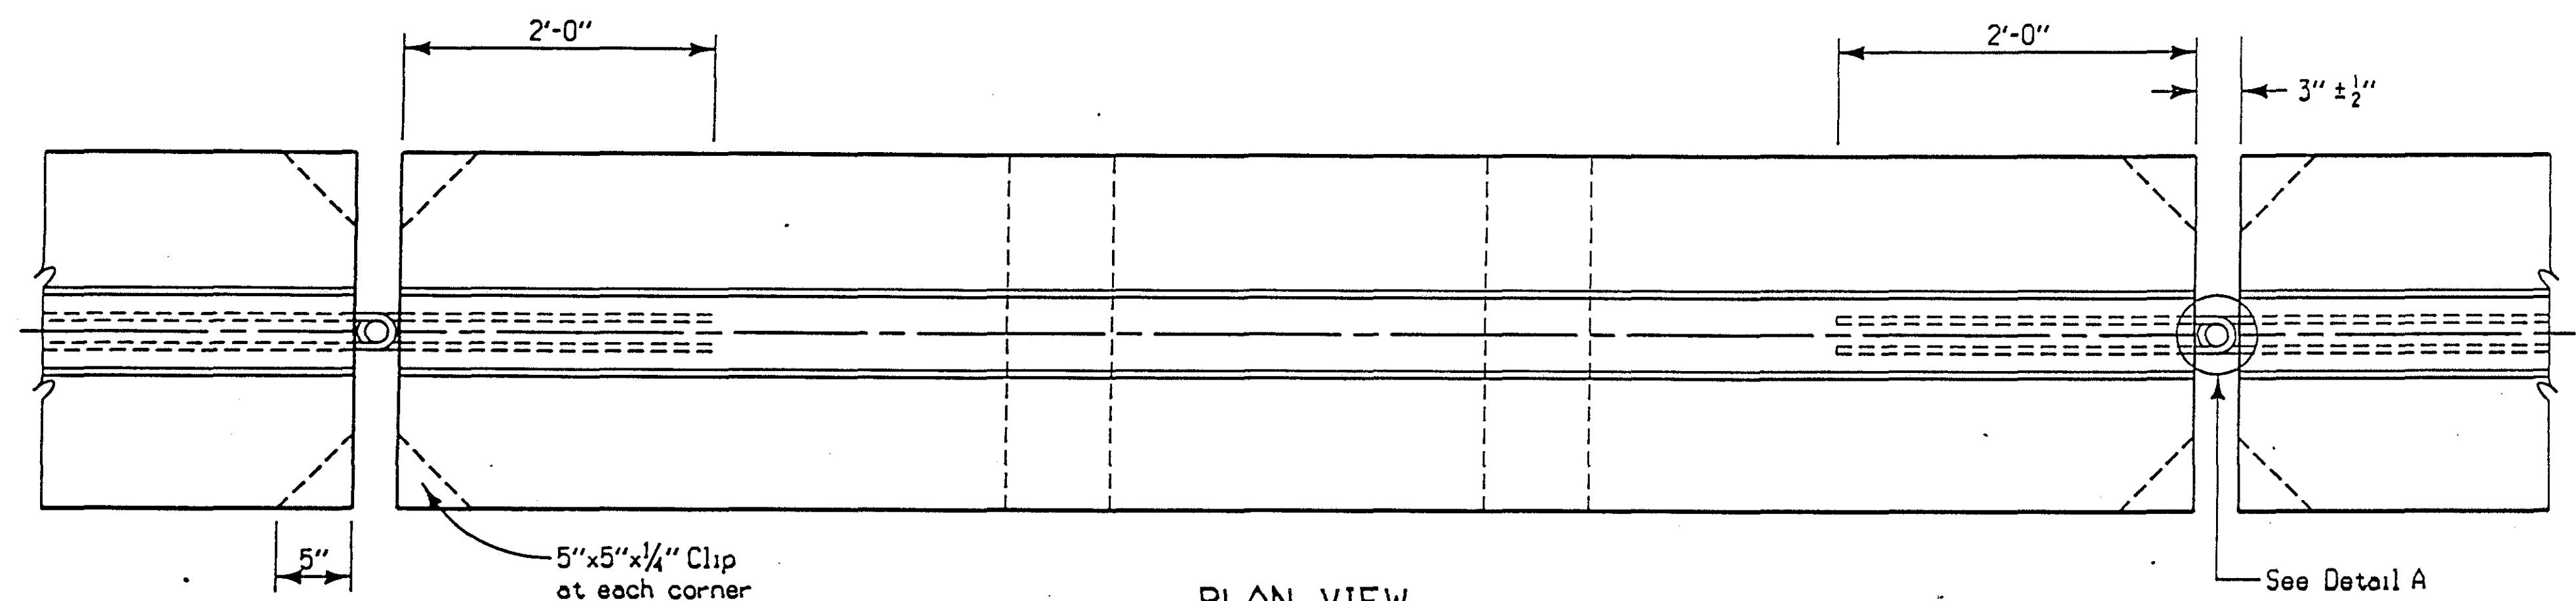


PLAN VIEW

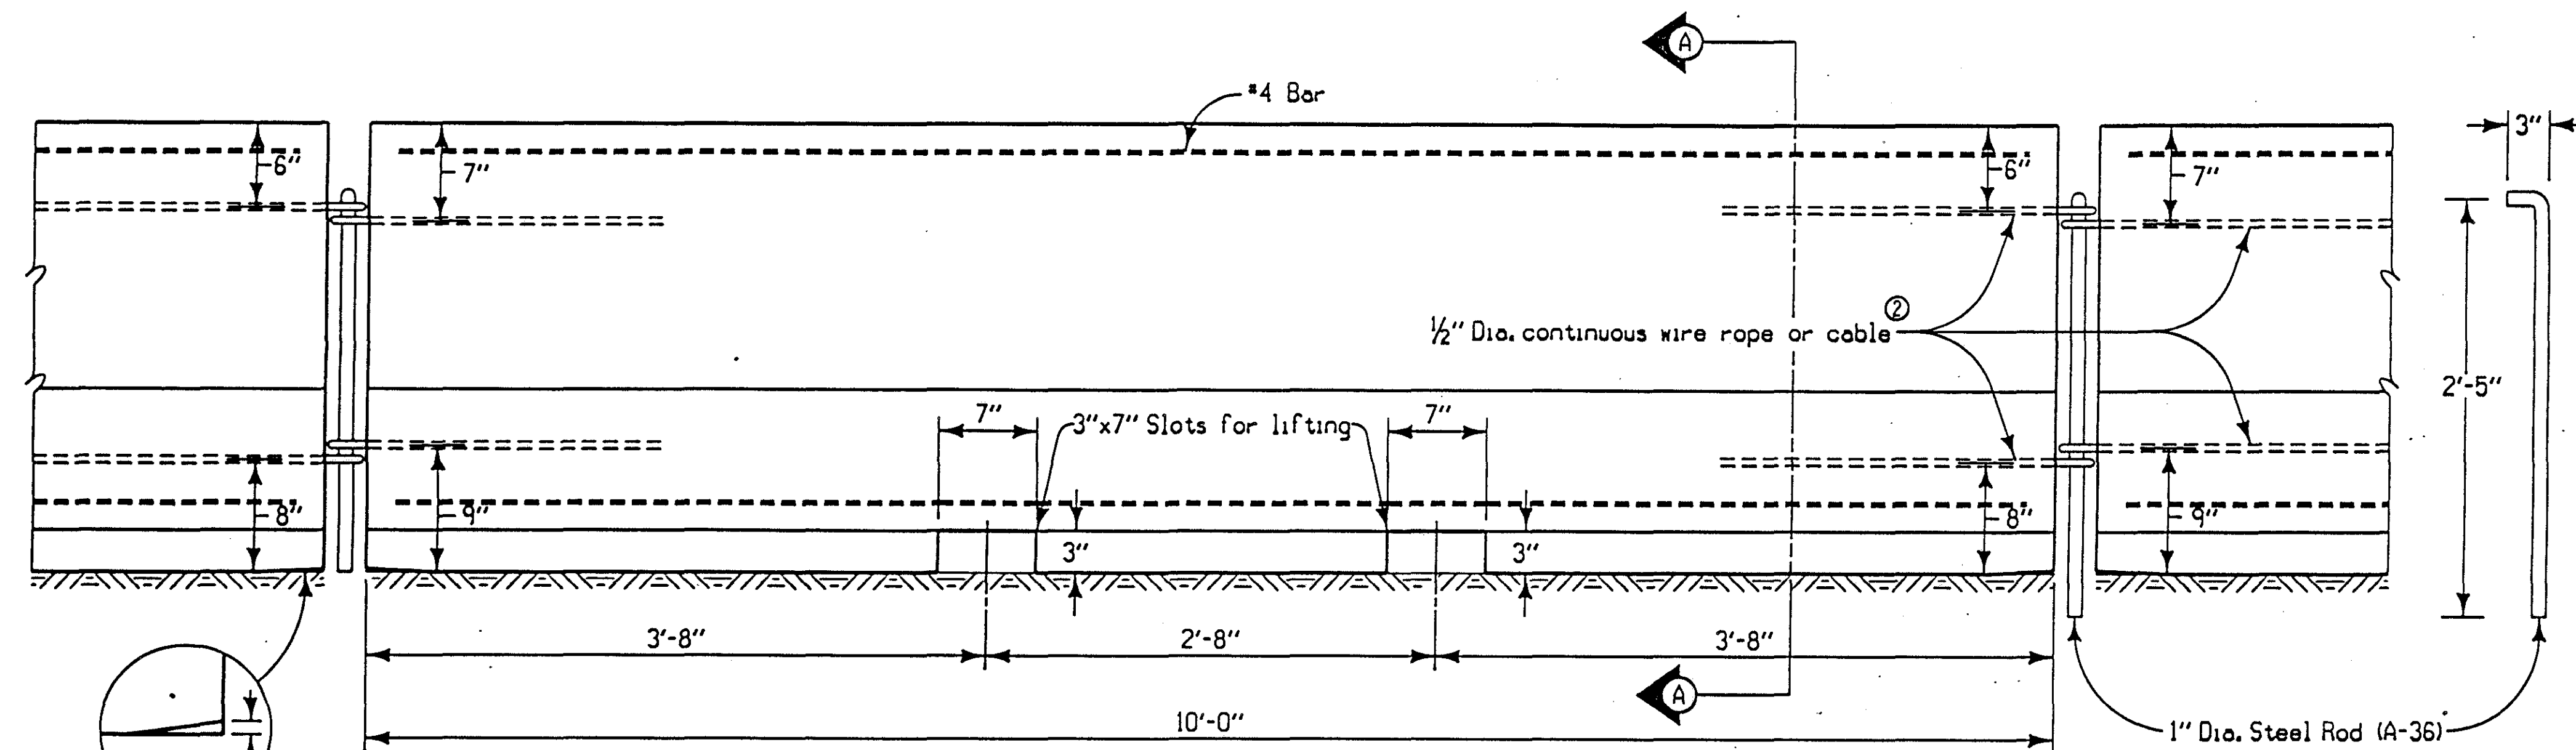


ELEVATION VIEW

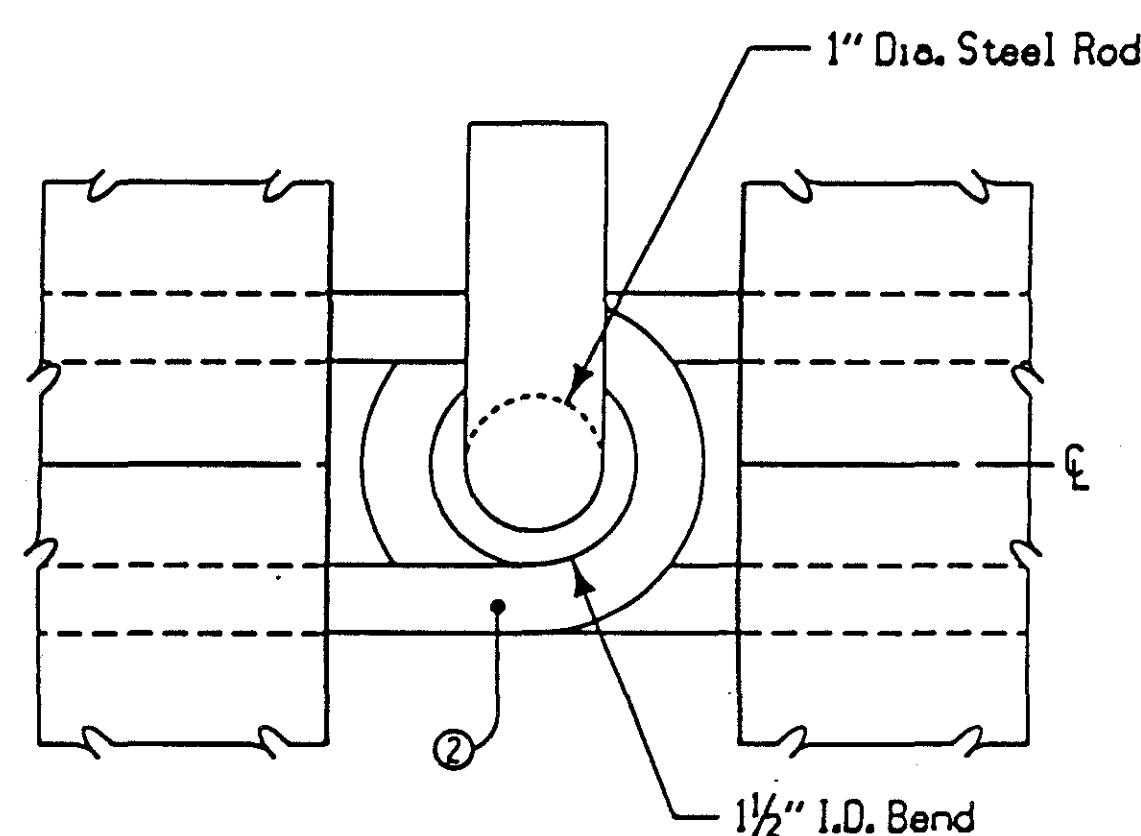

DETAIL A

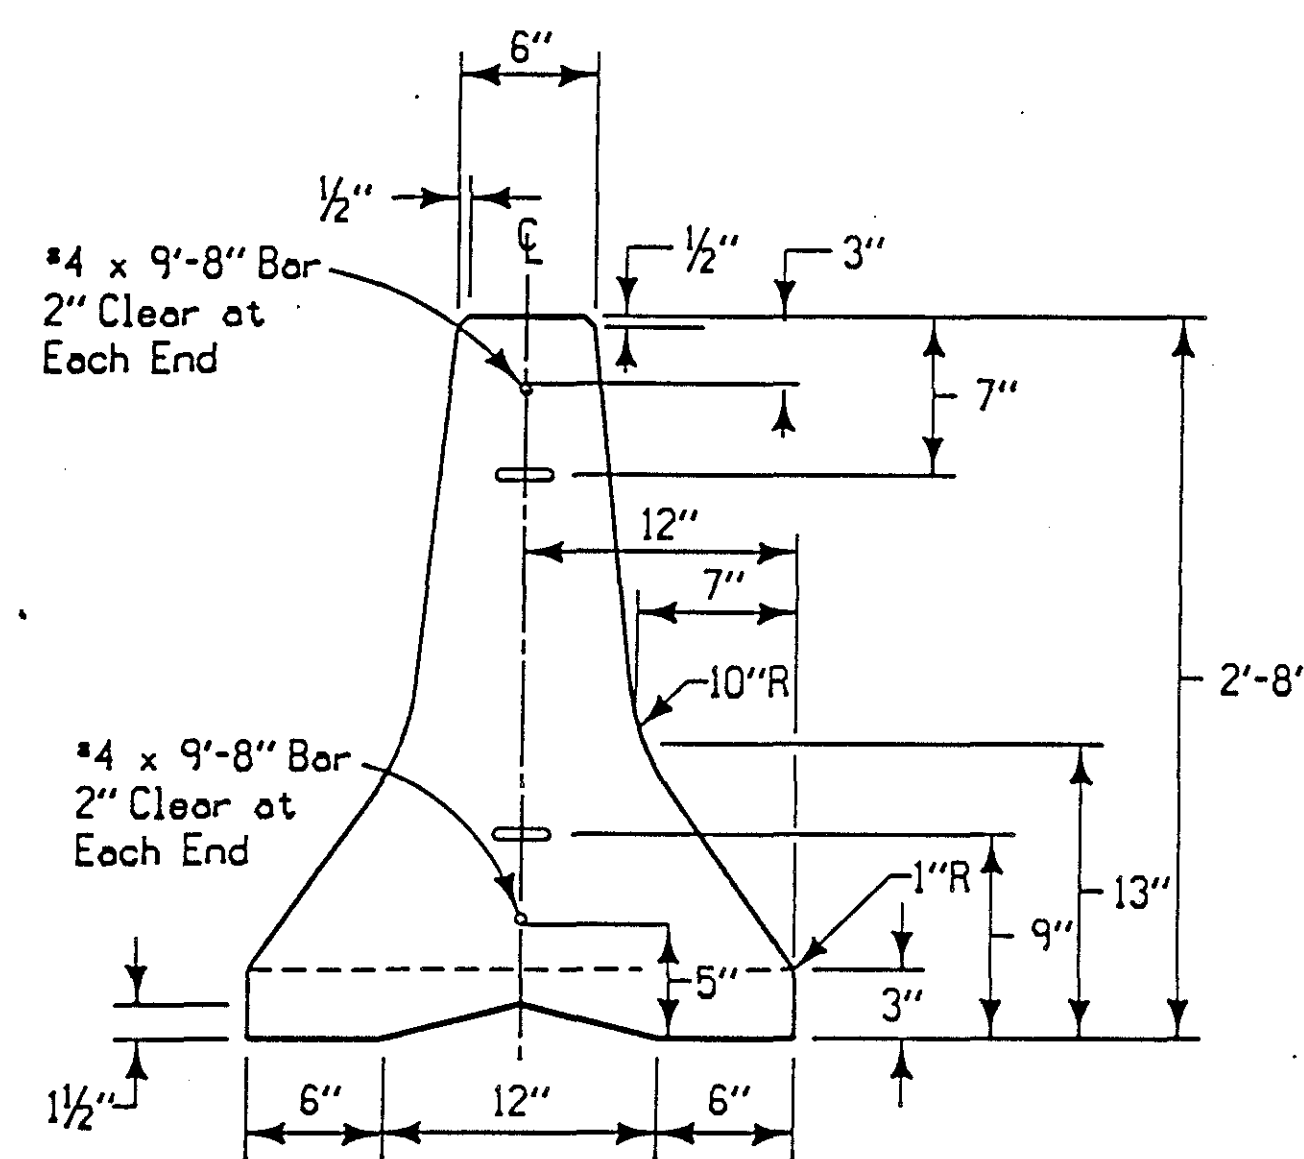

SECTION A-A

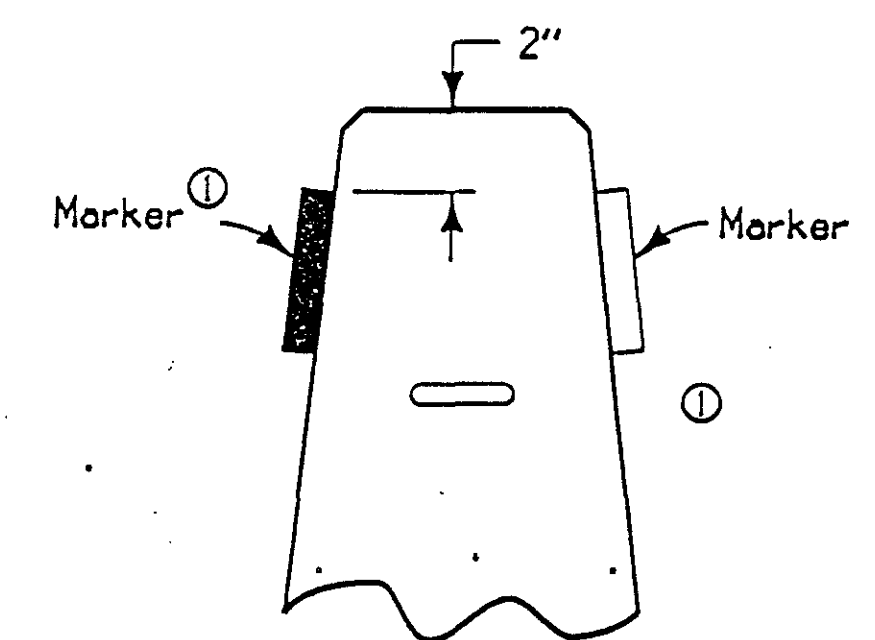

MARKER PLACEMENT DETAIL

GENERAL NOTES:

These details are for the fabrication and installation of temporary concrete barrier rail. Barrier shall be constructed as specified in Section 2513 of the current specifications.

Materials and methods of construction shall be in accordance with current Standard and Supplemental Specifications.

Details shown are typical. Alternate design details may be submitted to the Engineer for approval.

The contractor shall provide for an approved monitoring schedule with a person on call and available 24 hours a day, each day of the week, to realign barrier rail which has been struck. Initiation of service shall be within one hour of notification of need.

Markers shall be furnished and installed by the contractor. Markers shall be placed on the barrier as recommended by the manufacturer, and as shown in the Marker Placement Detail or as directed by the Engineer. The markers shall be installed at 10 foot spacing and face oncoming traffic. Refer to Details of Barrier Placement. The contractor shall maintain the markers and promptly repair or replace any damaged or missing units. All costs for furnishing, installing and maintaining markers shall be included in the price bid for the temporary barrier rail.

Unless stated otherwise in the plans, the barrier rail sections shall remain the property of the contractor and at the completion of the work shall be removed from the site by him.

When Temporary Barrier Rail is installed within 2 feet of a drop-off, tie downs as described and shown on Detail Sheet 540-10 shall be required.

The price bid for "Temporary Barrier Rail, Furnish Only" in linear feet shall be full compensation for furnishing temporary barrier rail as detailed and measured on this sheet.

The price bid for "Temporary Barrier Rail, Place Only" in linear feet of Barrier Rail shall be full compensation for placing temporary barrier rail as detailed on this sheet and elsewhere in the plan.

Contractor may add extra reinforcing bars to increase the service life of the rail sections.

- ① Color same as adjacent edgeline.
- ② Wire rope or cable to be 1/2" diameter, with a minimum breaking strength of 20,000 pounds.

NO. 4 DATE 11-10-92 REVISION: Change in the specifications.	DETAIL SHEET 540-2		
TEMPORARY CONCRETE BARRIER RAIL (PRECAST)			

ROAD DESIGN • CADD • PRODUCED

STATE OF IOWA

FWHA REGION 7

FISCAL YEAR

Lincoln COUNTY

PROJECT NUMBER

NH 5-100-1(23)--(19-57)

SHEET NUMBER


U06

GENERAL NOTES:


Tie-downs are required only where the Temporary Barrier Rail is adjacent to a drop-off. Holes for concrete anchors may be drilled after positioning the Temporary Barrier Rail. The concrete anchors are to be set so that the anchors can be removed at least 1½ inches below the concrete surface and the remaining hole filled with a neat mixture of sand-cement grout. The concrete anchors are to be removed, without damaging the surrounding concrete, only after the Temporary Barrier Rail is no longer needed at the particular location.

Concrete anchors are to be a minimum of ¾" Ø and as otherwise specified in the current Office of Materials I.M. 453.09 with a pull-out strength of 16,000 lbs. based 4,000 p.s.i. concrete.


Temporary barrier rail tie downs are considered incidental to concrete barrier rail.

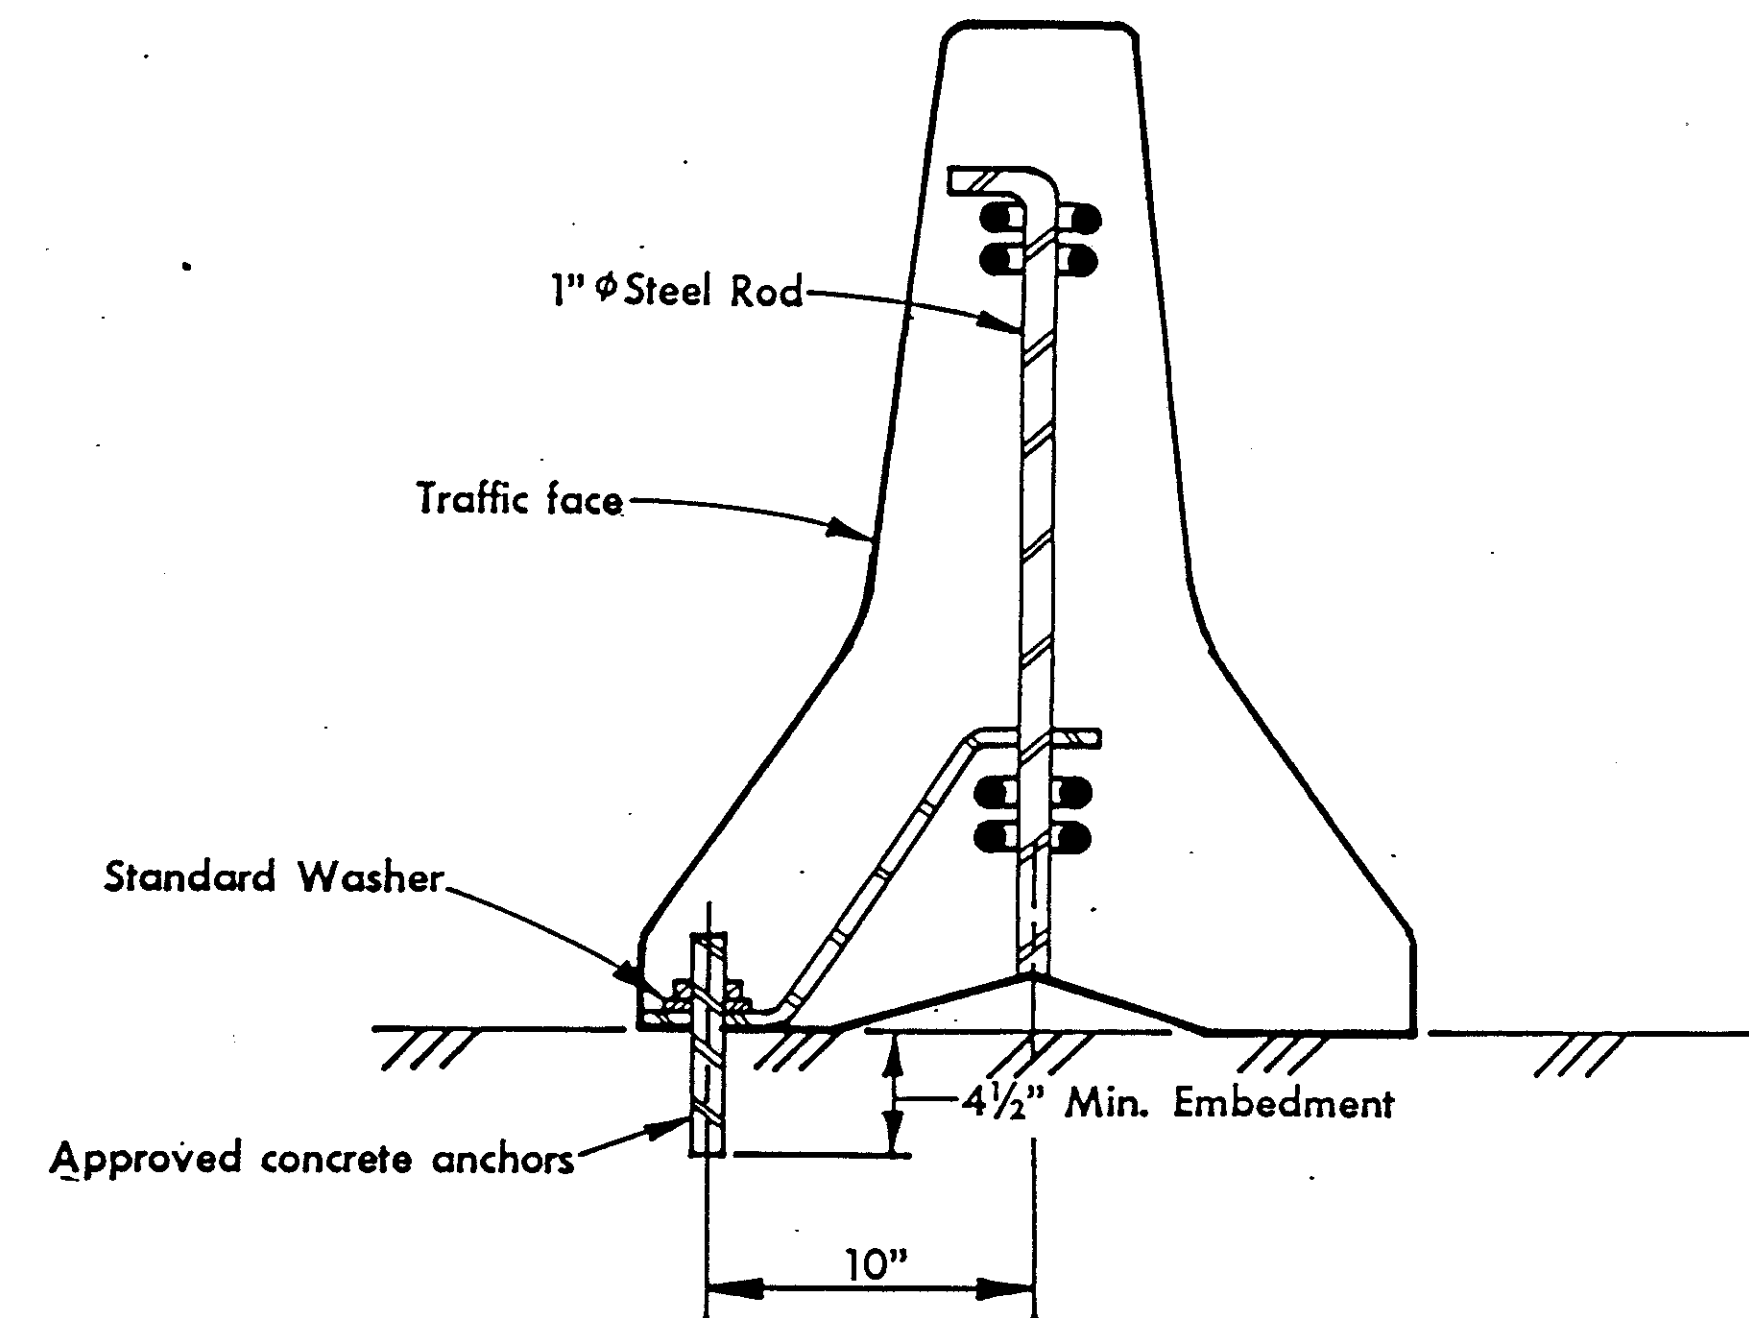

SECTION A-A

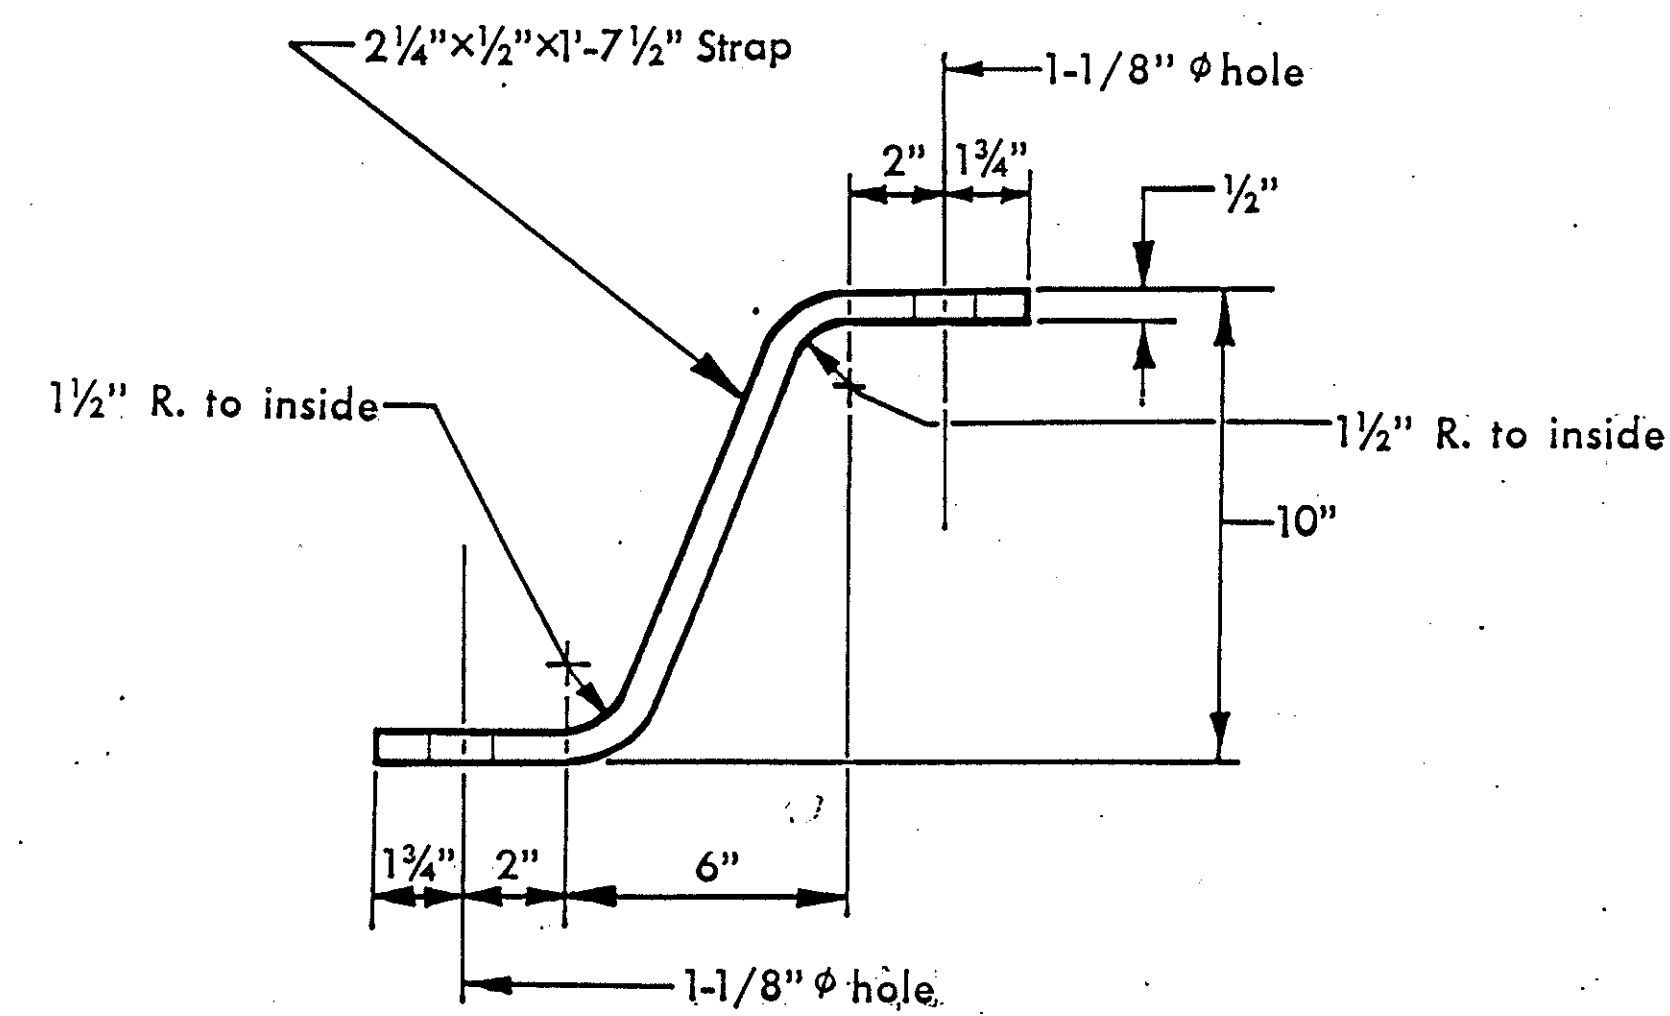


STRAP DETAIL

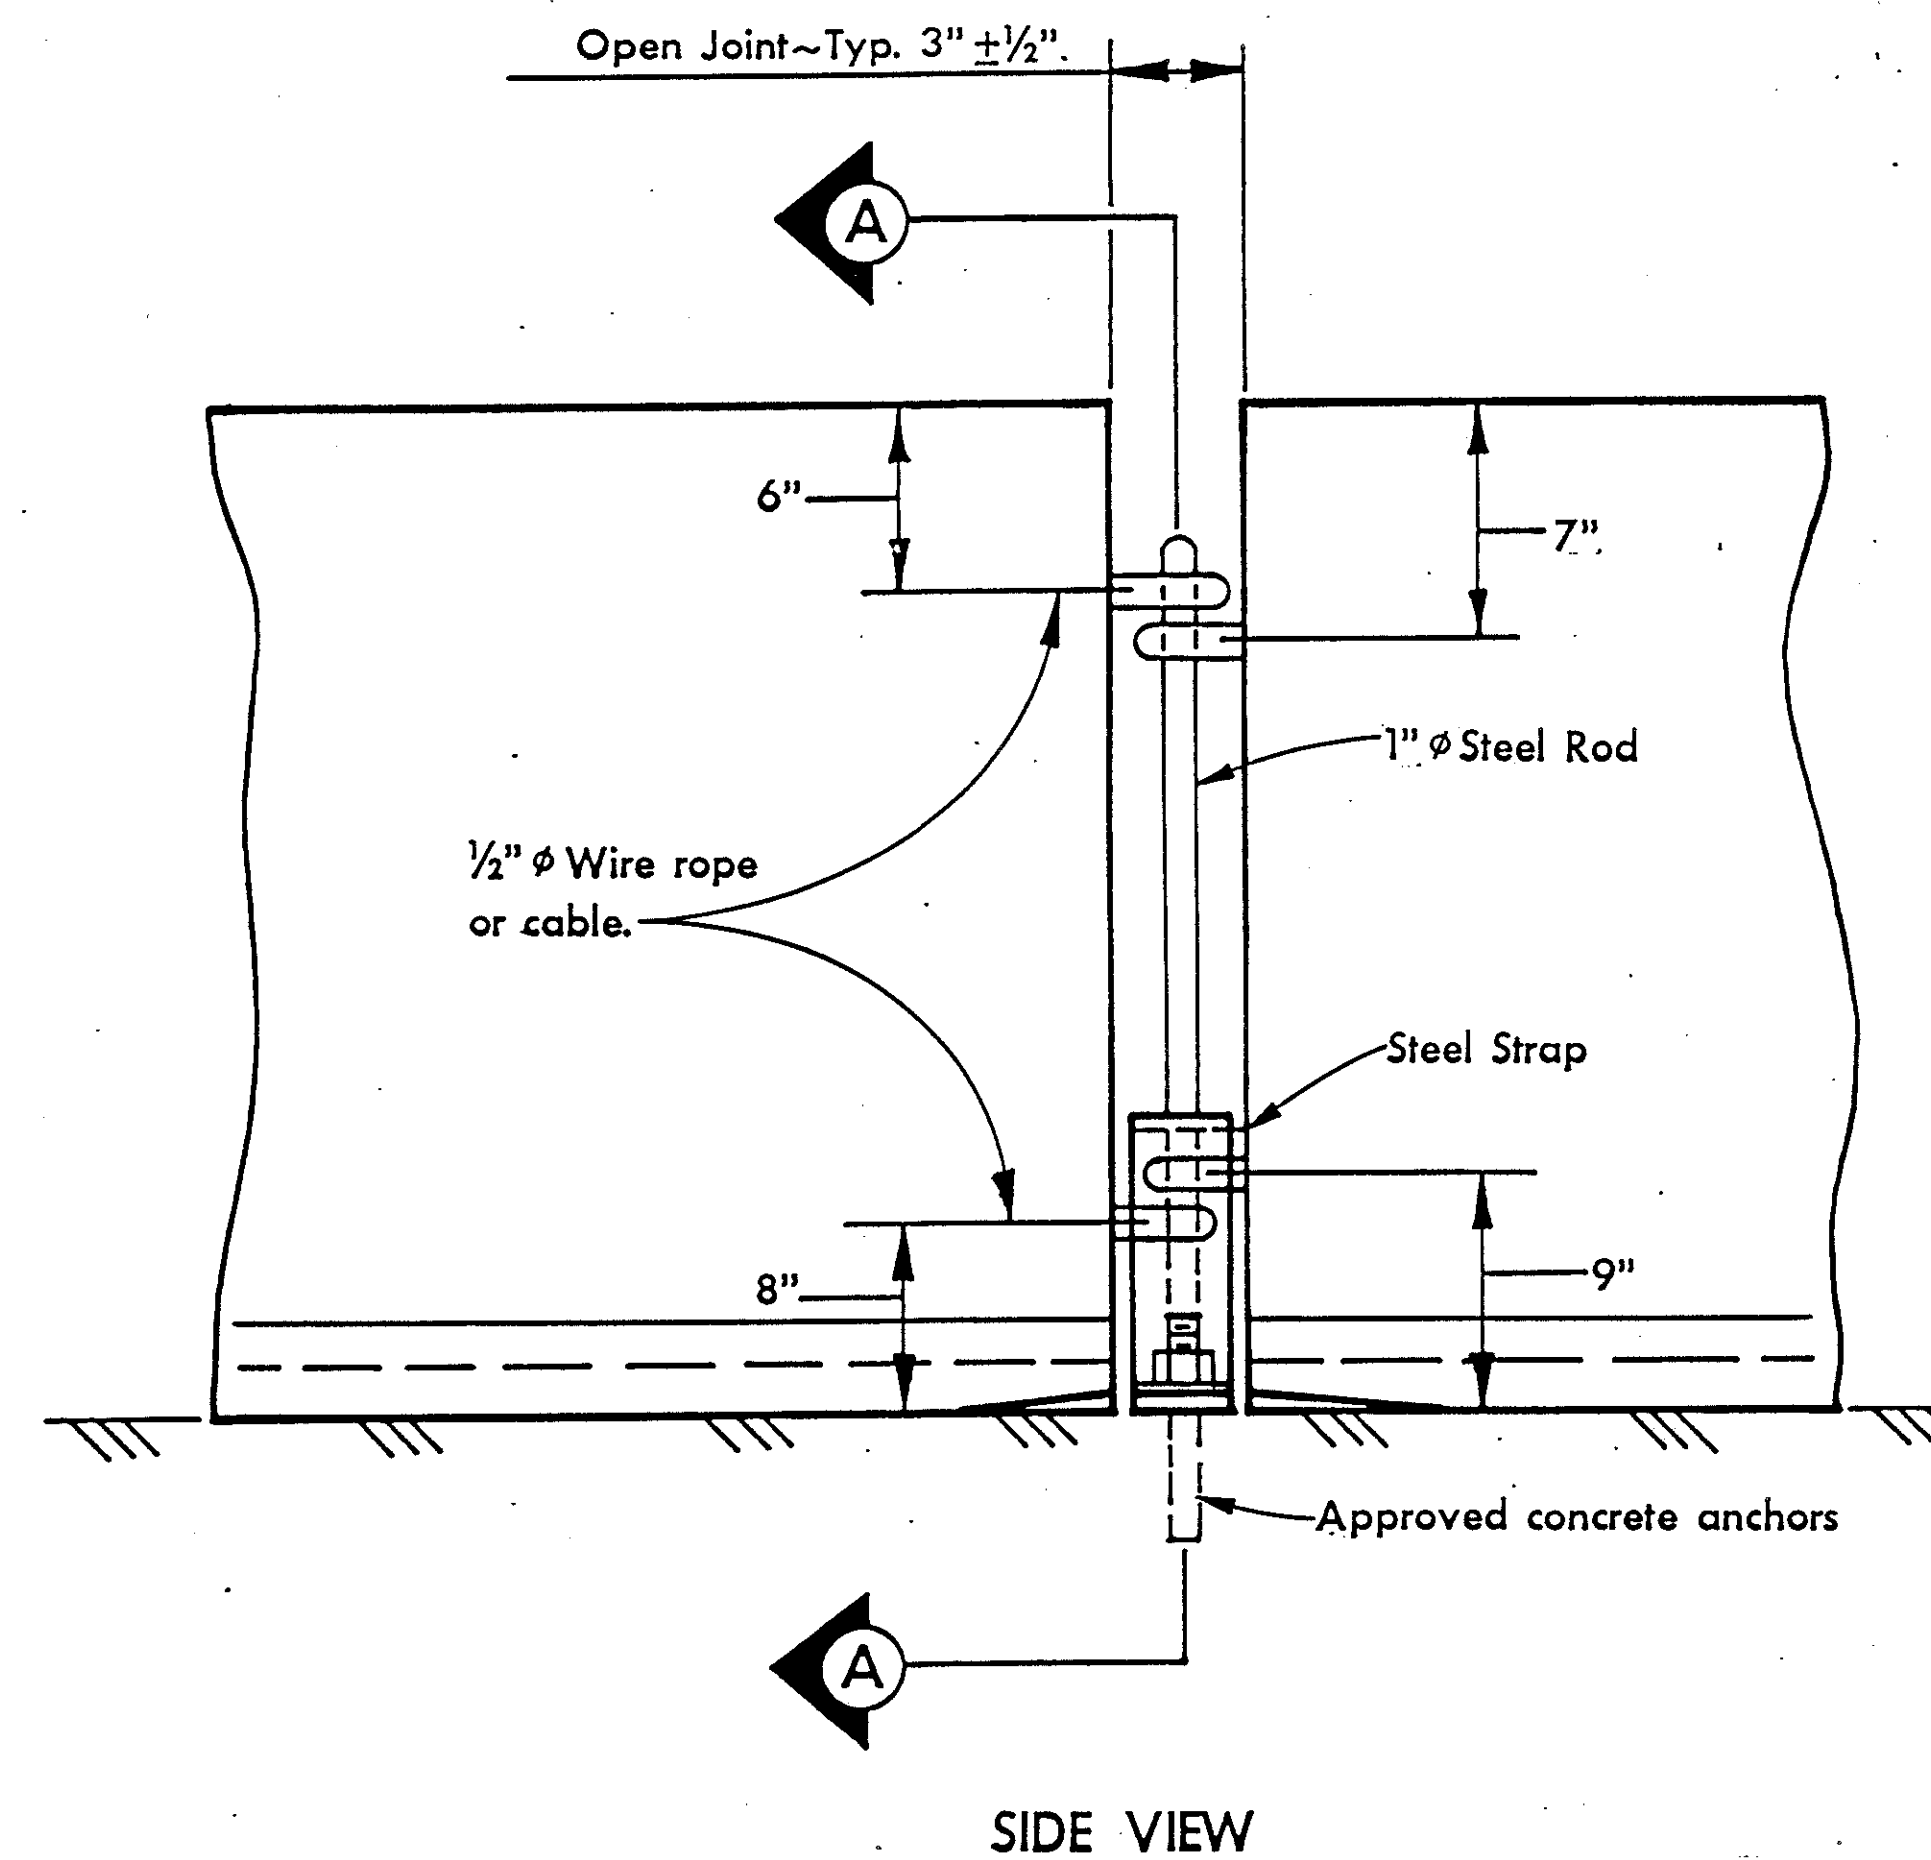

SIDE VIEW

NO.	REV.	DATE	DETAIL SHEET 540-10
REVISION:			TEMPORARY CONCRETE BARRIER RAIL TIE DOWNS

STATE OF IOWA	FHWA REGION 7	FISCAL YEAR	Linn COUNTY	PROJECT NUMBER	NHS-100-1(23)-19-57	SHEET NUMBER	TOTAL SHEETS	U.07
---------------	---------------	-------------	-------------	----------------	---------------------	--------------	--------------	------

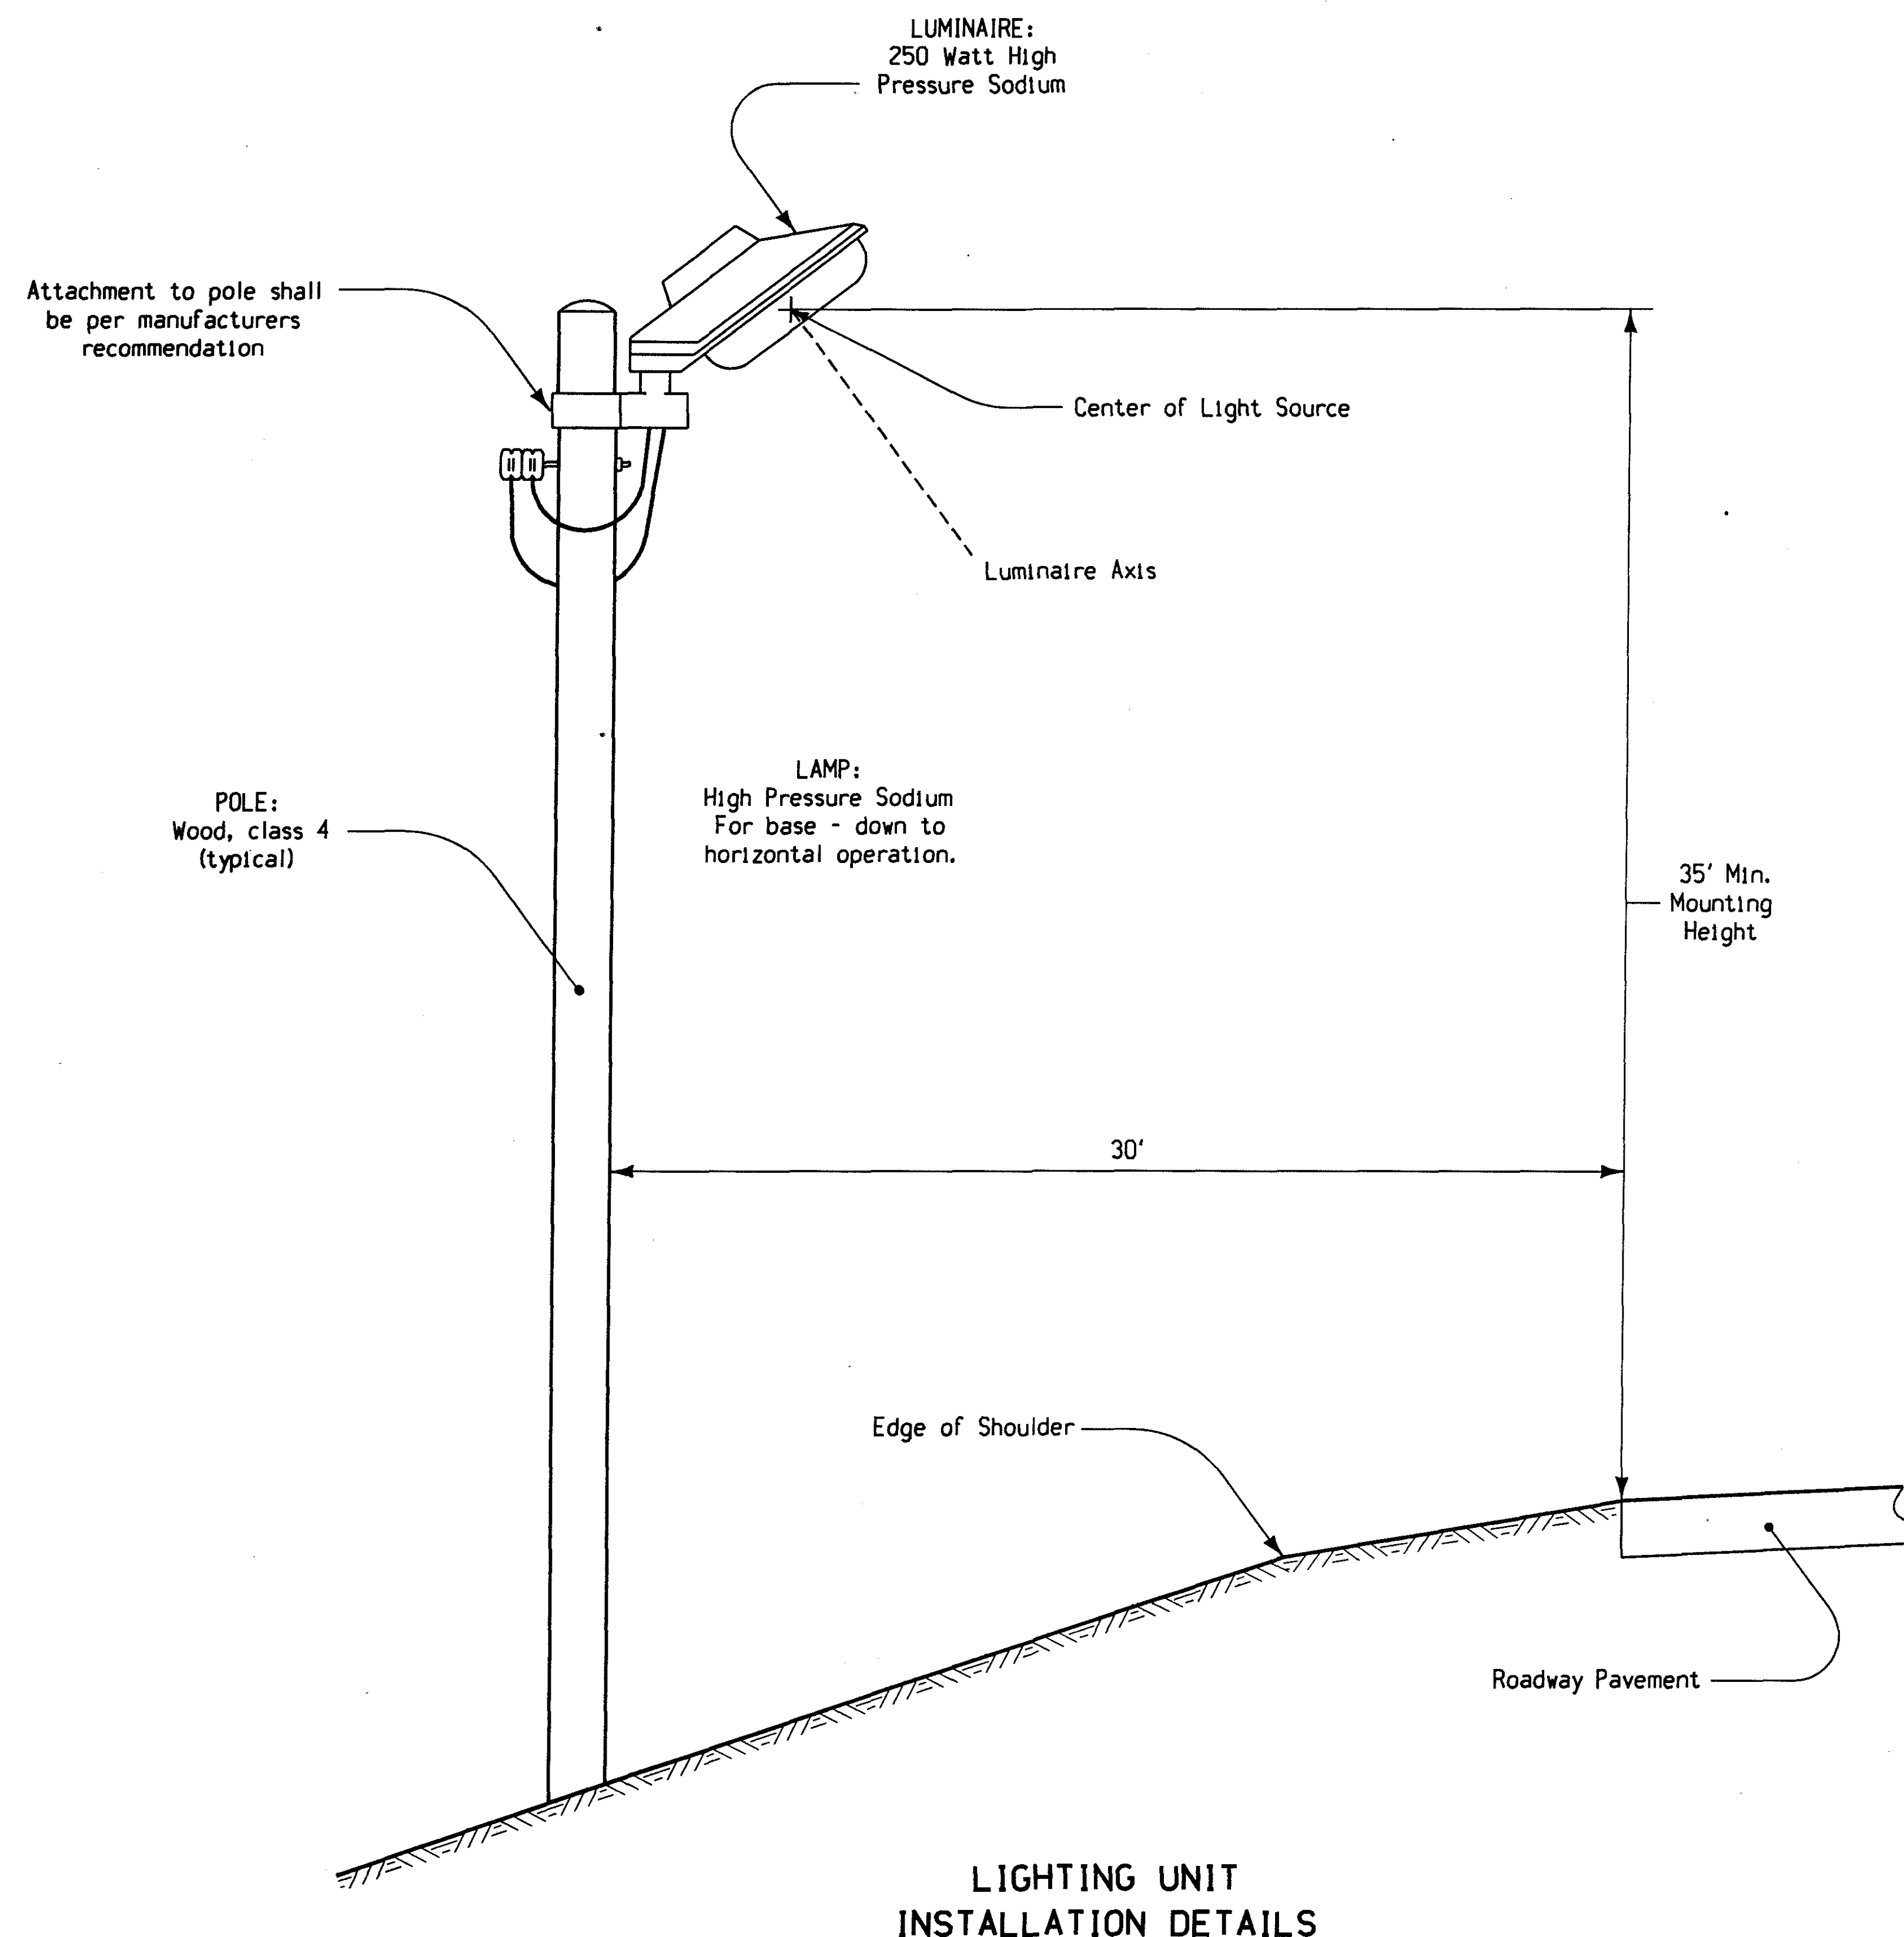

GENERAL NOTES:

Temporary floodlighting will be required on this project. The lighting shall conform to current Standard and Supplemental Specifications for floodlighting, Articles 2528.08 and 2528.12 paragraph A (5) except as modified hereon.

Temporary floodlighting shall consist of either a pole mounted luminaire as illustrated hereon or a luminaire mounted on portable type equipment. Location of the temporary floodlighting shall be as shown in the Traffic Control Plan or as determined by the Engineer. The contractor shall determine pole length by field measurement to obtain specified mounting height. Luminaire axis shall be directed to within the limits of the near traffic lane unless specified otherwise.

Proposals for alternatives to the class 4 wood pole used to mount luminaire may be submitted to the Engineer for approval.

The luminaire shall be designed to operate without a mastarm. The "Vector" and "Expressway" luminaire by the Holophane Company, Inc. or the "Interstate" luminaire by the Amerion Electric Division of I.T.T. are the approved luminaires.

Aerial lighting circuits shall be aluminum or A.C.S.R. triplex. Underground lighting circuits shall be type U.S.E. or U.F. All circuit design and materials shall be approved by the engineer before installation commences.

Price bid for "Temporary Floodlighting Luminaire" shall include all cost for furnishing, installing, maintaining and servicing the Temporary Floodlighting Units, all costs for electrical energy, and the cost of removing all lighting materials from the construction site.

		DETAIL SHEET		570-2
		TEMPORARY FLOODLIGHTING (OFFSET)		
NO. 8	DATE 06-15-93	REVISION: Change bid item.		

OFFICE OF DESIGN • CADD • PRODUCED

STATE OF IOWA

FHWA REGION 7

FISCAL YEAR

Linn COUNTY



PROJECT NUMBER

NHS-100-1(23)-19-57


SHEET NUMBER

U.08

STAND OFF GUY ALTERNATE

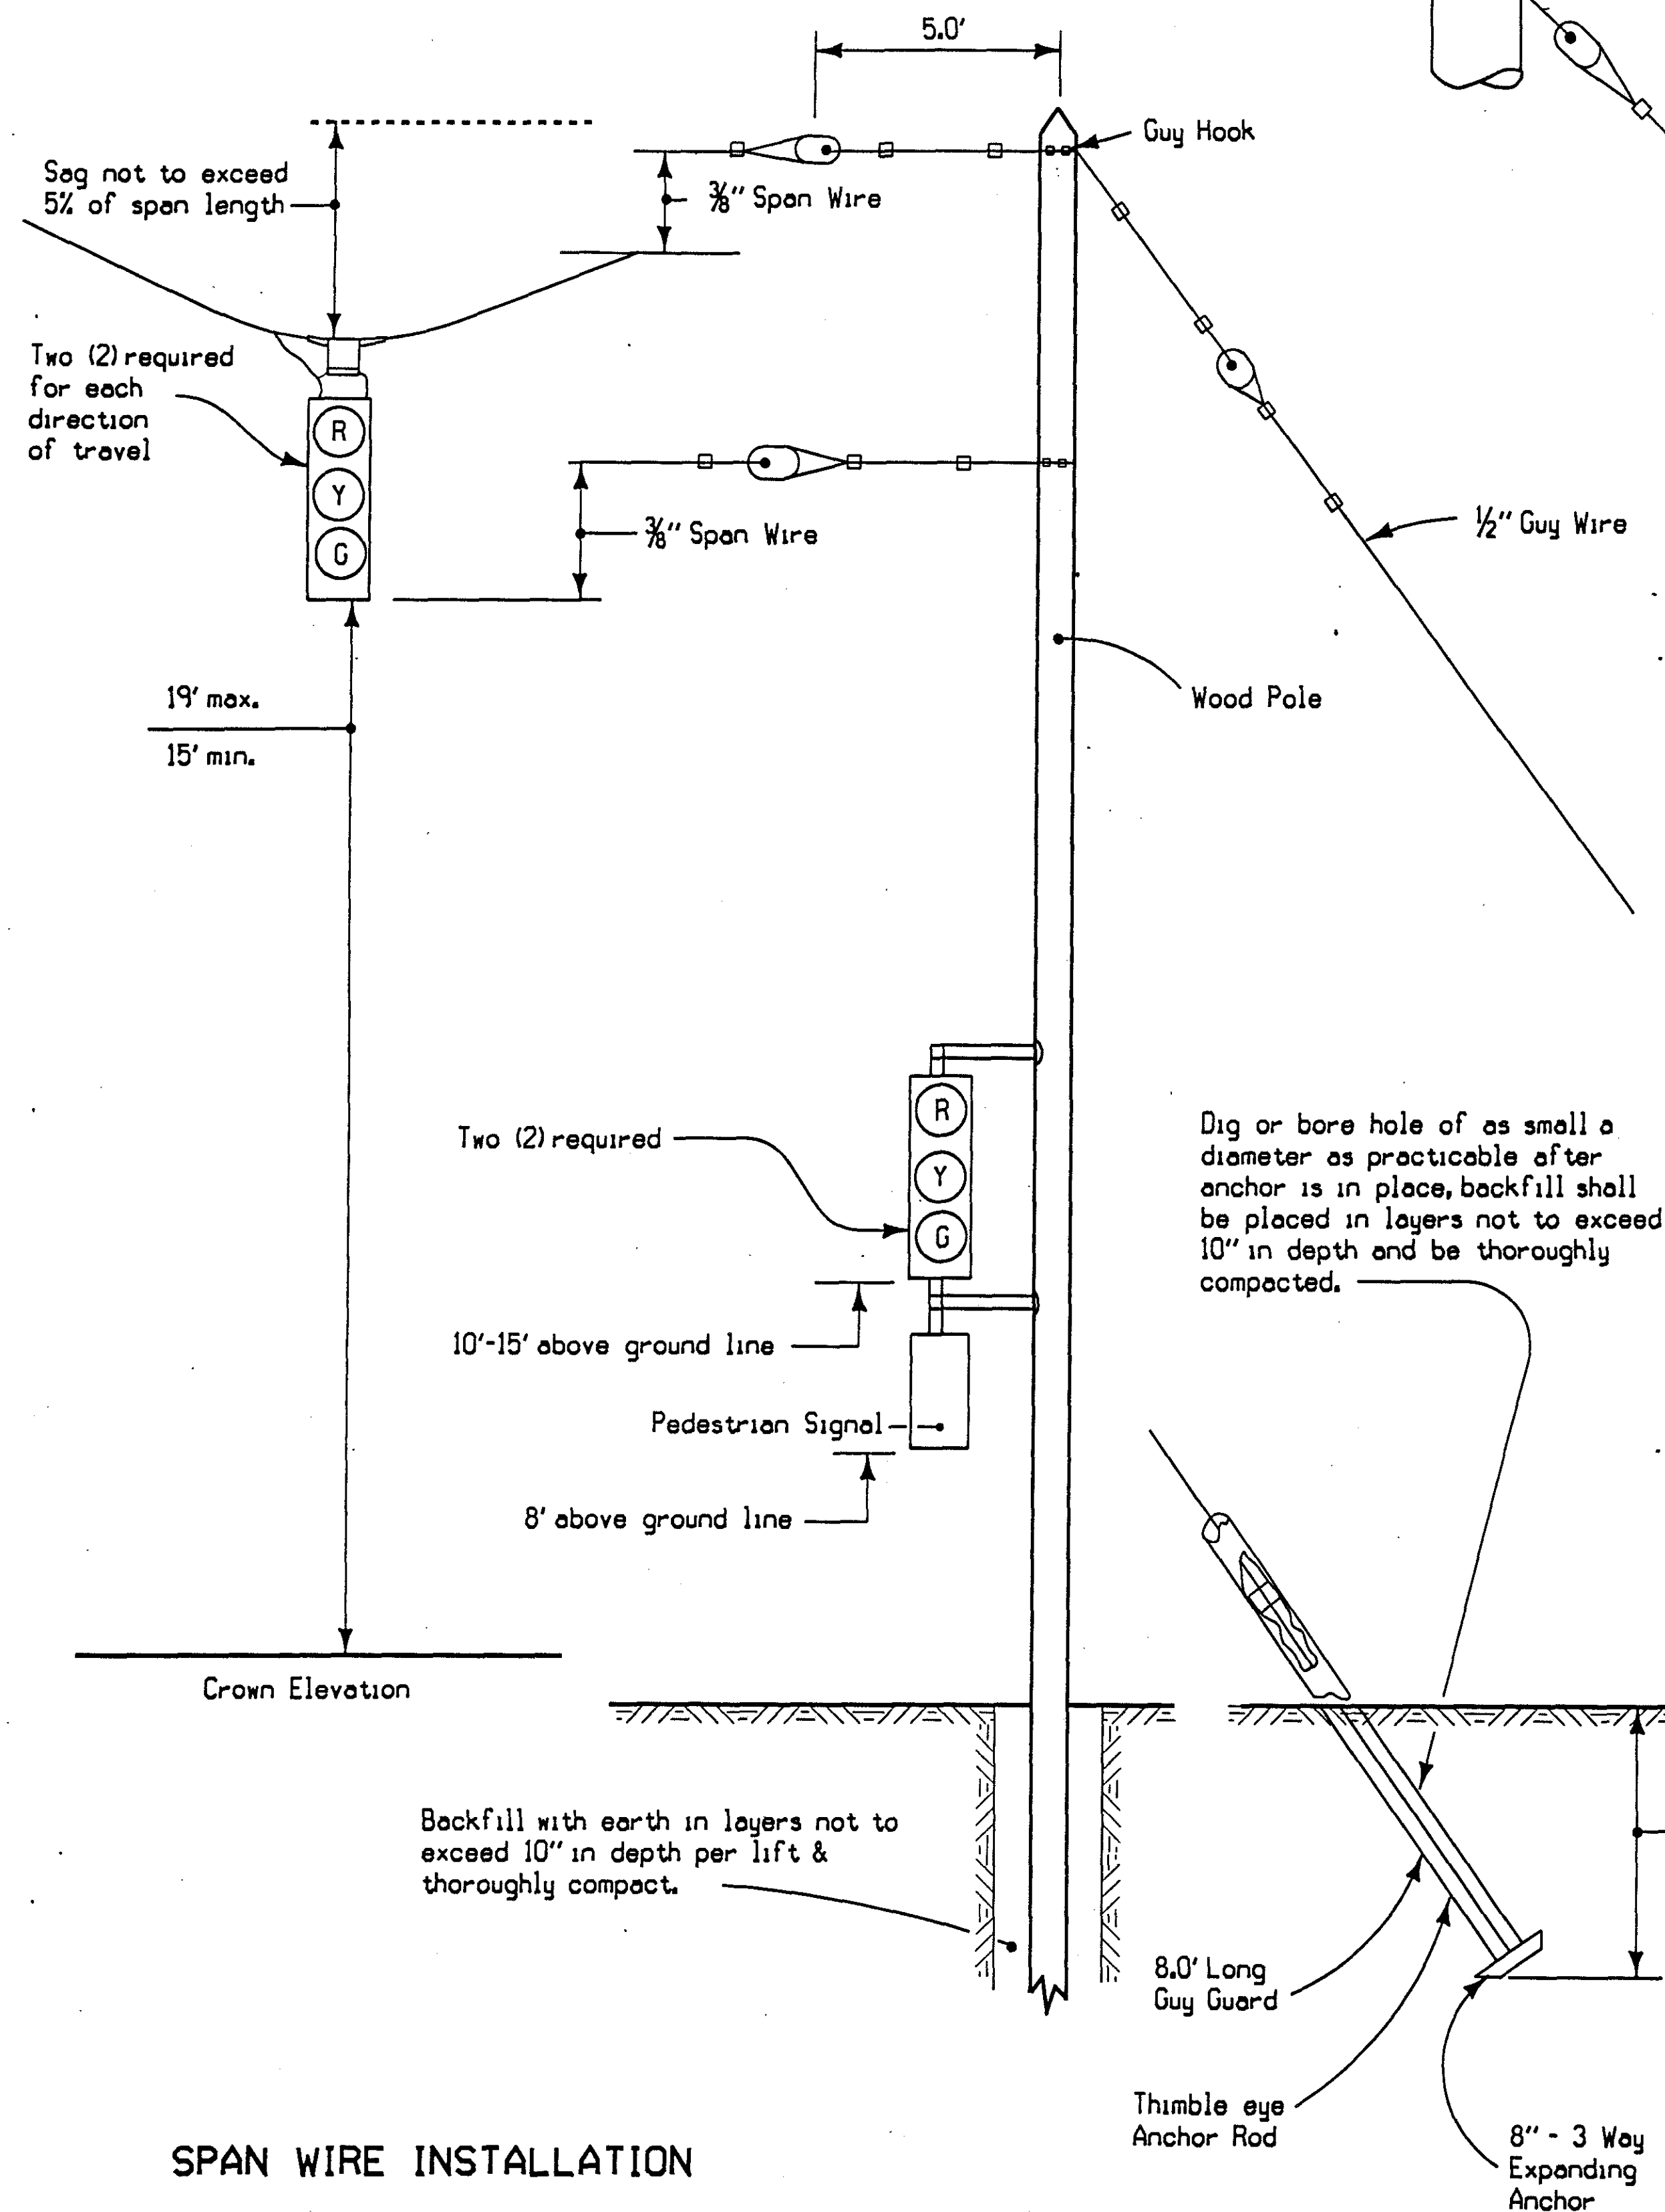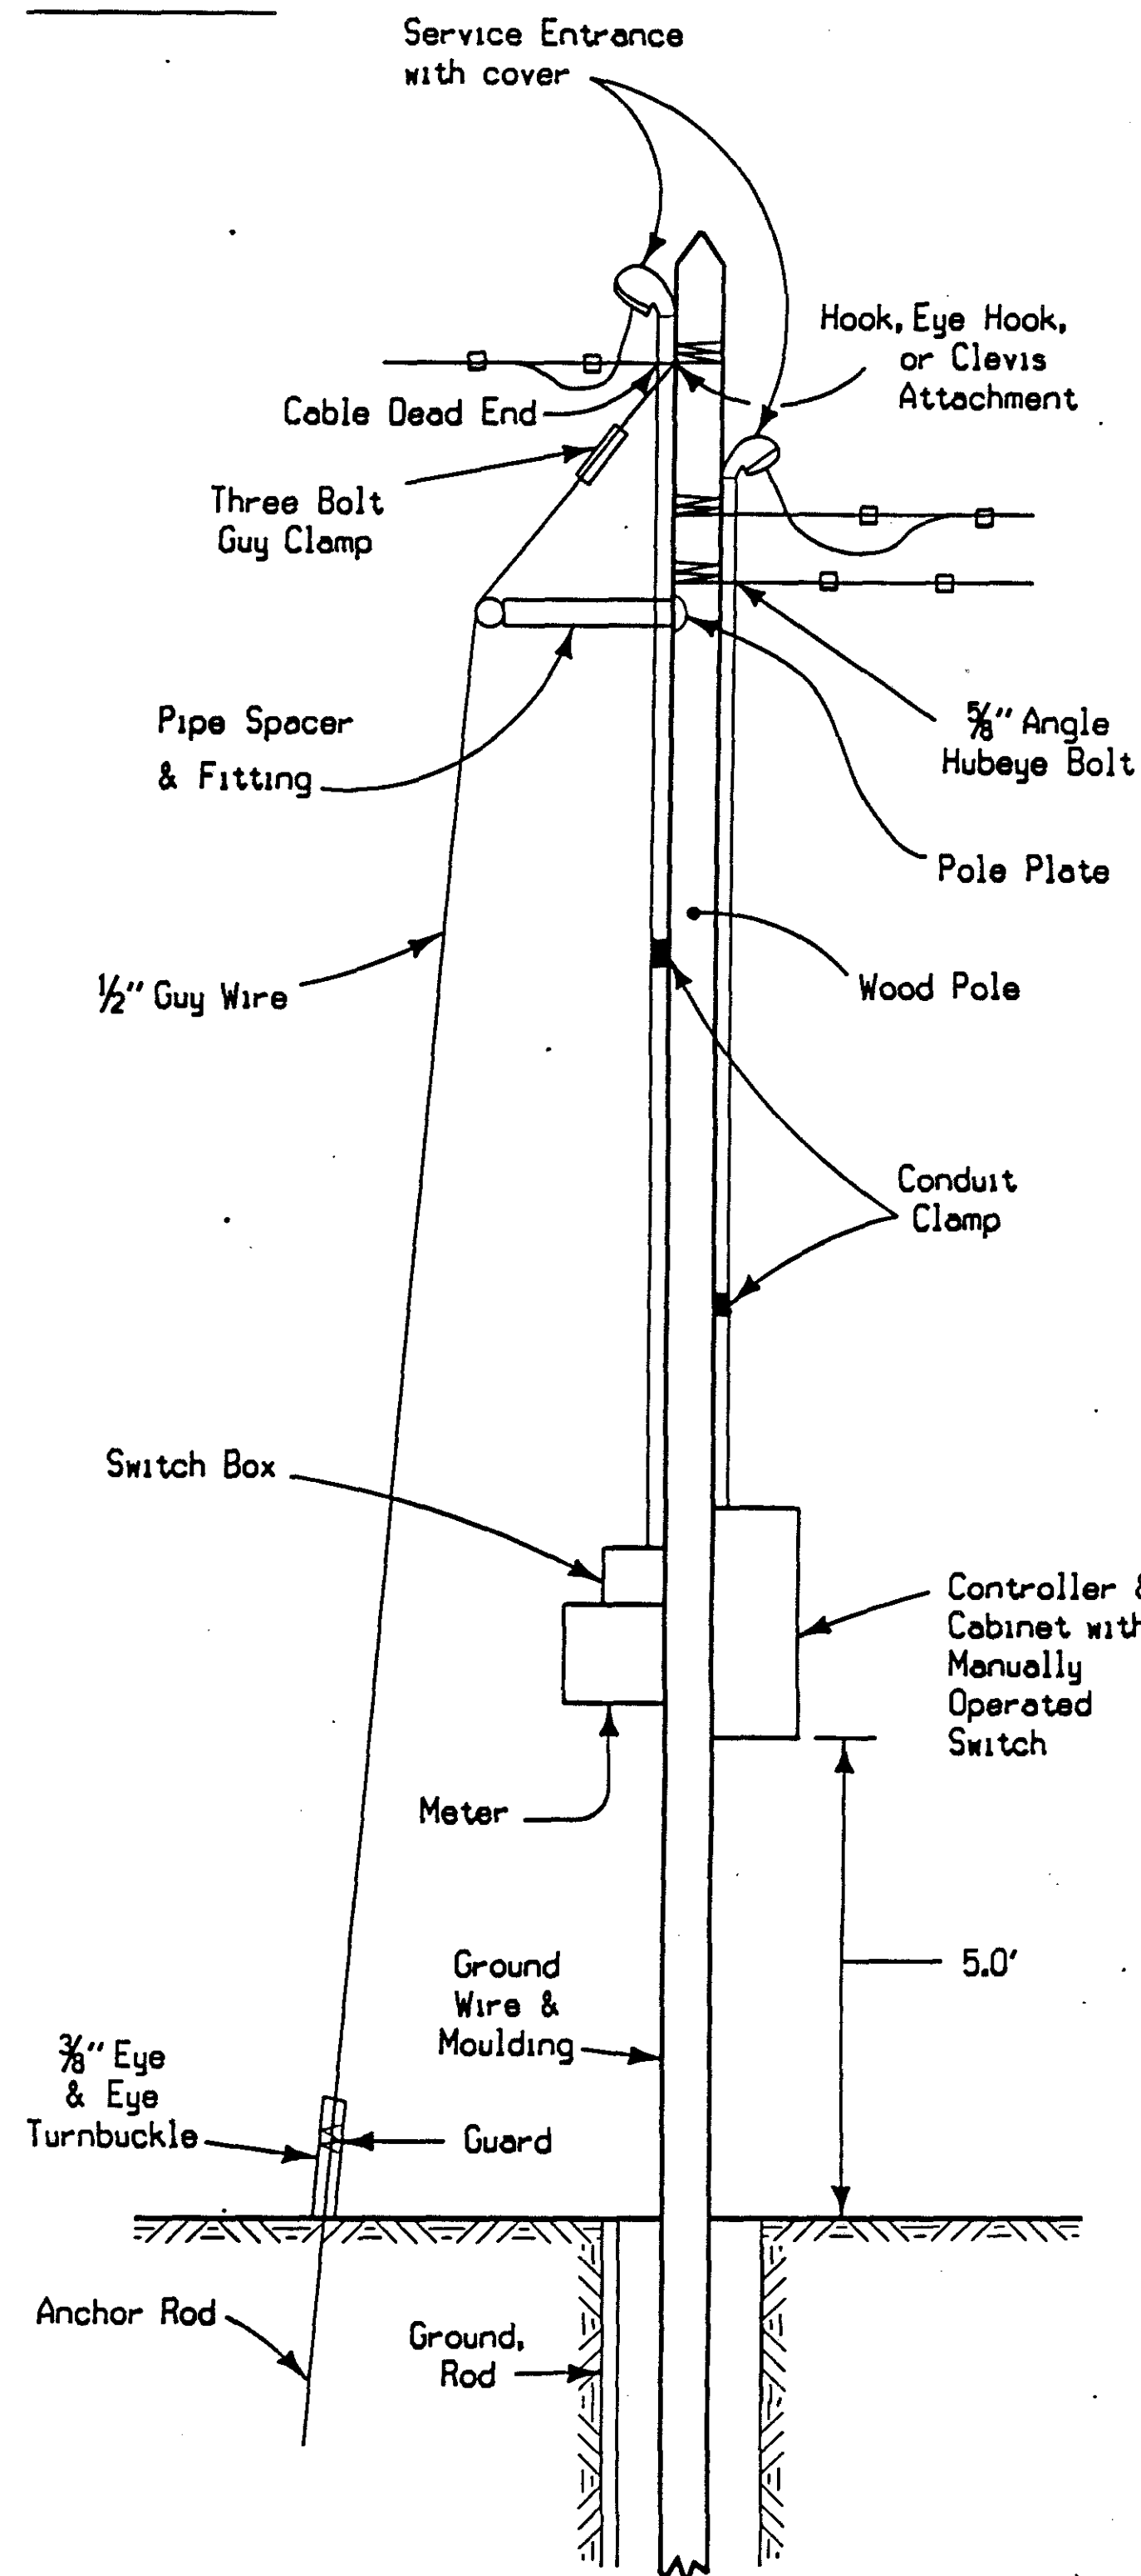

ALTERNATE METHOD OF MOUNTING

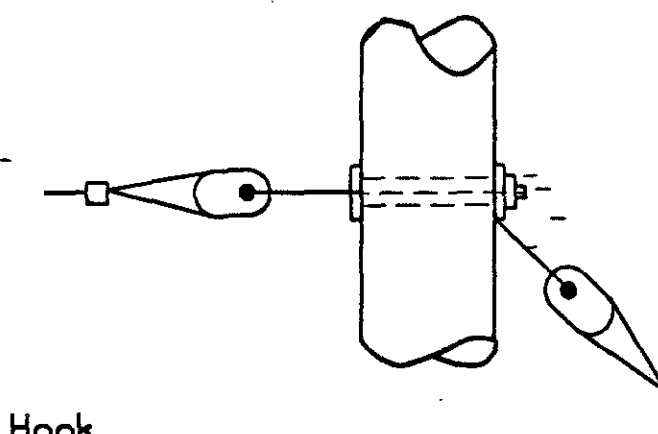

GENERAL NOTES:

The Engineer in charge of construction shall stake all locations for traffic signal poles to be installed. Final positions and pointing of signal faces to be determined in the field.

All traffic signal heads, brackets and controller cabinet to be painted traffic yellow, door and visor of signal heads to be painted flat black.

All wiring installed shall conform to the National Electrical Code and local ordinances and requirements.

All cable for intersection signal circuits shall be multi-conductor cable for operation of 600v max, and suitable for use at conductor temperatures not exceeding 75° C. Material, construction and tests shall be in accordance with the applicable requirements of I.P.C.E.A. S-19-81, I.P.C.E.A. S-16 402, I.M.S.A. 19, I.M.S.A. 20 or equivalent.

All signal cable and feeder runs to be carried overhead on span wire across roadways.

The operation and maintenance of the signal systems shall be the responsibility of the contractor.

All signal indications, clearances and sequences shall be in accordance with the current Manual on Uniform Traffic Control Devices.

The contractor shall be responsible for contacting utility companies for the location of any underground utilities.

The contractor will be responsible for contacting the local utility company to determine the location of the power connection. The contractor shall erect a maximum of two class 4 wood poles to help carry the aerial secondary cable to the controller. The pole locations will be determined by the utility company and the Engineer.

Pole heights for secondary power service shall provide a 30' mounting height and maintain a minimum clearance across roadway of 18'.

SPAN WIRE INSTALLATION

Iowa Department of Transportation Highway Division	
NO. 1	DATE 06-15-93
DETAIL SHEET 570-3	
TEMPORARY TRAFFIC SIGNALS SPAN WIRE INSTALLATIONS	

ROAD DESIGN • CADD • PRODUCED

STATE OF IOWA

FHWA REGION 7

FISCAL YEAR

Lin COUNTY

PROJECT NUMBER

NH3-100-1(23)-19-57

SHEET NUMBER


U.09

P. 136

HD-8
MODIFIED
2-5-91

NOTES:

1. For pipe placed under roadway pavement, granular backfill will be required as shown in the adjoining detail.
2. Granular backfill will be measured by the ton. The tonnage so measured will be computed using pay limits shown on this detail, based on 140 lbs. per cubic foot. Excavation and granular backfill outside the pay limits will be considered incidental.
3. If solid rock is encountered at the bedding elevation or within 6 inches below this elevation, excavation shall be carried 6 inches below the required elevation of the outside of the pipe, then backfilled with granular backfill material, and the bottom of the trench shaped as required for earth excavation.
4. If the pipe can not be bedded in firm earth, excavation shall be carried below the required elevation as directed by the Engineer, then backfilled with granular backfill material.

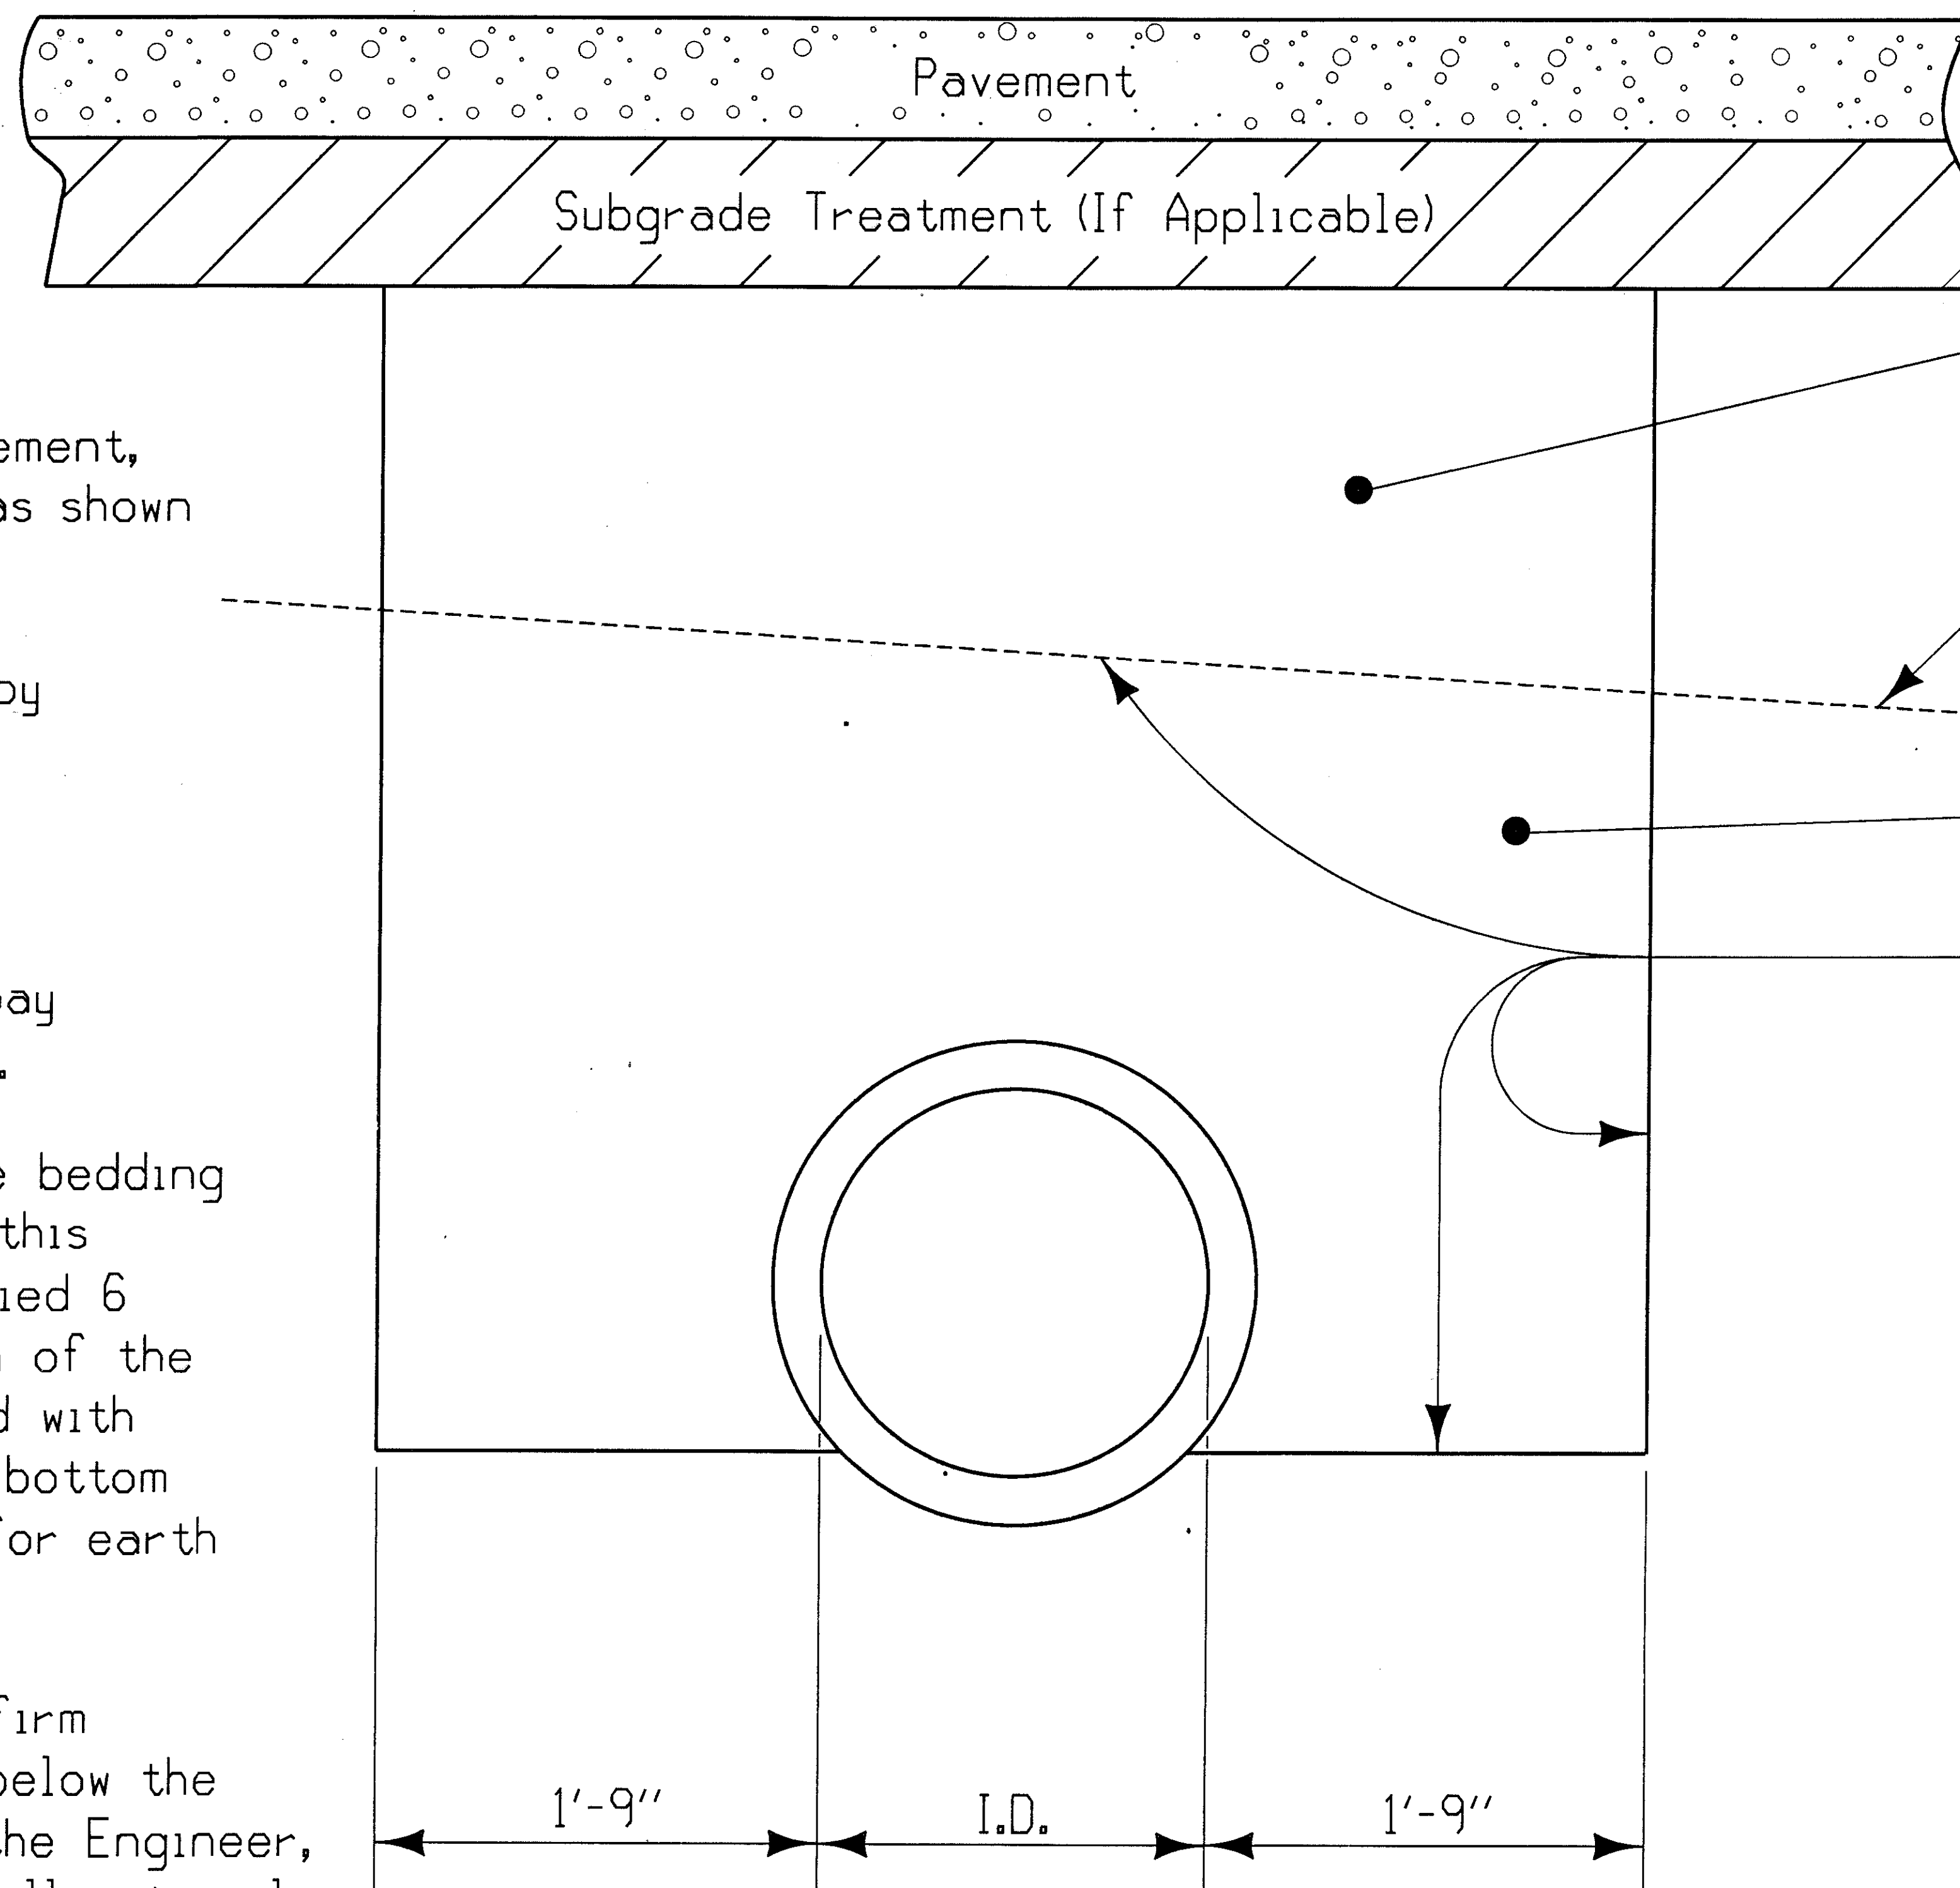


Granular Backfill
(Only if contractor
excavates through fill.
Contractor's cost
for backfill.)

Existing Grade
(where applicable)


Granular Backfill

Pay Limits
For
Granular
Backfill



DETAILS FOR GRANULAR BACKFILL ABOVE CROSS ROAD PIPE (Drainage, Storm & Sanitary) WHEN UNDER ROADWAY PAVEMENT



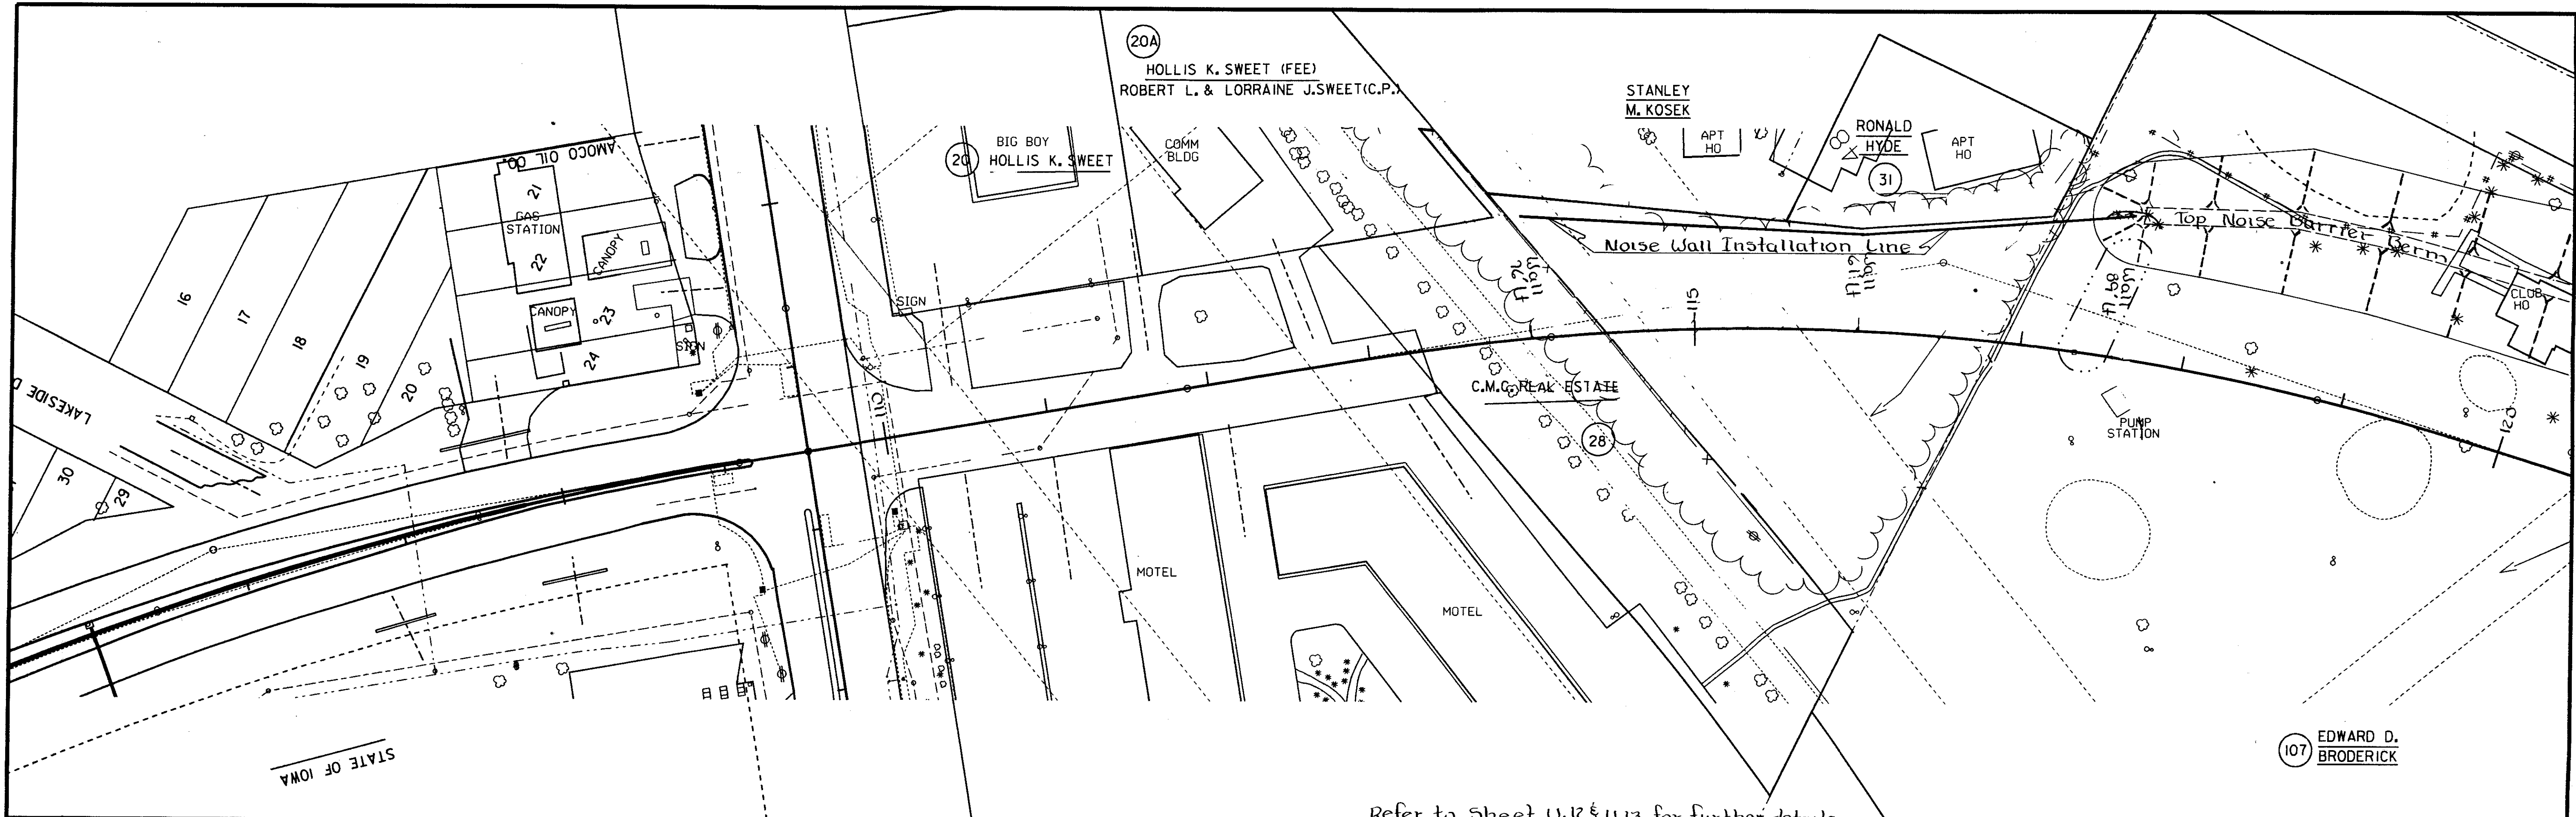


Refer to Sheet U.12 & U.13 for further details



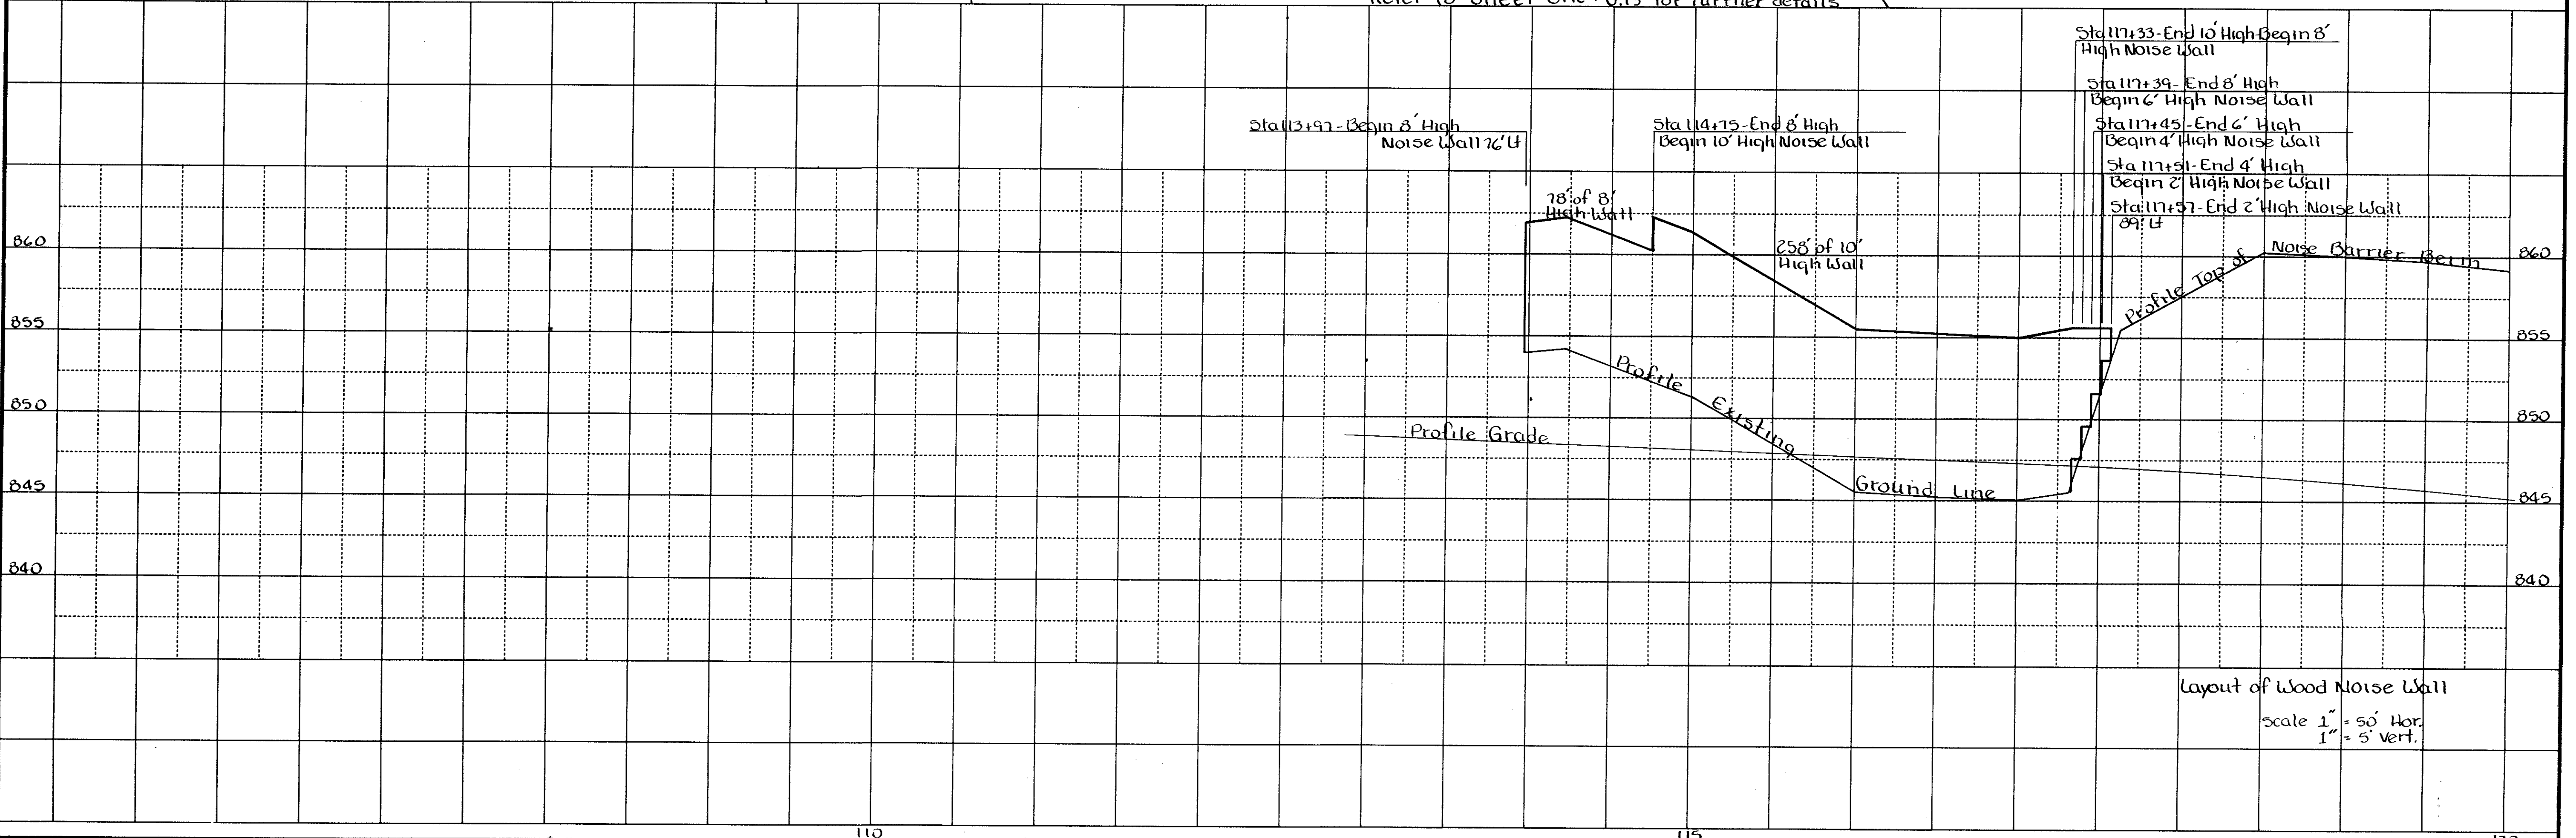


Layout of Wood Noise Wall
Scale 1" = 50' Hor.
1" = 5' Vert.

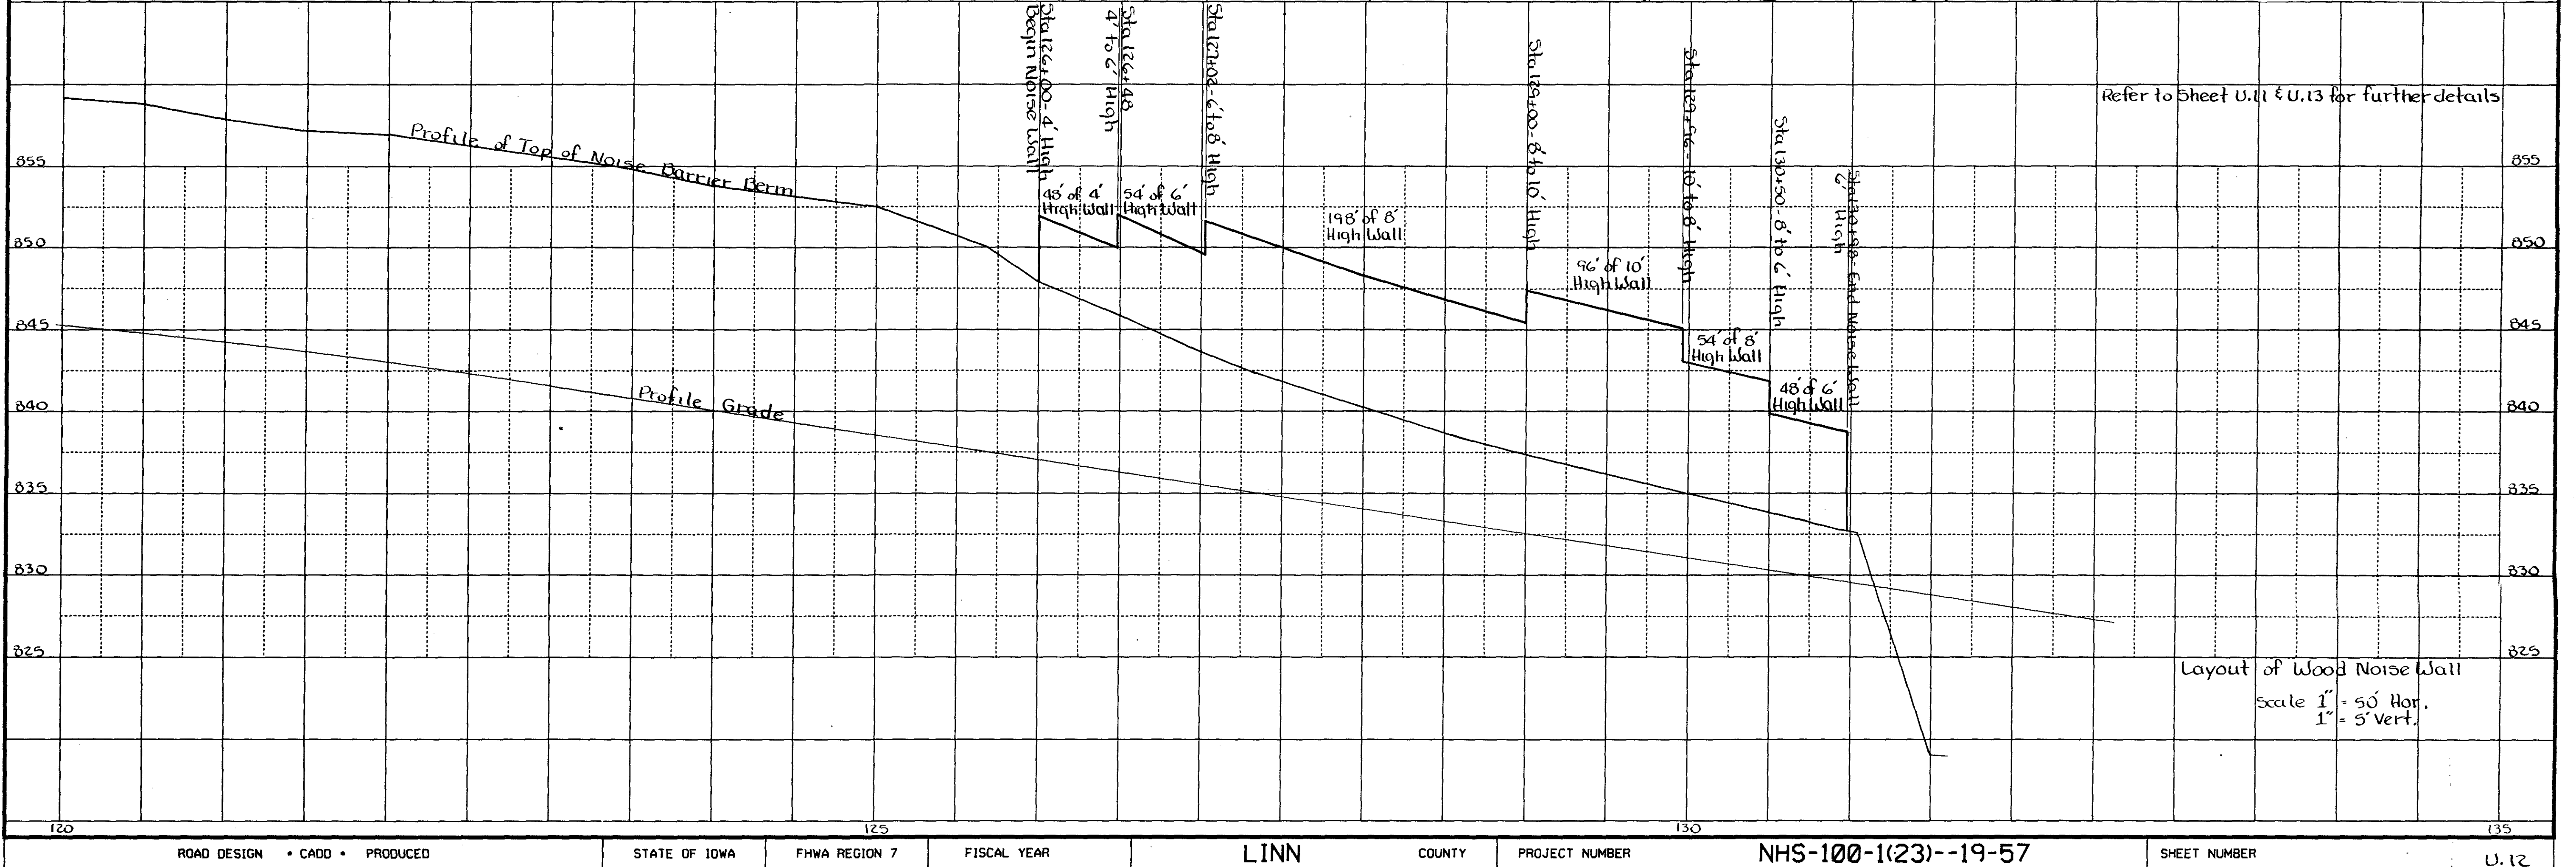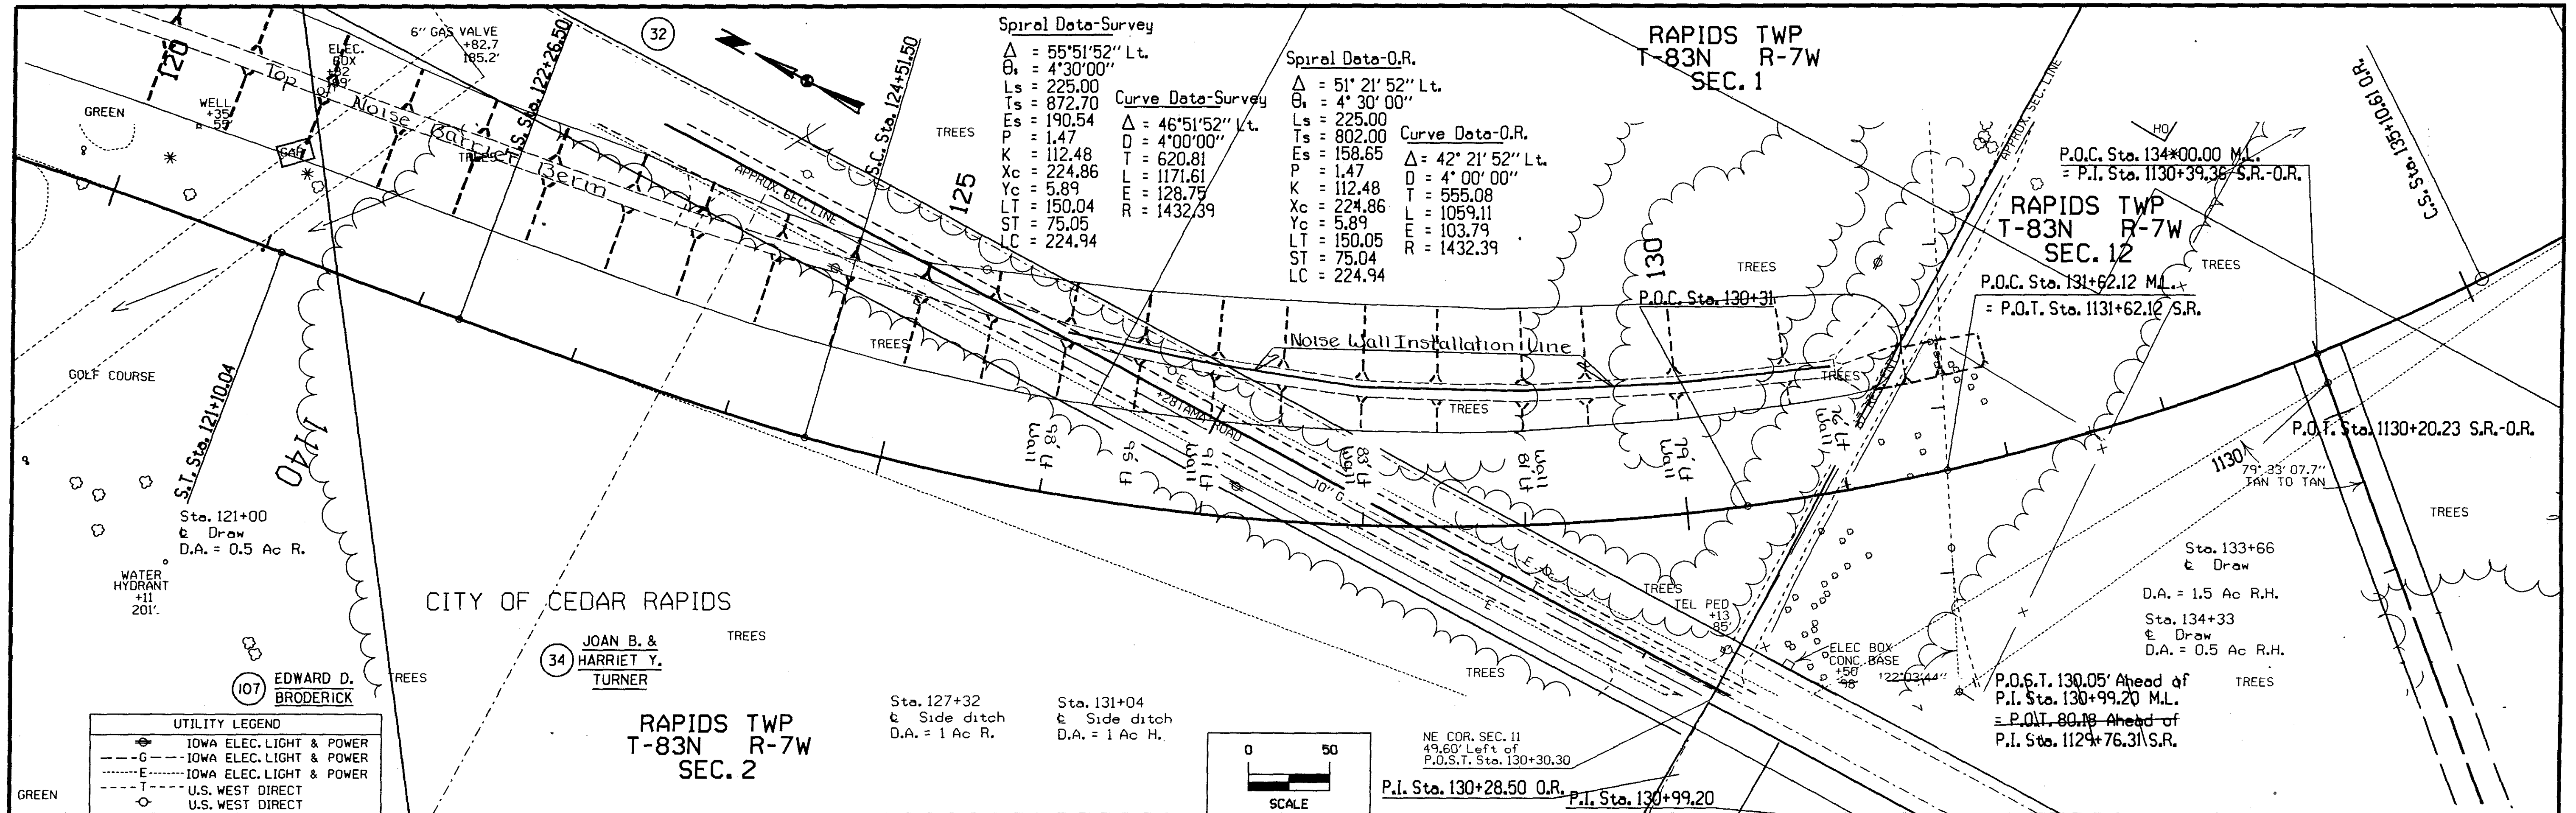

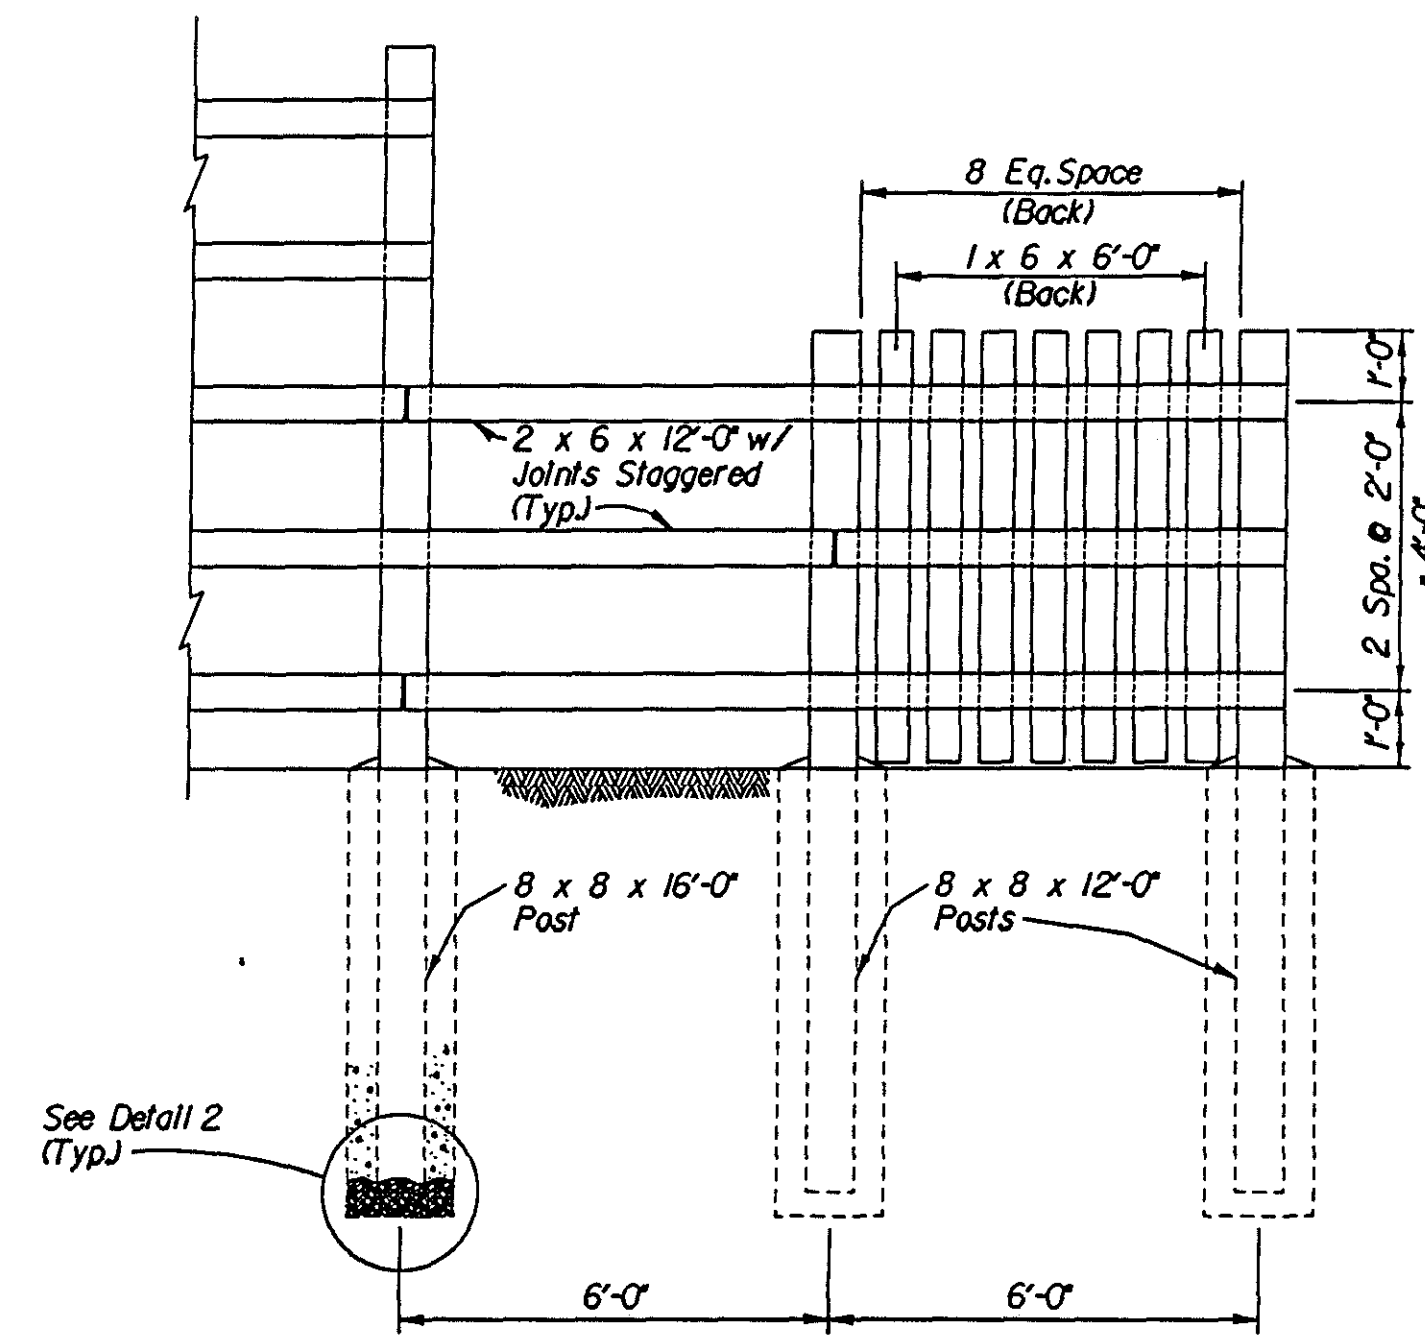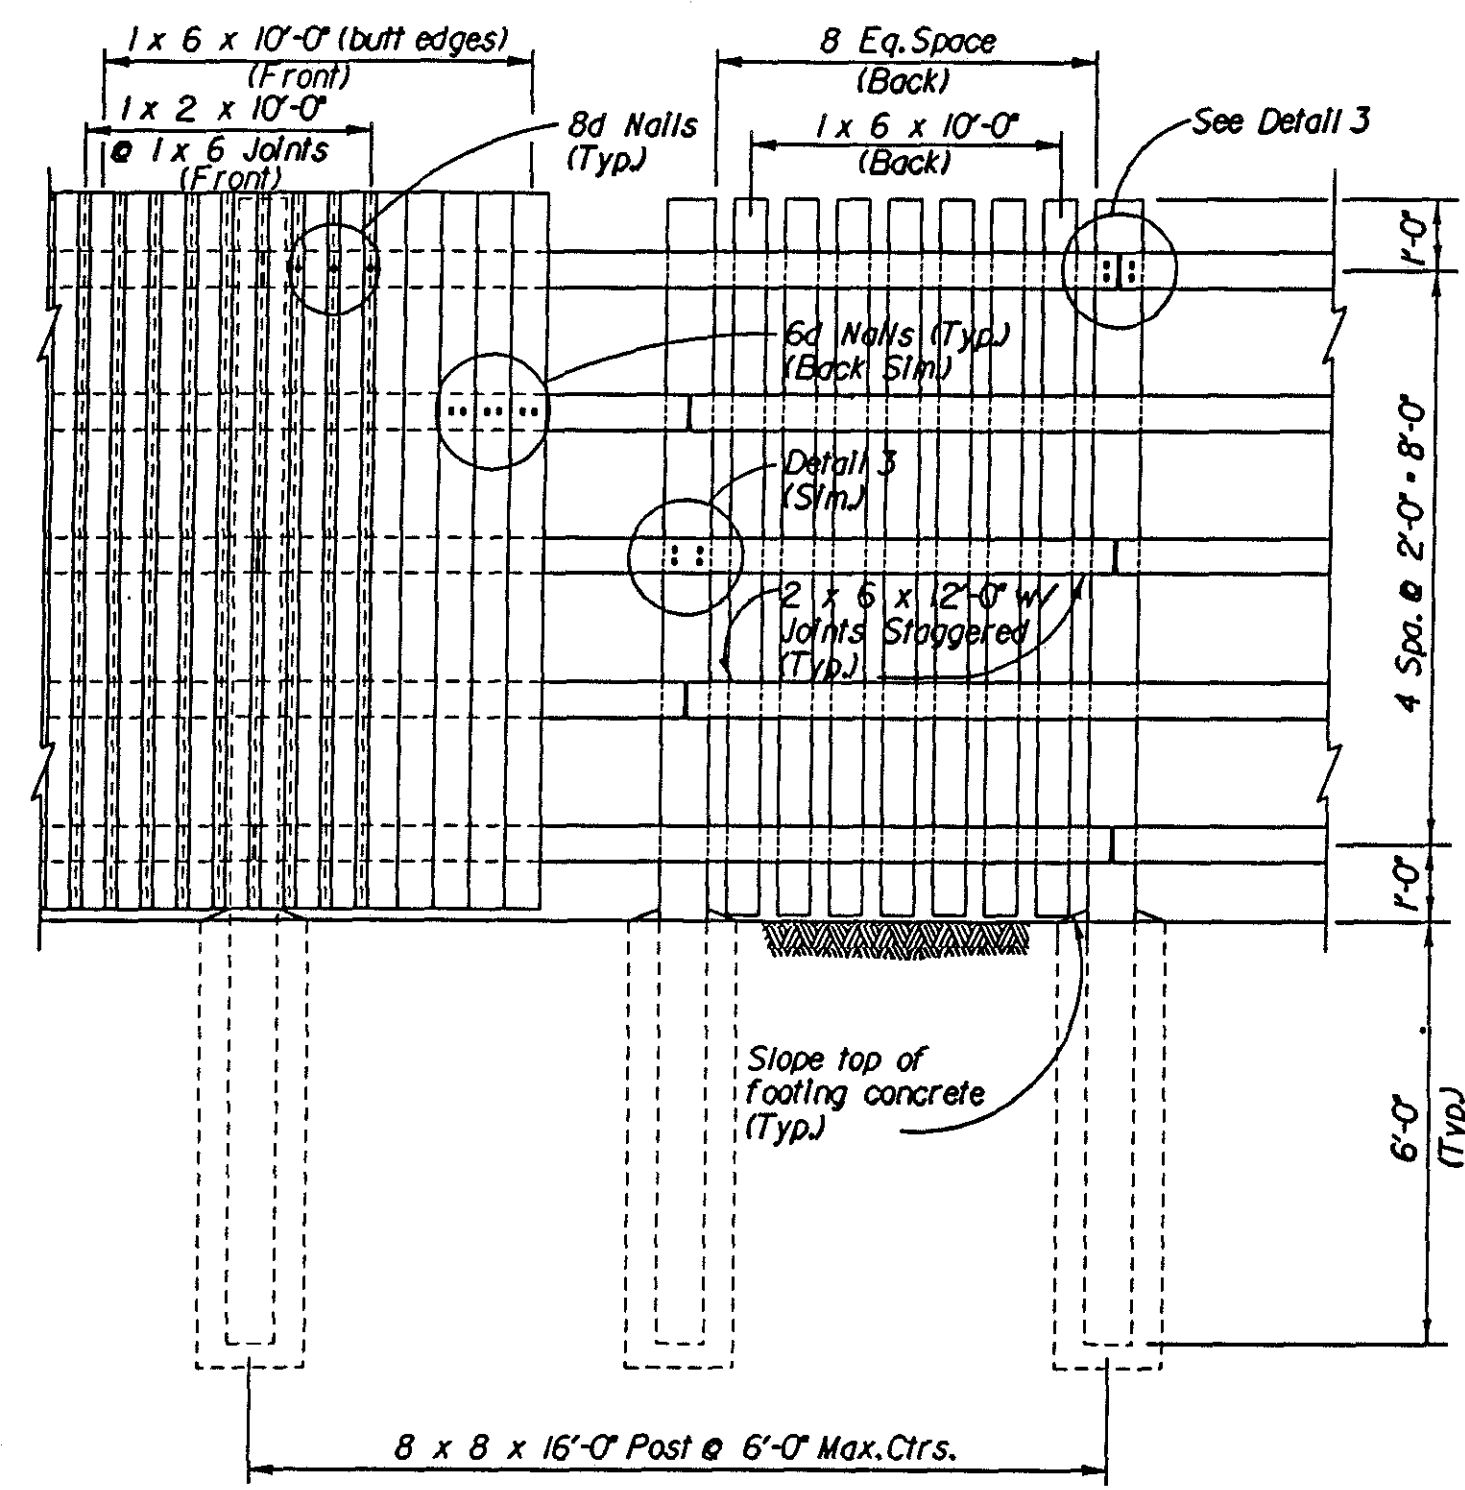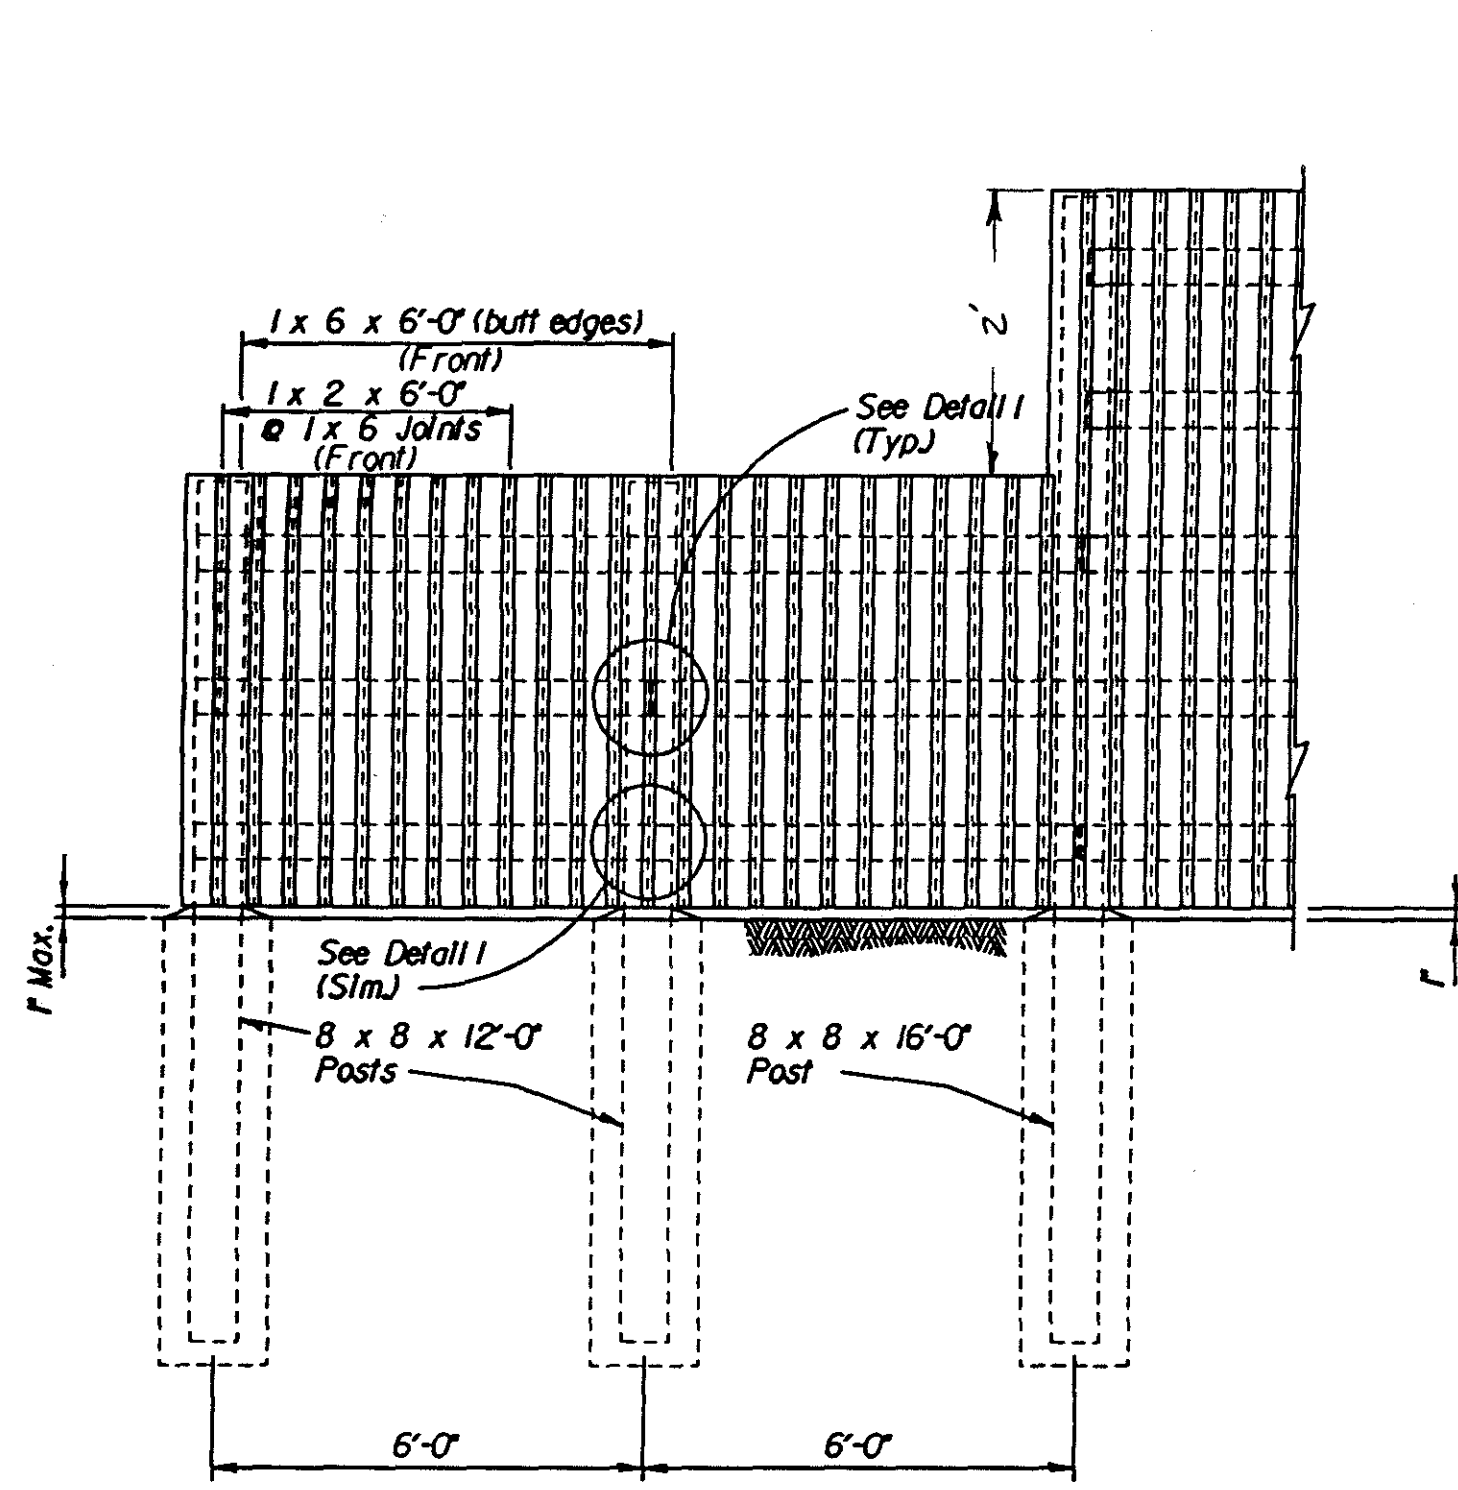

WOOD NOISE BARRIER WALL
SCALE: 3/8"=1'-0" (Roadway Side Shown)

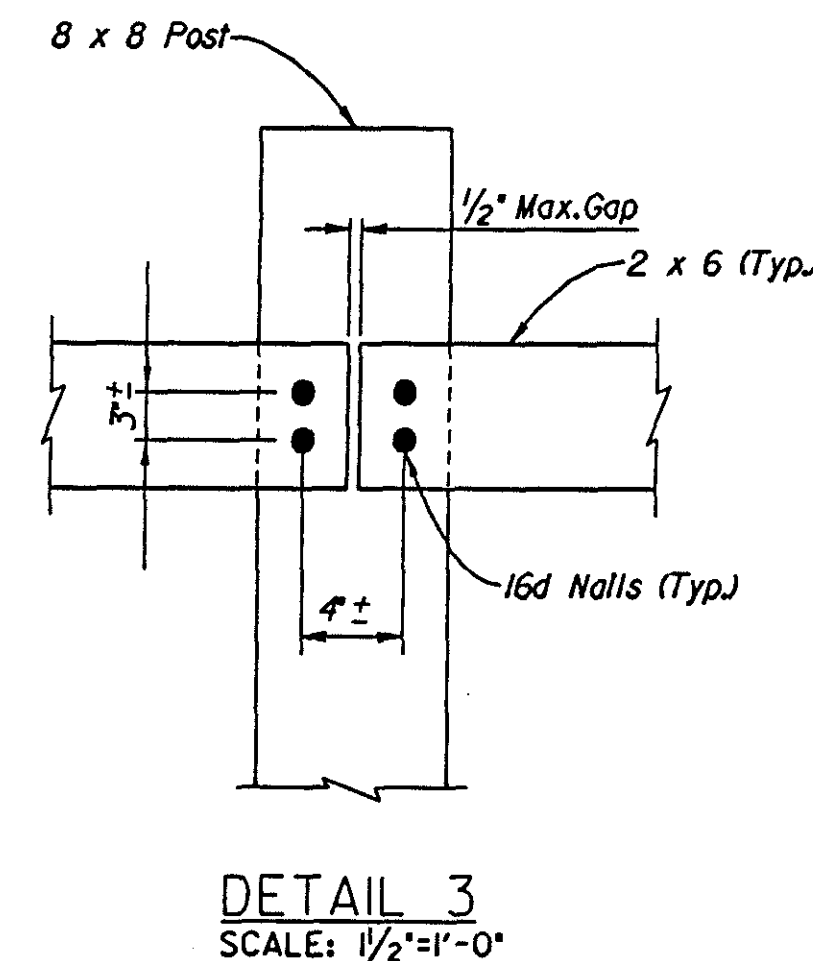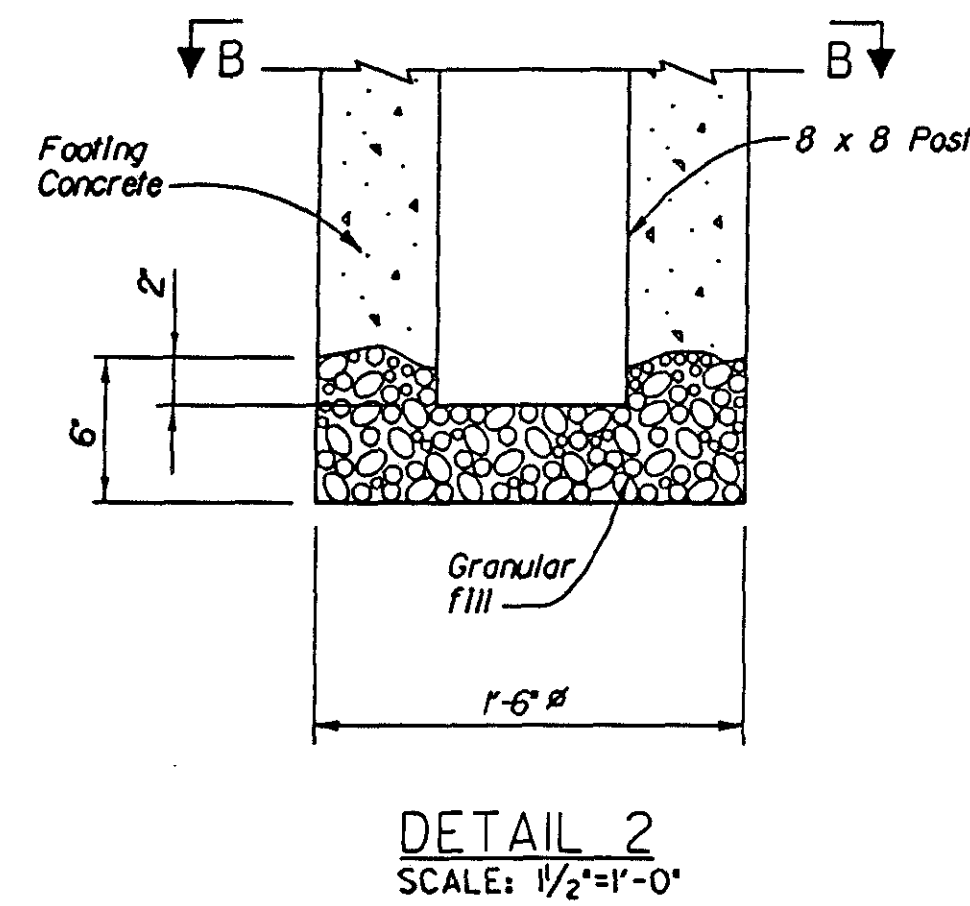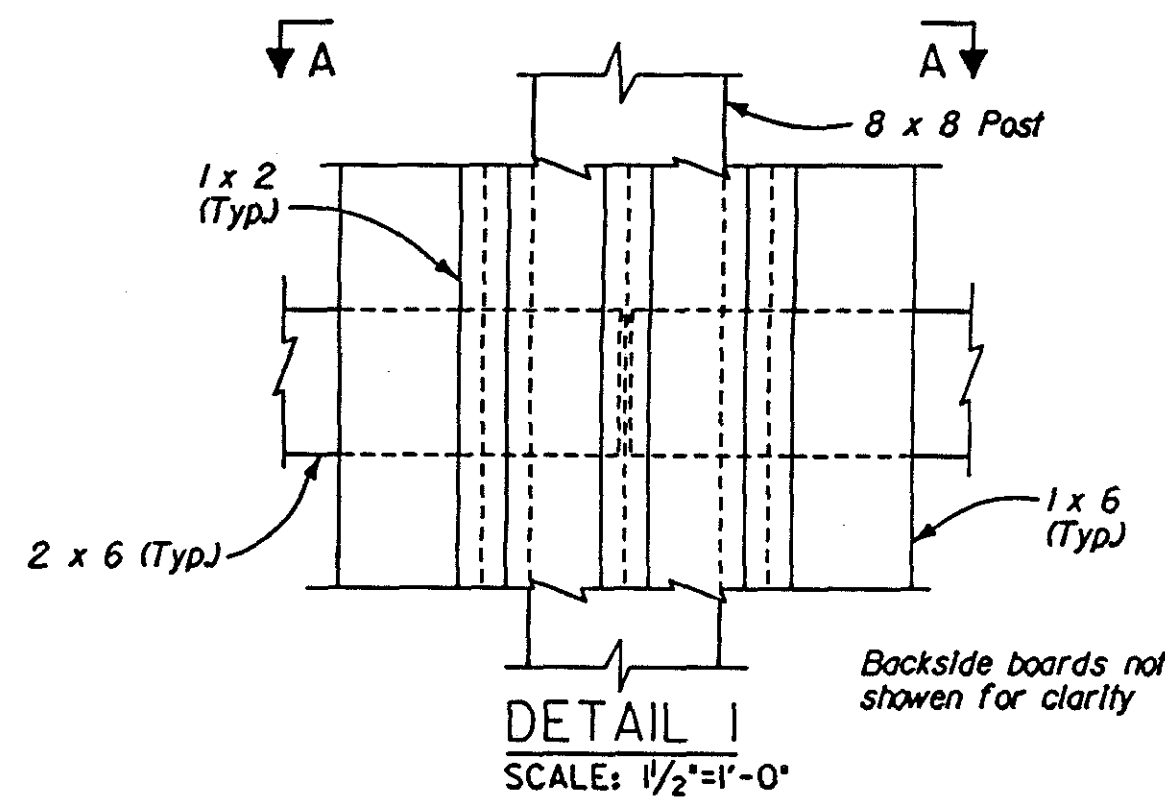

NOTES:


1. Boards (1" nominal) shall be No. 3 common grade, surfaced four sides (S4S).
2. Lumber (2" nominal) shall be No. 2 or better grade, surfaced four sides (S4S).
3. Posts (8" nominal) shall be No. 2 or better SR grade, roughsawn.
4. Boards, lumber and posts shall be southern yellow pine, and shall be pressure treated with CCA preservative in accordance with materials section 4161 in the standard specification.
5. Manually driven nails shall be double hot dip galvanized box nails. Pneumatically driven nails shall be aluminum box nails.
6. In order to maintain integrity of CCA preservative treatment, the ends of 8x8 posts shall not be cut.
7. Granular backfill material shall be in accordance with materials section 4133 in the standard specification.
8. Footing concrete shall be type C and in accordance with section 2403 in the standard specification.
9. Top of noise wall shall follow the slope of the ground.
10. Each end of noise wall shall be stepped as shown.
11. A post is required at locations of wall angle points and at wall termination points.

Refer to Sheet U.11 & U.12 for Layout


WOOD NOISE WALL DETAILS

P:\E:\d\dotus20\dgn\hwall.u08.dgn
DATE: 5-Oct-94 07:30

STATE OF IOWA	FHWA REGION 7	FISCAL YEAR		Linn COUNTY	PROJECT NUMBER	NH5-100-1(23)-19-57	SHEET NUMBER	U.13
---------------	---------------	-------------	--	-------------	----------------	---------------------	--------------	------

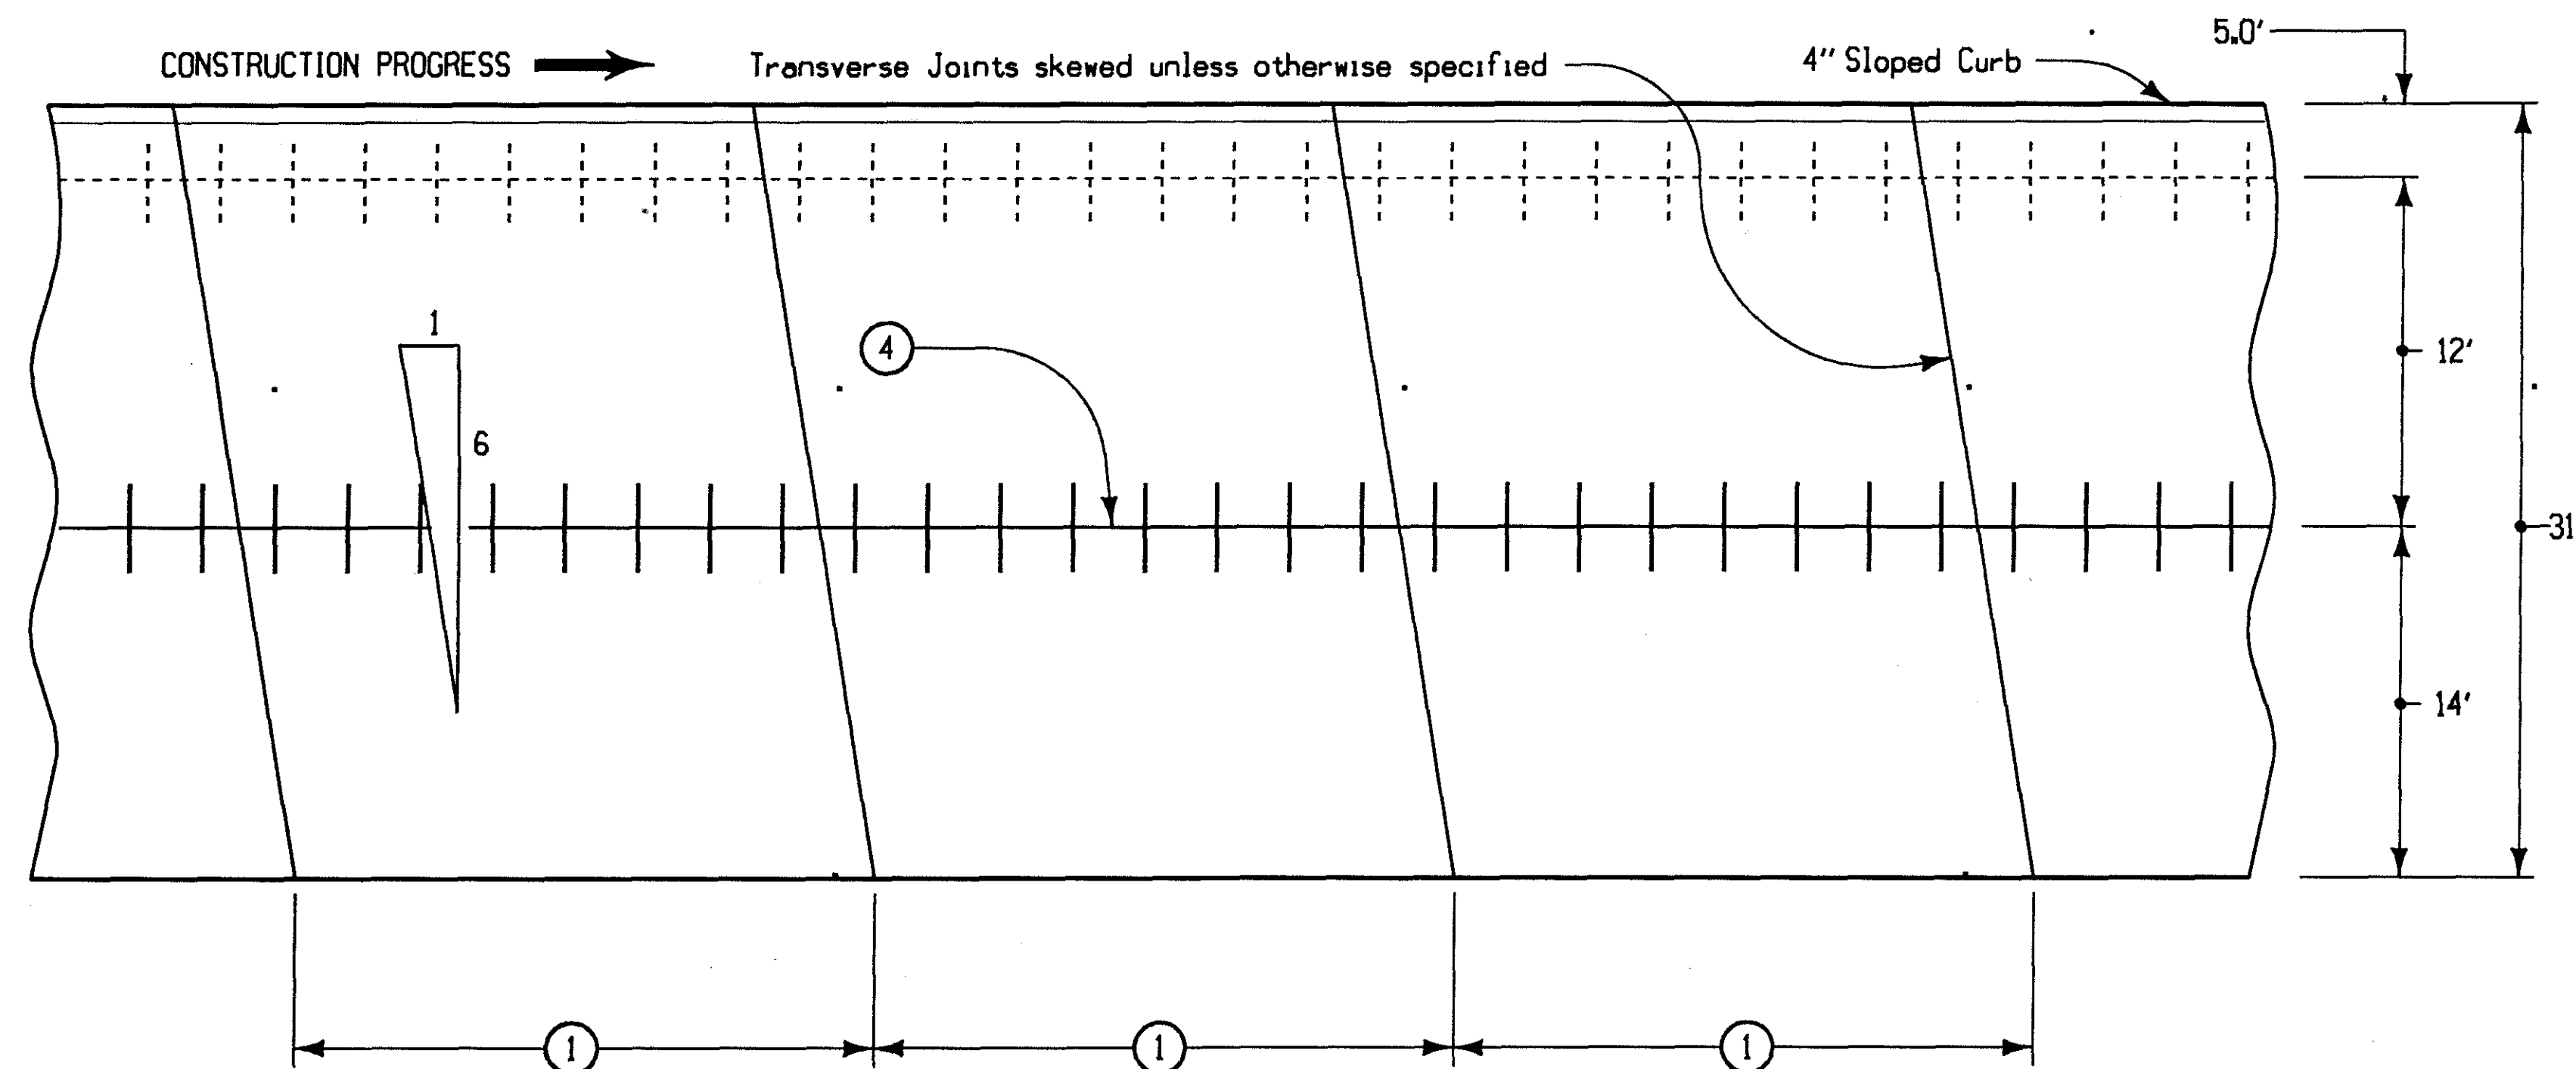

TYPICAL PAVEMENT PLAN

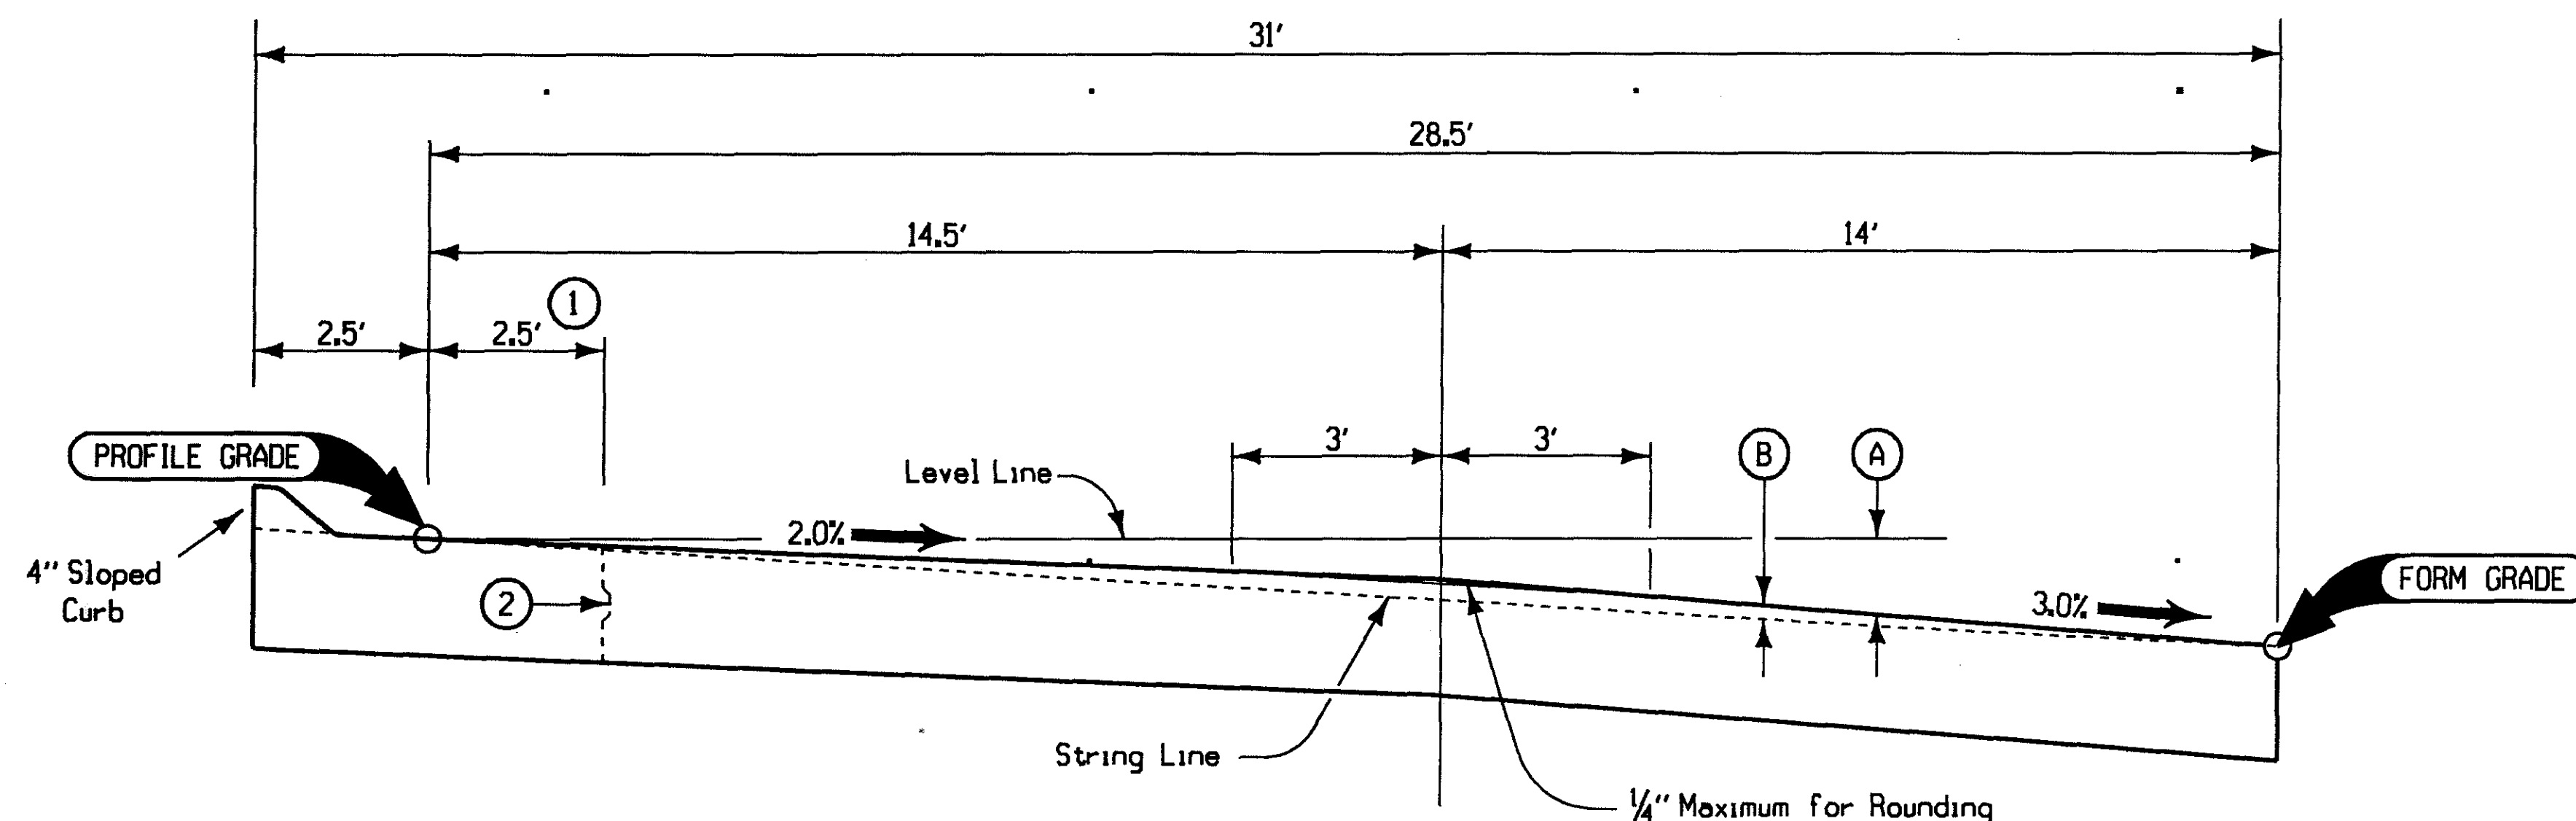

TYPICAL CROSS SECTION

GENERAL NOTES:

Details indicated on this plan are intended to illustrate the general requirements for Two-lane P.C. Concrete Pavements 28.5' in width. Unless specifically authorized otherwise the methods and materials used in the construction of this pavement shall be in conformance with current specifications for Portland Cement Concrete Pavement. Refer to individual project plans for specific dimensional requirements and other details of pavement construction.

Refer to Standard Road Plans RH-50, 51 and 52 for details of construction of joints in pavement. Joint layout shall be skewed as shown, 6:1 right ahead except at pavement intersection areas and other locations specifically designated by the engineer. End of day's work joint and joint at bridge approach section shall be constructed perpendicular to center line. Transverse Joints will be 'CD' except when 'C' joints are specifically required as a part of detail project plans or when T is less than 8'.

Normal crown shall be a straight line sloped from the profile grade for the distance and rate indicated. This crown may be varied through superelevated curves and intersection areas where special shaping is required or other areas specifically authorized by the engineer.

The dimensions shown are for the purpose of defining the surface of the proposed pavement. This surface may be tilted with respect to a level line. Refer to typical section and/or Resident Construction Engineer's large scale layout for specific details and form grade elevations.

The price bid for "Standard or Slip-Form PCC pavement" class and thickness as specified, in sq. yds. including all required joints, shall be considered full compensation for the construction of pavement as detailed hereon.



- ① Transverse joint spacing (normal) 20' for 'CD' joint (no dowels in outside 2.5' of pavement). 15' for 'C' joint.
- ② Optional: 'BT-1' Joint if pavement is less than 8". 'KT-2' Joint, if pavement thickness is 8" or greater.
- ③ Quantities include 4" sloped curb.
- ④ Joints will be:
'L-1' or 'BT-1' for T less than 8".
'L-2' or 'KT-2' for T greater or equal to 8".

PER STATION DESIGN VALUES FOR (28.5' B-B) PAVEMENT SECTION ③			
	ITEM	UNIT	T=10"
REFER TO SPEC. TYPICAL #1 (ON SHEET B.01)	Section Area	Sq. Ft.	25,888
	Concrete Volume	Cu. Yds.	96,451
	Surface Area	Sq. Yds.	344,444

Distance From Profile Grade		OFFSETS FOR 28.5' PAVEMENT WITH 4" SLOPED CURBS																												
		0.5'	1.5'	2.5'	3.5'	4.5'	5.5'	6.5'	7.5'	8.5'	9.5'	10.5'	11.5'	12.5'	13.5'	14.5'	15.5'	16.5'	17.5'	18.5'	19.5'	20.5'	21.5'	22.5'	23.5'	24.5'	25.5'	26.5'	27.5'	28.5'
A	Inches	1/8	3/8	5/8	7/8	1 1/8	1 1/4	1 1/2	1 3/4	2 1/8	2 1/4	2 1/2	2 3/4	3	3 1/4	3 1/2	3 3/4	4	4 1/4	4 1/2	4 3/4	5	5 1/4	5 1/2	5 3/4	6	6 1/4	6 1/2	6 3/4	7
	Feet	0.01	0.03	0.05	0.07	0.09	0.11	0.13	0.15	0.17	0.19	0.21	0.23	0.25	0.27	0.29	0.32	0.35	0.38	0.41	0.44	0.47	0.50	0.53	0.56	0.59	0.62	0.65	0.68	0.71
B	Inches	—	1/16	1/8	3/16	1/4	5/16	3/8	7/16	1/2	5/8	3/4	7/8	1	1 1/8	1 1/4	1 1/2	1 3/4	1 7/8	2	2 1/8	2 1/4	2 1/2	2 3/4	2 7/8	3	3 1/8	3 1/4	3 1/2	3 3/4
	Feet	0.002	0.007	0.012	0.017	0.022	0.027	0.032	0.037	0.042	0.047	0.052	0.056	0.061	0.066	0.071	0.076	0.081	0.086	0.091	0.096	0.101	0.106	0.111	0.116	0.121	0.126	0.131	0.136	

NON-REINFORCED FOUR LANE
28.5' P. C. CONCRETE PAVEMENT
DIVIDED ROADWAY

BENCH MARK NO. 305, STA. 152+50 = 112' L.T. (JUNE, 1989 SURVEY), SET R.R. SPK. IN N.W. SIDE 24" LOCUST, EL. 766.15.

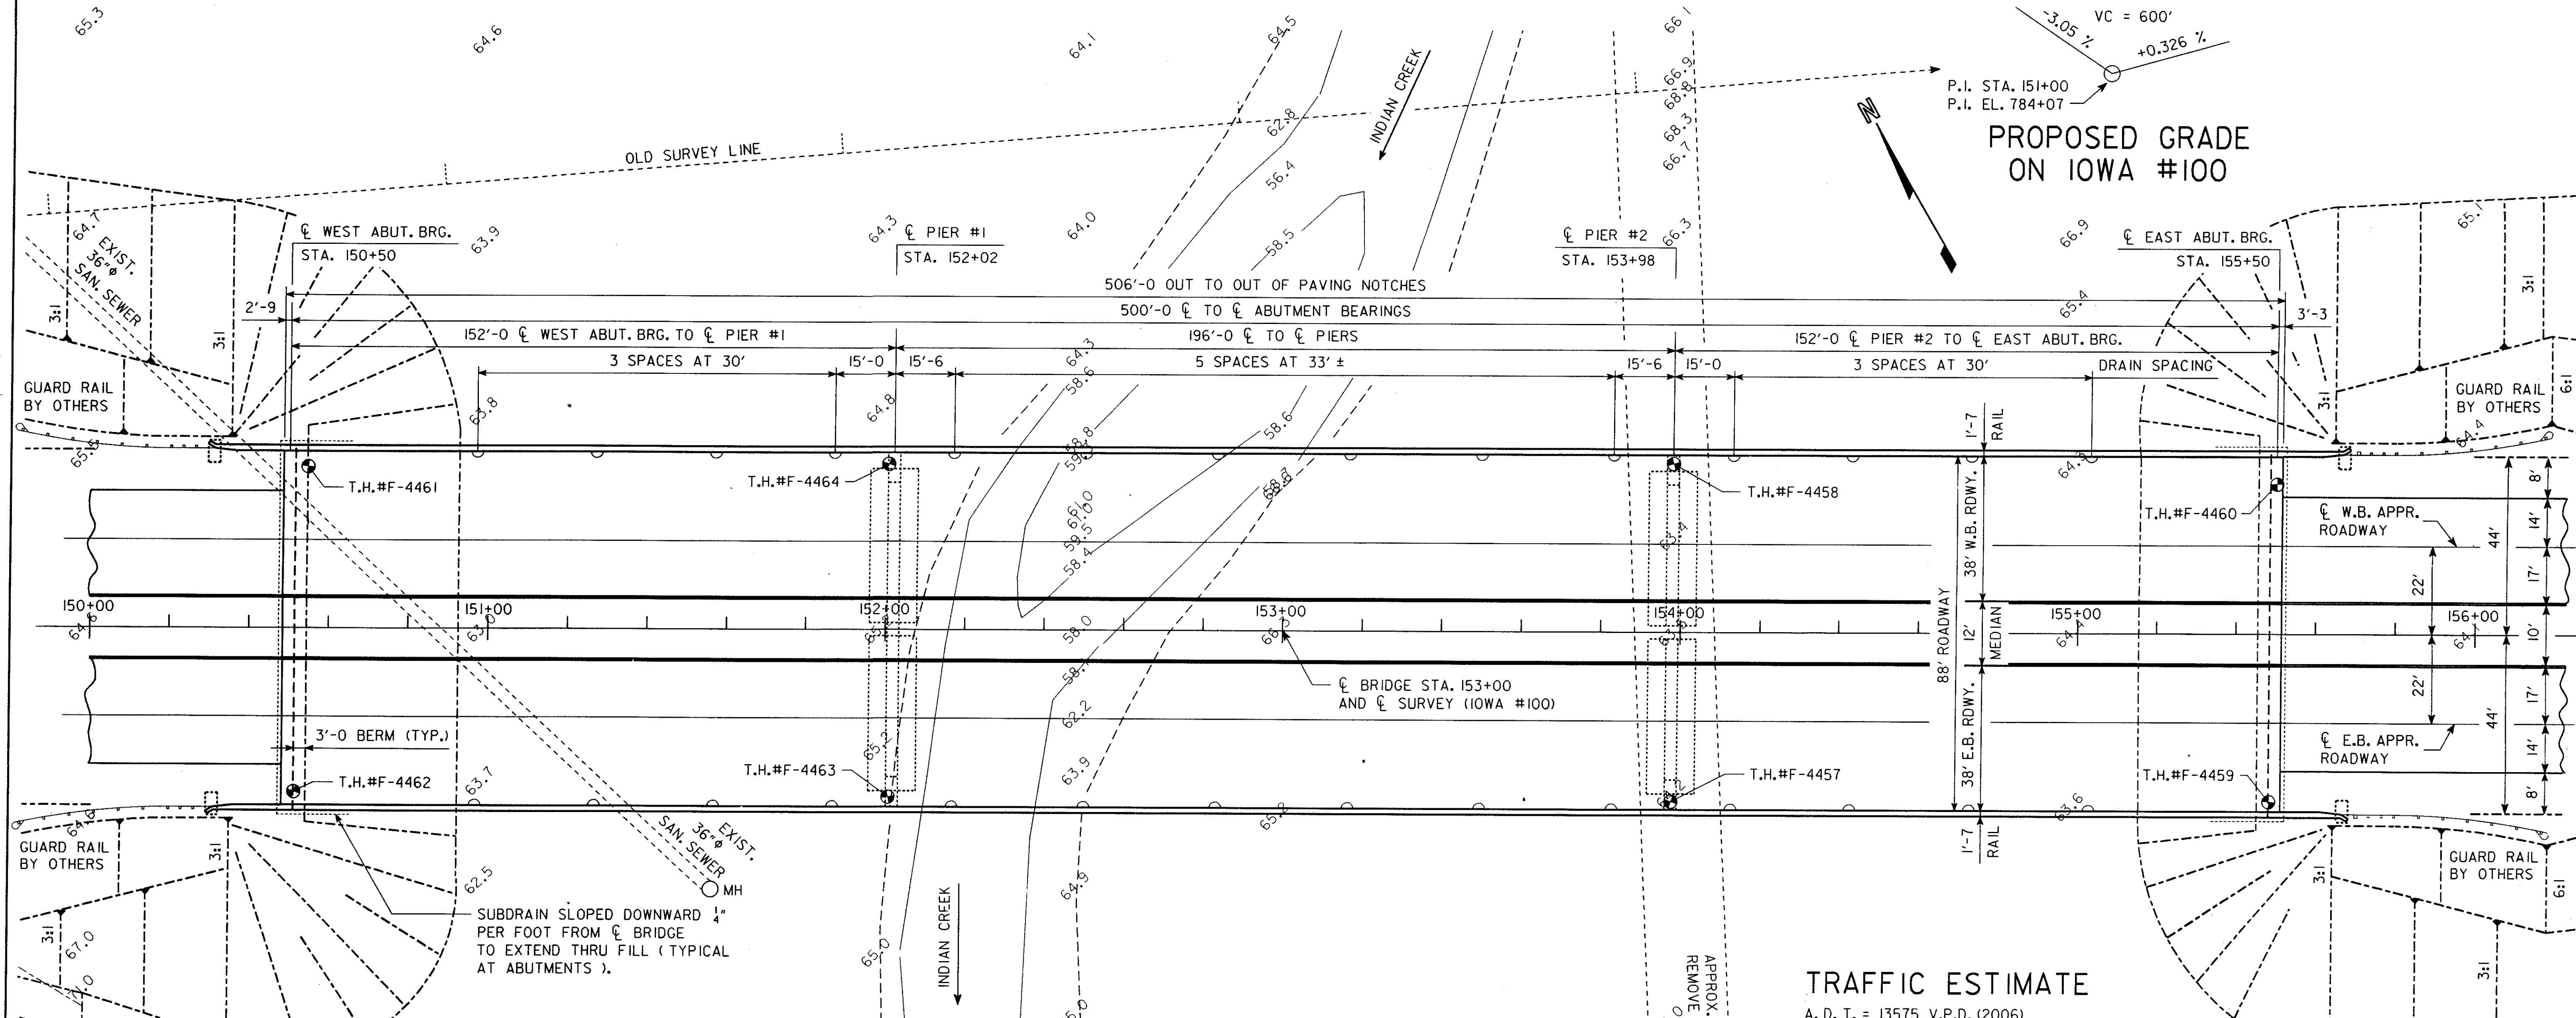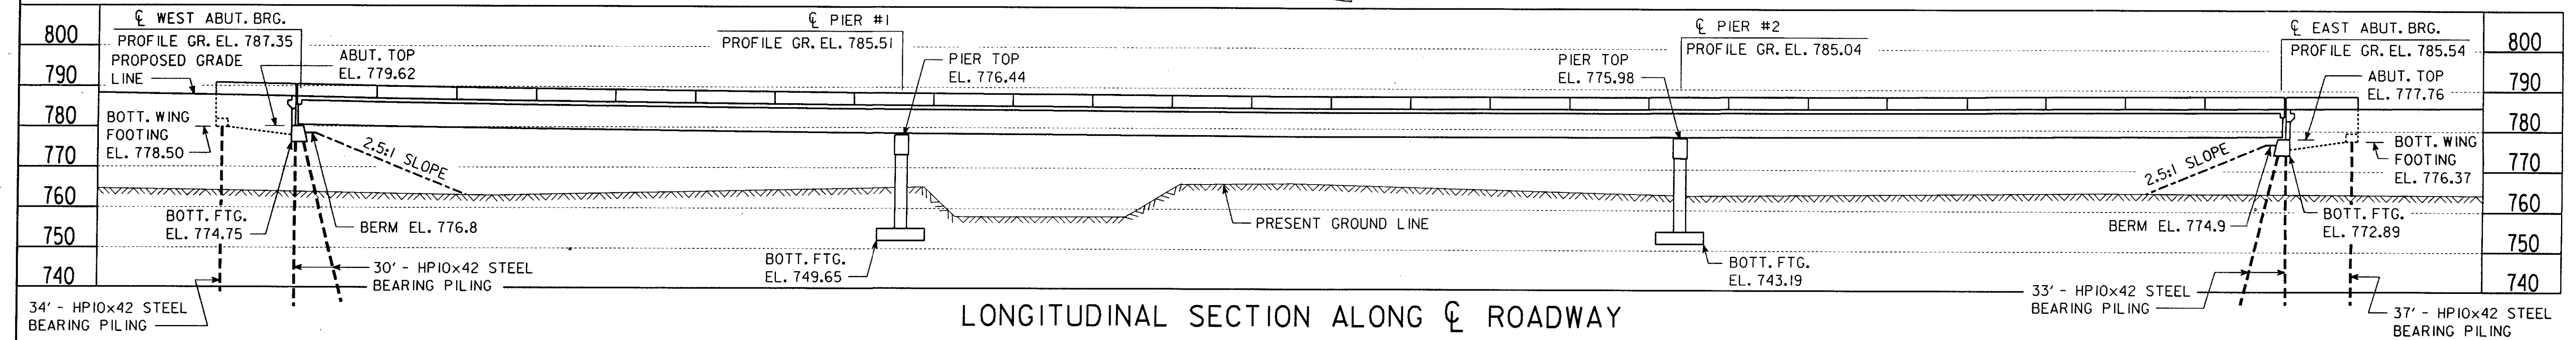

HYDRAULIC DATA

DRAINAGE AREA = 68.5
STREAM SLOPE = 5.63 FT./MI.

Q_{50} = 9010 CFS
NATURAL STAGE = 770.9

Q_{100} = 10900 CFS
NATURAL STAGE = 771.85

Q_{500} = 15870 CFS
STAGE W/BACKWATER = 773.93

TRAFFIC ESTIMATE

A. D. T. = 13575 V.P.D. (2006)
5% TRUCK

LOCATION

IOWA #100 OVER
INDIAN CREEK
T-83N, R-7W
SECTION 12
RAPIDS TWP.
LINN COUNTY

DESIGN FOR A 0° SKEW

500'-0" x 88' CONTINUOUS WELDED GIRDER BRIDGE

152'-0" END SPANS 196'-0" INTERIOR SPAN

SITUATION PLAN

STATION 153+00 NOVEMBER, 1993

LINN COUNTY

IOWA DEPARTMENT OF TRANSPORTATION - HIGHWAY DIVISION

DESIGN SHEET NO. 2 OF FILE NO. 26609 DESIGN NO. 391


P. 142

VC = 800'
MO = 3.69'

PISTA 304+00
PI ELEV 783.76

PROPOSED GRADE
IOWA NO. 100

LONGITUDINAL SECTION ALONG CULVERT
ANTICIPATED SETTLEMENT : NEGLIGIBLE

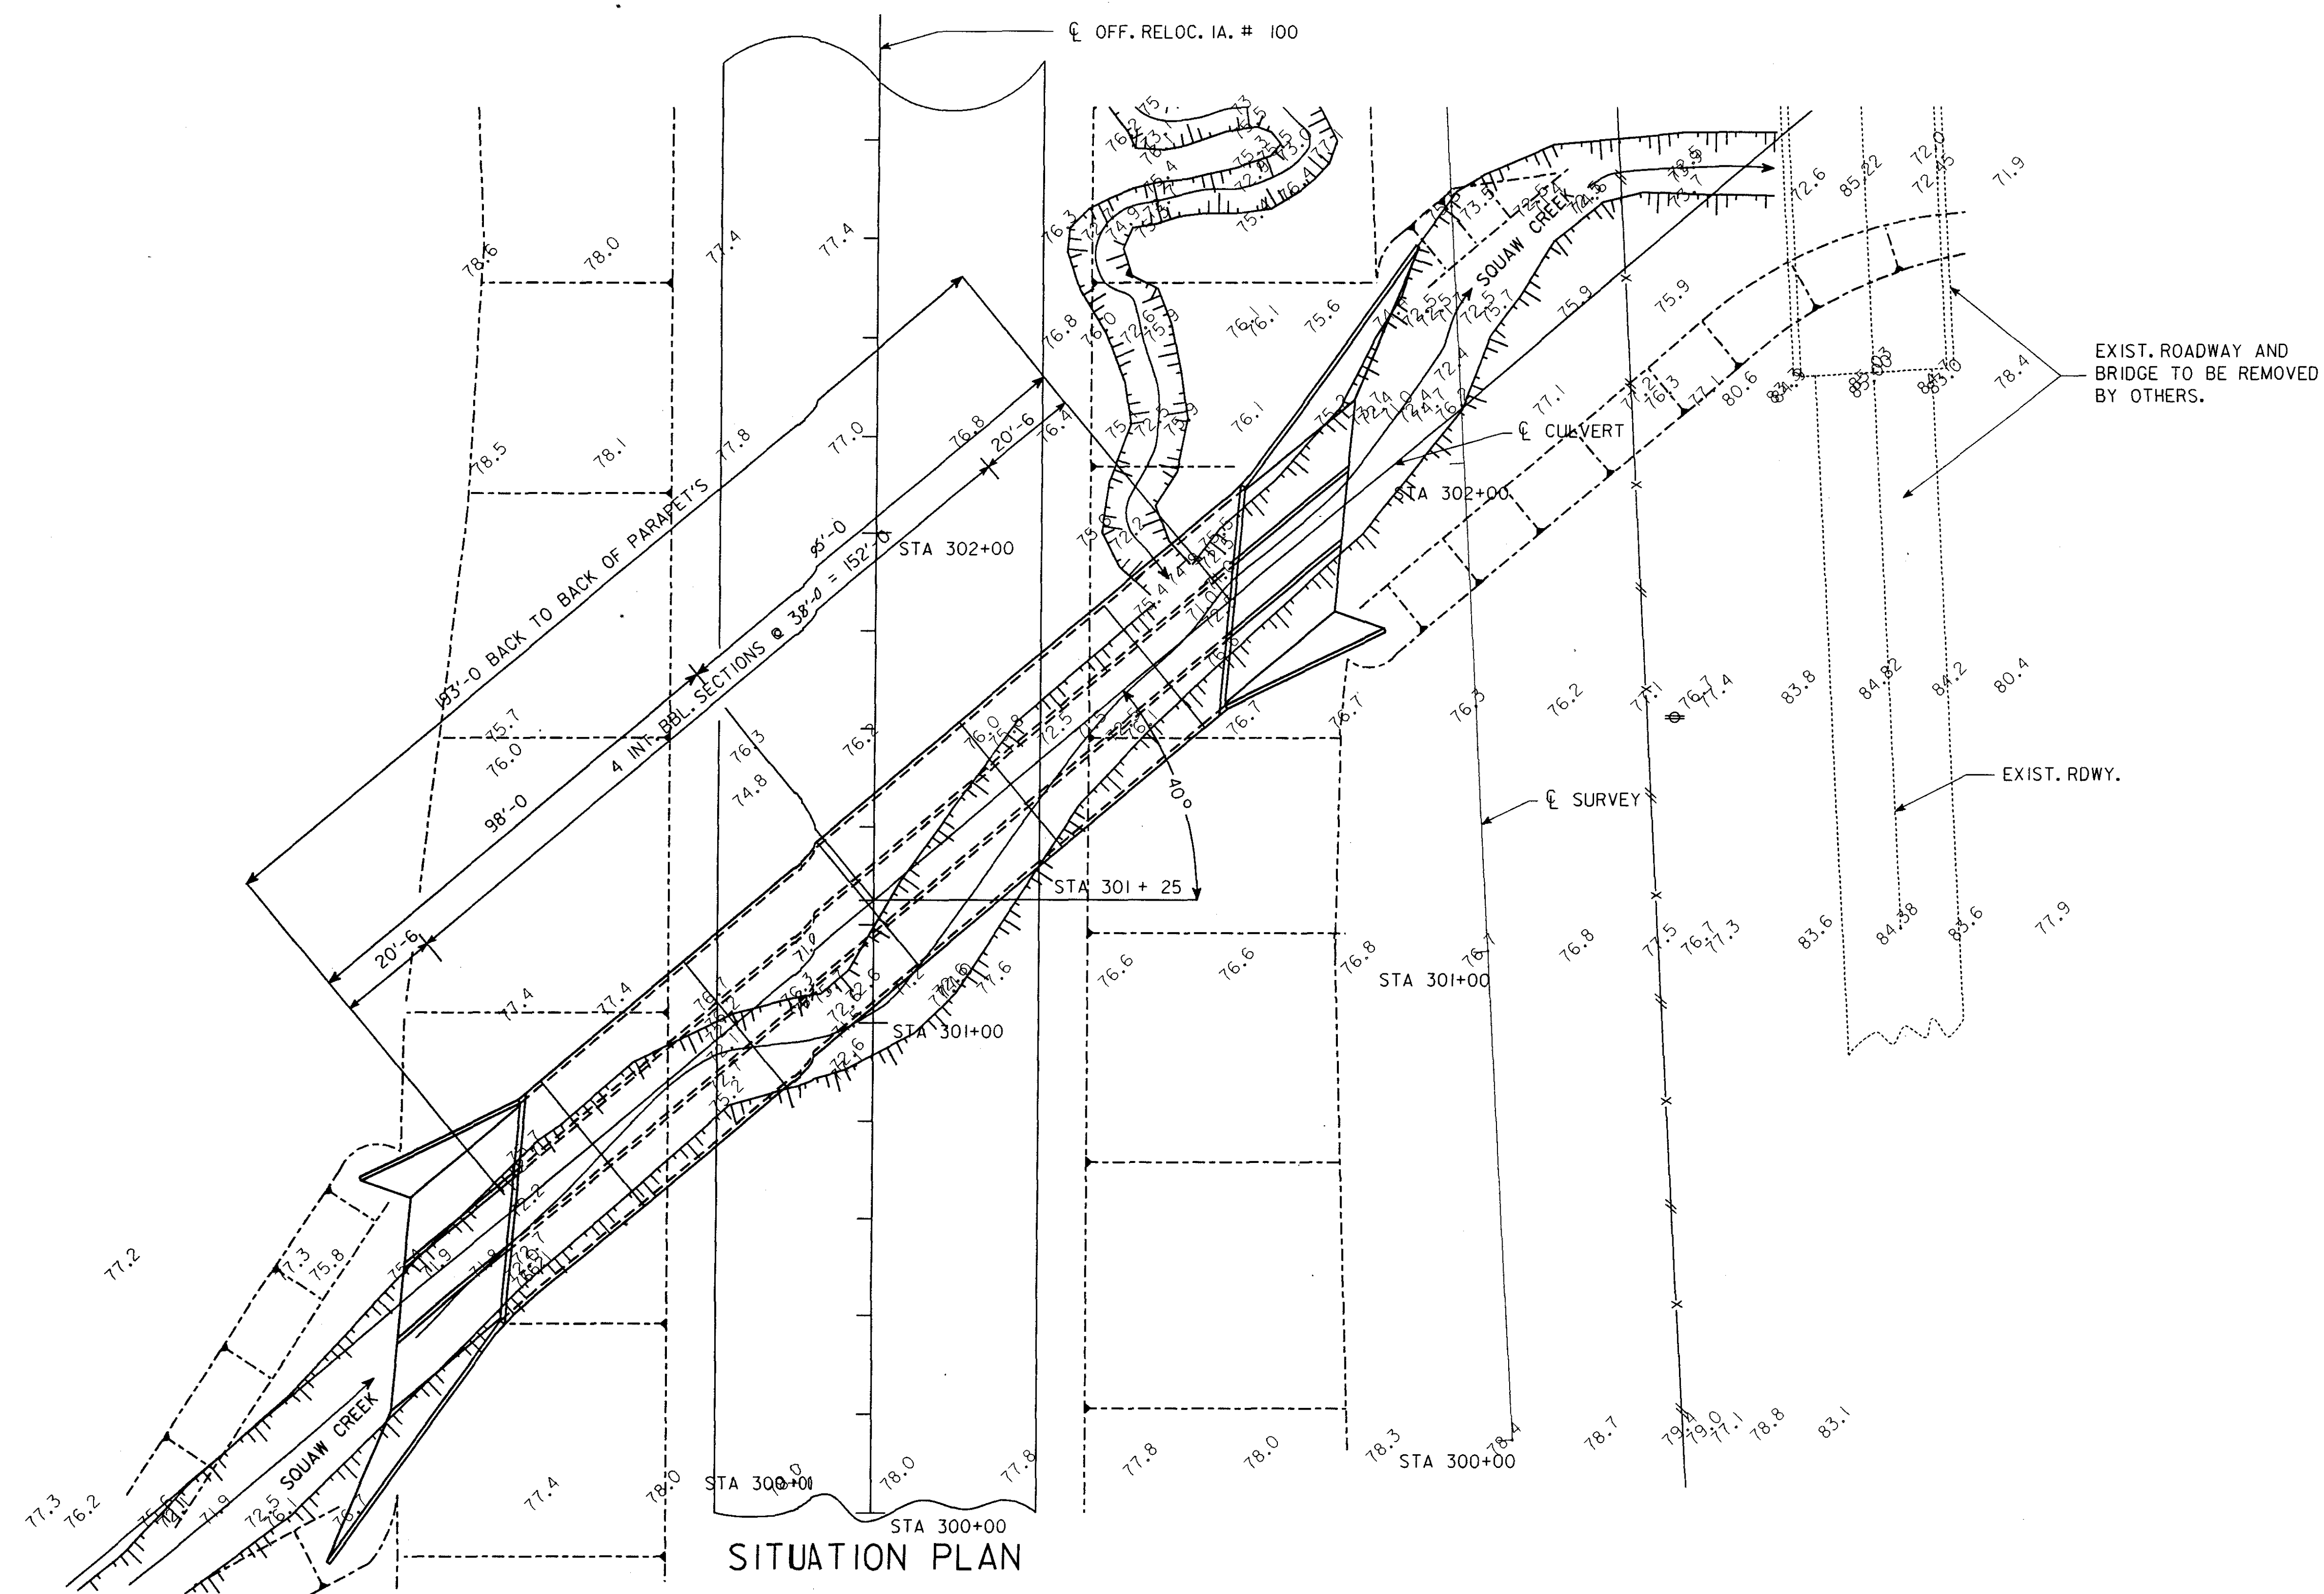

HYDRAULIC DATA

DRAINAGE AREA= 6.2 SQ MILES
STREAM SLOPE= 6.0 FT./MI.

Q50= 2380 CFS
INLET CONTROL= 781.5

Q100 = 2860 CFS
INLET CONTROL = 782.7

Q₅₀₀ = 3570 CFS
INLET CONTROL = 784.4

TRAFFIC ESTIMATE

1986: 9257 VPD
2006: 13575 VPD
5% TRUCKS

LOCATION:

IA. # 100
OVER SQUAW CREEK
T- 83N R - 6W
SECTION 4
MARION TWP.
LINN COUNTY

For Information Only

DESIGN FOR 40° SKEW (RT. AHEAD)

DESIGN FOR 40' SKEW (RT. AHEAD)
TRIPLE 10' x 10' x 193'-0 REINF.
CONCRETE BOX CULVERT

SITUATION PLAN

STATION: 301 + 25 (O.R.)

MARCH, 1994

LINN COUNTY

IOWA DEPARTMENT OF TRANSPORTATION - HIGHWAY DIVISION

DESIGN SHEET NO. 2 OF 12 FILE NO. 26609 DESIGN NO. 794

DESIGNED BY _____ TRACED BY _____ HM
 DETAILED BY _____ HM CHECKED BY J. Neiderhiser

H570794.S02

LINN COUNTY

PROJECT NUMBER

NH5-100-1(23) -- 19-57

STATE
IOWA

FHWA REGION
7

	FISCAL YEAR
--	----------------

SHEET NO.

TOTAL SHEETS	V.02
-----------------	------

IT IS THE INTENT OF THIS DESIGN TO BUILD A NEW 10'x8'x144'-0 REINFORCED CONCRETE BOX CULVERT.

THE PROPOSED CULVERT IS DESIGNED FOR HS20-44 LIVE LOAD AND EARTH FILL OF 7'. FOR VERTICAL LOADS THE WEIGHT OF EARTH IS ASSUMED AS 140 pcf, Z=170 FOR CRACK CONTROL. LATERAL EARTH LOADS EQUIVALENT FLUID PRESSURE IS ASSUMED AS 36 psf/FT.


UTILITY COMPANIES, WHOSE FACILITIES ARE KNOWN TO BE WITHIN THE CONSTRUCTION LIMITS, SHALL BE NOTIFIED BY THE CONTRACTOR OF THE CONSTRUCTION STARTING DATE.

WHEN DE-WATERING PRESENTS A PROBLEM FOR PLACING THE CURTAIN WALLS AS DETAILED, ALTERNATE METHODS SUCH AS STEEL SHEET PILE AND PRECAST CONCRETE WALLS MAY BE APPROVED BUT AT NO ADDITIONAL COST. THE CULVERT CONTRACTOR IS TO SUBMIT TO THE ENGINEER FOR APPROVAL COMPLETE DRAWINGS OF THE PROPOSED CURTAIN WALL ALTERNATE BEFORE BEGINNING CONSTRUCTION.

THE CONTRACTOR IS ENCOURAGED TO TAKE FULL ADVANTAGE OF SPECIFICATION 1105.15--VALUE ENGINEERING INCENTIVE PROPOSAL. A PAMPHLET AND CONCEPTUAL FORM WILL BE AVAILABLE AT THE PRECONSTRUCTION CONFERENCE.



THE CULVERT CONTRACTOR MAY USE PRECAST BOX SECTIONS INSTEAD OF THE CAST-IN-PLACE SECTIONS SHOWN ON THE PLANS. CAST-IN-PLACE HEADWALLS AS SPECIFIED ON THE PLANS WOULD STILL BE REQUIRED. BEFORE BEGINNING CONSTRUCTION THE CONTRACTOR SHALL SUBMIT DETAILS OF THE PROPOSED PRE-CAST BOX SECTIONS AND HEADWALL TO BOX CONNECTION TO THE ENGINEER FOR APPROVAL. THE CONTRACTOR SHALL ALLOW 10 WORKING DAYS FOR THE ENGINEER'S REVIEW. THE BASIS OF PAYMENT FOR THE PRE-CAST BOX SECTION ALTERNATE WILL BE FOR CONTRACT QUANTITIES AT THE UNIT PRICE BID FOR STRUCTURAL CONCRETE AND REINFORCING STEEL.

THE ROADWAY WILL BE CLOSED TO TRAFFIC DURING CONSTRUCTION. TRAFFIC CONTROL FOR ROAD CLOSURE SHALL BE THE RESPONSIBILITY OF THE ROAD CONTRACTOR.

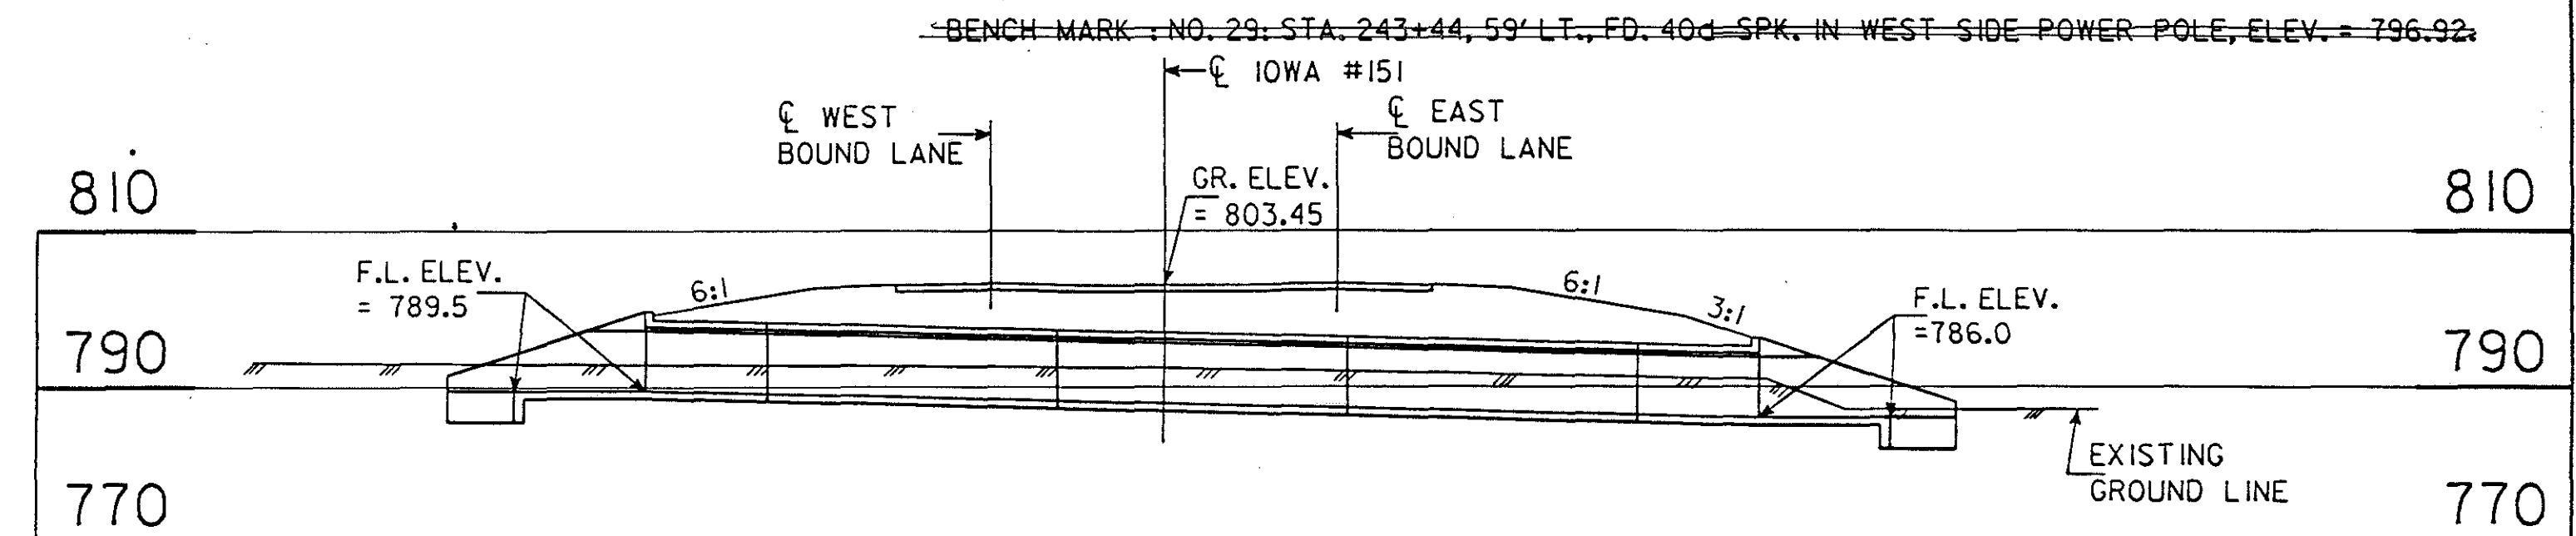

LONGITUDINAL SECTION ALONG CULVERT

HYDRAULIC DATA :
DRAINAGE AREA : 439 ACRES R-H
Q50 = 800 cfs

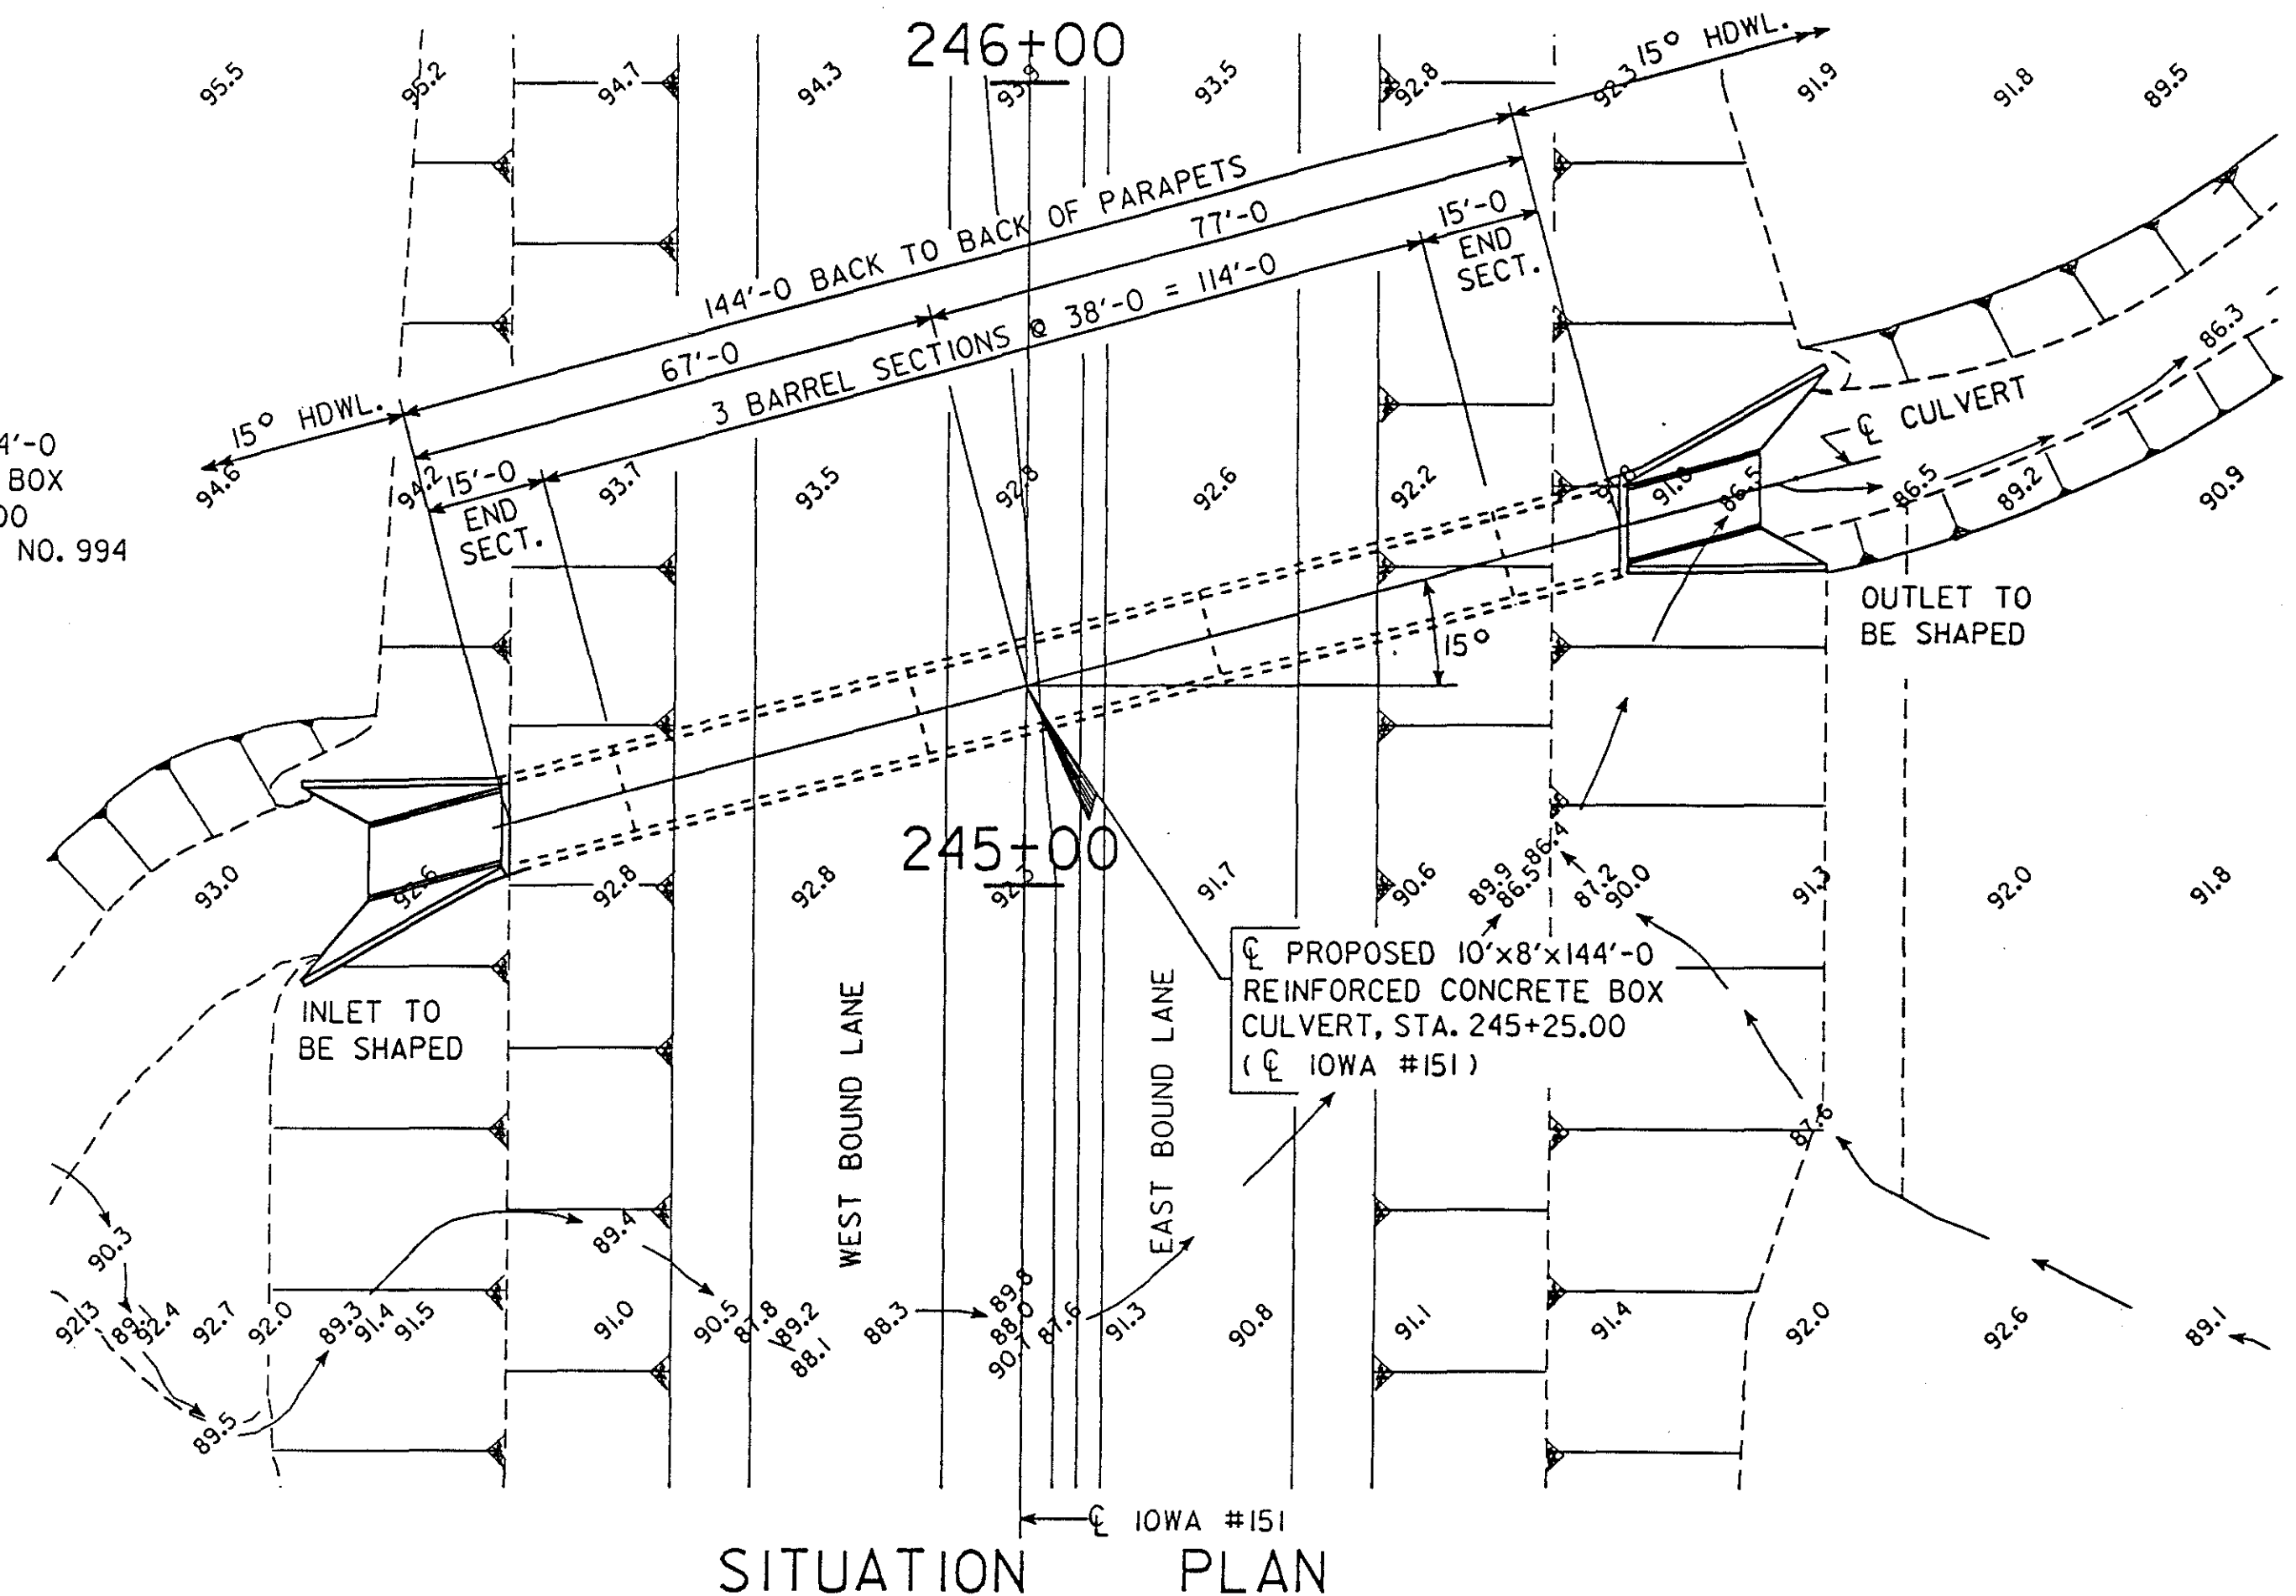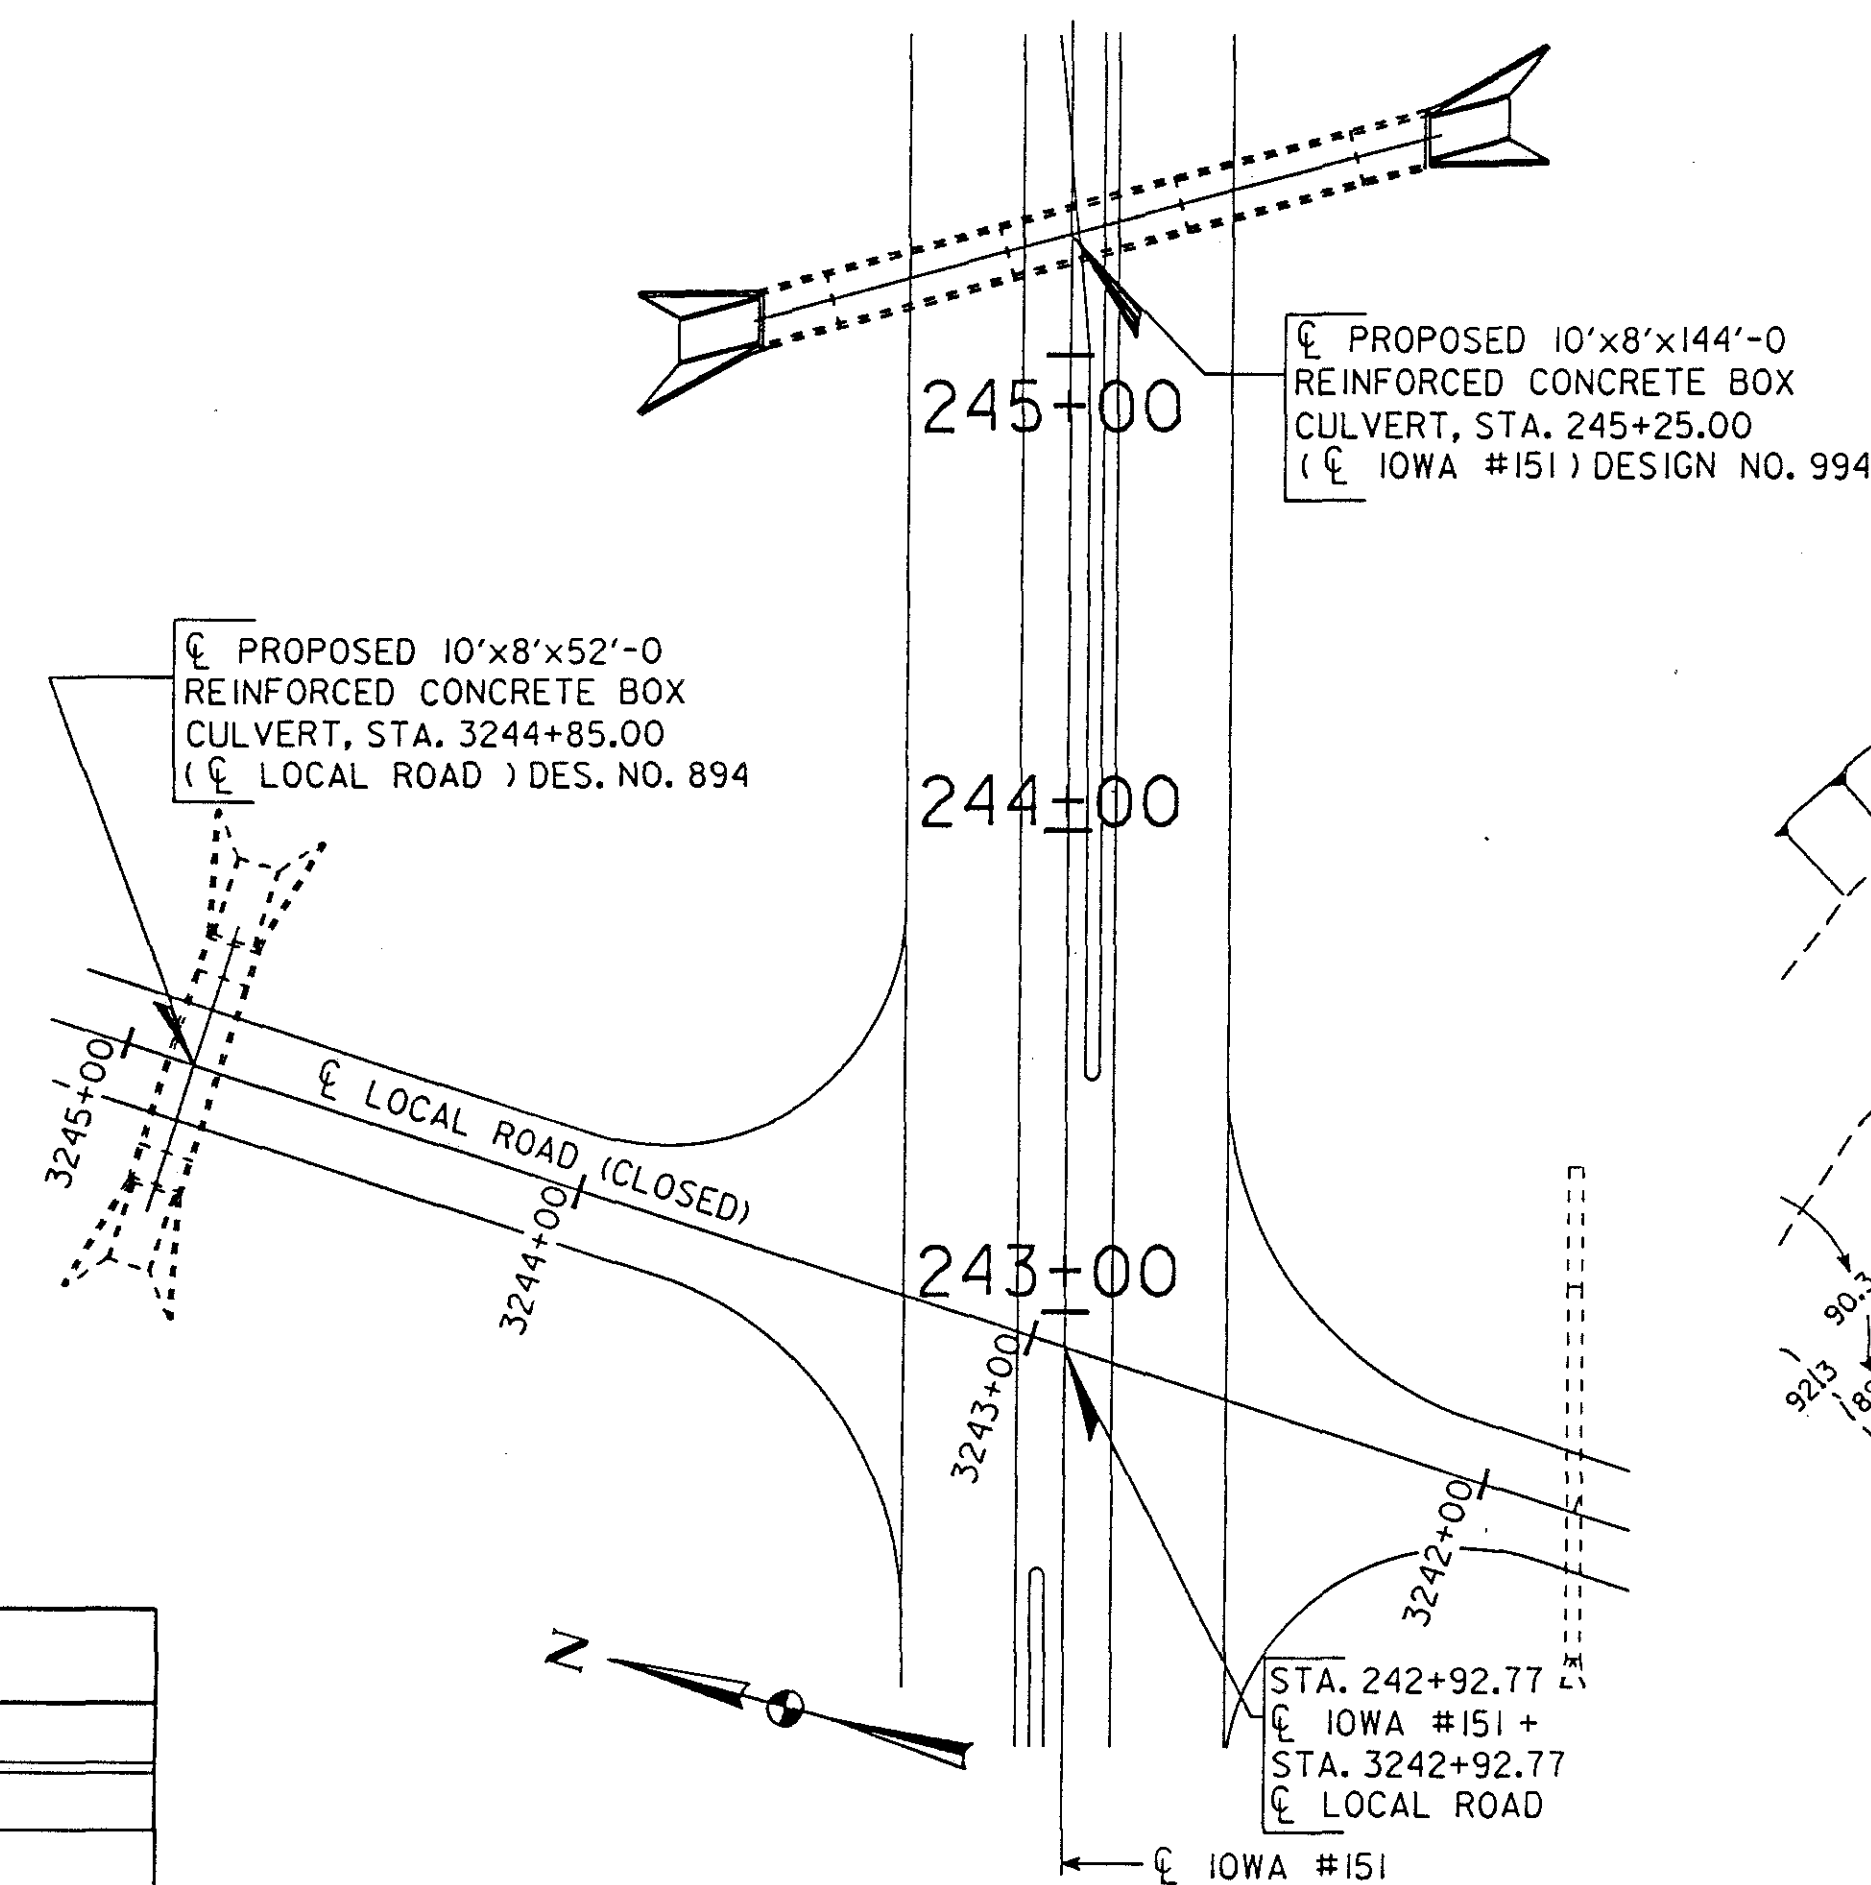

LOCATION	QUANTITY	TOTAL
2-10'x8' HDWL'S, 15° SKEW	2 @ 3985	7970
3 - 38'-0 BARREL SECTIONS	3 @ 8218	24,654
2 - 15'-0 END SECTIONS	2 @ 3244	6488
4 - SETS OF 5r1 BARS	4 @ 40	160
	TOTAL (LBS.)	39,272

LOCATION	SLAB	WALLS	FOOTING	TOTAL
2-10'x8' HDWL'S. 15° SKEW	*2 @ 1.6=3.2	2 @ 9.6=19.2	2 @ 21.3=42.6	65.0
3 - 38'-0 BARREL SECTIONS	3 @ 12.0=36.0	3 @ 16.1=48.3	3 @ 16.2=48.6	132.9
2 - 15'-0 END SECTIONS	2 @ 4.7=9.4	2 @ 6.3=12.6	2 @ 6.4=12.8	34.8
TOTAL - CU.YDS.	48.6	80.1	104.0	232.7

DESIGNED BY _____ TRACED BY _____
 DETAILED BY R.RYSAVY CHECKED BY _____

ESTIMATED CULVERT QUANTITIES			
ITEM NO.	ITEM	UNITS	QUANTITY
1	STRUCTURAL CONCRETE	CU.YDS.	232.7
2	REINFORCING STEEL	LBS.	39,272
3	CLASS 20 EXCAVATION	CU.YDS.	800
4	MOBILIZATION	LS	LUMP SUM

SECTION LEADER

STANDARDS :	LATEST REVISION DATE
RCB-GI-87	10-89
RCB 10-1-87	8-89
FWH 15-1-87	8-89
FWH 15-4-87	_____
FWH 15-5-87	_____
FWH 15-6-87	_____

IOWA 151 OVER STREAM
SECTION 8
T 83 N R 6 W
MARION TWP.
LINN COUNTY

1994: 750 VPD
2014: 800 VPD
14% TRUCKS

For Information Only

SITUATION PLAN

FEBRUARY, 1994

LINN COUNTY

IOWA DEPARTMENT OF TRANSPORTATION - HIGHWAY DIVISION
DESIGN SHEET NO. 1 OF 1 FILE NO. 26609 DESIGN NO. 994

LINN COUNTY

PROJECT NUMBER	
----------------	--

NHS-100-1 (23) --19-57

STATE

FHWA
REGIONAL OFFICEFISCAL
YEAR

SHEET
NO.

TOTAL SHEET

GENERAL NOTES

IT IS THE INTENT OF THIS DESIGN TO REPLACE THE EXISTING 8'x40' ARCH WITH CMP APRON, WITH A 10'x8'x52'-0 REINFORCED CONCRETE BOX CULVERT. THE PROPOSED CULVERT IS DESIGNED FOR HS20-44 LIVE LOAD AND EARTH FILL OF 3'. FOR VERTICAL LOADS THE WEIGHT OF EARTH IS ASSUMED AS 140 pcf. Z=170 FOR CRACK CONTROL. LATERAL EARTH LOADS EQUIVALENT FLUID PRESSURE IS ASSUMED AS 36 psf/ft.

UTILITY COMPANIES, WHOSE FACILITIES ARE KNOWN TO BE WITHIN THE CONSTRUCTION LIMITS, SHALL BE NOTIFIED BY THE CONTRACTOR OF THE CONSTRUCTION STARTING DATE.

THE LUMP SUM BID ITEM "REMOVAL OF EXISTING STRUCTURES" SHALL INCLUDE THE REMOVAL AND DISPOSAL OF THE EXISTING 8'x40' ARCH AT STATION 3244+85.50. THE STRUCTURE SHALL BE REMOVED IN ACCORDANCE WITH SECTION 2401 OF THE STANDARD SPECIFICATIONS. ALL MATERIAL REMOVED SHALL BECOME THE PROPERTY OF THE CONTRACTOR AND SHALL BE HAULED FROM THE SITE TO A WASTE AREA OR DISPOSAL SITE BY HIM. NO PAYMENT FOR OVERHAUL WILL BE ALLOWED FOR MATERIAL HAULED TO THESE SITES.

WHEN DE-WATERING PRESENTS A PROBLEM FOR PLACING THE CURTAIN WALLS AS DETAILED, ALTERNATE METHODS SUCH AS STEEL SHEET PILE AND PRECAST CONCRETE WALLS MAY BE APPROVED BUT AT NO ADDITIONAL COST. THE CULVERT CONTRACTOR IS TO SUBMIT TO THE ENGINEER FOR APPROVAL COMPLETE DRAWINGS OF THE PROPOSED CURTAIN WALL ALTERNATE BEFORE BEGINNING CONSTRUCTION.


THE CONTRACTOR IS ENCOURAGED TO TAKE FULL ADVANTAGE OF SPECIFICATION 1105.15--VALUE ENGINEERING INCENTIVE PROPOSAL. A PAMPHLET AND CONCEPTUAL FORM WILL BE AVAILABLE AT THE PRECONSTRUCTION CONFERENCE.

THE CULVERT CONTRACTOR MAY USE PRECAST BOX SECTIONS INSTEAD OF THE CAST-IN-PLACE SECTIONS SHOWN ON THE PLANS. CAST-IN-PLACE HEADWALLS AS SPECIFIED ON THE PLANS WOULD STILL BE REQUIRED. BEFORE BEGINNING CONSTRUCTION THE CONTRACTOR SHALL SUBMIT DETAILS OF THE PROPOSED PRE-CAST BOX SECTIONS AND HEADWALL TO BOX CONNECTION TO THE ENGINEER FOR APPROVAL. THE CONTRACTOR SHALL ALLOW 10 WORKING DAYS FOR THE ENGINEER'S REVIEW. THE BASIS OF PAYMENT FOR THE PRE-CAST BOX SECTION ALTERNATE WILL BE FOR CONTRACT QUANTITIES AT THE UNIT PRICE BID FOR STRUCTURAL CONCRETE AND REINFORCING STEEL.


IT SHOULD BE NOTED THE CULVERT CONTRACTOR IS TO PLACE A 12' SECTION OF 15" CONCRETE ROADWAY PIPE (2000 D) RF-1 UNDER THE CULVERT. THE PIPE IS TO BE PLACED 8' RIGHT OF C OFFICE RELOCATION AND TO THE FLOW LINES NOTED AND SHOWN.

TRAFFIC CONTROL PLAN


THE ROADWAY WILL BE CLOSED TO TRAFFIC DURING CONSTRUCTION. TRAFFIC CONTROL FOR ROAD CLOSURE SHALL BE THE RESPONSIBILITY OF THE ROAD CONTRACTOR.

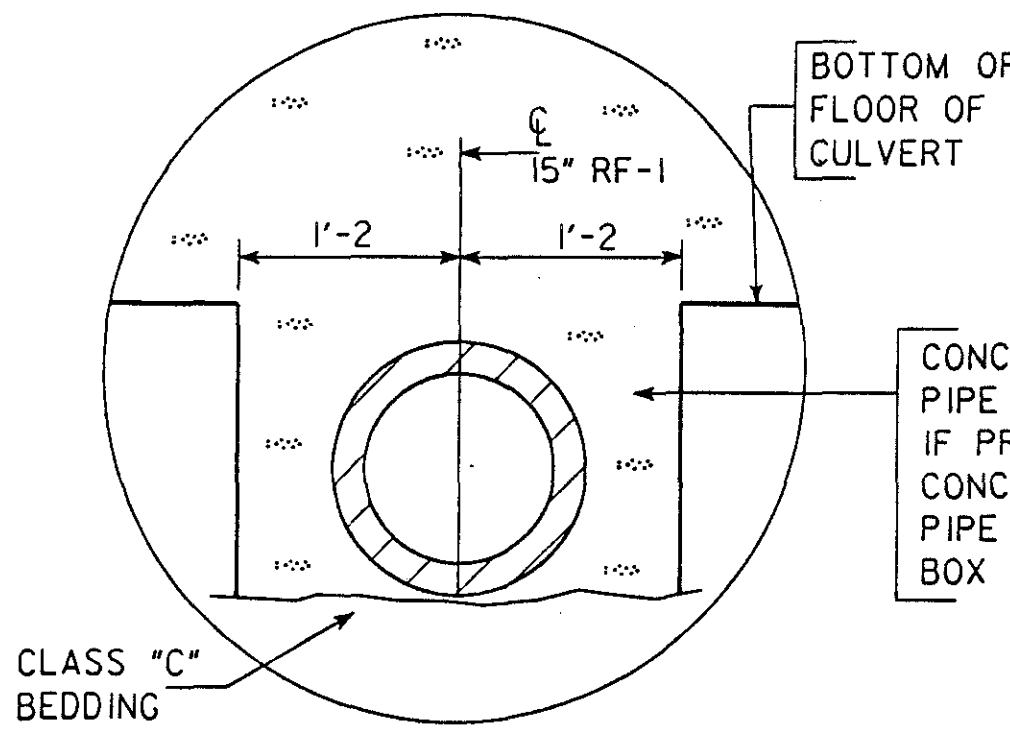

CONCRETE SHALL BE PLACED AROUND RF-1 PIPE DURING PLACEMENT OF CULVERT FLOOR. IF PRECAST BOX SECTIONS ARE USED, CONCRETE SHALL BE PLACED AROUND RF-1 PIPE PRIOR TO PLACING THE PRECAST BOX SECTIONS.

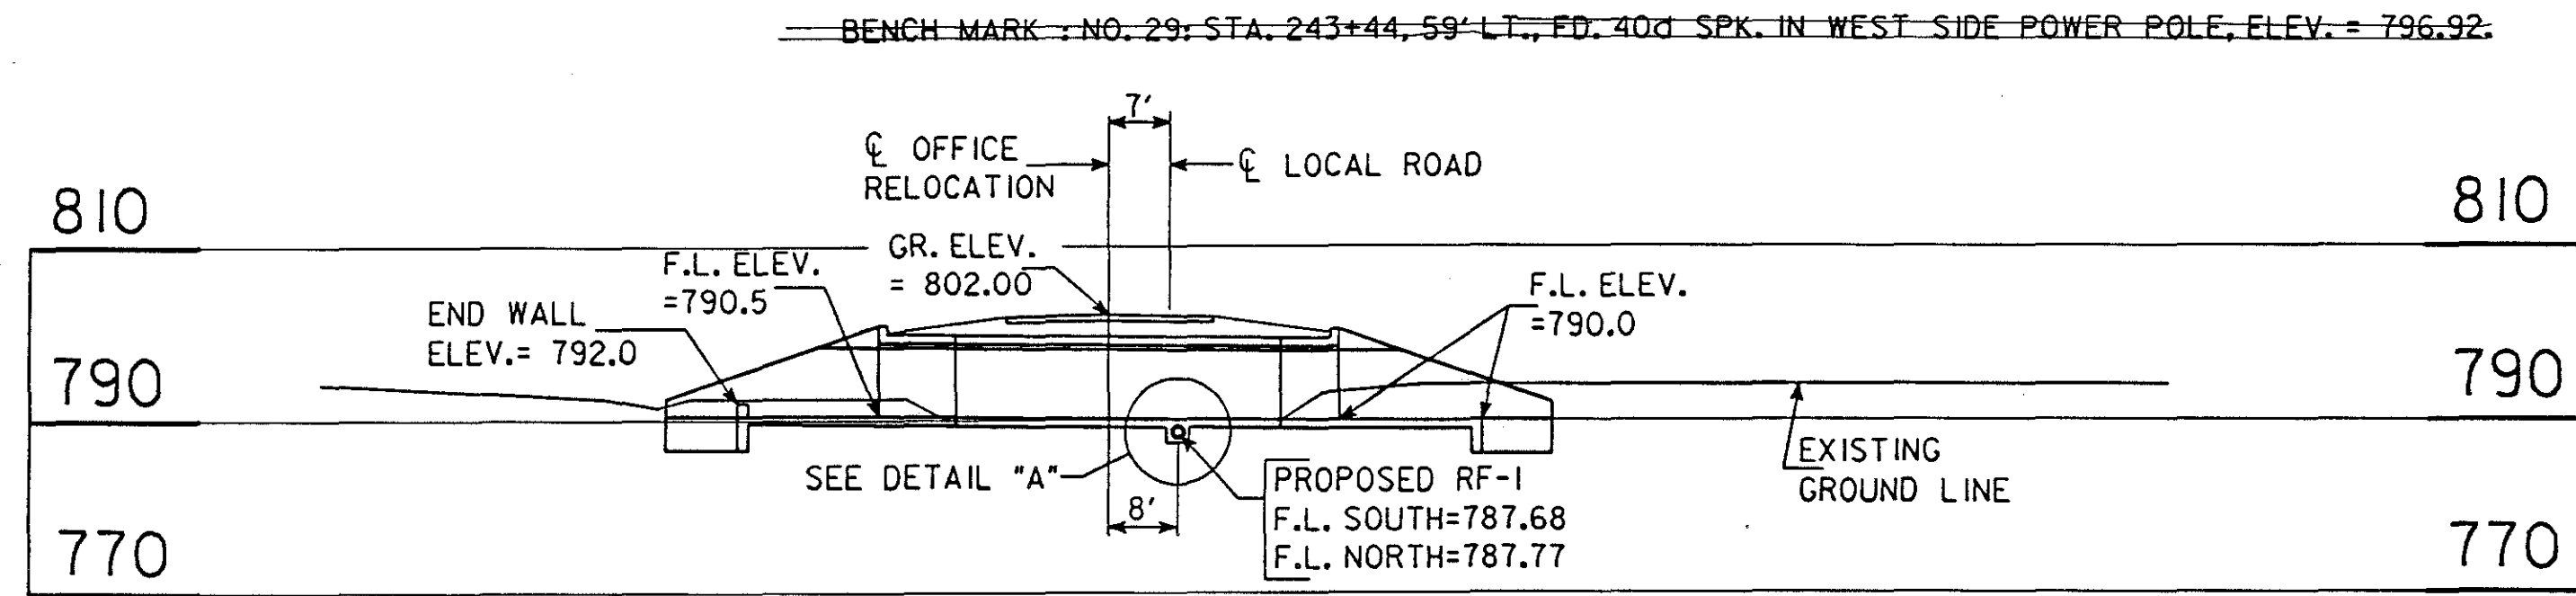

HYDRAULIC DATA :
DRAINAGE AREA : 399 ACRES R-H
Q50 = 800 cfs

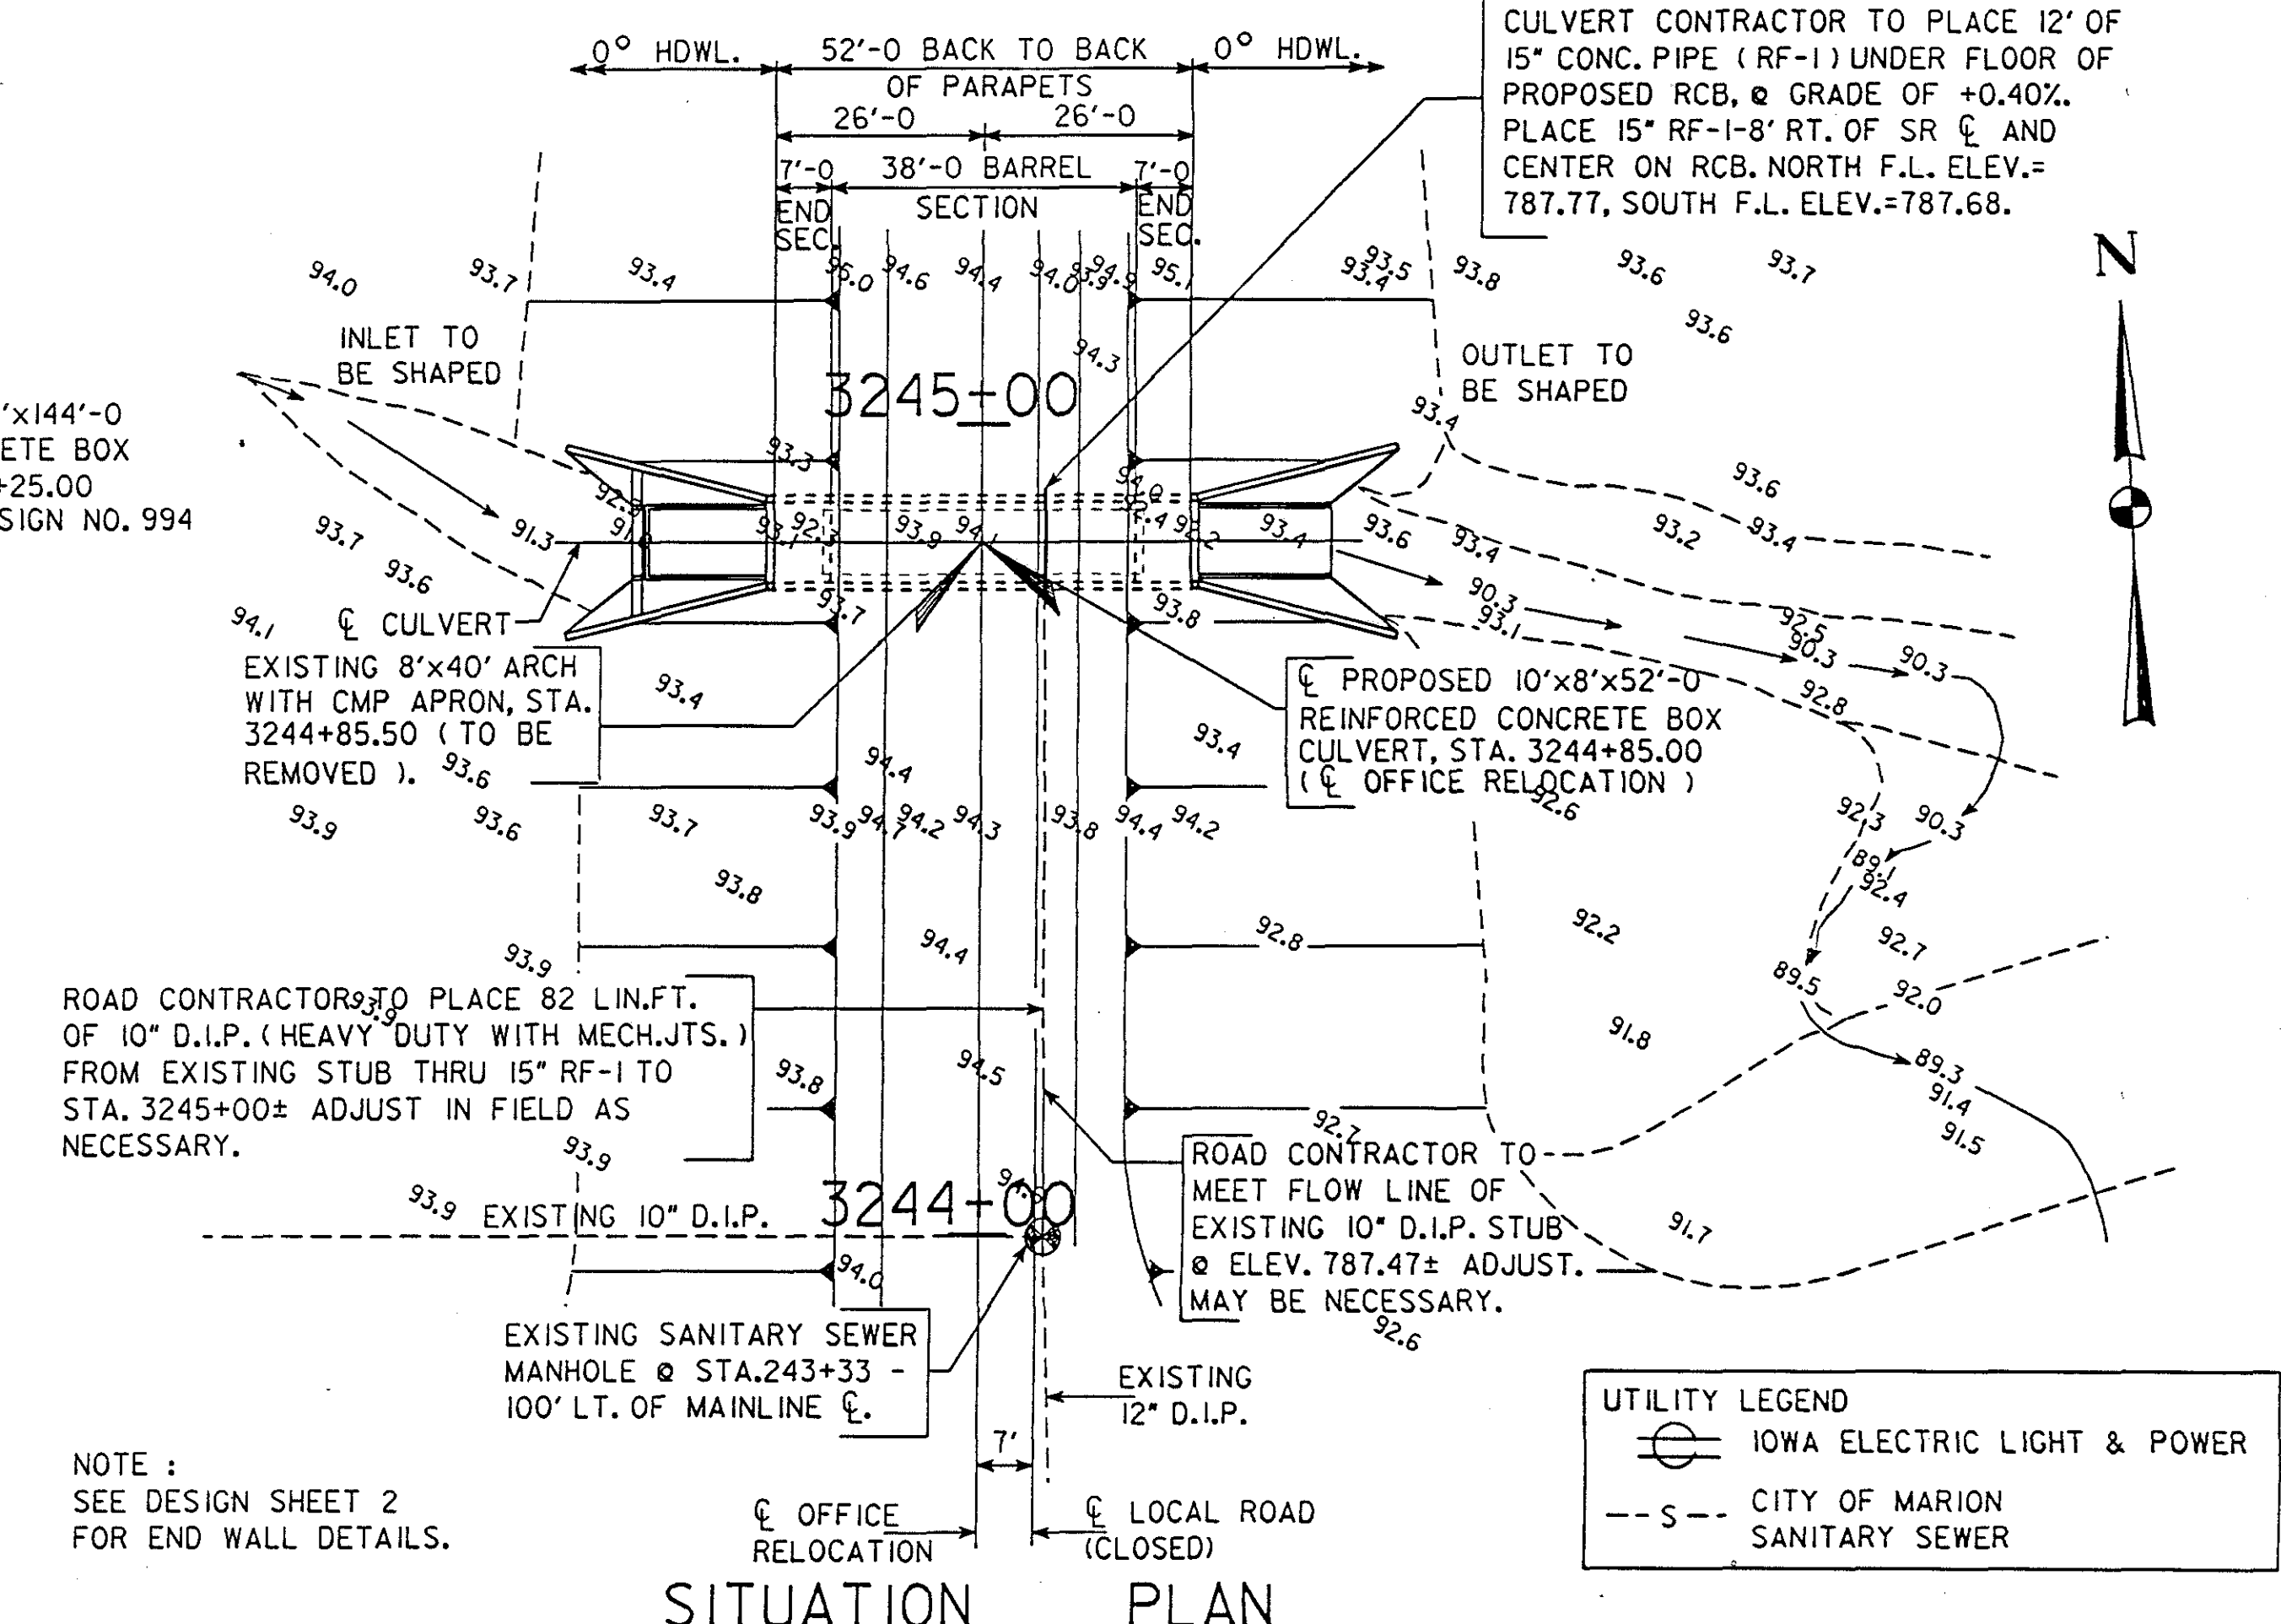

SUMMARY OF REINFORCING STEEL

LOCATION	QUANTITY	TOTAL
2-10'x8' HDWL'S. 0° SKEW	2 @ 3953	7906
1- 38'-0 BARREL SECTION	6768	6768
2 - 7'-0 END SECTIONS	2 @ 1247	2494
END WALL (INLET HDWL.)	231	231
2 - SETS OF 5r1 BARS	2 @ 40	80
TOTAL (LBS.)		17,479

CONCRETE PLACEMENT QUANTITIES

LOCATION	SLAB	WALLS	FOOTING	TOTAL
2-10'x8' HDWL'S. 0° SKEW	*2 @ 1.5=3.0	2 @ 9.1=18.2	2 @ 20.3=40.6	61.8
1- 38'-0 BARREL SECTION	12.0	16.1	4 16.5	44.6
2 - 7'-0 END SECTIONS	2 @ 2.2=4.4	2 @ 3.0=6.0	2 @ 2.9=5.8	16.2
END WALL (INLET HDWL.)		0.9		0.9
TOTAL - CU.YDS.	19.4	41.2	62.9	123.5

ESTIMATED CULVERT QUANTITIES

ITEM NO.	ITEM	UNITS	QUANTITY
1	STRUCTURAL CONCRETE	CU.YDS.	123.5
2	REINFORCING STEEL	LBS.	17,479
3	CLASS 20 EXCAVATION	CU.YDS.	300
4	CONCRETE ROADWAY PIPE CULVERT, 12 IN. DIA.	LIN.FT.	12.0
5	REMOVAL OF EXISTING STRUCTURES	LS	LUMP SUM
6	MOBILIZATION	LS	LUMP SUM

ESTIMATE REFERENCE INFORMATION :
1 ALL STRUCTURAL CONCRETE TO BE CLASS "C".
4 CONCRETE ROADWAY PIPE TO BE 2000D.

DESIGNED BY R.RYSAVY TRACED BY
CHECKED BY

SECTION LEADER

LINN COUNTY

PROJECT NUMBER	NHS-100-1(23)--19-57	STATE	IOWA	FHWA REGION	7	FISCAL YEAR		SHEET NO.	V.04	TOTAL SHEETS	
----------------	----------------------	-------	------	-------------	---	-------------	--	-----------	------	--------------	--