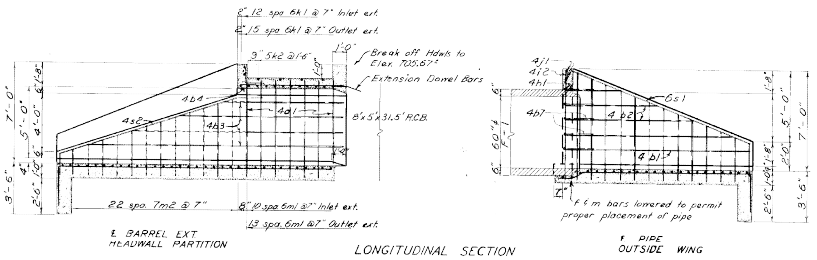

E. BARREL EXT. HEADWALL PARTITION

LONGITUDINAL SECTION

F. PIPE OUTSIDE WING

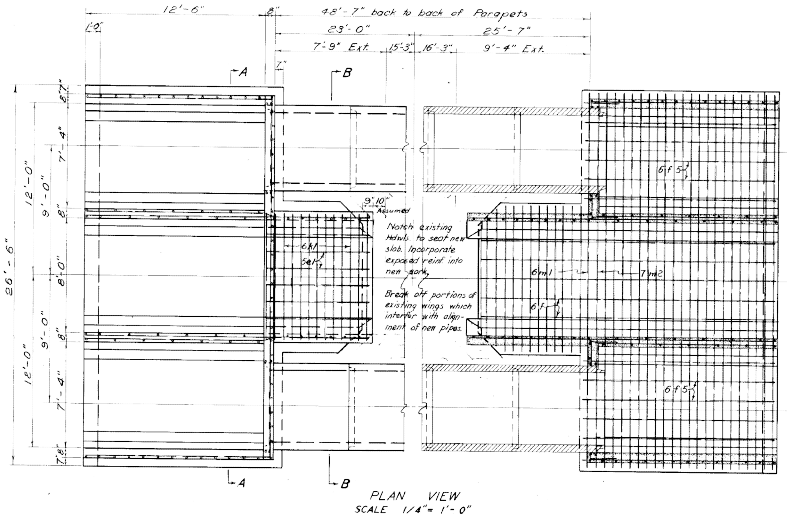

PLAN VIEW
SCALE 1/4" = 1'-0"

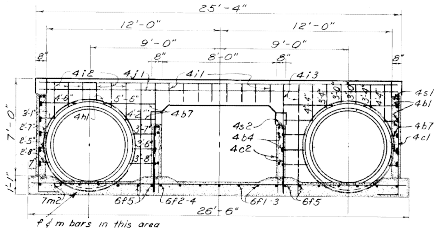

SECTION A - A

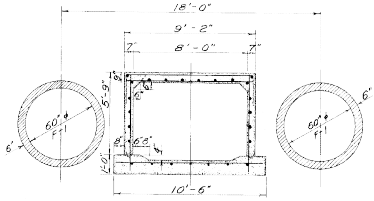

SECTION B-B

~~ESTIMATED~~ QUANTITIES OF REINFORCING

BAR	LOCATION	SHAPE	No.	LENGTH	LINEAR FEET 4	5	6	7
4a1	Walls Vert.		32	8'-8" 8'-5"; 4'-8" 4'-3"	214.3			
4b1	Wings Outside Horiz.		4	12'-10"	51.3			
4b2	Wings Outside Horiz.		16	4'-3"-11'-10"	128.7			
4b3	Cir. Wings & Bbl. Walls Horiz Inlet		8	8'-6"-17'-10"	105.3			
4b4	Cir. Wings & Bbl. Walls Horiz Inlet		2	7'-3"	14.5			
4b5	Cir. Wings & Bbl. Walls Horiz Outlet		8	10'-1"-19'-5"	118.0			
4b6	Cir. Wings & Bbl. Walls Horiz Outlet		2	6'-10"	17.7			
4b7	Hdwl. Face Horiz.		40	Shown	71.3			
4c1	Wings Vert. Outside		52	4'-0"-8'-8"	329.3			
4c2	Wings Vert. Center		48	8'-2"-5'-5"	188.0			
4c3	Wings Vert. Center Front		8	1'-10"	14.7			
5s1	Slab Long.		12	8'-8" 7'-3" 6'-8" 5'-6" 4'-3" 2'-10" 1'-9"		93.5		
4s2	Slab Long. Top		4	8'-8" 7'-3" 6'-8" 5'-6" 4'-3" 2'-10" 1'-9"	32.2			
6f1	Floor Long. Inlet		5	22'-4"			111.7	
6f2	Floor Long. Inlet		6	21'-2"			92.3	
6f3	Floor Long. Outlet		5	23'-11"			119.6	
6f4	Floor Long. Outlet		2	22'-9"			45.5	
6f5	Floor Long.		28	16'-1"			450.3	
4h1	Hoops Around Pipe Ends		8	20'-9"	166.0			
4j1	Rpt. Vert.		16	1'-9"	28.0			
4i2	Rpt. Vert. & Hdwl. Face		24	Shown	42.7			
4i3	Rpt. Vert. & Hdwl. Face		8	7'-8"	61.3			
4j1	Rpt. Trans.		4	25'-0"	100.0			
6k1	Slab Trans. Bot.		29	8'-10"			256.2	
5k2	Slab Trans. Top		9	14'-6"		130.5		
6m1	Bbl. Floor Trans.		25	2'-10.5"-8'-8" @ 10"-8"			285.2	
7m2	Hdwl. Floor Trans.		44	26'-2"				1151.3
4s1	Wing Slope Outside		8	14'-4"	114.7			
4s2	Wing Slope Center		8	13'-11"	111.3			
				TOTAL LENGTH	1903.3	221.0	1310.8	1151.3
				WEIGHT	1271.4	236.8	1968.8	2353.2
				TOTAL WEIGHT	5830.2 LBS.			

~~ESTIMATED~~ QUANTITIES OF CONCRETE

LOCATION	ABOVE KEYWAY	BELOW KEYWAY	TOTAL
2 HEADWALL & Beams 7@1'-4"	12.19 CY	32.33 CY	44.48 CY
BARREL EXT.	6T		
	7.39 ✓	6.12	14.20 CY
TOTAL	20.22 CY	38.46 CY	58.68 CY

For details and General Notes not shown, refer to Iowa State Highway Commission Standard, C-8-F with 2 feet of fill.

TOTAL ~~ESTIMATED~~ QUANTITIES

CONCRETE	58.7	C.Y.
REINFORCING	5830	LBS.
60" ϕ F-1 PIPE	100	L.F.T.
EXCAVATION CLASS 20	884	C.Y.

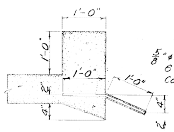

5/8" ϕ x 2'-0" dowels @ 1'-6" C dowels needed = 12.5 lbs. Cost to be included in price bid for concrete.

EXTENSION DOWEL BARS

Installation of dowels
1. Drill holes twice the diameter of bar to indicated depth.
2. Fill holes with water and let stand long enough to thoroughly saturate concrete. (four hours)
3. Blow out all free water.
4. Fill holes about ⅔ full of mortar.
5. Insert dowels by driving. If necessary, and manipulate or tap with hammer to secure complete embedement
6. Add more mortar if necessary to fill hole. Mortar mix shall consist of equal parts of cement and sand with just enough water to make workable mix.

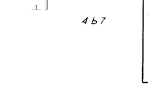

General Note:
Design Stresses for the following materials are in accordance with AASHO Standard Specifications for Highway Bridges. Series of 1957

Reinforcing Steel in accordance with Section 1.4.12, "Reinforcement" for Intermediate, Hard or Rail Steel Grade.

Concrete in accordance with Section 1.4.11
$F_c' = 3500$ psi.

Sta. 204+99.6 ± H.C. pkg. in N. Hdwl. 8'x8' R.C.B. El. 706.09

BENCH MARK No. 20AA ~~Sta 204+99.6, 1'-0" offset Handrail El 713.3 R.C. Bar. El. 710.35~~

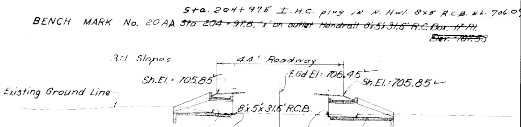

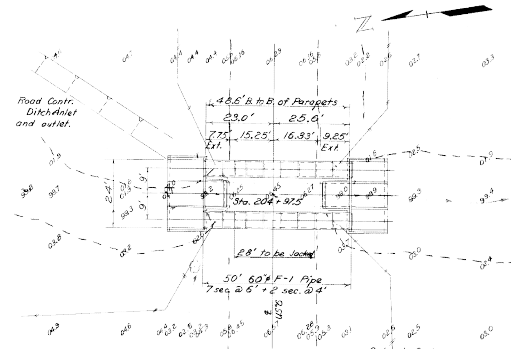

SITUATION PLAN
SCALE 1" = 20.0'

CONSTRUCTED ~~LOCATION~~
SECTION 27 T-80-N R-7-W
CLEARCREEK TOWNSHIP
JOHNSON COUNTY

D.A. 700 AC. HILLY TO ROLLING
FILL 2 FT.

Culvert Contr. ~~Strip~~ off nonearth to below elev. of 705.67'. Jack 60" pipes, 60'-9 x 28'-2 F-1 under roadway. Notch existing Hdwl to seat new slab. Incorporate exposed reinf into new work. ~~Break~~ off portions of existing wings which interfere with alignment of new pipe.

DESIGN FOR
8' x 5' R.C. BOX CULVERT EXT.
FLANKED BY
2-60" ϕ F-1 PIPES
WITH
24' x 5' R.C. HEADWALL
STA 204 + 97.5 PROJECT No. F-289(6)

JOHNSON COUNTY

~~Construction~~ as Shown

IOWA STATE HIGHWAY COMMISSION

FEBRUARY 1960 SCALES AS NOTED

DESIGN No. 2760 JOHNSON COUNTY FILE No. 20708